

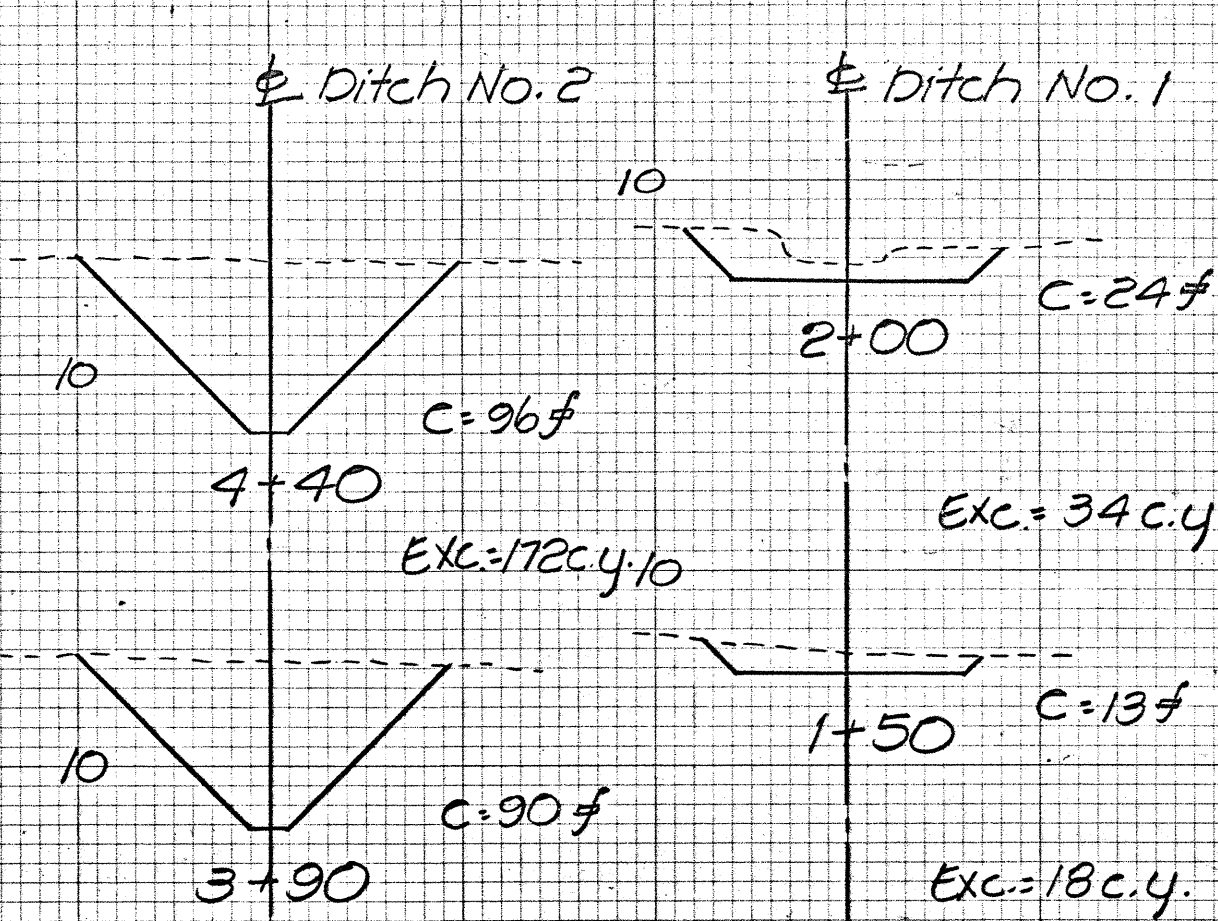
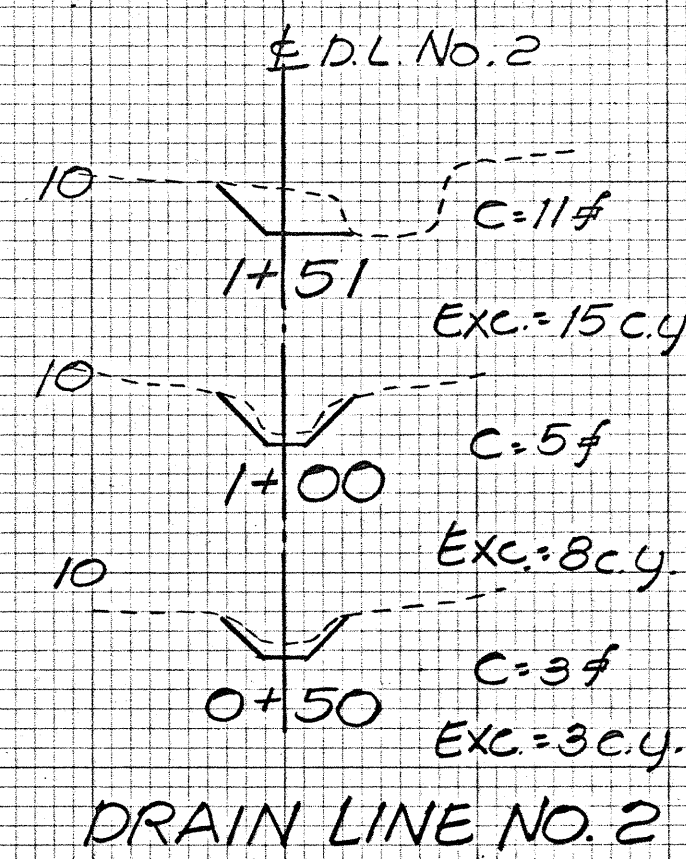
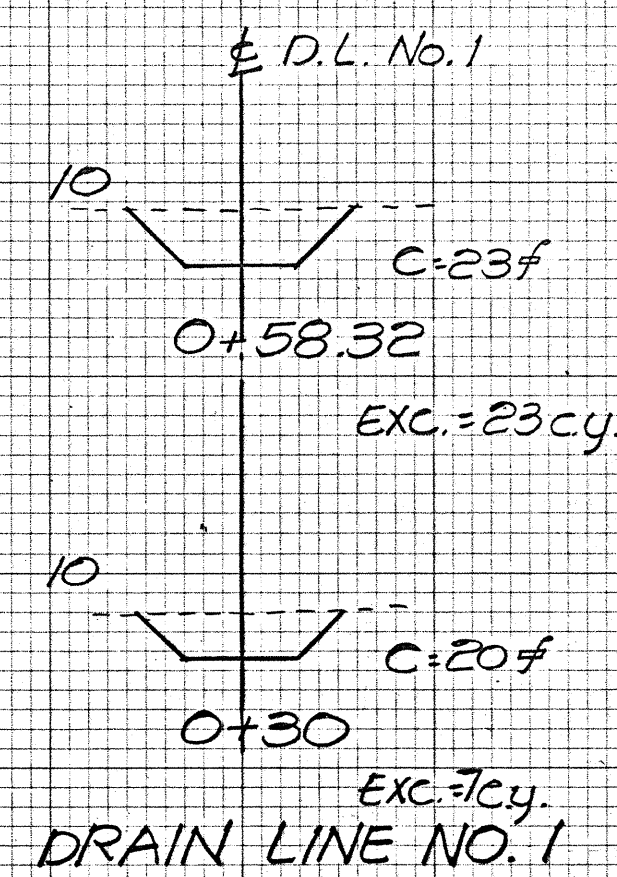
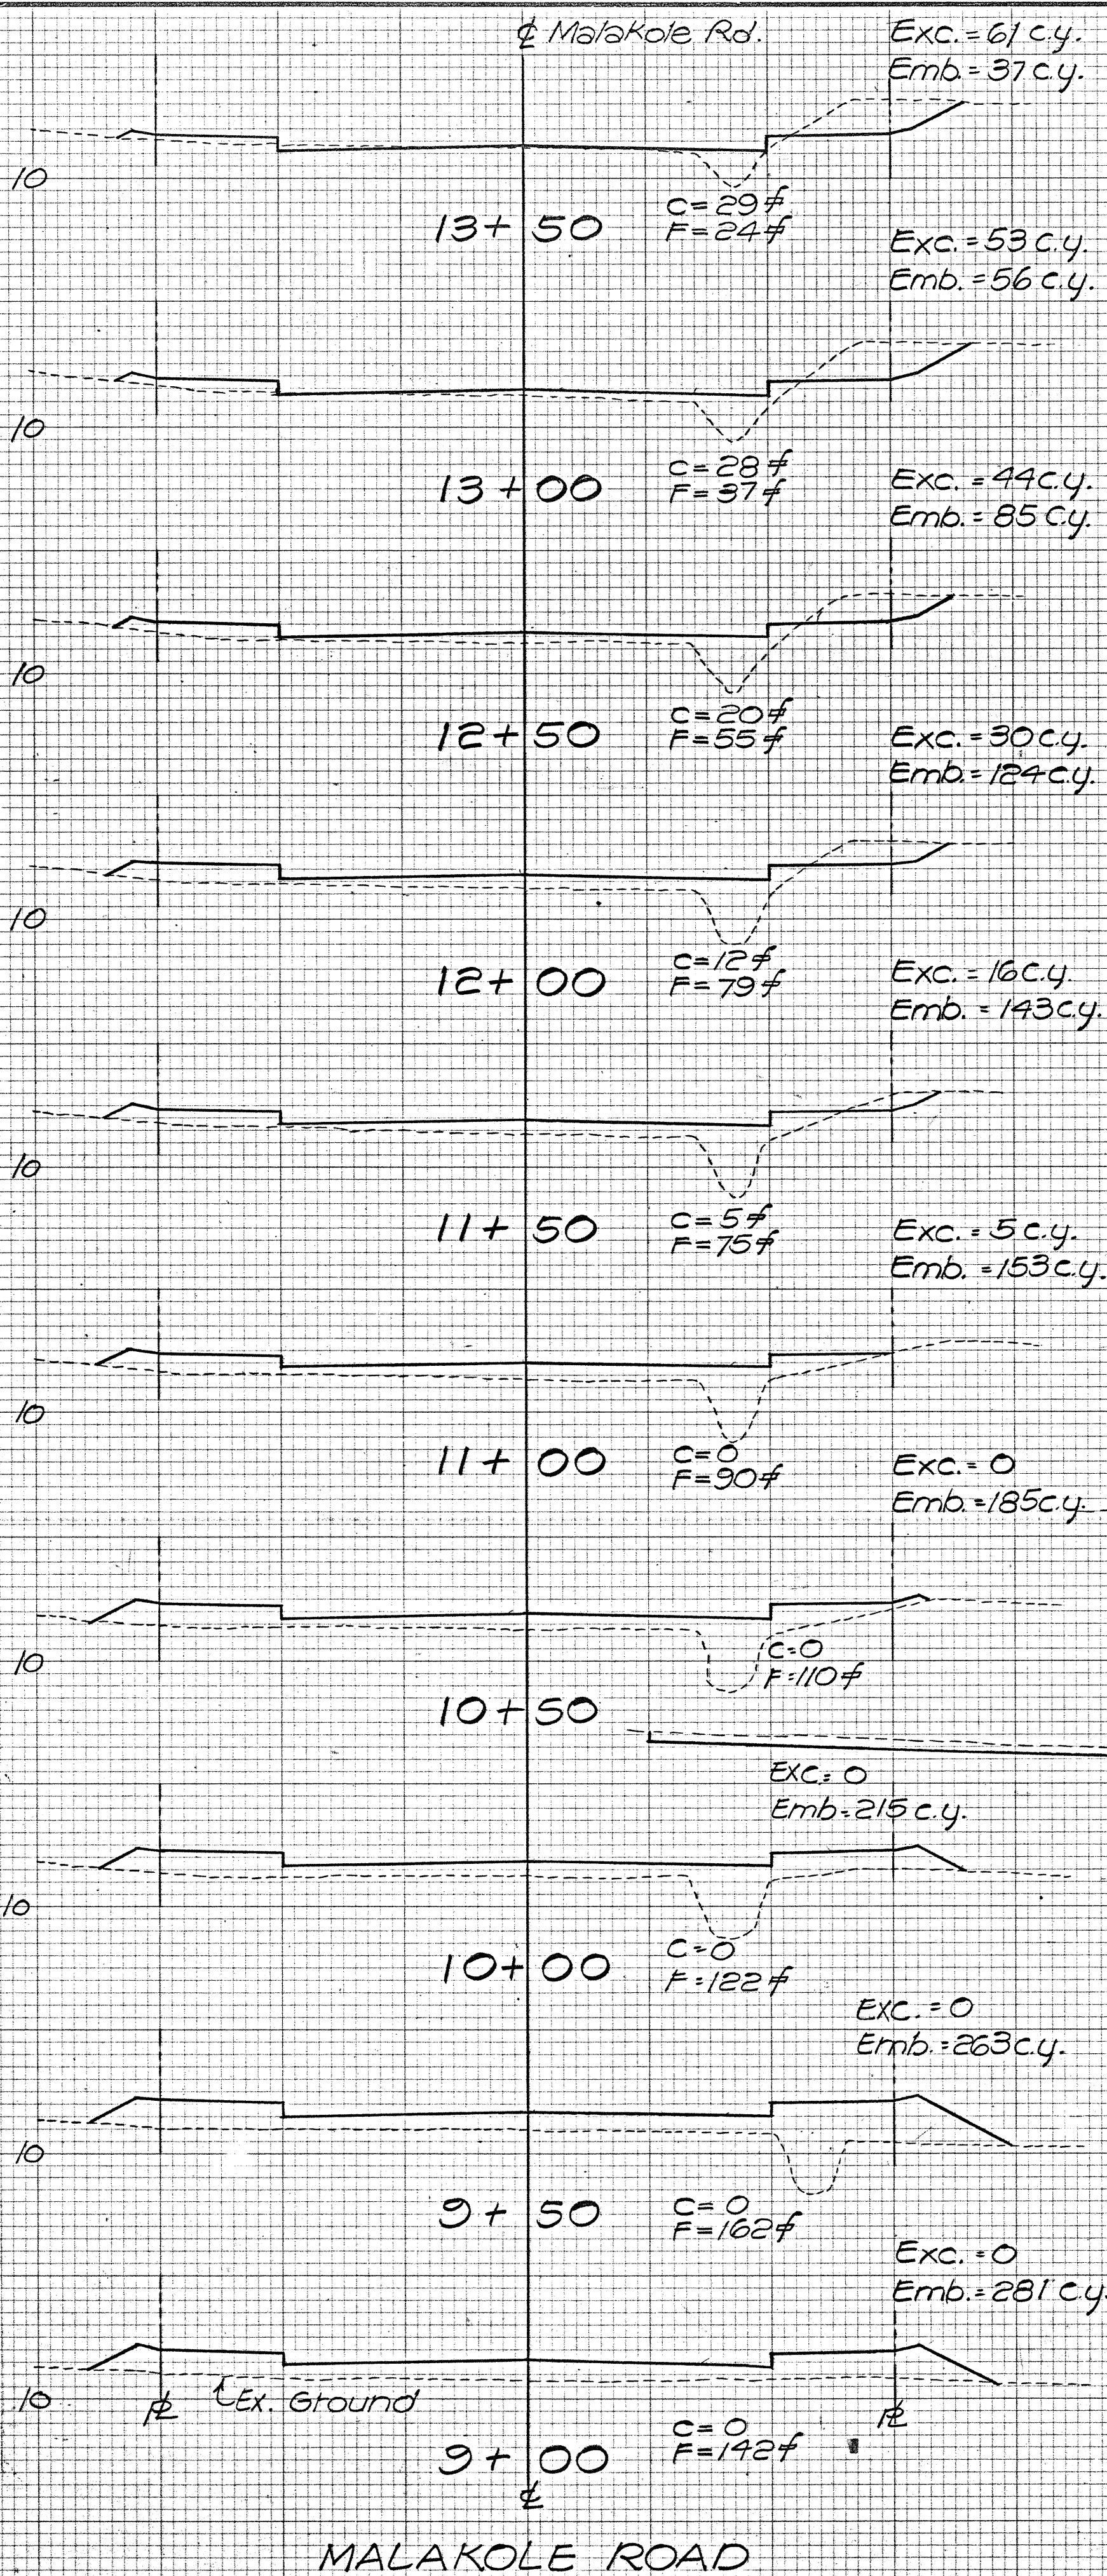
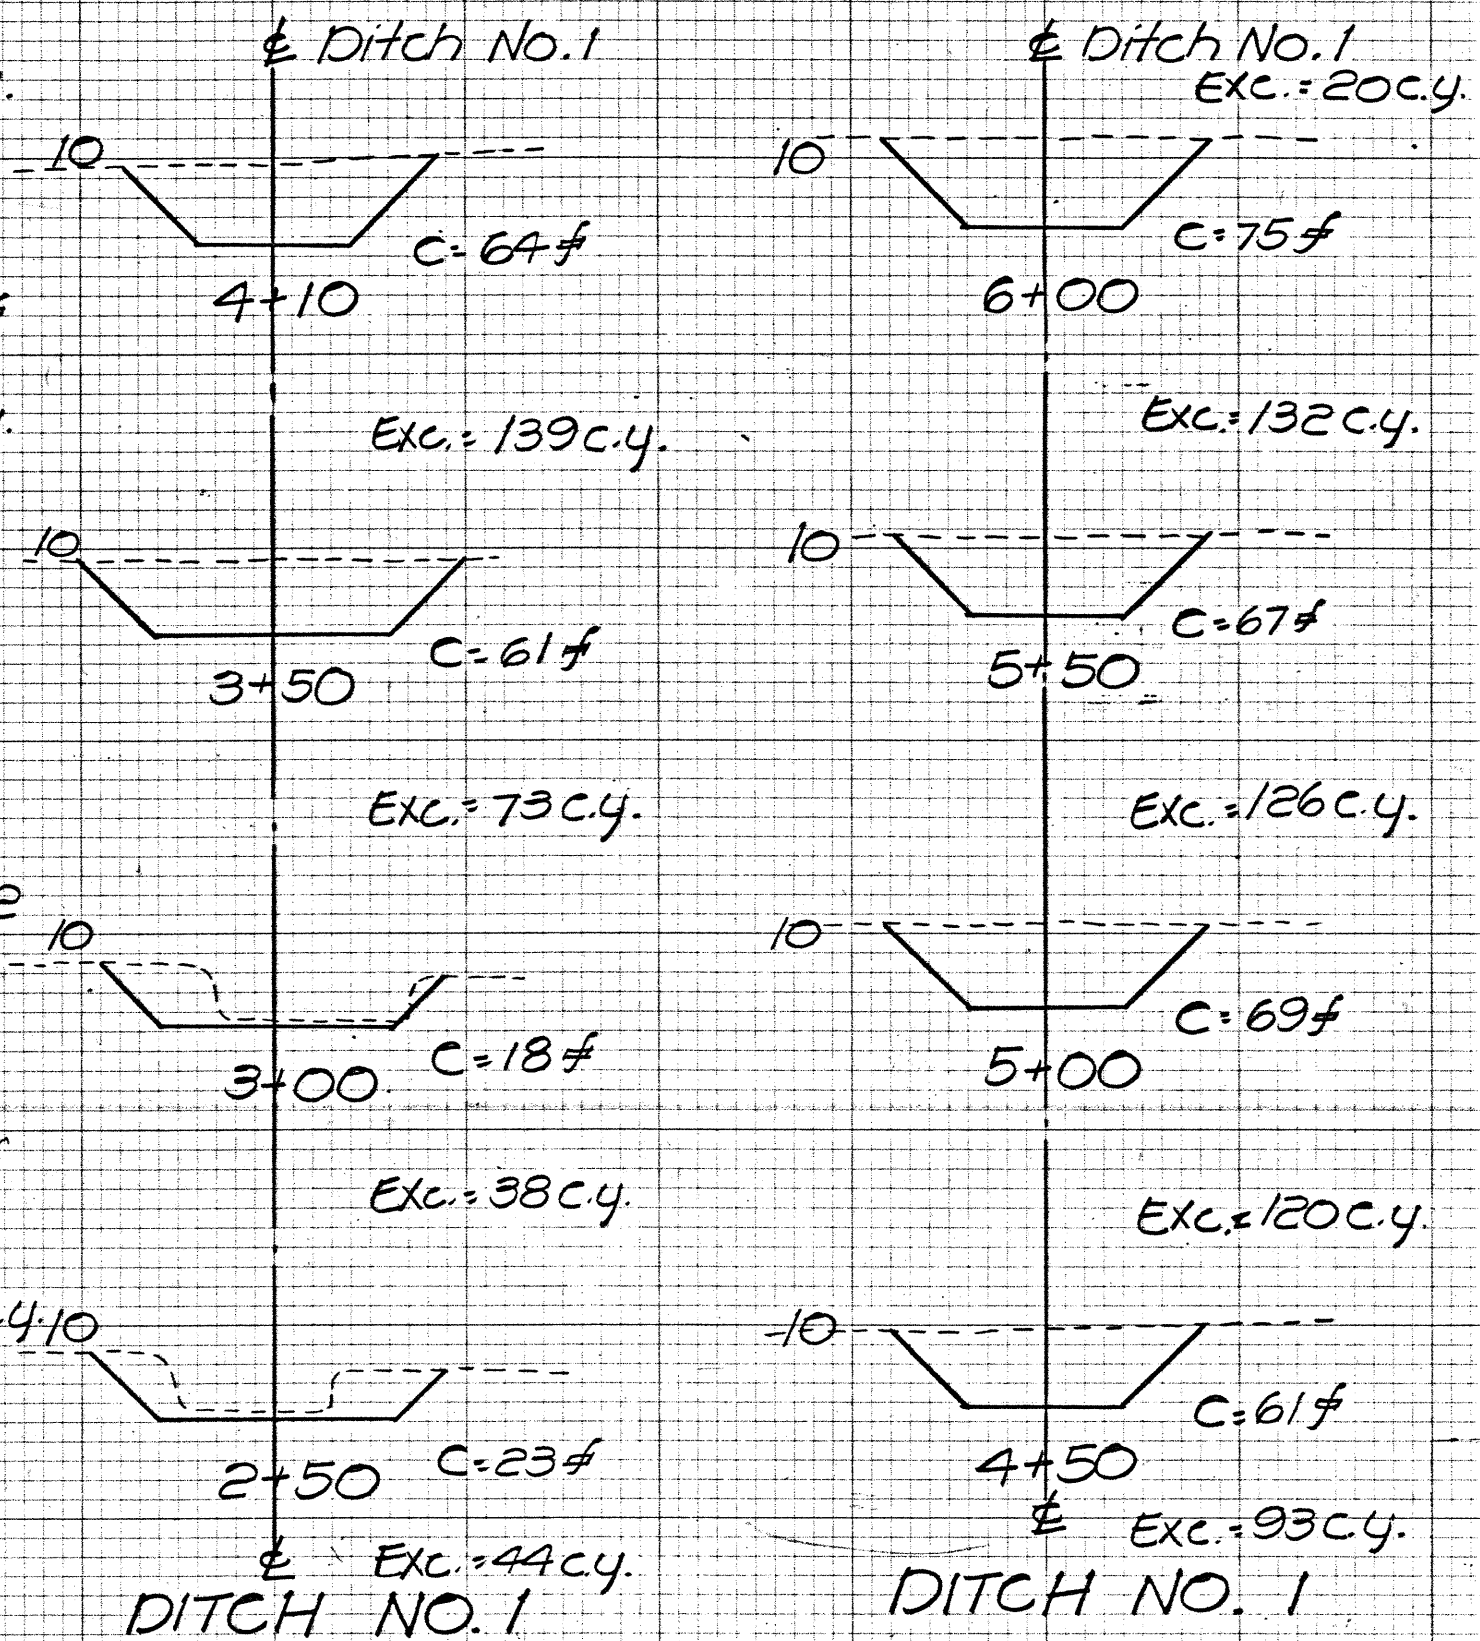


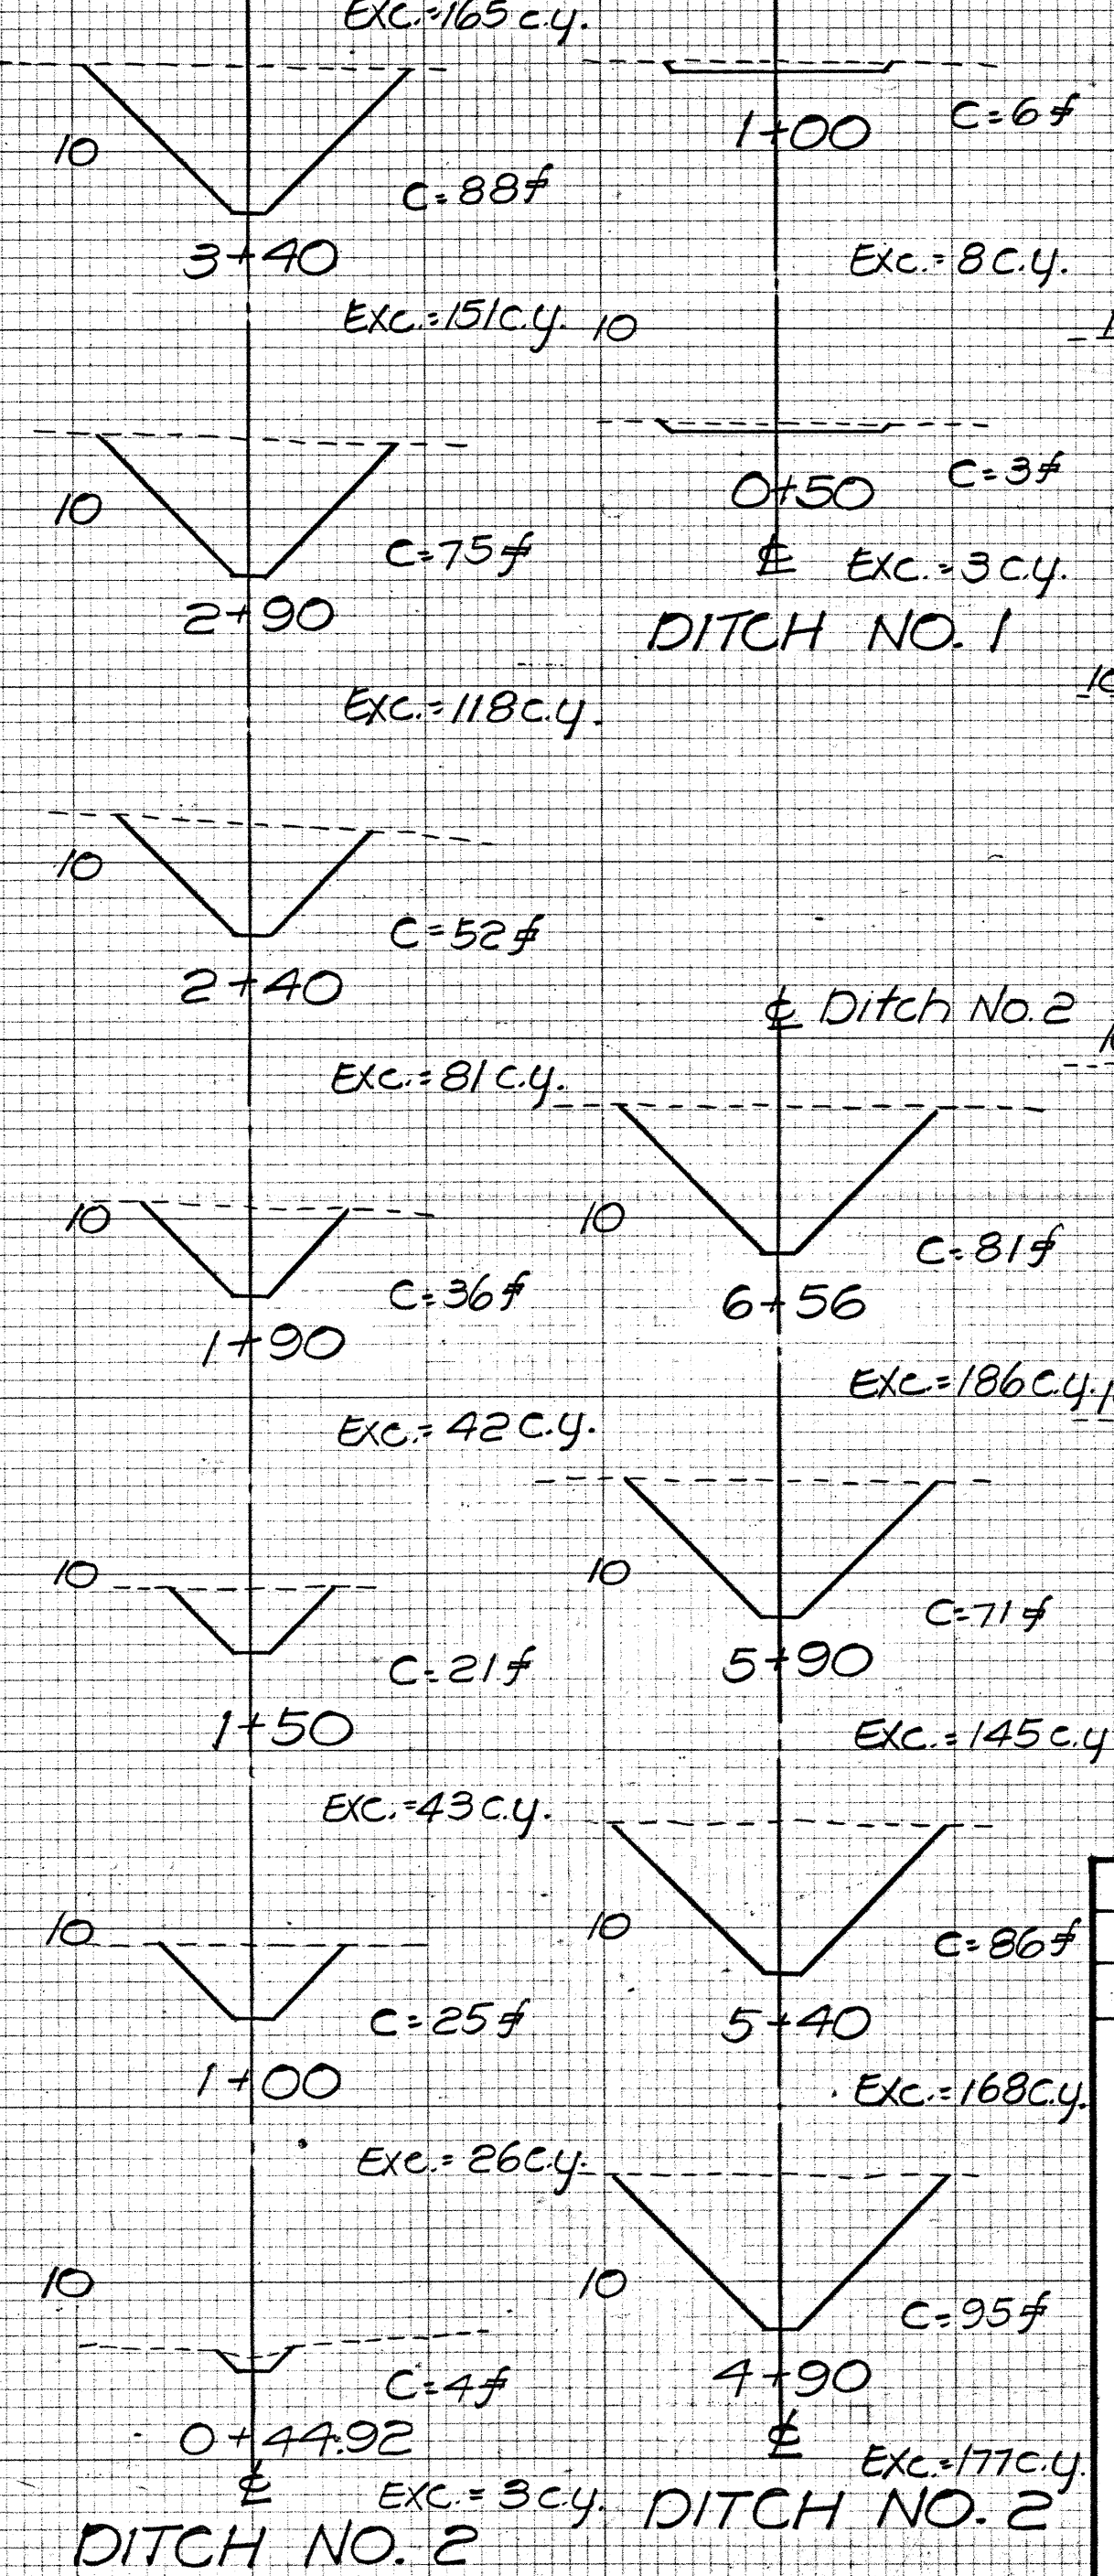

SUMMARY OF EARTHWORK QUANTITIES:		
	Exc.	Emb.
MALAKOLE RD. (Includes filling ditches)	505 c.y.	8005 c.y.
DRAIN LINE NO. 1	30 c.y.	
DRAIN LINE NO. 2	26 c.y.	
DITCH NO. 1	848 c.y.	
DITCH NO. 2	1,477 c.y.	
TOTAL	2,886 c.y.	8,005 c.y.

Approx. Area to be graded = 4.7± acs.

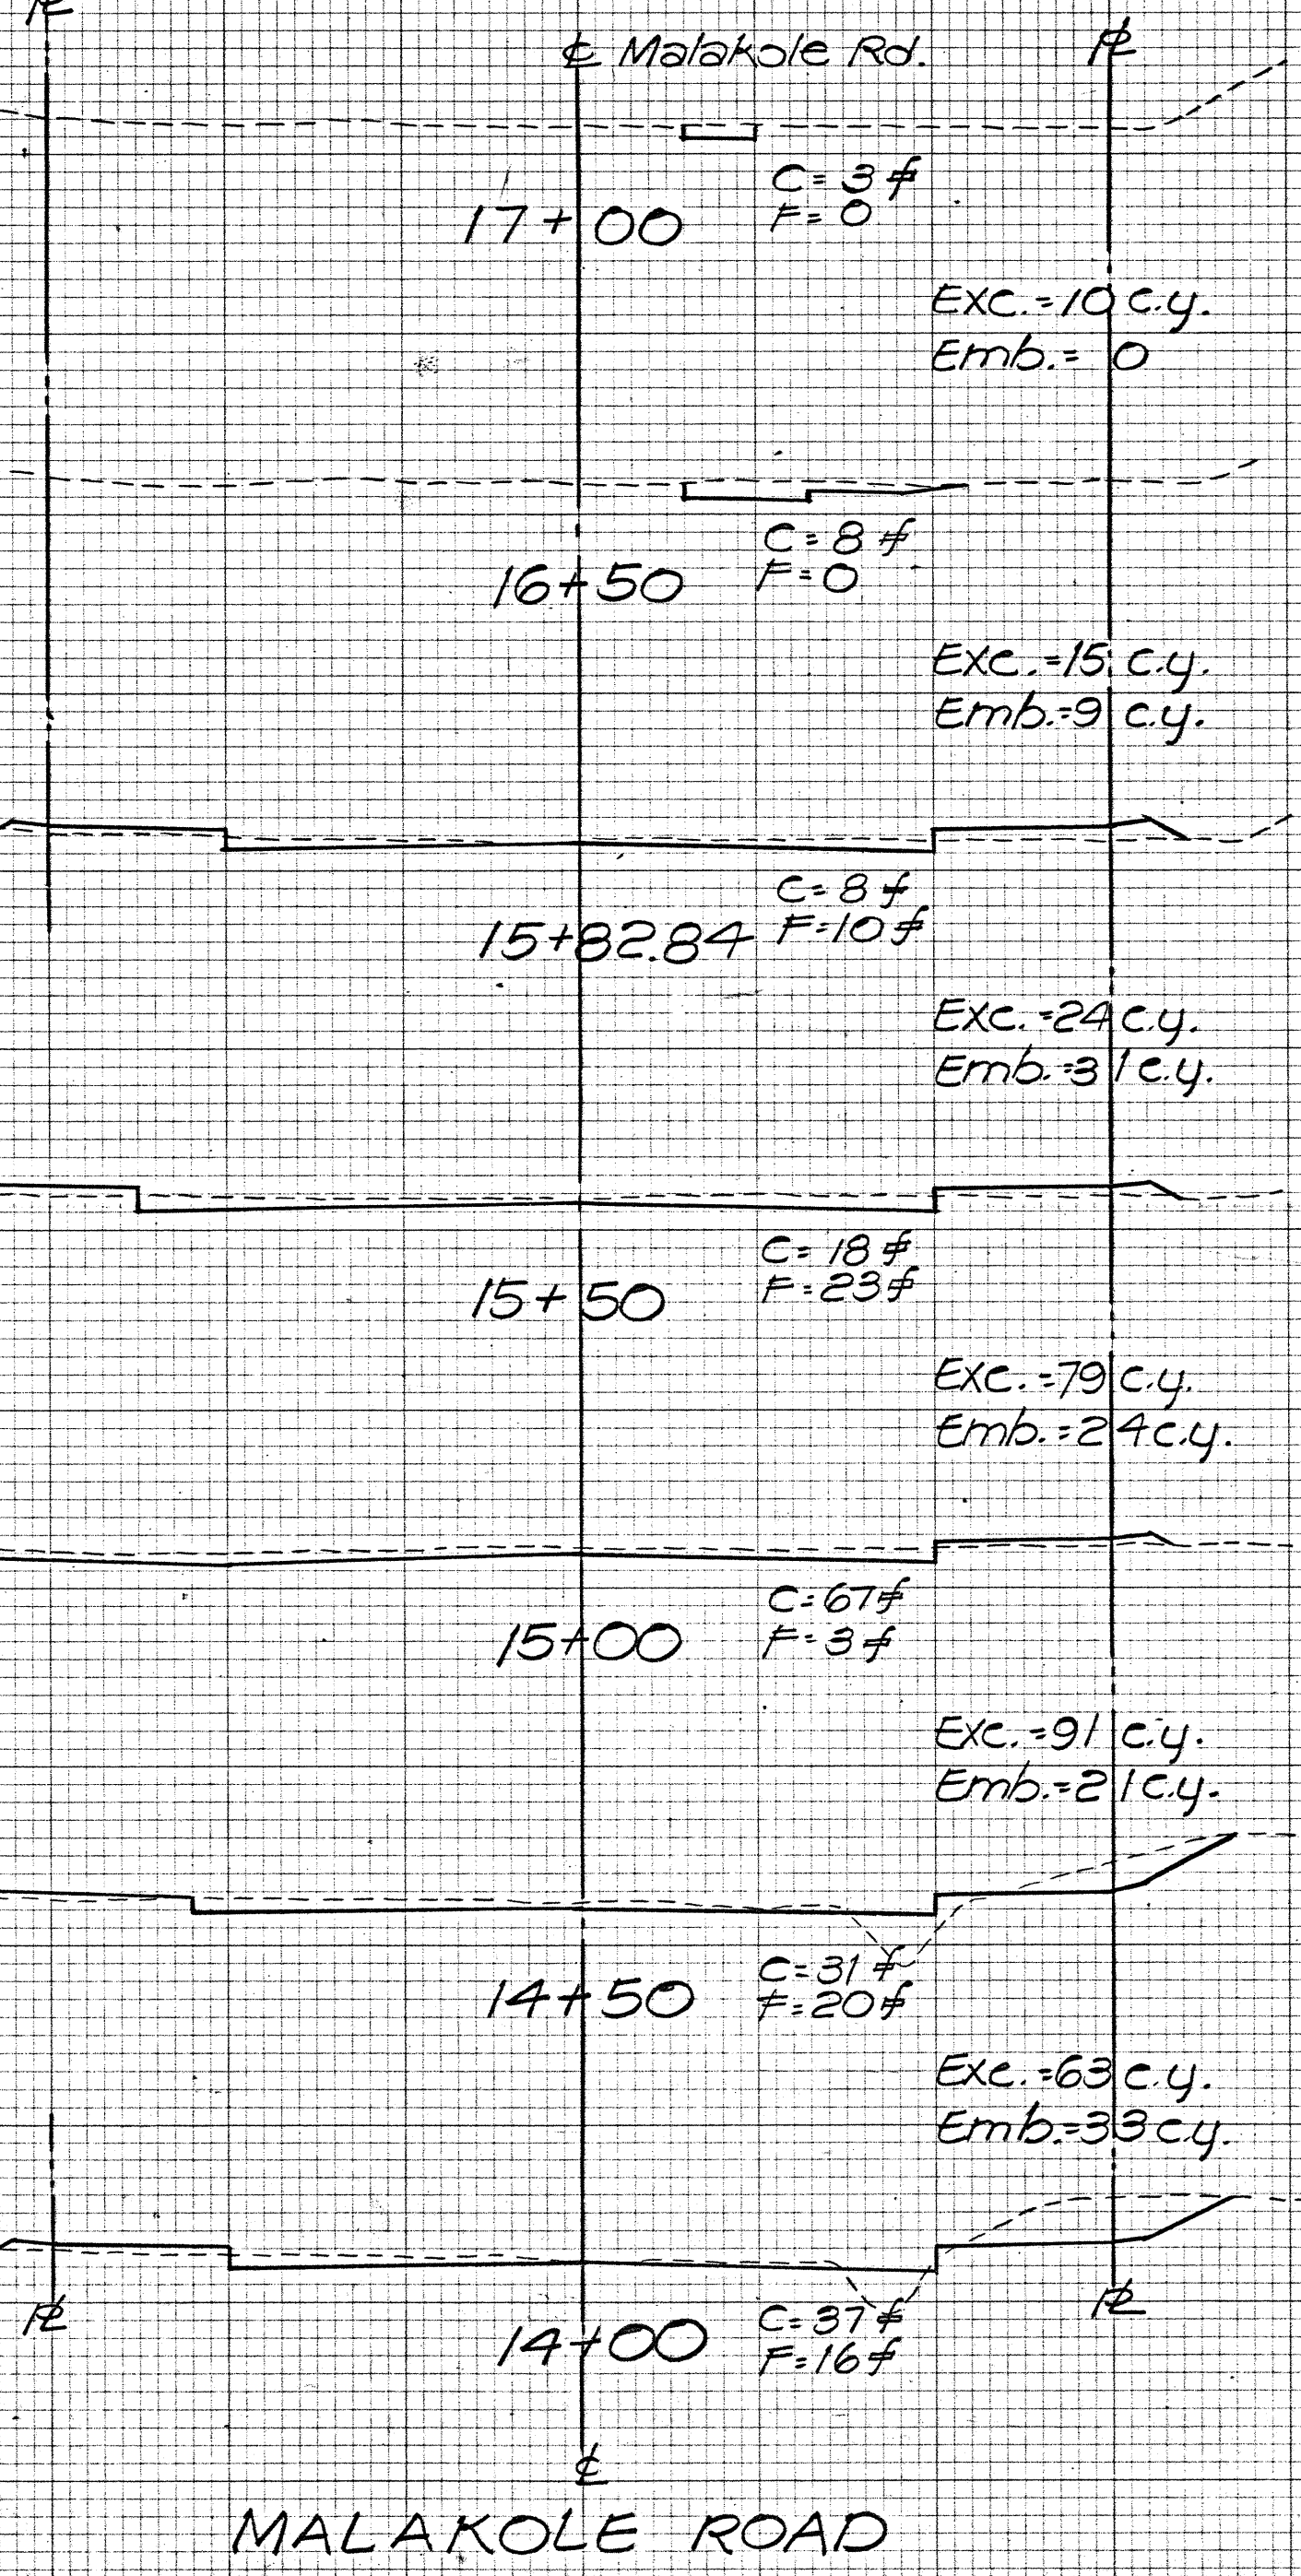

ENGINEER KYS	DRAFTSMAN WC	CHECKED BY ACY
THIS WORK WAS PREPARED BY ME OR UNDER MY SUPERVISION. Signature: <i>Calhoun</i> Date: 3/14/78		
REVISION DATE BRIEF BY APPROVED		
R. M. TOWILL CORPORATION PLANNERS, ENGINEERS, SURVEYORS, PHOTOGRAMMETRISTS 1600 Kapiolani Boulevard Honolulu, Hawaii 96814		
JAMES CAMPBELL INDUSTRIAL PARK MALAKOLE ROAD IMPROVEMENT BETWEEN HANUA ST. & KALAELOA BLVD. AT HONOLULU, EWA, OAHU, HAWAII DEVELOPER: CAMPBELL ESTATE		
CROSS SECTIONS		
AS BUILT SHEET 11 OF 13 SHEETS		