

# JAMES CAMPBELL INDUSTRIAL PARK MALAKOLE ROAD IMPROVEMENT BETWEEN HANUA ST. & KALAELOA BLVD. HONOLULI, EWA, OAHU, HAWAII


CAMPBELL ESTATE - DEVELOPER

**AS BUILT TRACINGS**

CERTIFIED BY: *Walter P. Thompson* DATE 6/1/79  
APPROVED BY: *William C. Bishop* DATE 9-25-79

PREPARED BY: *A*  
**R. M. TOWILL CORPORATION**  
PLANNERS, ENGINEERS, SURVEYORS, PHOTOGRAMMETRISTS

NOTE:  
As Built Elevations Surveyed by Walter P. Thompson, Inc. as indicated with an asterisk (\*).

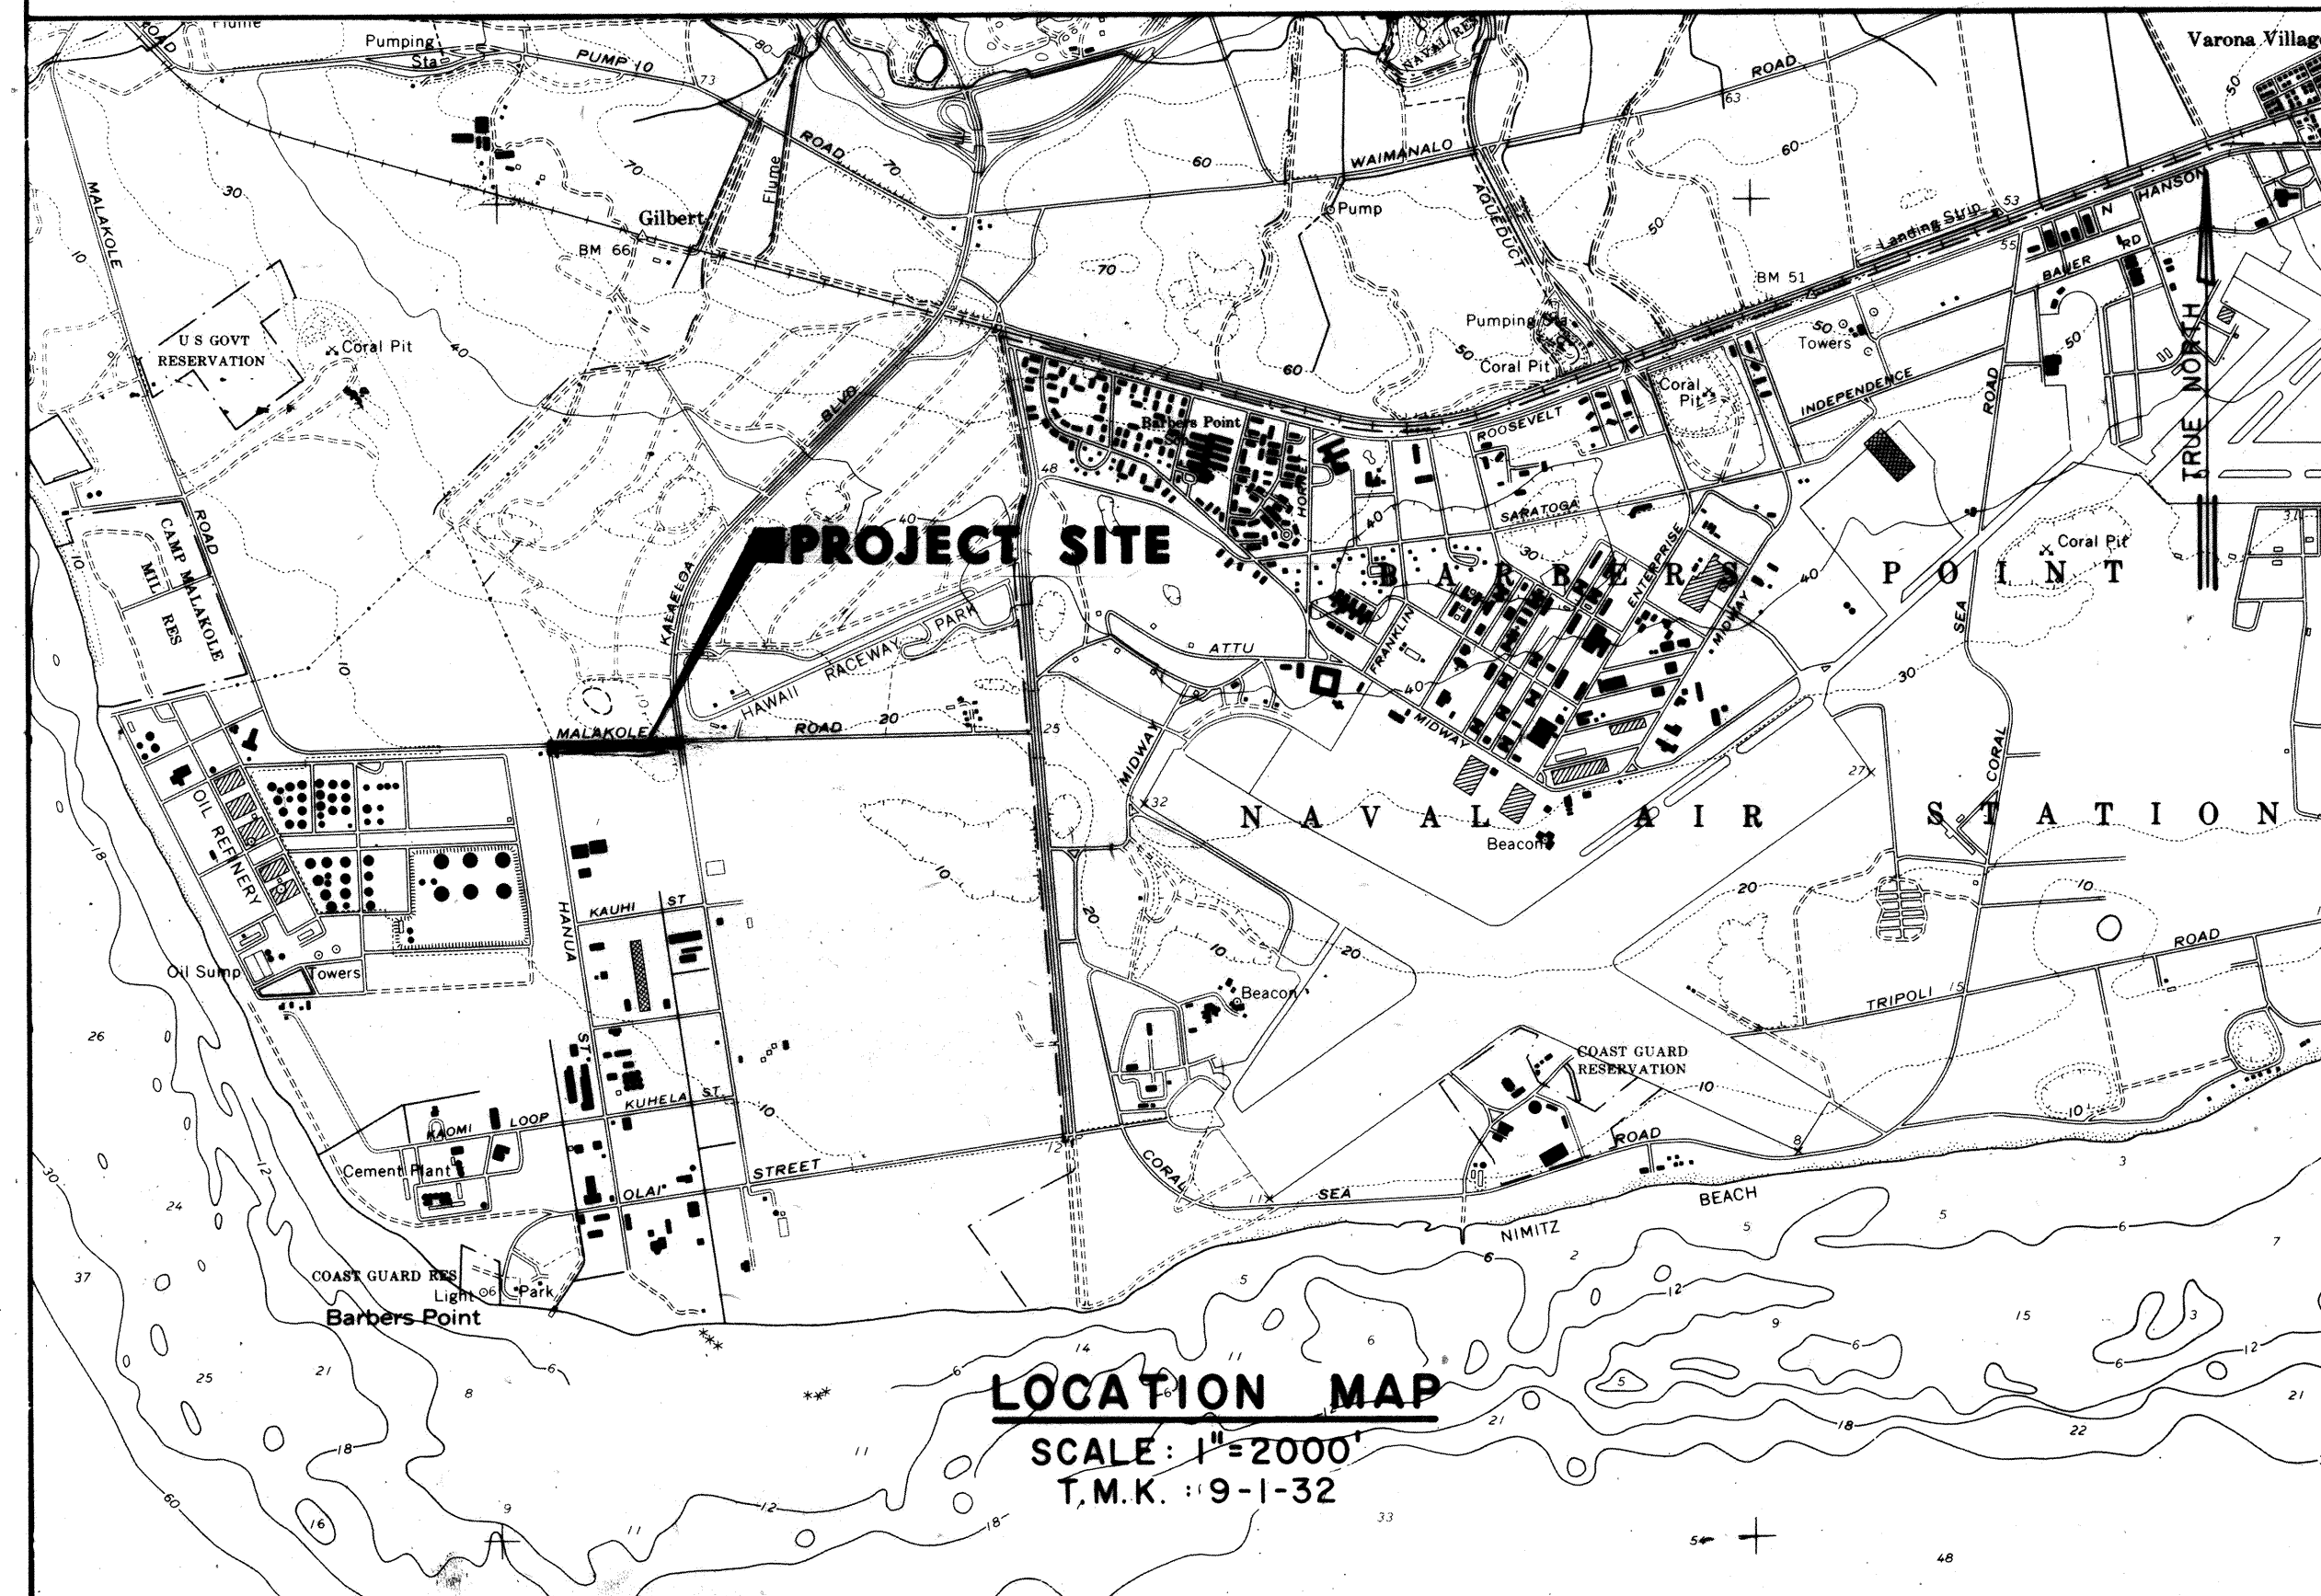

## INDEX

| DESCRIPTION                                             | SHEET NO.  |
|---------------------------------------------------------|------------|
| TITLE SHEET                                             | 1          |
| NOTES & TYPICAL ROAD SECTIONS                           | 2          |
| GENERAL PLAN                                            | 3          |
| PLAN & PROFILE - MALAKOLE RD. - STA. 0+00 TO STA. 9+00. | 4          |
| MALAKOLE RD. STA. 9+00 TO STA. 17+30.                   | 5          |
| DITCH NO. 1 & DRAIN LINE NO. 1                          | 6          |
| DITCH NO. 2 & DRAIN LINES NO. 2, 3, & 4.                | 7          |
| SIGN & PAVEMENT MARKING PLAN.                           | 8          |
| DRAINAGE & MISCELLANEOUS DETAILS.                       | 9          |
| CROSS SECTIONS.                                         | 10         |
| CROSS SECTIONS.                                         | 11         |
| GENERAL LIGHTING & SHEET LAYOUT PLAN.                   | 12 OMITTED |
| SECTIONS "A" & "B" - ELECTRICAL PLANS                   | 13 OMITTED |

## APPROVED:

|                                                                                             |                 |
|---------------------------------------------------------------------------------------------|-----------------|
| <i>Walter P. Thompson</i><br>TRUSTEE, ESTATE OF JAMES CAMPBELL                              | DATE<br>4-27-78 |
| <i>Fred E. Trotter</i><br>TRUSTEE, ESTATE OF JAMES CAMPBELL                                 | DATE<br>4/27/78 |
| <i>William C. Bishop</i><br>TRUSTEE, ESTATE OF JAMES CAMPBELL                               | DATE<br>3-21-78 |
| <i>Walter P. Thompson</i><br>TRUSTEE, ESTATE OF JAMES CAMPBELL                              | DATE<br>3/14/78 |
| <i>James W. Bishop</i><br>DIRECTOR, DEPARTMENT OF LAND UTILIZATION                          | DATE<br>1/4/78  |
| <i>Wallace Meyerson</i><br>DIRECTOR & CHIEF ENGINEER, DEPARTMENT OF PUBLIC WORKS            | DATE<br>2/1/78  |
| <i>Edward H. Bishop</i><br>MANAGER & CHIEF ENGINEER, BOARD OF WATER SUPPLY                  | DATE<br>8/22/77 |
| <i>Leslie H. Bishop</i><br>DIRECTOR, DEPARTMENT OF TRANSPORTATION SERVICES                  | DATE            |
| <i>John L. Bishop</i><br>CHIEF, STATE ENVIRONMENTAL PROTECTION AND HEALTH SERVICES DIVISION | DATE            |