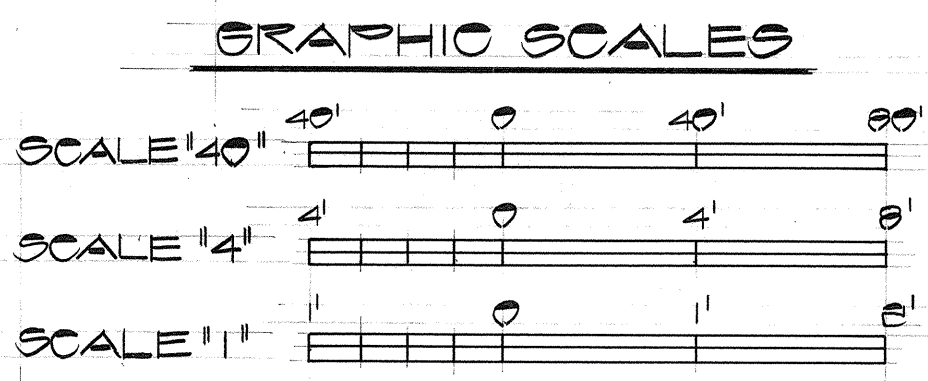
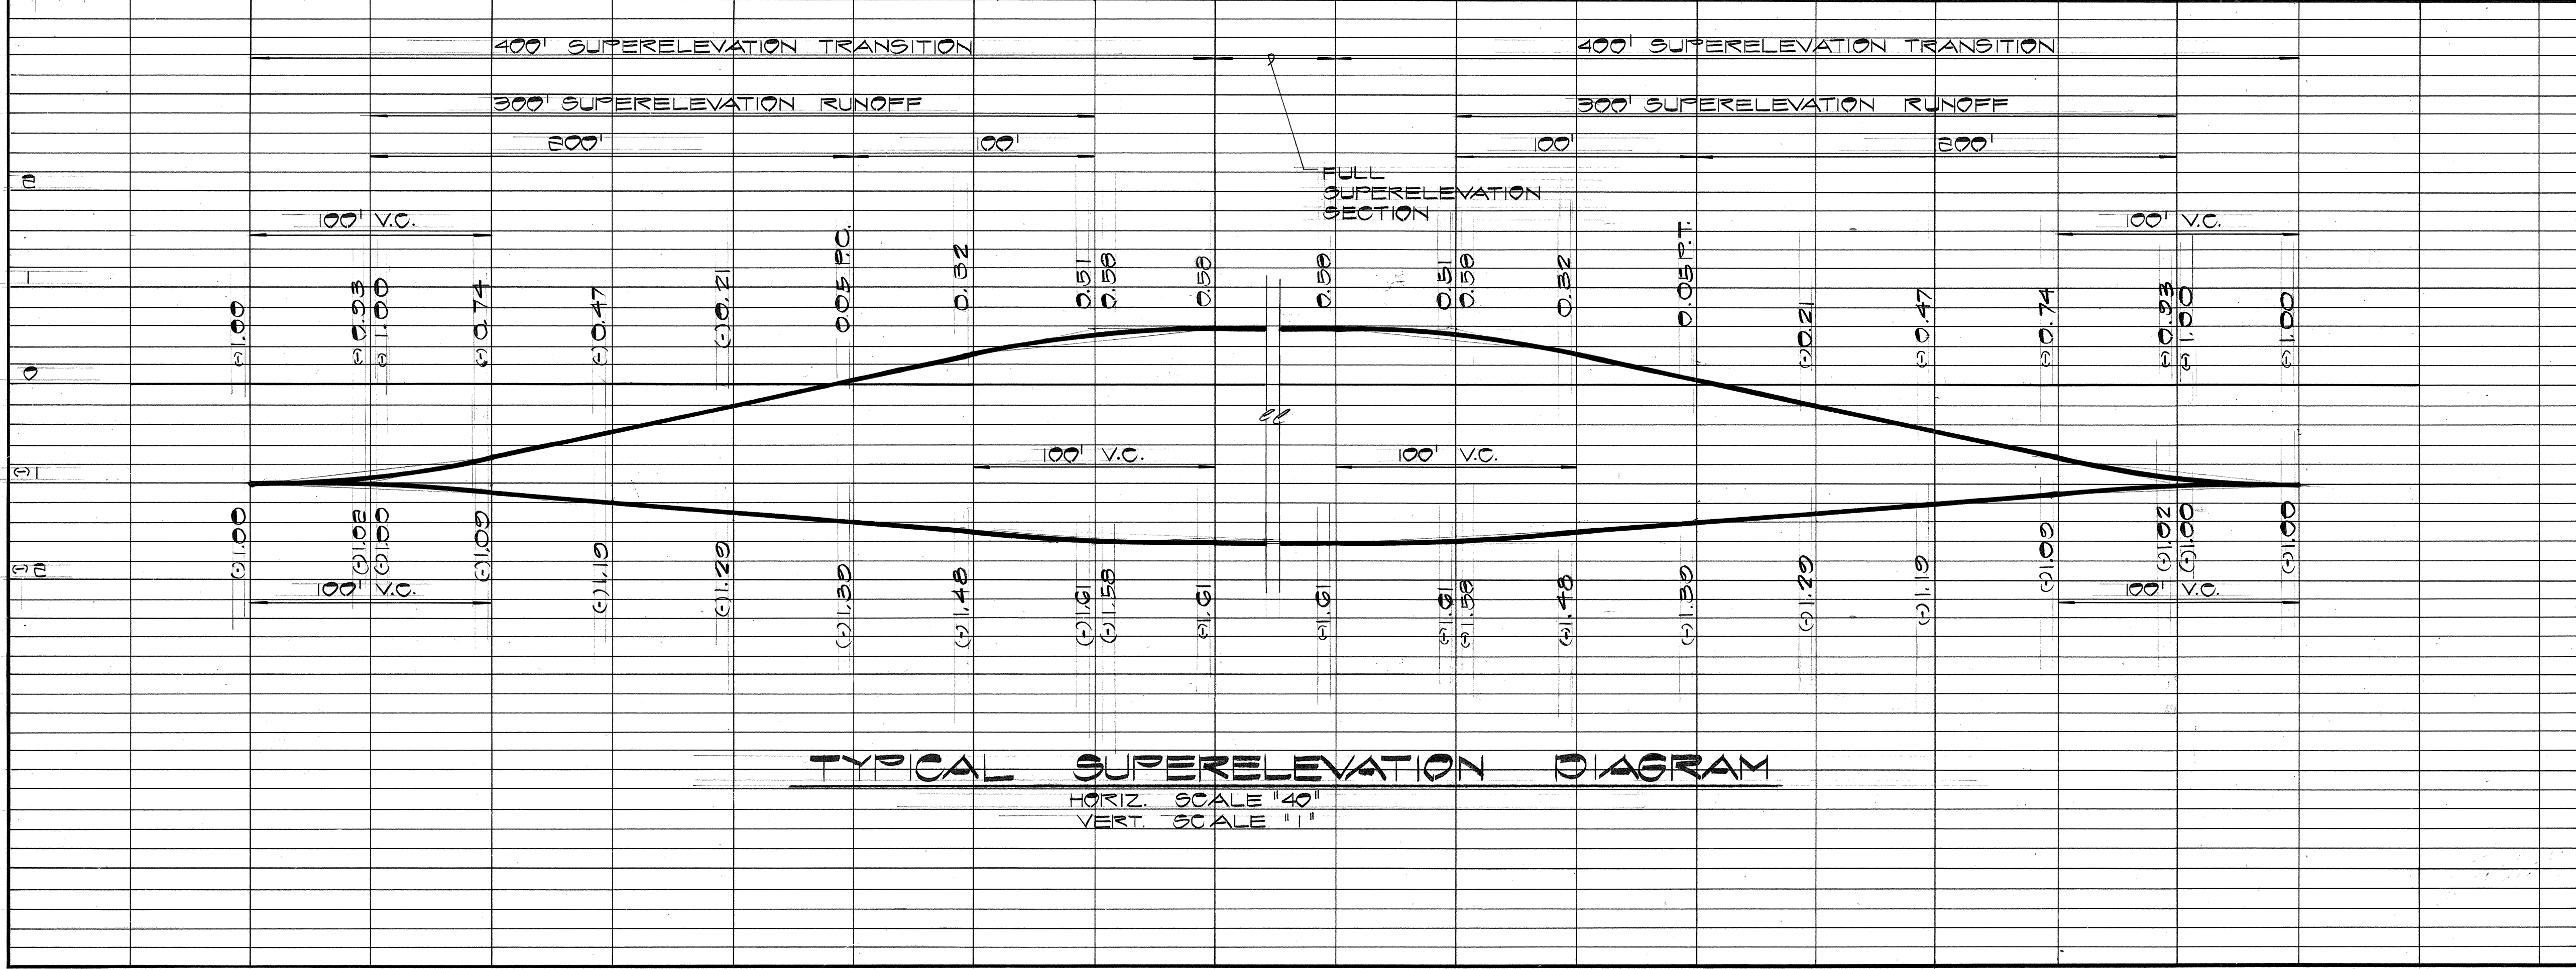
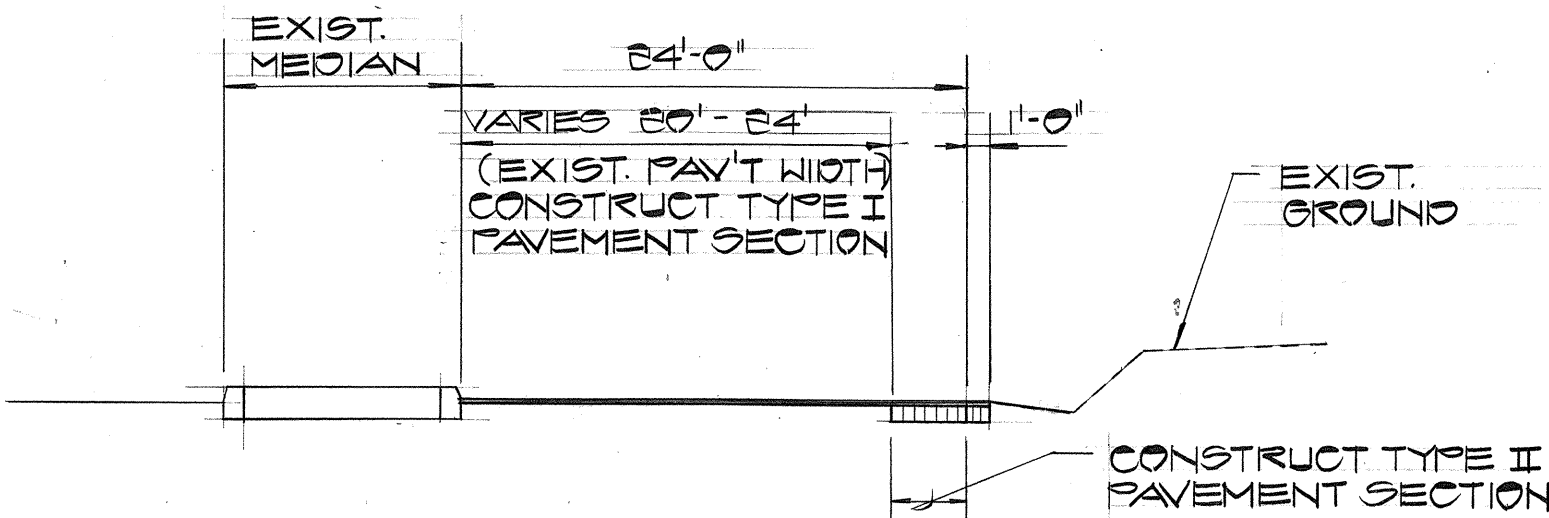
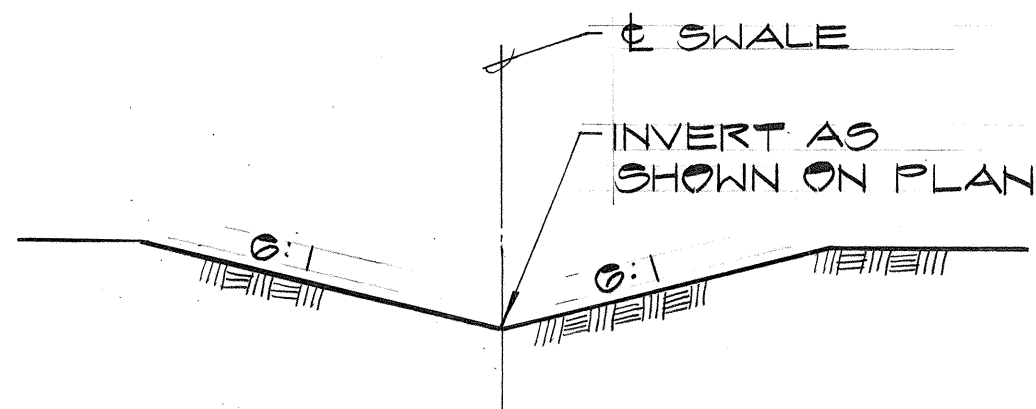
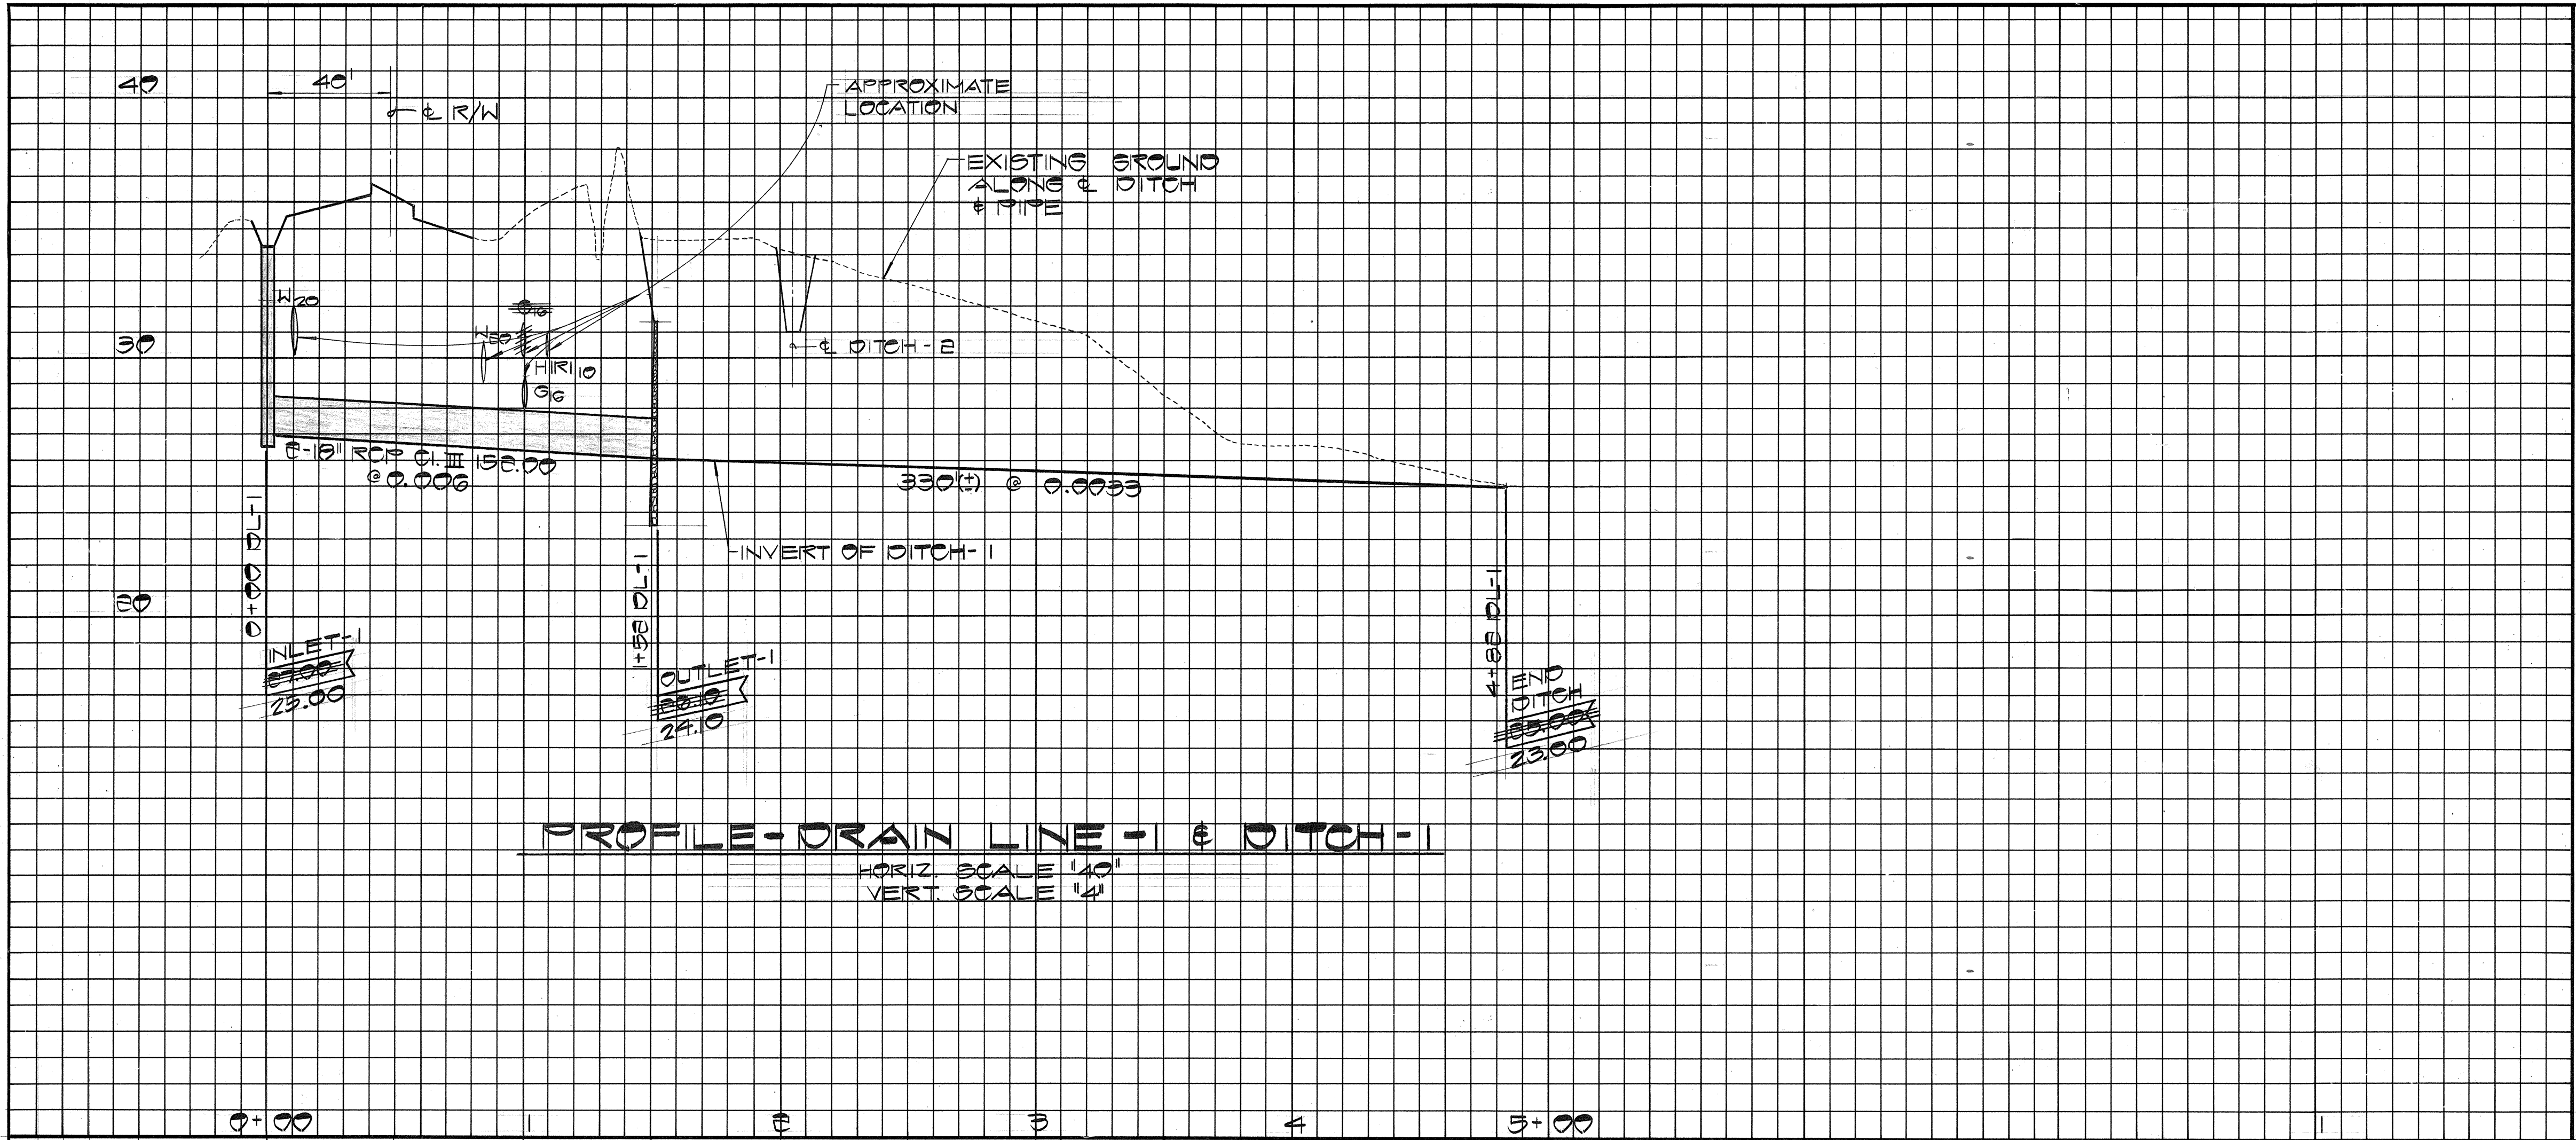


REVISION	DATE	BRIEF	BY	APPR'D

EDP HAWAII INC.
Consulting Engineers

TRUSTEES OF
THE ESTATE OF JAMES CAMPBELL
HONOLULU, HAWAII

KALAELOA BOULEVARD IMPROVEMENTS
HONOLULU, EWA, OAHU, HAWAII

MISCELLANEOUS DETAILS

DRAWN BY: HH ENGINEER: KT

APPROVED BY: *[Signature]* DATE: 4-27-83
FOR: *[Signature]* DATE: 4-27-83
Subject: Planning & Engineering B.W.S. DATE: 4-27-83