






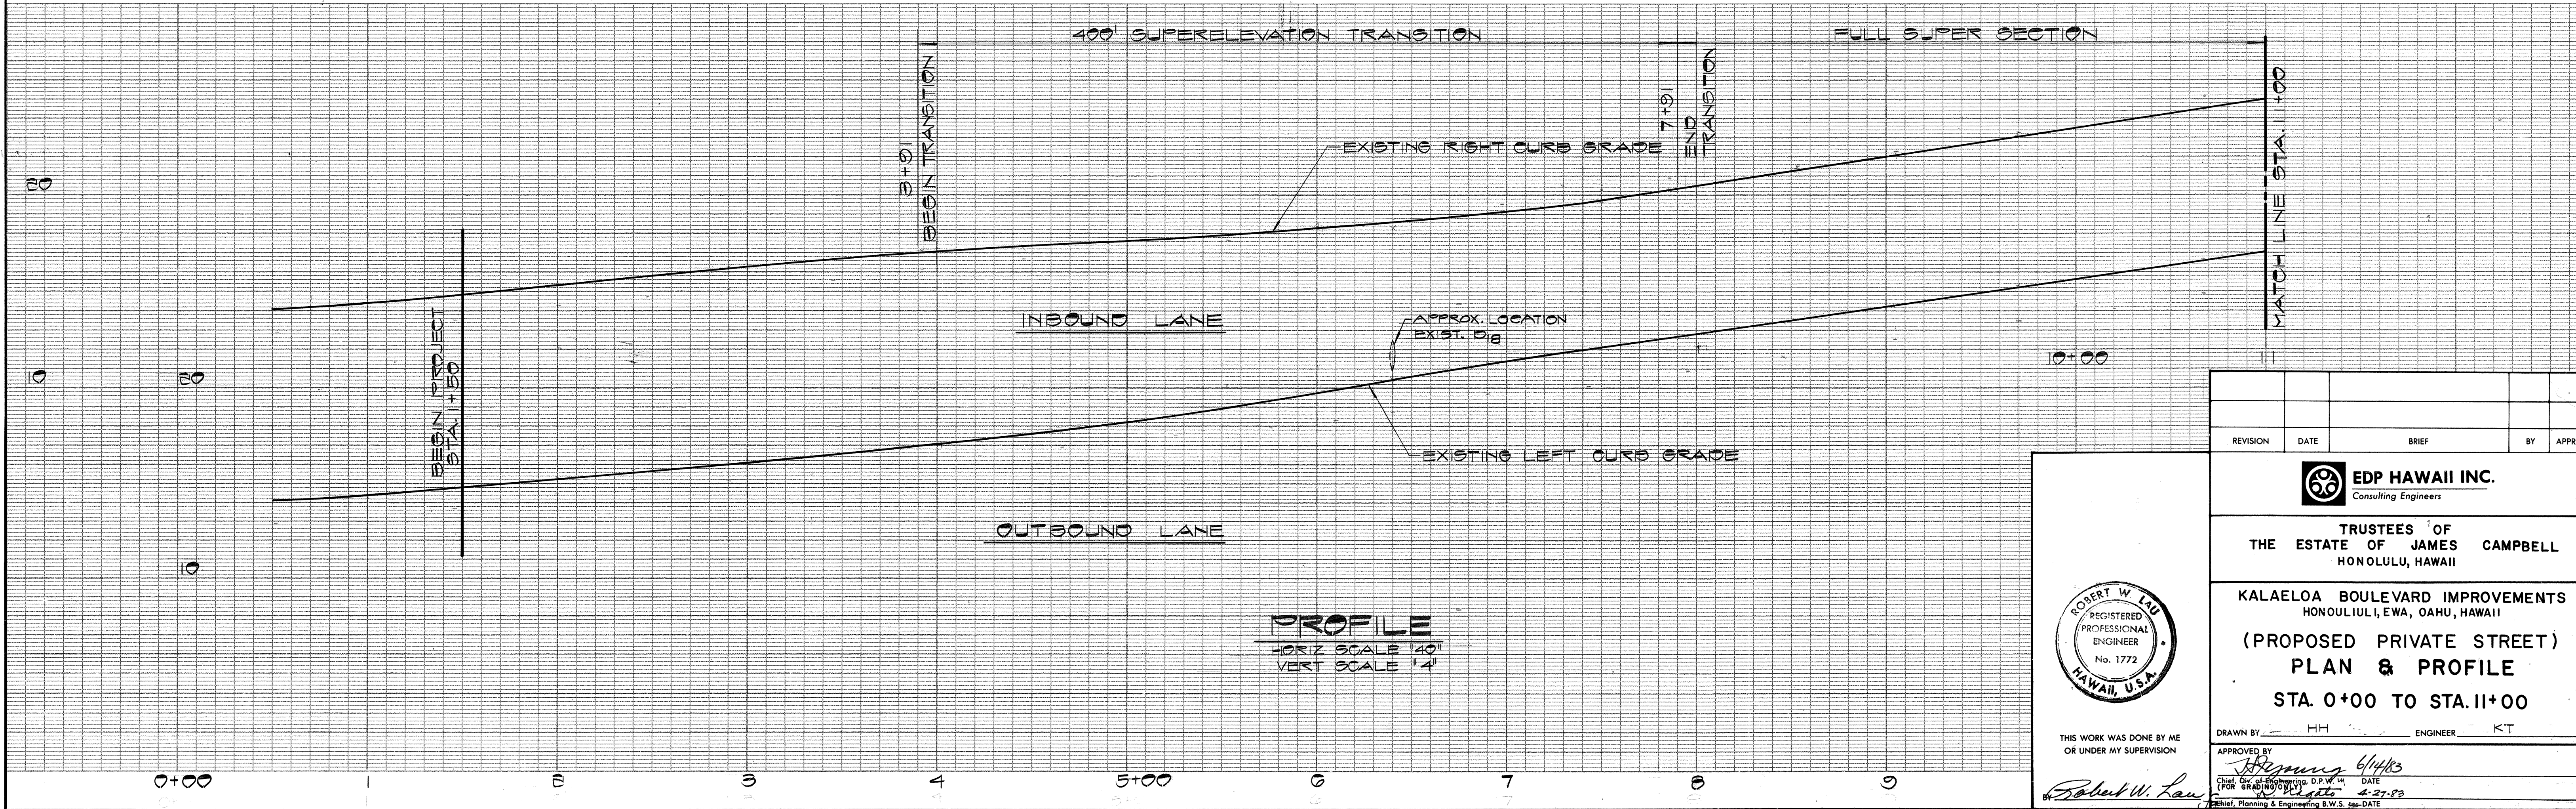


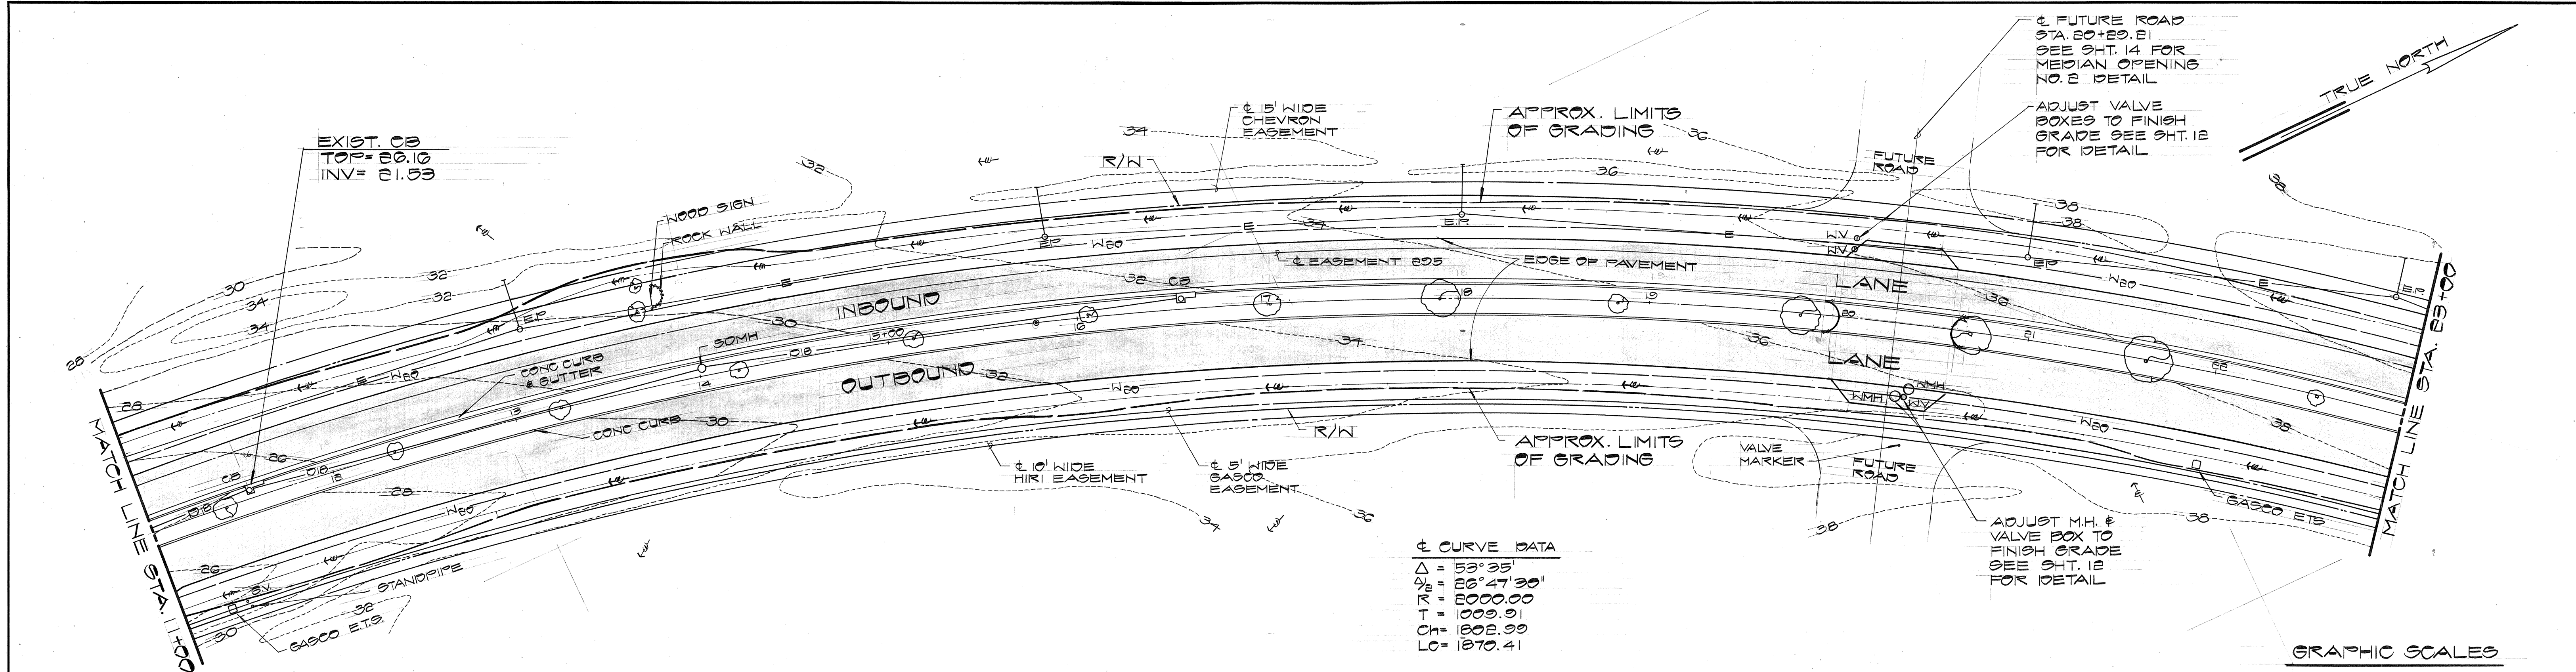

△ CURVE DATA  
 $\Delta = 53^\circ 35'$   
 $\Delta_b = 26^\circ 47' 30''$   
 $R = 2000.00$   
 $T = 1009.91$   
 $Ch = 1802.99$   
 $LO = 1870.41$

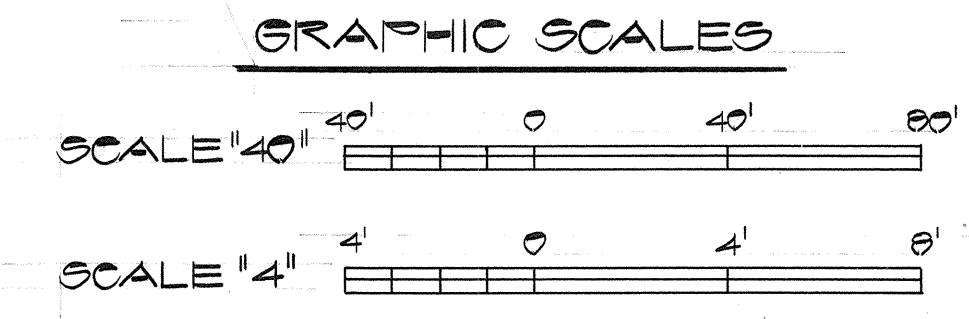

PLAN - KALAELOA BLVD.  
 SCALE "40"

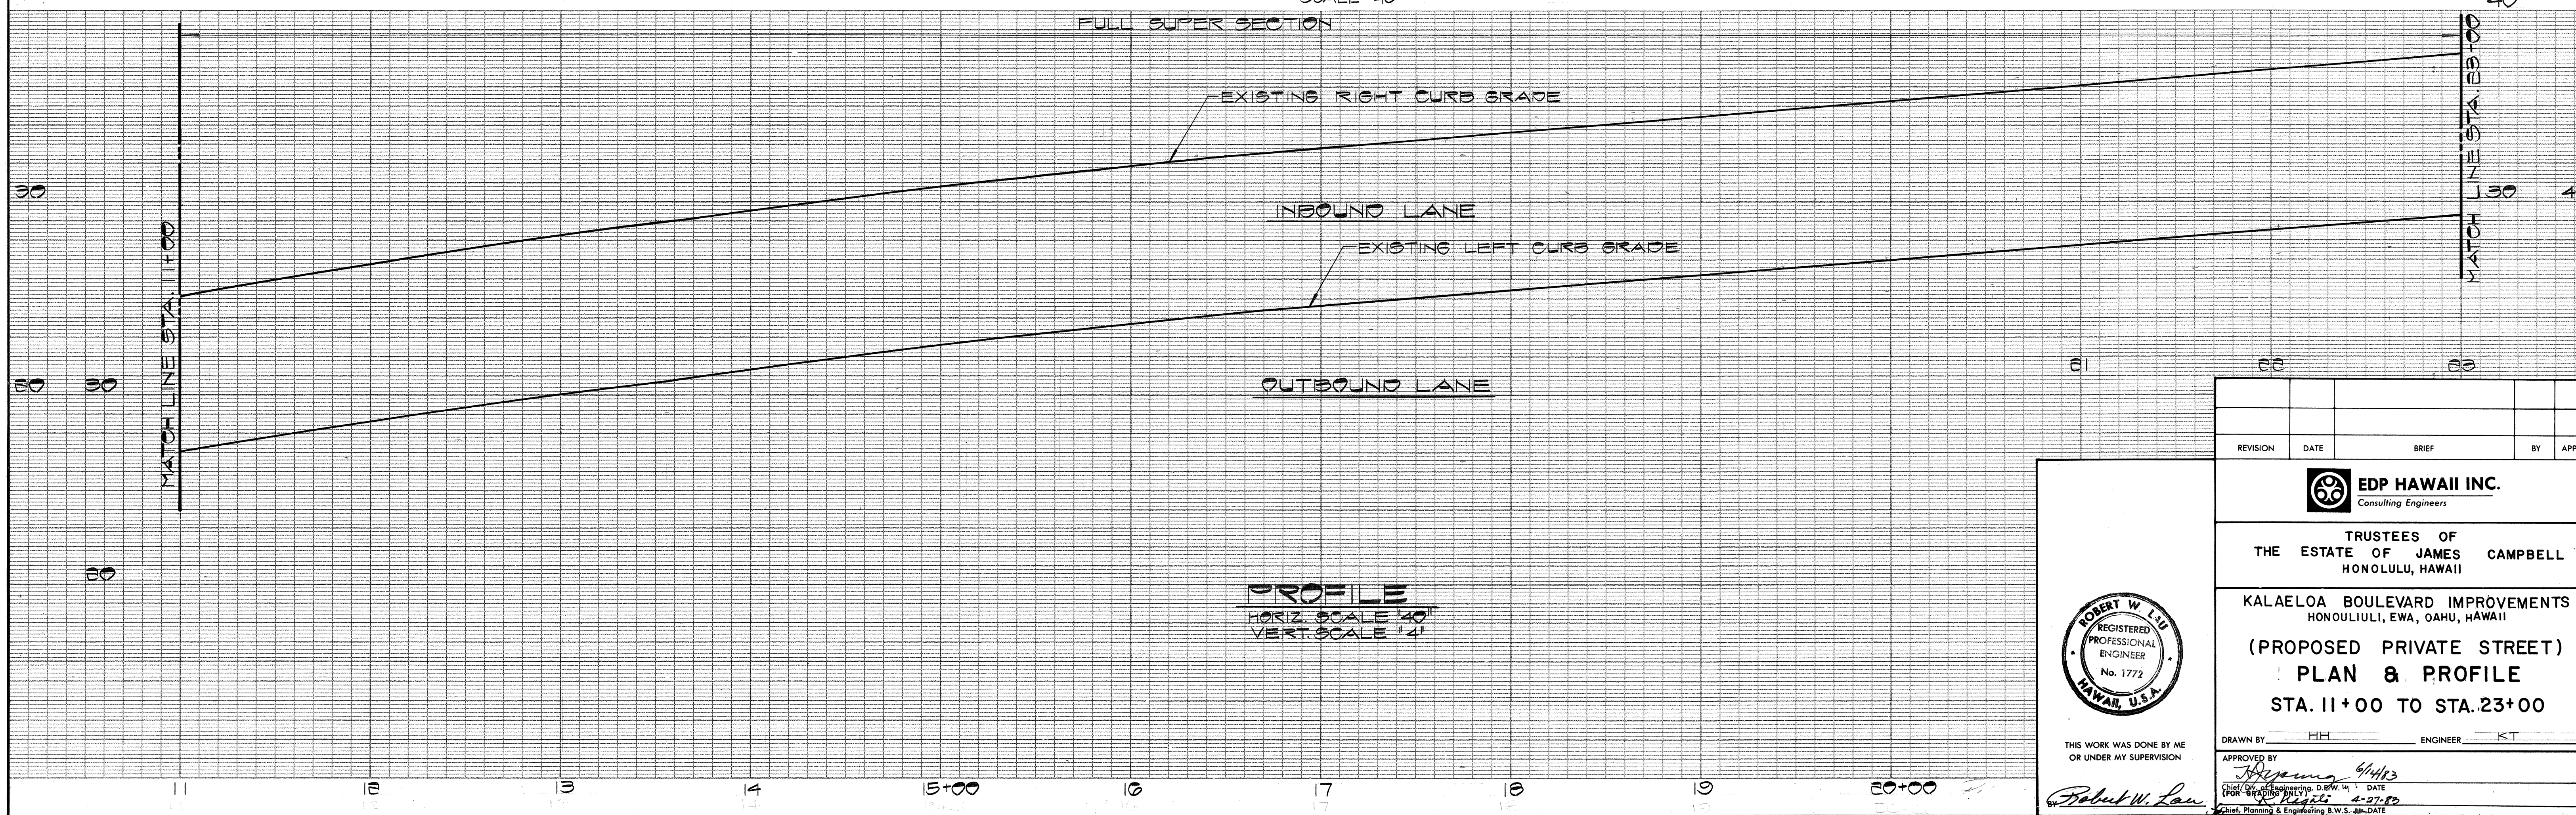

| REVISION | DATE | BRIEF | BY | APPR'D |
|----------|------|-------|----|--------|
|          |      |       |    |        |




TRUSTEES OF  
 THE ESTATE OF JAMES CAMPBELL  
 HONOLULU, HAWAII

KALAELOA BOULEVARD IMPROVEMENTS  
 HONOLULU, EWA, OAHU, HAWAII

(PROPOSED PRIVATE STREET)  
 PLAN & PROFILE  
 STA. 11+00 TO STA. 23+00

DRAWN BY HH ENGINEER KT


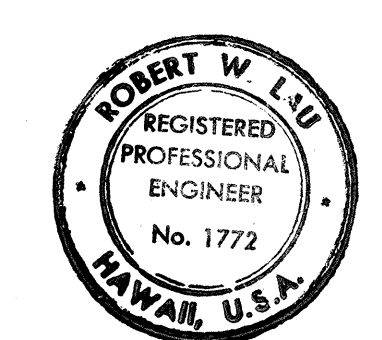


THIS WORK WAS DONE BY ME  
 OR UNDER MY SUPERVISION


Robert W. Lau

APPROVED BY  
 DATE  
 4-27-82  
 Chief, Planning & Engineering B.W.S. - DATE



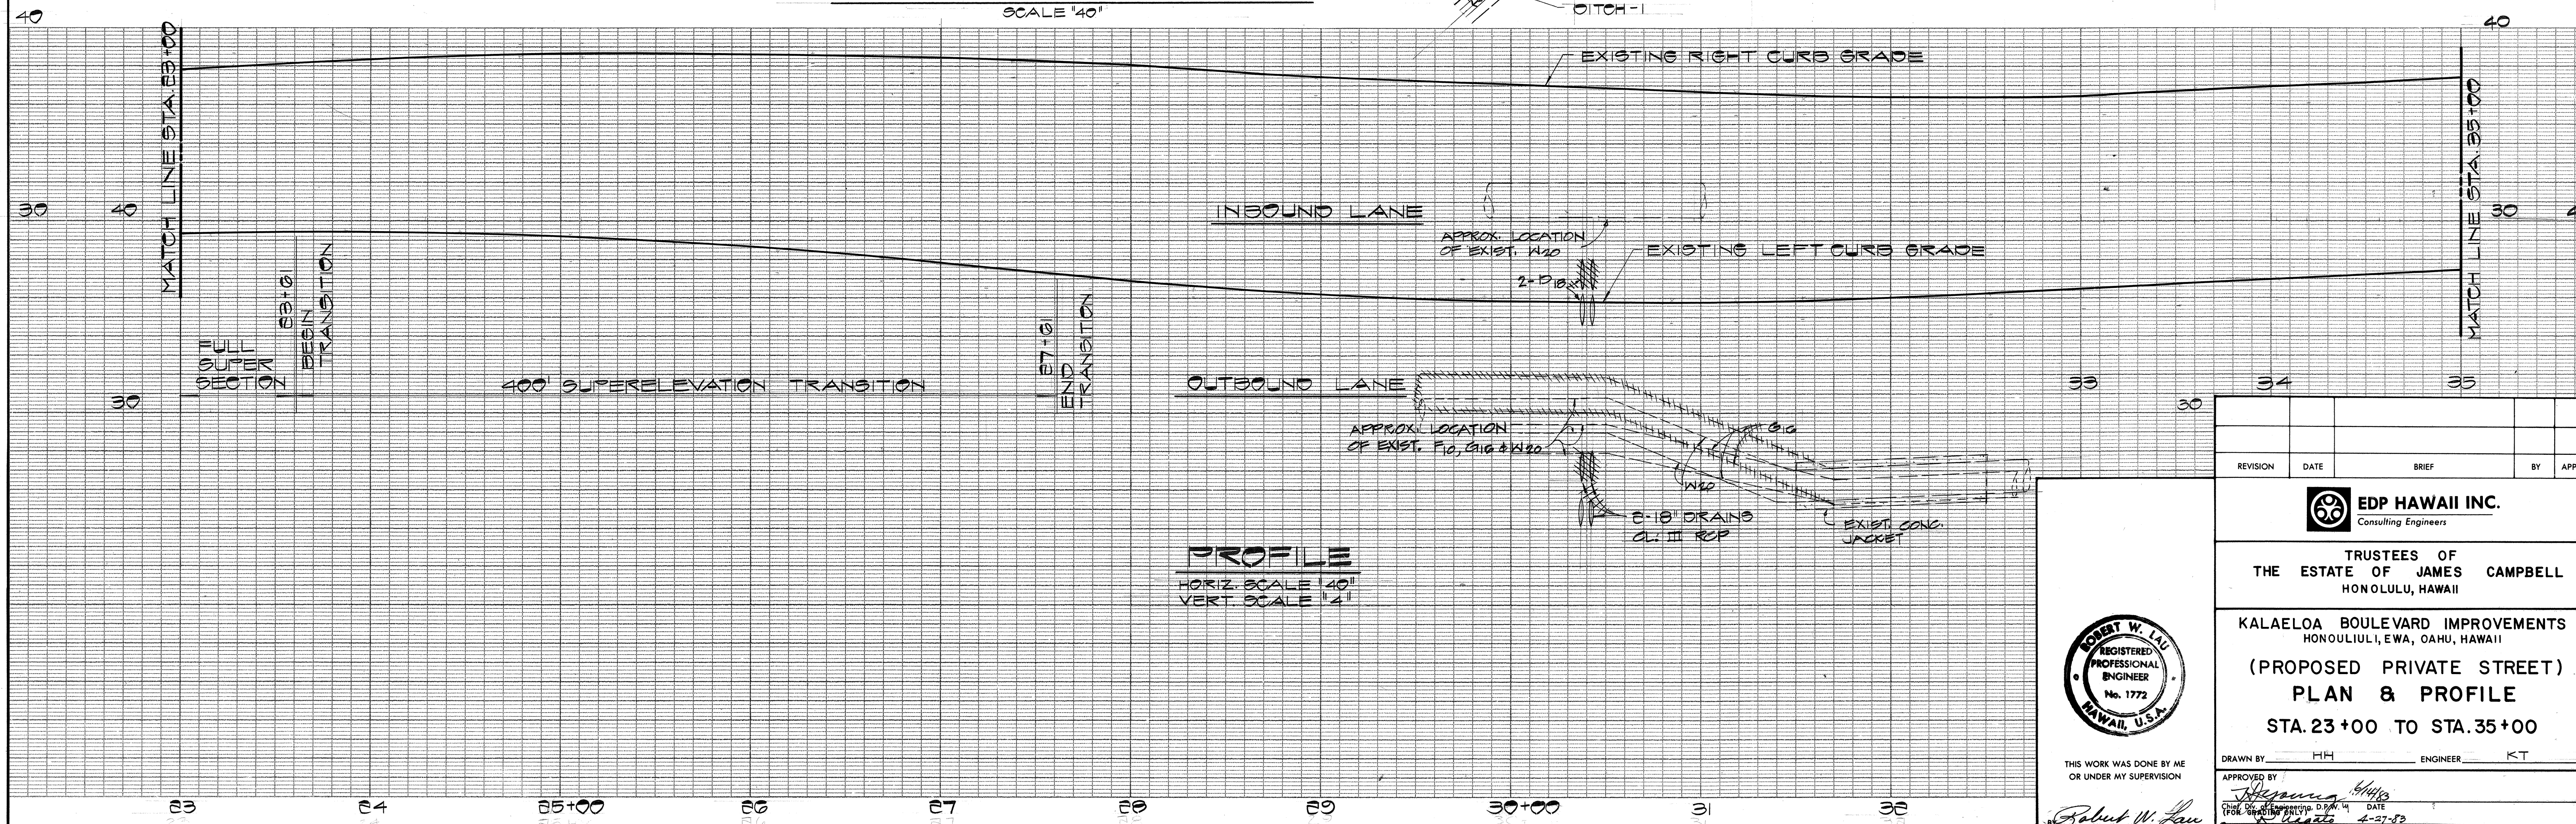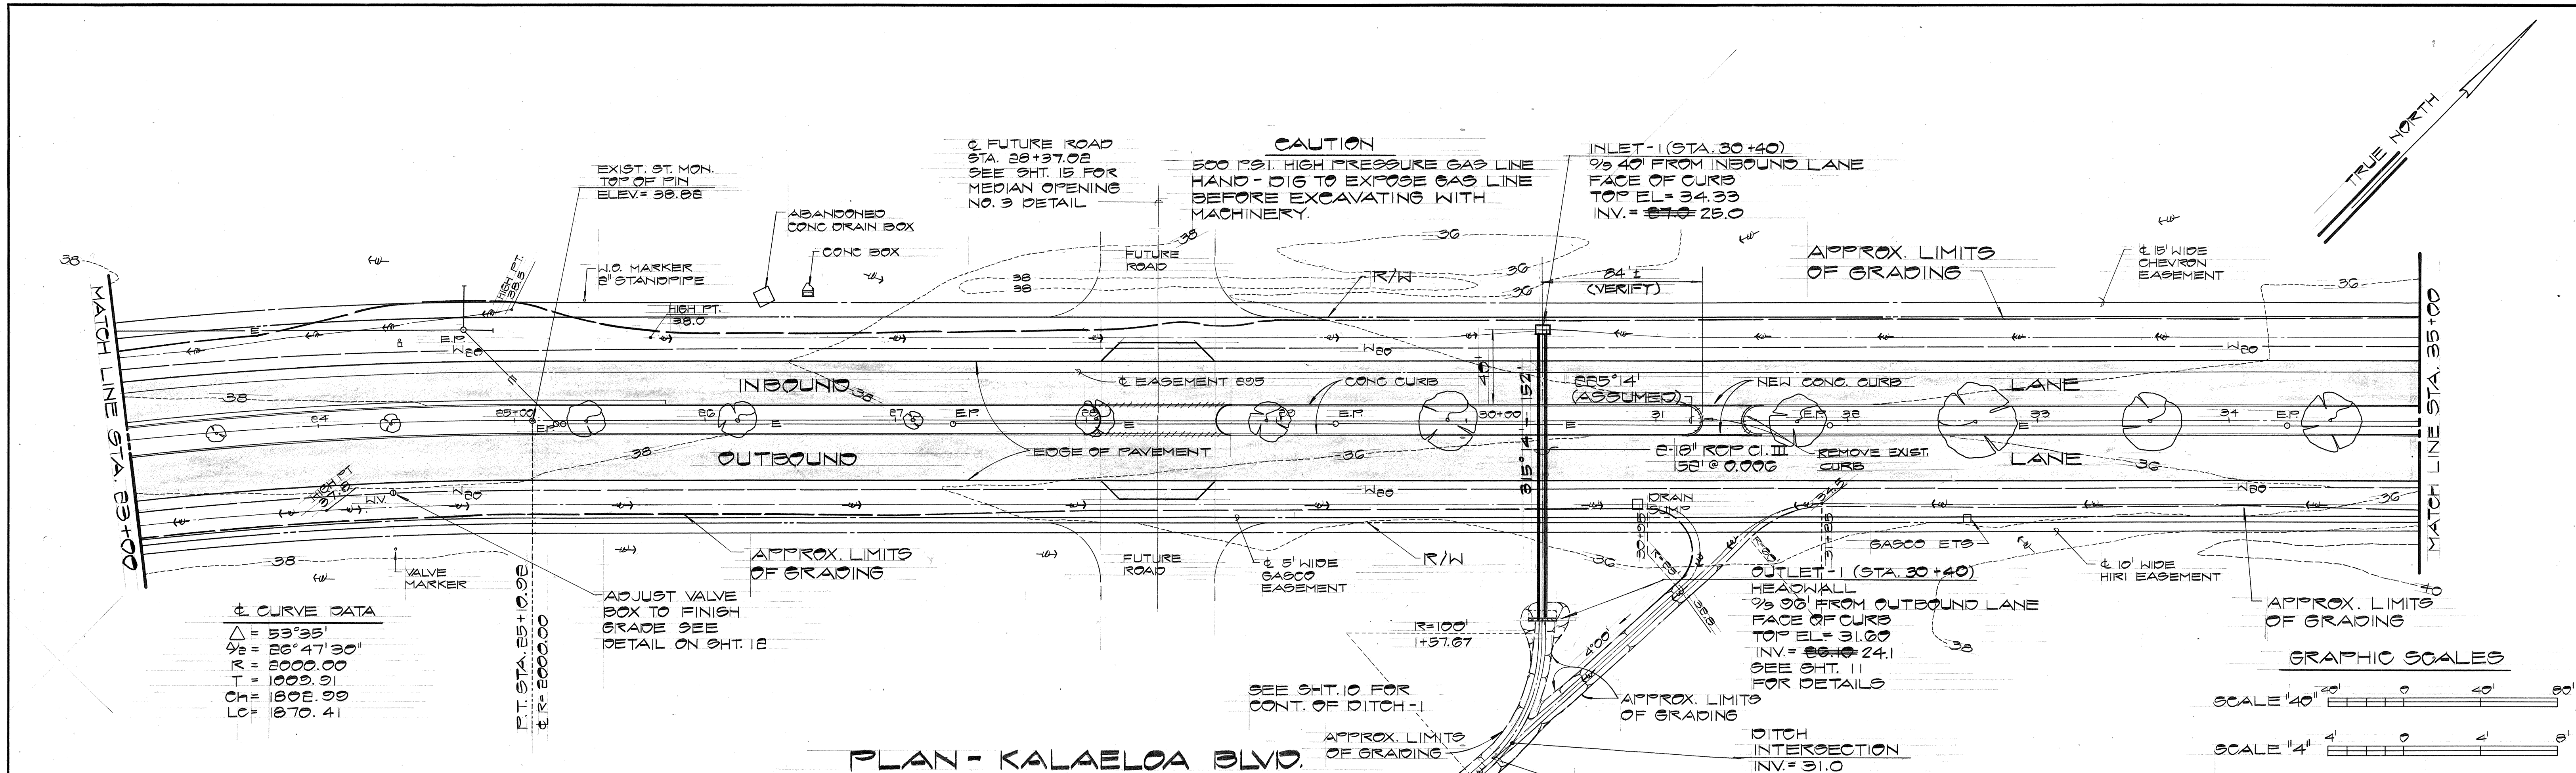

| REVISION | DATE | BRIEF | BY | APPR'D |
|----------|------|-------|----|--------|
|          |      |       |    |        |

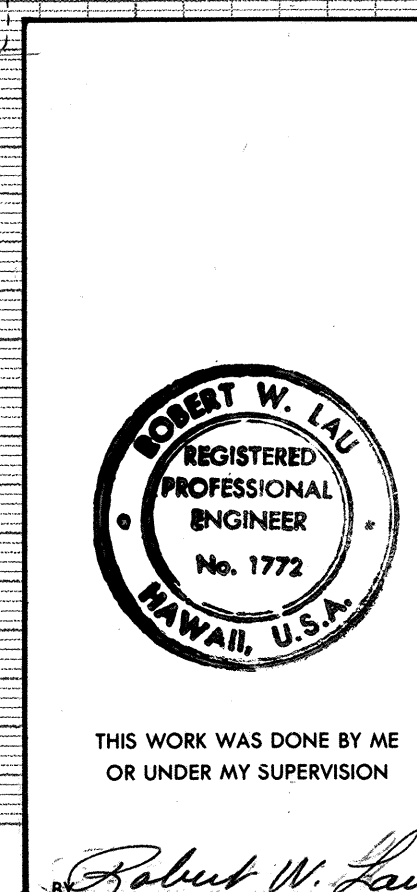

**EDP HAWAII INC.**  
Consulting Engineers

TRUSTEES OF  
THE ESTATE OF JAMES CAMPBELL  
HONOLULU, HAWAII

KALAELOA BOULEVARD IMPROVEMENTS  
HONOLULU, EWA, OAHU, HAWAII

(PROPOSED PRIVATE STREET)  
**PLAN & PROFILE**  
STA. 23+00 TO STA. 35+00

DRAWN BY: HH ENGINEER: KT


APPROVED BY: *Robert W. Lau*

DATE: 4-27-83



FOR: KALAELOA BOULEVARD IMPROVEMENTS

Prepared by: Robert W. Lau, EDP, Inc.



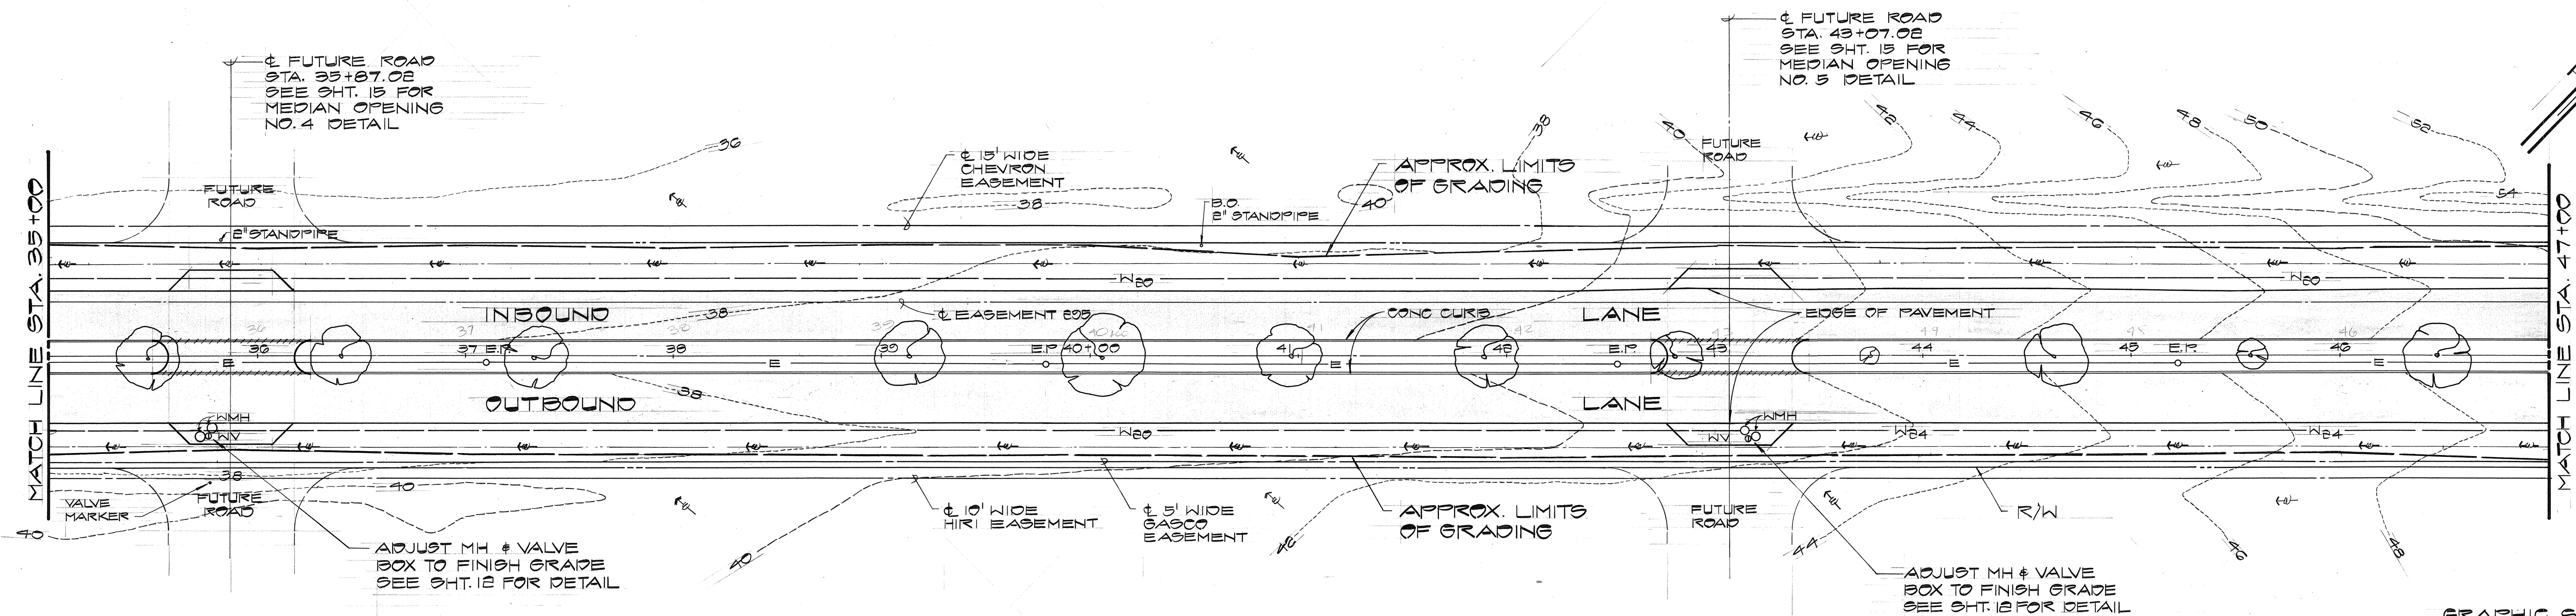

PLAN - KALAELOA BLVD.  
SCALE "40"

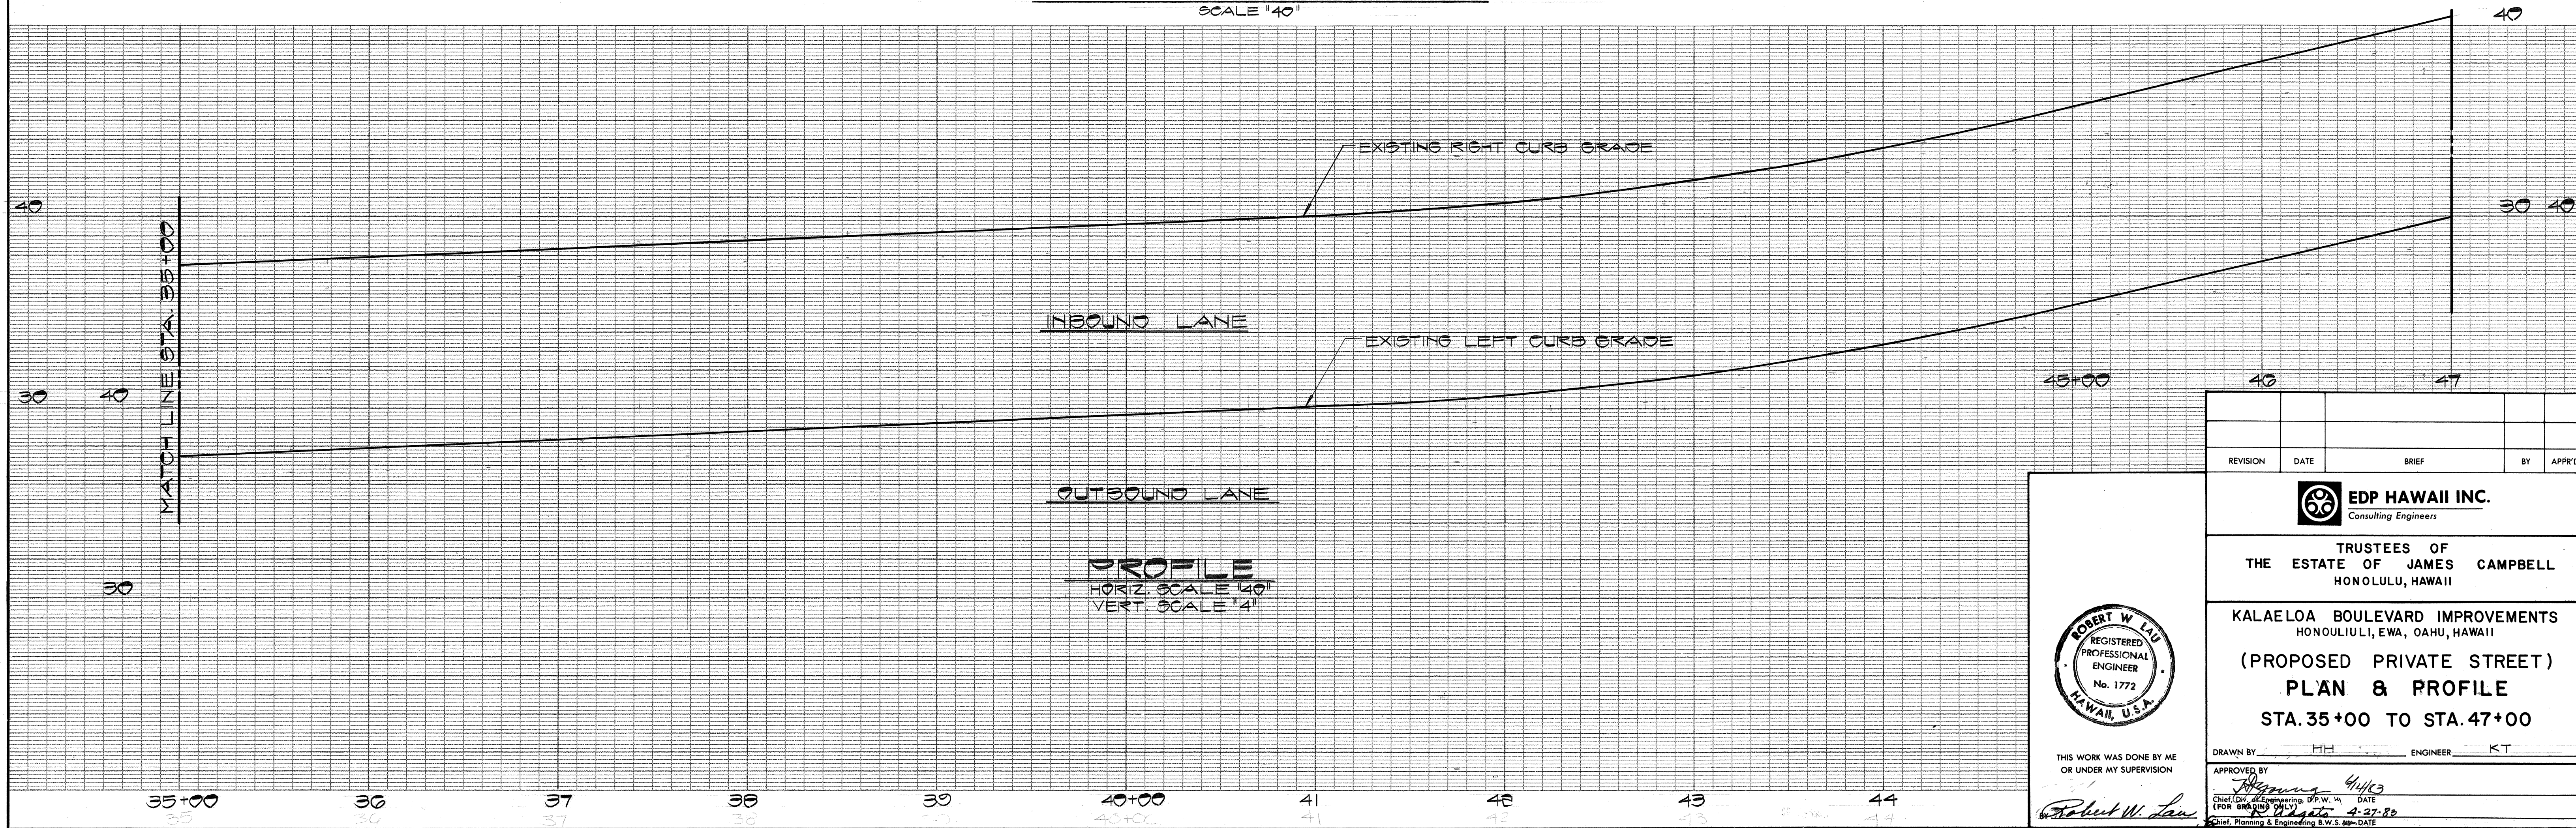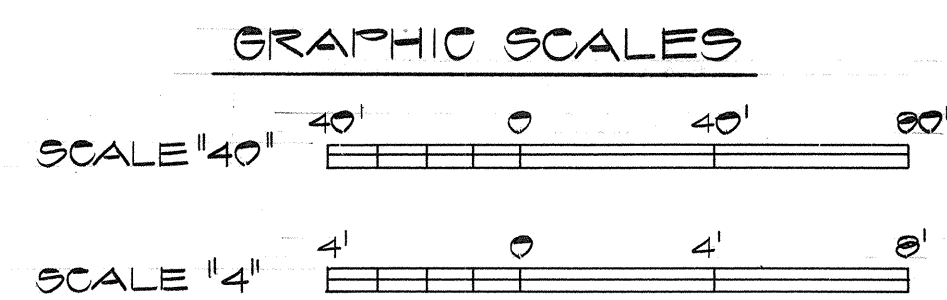


| REVISION | DATE | BRIEF | BY | APPR'D |
|----------|------|-------|----|--------|
|          |      |       |    |        |

**EDP HAWAII INC.**  
Consulting Engineers

TRUSTEES OF  
THE ESTATE OF JAMES CAMPBELL  
HONOLULU, HAWAII

KALAELOA BOULEVARD IMPROVEMENTS  
HONOLULU, EWA, OAHU, HAWAII  
(PROPOSED PRIVATE STREET)  
**PLAN & PROFILE**  
STA. 35+00 TO STA. 47+00

DRAWN BY: HH ENGINEER: KT

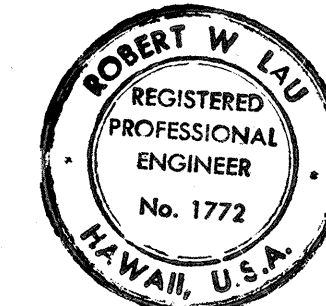

THIS WORK WAS DONE BY ME  
OR UNDER MY SUPERVISION



Robert W. Lau

APPROVED BY: [Signature] DATE: 4/4/83  
Checked by: [Signature] DATE: 4-27-83  
Chief, Planning & Engineering, E.W.S. Inc.








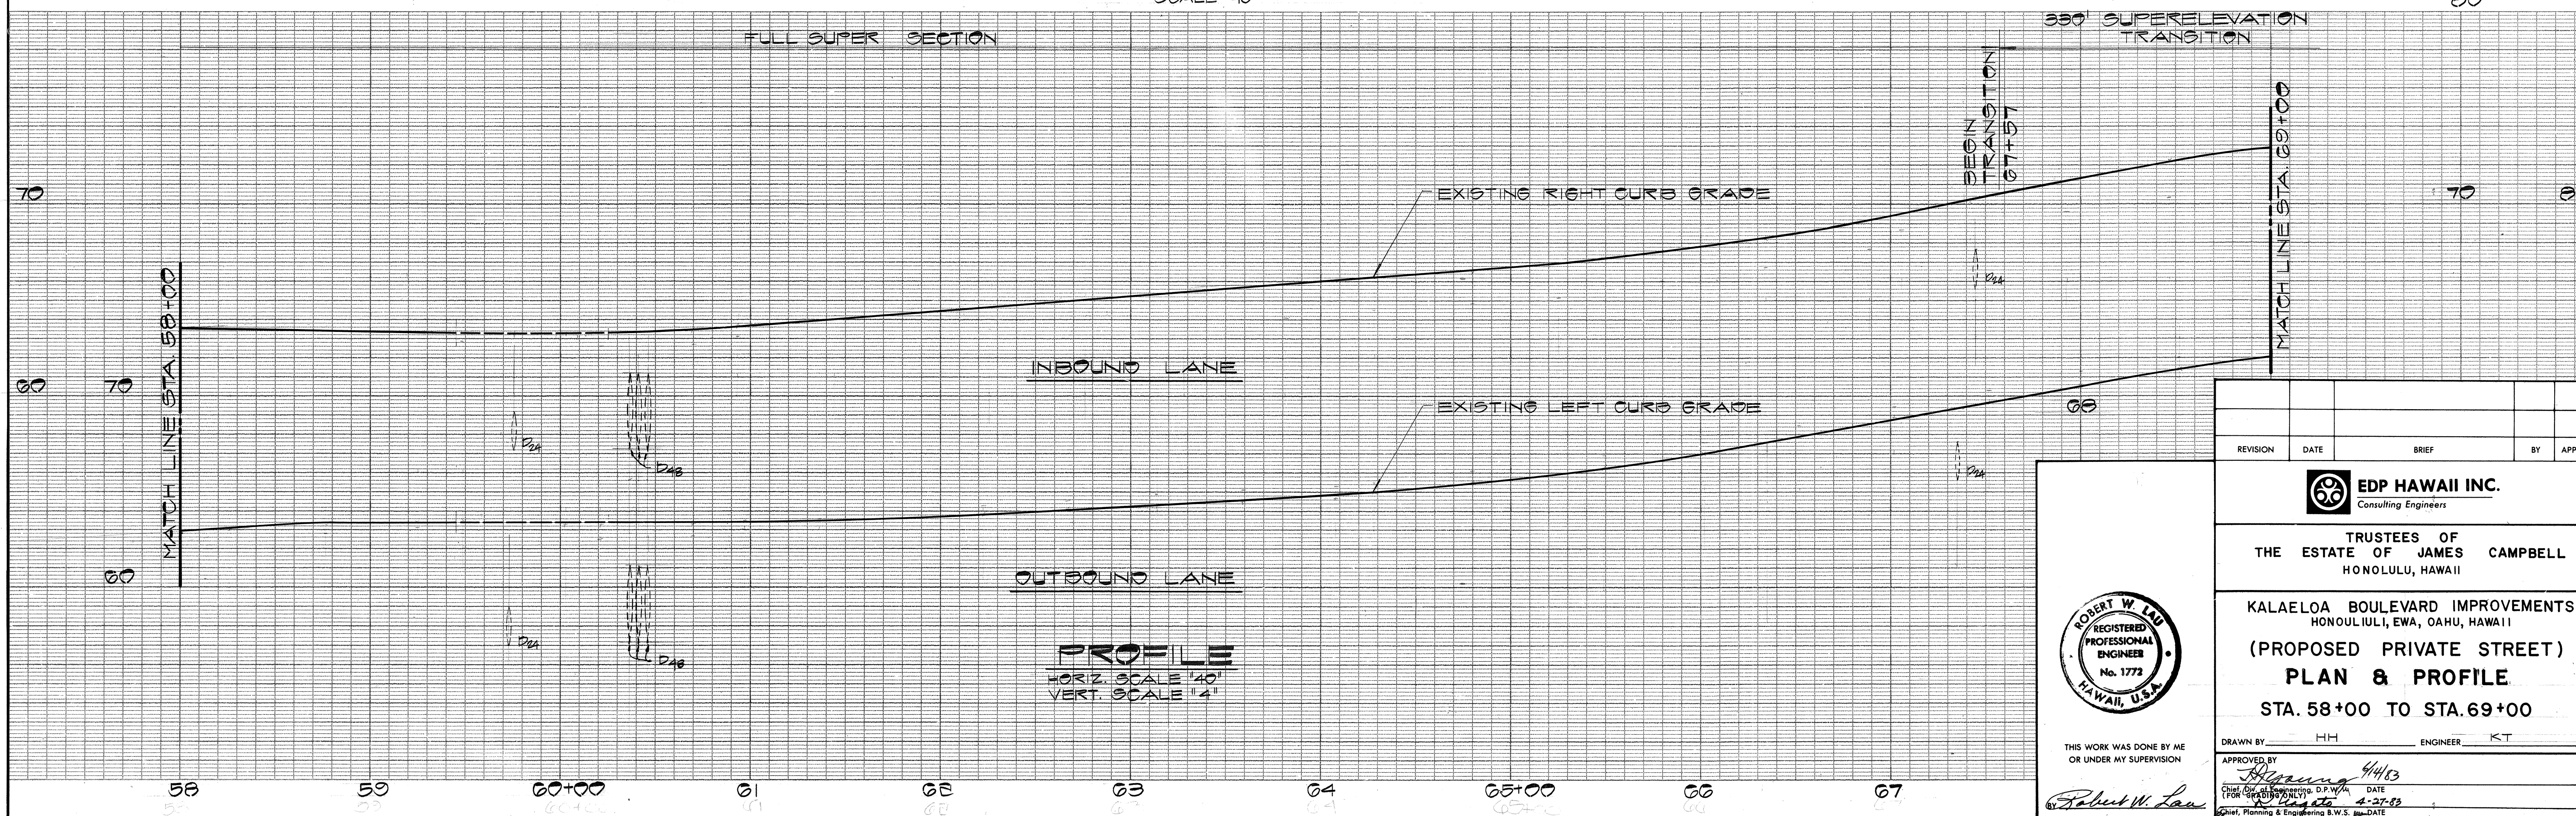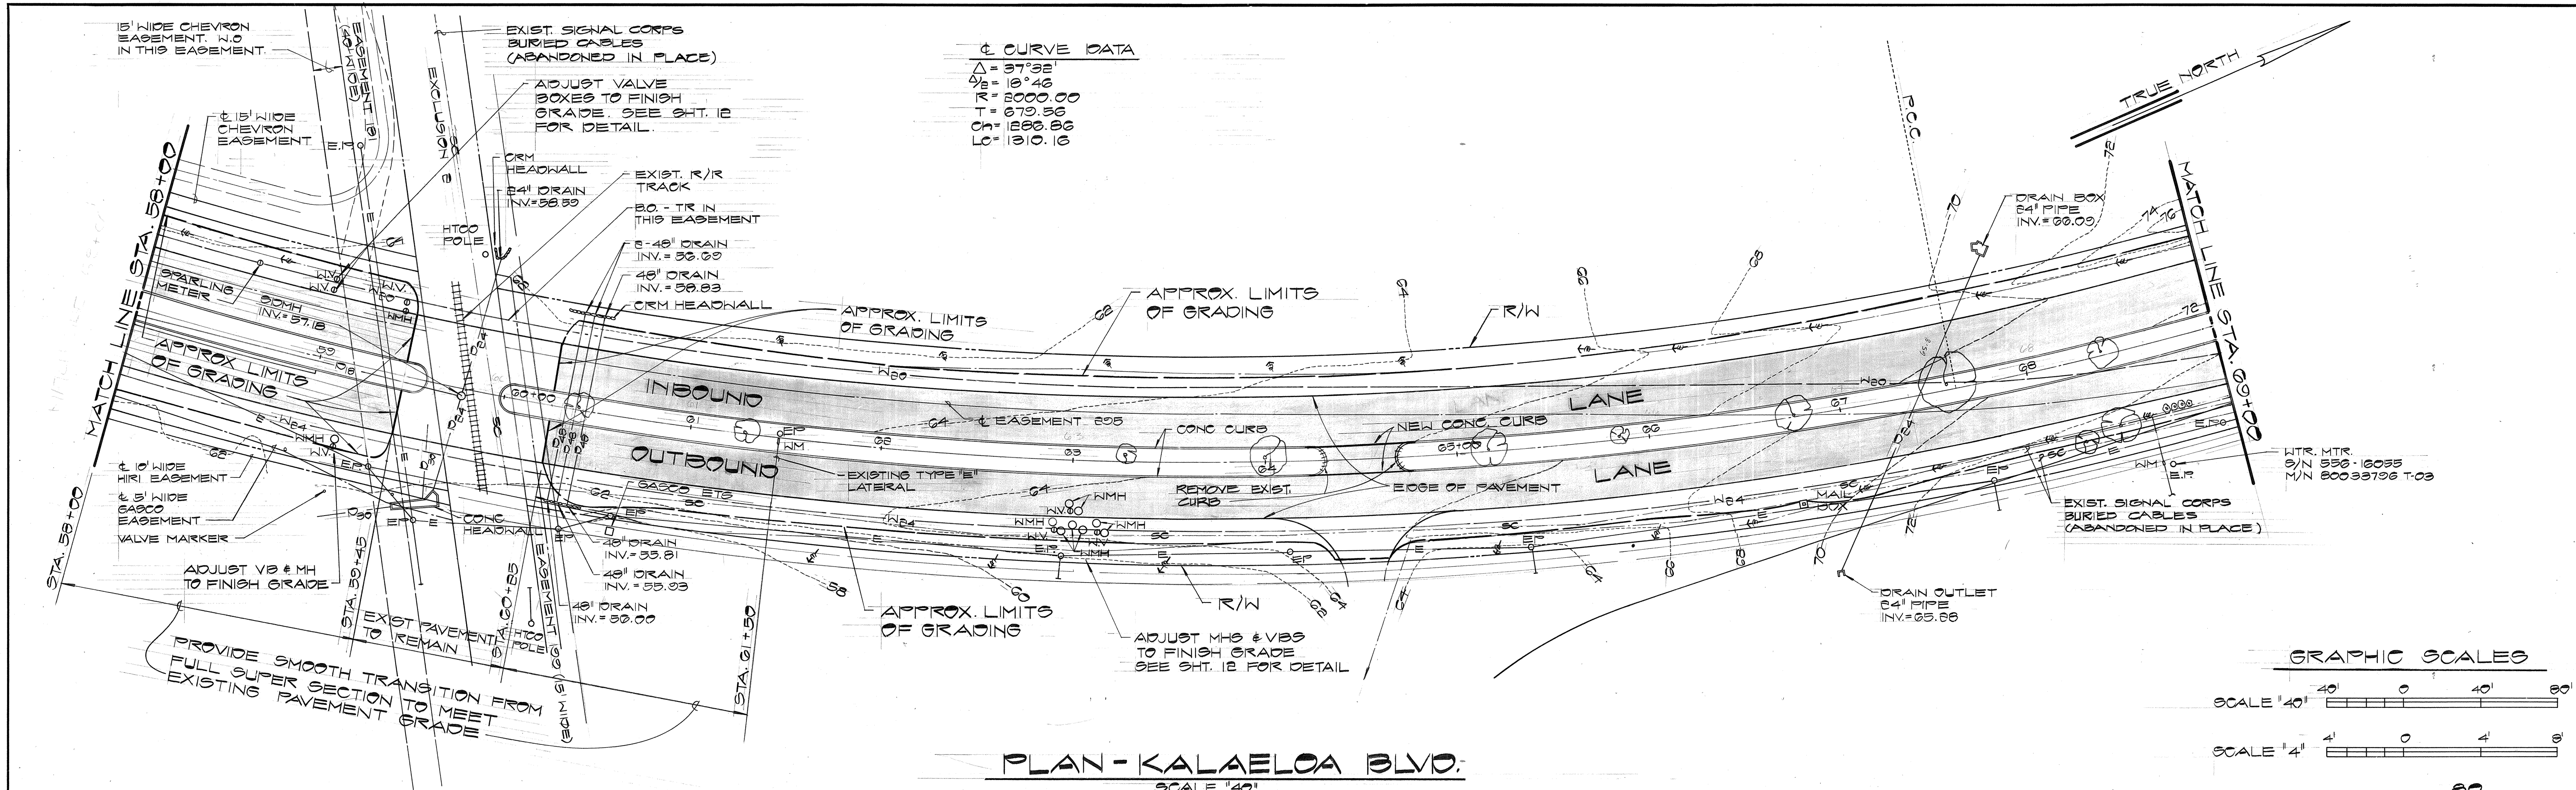

| REVISION | DATE | BRIEF | BY | APP'D |
|----------|------|-------|----|-------|
|          |      |       |    |       |

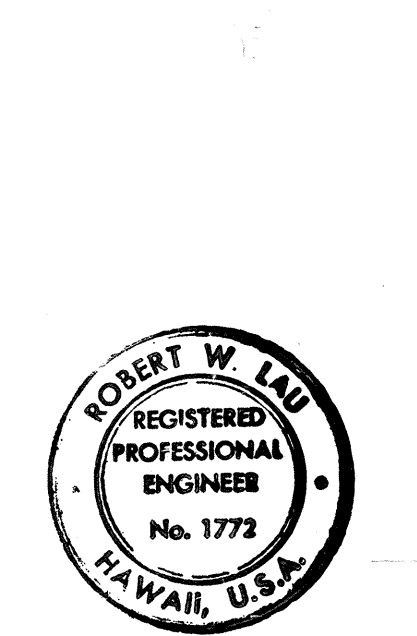

**EDP HAWAII INC.**  
Consulting Engineers

TRUSTEES OF  
THE ESTATE OF JAMES CAMPBELL  
HONOLULU, HAWAII


KALAELOA BOULEVARD IMPROVEMENTS  
HONOLULU, EWA, OAHU, HAWAII

(PROPOSED PRIVATE STREET)  
**PLAN & PROFILE**  
STA. 58+00 TO STA. 69+00




DRAWN BY: HH ENGINEER: KT

APPROVED BY: *Robert W. Lau* DATE: 4-27-83  
FOR: *James Campbell* DATE: 4-27-83  
Chief, Planning & Engineering S.W.S. 80-DATE



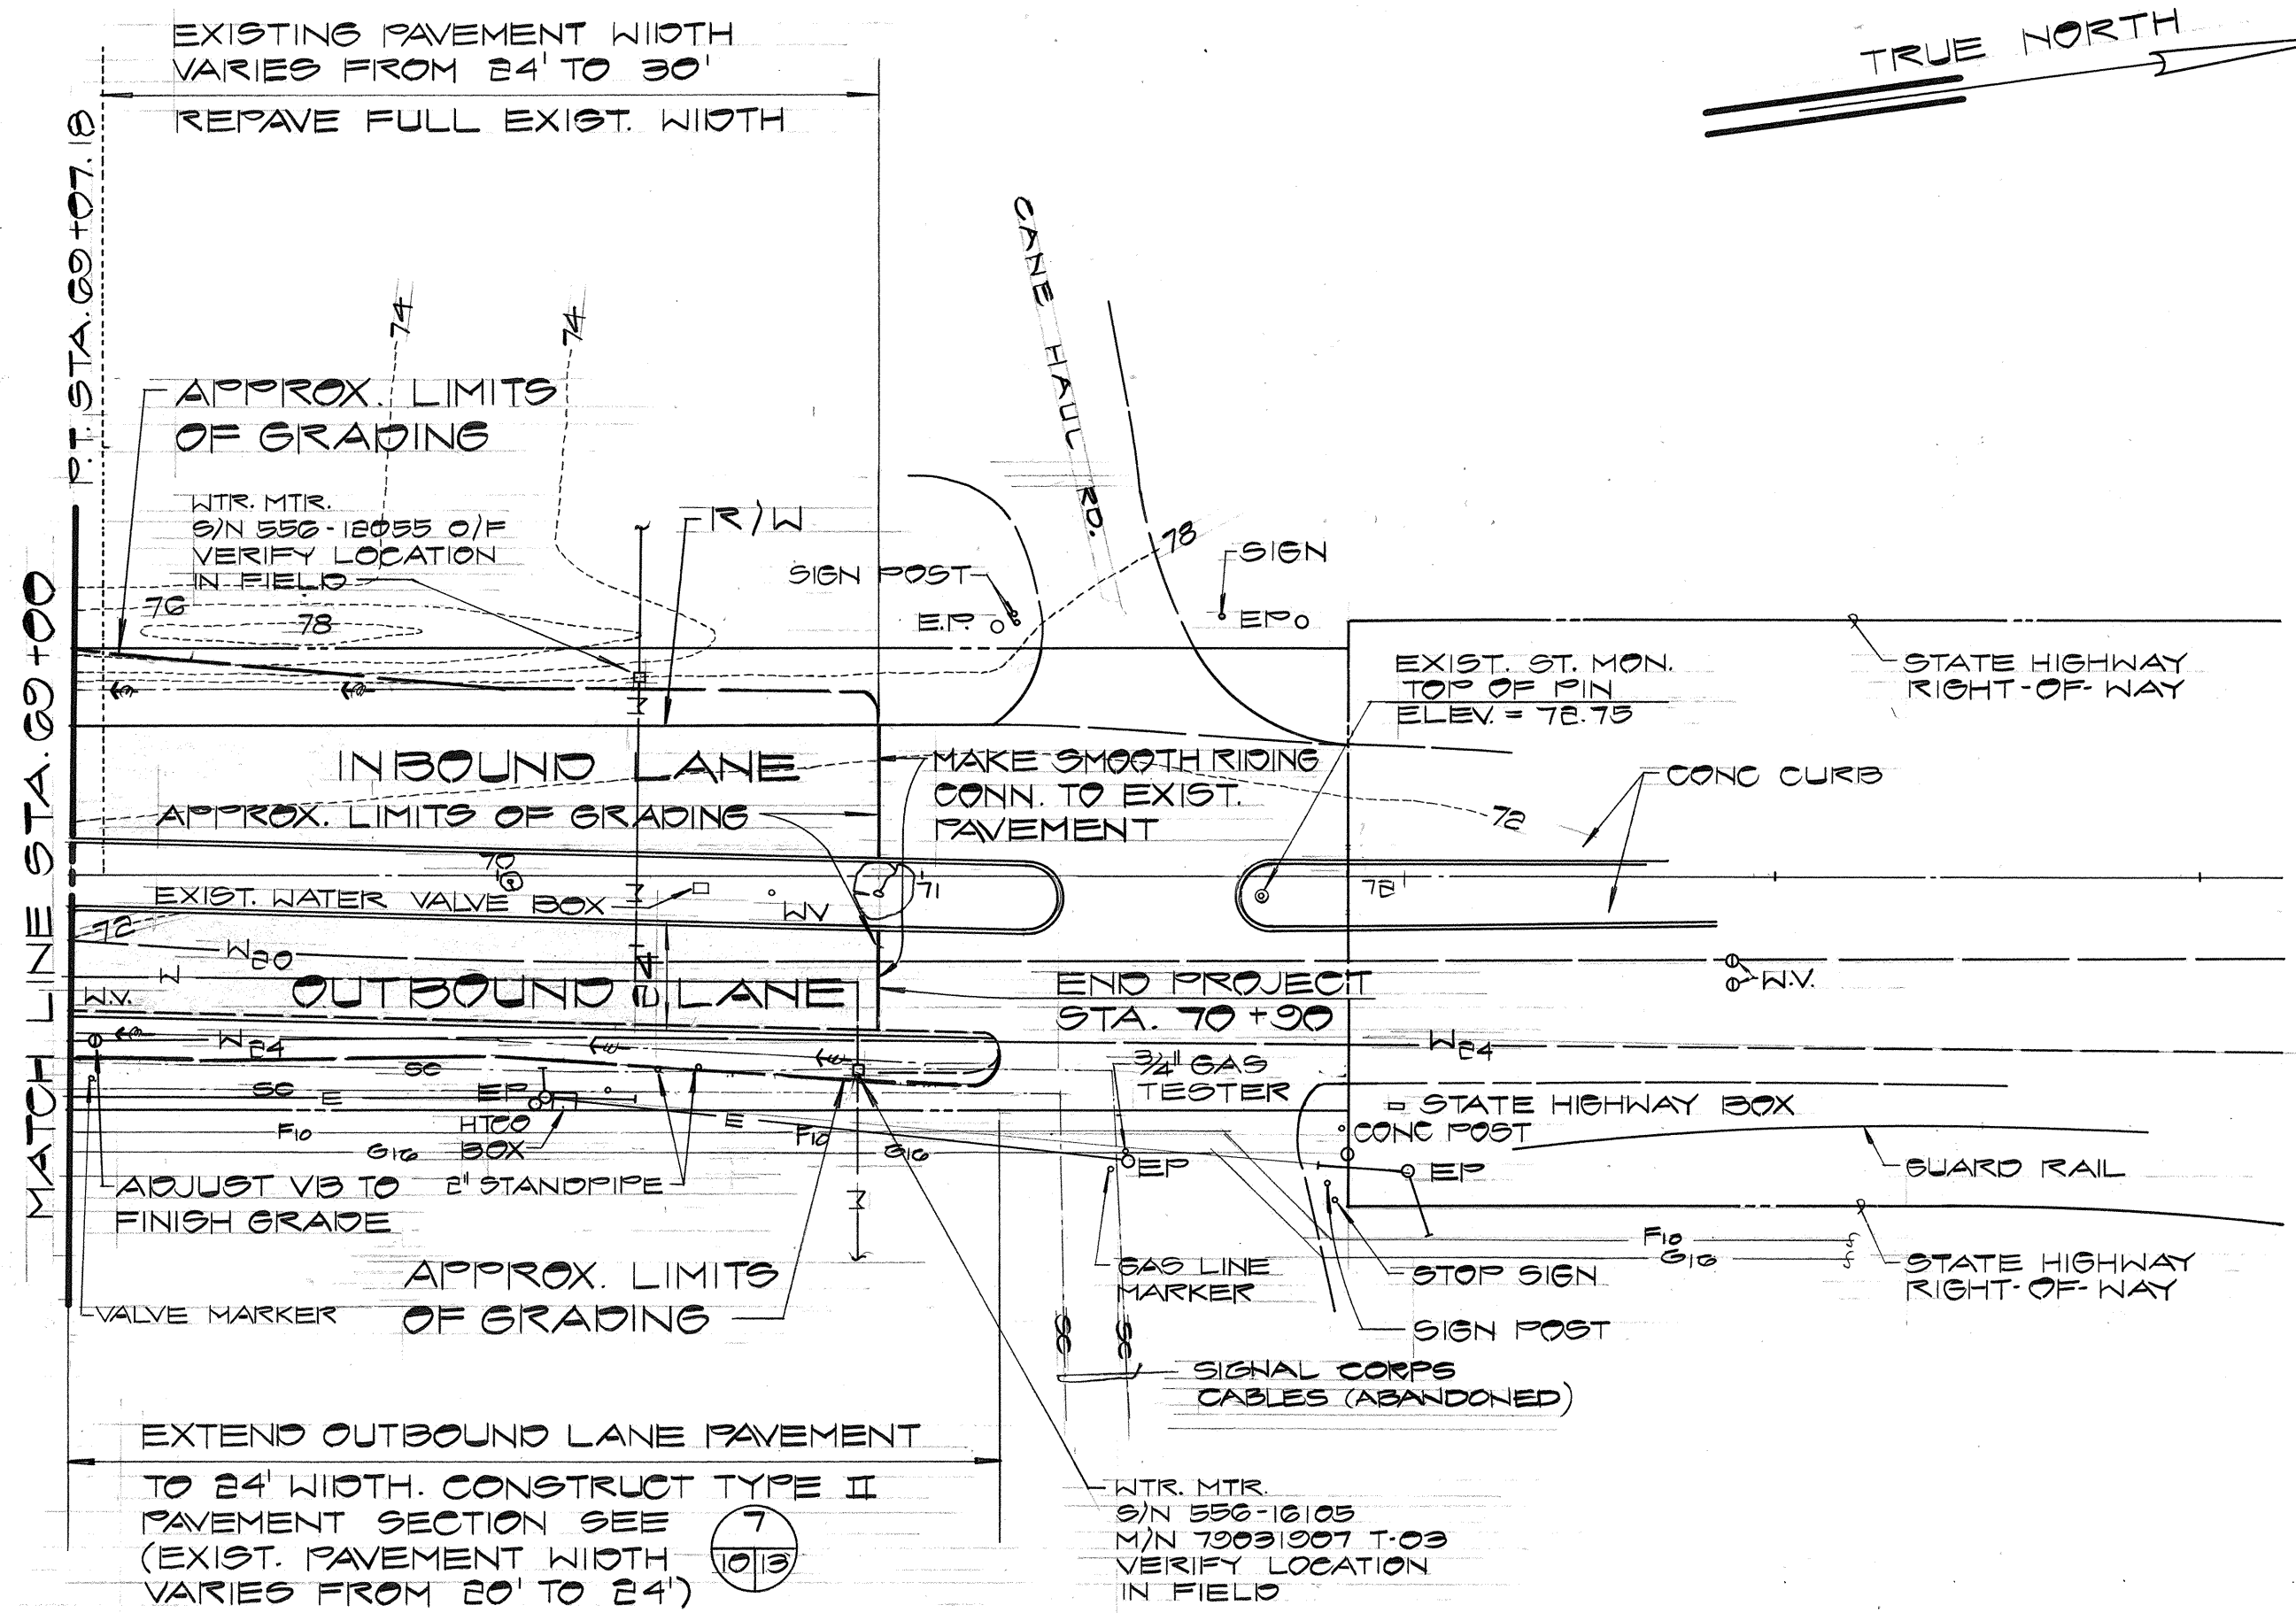

PLAN - KALAELOA BLVD.  
SCALE "40"

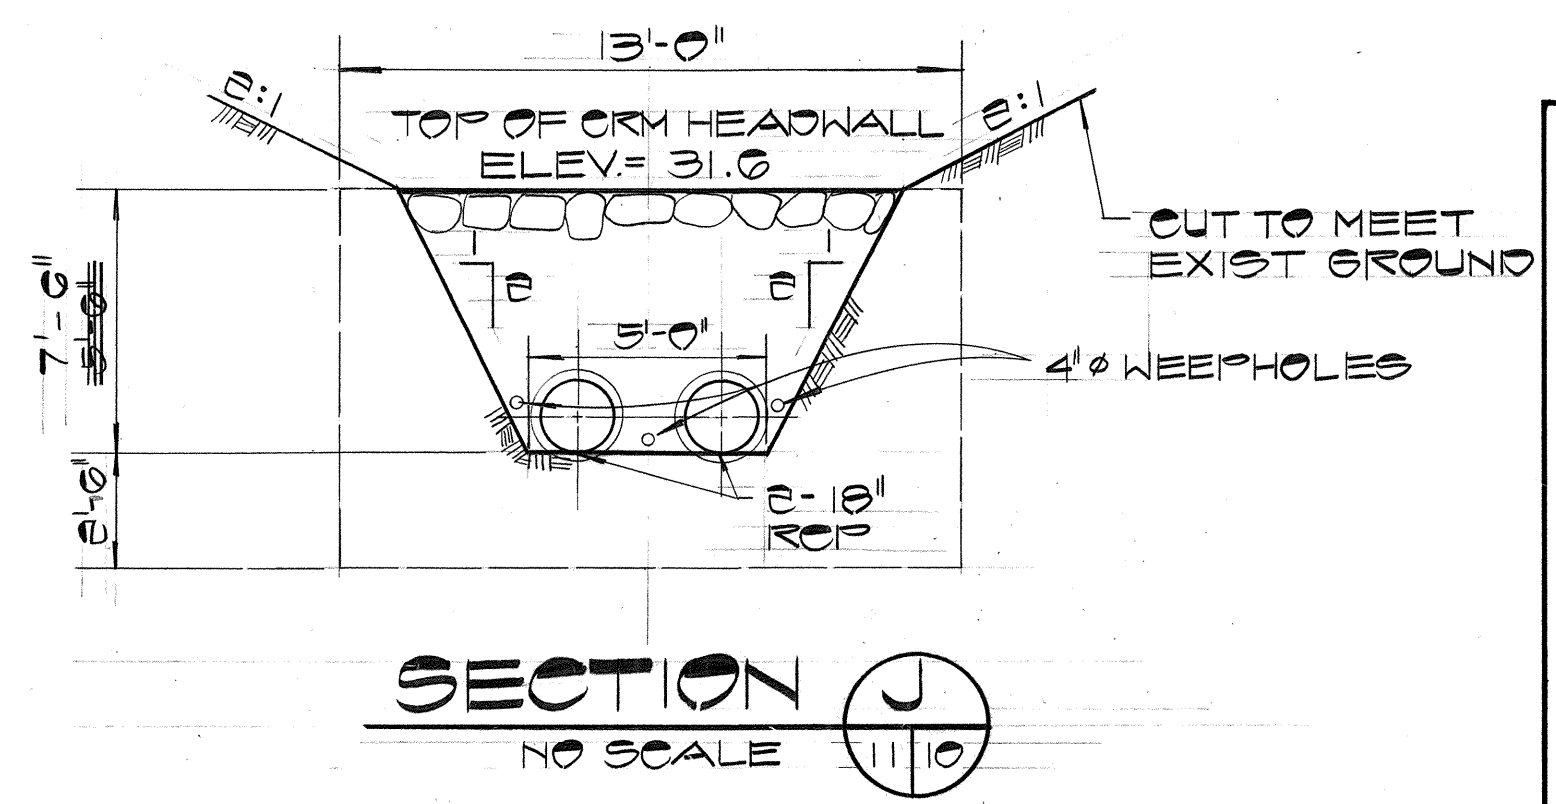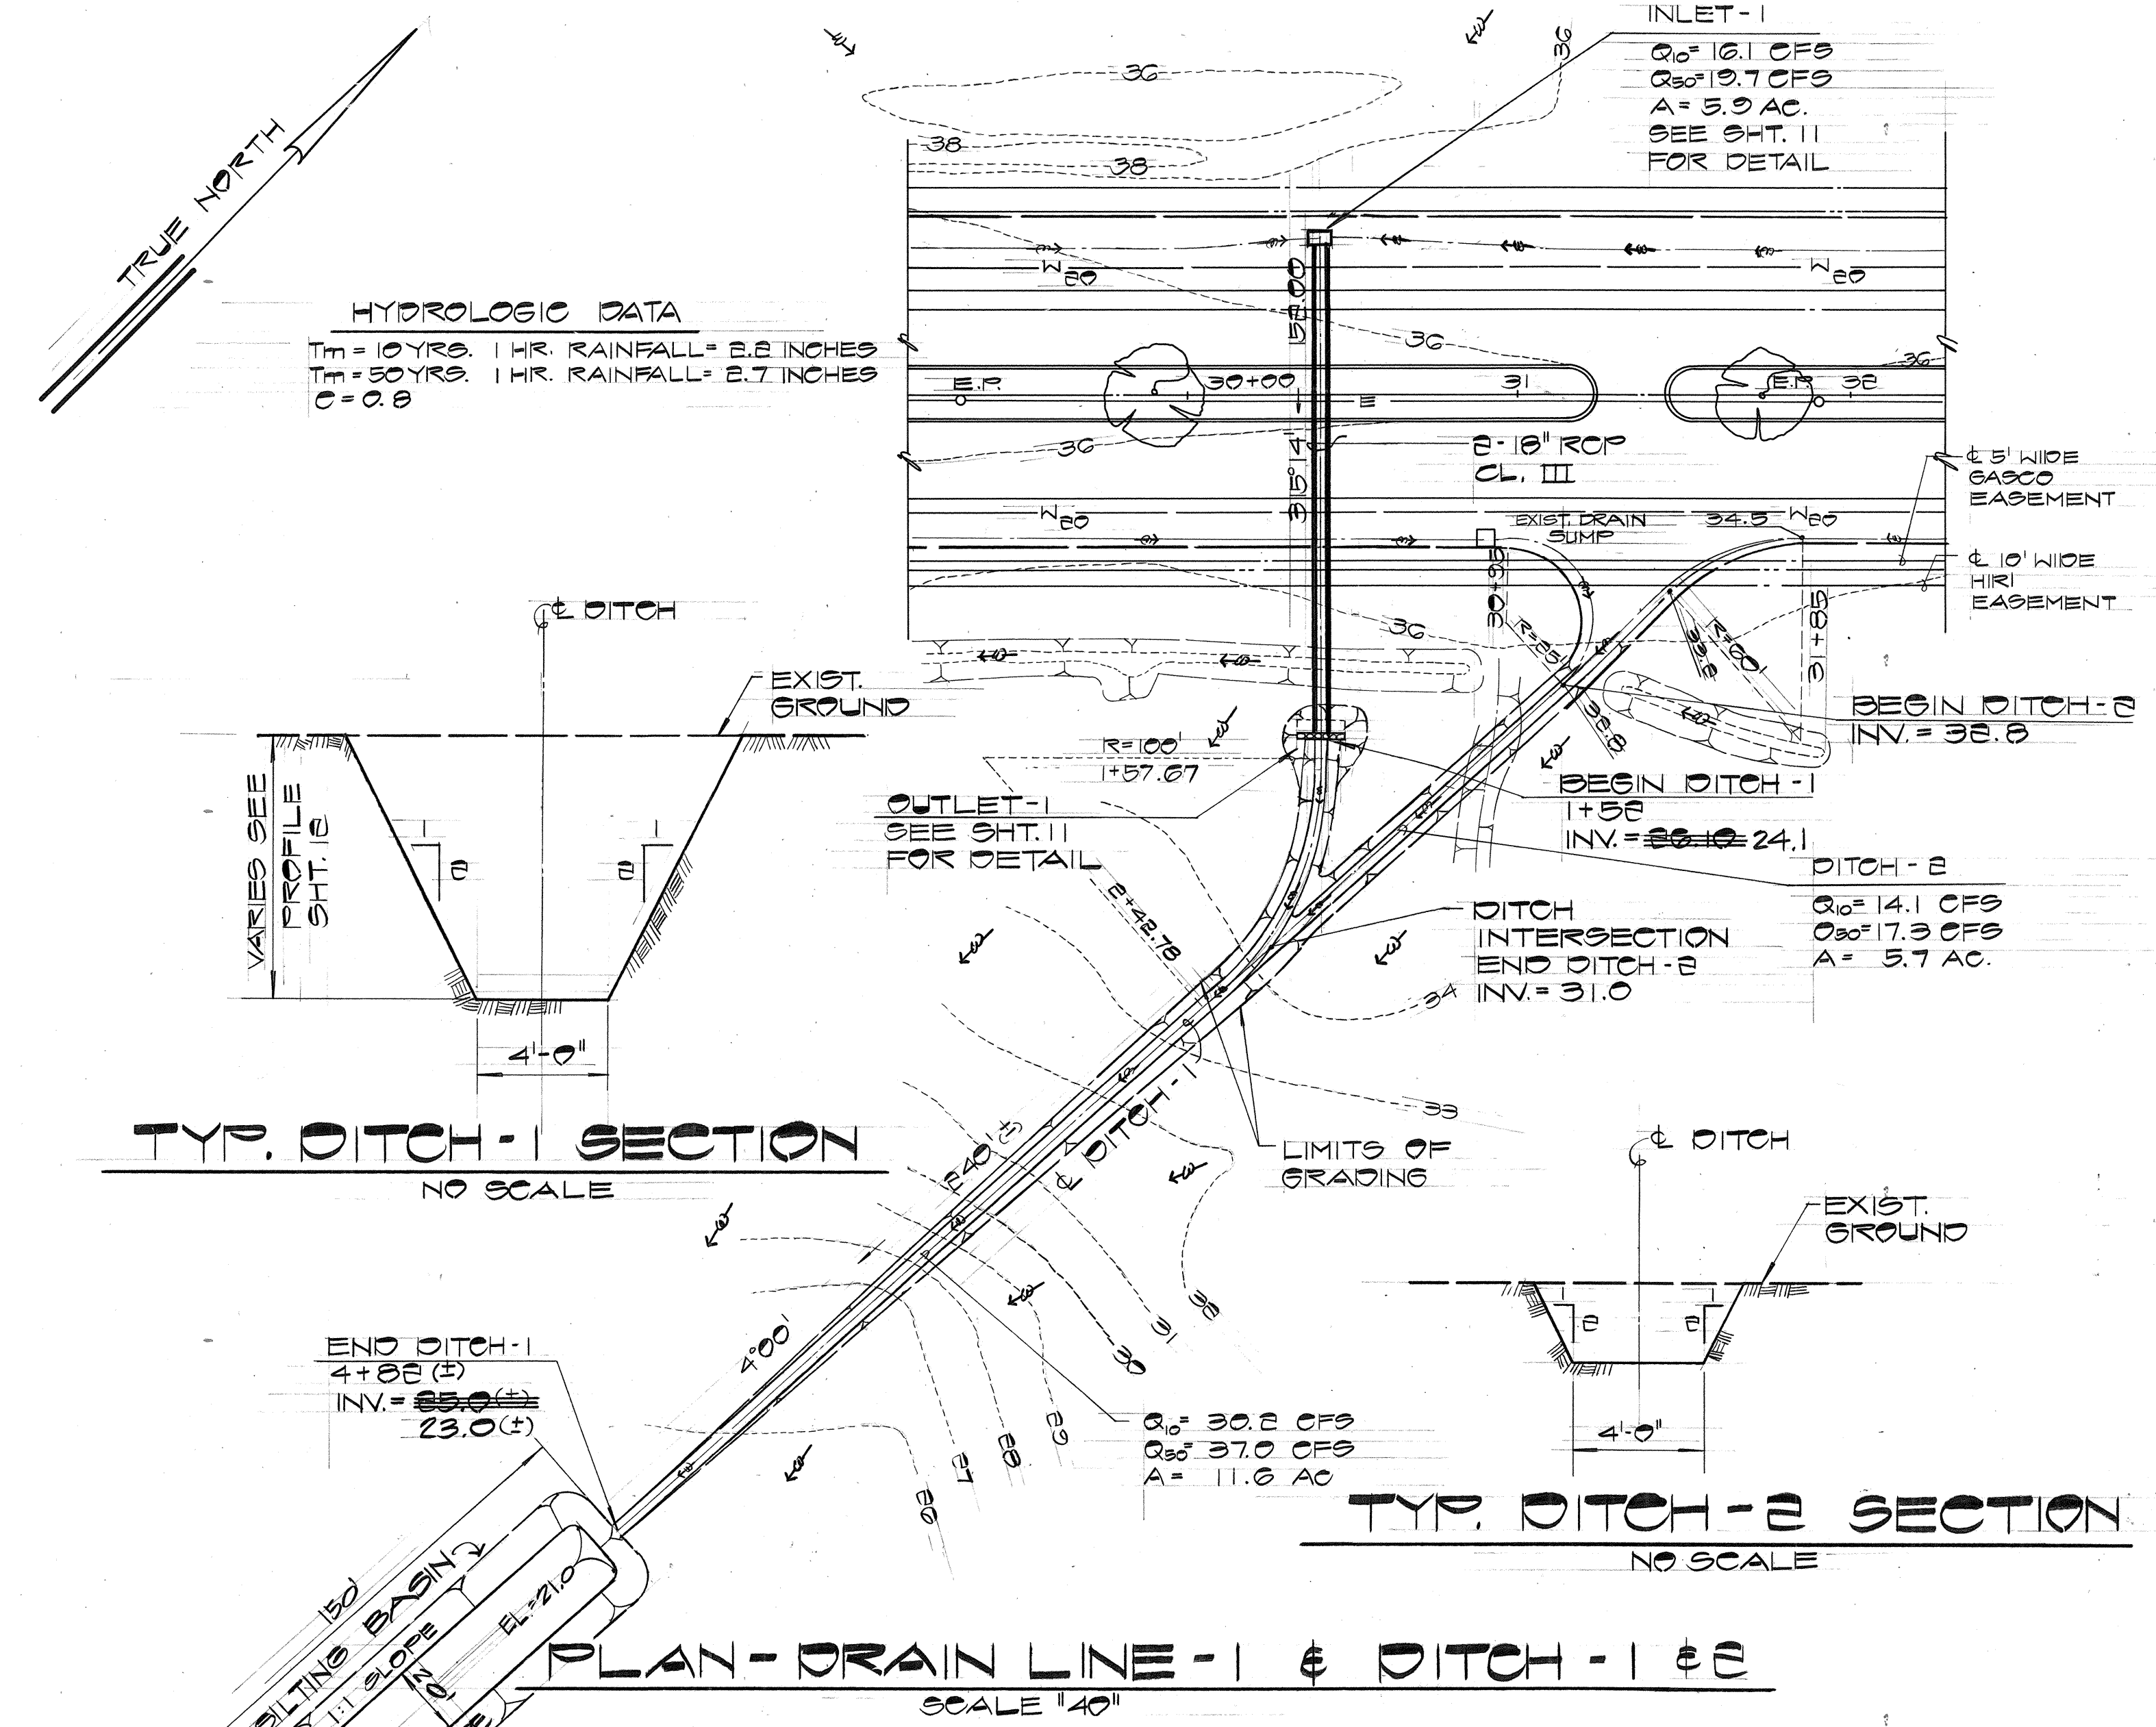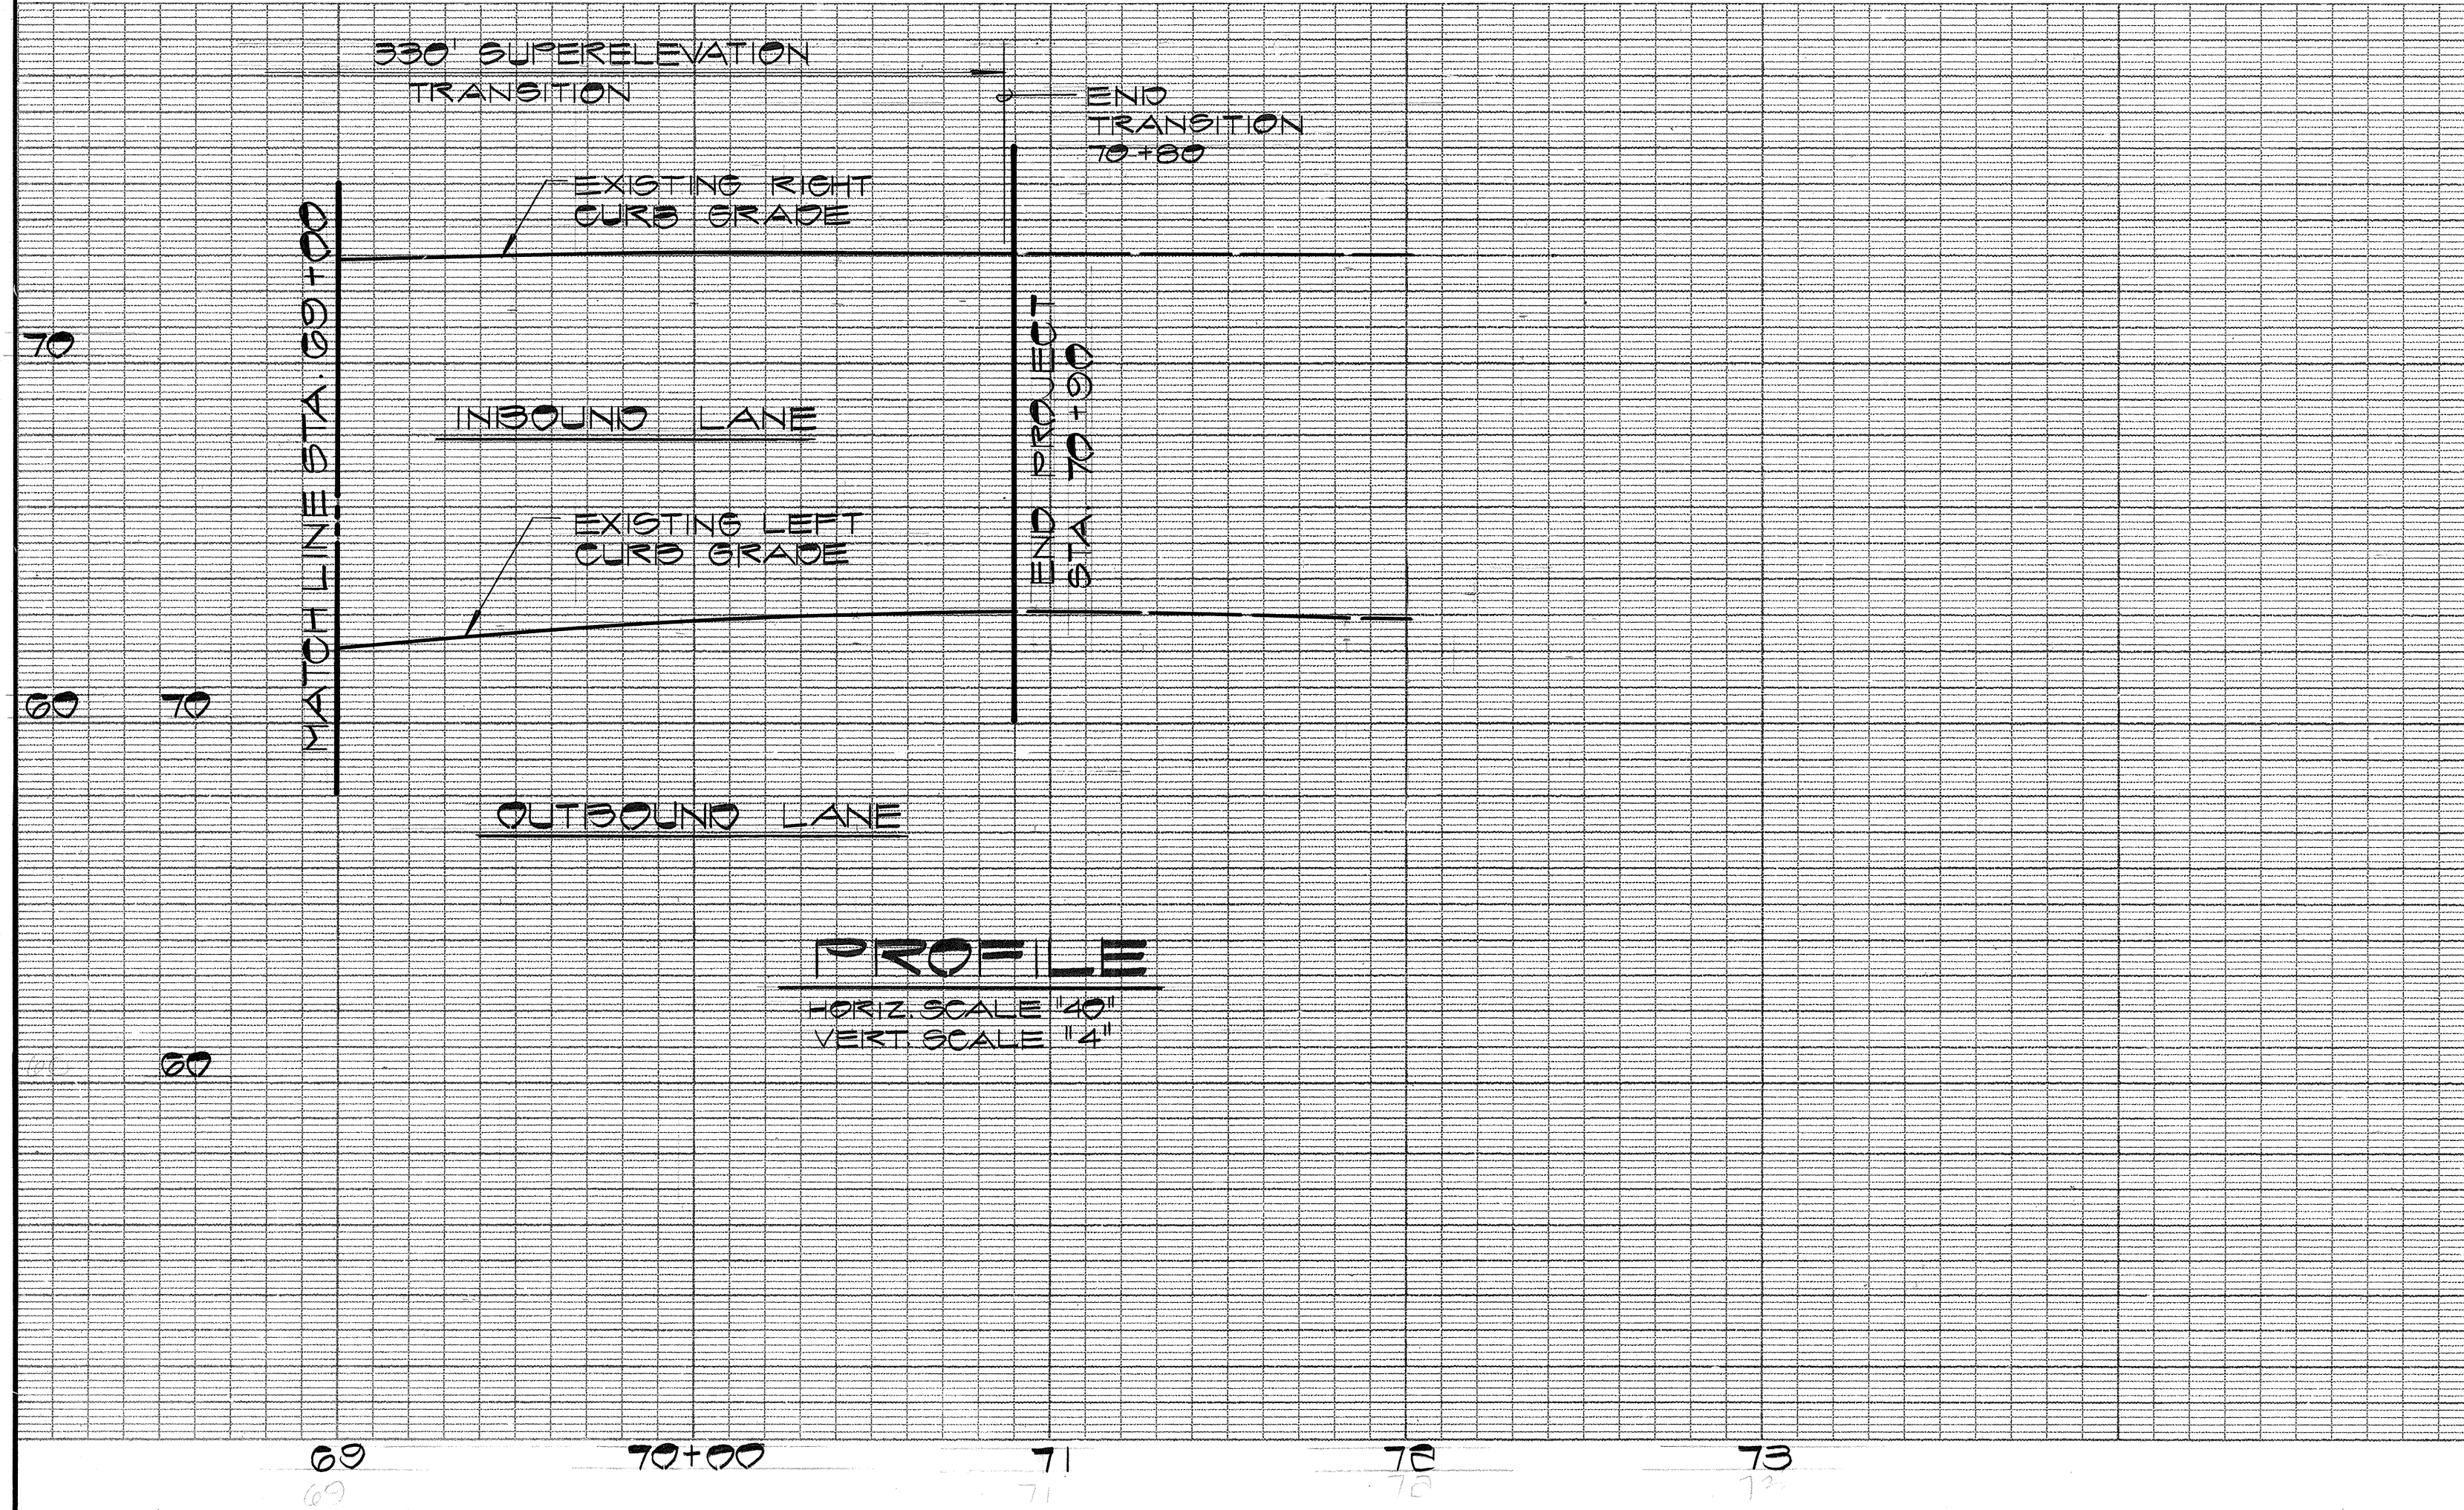

|          |      |       |    |        |
|----------|------|-------|----|--------|
| REVISION | DATE | BRIEF | BY | APPR'D |
|          |      |       |    |        |

**EDP HAWAII INC.**  
Consulting Engineers

TRUSTEES OF  
THE ESTATE OF JAMES CAMPBELL  
HONOLULU, HAWAII

KALAELOA BOULEVARD IMPROVEMENTS  
HONOLULU, EWA, OAHU, HAWAII  
(PROPOSED PRIVATE STREET)  
**PLAN & PROFILE**  
STA. 69+00 TO STA. 72+00  
& PLAN DL-1 & DITCH 1 & 2

DRAWN BY: HH ENGINEER: KT

APPROVED BY: *Robert W. Lau* DATE: 4-27-83

FOR GRADING ONLY  
Shts. Planning & Engineering B.W.S. DATE: 4-27-83

THIS WORK WAS DONE BY ME OR UNDER MY SUPERVISION

ROBERT W. LAU  
REGISTERED PROFESSIONAL ENGINEER  
No. 1772  
HAWAII, U.S.A.