


ORIGINAL SURVEY		BY	DATE
SURVEYED			
PLOTTED			
TEMPLATE			
AREAS			
AREAS CHECKED			
NO			

SHEET No. 1 OF 5 SHEETS

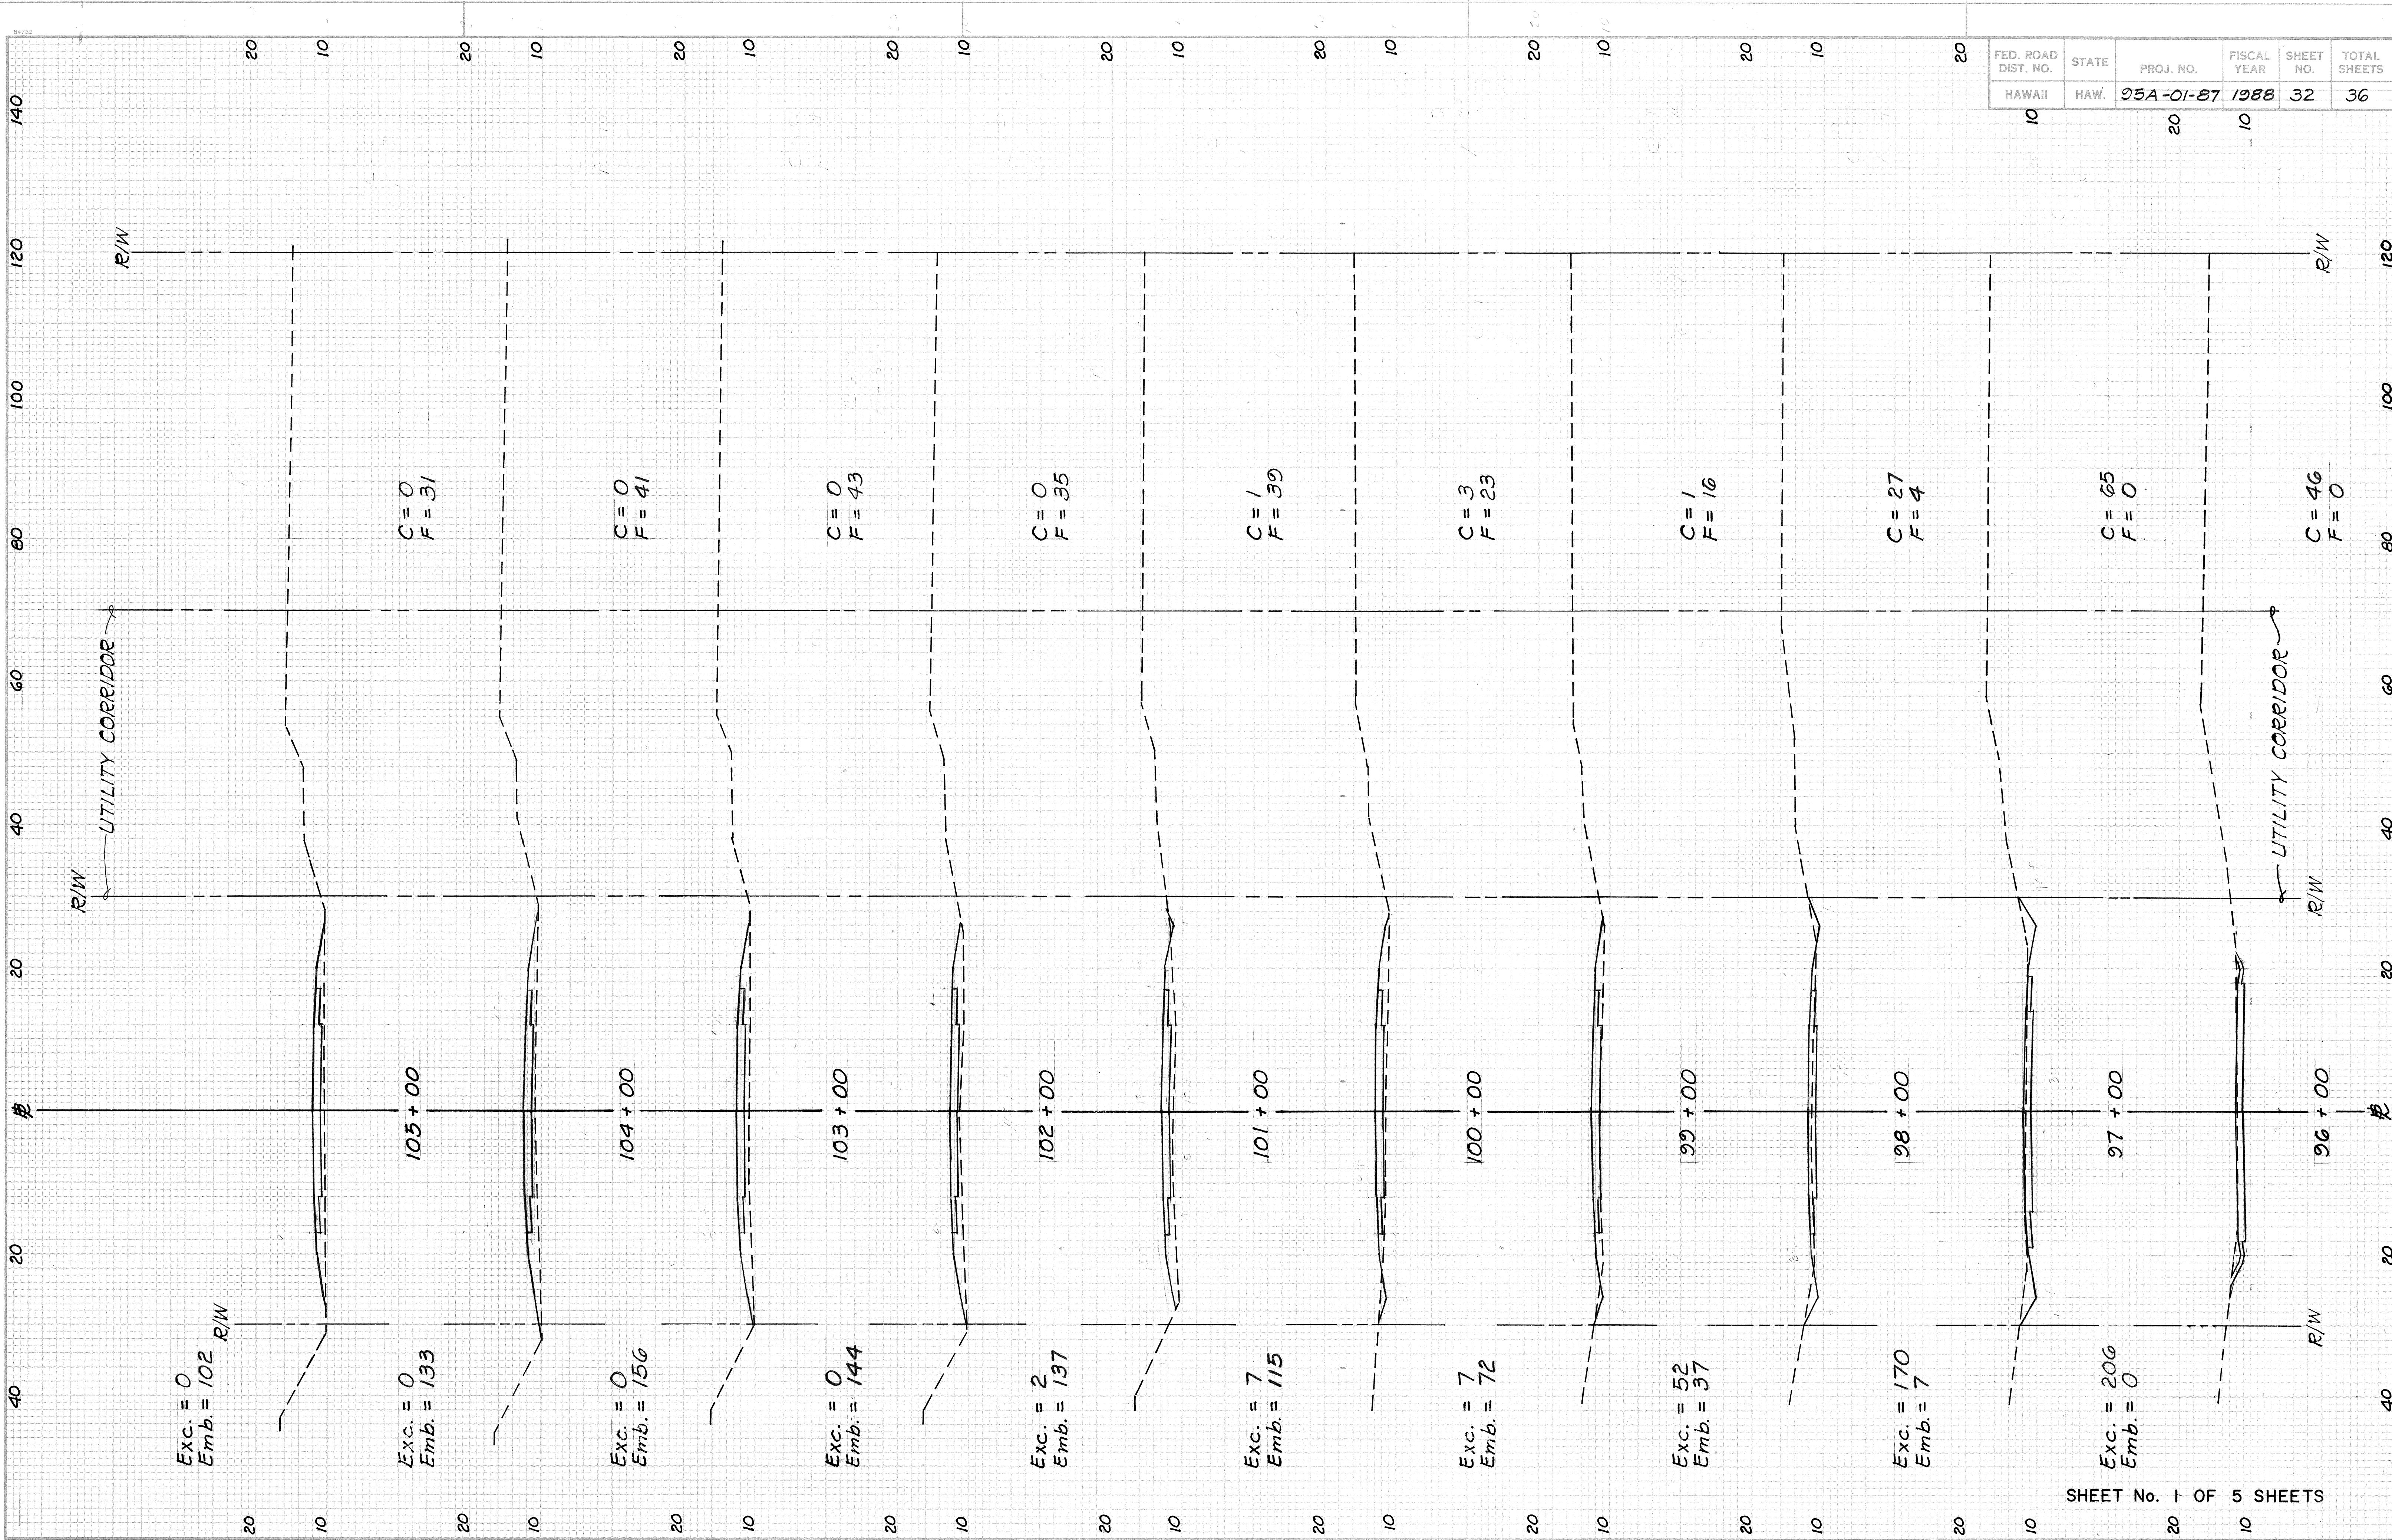


0 20 10 0

ORIGINAL SURVEY		BY _____	DATE _____
NOTE BOOK		SURVEYED _____	
		PLOTTED _____	
		TEMPLATE _____	
		AREAS _____	
		AREAS CHECKED _____	



ORIGINAL	SURVEYED	DATE
NO.	BY	
NOTE BOOK	PLOTTED	
AREAS CHECKED	TEMPLATE	

FINAL	SURVEYED	DATE
NO.	BY	
NOTE BOOK	PLOTTED	
AREAS CHECKED	TEMPLATE	

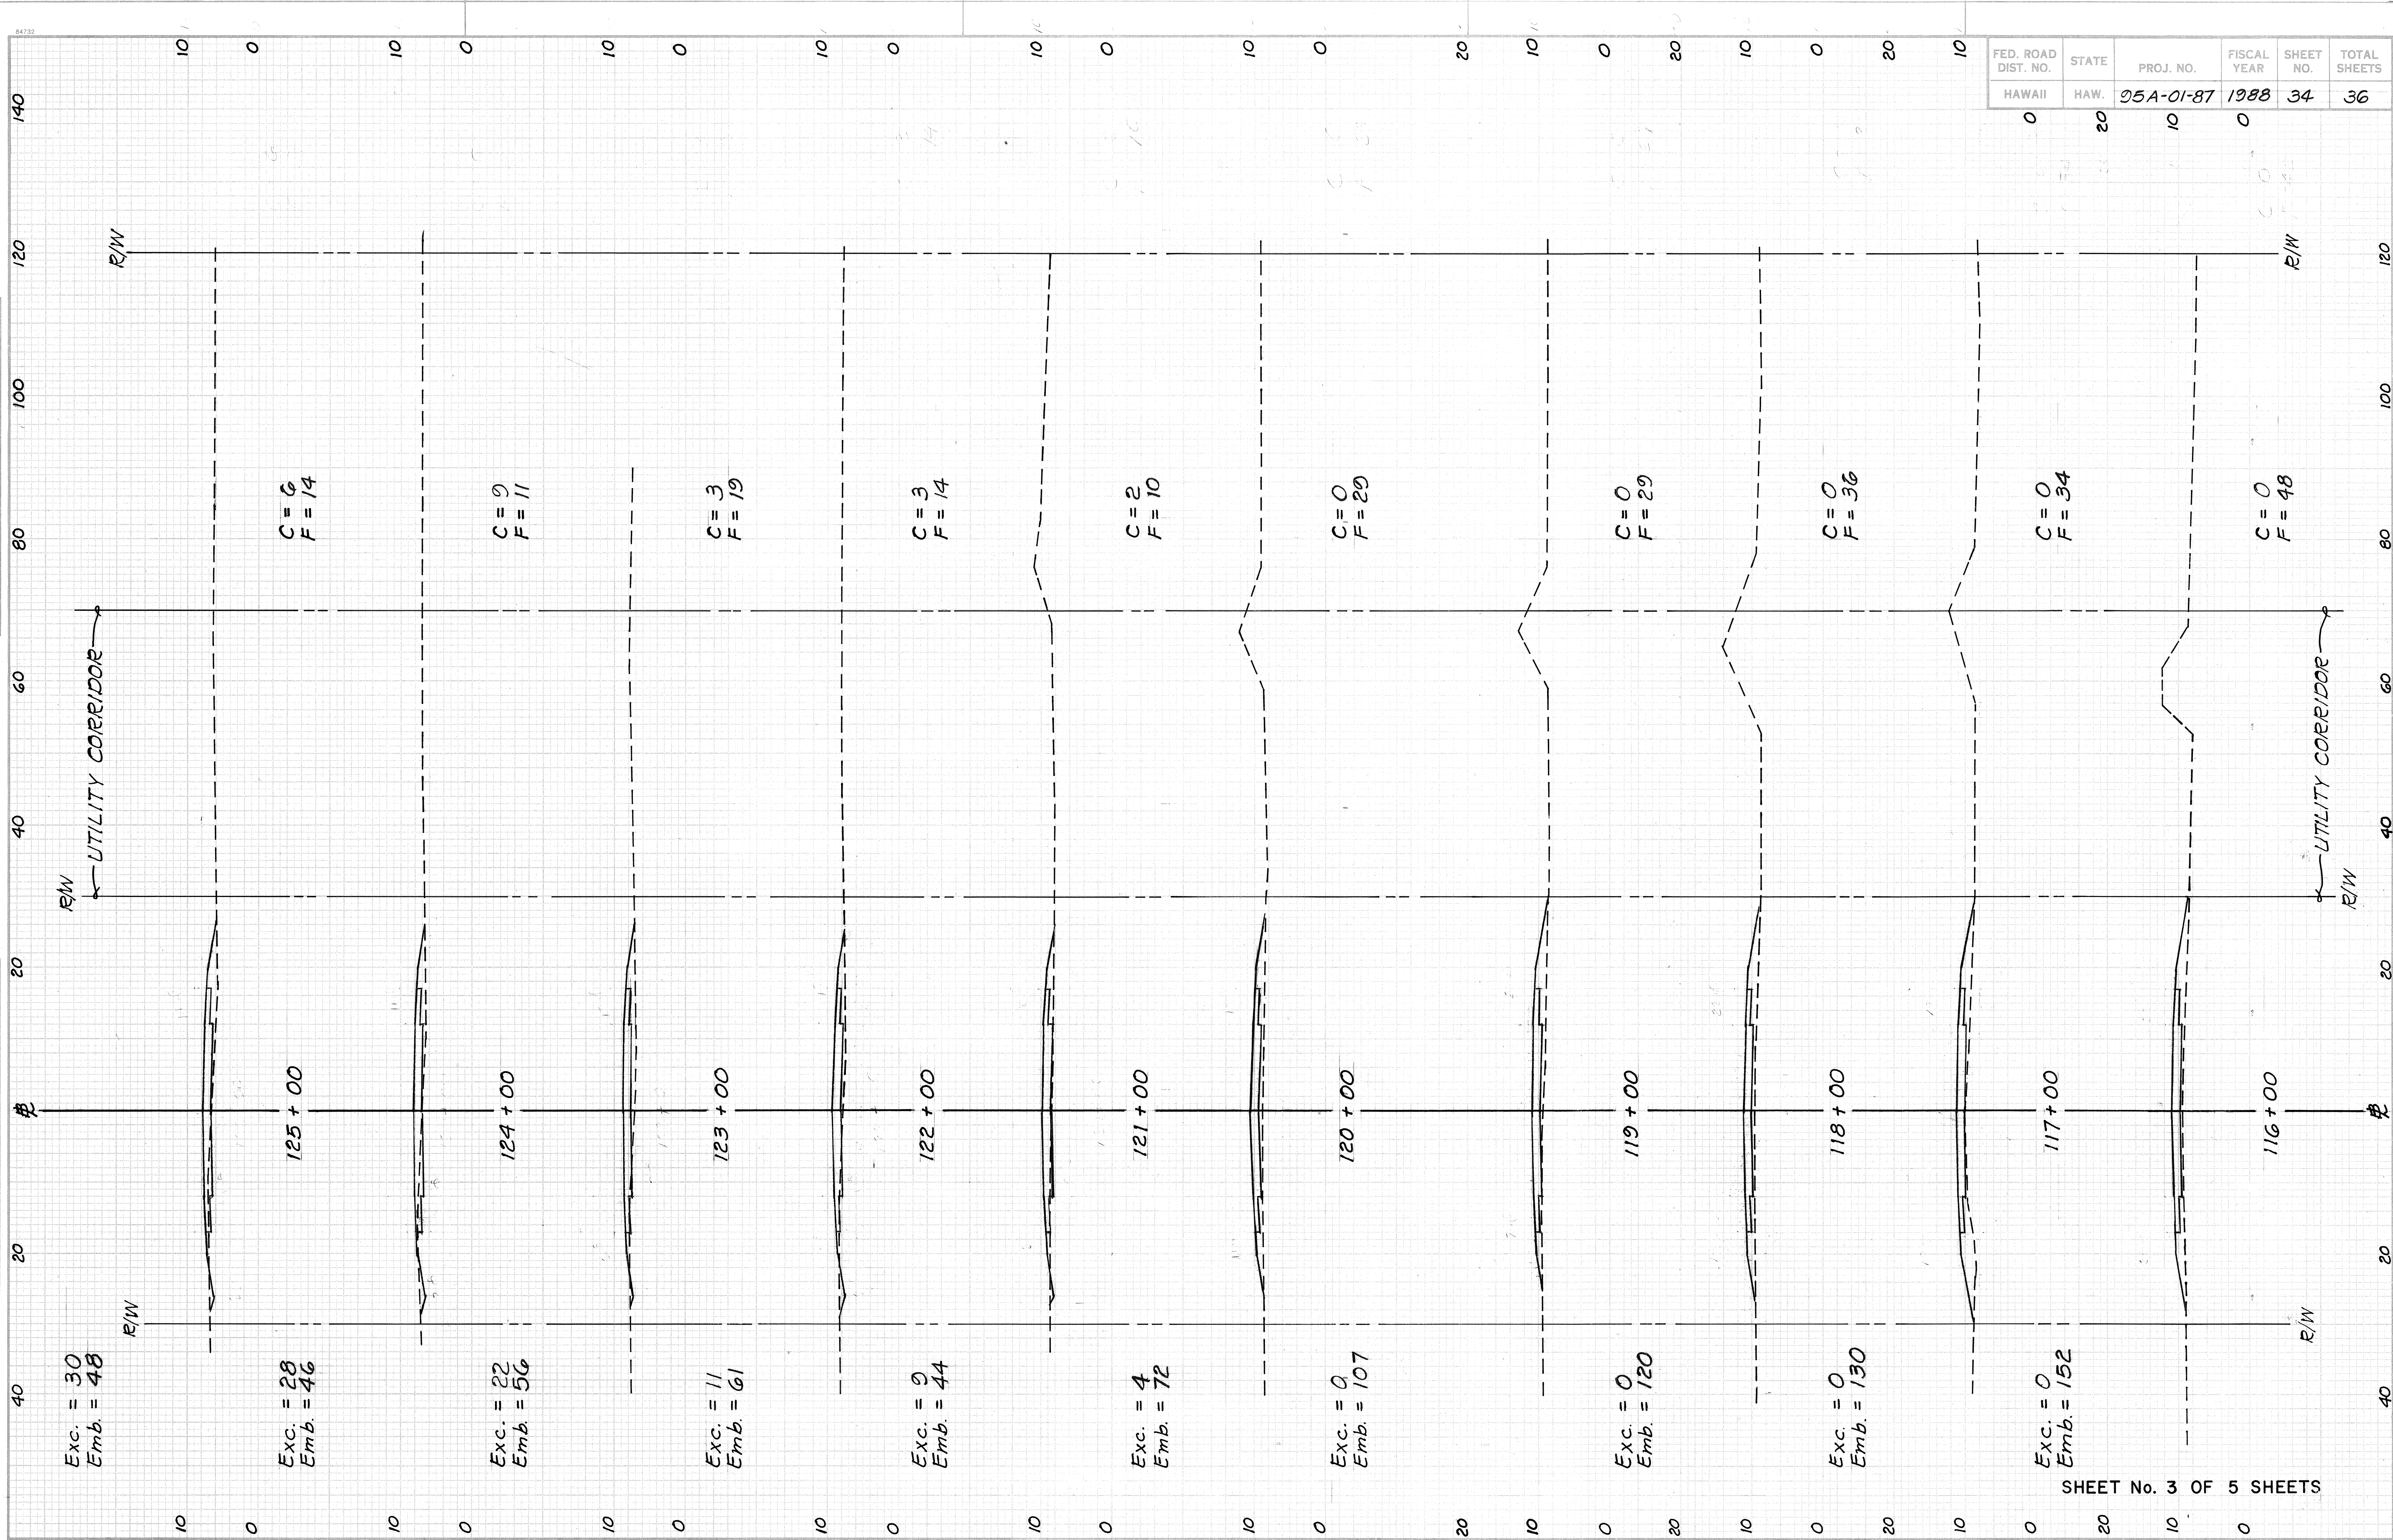


FED. ROAD DIST. NO.	STATE	PROJ. NO.	FISCAL YEAR	SHEET NO.	TOTAL SHEETS
HAWAII	HAW.	95A-01-87	1988	34	36

SHEET No. 3 OF 5 SHEETS

ORIGINAL	SURVEYED	BY	DATE
NO.	NO.		
NOTE BOOK	PLOTTED		
	DATE		
	AREAS		
	CHECKED		

FINAL	SURVEYED	BY	DATE
NO.	NO.		
NOTE BOOK	PLOTTED		
	DATE		
	AREAS		
	CHECKED		

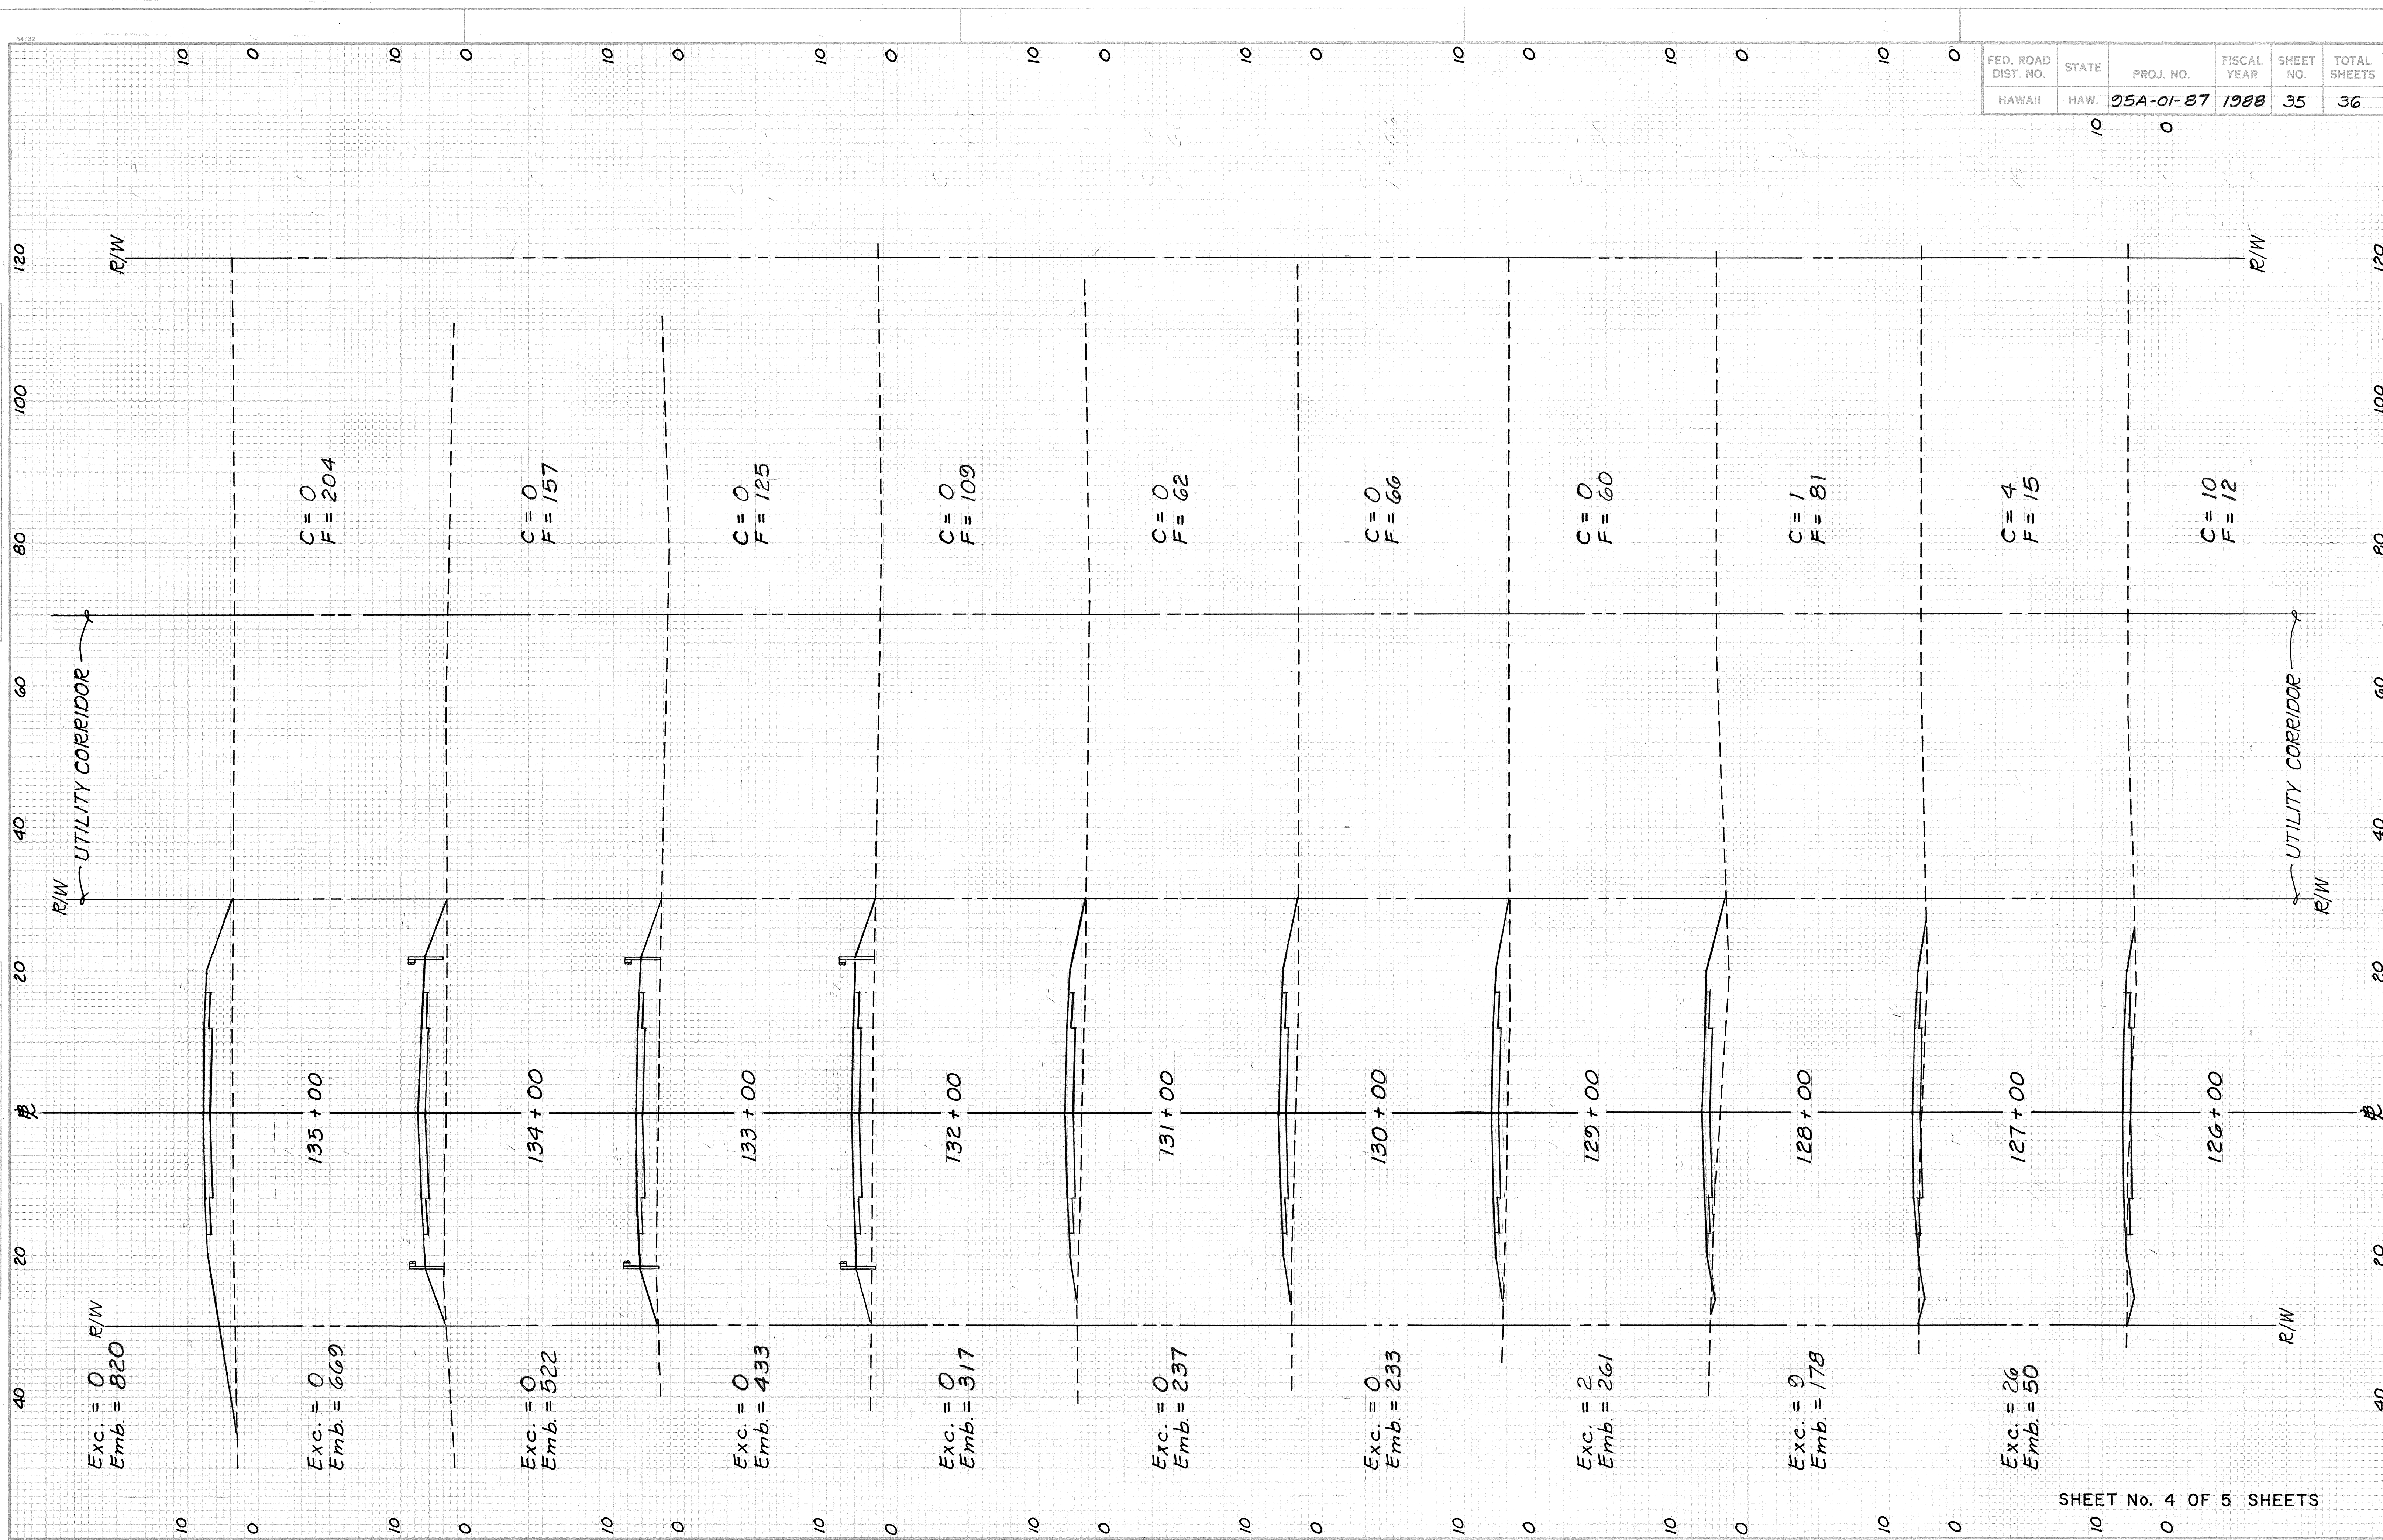

FED. ROAD DIST. NO.	STATE	PROJ. NO.	FISCAL YEAR	SHEET NO.	TOTAL SHEETS
HAWAII	HAW.	95A-01-87	1988	35	36

SHEET No. 4 OF 5 SHEETS

10 0

ORIGINAL SURVEY	SURVEYED	BY	DATE
	PLOTTED		
	TEMPLATE		
	AREAS		
NO	AREAS CHECKED		

