



FED. ROAD DIST. NO.	STATE	PROJ. NO.	FISCAL YEAR	SHEET NO.	TOTAL SHEETS
HAWAII	HAW.	95A-01-87	1988	22	36

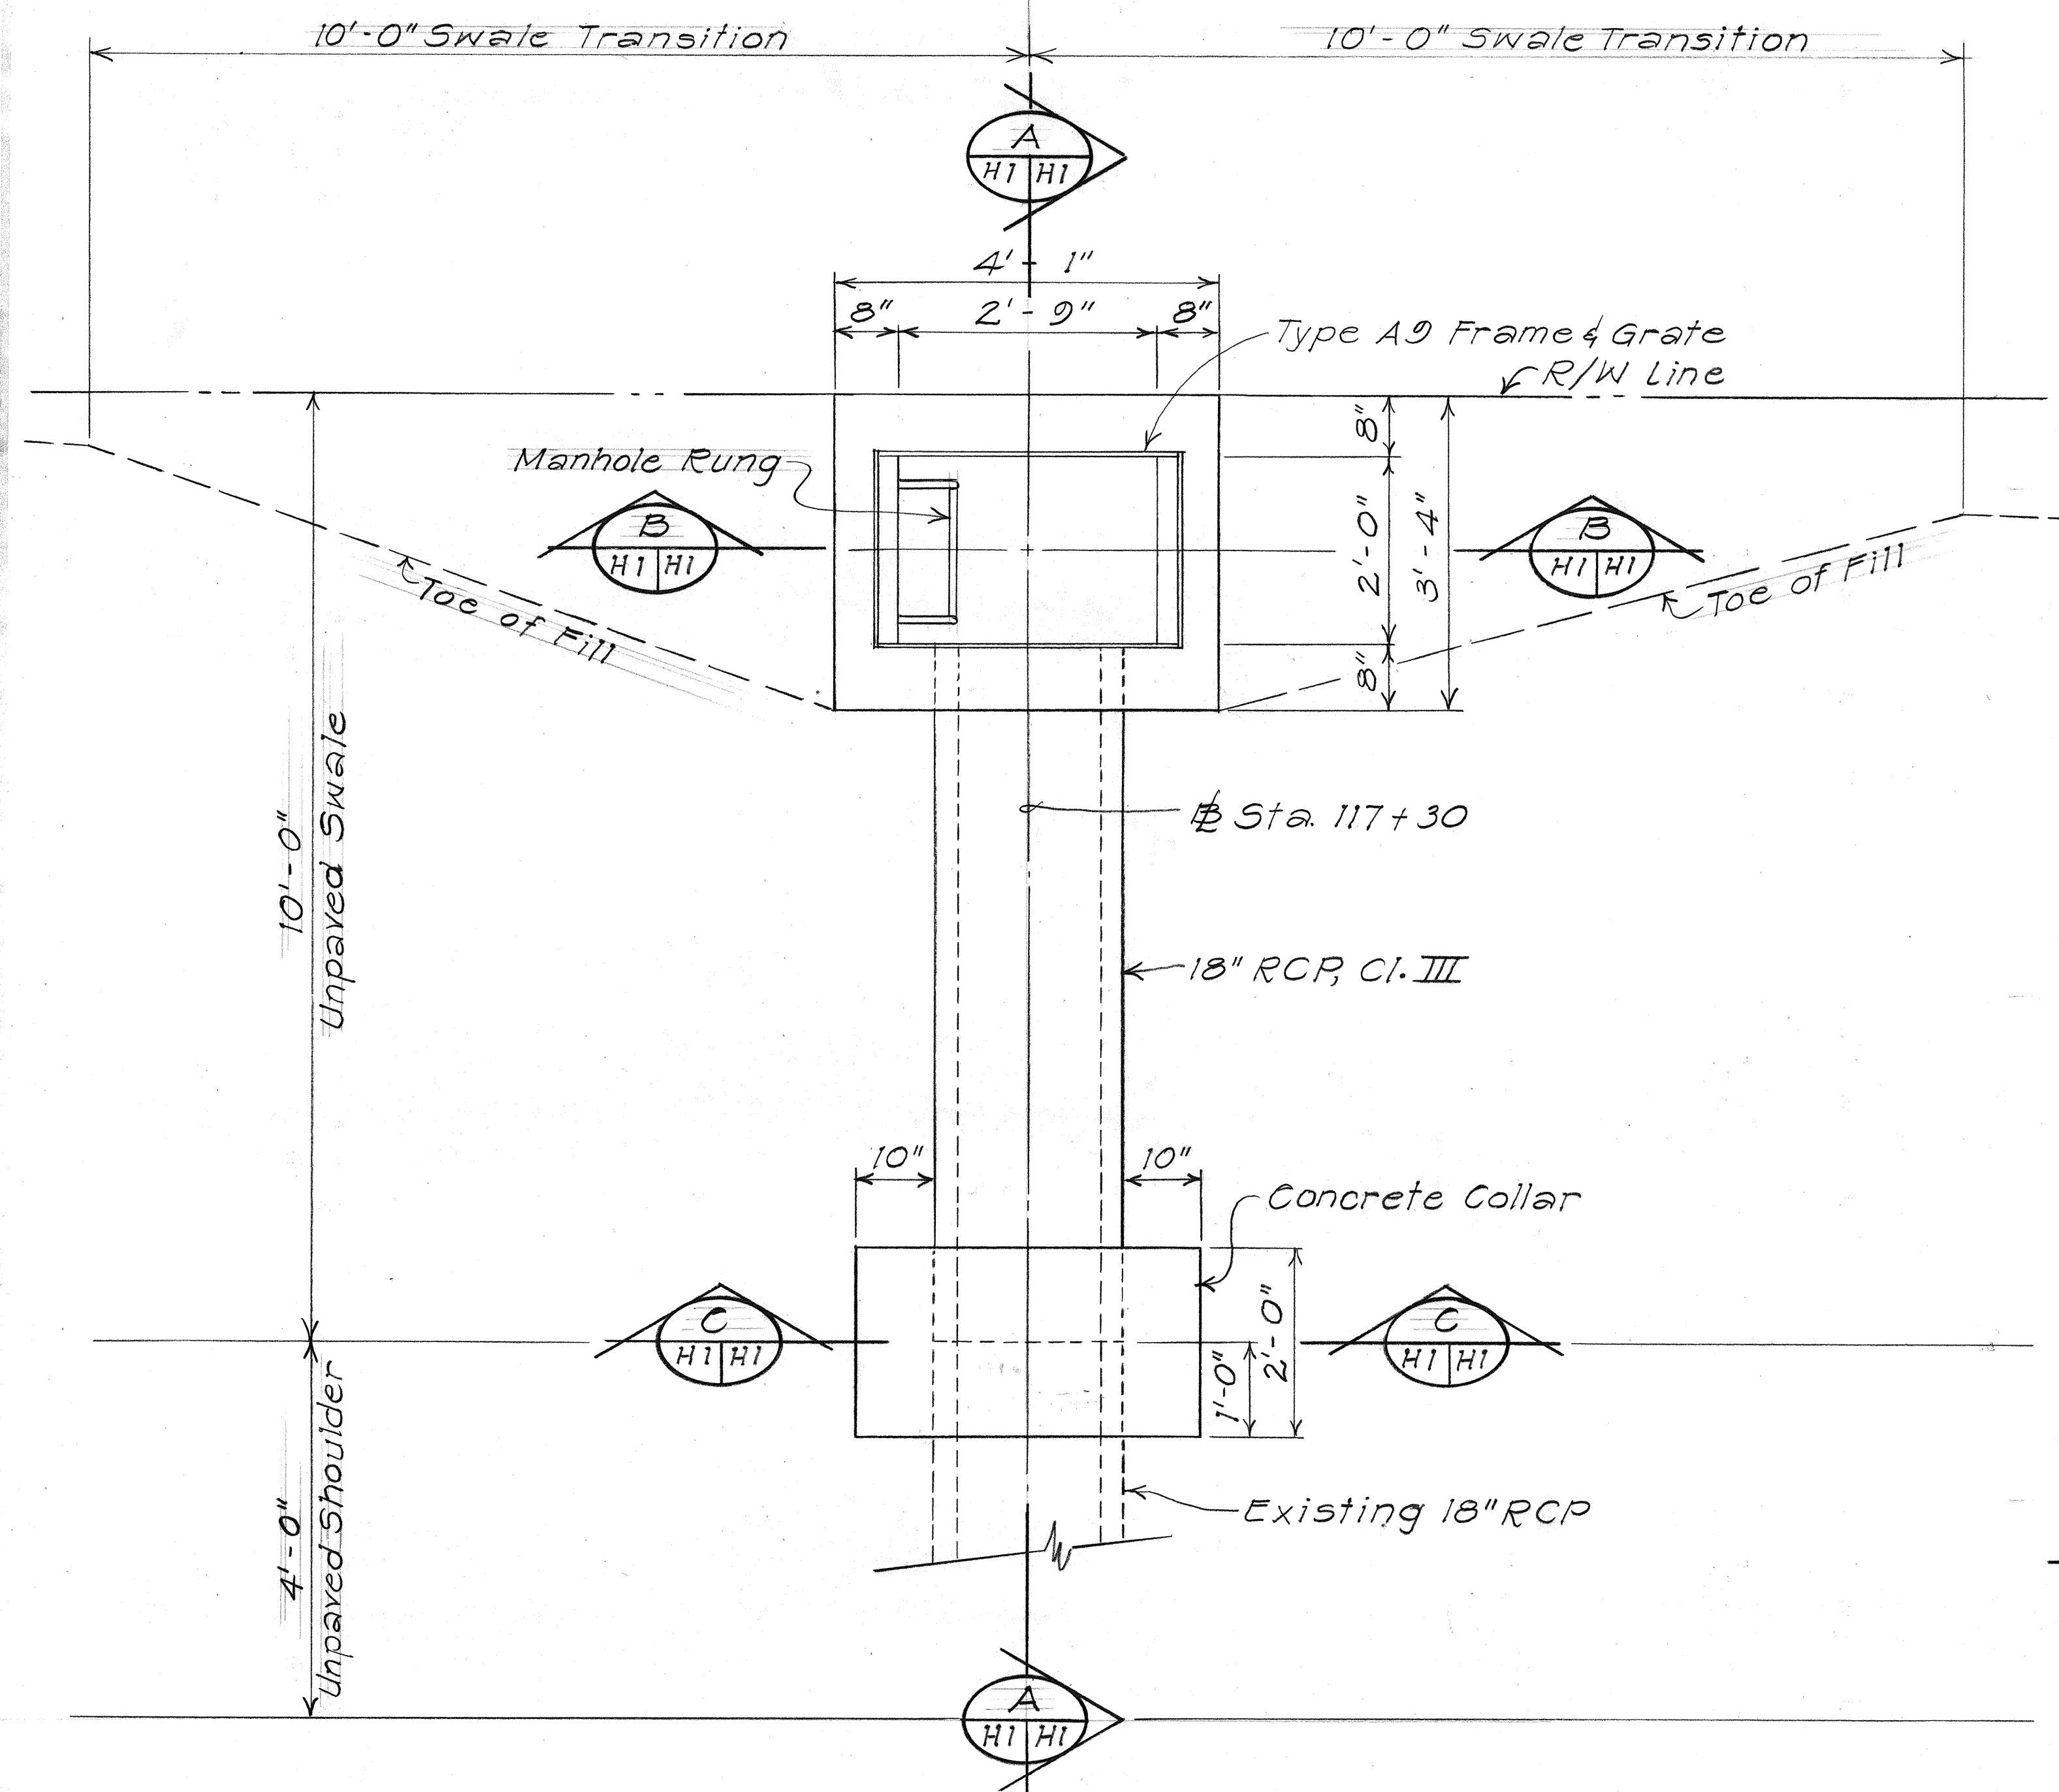


PLAN

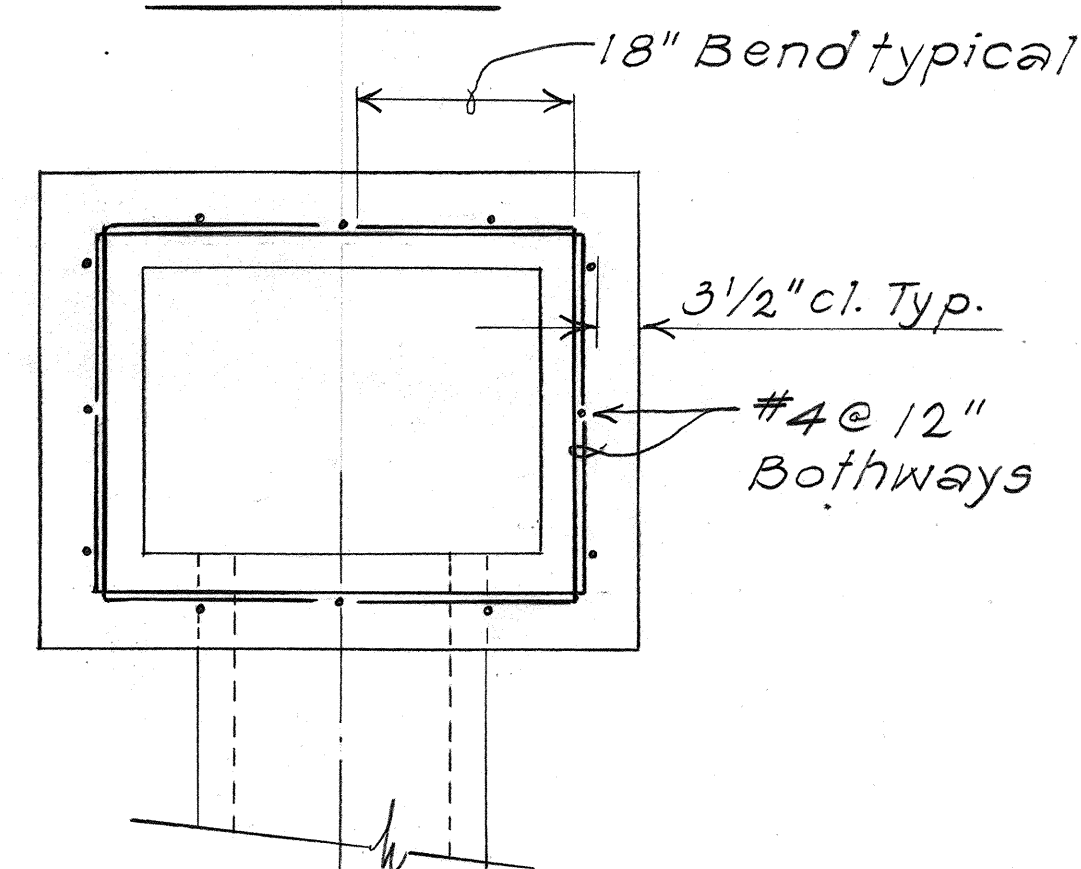


PLAN VIEW OF REINFORCING STEEL
DETAIL OF TYPE A-9 G.D.I. AT STA. 117+30±LT.


Scale: 3/4" = 1'-0"

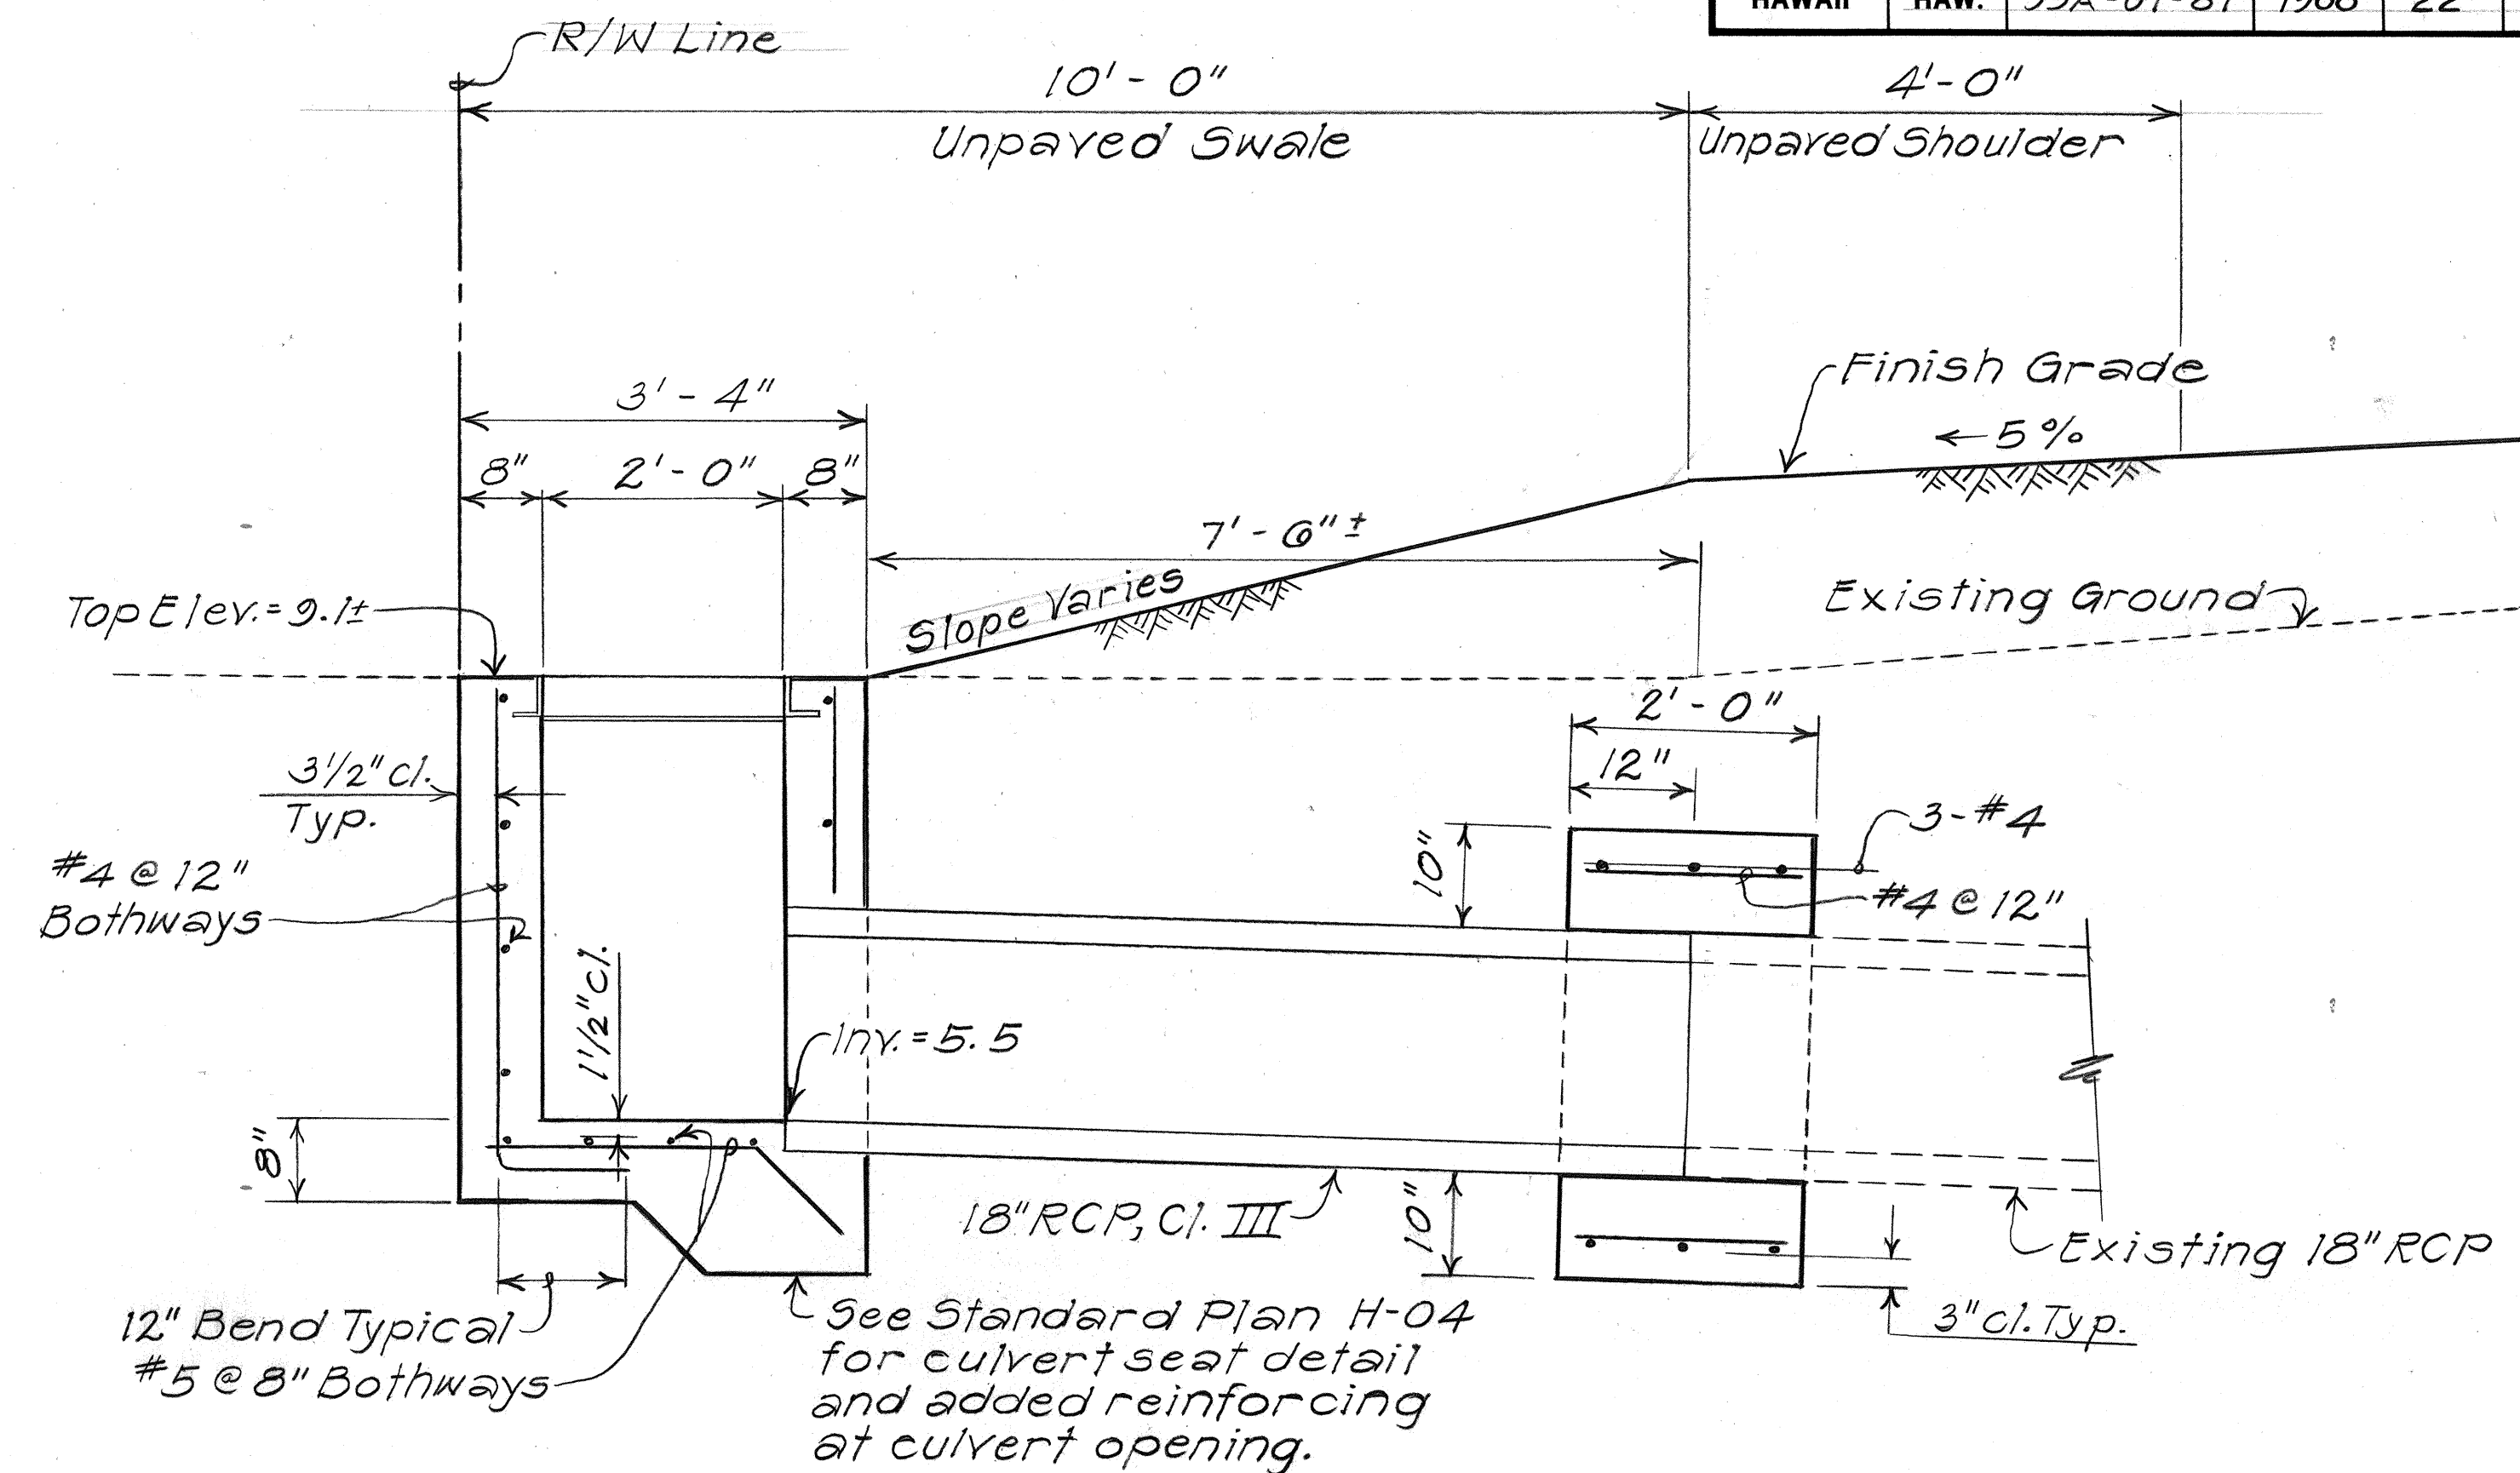

SECTION A
HI HI

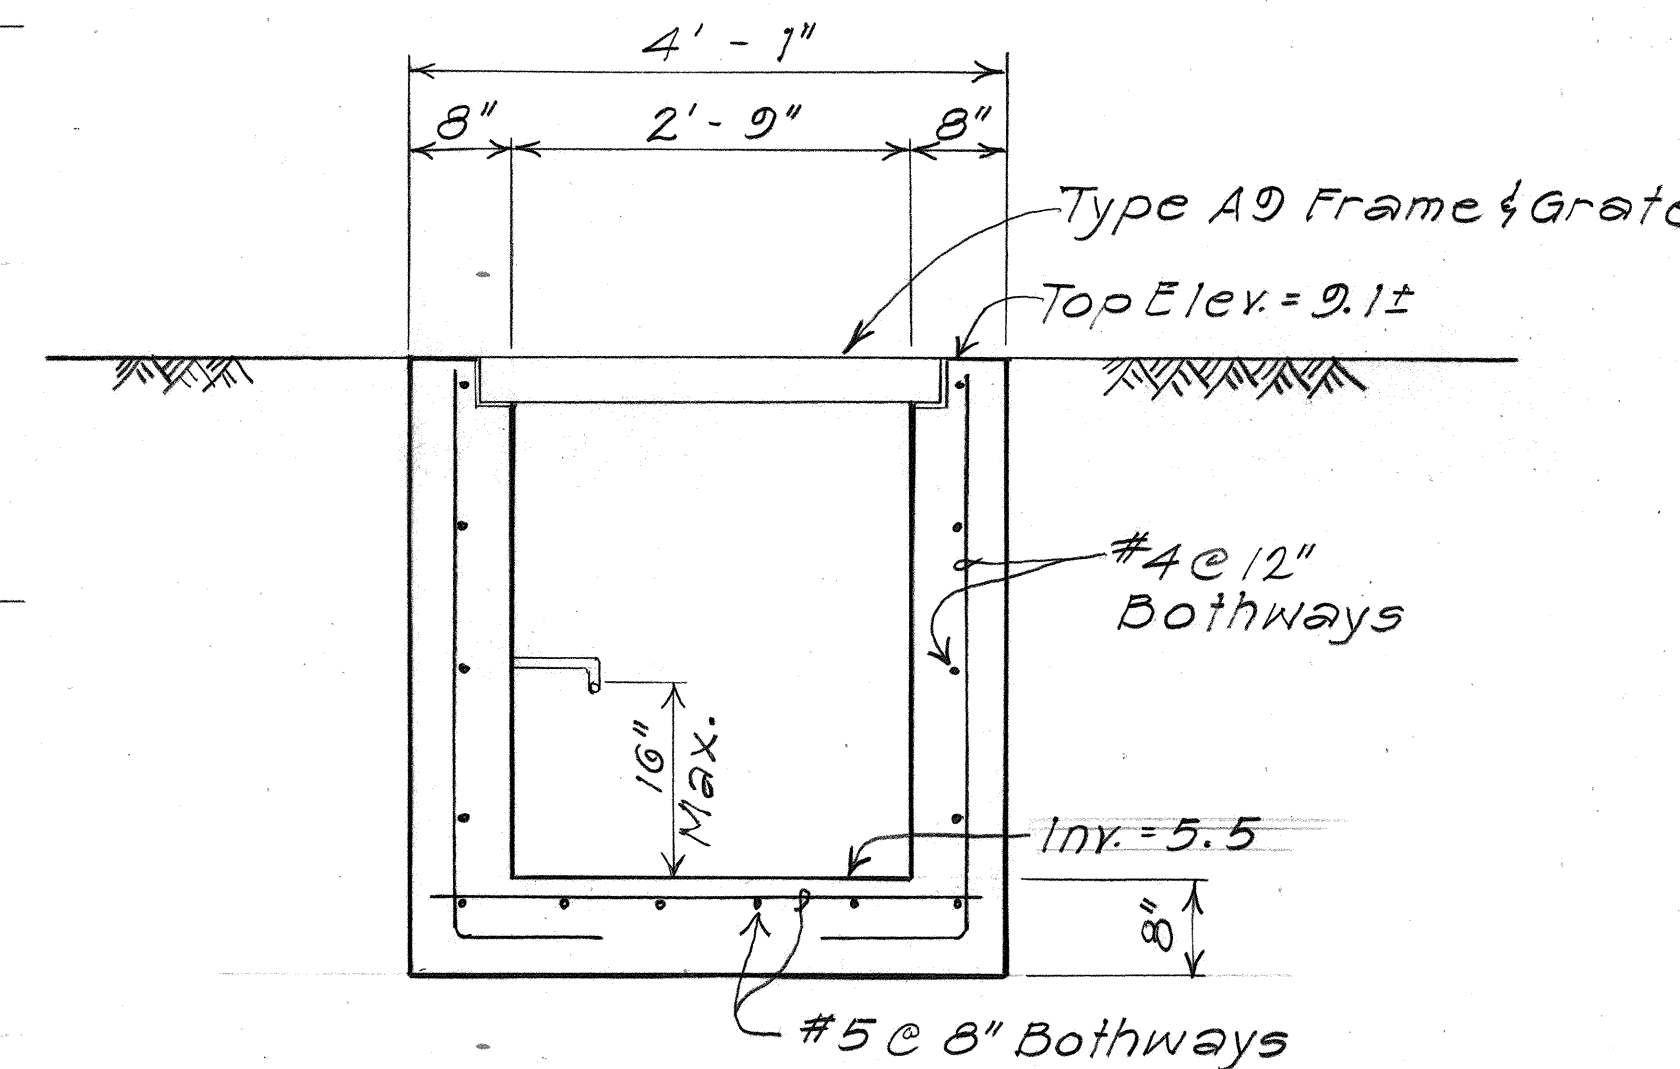

SECTION B
HI HI

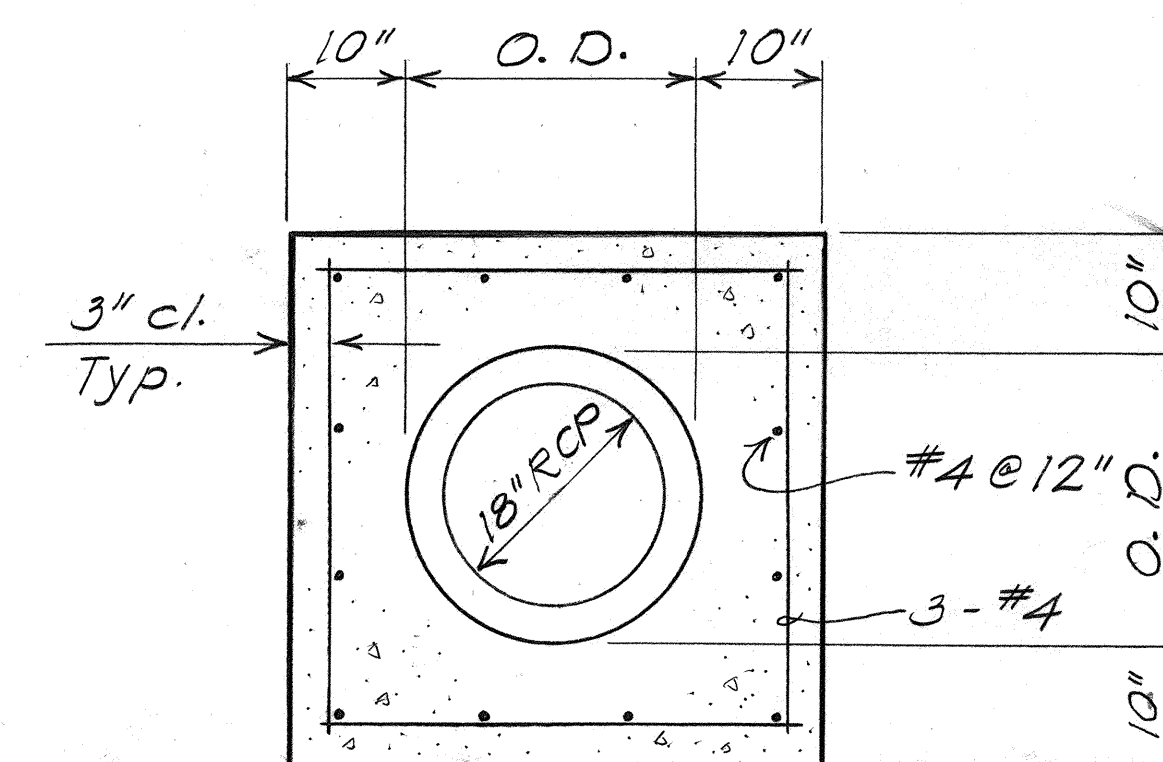

SECTION C
HI HI

STATE OF HAWAII
DEPARTMENT OF TRANSPORTATION
HIGHWAYS DIVISION

DRAINAGE DETAILS

KALAELOA BOULEVARD AND
MALAKOLE STREET IMPROVEMENTS
Project No. 95A-01-87

Scale: As Shown Date: Mar, 1988

SHEET No. 11 OF 1 SHEETS