	INDEX TO DRAWINGS
SHEET NO.	DESCRIPTION
	TITLE SHEET
2	STANDARD PLANS SUMMARY
3	GENERAL AND DRAINAGE NOTES
4 - 5	TYPICAL SECTIONS AND DETAILS
^① 6 - 15	PLANS, AND PLAN & PROFILE
16	DRIVEWAY RECONSTRUCTION PLANS
©17 - 21	20 - INCH WATER LINE
22	DRAINAGE DETAILS
23 - 31	SIGNING AND PAVEMENT MARKING PLANS AND DETAILS
32 - 36	CROSS SECTIONS

Plan Sht. Nos. © CO 15 S-1, 221 S-1 are supplementary sheets to this project. TOTAL SHEET COUNT after "AS BUILT" postings, 38 Sheets.

548-7490 PHONE

NISHIMURA P. S. & E. STATE OF HAWAII

DEPARTMENT OF TRANSPORTATION
HIGHWAYS DIVISION
HONOLULU, HAWAII

PLANS FOR

"AS-BUILT"

KALAELOA BOULEVARD


AND


MALAKOLE STREET IMPROVEMENTS

INTERSTATE ROUTE H-I TO BARBERS POINT HARBOR

PROJECT NO. 95A - 01-87

DISTRICT OF EWA ISLAND OF OAHU

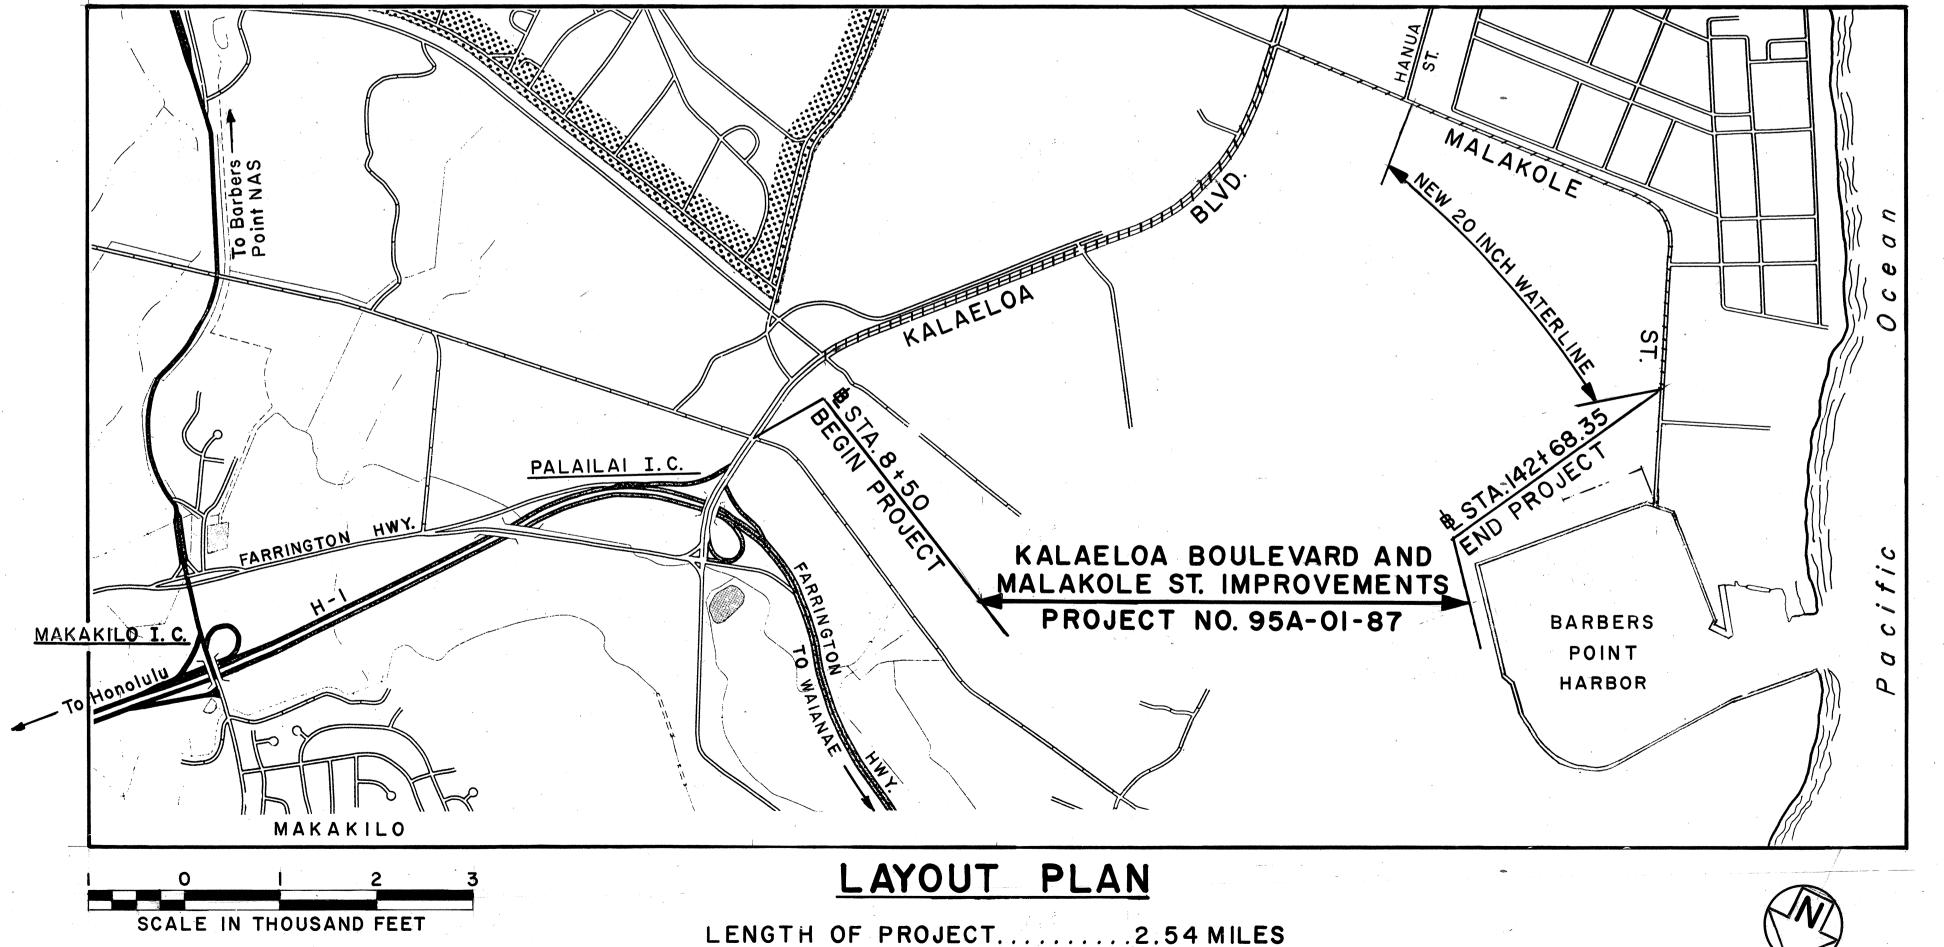

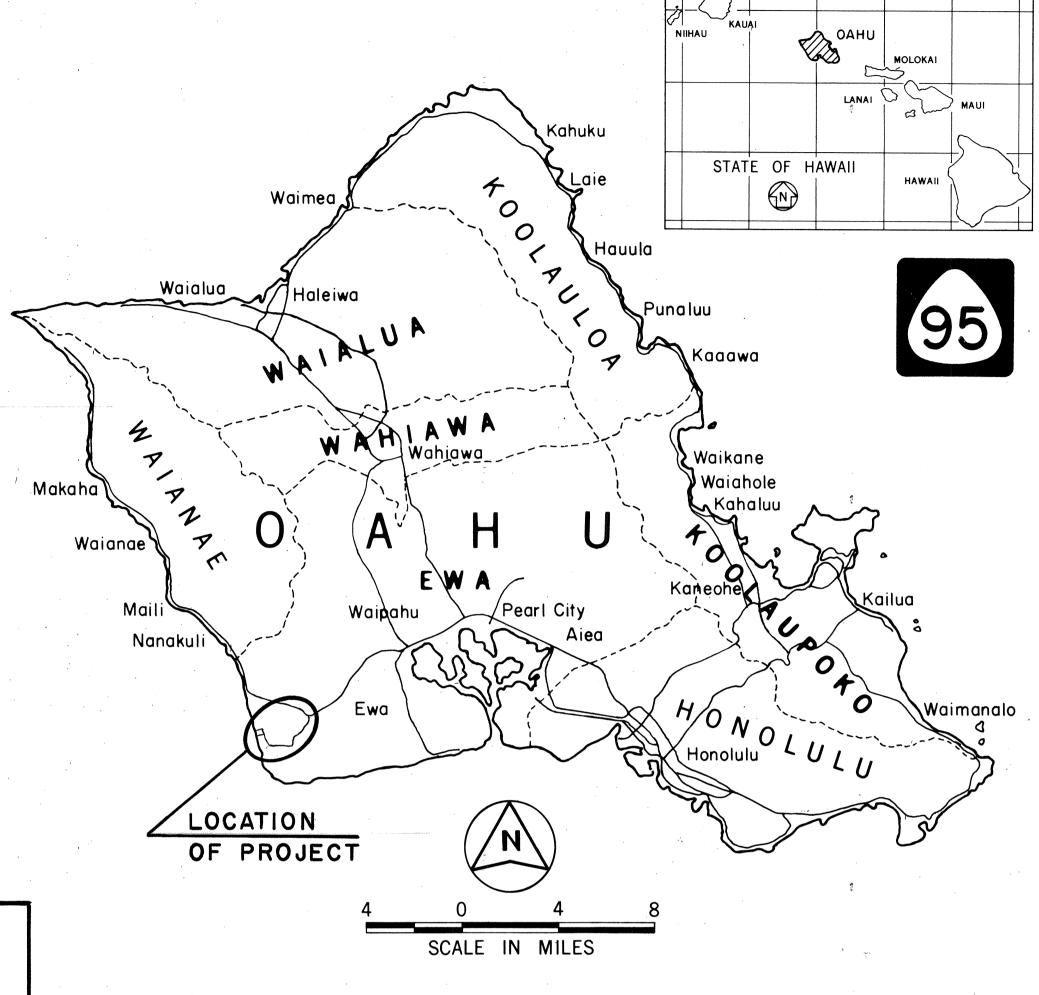

FED. ROAD DIST. NO.

STATE

PROJ. NO.

95A-01-87

CHANGES MADE DURING CONSTRUCTION HAVE
BEEN INCORPORATED ON THESE PLANS EXCEPT
CHANGES IN THE ORIGINAL THEORETICAL
QUANTITIES. FOR ACTUAL QUANTITIES, REFER TO
PROJECT LEDGER AND/OR COMPUTATION BOOK.

Michael Duriega RESIDENT ENGINEER

7/13/93 DATE

APPROVED:

G/2/88

MÁNAGER AND CHIEF ENGINEER DATE
BOARD OF WATER SUPPLY

DEPARTMENT OF TRANSPORTATION
STATE OF HAWAII

APPROVED:

LINE 5/31/18

DIR. OF TRANSPORTATION DATE

FISCAL SHEET TOTAL YEAR NO. SHEETS