



FED. ROAD DIST. NO.	STATE	FED. AID PROJ. NO.	FISCAL YEAR	SHEET	TOTAL SHEETS
HAWAII	HAW	F-098-1(1) UNIT 2	1956	5	70

PLAN
NOTES:
1. ALL DIMENSIONS IN FEET AND INCHES.
2. ALL DIMENSIONS TO CENTERLINE UNLESS OTHERWISE NOTED.
3. ALL DIMENSIONS TO FACE UNLESS OTHERWISE NOTED.
4. ALL DIMENSIONS TO CENTERLINE UNLESS OTHERWISE NOTED.
5. ALL DIMENSIONS TO FACE UNLESS OTHERWISE NOTED.

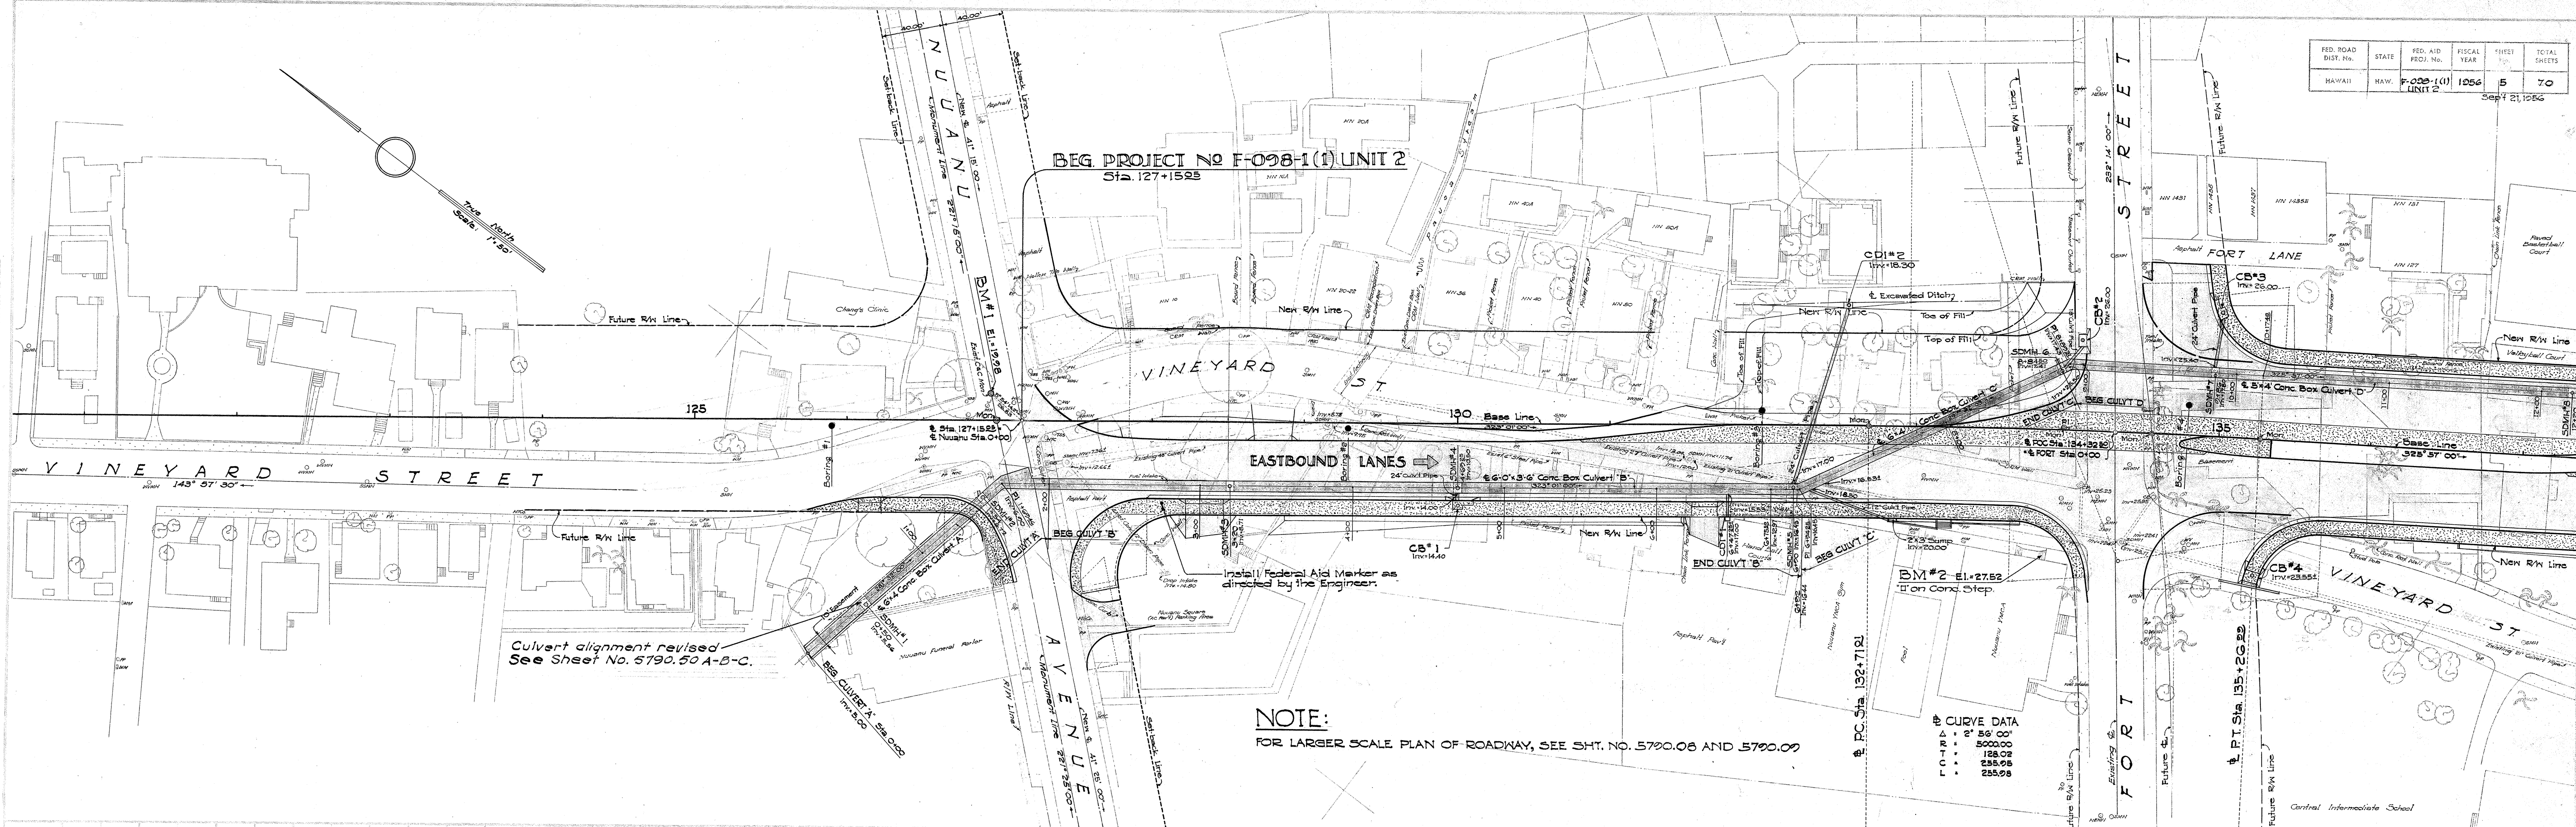

PROFILE
NOTES:
1. ALL DIMENSIONS IN FEET AND INCHES.
2. ALL DIMENSIONS TO CENTERLINE UNLESS OTHERWISE NOTED.
3. ALL DIMENSIONS TO FACE UNLESS OTHERWISE NOTED.
4. ALL DIMENSIONS TO CENTERLINE UNLESS OTHERWISE NOTED.
5. ALL DIMENSIONS TO FACE UNLESS OTHERWISE NOTED.

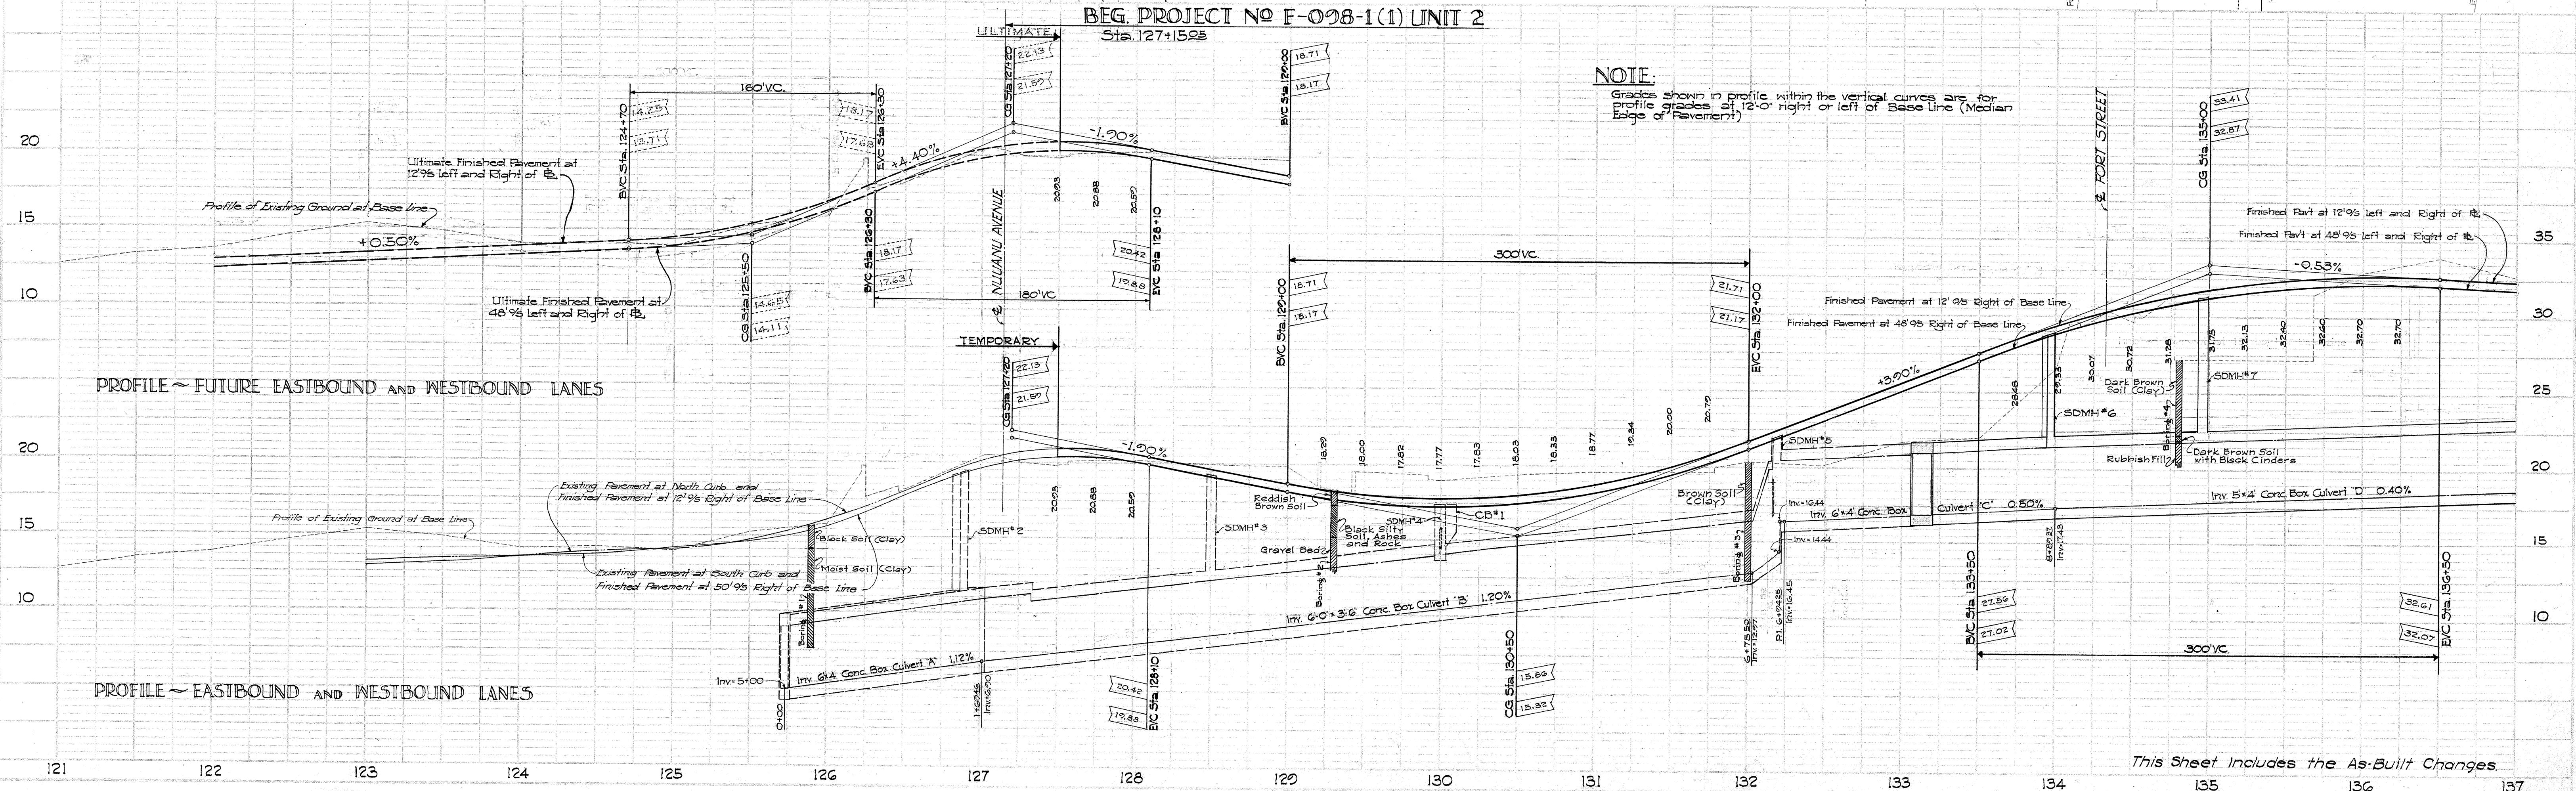


This Sheet Includes the As-Built Changes.

5790.05


FED. ROAD DIST. No.	STATE	FED. AID PROJ. No.	FISCAL YEAR	SHEET No.	TOTAL SHEETS
HAWAII	HAW.	F-098-1(V) UNIT 2	1956	7	70

Sept 21, 1956

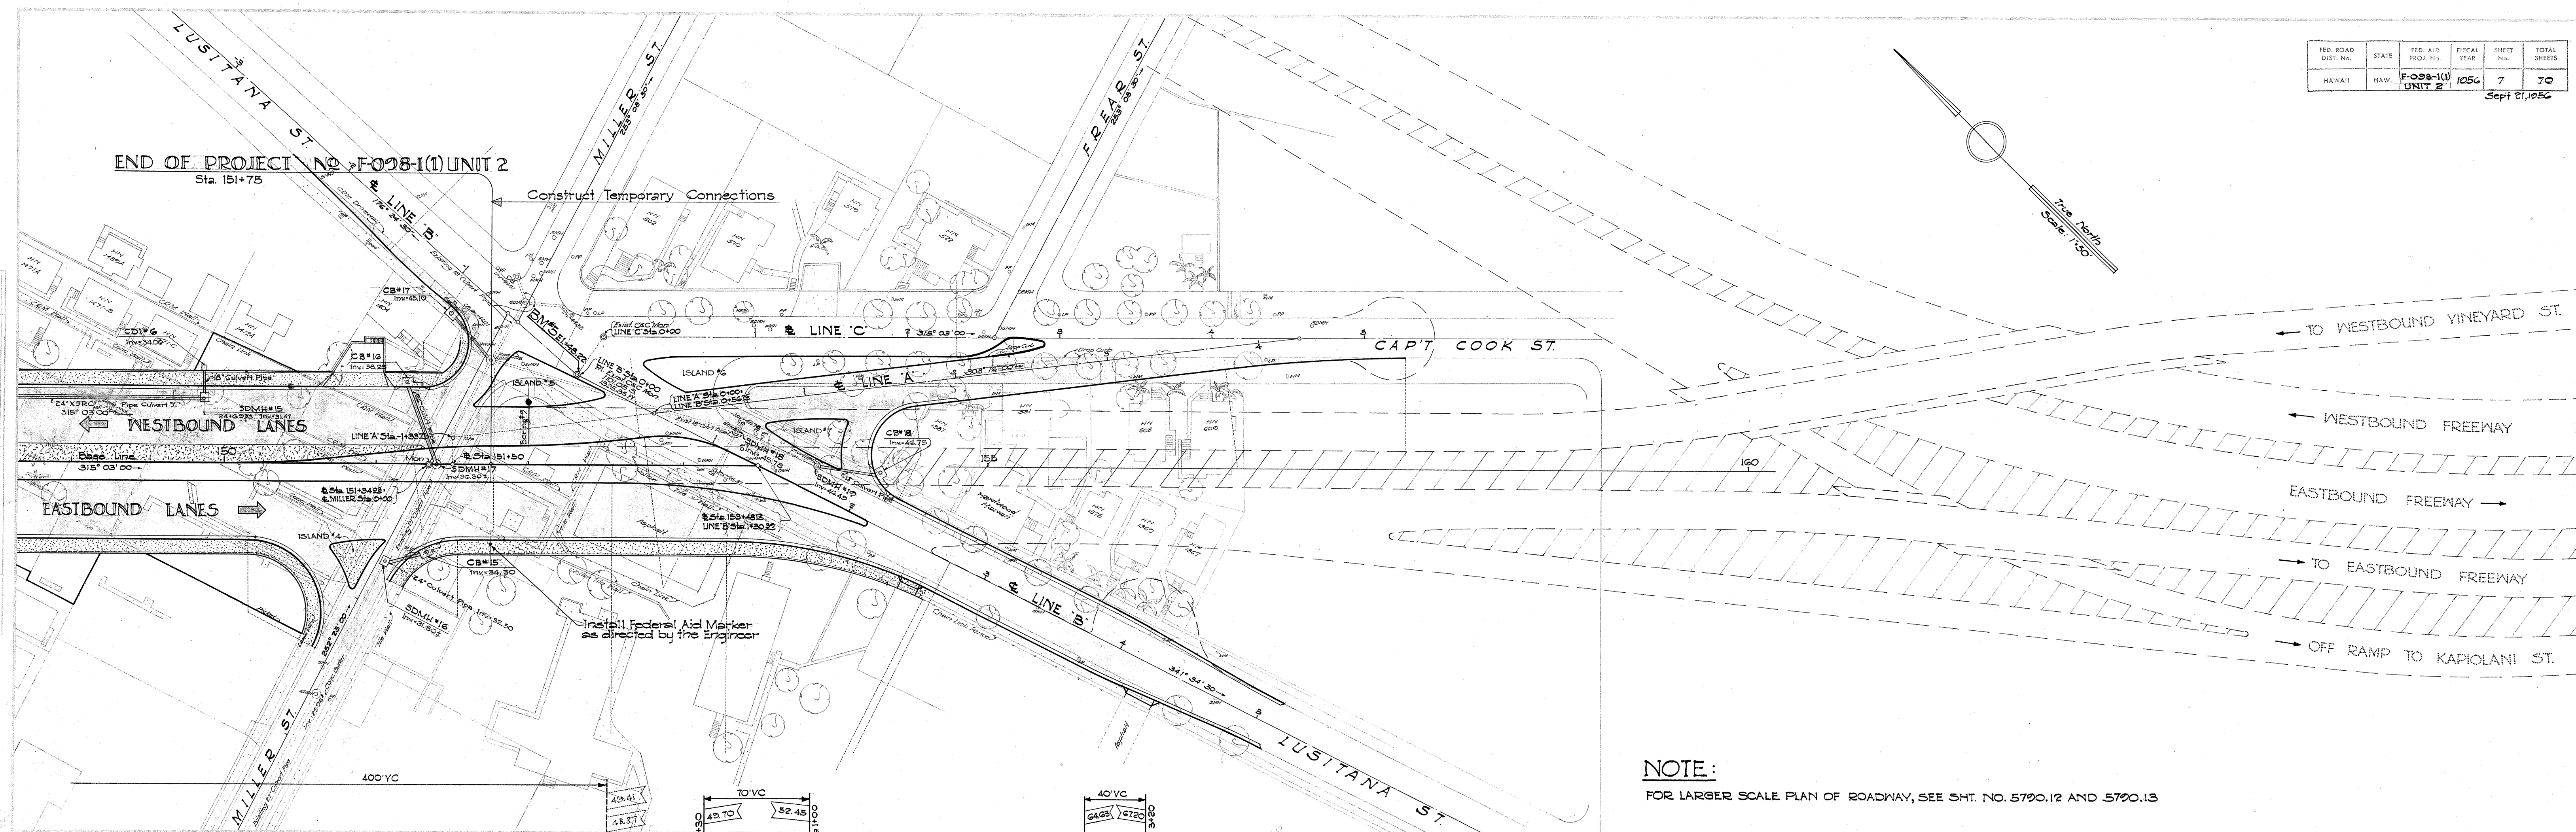

NOTE:

FOR LARGER SCALE PLAN OF ROADWAY, SEE SHT. NO. 5790.12 AND 5790.13

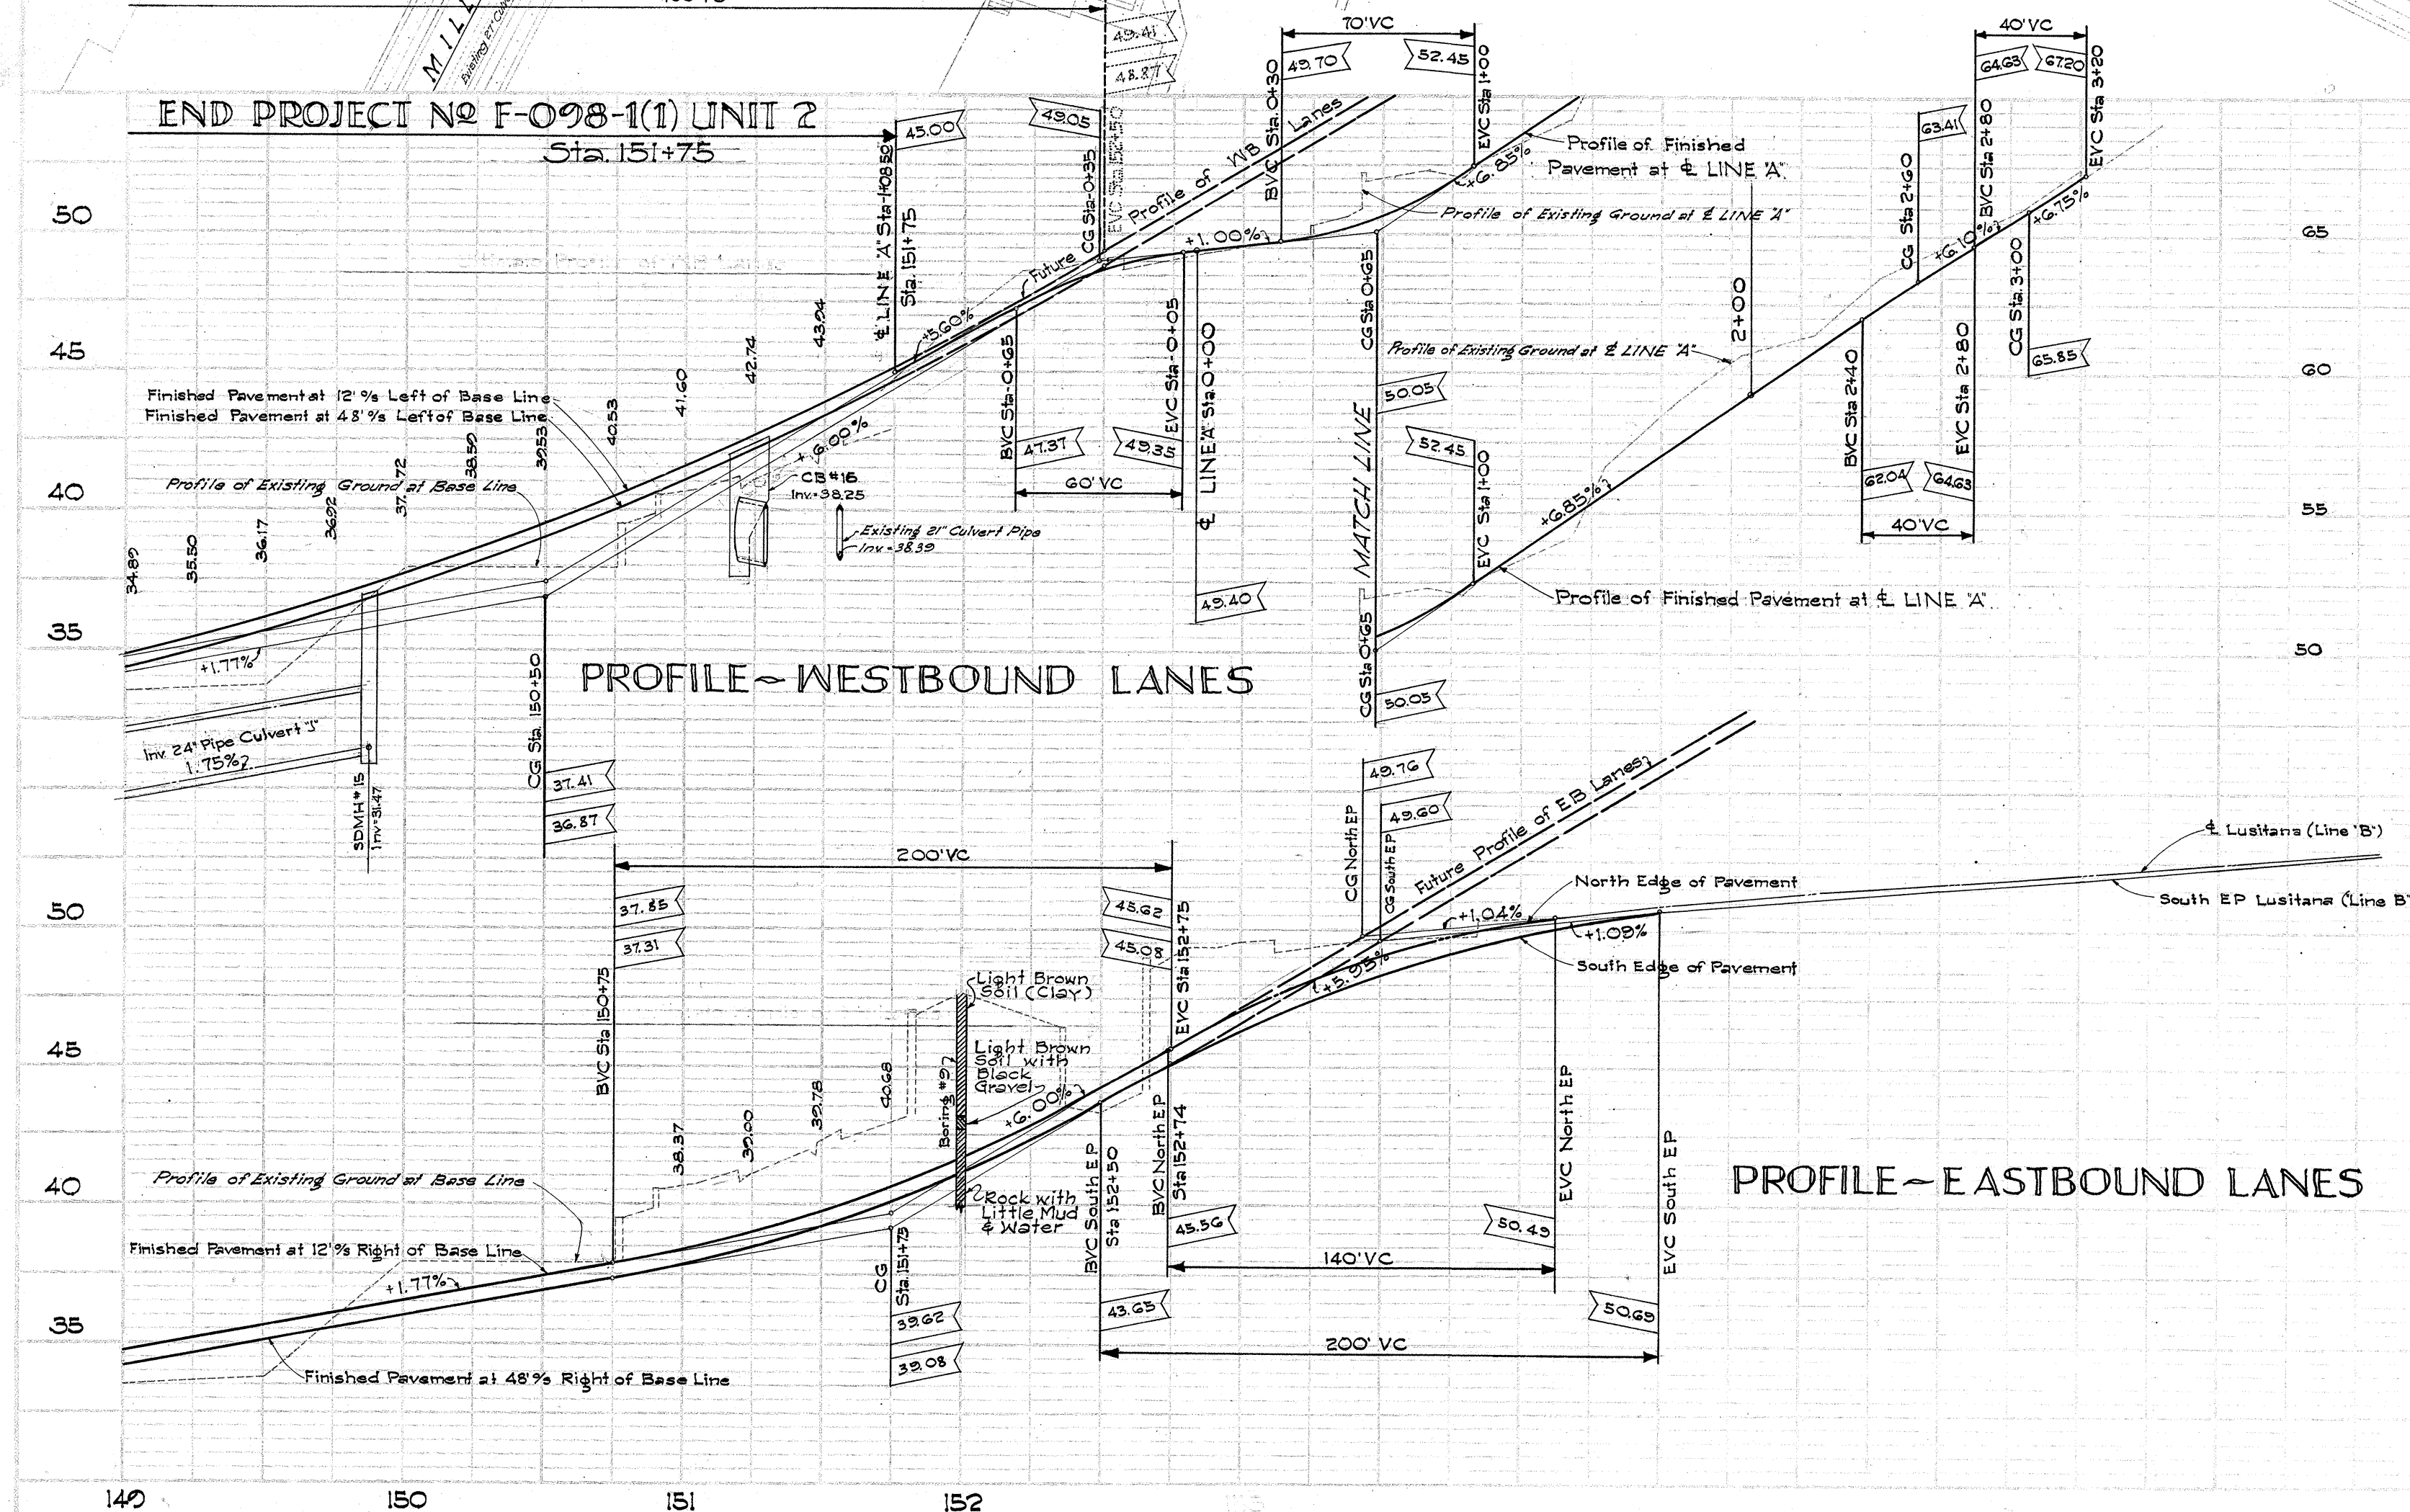

No As-Built Changes on this Sheet.

5790.07