




FED. ROAD DIST. NO.	STATE	FED. AID PROJ. NO.	FISCAL YEAR	SHEET NO.	TOTAL SHEETS
HAWAII	HAW.	F098-1(1)	1956	2	70

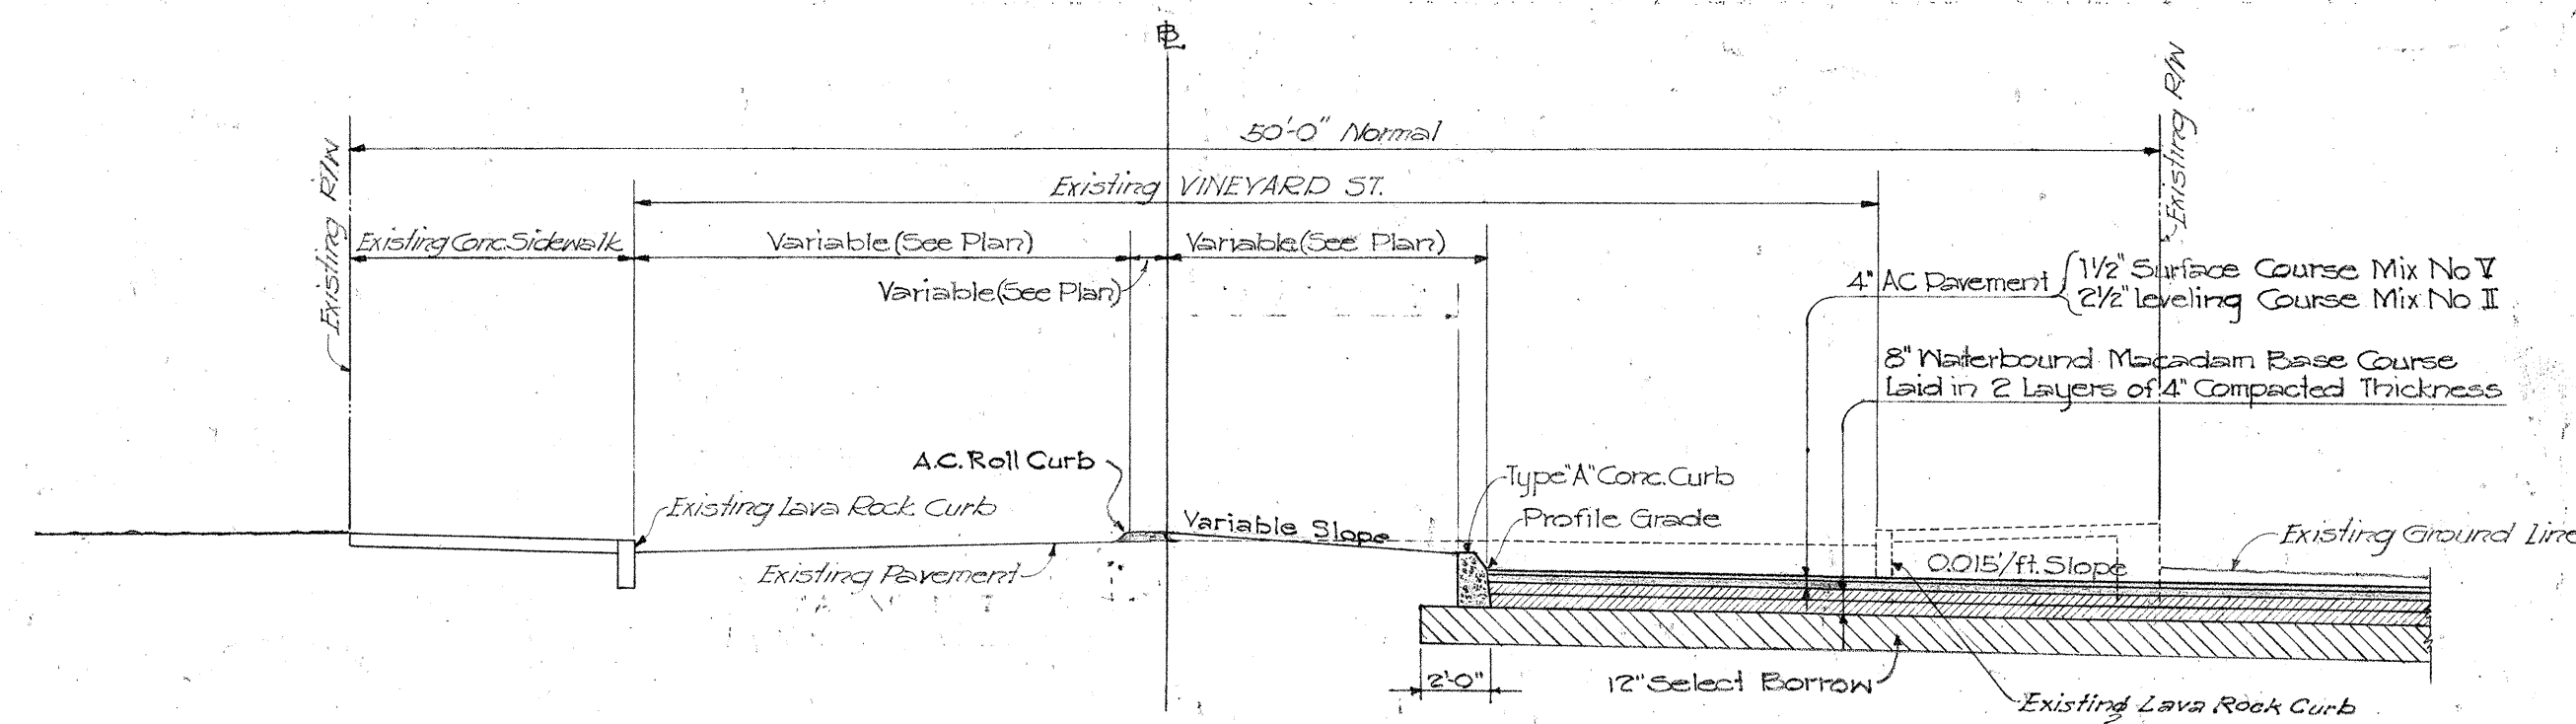


TYPICAL SECTION ~ STA. 131+00±
Scale: 3/16"=1'-0"

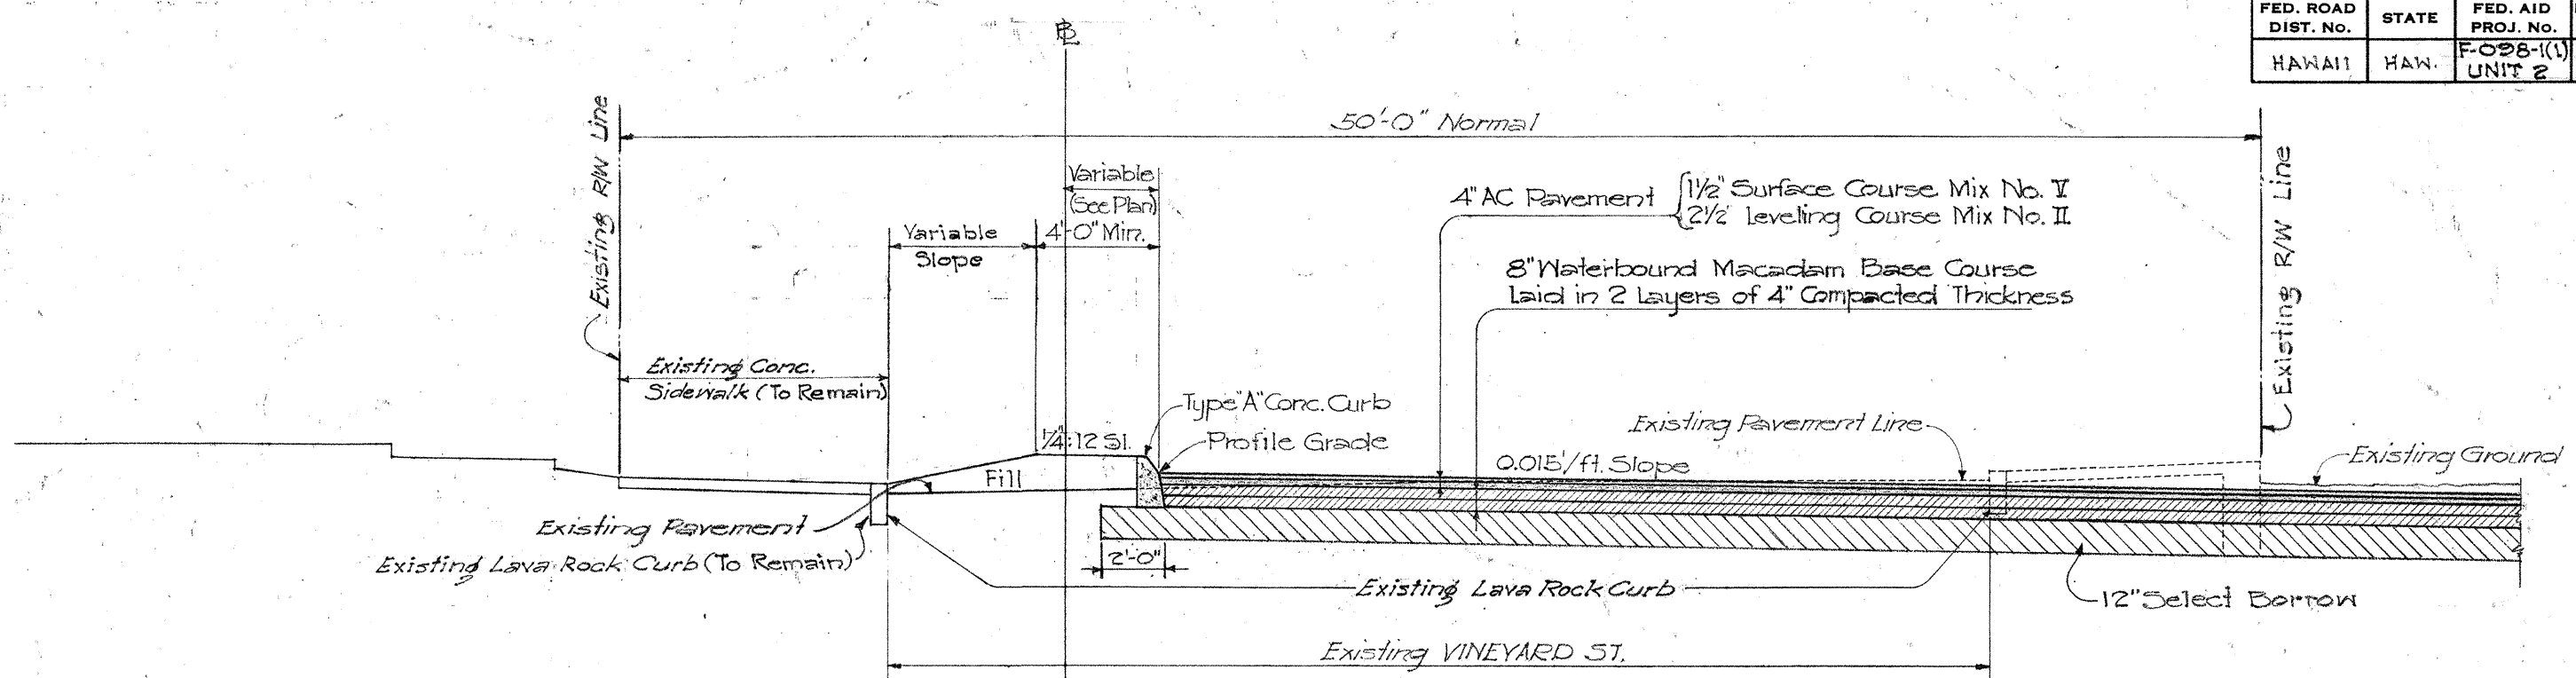


TYPICAL SECTION ~ STA. 131+50±
Scale: 3/16"=1'-0"

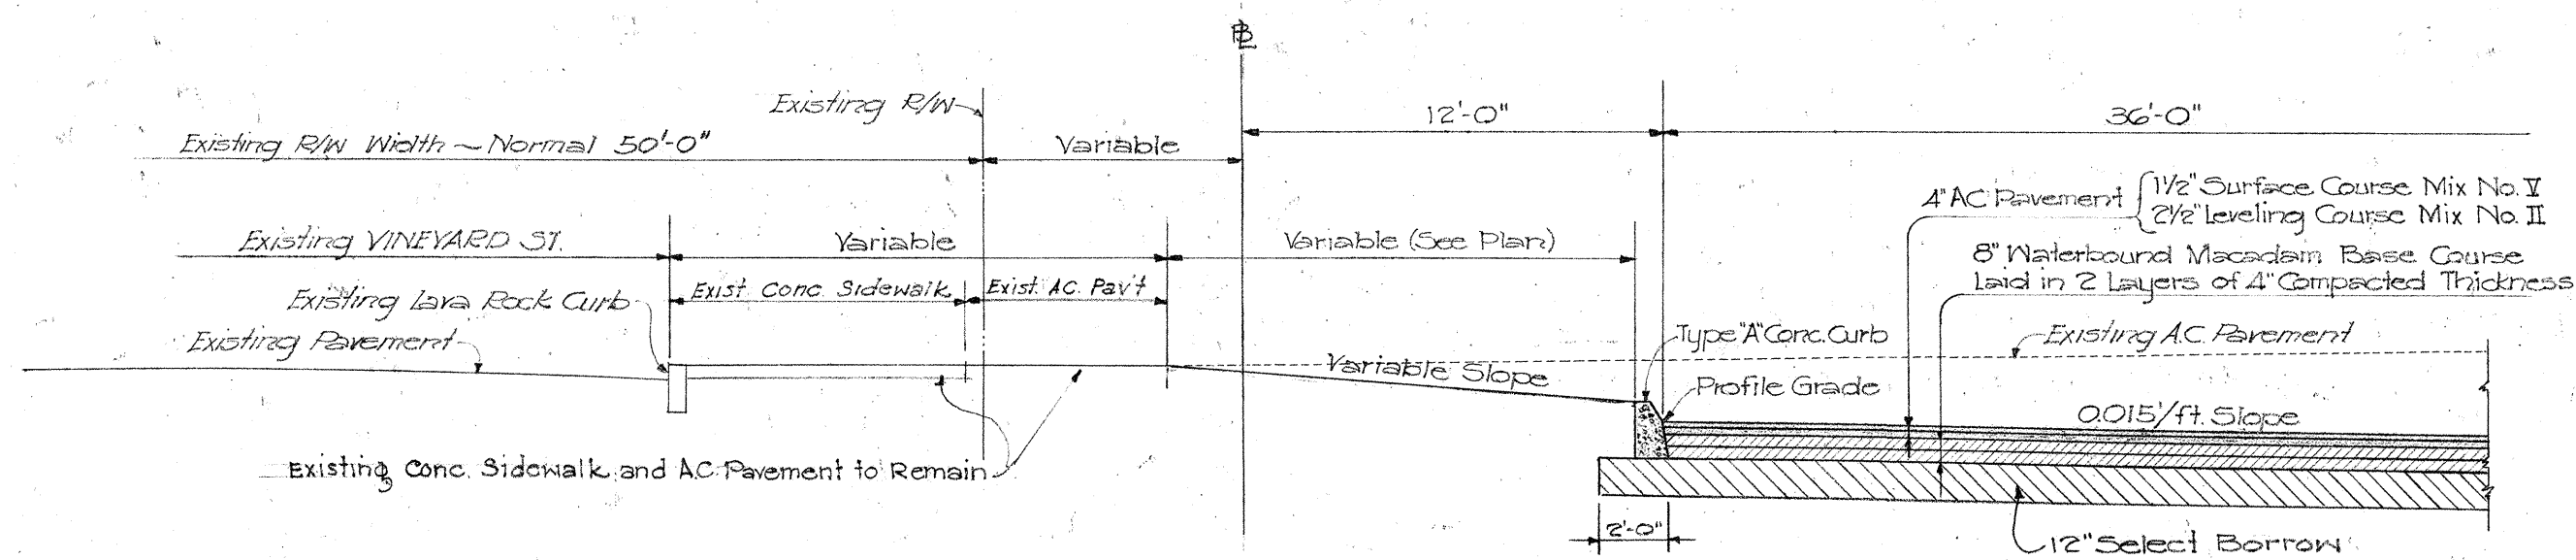


TYPICAL SECTION ~ STA. 129+00±
Scale: 3/16"=1'-0"

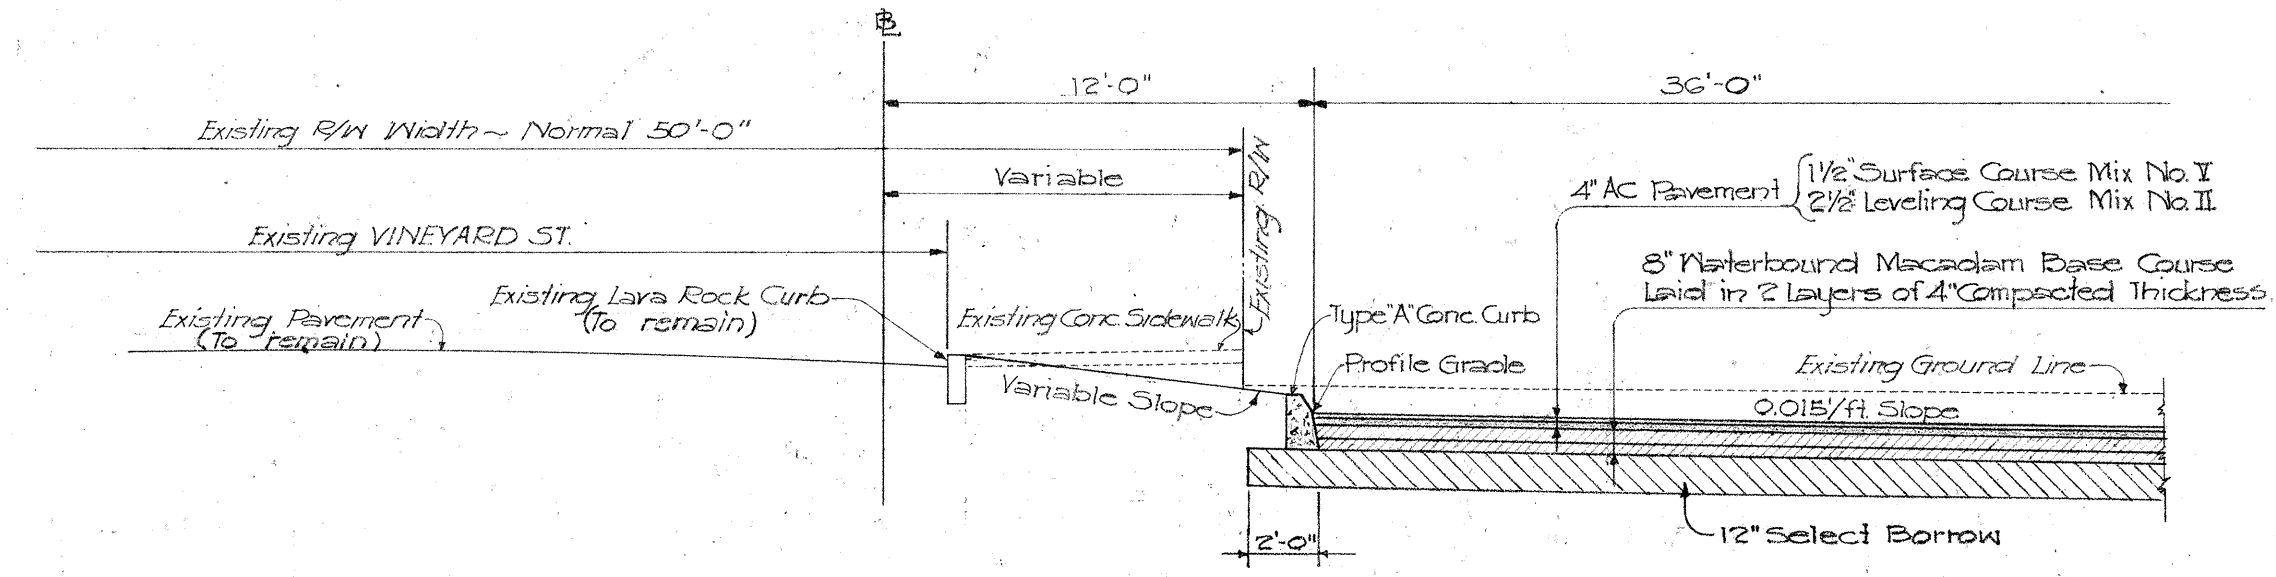

TYPICAL SECTION ~ STA. 130+00±
Scale: 3/16"=1'-0"

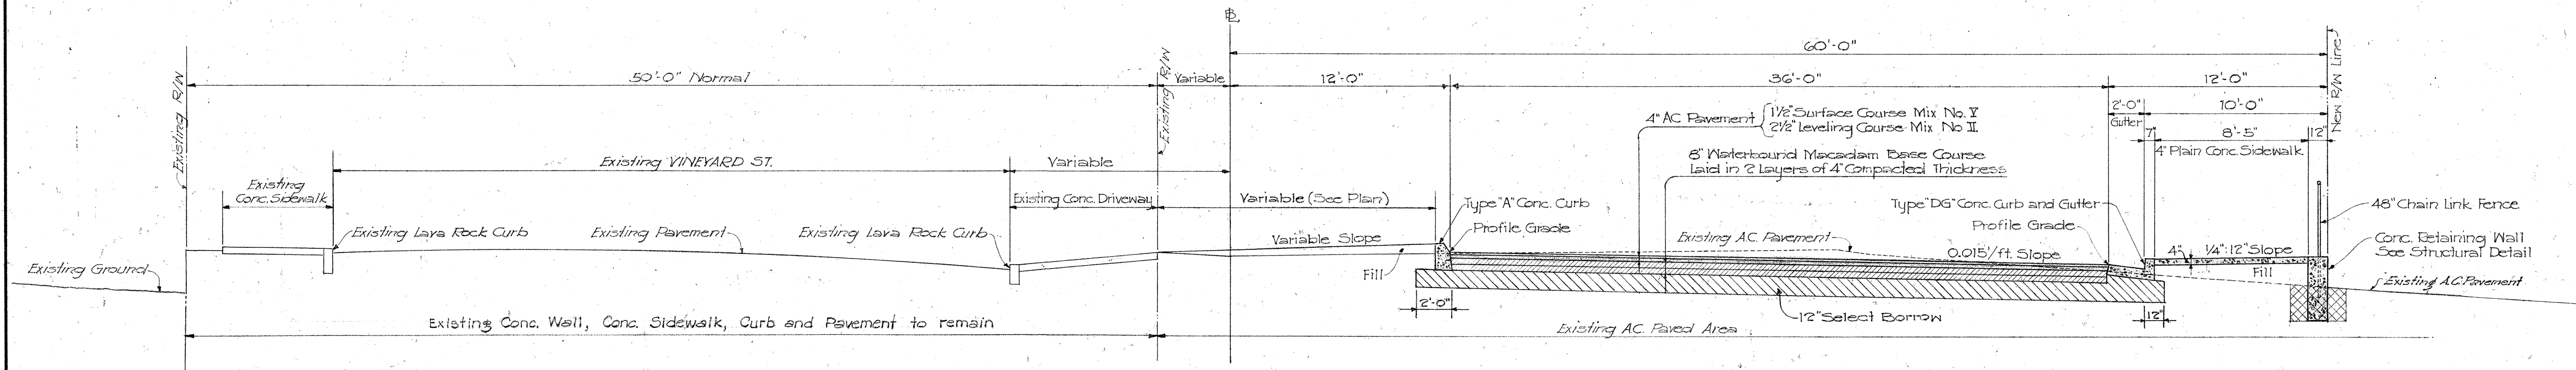

TYPICAL SECTION ~ STA. 128+00±
Scale: 3/16"=1'-0"

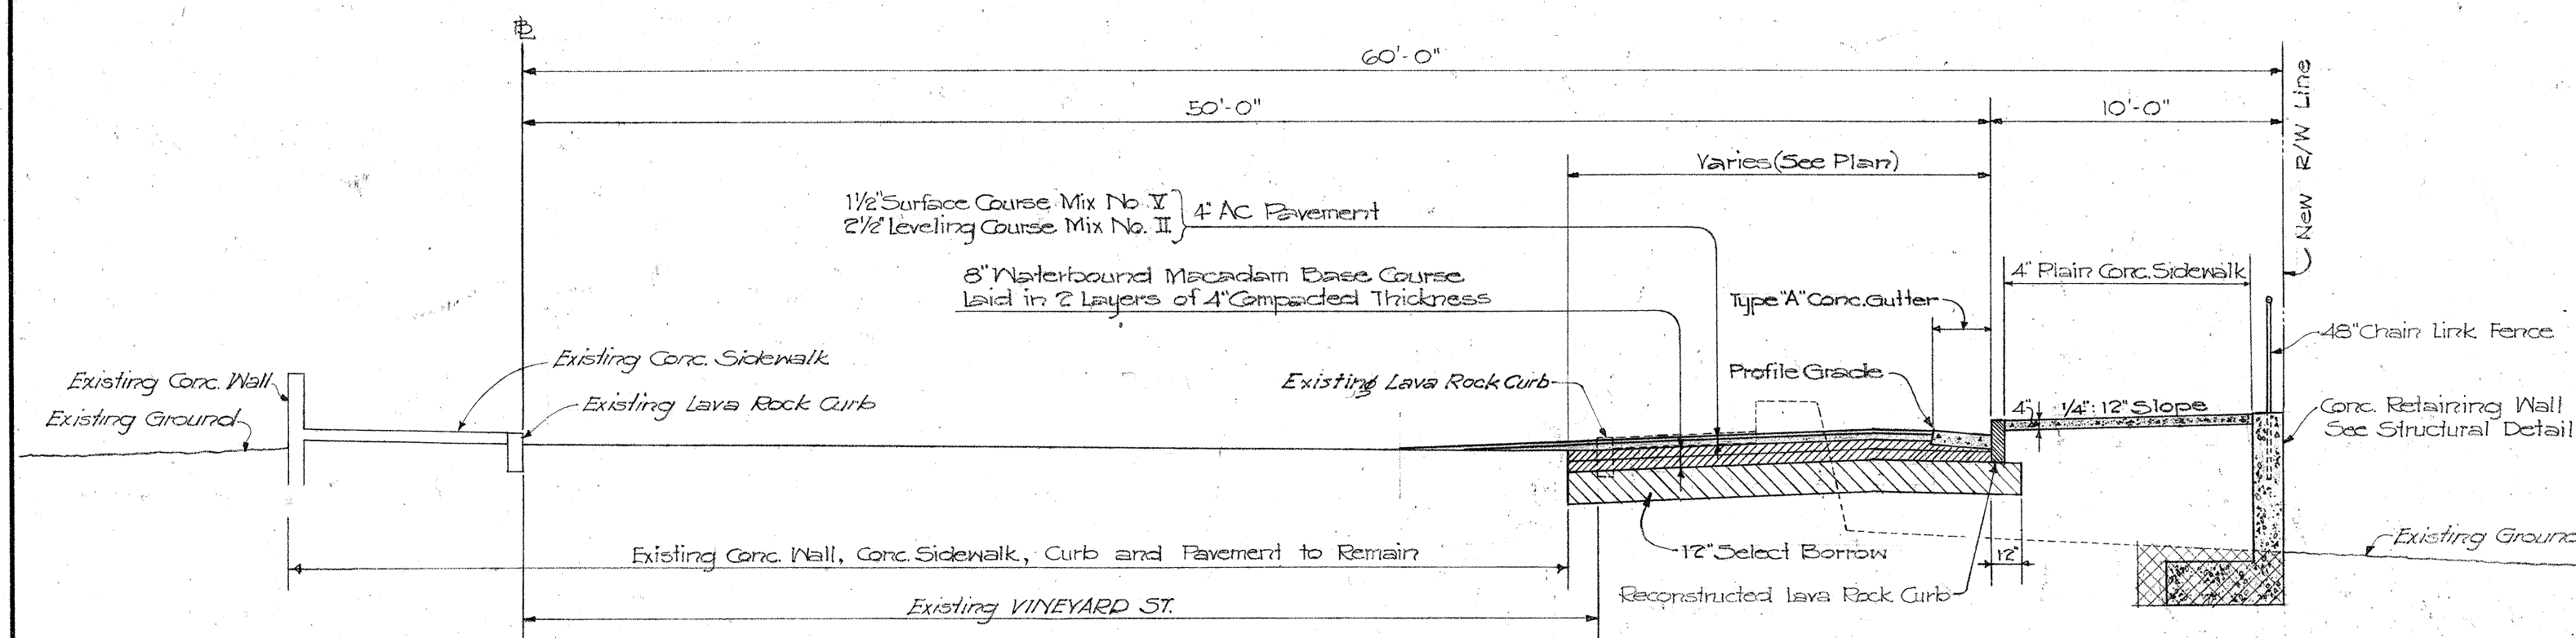

TYPICAL SECTION ~ STA. 126+50±
Scale: 3/16"=1'-0"

NOTE

Asphalt Concrete Pavement shall be of thicknesses shown fully compacted. If Mix No. III is used instead of Mix No. II for Levelling Course, the tonnage of Mix No. III used shall be paid for under Contract Item No. 42(1).

Surface of Existing Pavement shall be broomed and given a tack coat of 0.15 gal. per sq. yd. of Emulsified Asphalt before laying variable thickness of A.C. Mix No. II Levelling Course or A.C. Mix No. I Surface Course wherever the latter mix is placed directly on existing pavement.

Prime Coat; Slow Curing Liquid Asphalt for Prime Coat shall be applied to the surface of Base Course at the rate of 0.35 gal. per sq. yd. before placing Levelling Course.

Portland Cement Concrete Pavement shall not be reinforced with bars or wire mesh except where bar reinforcement is required by the Engineer for protection of certain sub-structures. No longitudinal Contract Joints are permitted—pavement shall be paved full width. "Weakened Plane Joints" shall be installed approximately 30-ft. centers. No Expansion Joints are required.

Excavation: All excavations shall be Class 'A' Excavation.

Irregularities of the Existing Pavement shall be levelled with A.C. Mix No. II before laying uniform thickness of 1" A.C. Surface Course using Mix No. I. Where base course is to be laid over existing pavement, such pavement shall be removed and sub-grade rolled prior to placing of Base Course. Base Course shall be placed in layers of not over 4" compacted thickness.

Wherever Type "A" Conc. Curb is shown, this curb shall be as shown on the Standard Details; except that recesses shall be omitted.

NOTE:

Excavation of areas shown cross-hatched in these Typical Sections shall be paid for under the item of "Unclassified Excavation for Structures other than at Bridges".

TERRITORIAL HIGHWAY DEPARTMENT
TERRITORY OF HAWAII


TYPICAL SECTION
VINEYARD THOROUGHFARE
NUUANU AVE. TO LUSITANA ST.
PROJECT No. F-098-1 (1)
UNIT 2

Scale: As Noted Dec. 1955

SHEET No. 1 OF 3 SHEETS


5790.02

FED. ROAD DIST. NO.	STATE	FED. AID PROJ. NO.	FISCAL YEAR	SHEET NO.	TOTAL SHEETS
HAWAII	HAW.	F-098-1(1) UNIT 2	1956	3	70

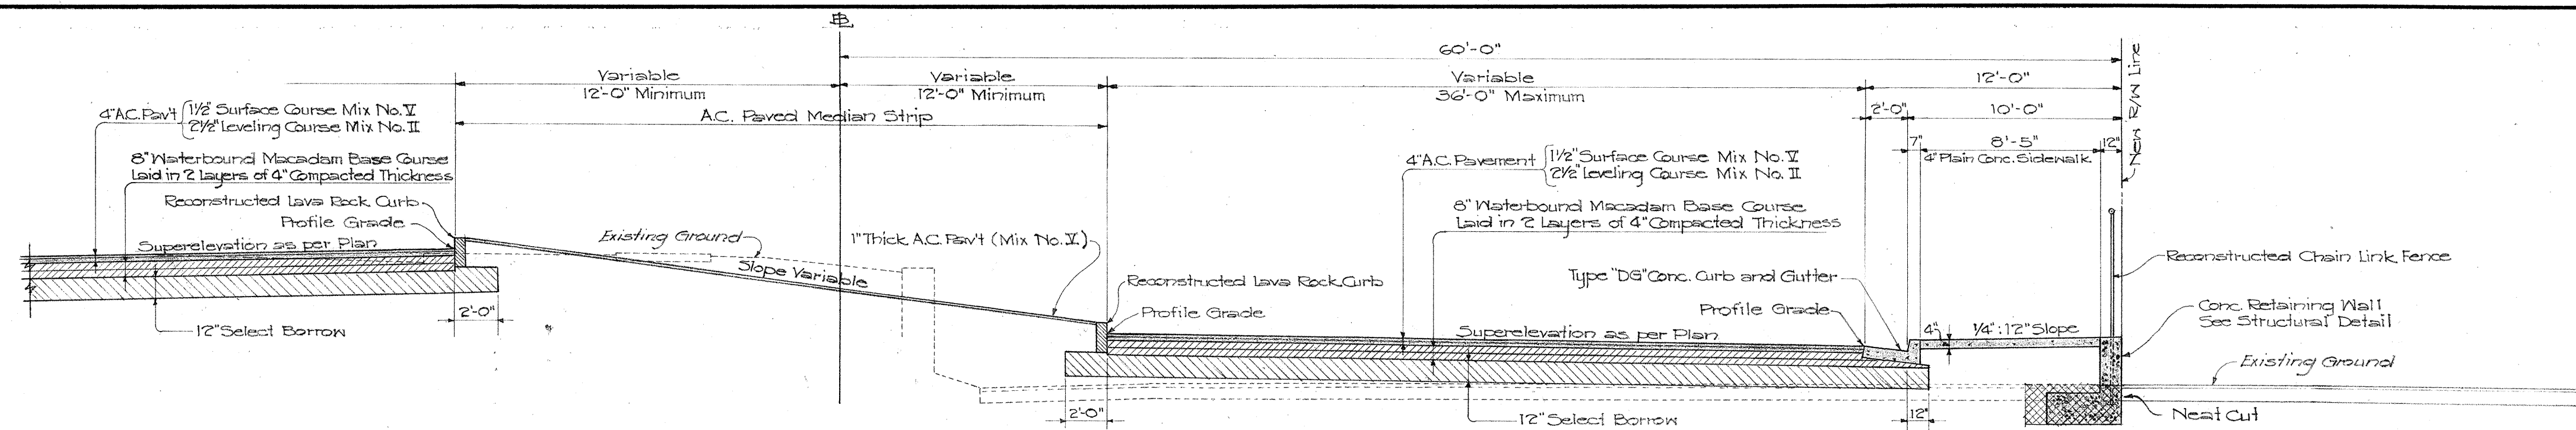


TYPICAL SECTION ~ STA. 152+50 to STA. 153+00
Scale: 3/16" = 1'-0"


NOTE:
Excavation of areas shown cross-hatched in these Typical Sections shall be paid for under the item of "Unclassified Excavation for Structures other than at Bridges".

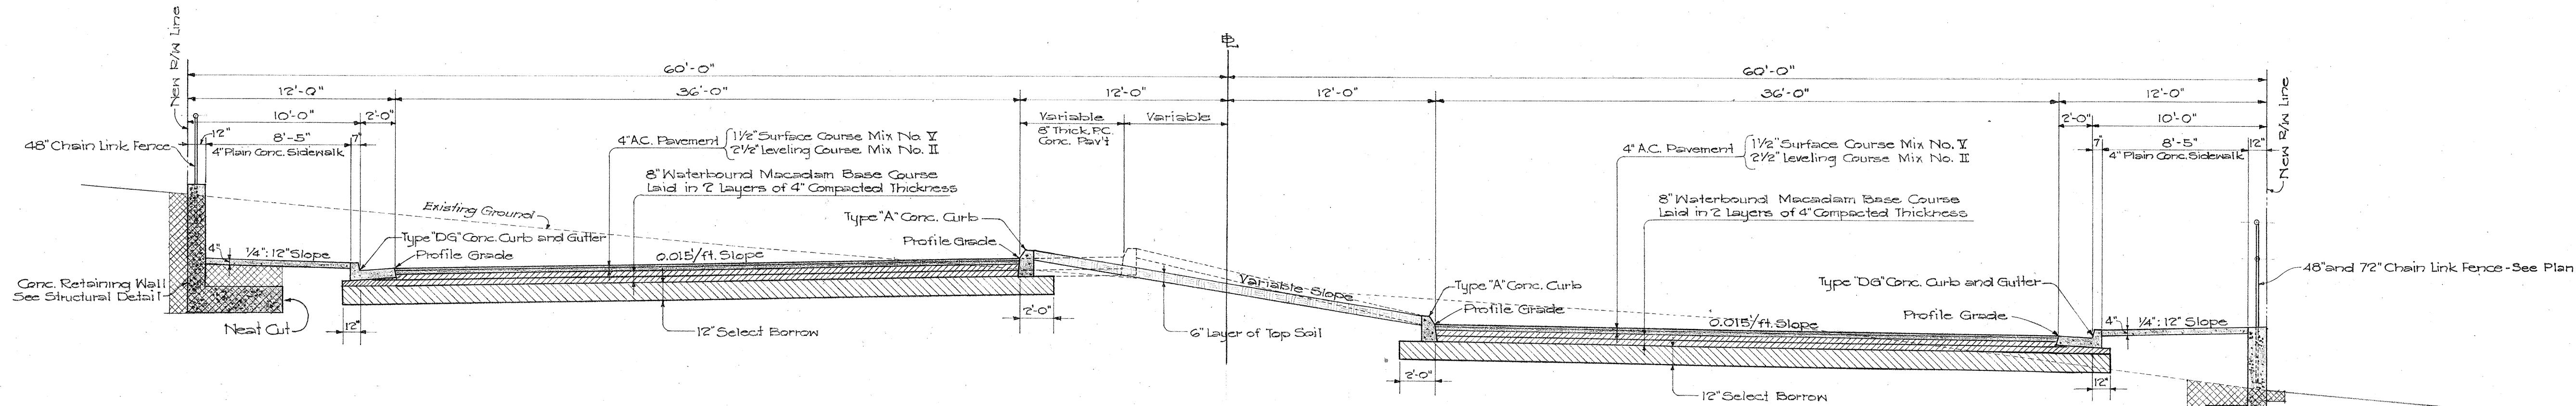

TYPICAL SECTION ~ STA. 149+50 to STA. 152+00
Scale: 3/16" = 1'-0"

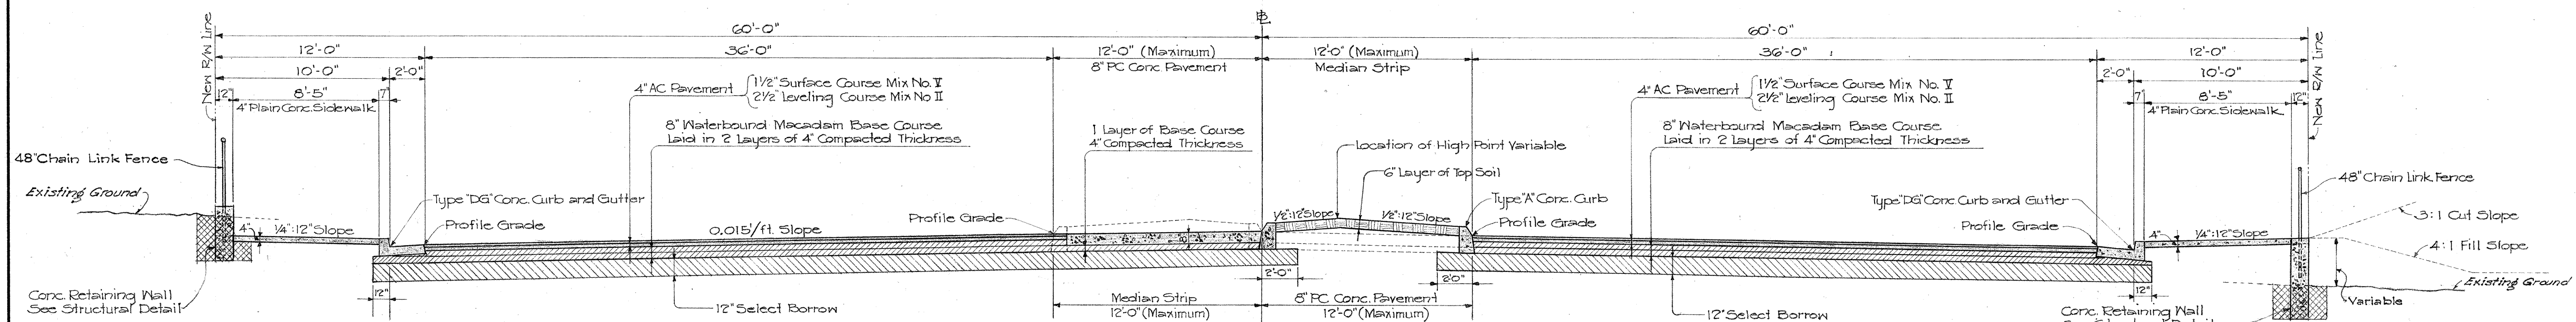

TYPICAL SECTION ~ STA. 135+00 to STA. 149+00
Scale: 3/16" = 1'-0"

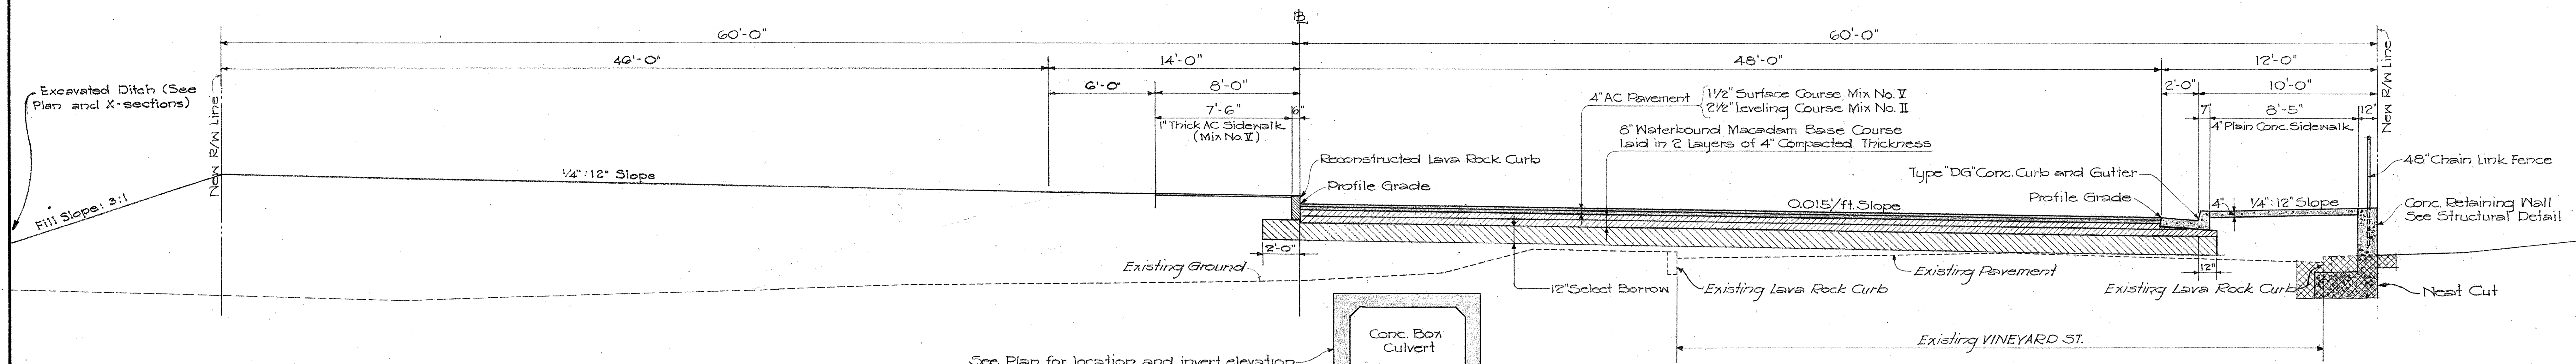

TYPICAL SECTION ~ STA. 132+00 to STA. 134+00
Scale: 3/16" = 1'-0"

No As-Built Changes on this Sheet

TERRITORIAL HIGHWAY DEPARTMENT
TERRITORY OF HAWAII

TYPICAL SECTION
VINEYARD THOROUGHFARE
NUUANU AVE. TO LUSITANA ST.
PROJECT No F-098-1(1)
UNIT 2


Scale: As Noted

Dec. 1955


SHEET No. 2 OF 3 SHEETS

5790.03


SURVEY PLOTTED BY	DATE
DESIGNED BY	1-56
TRACED BY	2-56
QUANTITIES CHECKED BY	2-56
CHECKED BY	1-56
ORIGINAL PLAN NO.	
NOTE BOOK NO.	

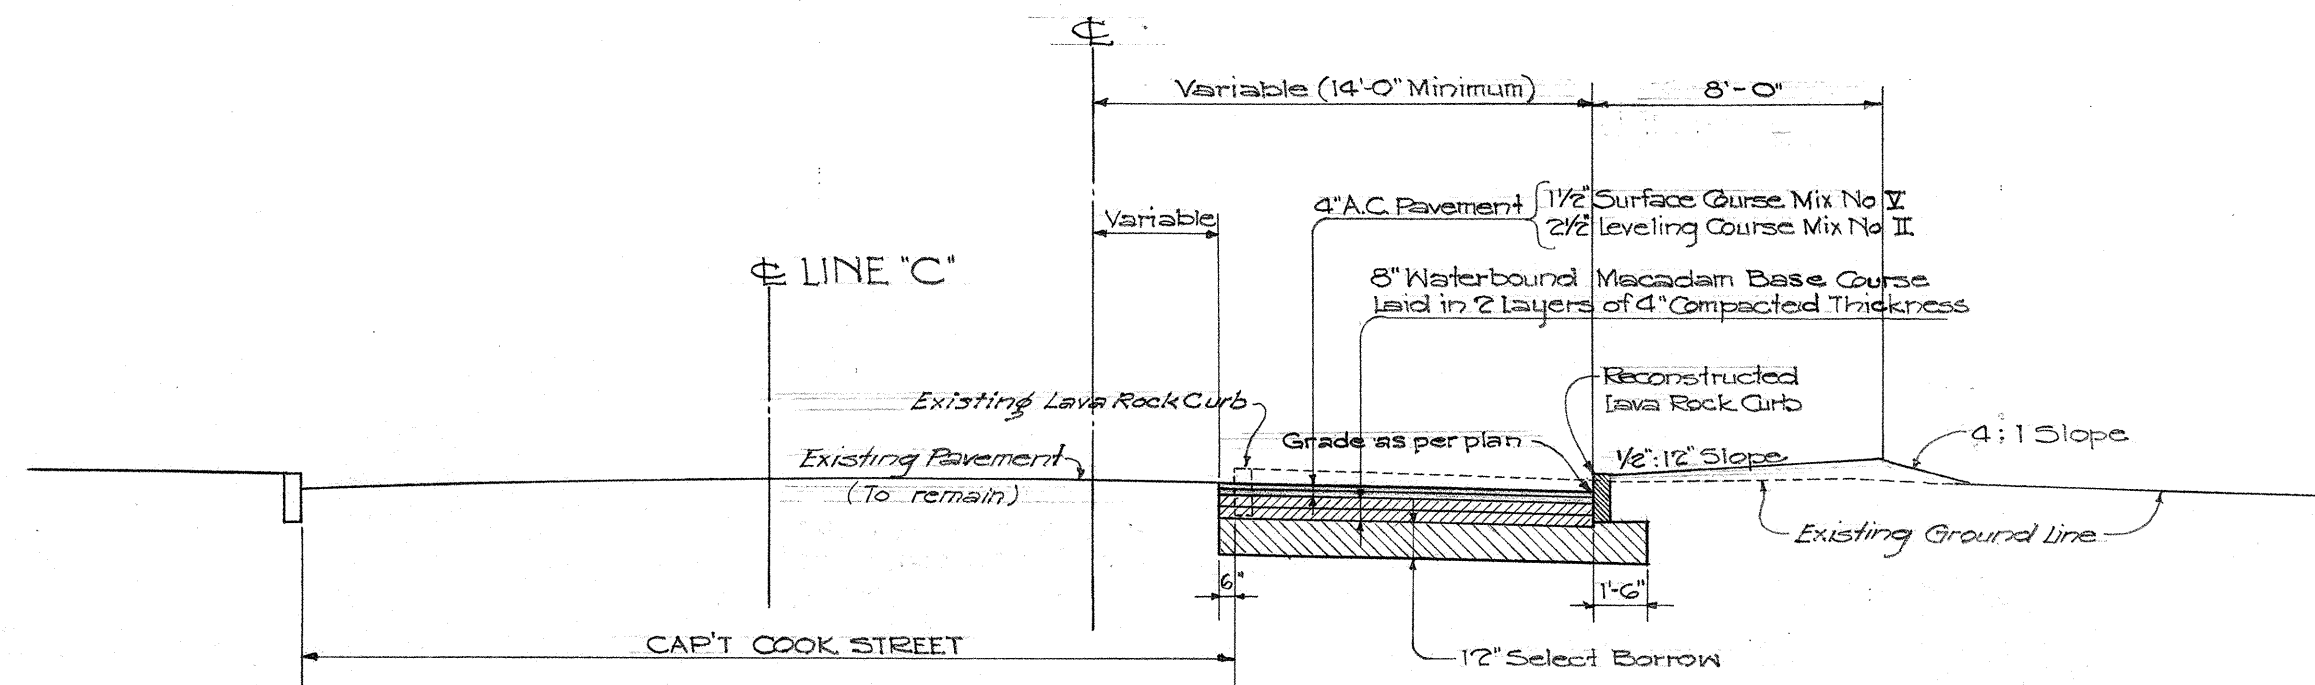


TYPICAL SECTION ~ LINE "A" STA. 2+75 to STA. 5+25
Scale: 3/16"=1'-0"

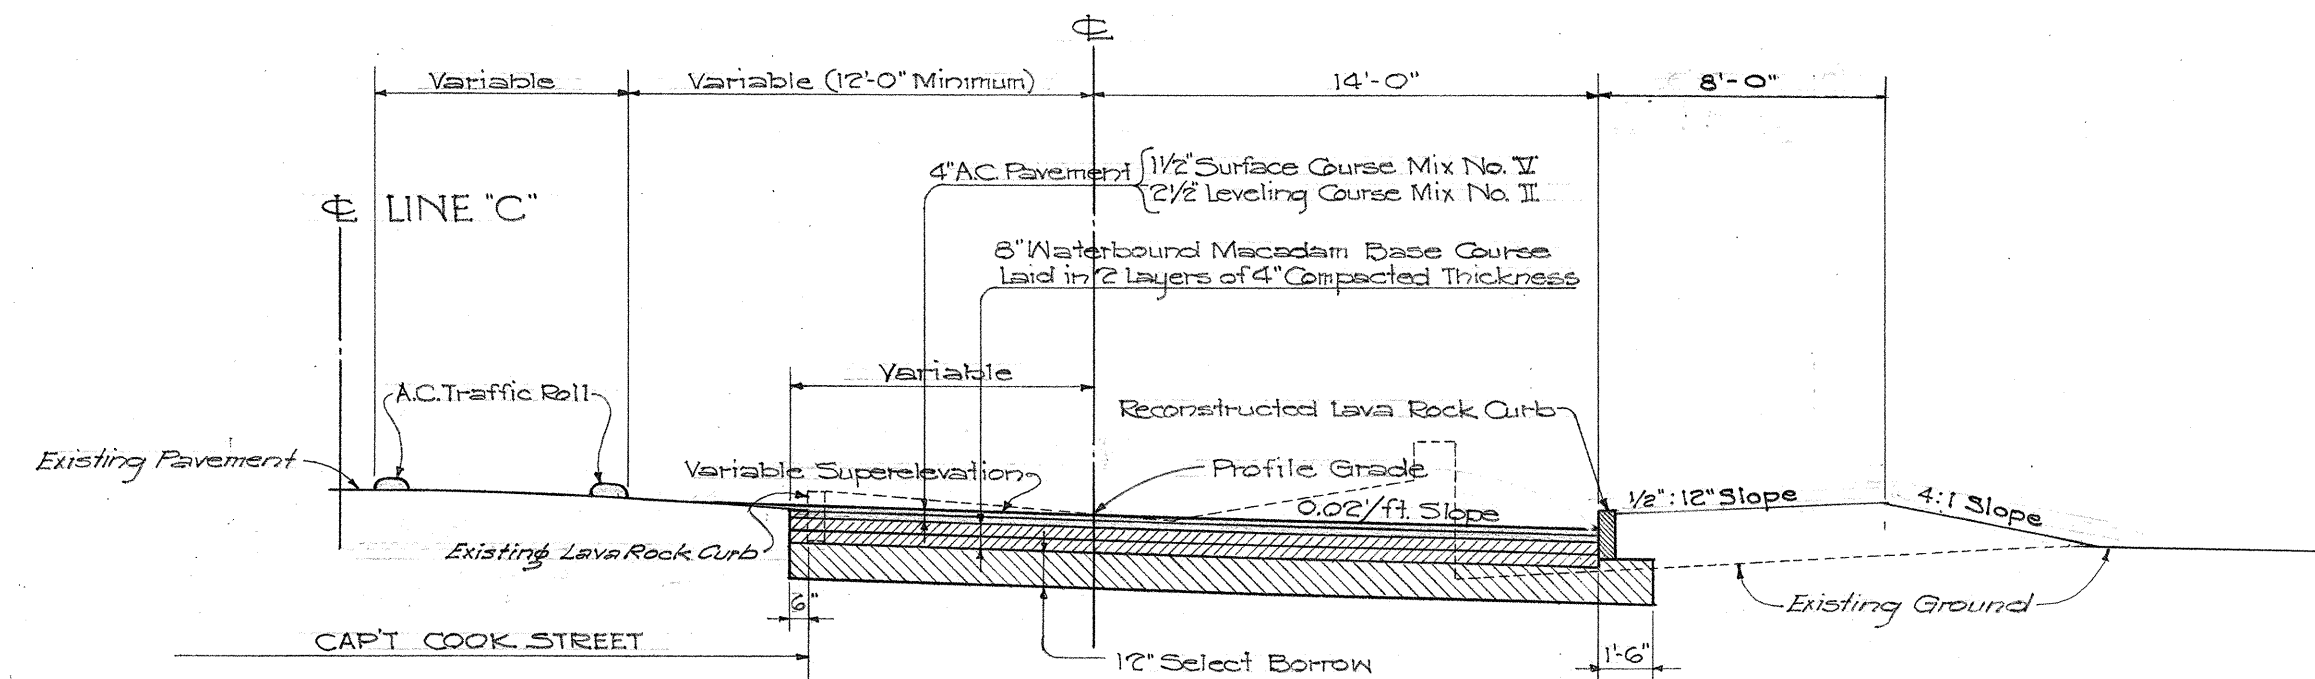


TYPICAL SECTION ~ LINE "A" STA. 2+25 to STA. 2+50
Scale: 3/16"=1'-0"

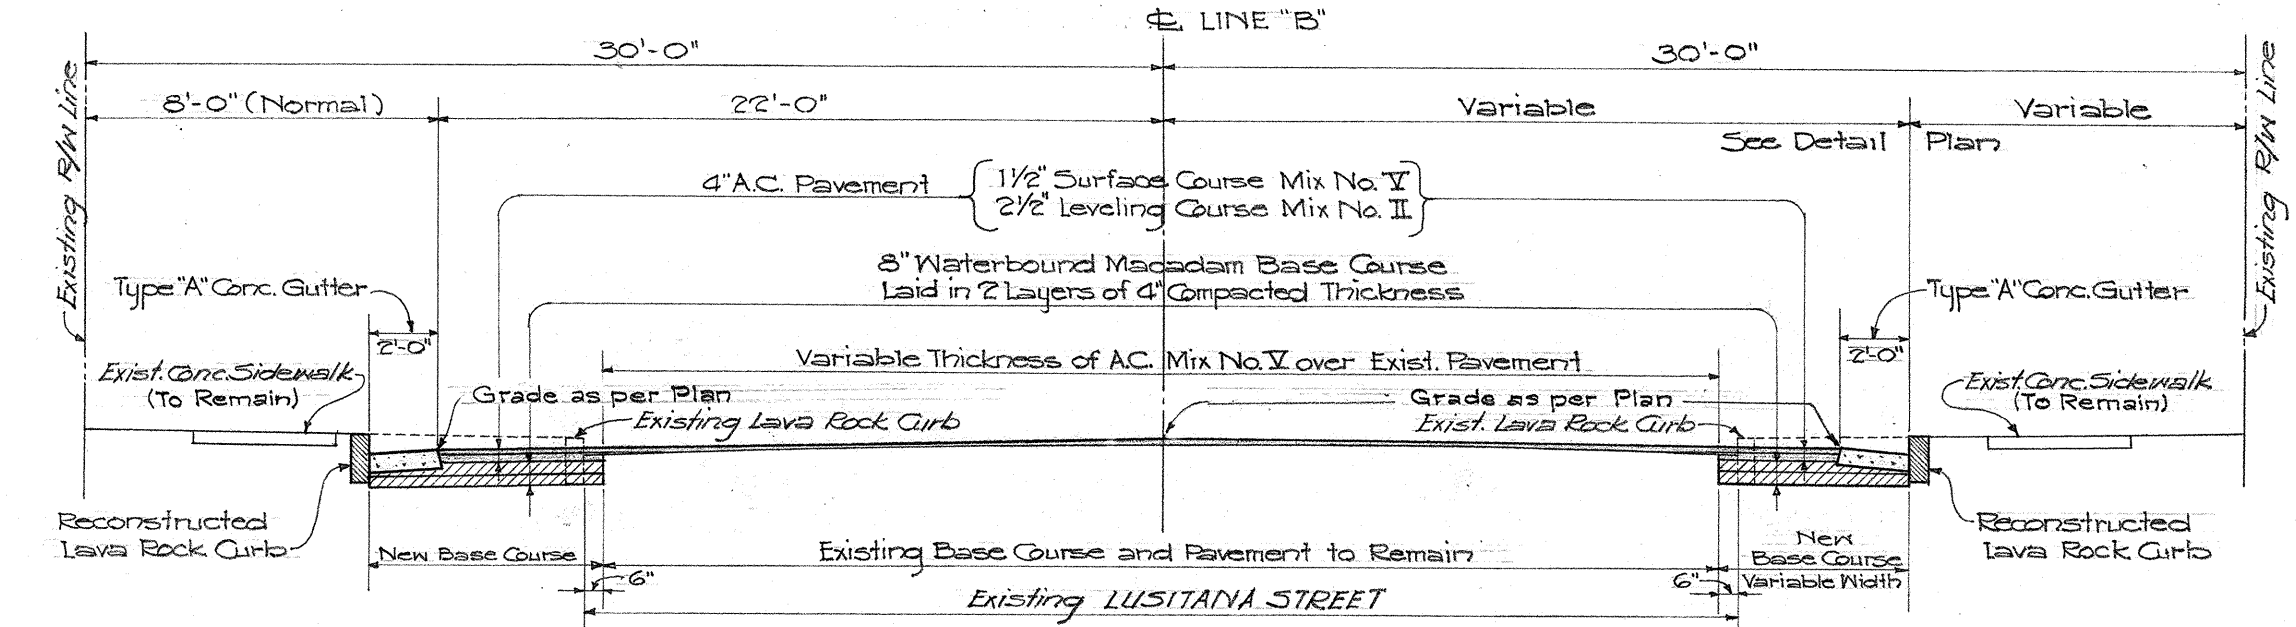


TYPICAL SECTION ~ LINE "B" STA. 2+25 to STA. 5+00
(LUSITANA STREET)
Scale: 3/16"=1'-0"

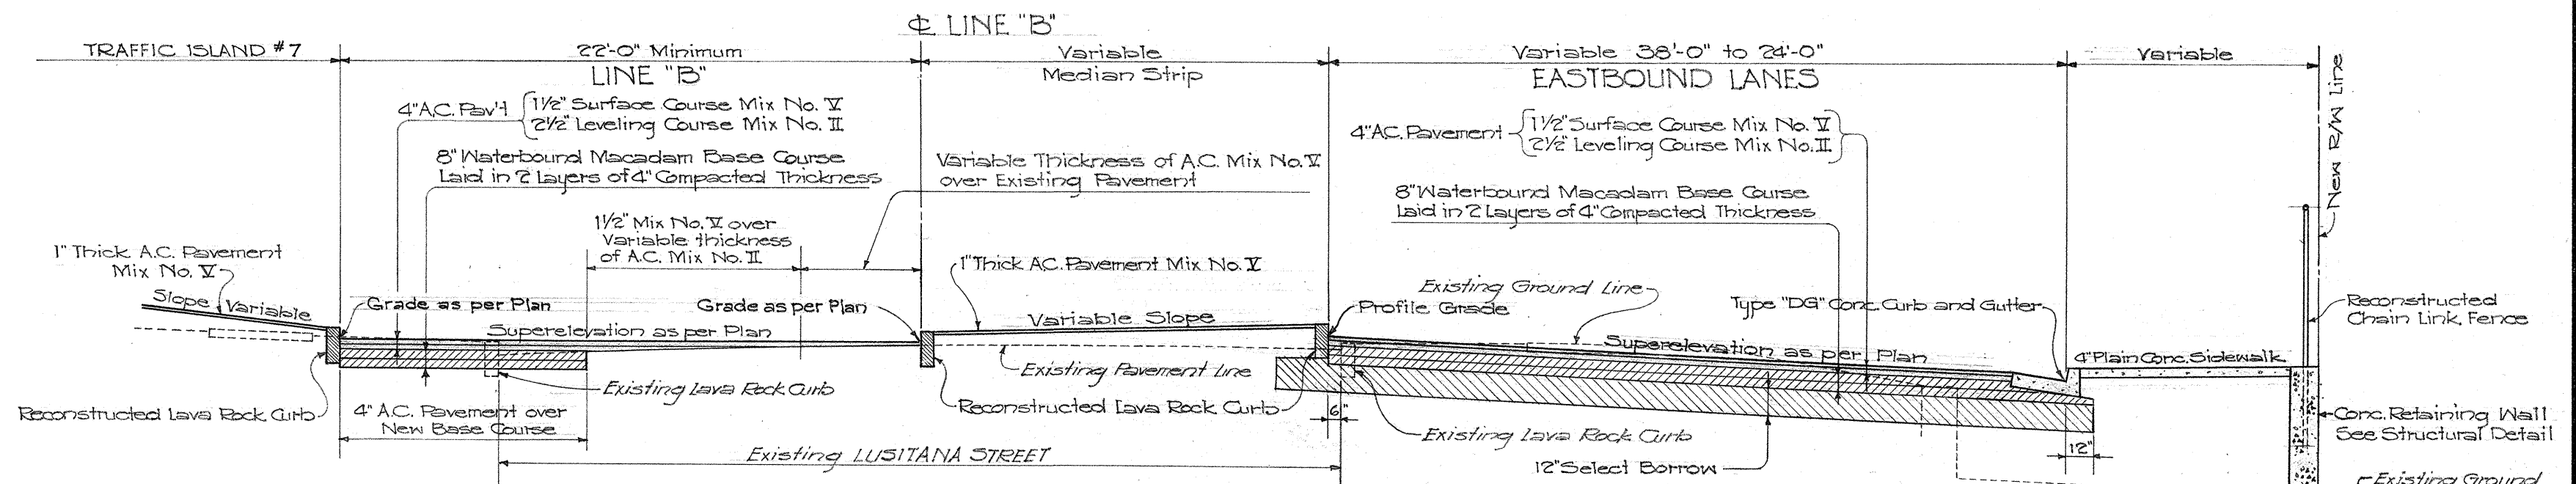


SECTION THRU LINE "B" STA. 1+50 and EASTBOUND LANES
Scale: 3/16"=1'-0"

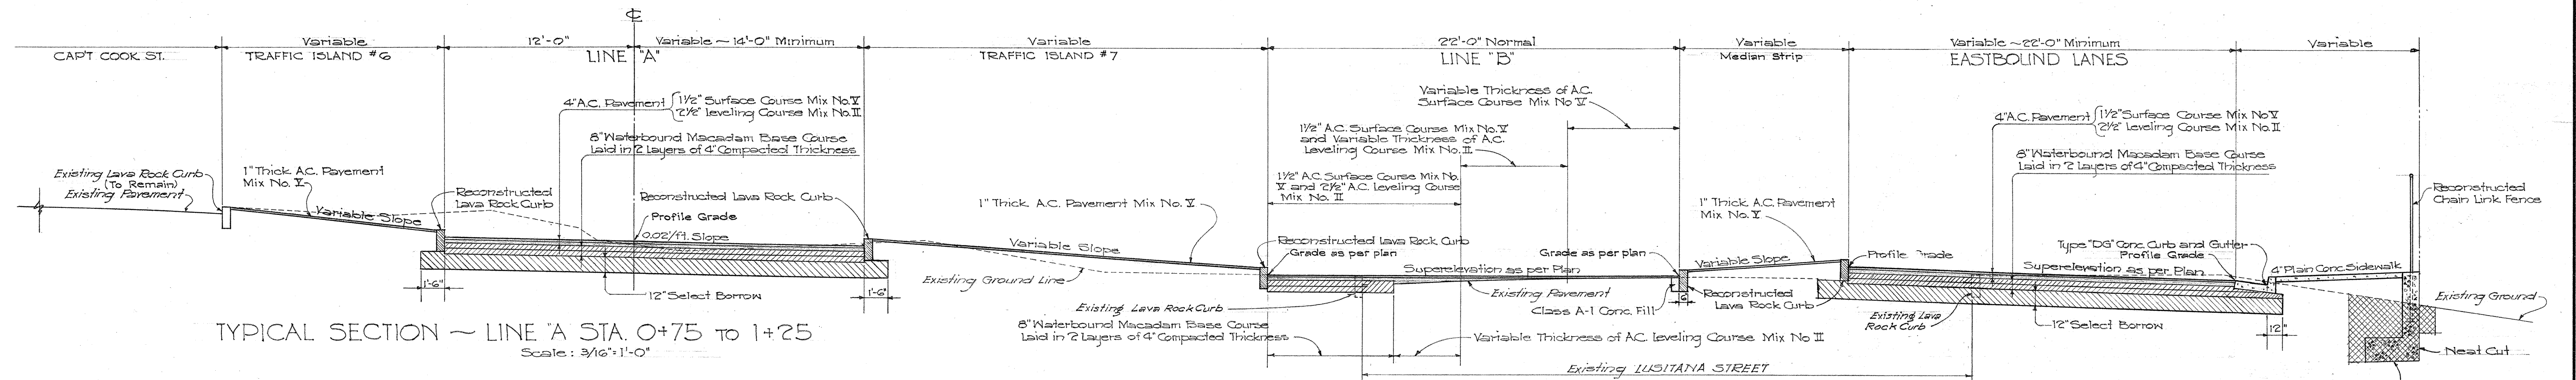

TYPICAL SECTION ~ LINE "A" STA. 0+75 to 1+25
Scale: 3/16"=1'-0"

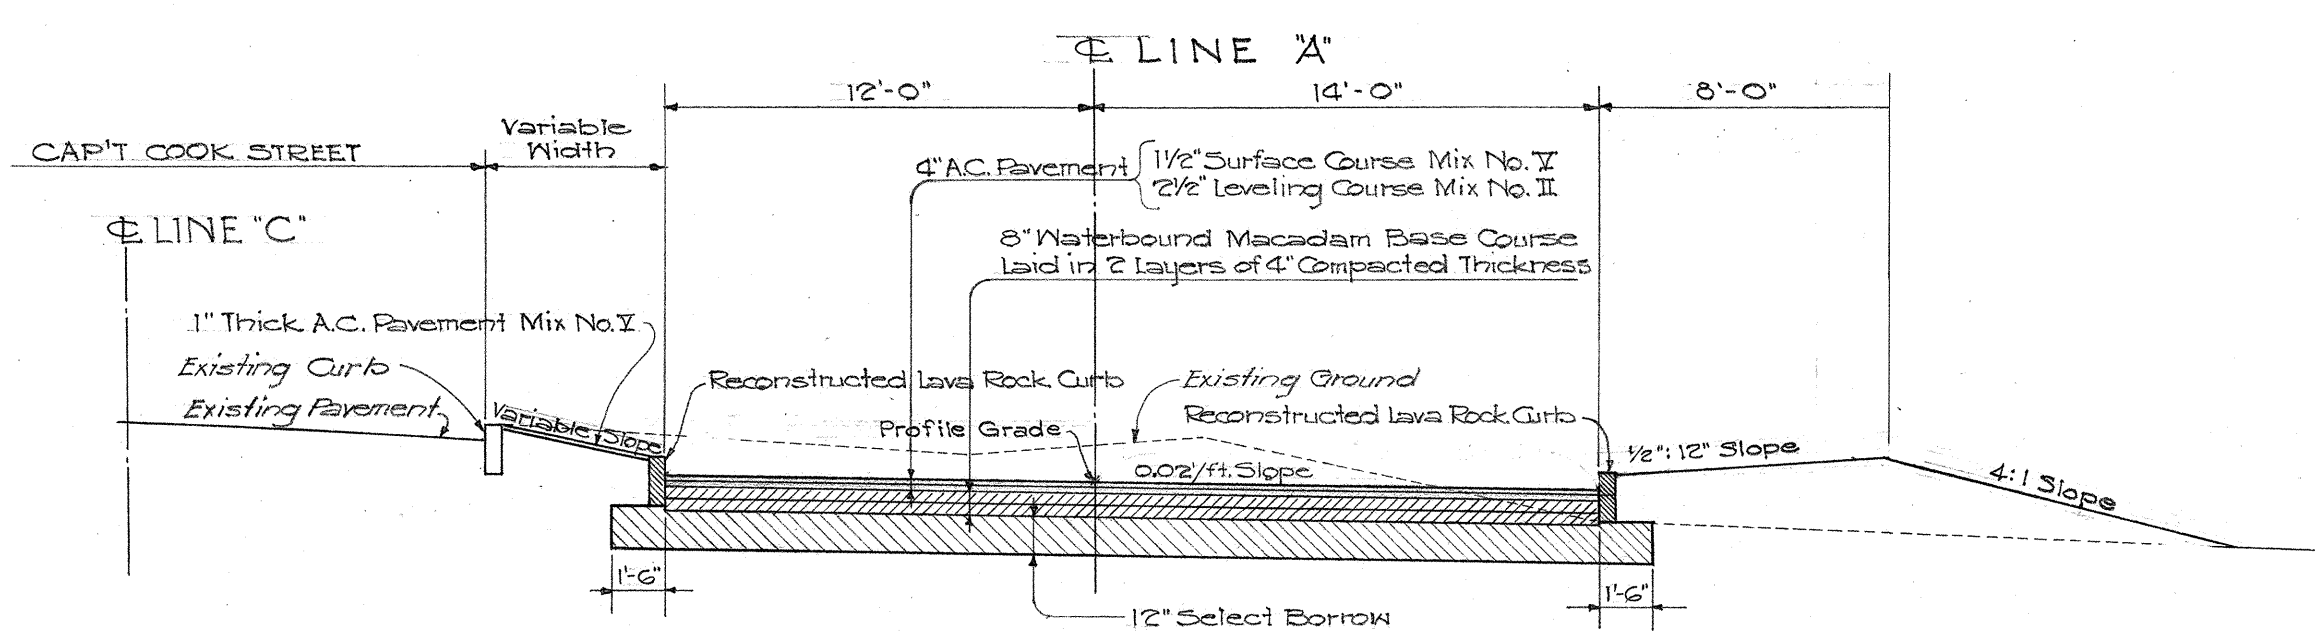

TYPICAL SECTION ~ LINE "A" STA. 1+75 to STA. 2+00
Scale: 3/16"=1'-0"

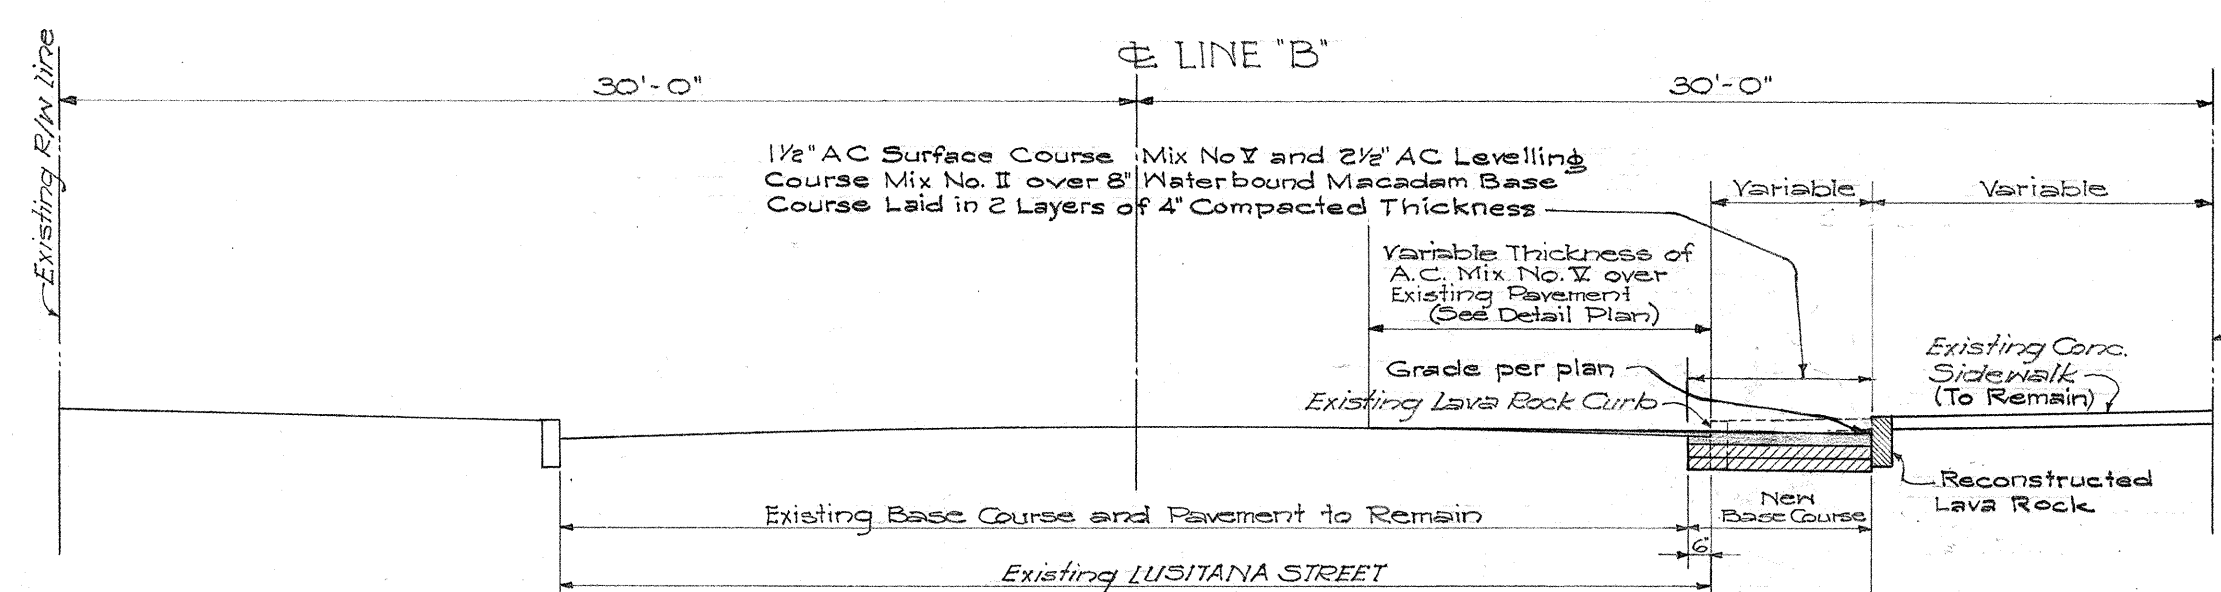

TYPICAL SECTION ~ LINE "B" STA. 0+75 to STA. -2+25
(LUSITANA STREET)
Scale: 3/16"=1'-0"

NOTE:
Excavation of areas shown cross-hatched in these Typical Sections shall be paid for under the item of "Unclassified Excavation for Structures other than at Bridges."

No As-Built Changes on this Sheet.

TERRITORIAL HIGHWAY DEPARTMENT
TERRITORY OF HAWAII
TYPICAL SECTION
VINEYARD THOROUGHFARE
NUUANU AVE. TO LUSITANA ST.
PROJECT No. F-098-1(1)
UNIT 2
Scale: As Noted
Dec. 1955

SHEET No. 3 OF 3 SHEETS

5790.04

SURVEY PLOTTED BY: DATE: 1-56
DRAWN BY: Y.O. IN: 2-56
CHECKED BY: Y.O. IN: 3-56
NOTE BOOK No. 1-56