
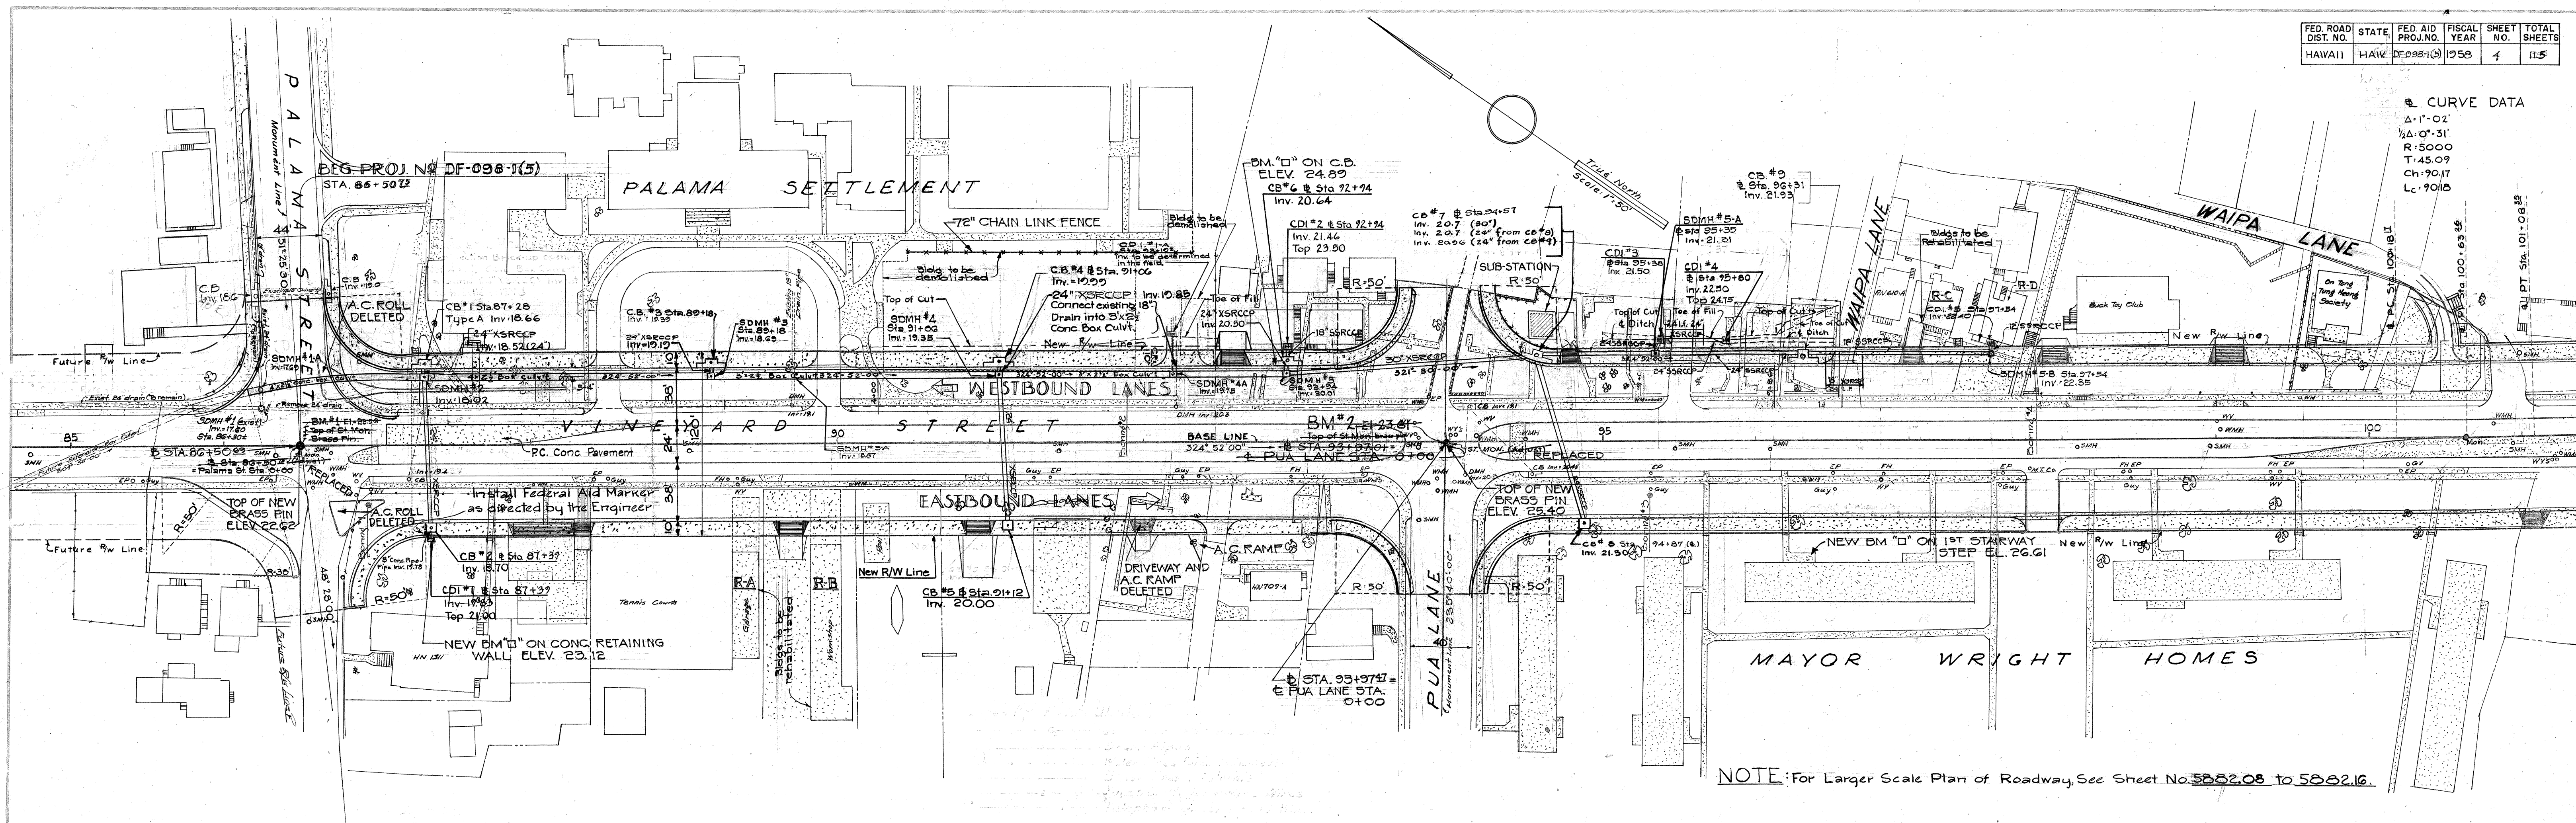
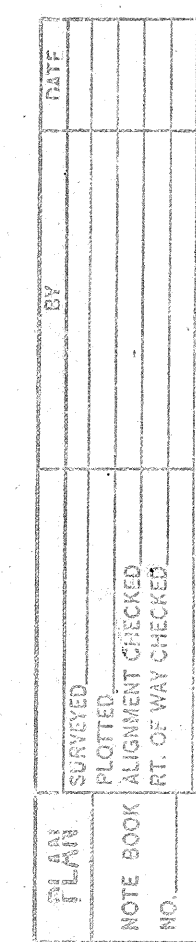



FED. ROAD DIST. NO.	STATE	FED. AID PROJ. NO.	FISCAL YEAR	SHEET NO.	TOTAL SHEETS
HAWAII	HAWAII	DE-098-1(5)	1958	4	115

CURVE DATA

$\Delta = 1^{\circ} - 02'$
 $\frac{1}{2}\Delta = 0^{\circ} - 31'$
 $R = 5000$
 $T = 45.09$
 $Ch = 90.17$
 $L_c = 90.18$

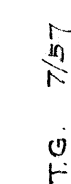

NOTE: For Larger Scale Plan of Roadway, See Sheet No. 5882.08 to 5882.16

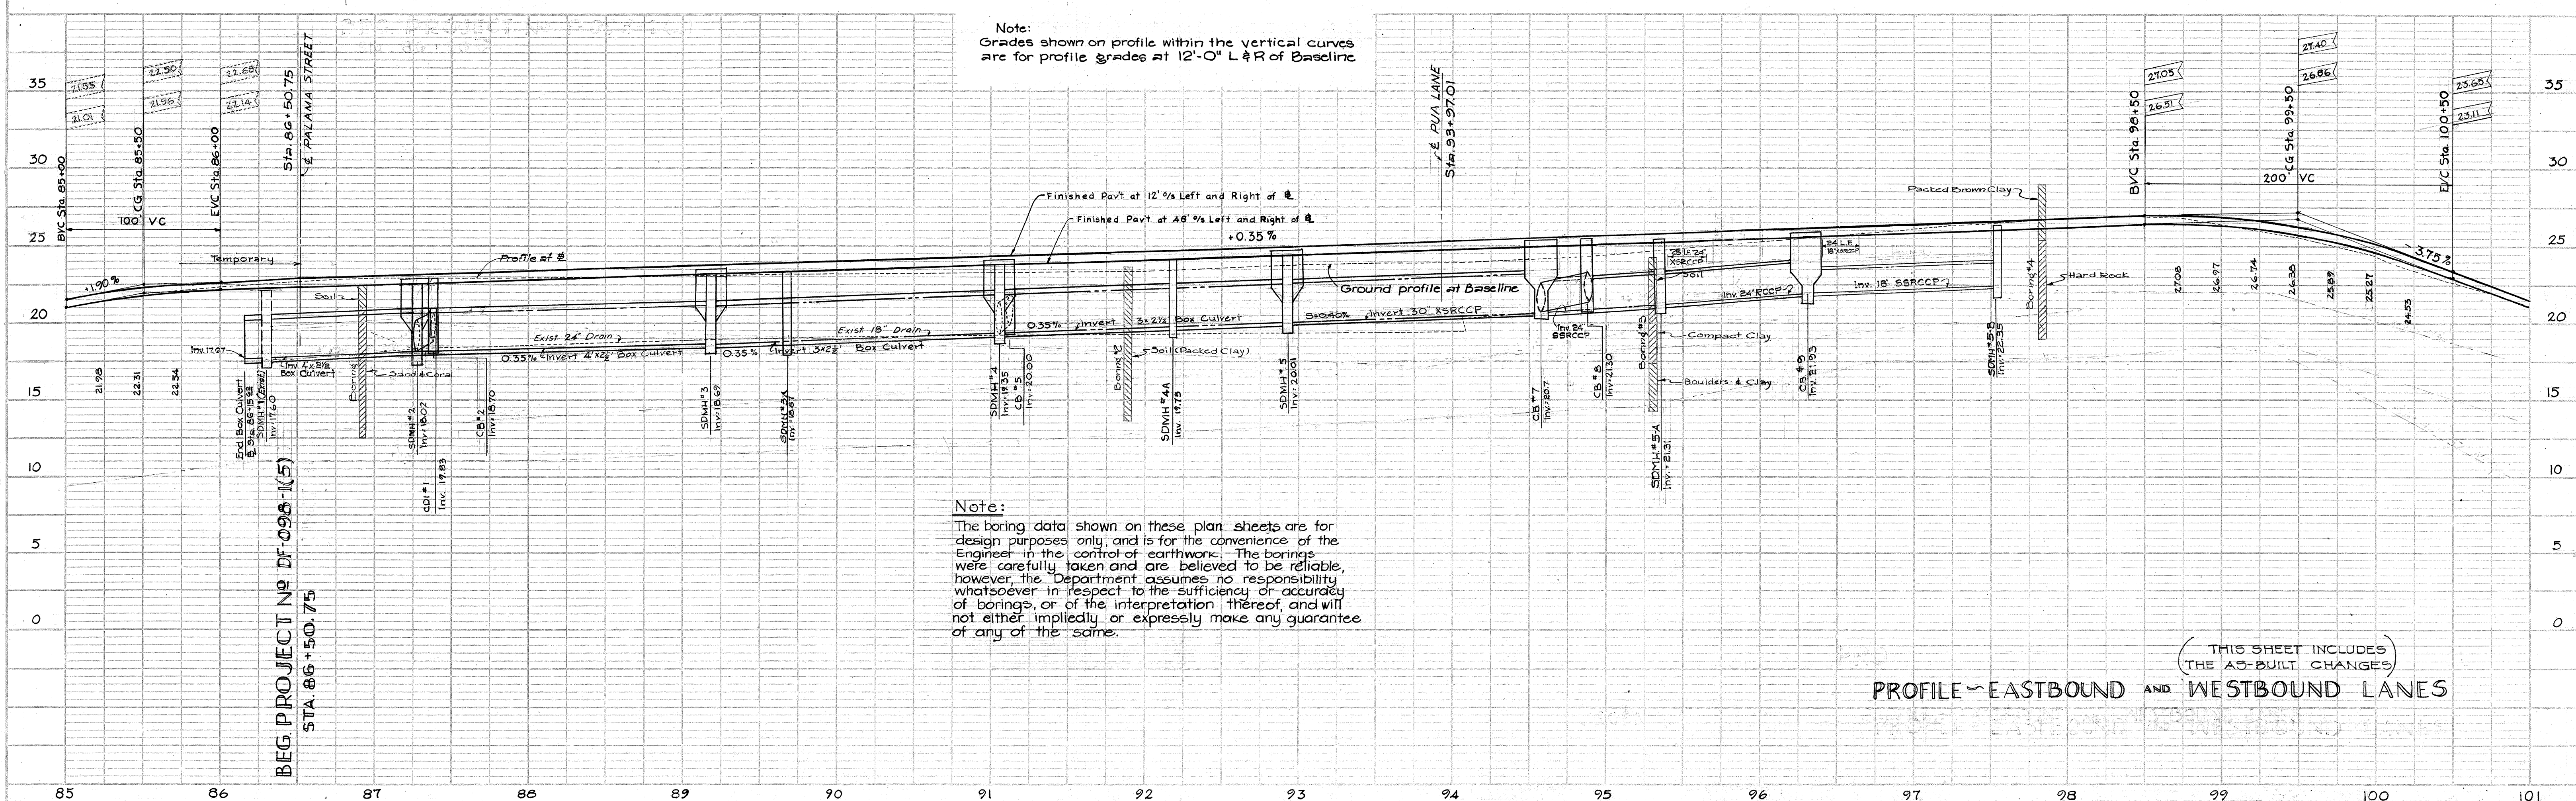


Note:
Grades shown on profile within the vertical curves
are for profile grades at 12'-0" L & R of Baseline

Note: The boring data shown on these plan sheets are for design purposes only, and is for the convenience of the Engineer in the control of earthwork. The borings were carefully taken and are believed to be reliable, however, the Department assumes no responsibility for their use in respect to the sufficiency or accuracy of borings, or of the interpretation thereof, and will not either impliedly or expressly make any guarantee of any of the same.


PROFILE ~ EASTBOUND AND WESTBOUND LANES

5882.04

PLAN	SURVEYED	DATE
NO.	BY	
NOTE BOOK	ALIGNED CHECKED	
	BY	

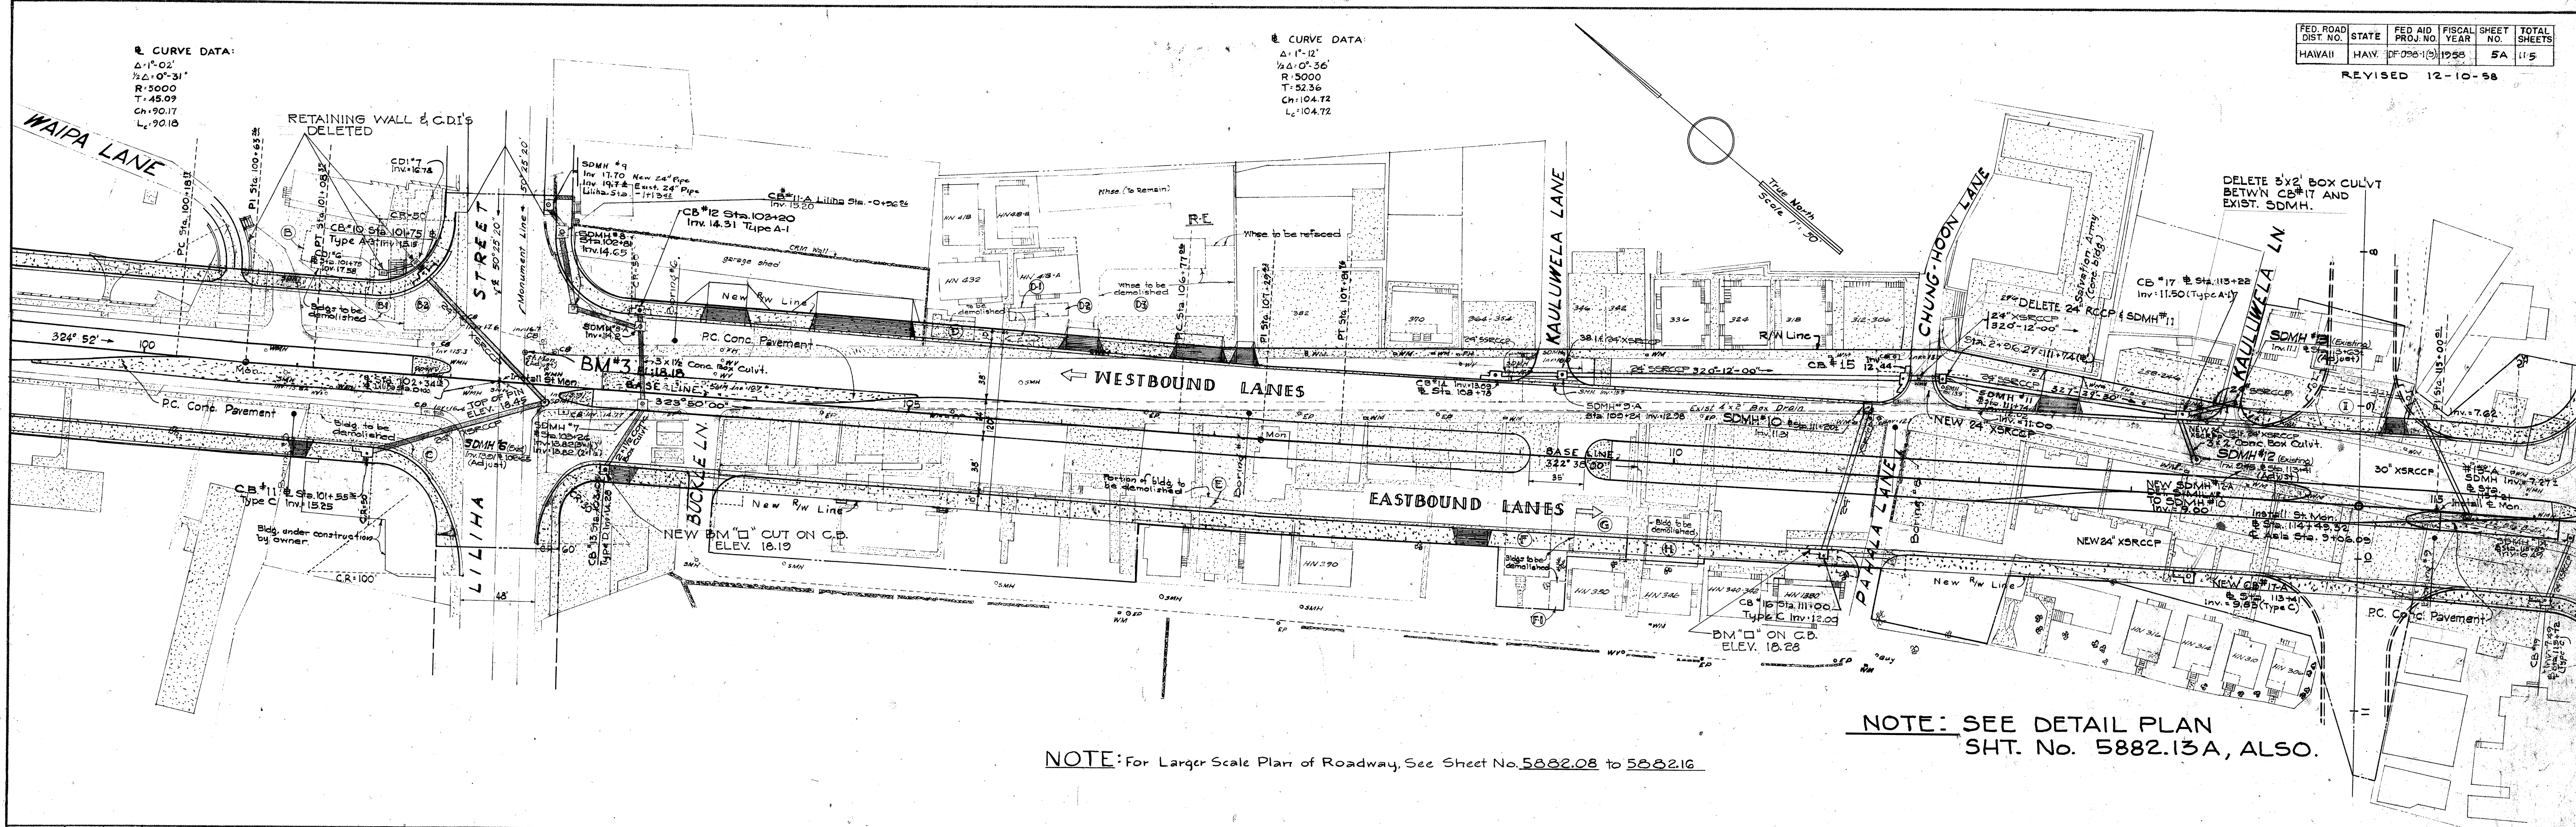


PROFILE	SURVEYED	BY	DATE
NOTE BOOK	GRADES CHECKED		
NO.	BY		
	STRUCTURE NOTAT'NS CH'KD.		

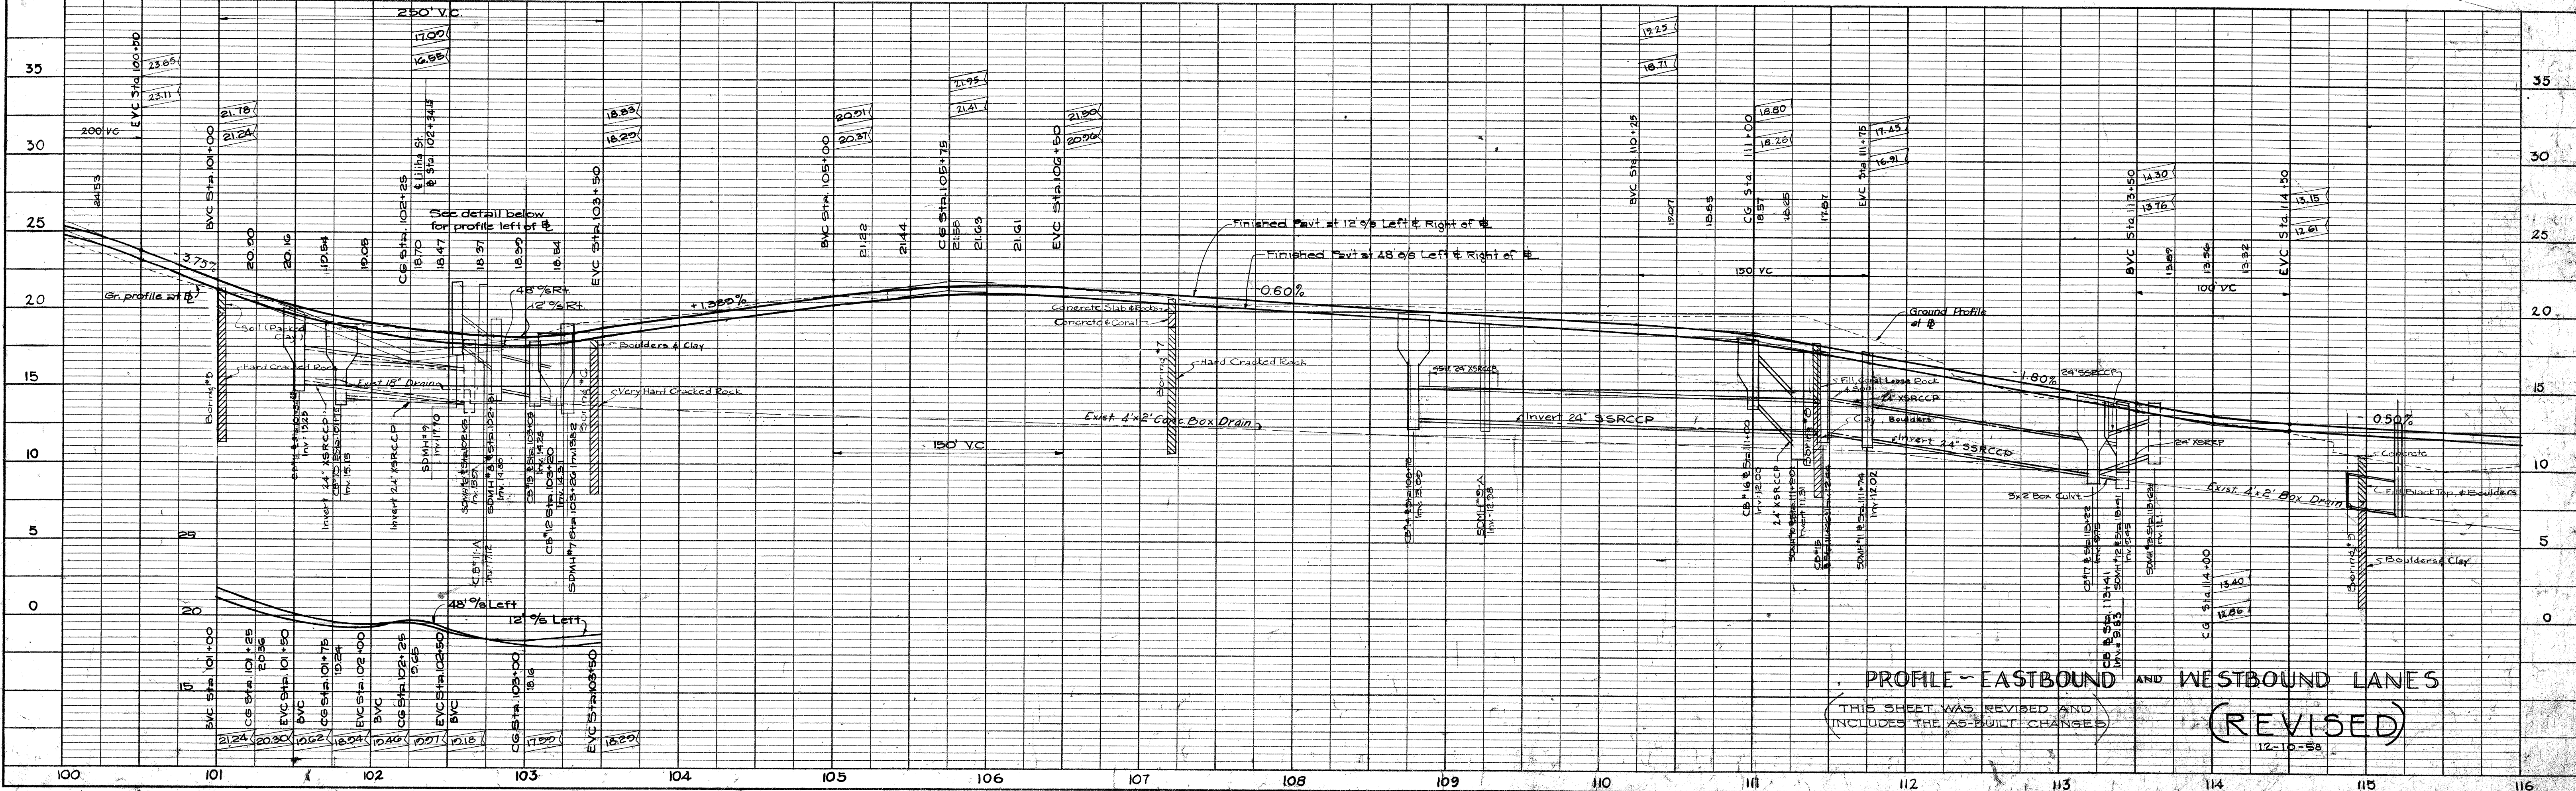


REVISED 12-10-58

DATE	BY	PLAN
		SURVEYED
		NOTE BOOK
		ALIGNED CHECKED
		NO.

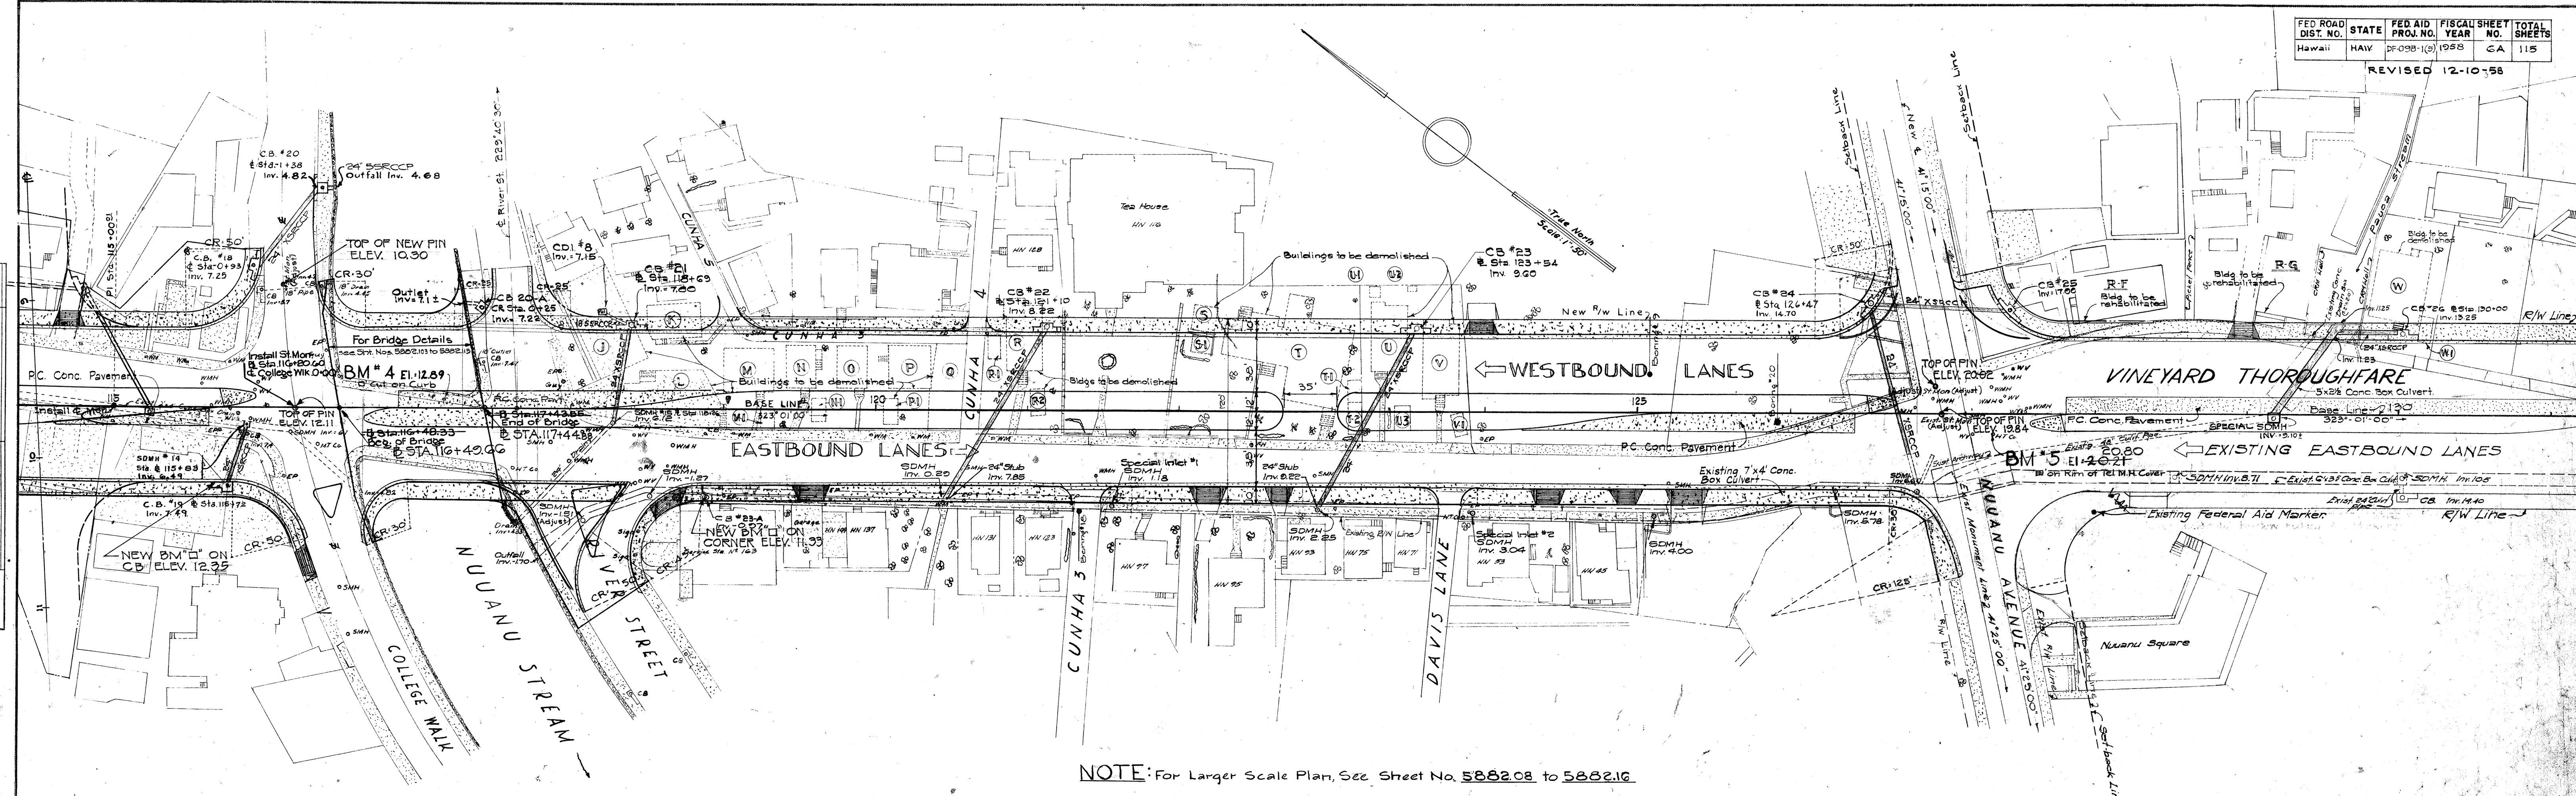

NOTE: For Larger Scale Plan, See Sheet No. 5882.08 to 5882.16

DATE	BY	PROFILE
		SURVEYED
		NOTE BOOK
		GRADES CHECKED
		NO.

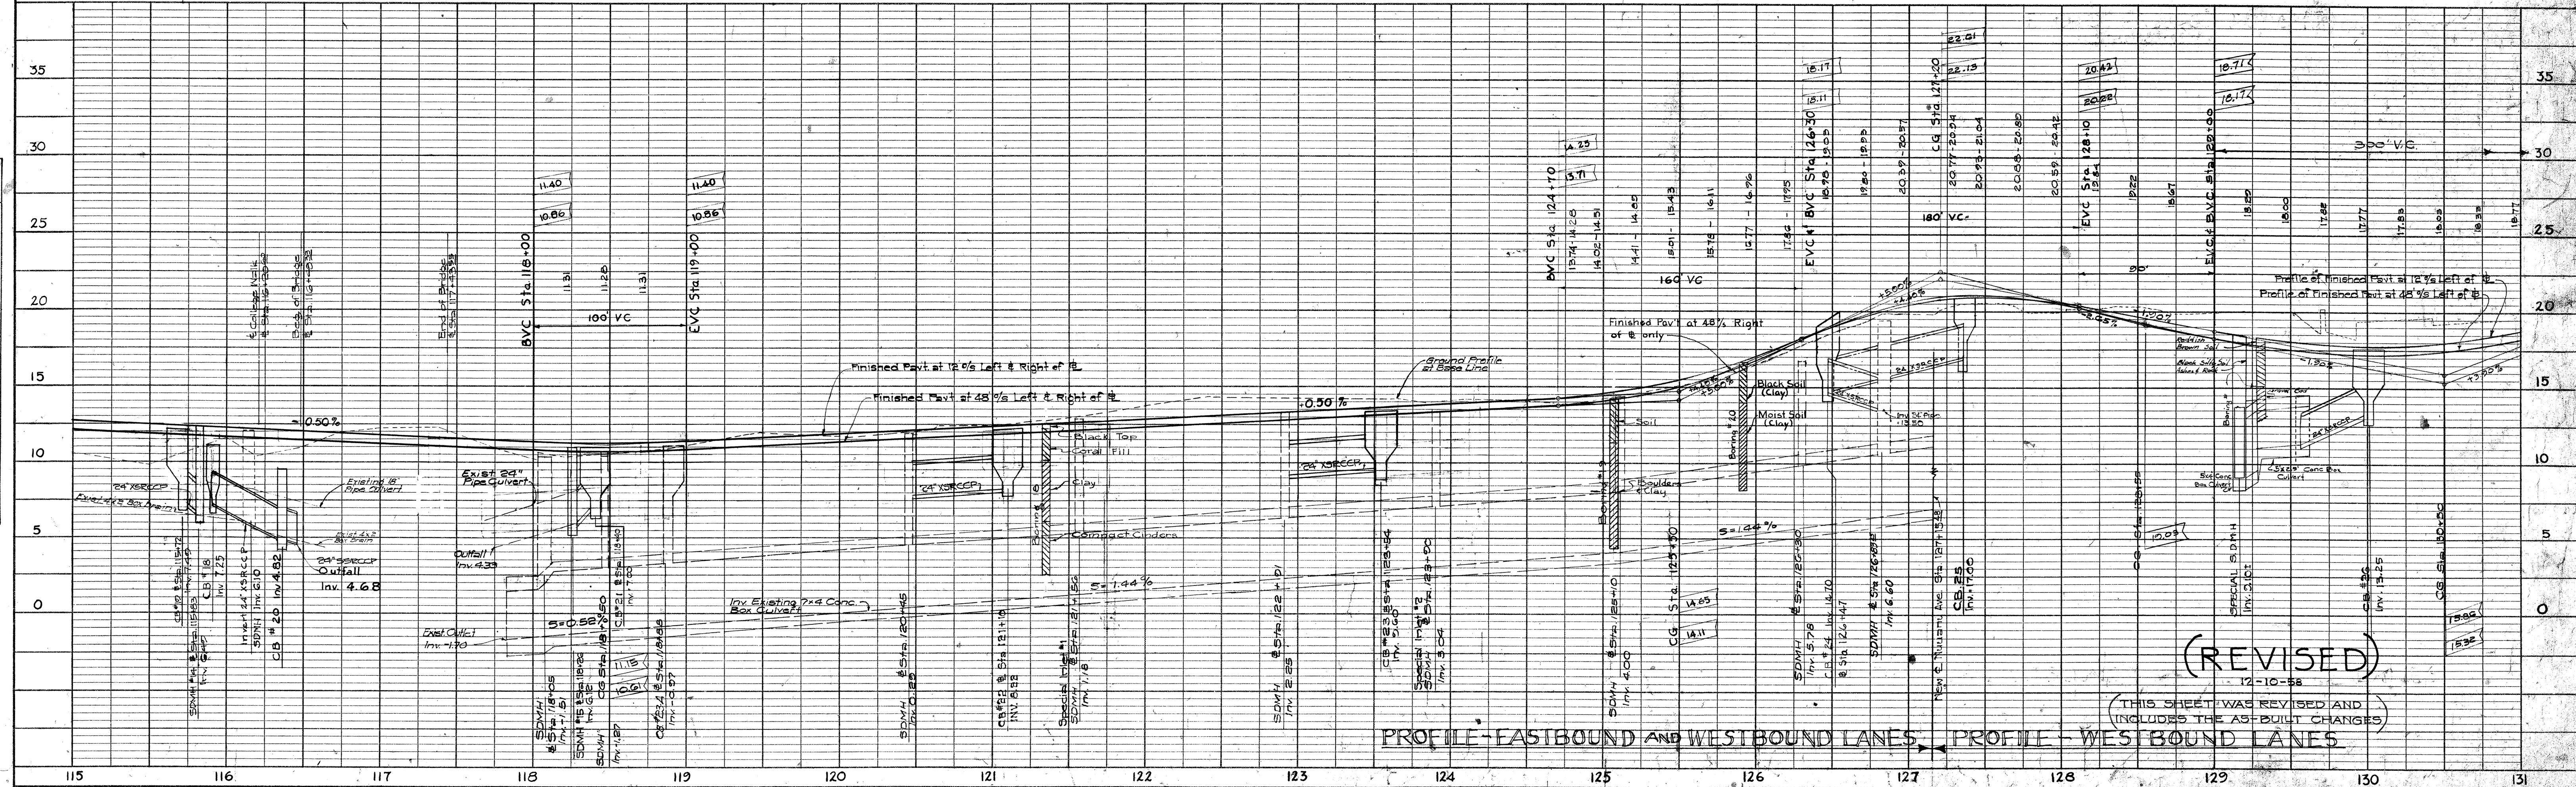

PROFILE - EASTBOUND AND WESTBOUND LANES, PROFILE - WESTBOUND LANES


(REVISED)
12-10-58

(THIS SHEET WAS REVISED AND INCLUDES THE AS-BUILT CHANGES)


5882.06A

PRO. ROAD DIST. No.	STATE	PRO. AID PROJ. No.	FISCAL YEAR	SHEET No.	TOTAL SHEETS
HAWAII	HAW.	DF-098-10	1958	07	115

PLAN
STARTED: 1/15/58
PROJECTED: 1/15/58
NOTE: BOOK NO. 1000 CHECKED BY: [Signature]
NO.

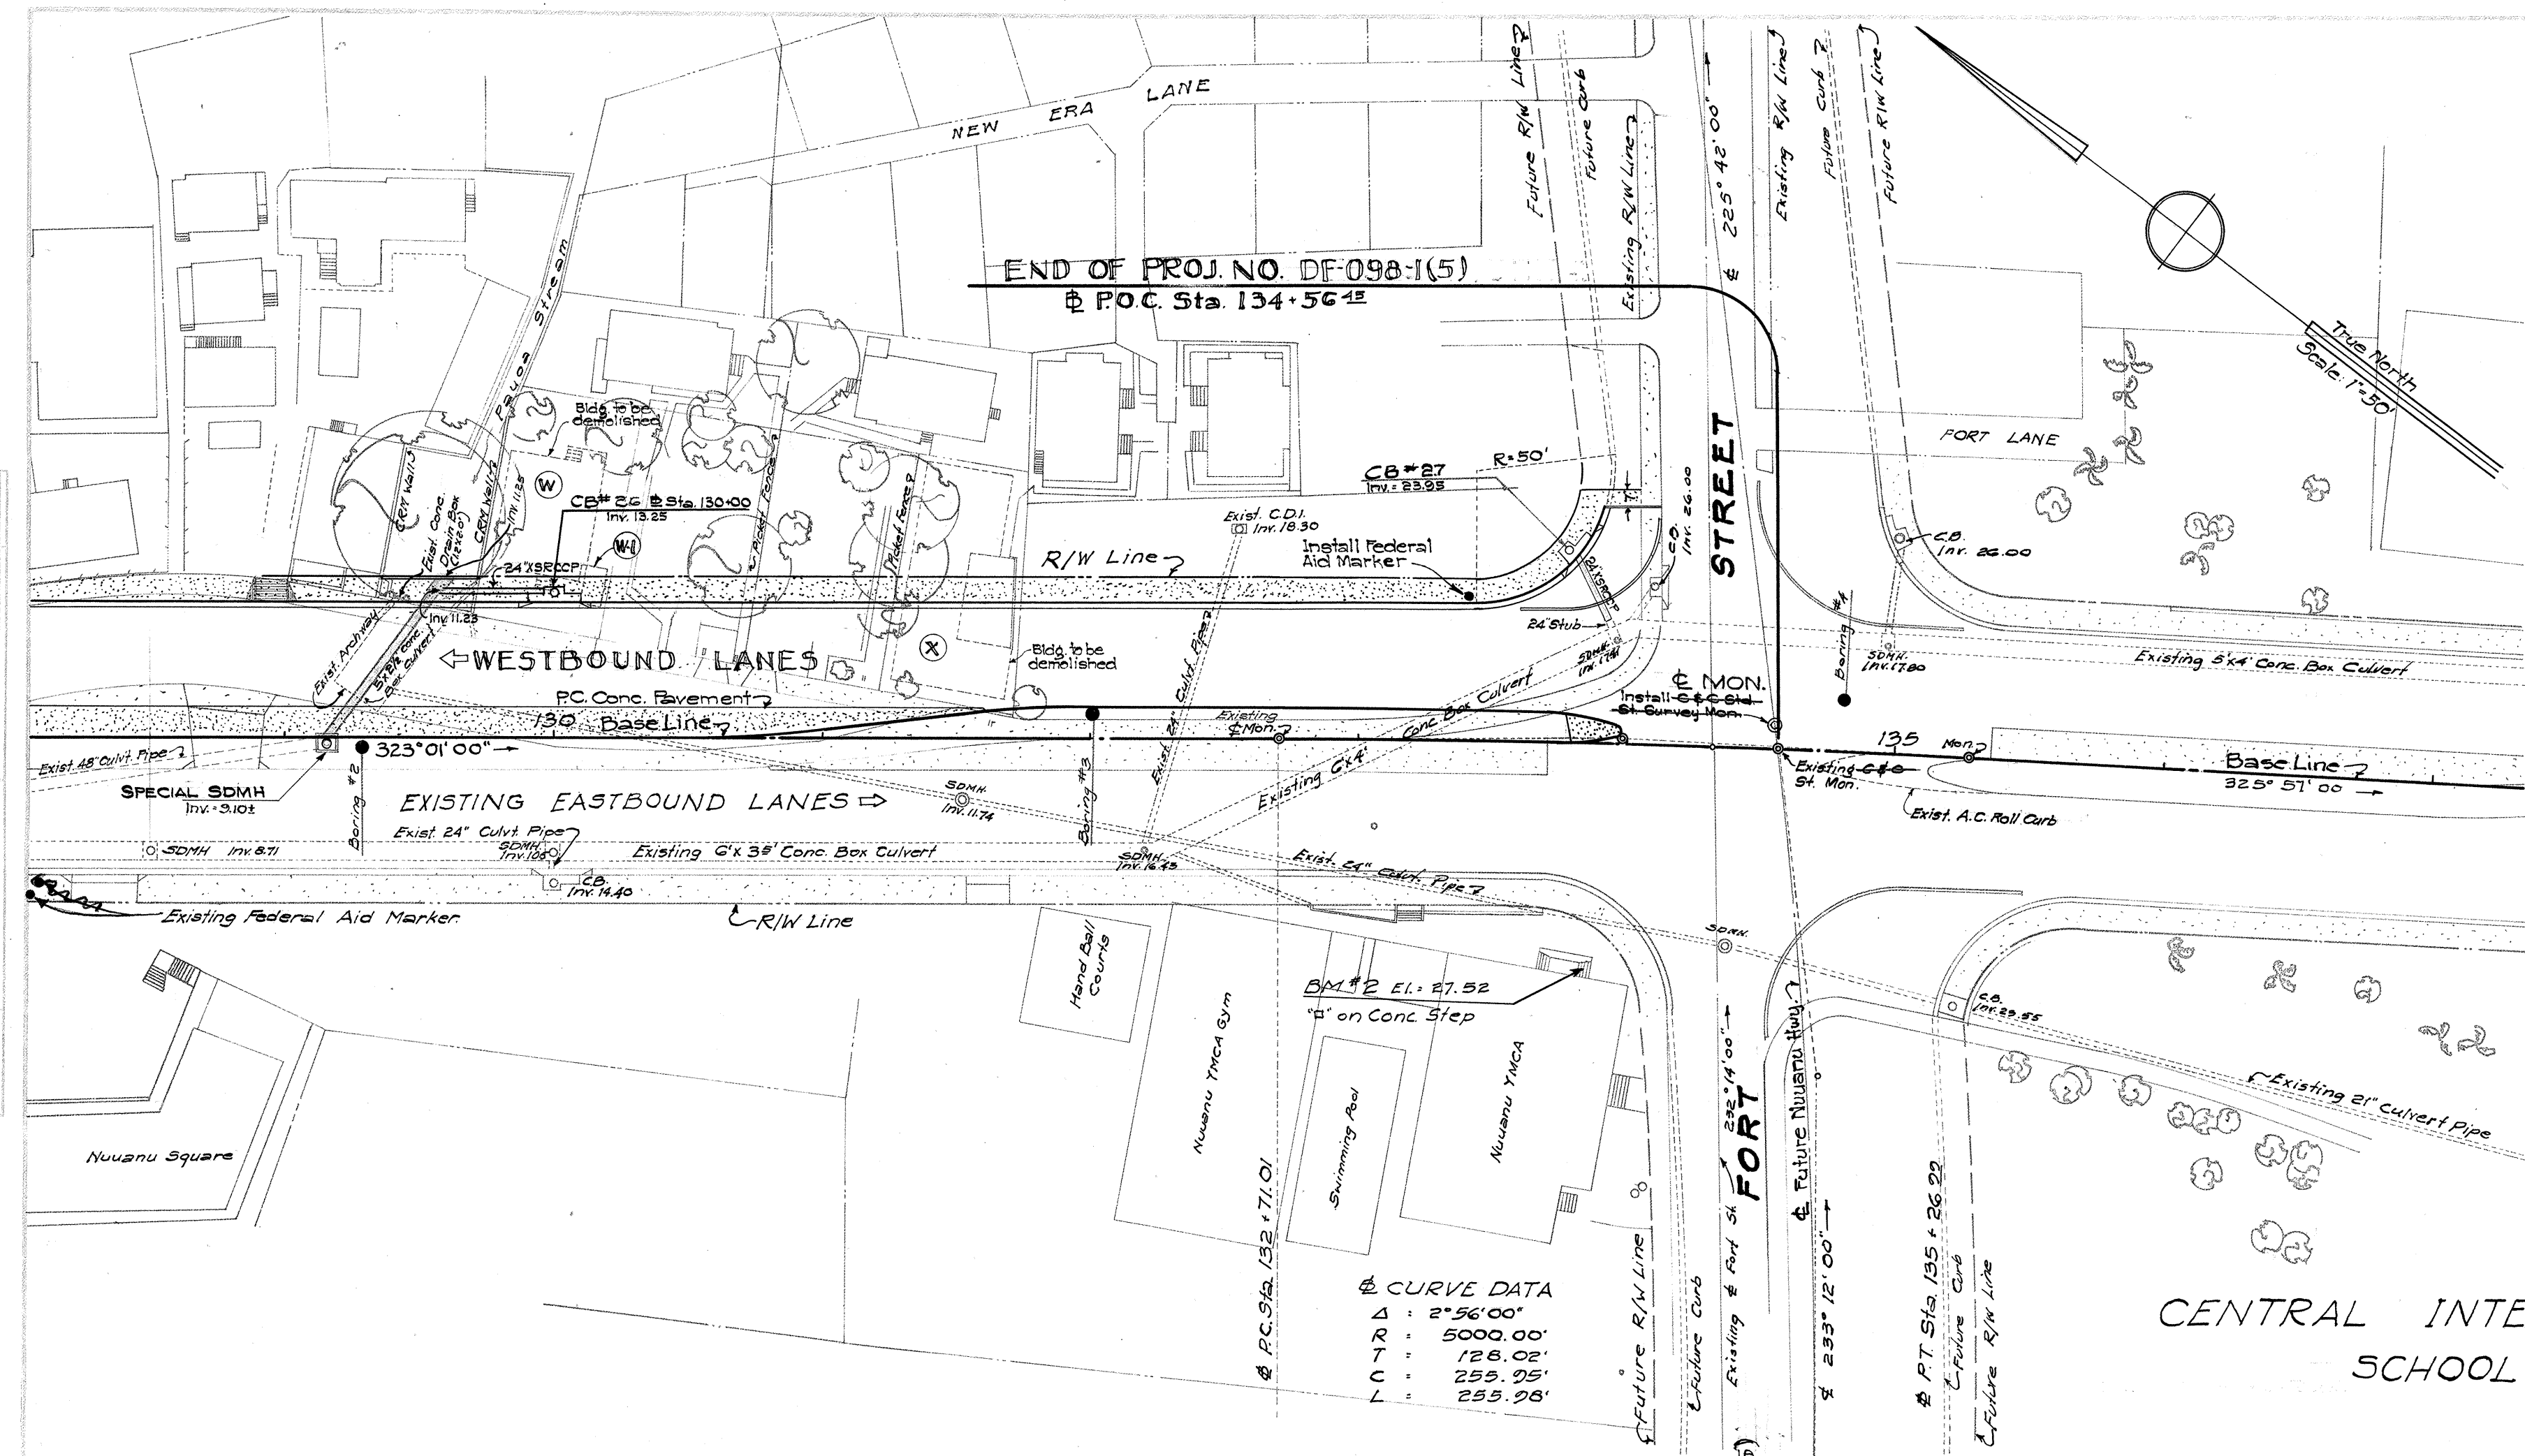

PROFILE
STARTED: 1/15/58
PROJECTED: 1/15/58
NOTE: BOOK NO. 1000 CHECKED BY: [Signature]
NO.

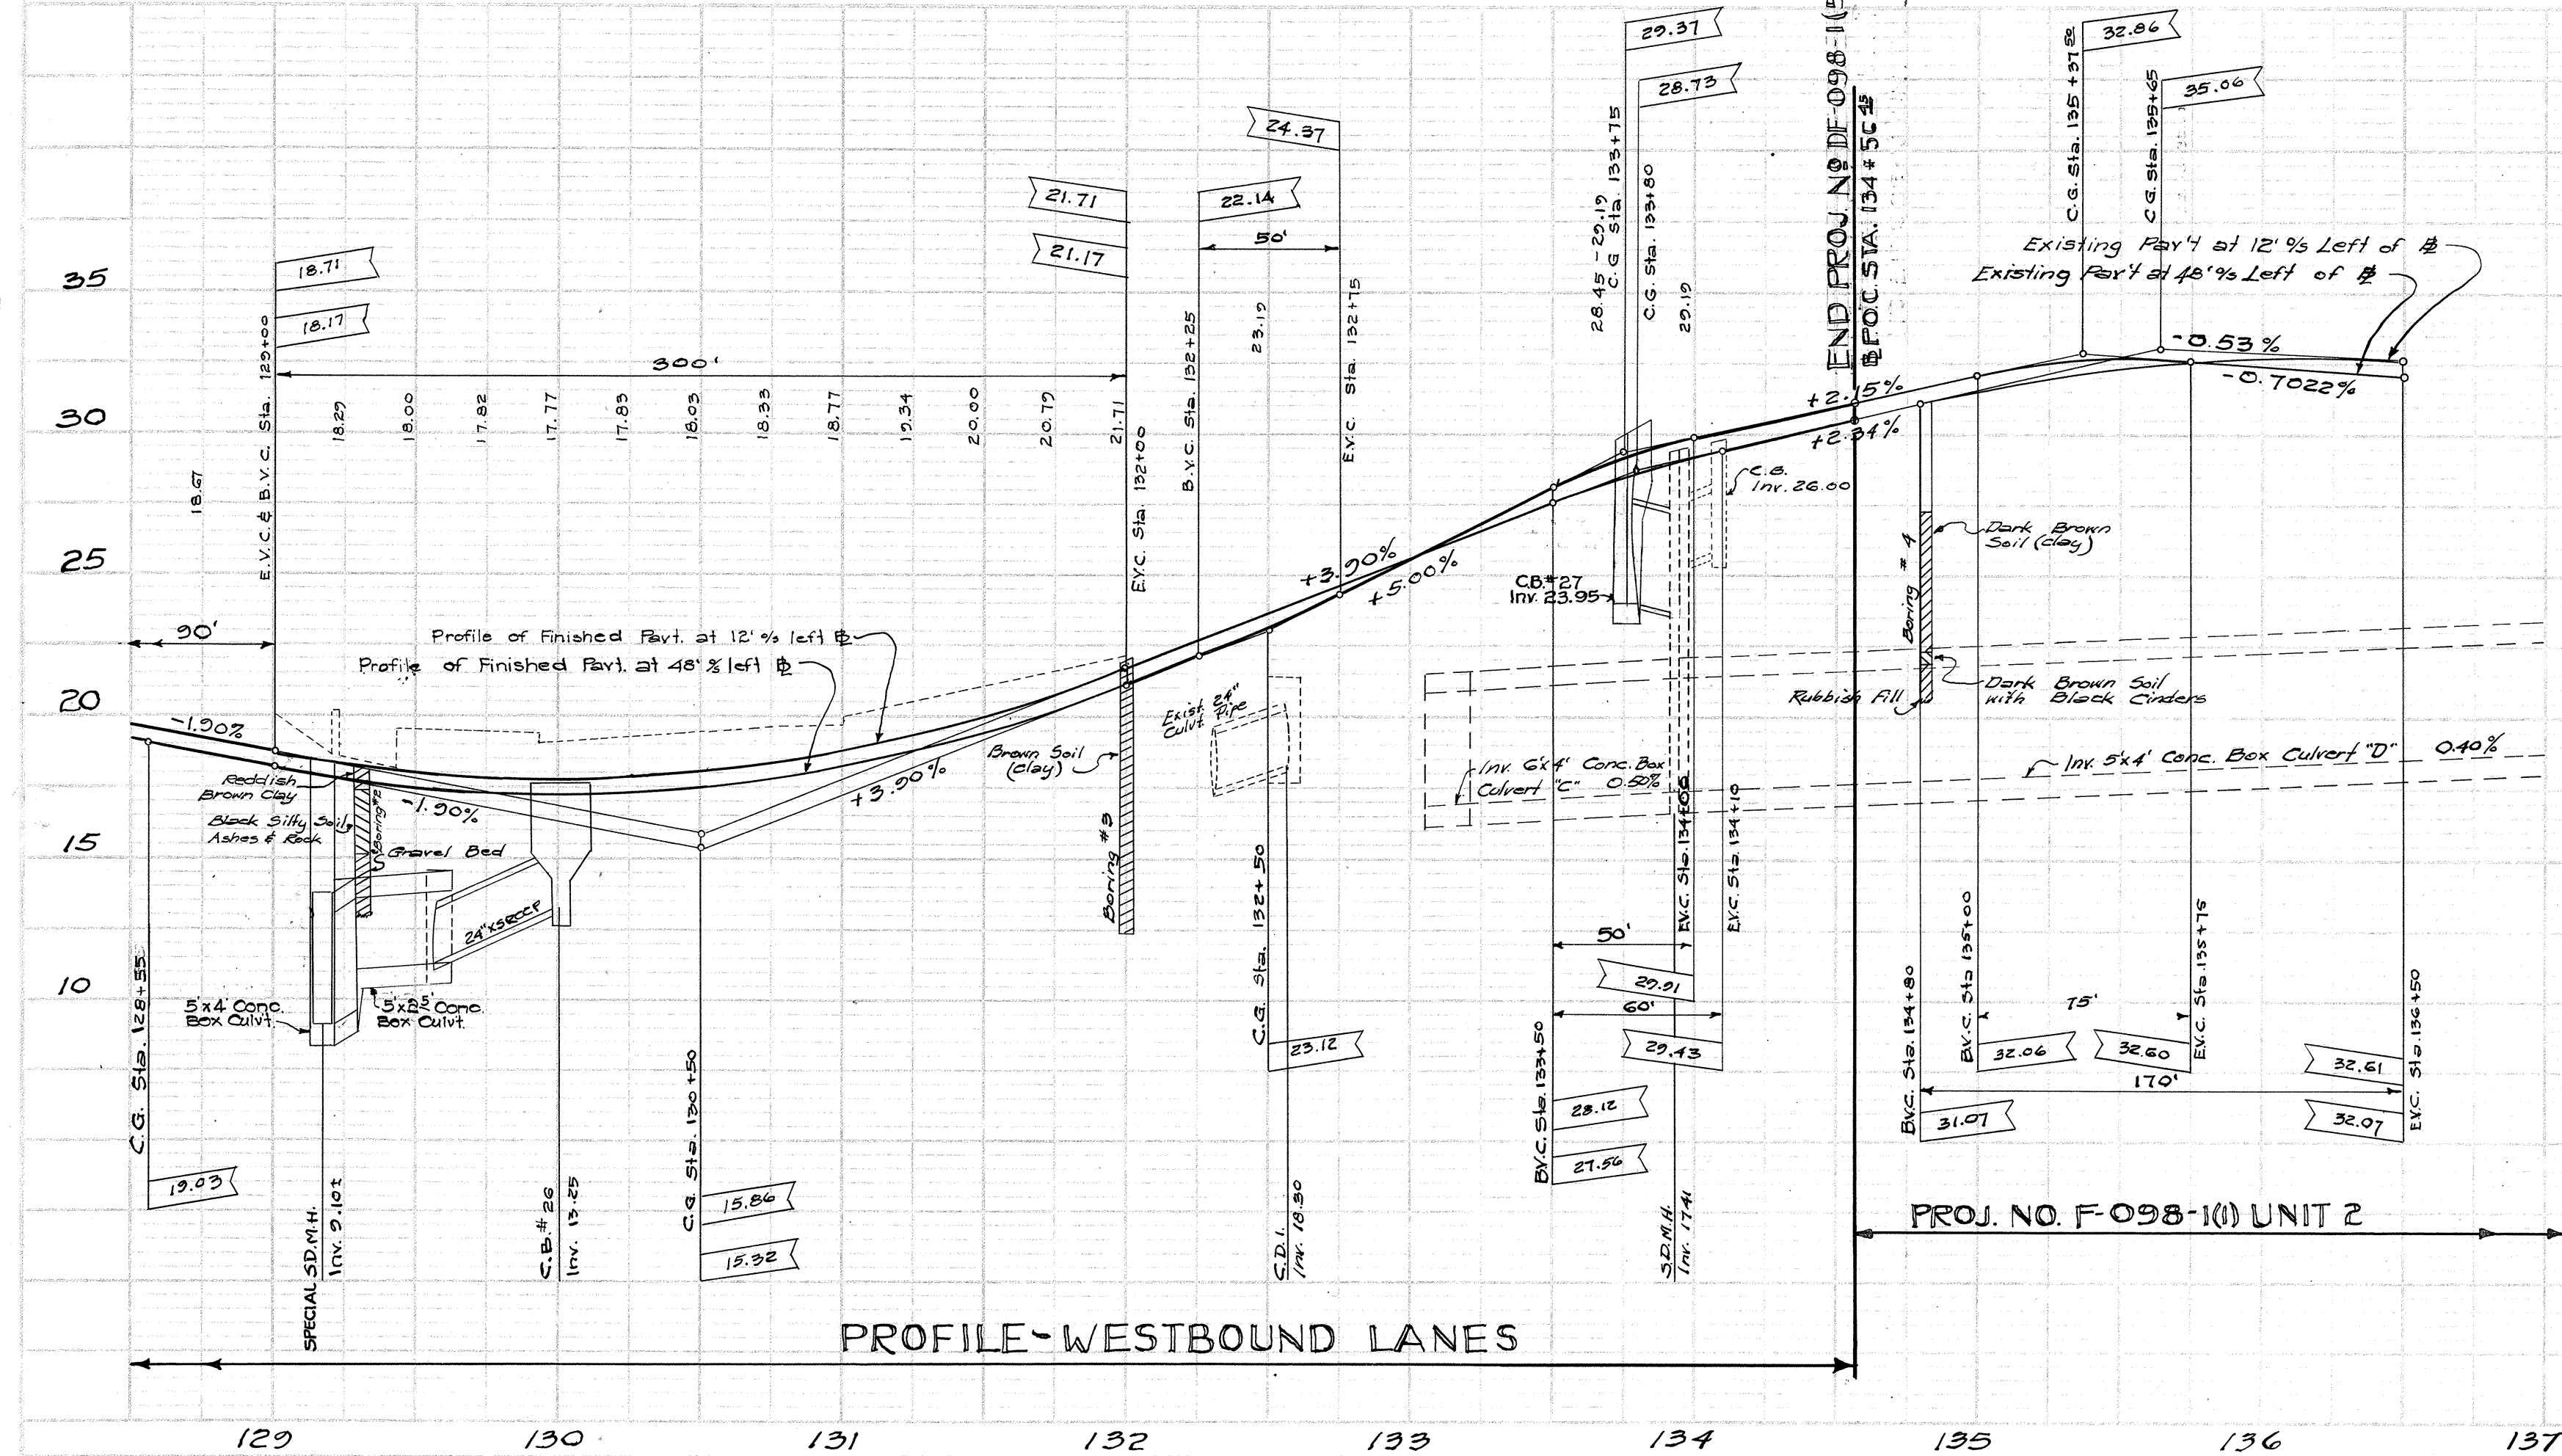

(THIS SHEET INCLUDES THE AS-BUILT CHANGES)

5882.07

DD-P-15

7