


CONSTRUCTION SCHEDULING AND TRAFFIC PLAN FOR
VINEYARD THOROUGHFARE F.A.P.
DF-098-1(5)

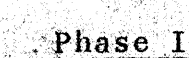

A. Construction Schedule


- (1) Westbound lanes and Mauka half of median from Palama St. to Liliha St. Install concrete box culvert.
- (2) Eastbound lanes and majority of median from Liliha St. to College Walk. Connect new drains into existing concrete box culvert along Vineyard St.
- (3) Demolish old Vineyard St. bridge and construct entire new Nuuanu Stream Bridge. 12" Water line across Nuuanu Stream to be installed at same time.
- (4) Westbound lanes and median from River Street to Nuuanu Avenue.

B. Traffic Plan

- (1) Two-way traffic flow between Palama St. and Liliha St. along makai half of Vineyard St. only. No Parking permitted on Vineyard St. during this phase of construction.

At least one access maintained at all times to Palama Settlement and Waipa Lane. Access at all times to Pua Lane and Lane "B". The contractor's attention is called to Section 7.5, "Public Convenience," of the T.H. Standard Specifications for Road and Bridge Construction, dated May, 1957.

- (2) Two-way traffic flow between Liliha St. and College Walk. At least one access provided at all times to Buckle Lane. Parking allowed on Mauka side only.
- (3) Existing Nuuanu Stream Bridge closed to traffic during re-construction. Vehicular traffic to use Kukui St. Bridge.
- (4) One-way traffic flow (clockwise circulation) between River St. and Nuuanu Ave. Parking permitted on Makai side only.

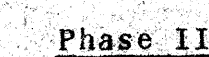

A. Construction Schedule

- (1) Eastbound lanes and Makai half of median from Palmsa St. to Liliha St.
- (2) Westbound lanes and remainder of median from Liliha St. to College Walk.
- (3) Construction of new bridge to continue until completed.
- (4) Eastbound lanes from River St. to Nuuanu Ave.

B. Traffic

- (1) Two-way traffic flow on completed Westbound Lanes between Palama and Liliha Sts. Access maintained at all times to Palama St., Lane "A", Pua Lane and Mayor Wright Homes Parking Lot. No parking permitted at any time. The contractor's attention is called to Section 7.5, "Public Convenience," of the T.H. Standard Specifications for Road and Bridge Construction, dated May, 1957.
- (2) Two-way traffic flow on completed Eastbound lanes between Liliha St. and Collage Walk. Access maintained at all times to Kauluwela Lane I, Chun Hoon Lane, Kauluwela Lane II and Lane "C". No parking permitted at any time.
- (3) Nuuanu Stream Bridge closed until completed.
- (4) One-way traffic flow (clockwise circulation) between River St. and Nuuanu Ave. No parking permitted at any time.

(NO AS-BUILT CHANGES
ON THIS SHEET

TERRITORIAL HIGHWAY DEPARTMENT
TERRITORY OF HAWAII

TRAFFIC ROUTING PLAN

VINEYARD THOROUGHFARE

PALAMA ST. TO FORT ST.

PROJECT No DF-098-1(5)

Scale: 1" = 200'

SHEET No. 1 OF 1 SHEETS

5882.17

(1)