


PLAN	DATE
BY	
CHECKED	
NOTED	
NO.	

PROFILE	DATE
BY	
CHECKED	
NOTED	
NO.	

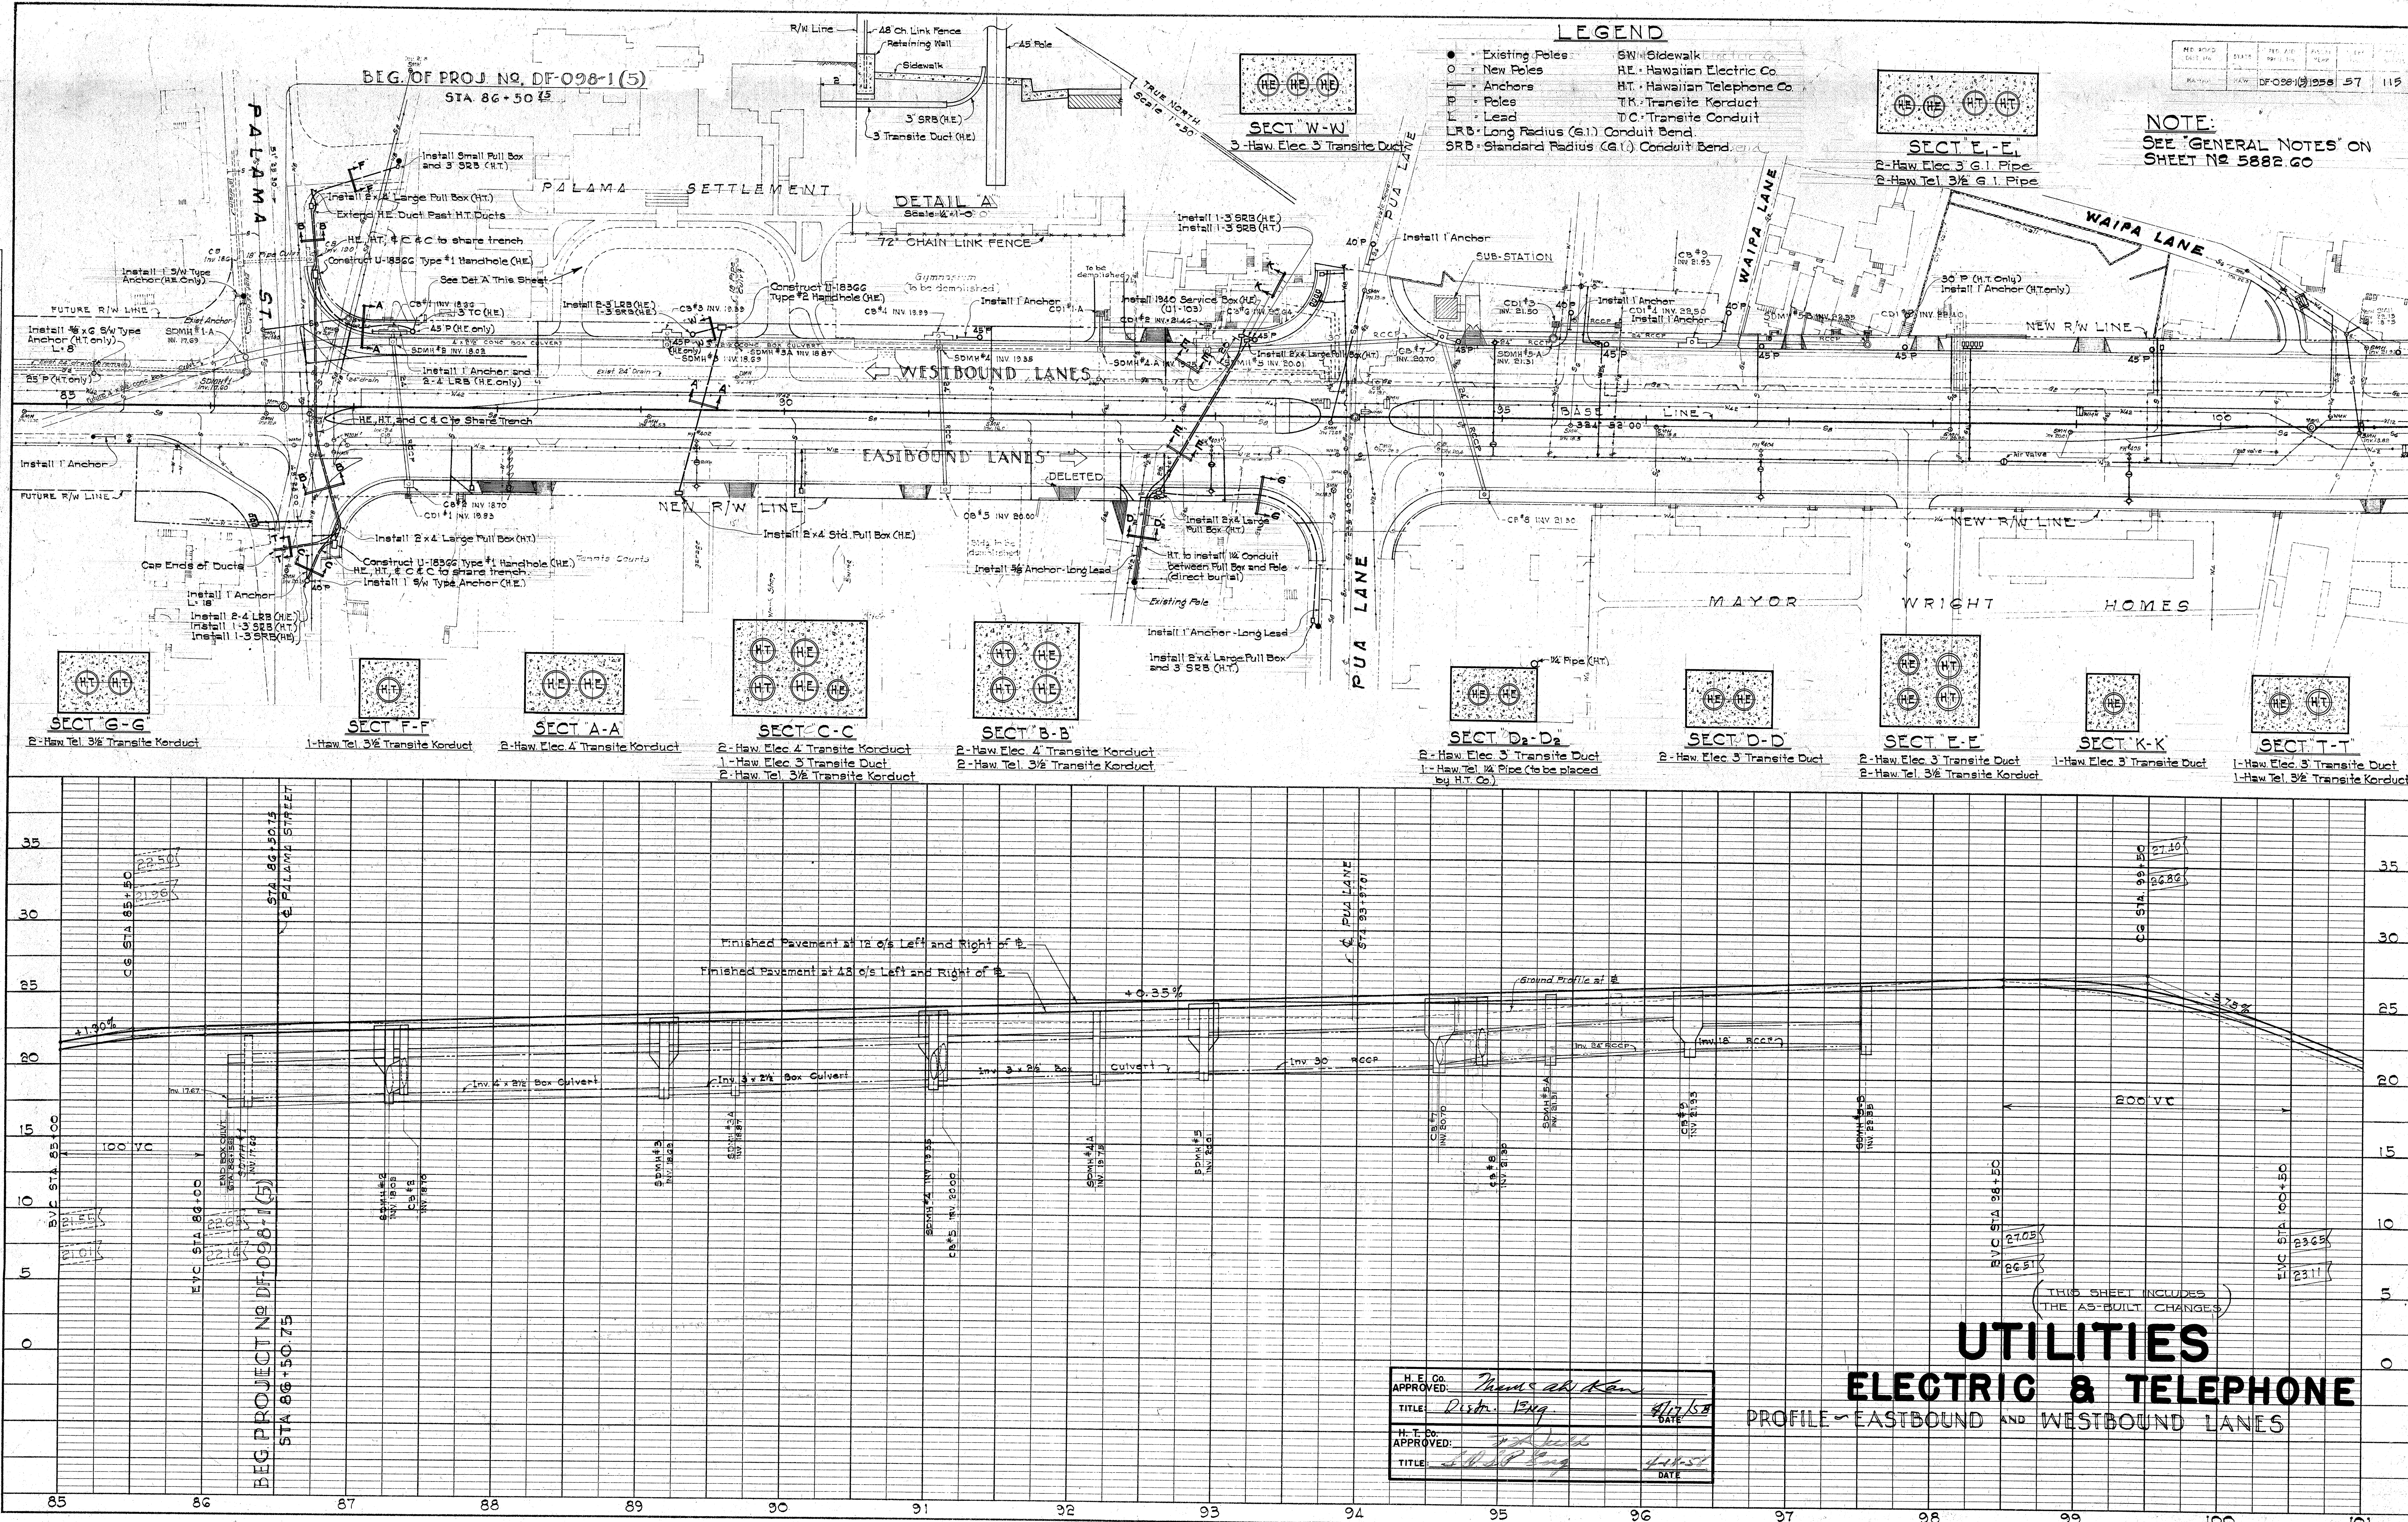

LEGEND

- Existing Poles
- New Poles
- Transit
- Lead
- Long Radius (G.I.) Conduit Bend
- Standard Radius (G.I.) Conduit Bend
- SW - Sidewalk
- HE - Hawaiian Electric Co.
- HT - Hawaiian Telephone Co.
- TK - Transite Korduct
- TC - Transite Conduit

NOTE:
SEE "GENERAL NOTES" ON
SHEET NO. 5882.00

H. E. Co.	APPROVED	<i>Thomas A. Kan</i>	DATE	4/12/58
TITLE	Dist. Eng.			
H. T. Co.	APPROVED	<i>J. A. Wells</i>	DATE	4-11-58
TITLE	Supt. Eng.			

UTILITIES ELECTRIC & TELEPHONE PROFILE - EASTBOUND AND WESTBOUND LANES

FED. ROAD DIST. No.	STATE	FED. AID PROJ. No.	FISCAL YEAR	SHEET No.	TOTAL SHEETS
HAWAII	HAW.	DR098-1(6)	1958	58A	115

REVISED 12-10-58

NOTE:
SEE 'GENERAL NOTES' ON
SHEET No 5882.50

HT NOTE:

1. H.T. Ducts crossing under Cunha Lane 3 and Davis Lane and any other Lanes, shall be encased in concrete jacket.
2. Small Pull Box to be located where directed by H.T. Co. H.T. Co. to cut Subscribers conduit and cable and reroute into Pull Box.
3. Removing existing pull box shall be considered incidental to item of 'installing four ducts in jackets'.

DATE	BY	REVISION

PLAN

NO.

NO.


NO.

NO.

NO.

NO.

NOTE: FOR REVISED STORM DRAINAGE SYSTEM
B STA. 111+40 TO B STA. 115+21, SEE
SHT. No 5882.13-A

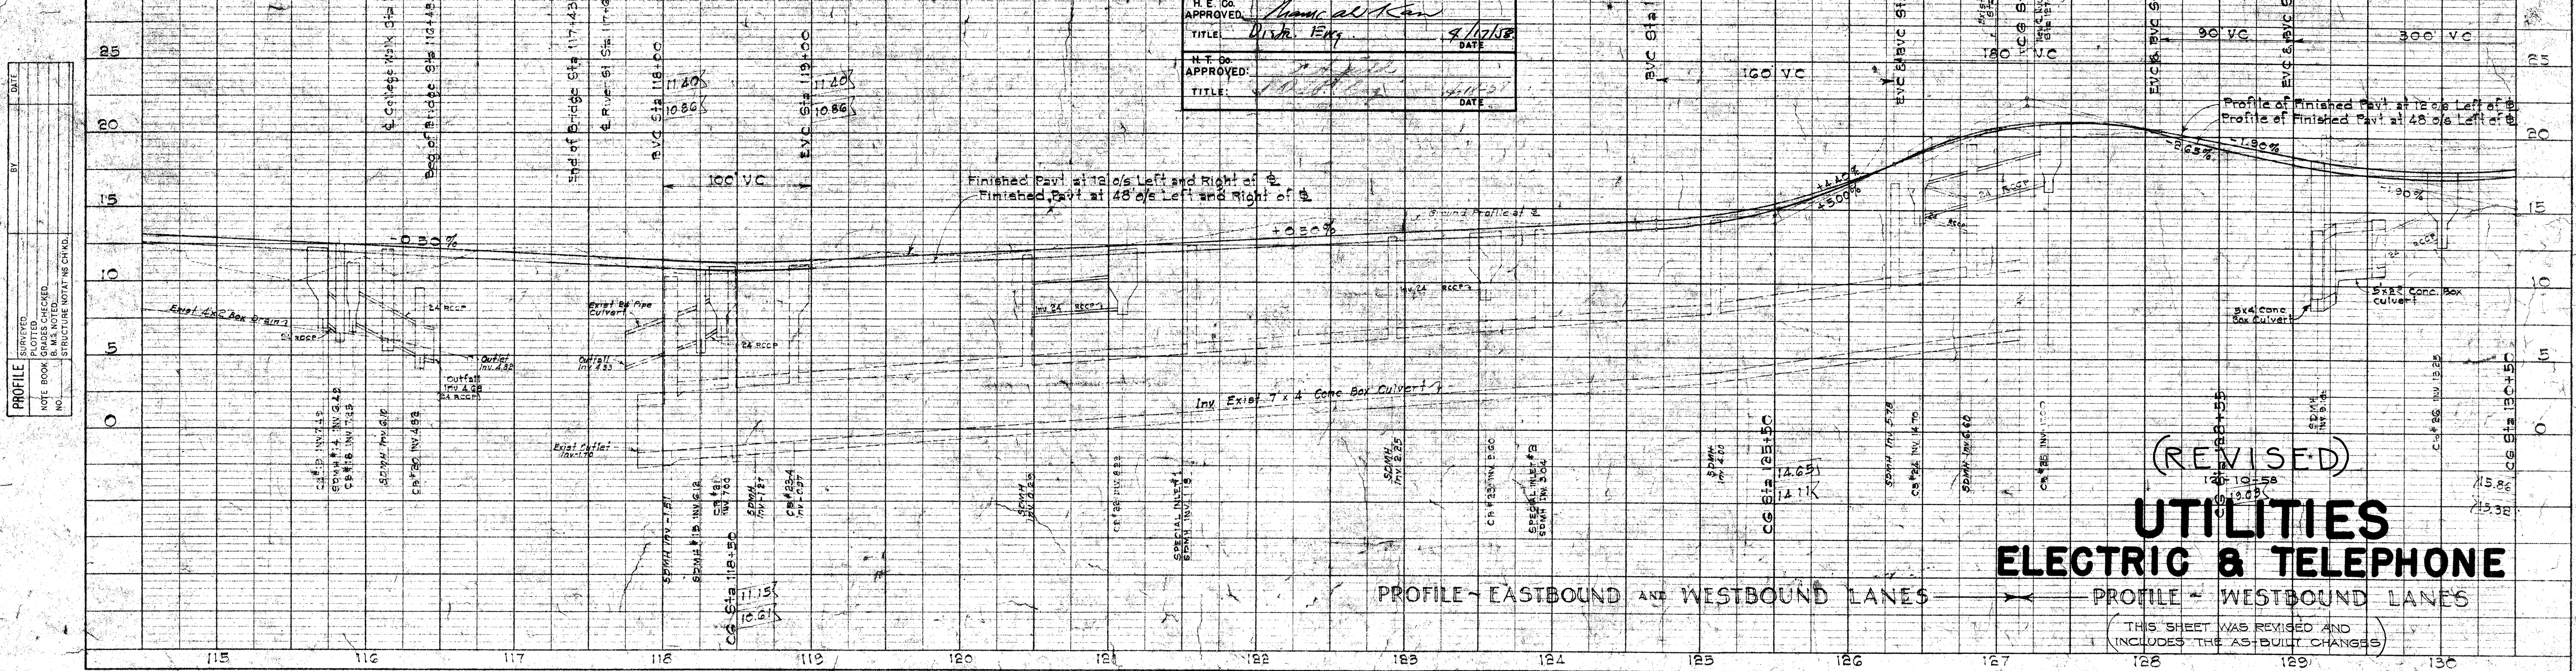

H.T. CO.	APPROVED:	<i>[Signature]</i>	DATE:	4/17/58
TITLE:	H.T. CO. 3\"/>			

(REVISED)

UTILITIES ELECTRIC & TELEPHONE


(THIS SHEET WAS REVISED AND
INCLUDES THE AS-BUILT CHANGES)

5882.59A

PLATE 1 - PLAN PROFILE - D.P.A.R.E. STANDARD
K & E CO. INC. 348-10A

PLAN	SURVEYED	DATE	BY	NOTES
NOTE BOOK	CHECKED	DATE	BY	NOTES

PROFILE	SURVEYED	DATE	BY	NOTES
NOTE BOOK	CHECKED	DATE	BY	NOTES

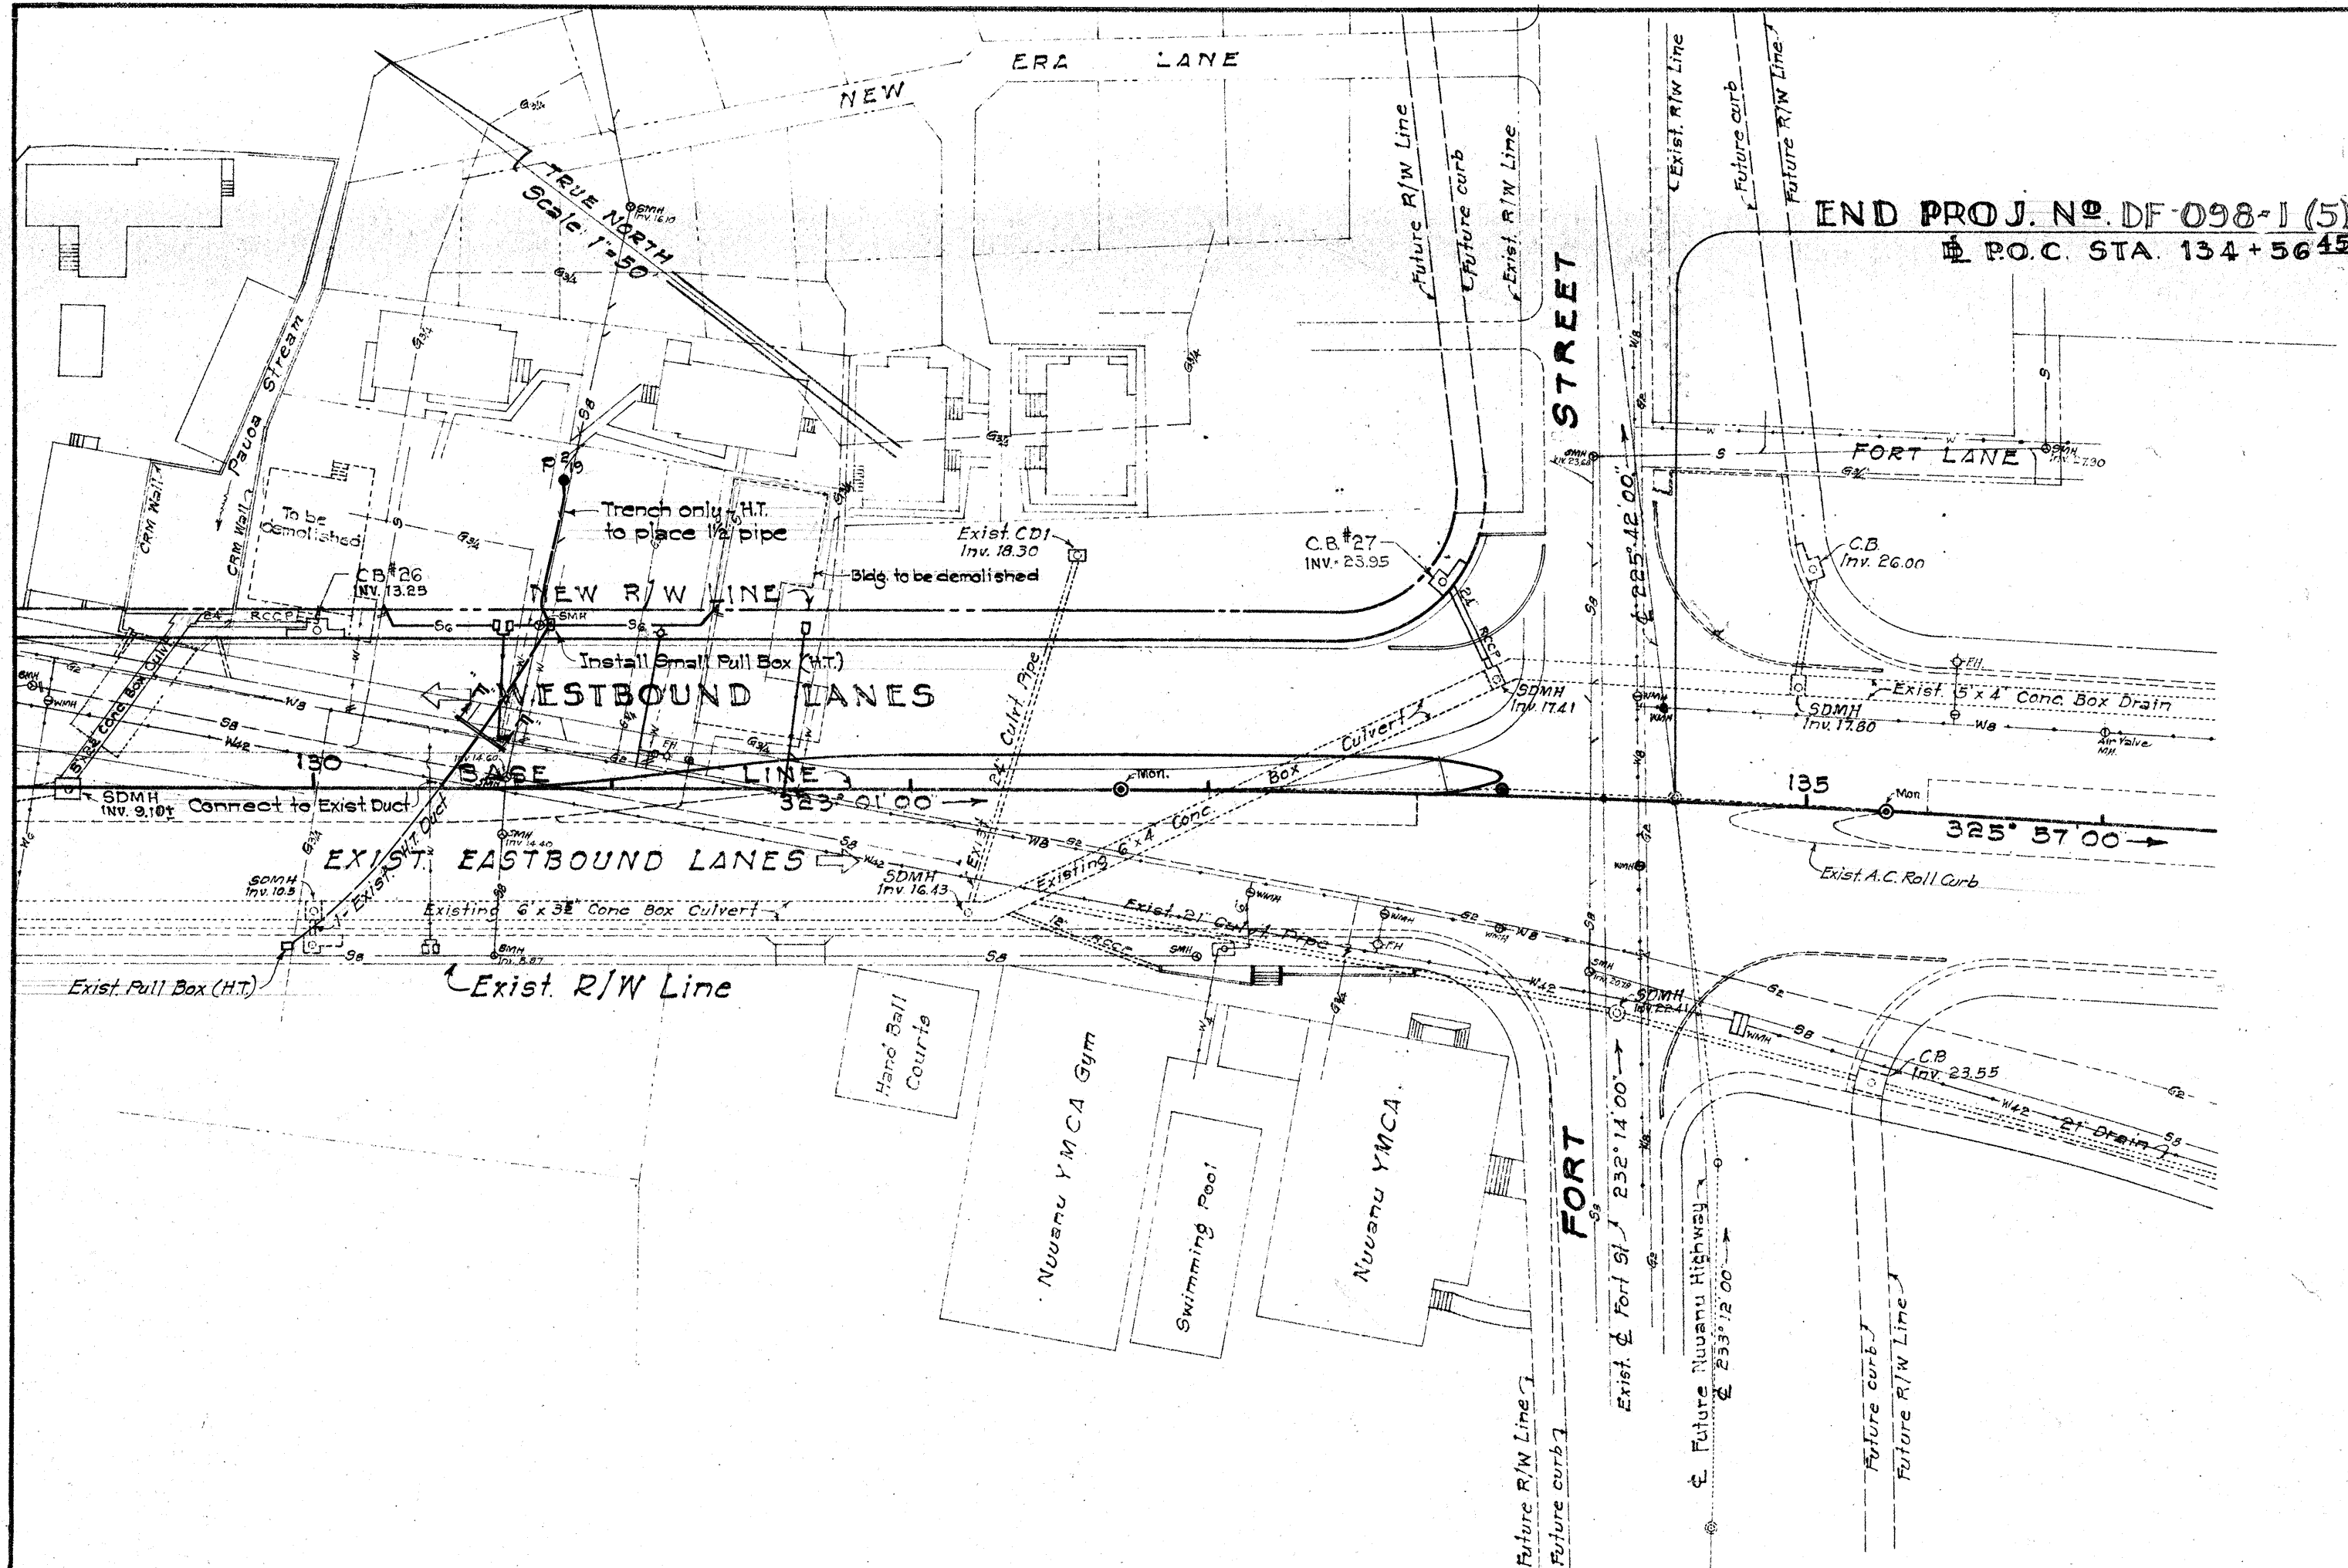

POLE SETTING DEPTH DATA




POLE LENGTH	DEPTH FROM FINISHED GRADE	IN SOIL	IN ROCK	APPROX. HOLE DIA.
25	4'-6"	3'-0"	1'-4"	1'-4"
30	5'-0"	3'-0"	1'-4"	1'-4"
35	5'-0"	3'-0"	1'-4"	1'-4"
40	5'-0"	3'-0"	1'-4"	1'-4"
45	6'-0"	4'-0"	1'-8"	1'-8"
50	6'-0"	4'-0"	1'-8"	1'-8"
55	7'-0"	4'-6"	1'-10"	1'-10"
60	7'-0"	4'-6"	1'-10"	1'-10"

ANCHOR SETTING DATA REFER TO THE FOLLOWING STANDARDS


ANCHORING DATA	OS-101
GUY ANCHOR 18' DEADMAN	OS-102
GUY ANCHOR 24' DEADMAN	OS-103
SIDEWALK ANCHOR	OS-104
ROCK ANCHOR	OS-105

GENERAL NOTES

- MINIMUM DEPTH OF DUCT LINES 18' FROM FINISHED GRADE TO:
 - TOP OF CONCRETE JACKET WHERE DUCTS ARE CONCRETE ENCASED.
 - TOP OF DUCTS NOT ENCASED IN CONCRETE (DIRECT BURIAL)
- DEPTH OF ALL PULL BOXES, SERVICE BOXES, AND H.E. HANDHOLES TO BE DETERMINED IN THE FIELD.
- DEPTH OF POLES AND ANCHOR HOLES ARE TAKEN FROM FINISHED GRADE.
- INSTALLATION OF AND BACKFILL FOR POLES BY H.E. CO. AND H.T. CO.
- BACKFILL OF ANCHOR HOLES BY THE CONTRACTOR.
- POLES AND ANCHORS NOT NOTED H.E. OR H.T. ARE FOR BOTH UTILITIES.
- FOR POLE SETTING DEPTH DATA, SEE THIS SHEET.
- CITY AND COUNTY CONDUITS AND PULL BOXES (NOT SHOWN ON PLANS) SHARING TRENCHES WITH H.E. CO. AND/OR H.T. CO. WILL BE INSTALLED BY CITY AND COUNTY STREET LIGHTING DIVISION.
- DUCTS ENCASED IN CONCRETE JACKETS:
 - NORMAL DISTANCE FROM FACE OF CONCRETE JACKET TO ALL DUCTS TO BE 3" MINIMUM.
 - CLEAR DISTANCE OF 1/2" MINIMUM BETWEEN DUCTS OF SAME UTILITY CO.
 - CLEAR DISTANCE OF 3" MINIMUM BETWEEN H.E. DUCTS AND H.T. DUCTS.

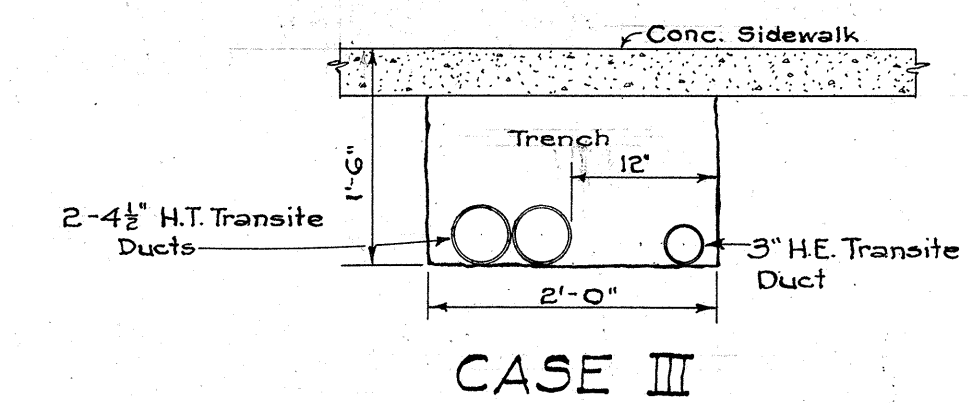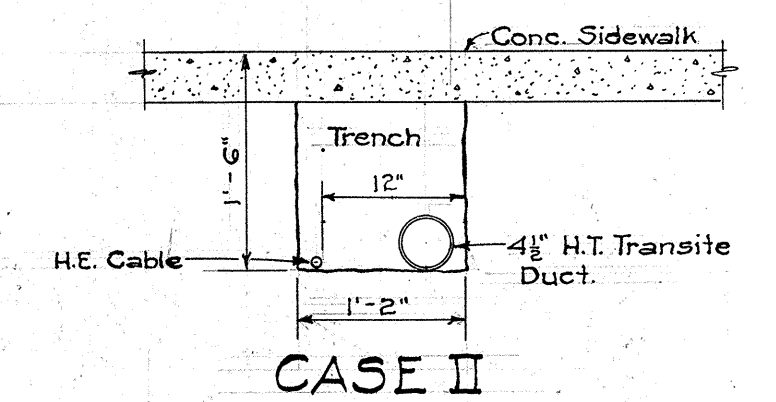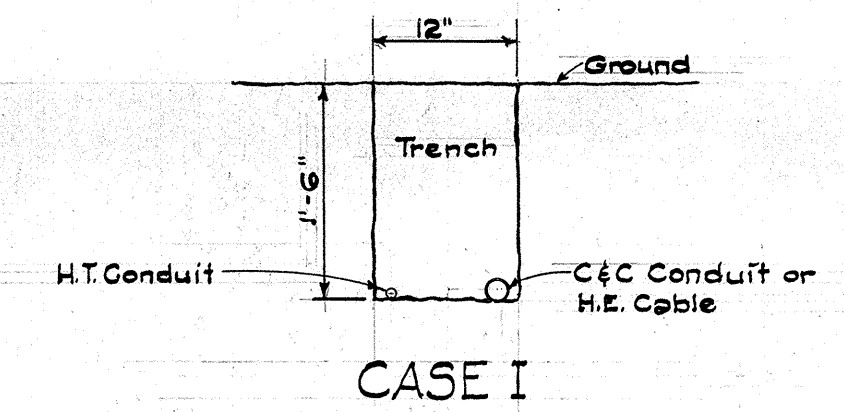

TYPICAL DETAIL OF TRENCHES FOR
TRANSITE DUCTS, CONDUITS AND CABLES
(DIRECT BURIAL)
Scale: 3/4" = 1'-0"

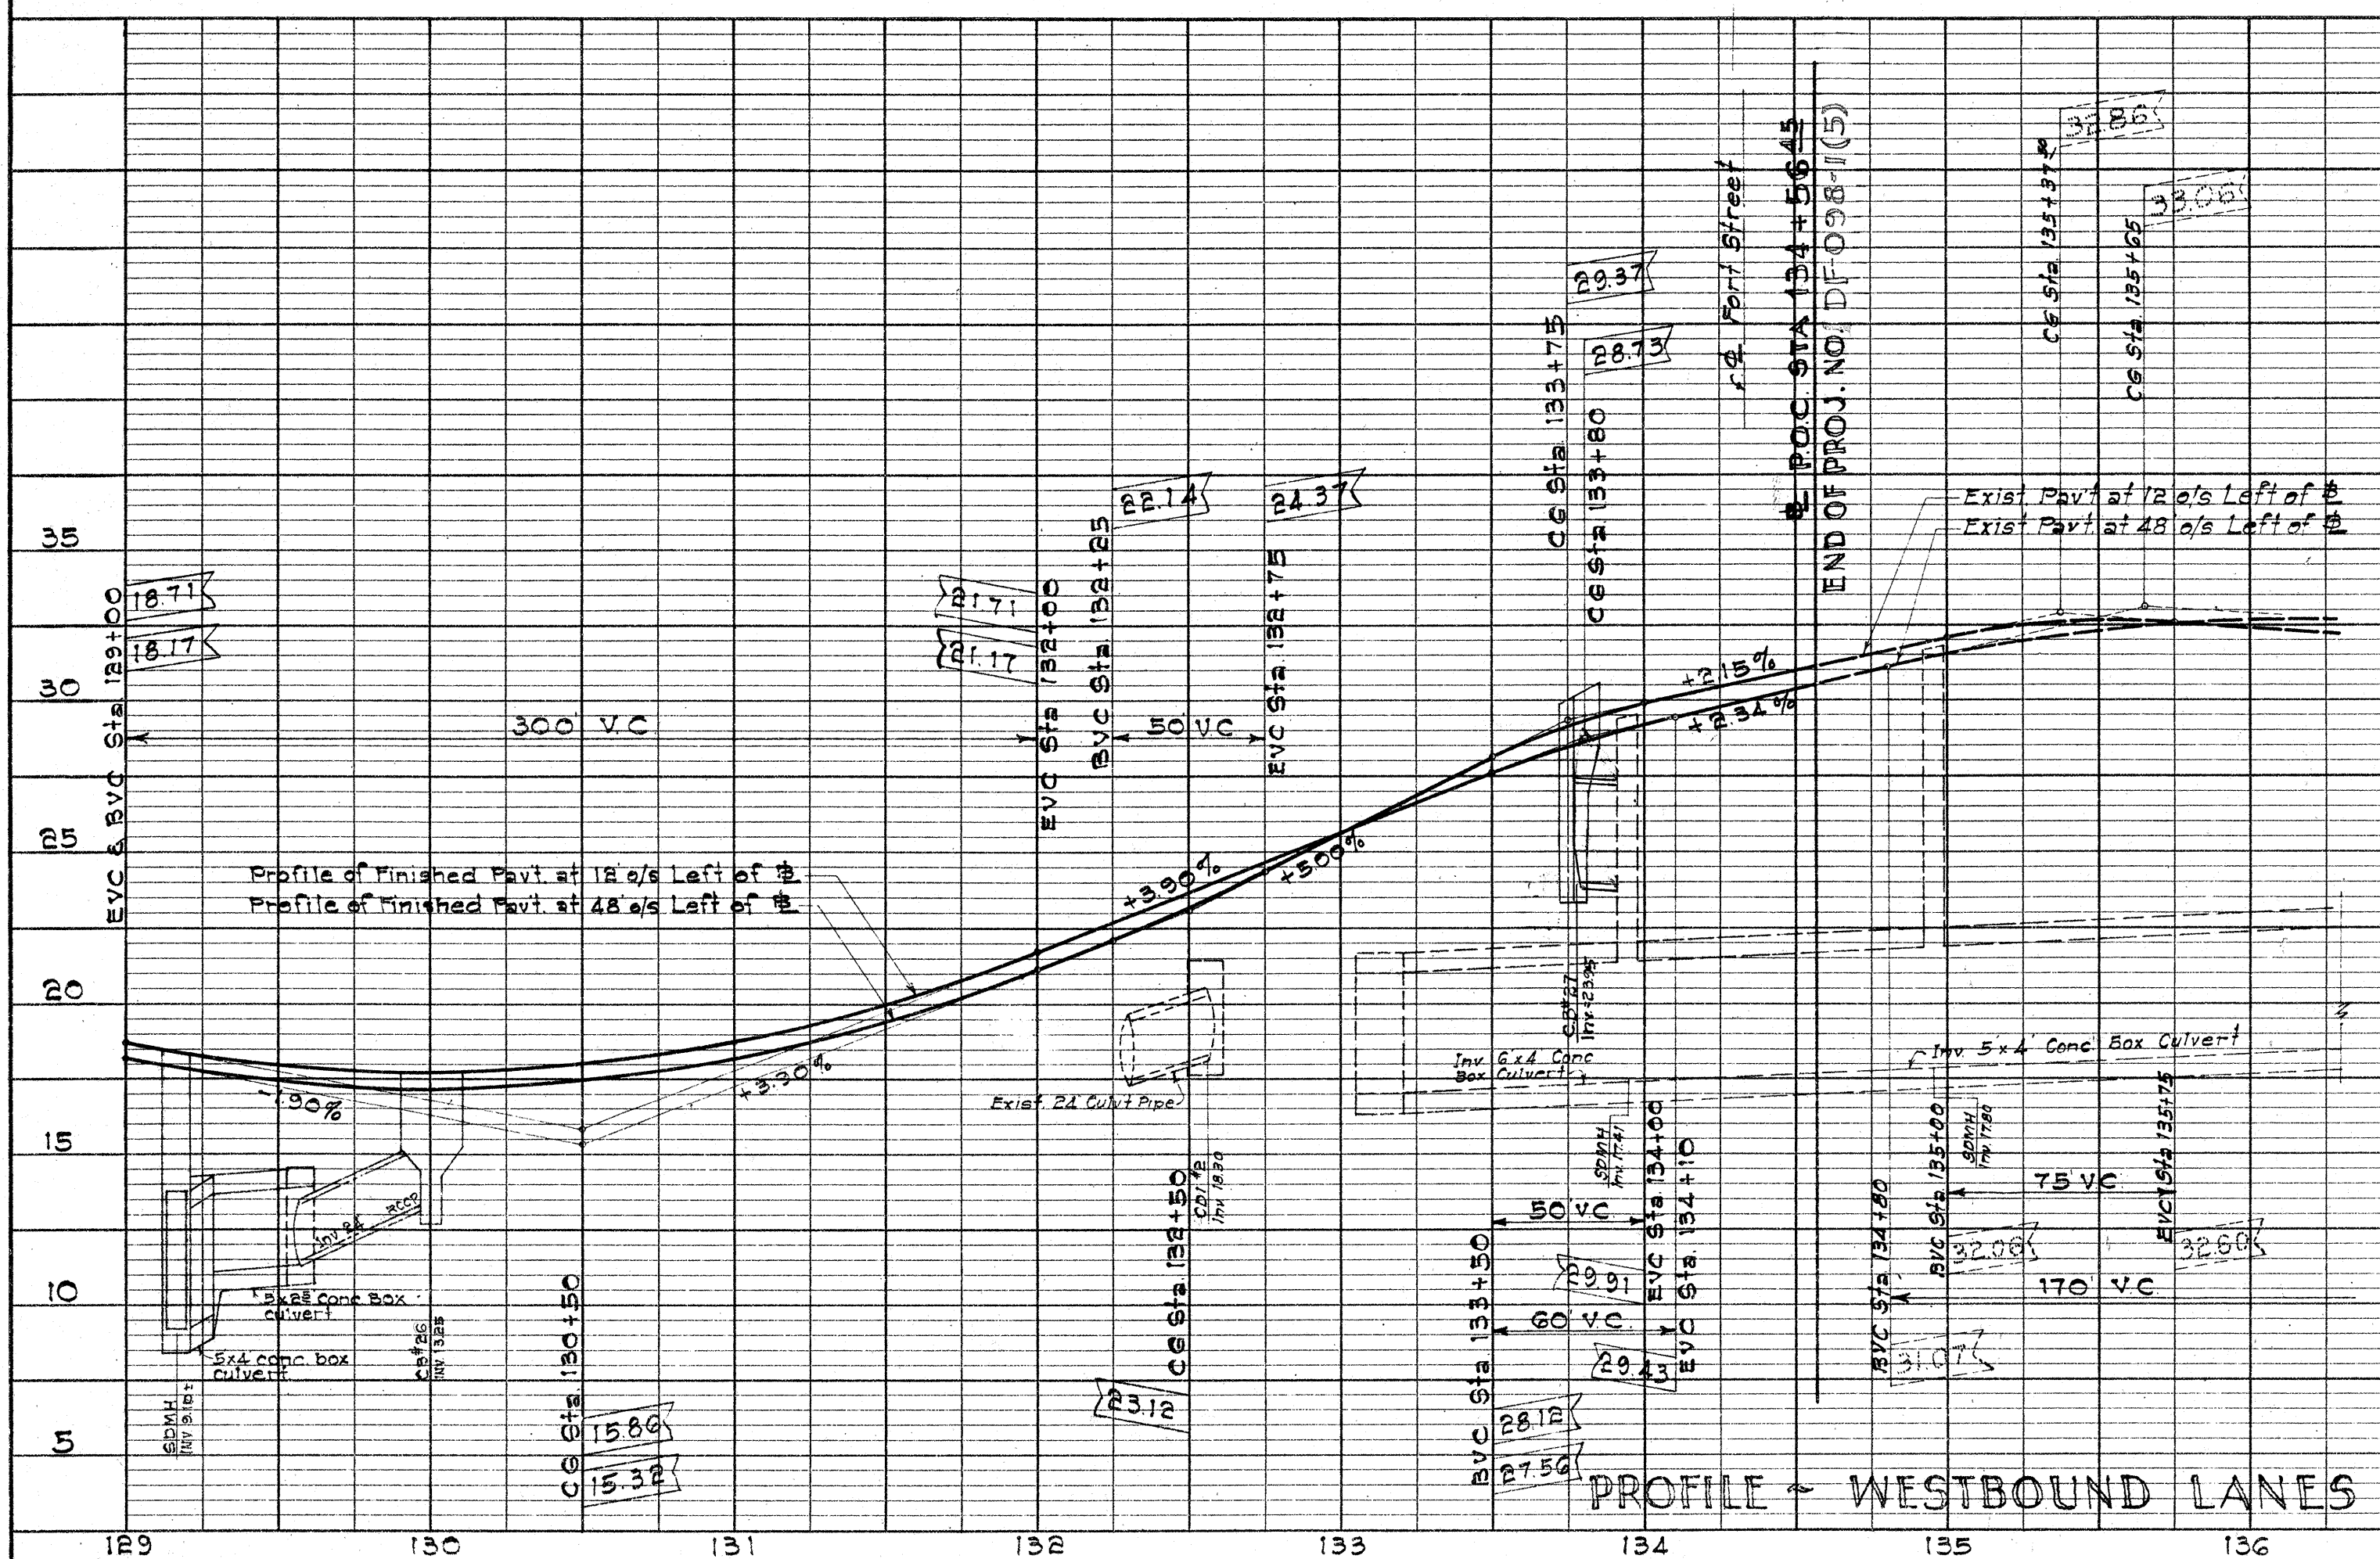


H.E. CO. APPROVED:	<i>Manuel de la Cruz</i>	DATE	4/12/52
TITLE:	DISTR. R/W	DATE	4/12/52
H.T. CO. APPROVED:	<i>John J. Smith</i>	DATE	4/12/52
TITLE:	UTILITY R/W	DATE	4/12/52


(NO AS-BUILT CHANGES
ON THIS SHEET)

UTILITIES


ELECTRIC & TELEPHONE

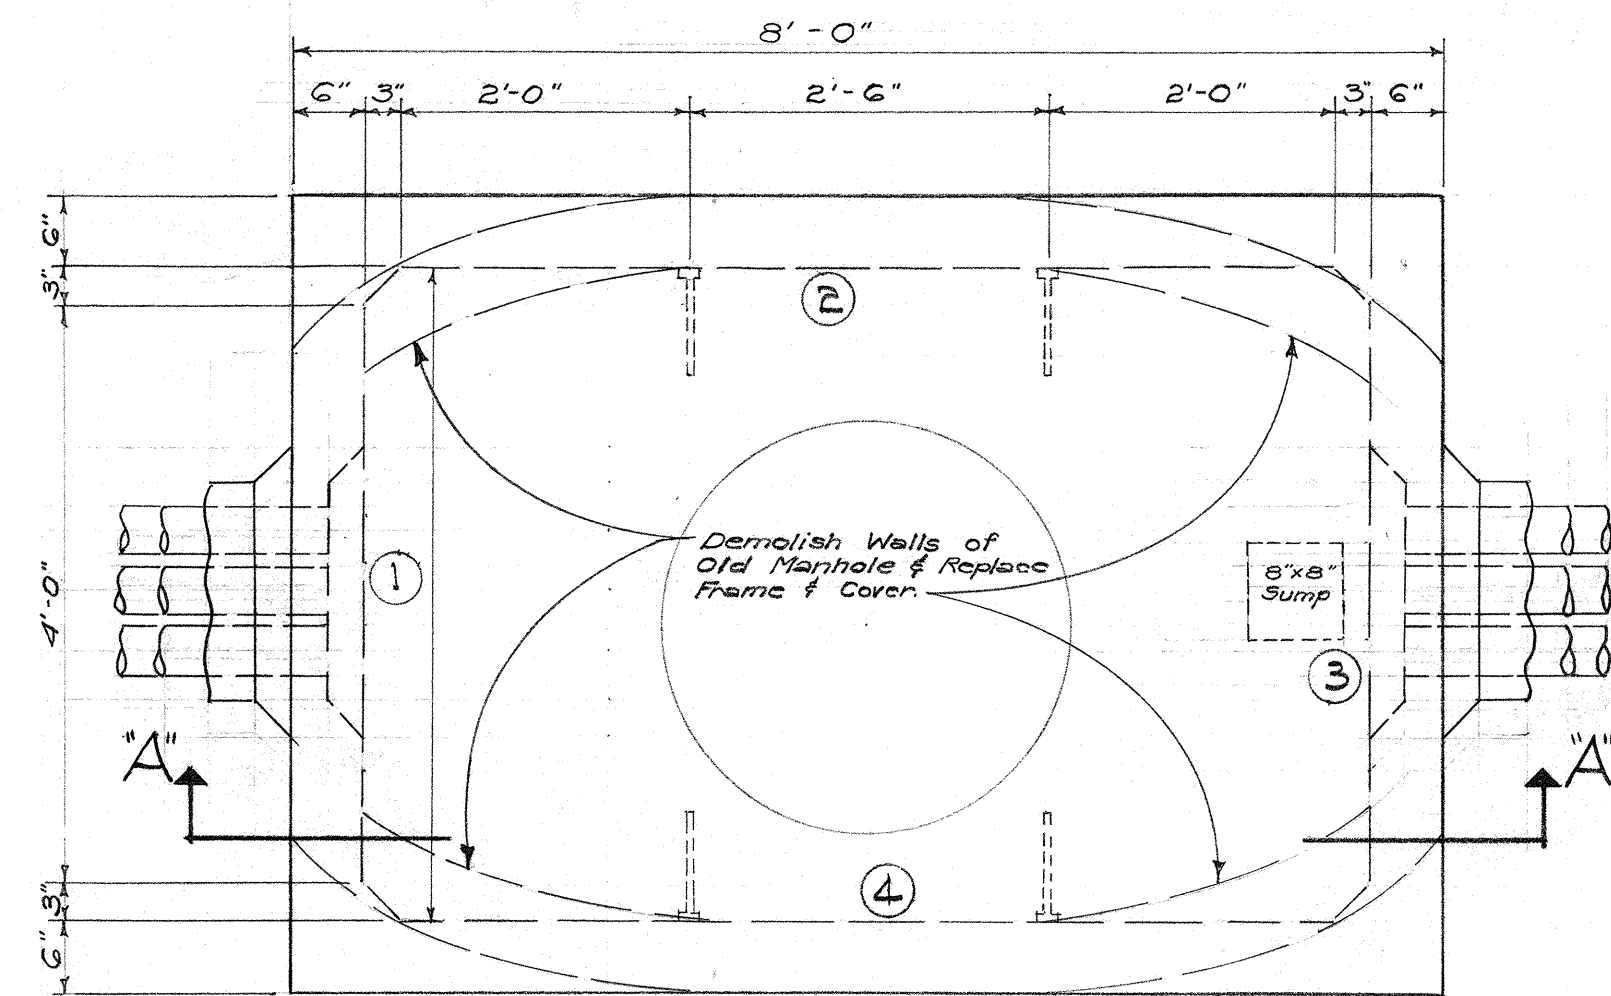


PLAN
Scale: 3/4" = 1'-0"

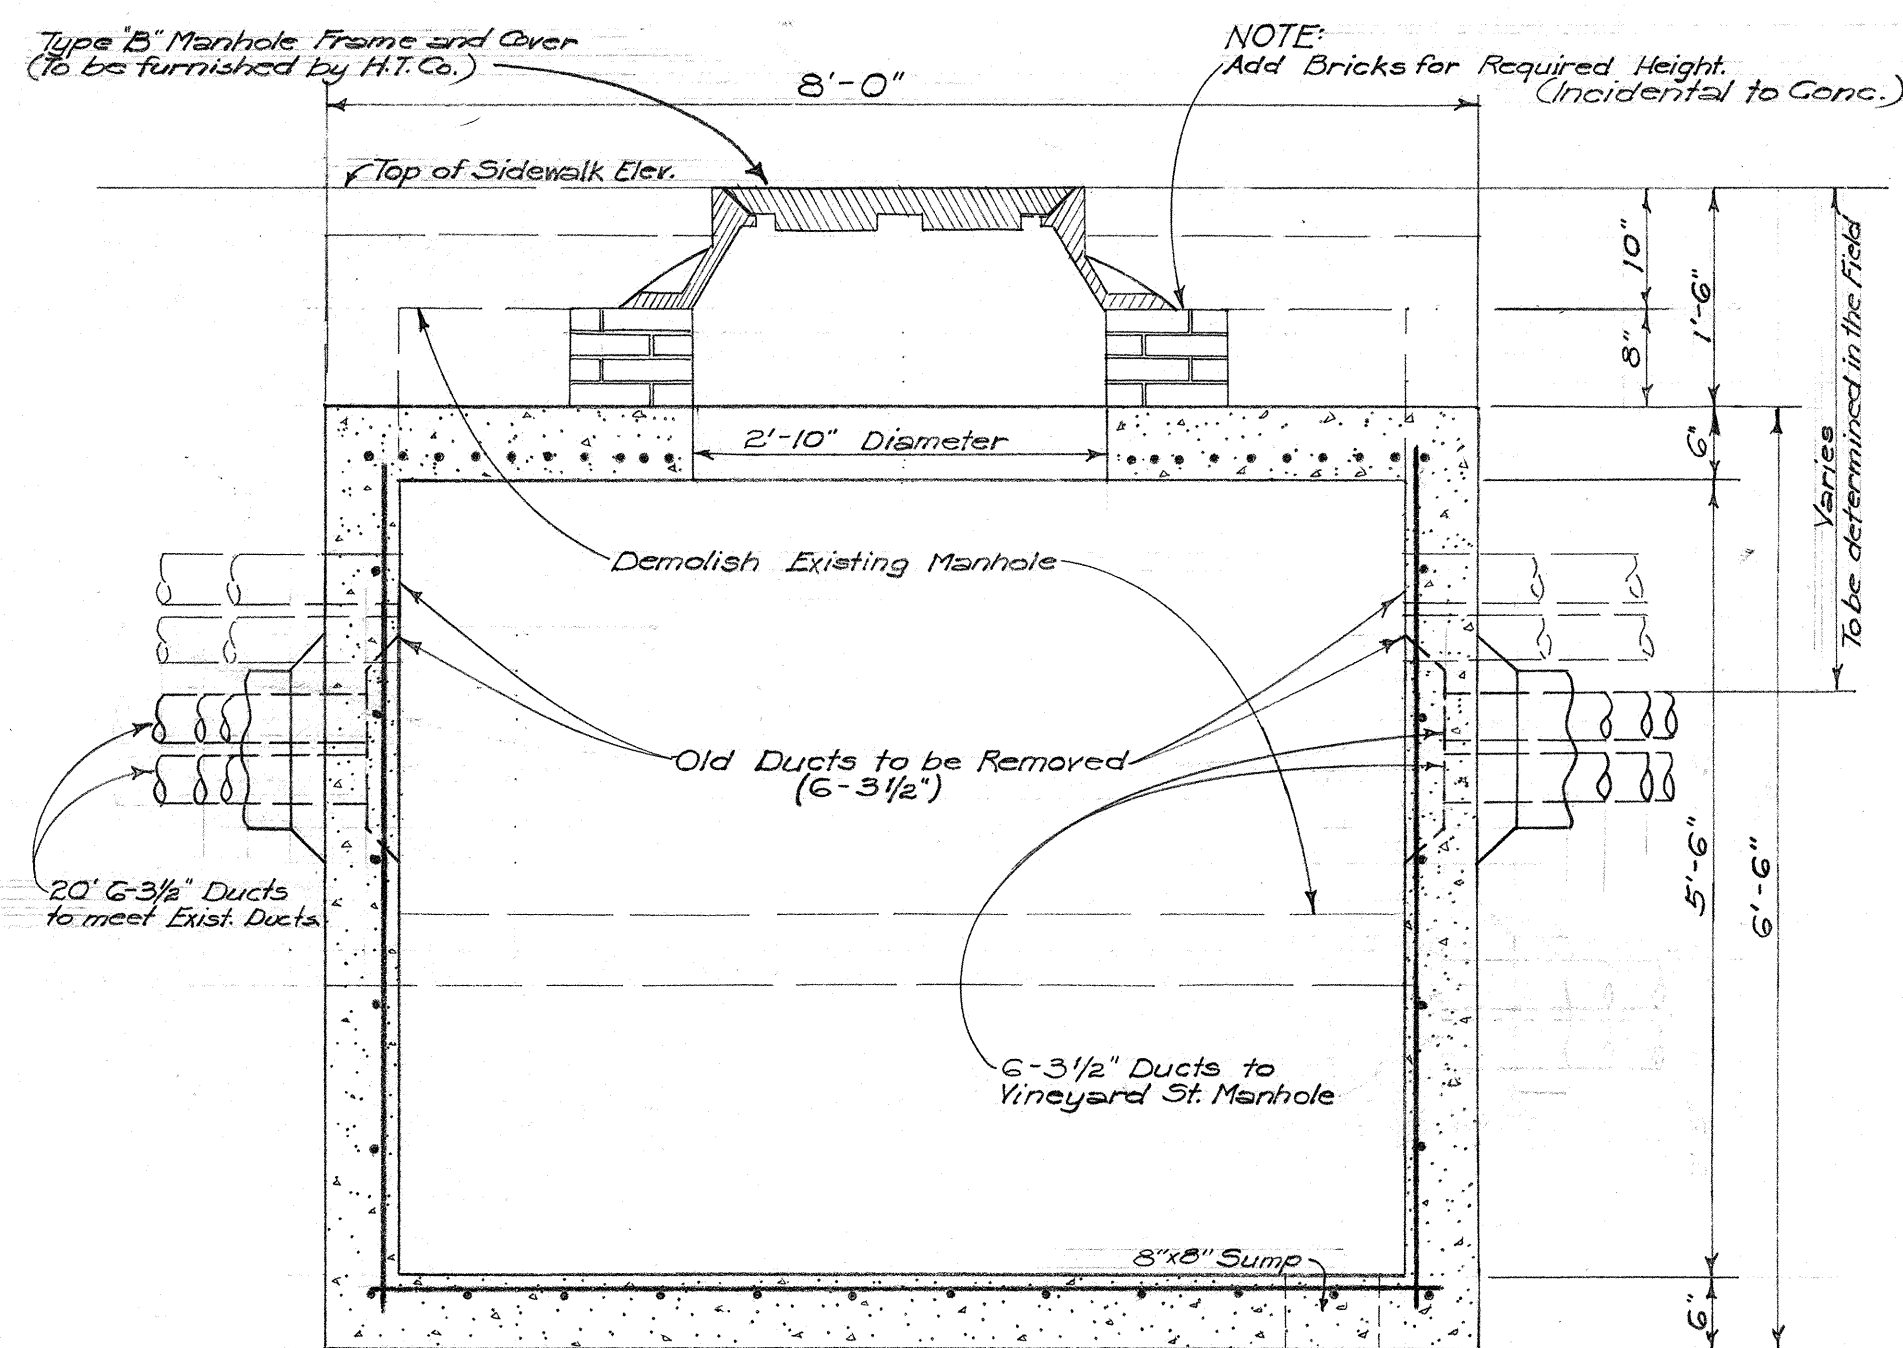


SECTION "A-A"
Scale: 3/4" = 1'-0"

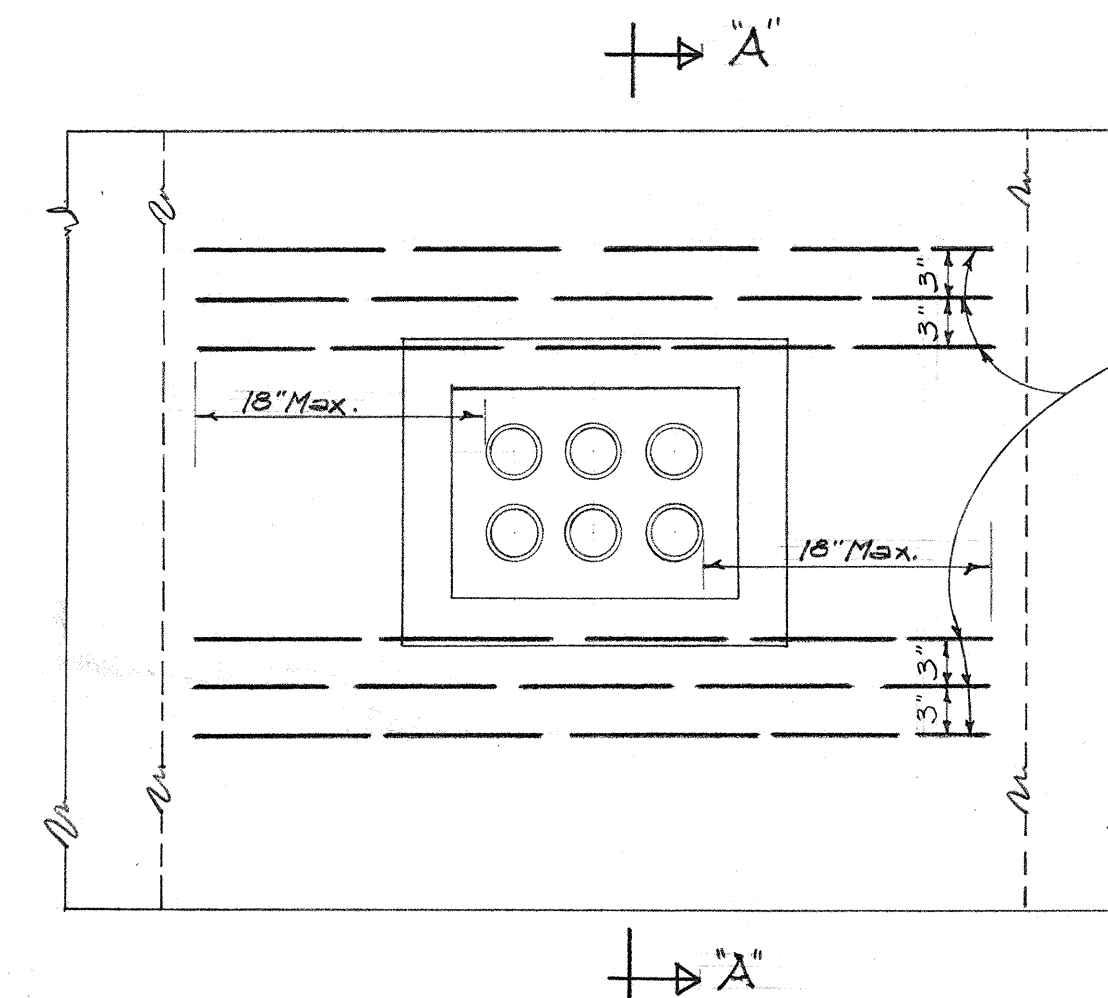

TYPICAL ELEVATION SHOWING
DUCT OPENING REINFORCING
Scale: 1" = 1'-0"

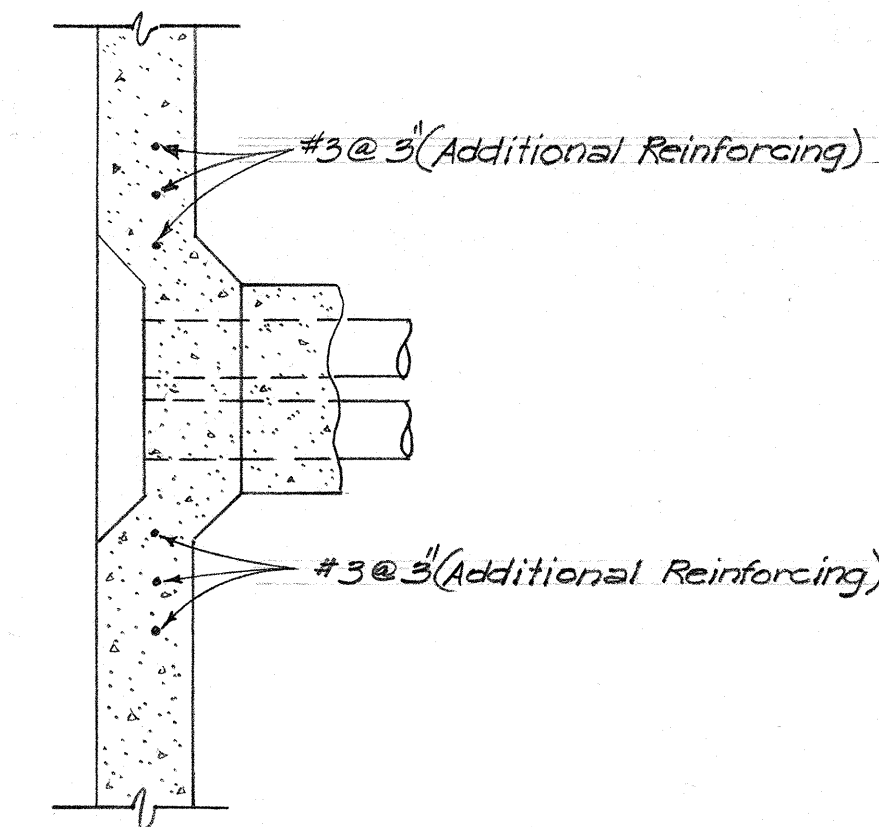

SECTION A-A
Scale: 1" = 1'-0"

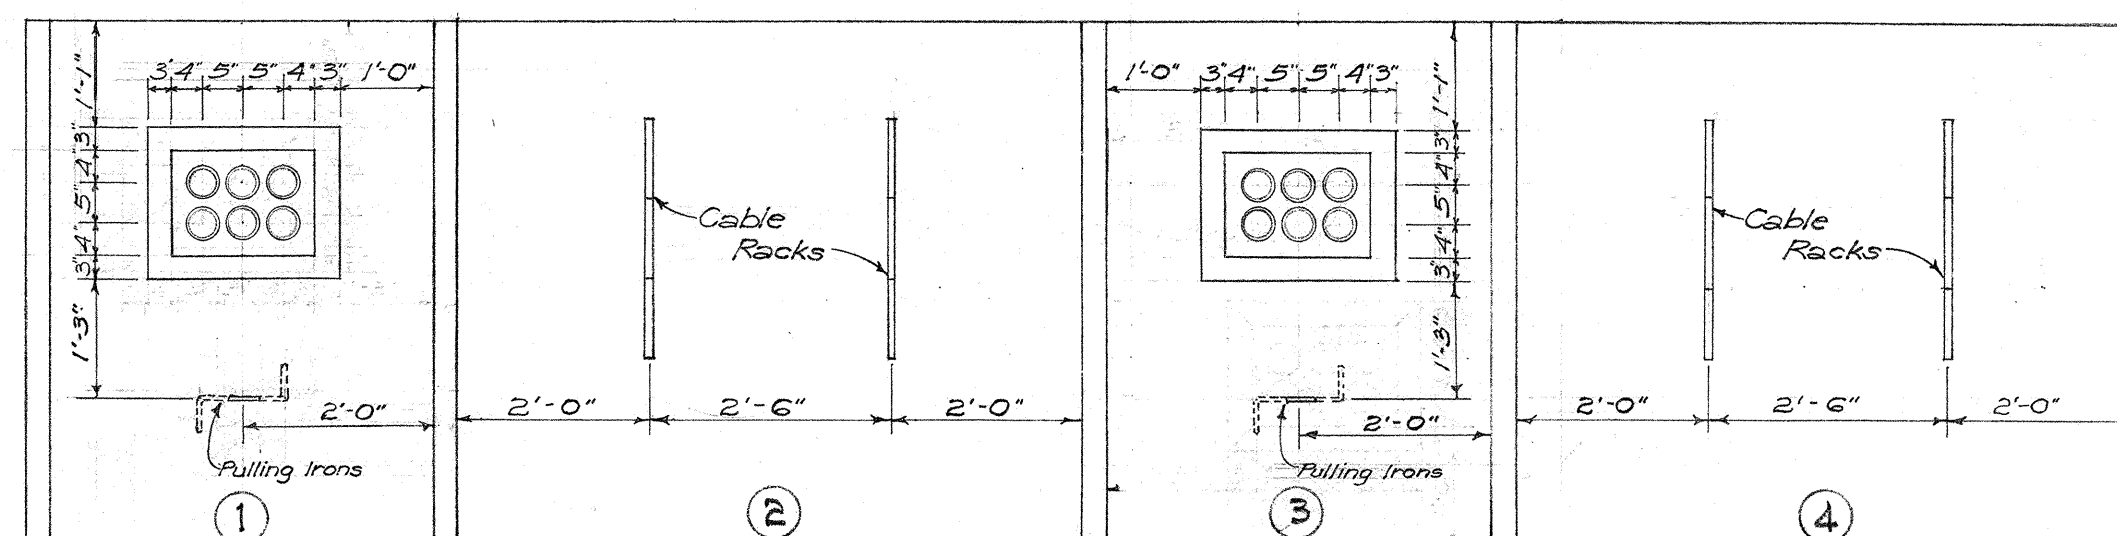

DEVELOPED VIEW OF WALLS
Scale: 1/2" = 1'-0"

MANHOLE No 233
(FOR HAWAIIAN TELEPHONE CO. ONLY)

NOTE:

1. For Roof Slab Details, Sheet No. 5882.65
2. All Wall Reinforcement is #3 Bars.
Vertical: 8' O.C. Horizontal: 12' O.C.
3. Floor Reinforcement is #5 Bars @ 8' O.C.
both ways.
4. Concrete shall be Class "B-1"
5. Contractor to furnish bricks and construct collars. (Incidental to Gene.)


(NO AS-BUILT CHANGES
ON THIS SHEET)

TERRITORIAL HIGHWAY DEPARTMENT
TERRITORY OF HAWAII
DETAILS OF HAWAIIAN TELEPHONE
COMPANY MANHOLE NO. 233
VINEYARD THOROUGHFARE
PALAMA ST. TO FORT ST.
PROJECT NO. DF-008-1(5)
Scale: As Noted Feb. 3, 1958


H.T. CO. APPROVED: *[Signature]*
TITLE: *[Signature]* 4-23-58
DATE:

SHEET No. 1 OF 3 SHEETS


5882.61

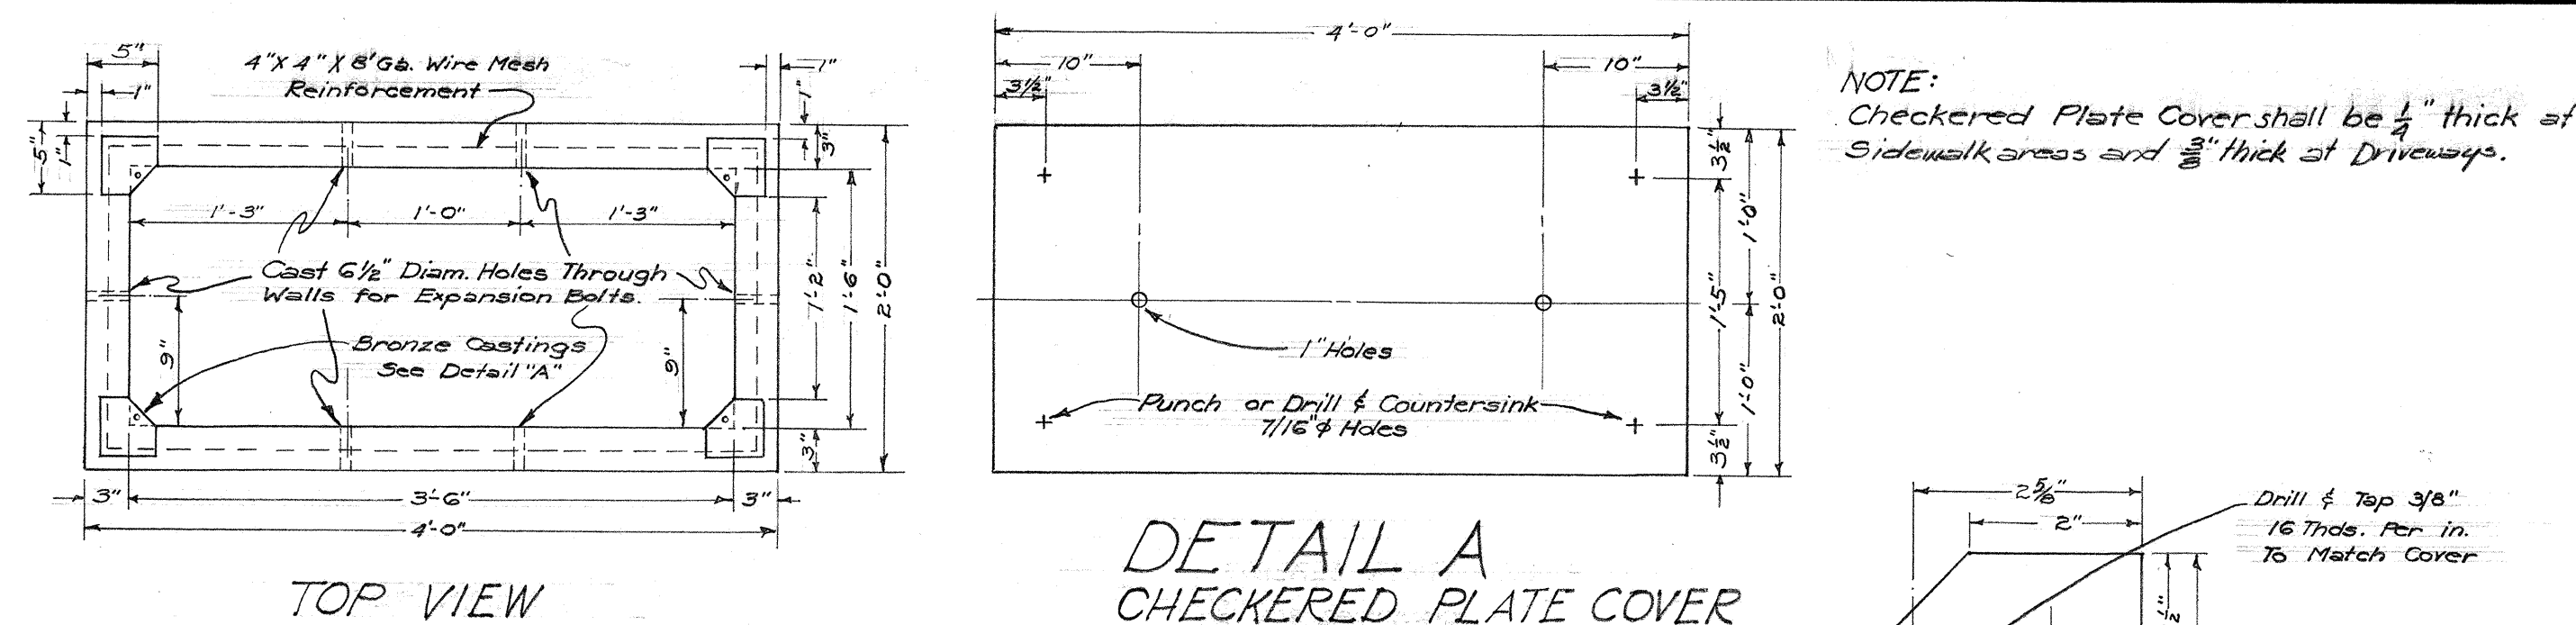


DETAIL A
CHECKERED PLATE COVER

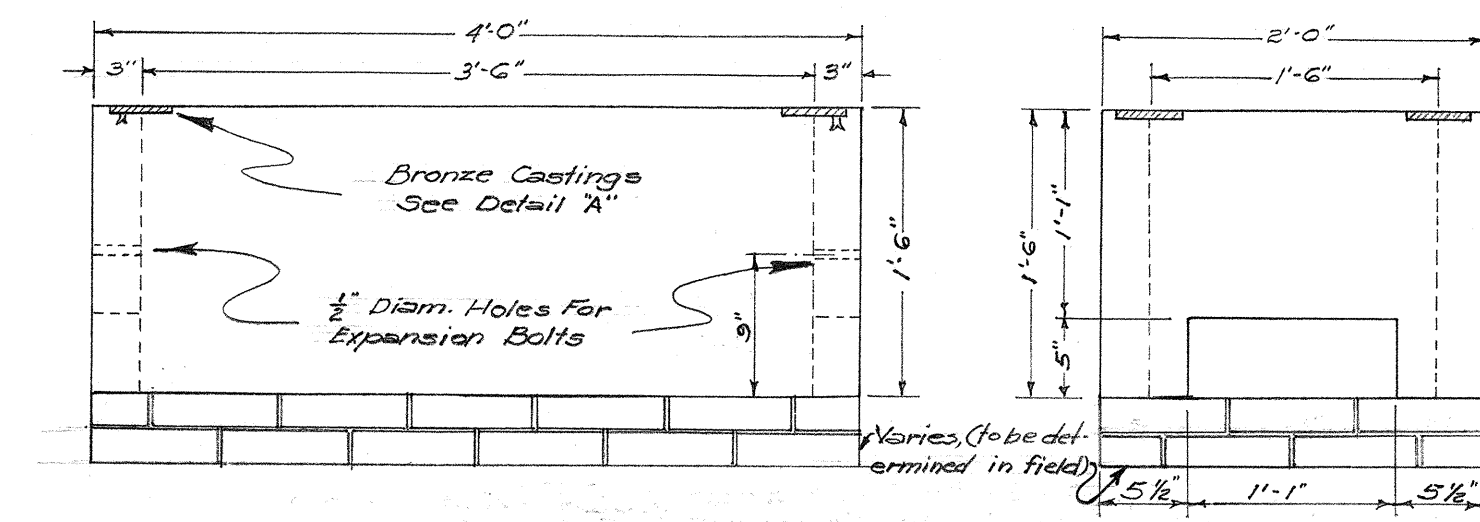


2' x 4' LARGE PRECAST CONC. PULL BOX
WITH STEEL COVER
SCALE: 1" = 1'-0"

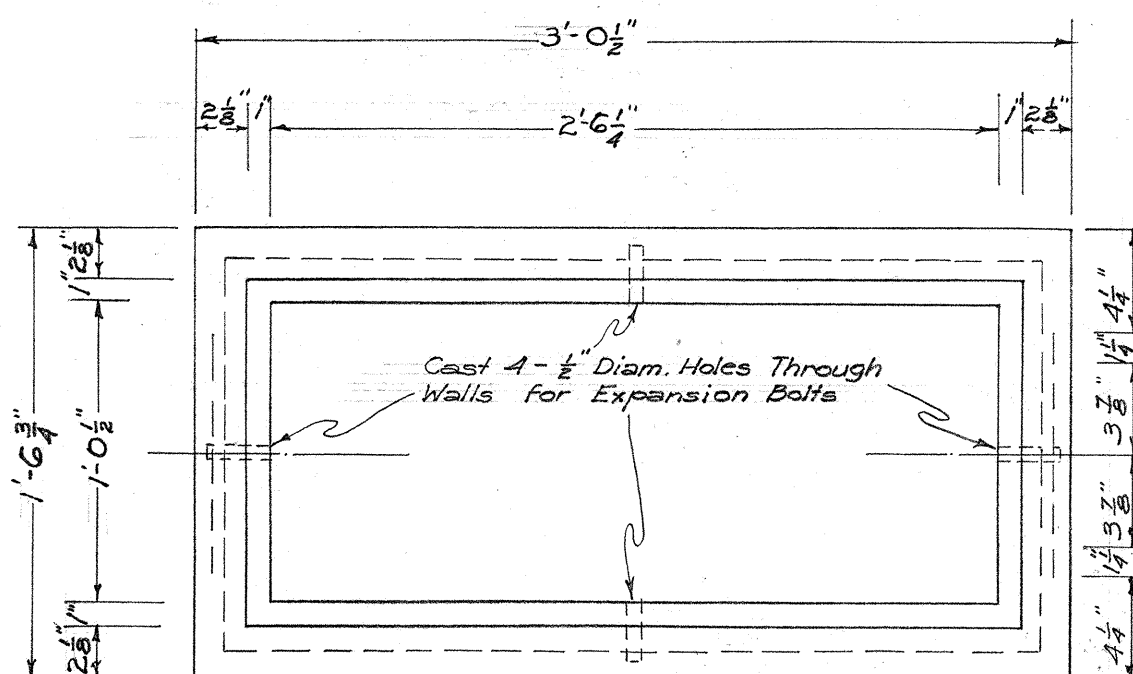

PLAN
SCALE: $\frac{1}{8}$ " = 1'

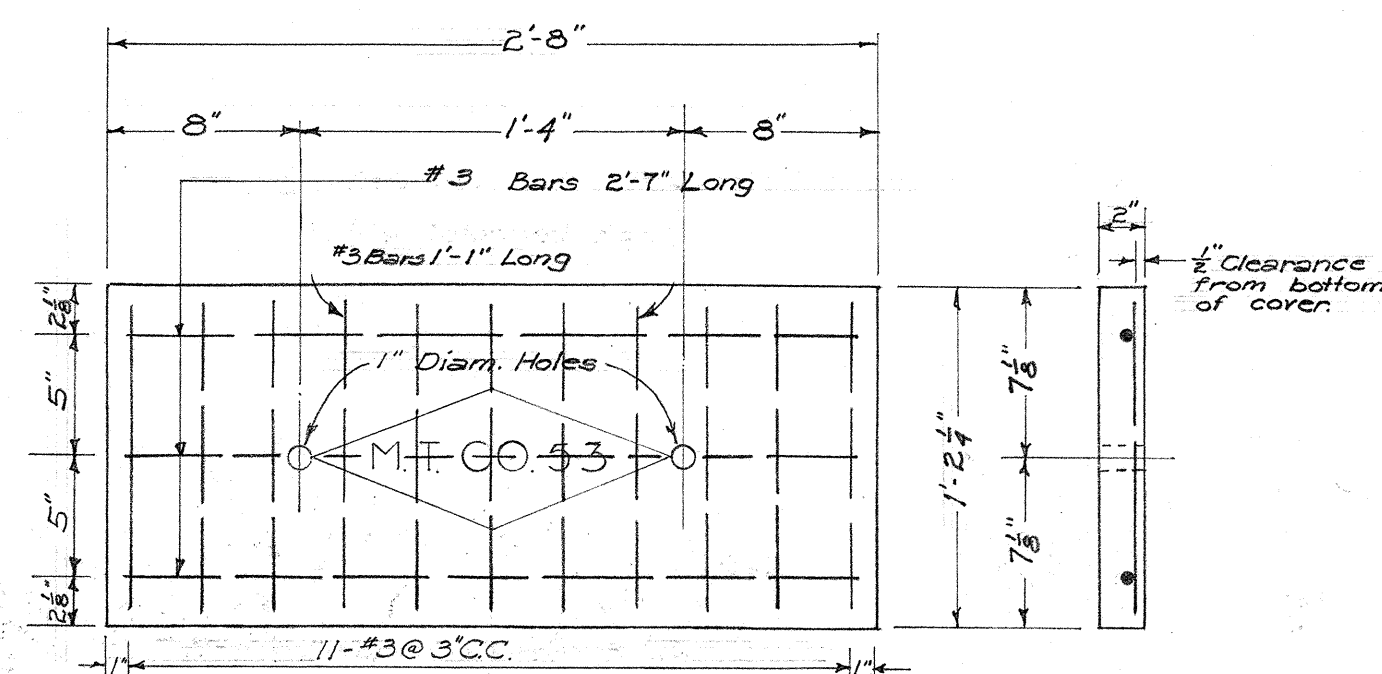


PLAN OF COVER
SCALE: $\frac{1}{8}$ " = 1'

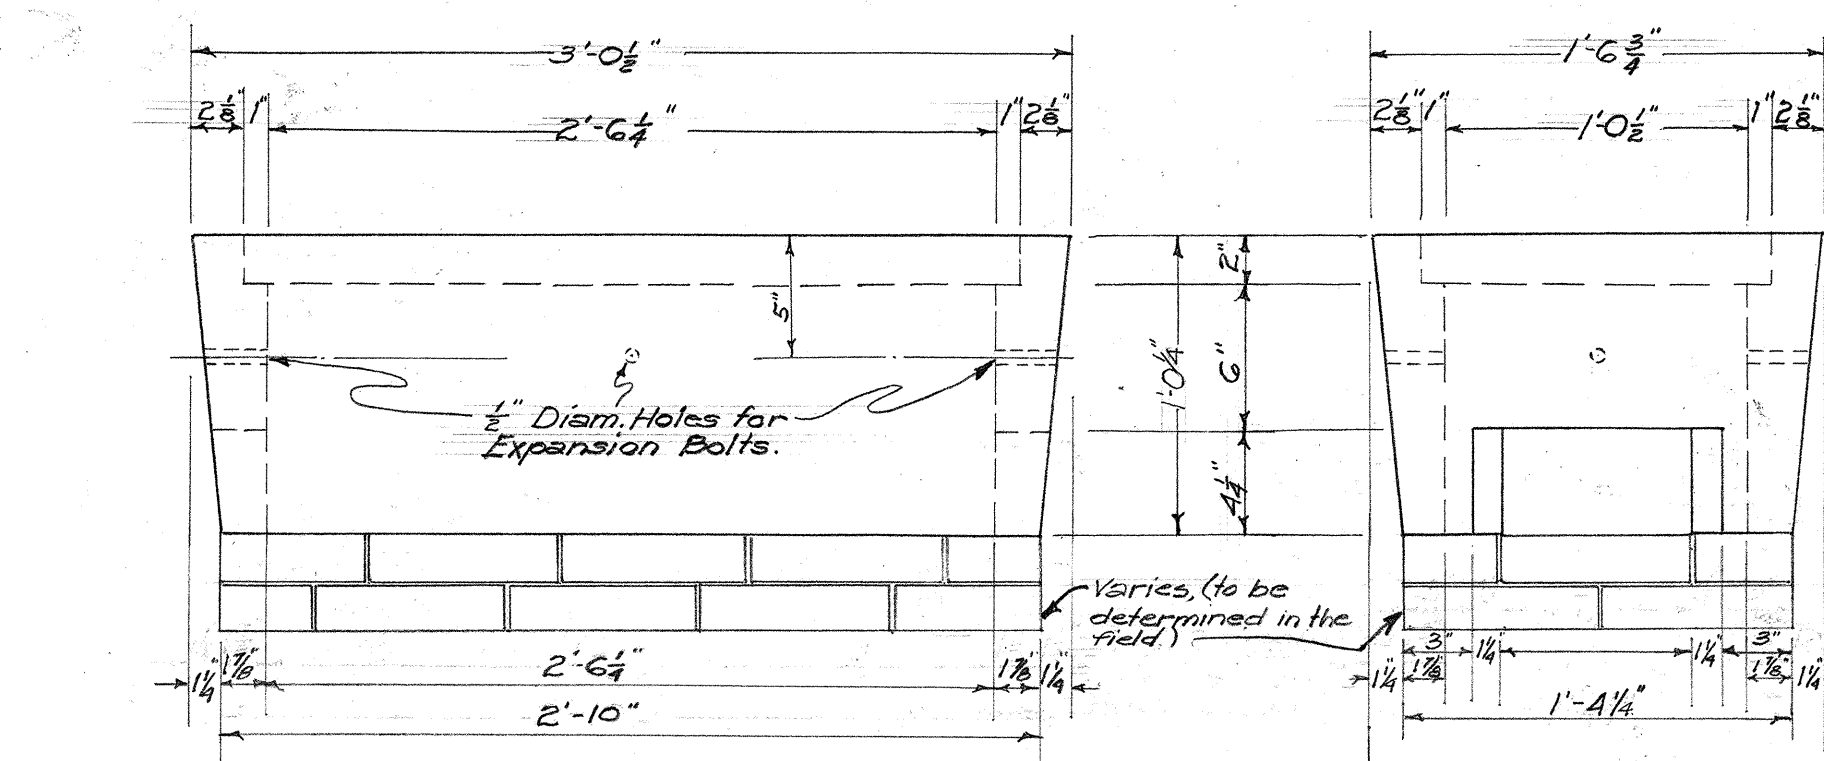


SIDE ELEVATION
SCALE: $\frac{1}{8}$ " = 1'

END ELEVATION
SCALE: $\frac{1}{8}$ " = 1'


SMALL STD. PRECAST CONC. PULL BOX
WITH CONC. COVER

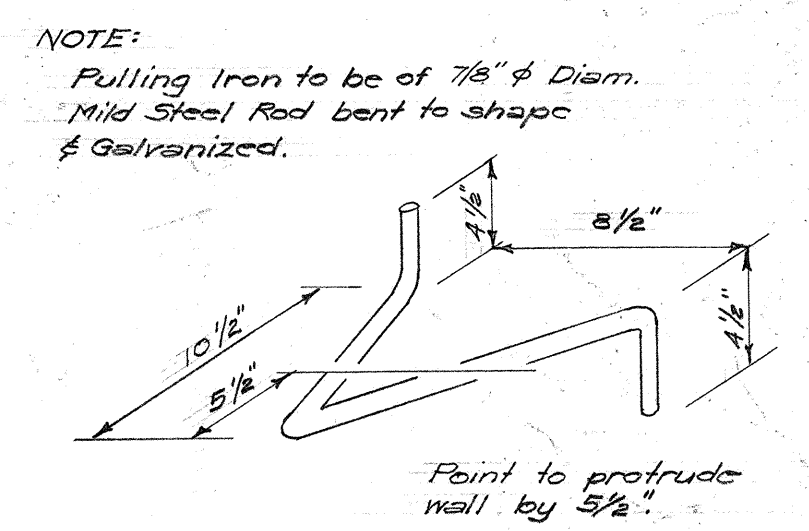


PULLING IRON DETAIL
SCALE: $\frac{1}{2}$ " = 1'-0"

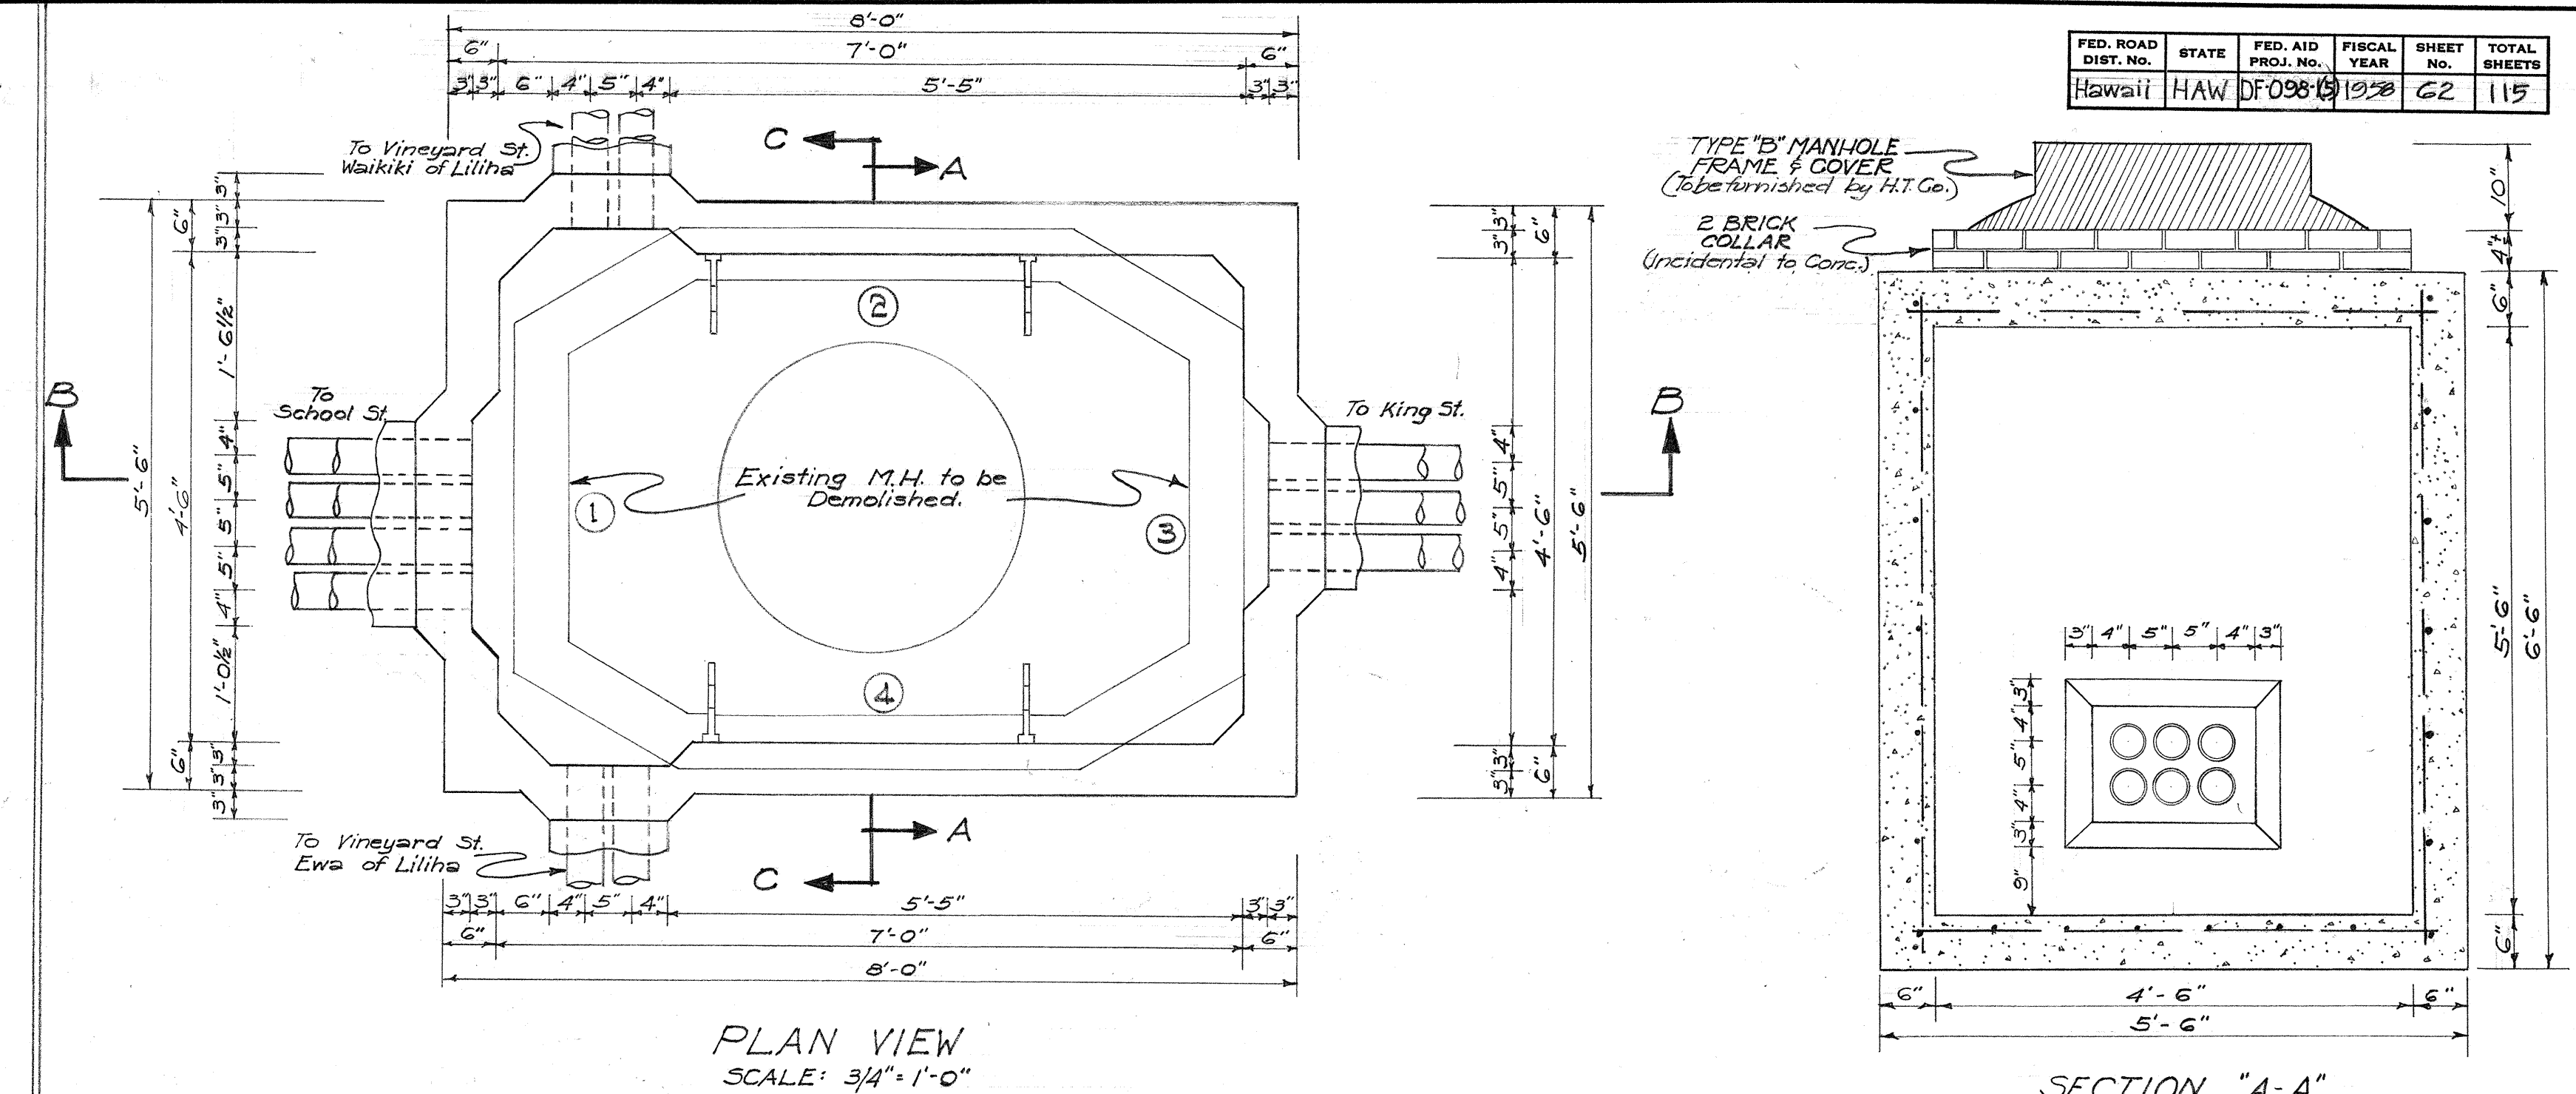


PLAN VIEW
SCALE: $\frac{3}{4}$ " = 1'-0"

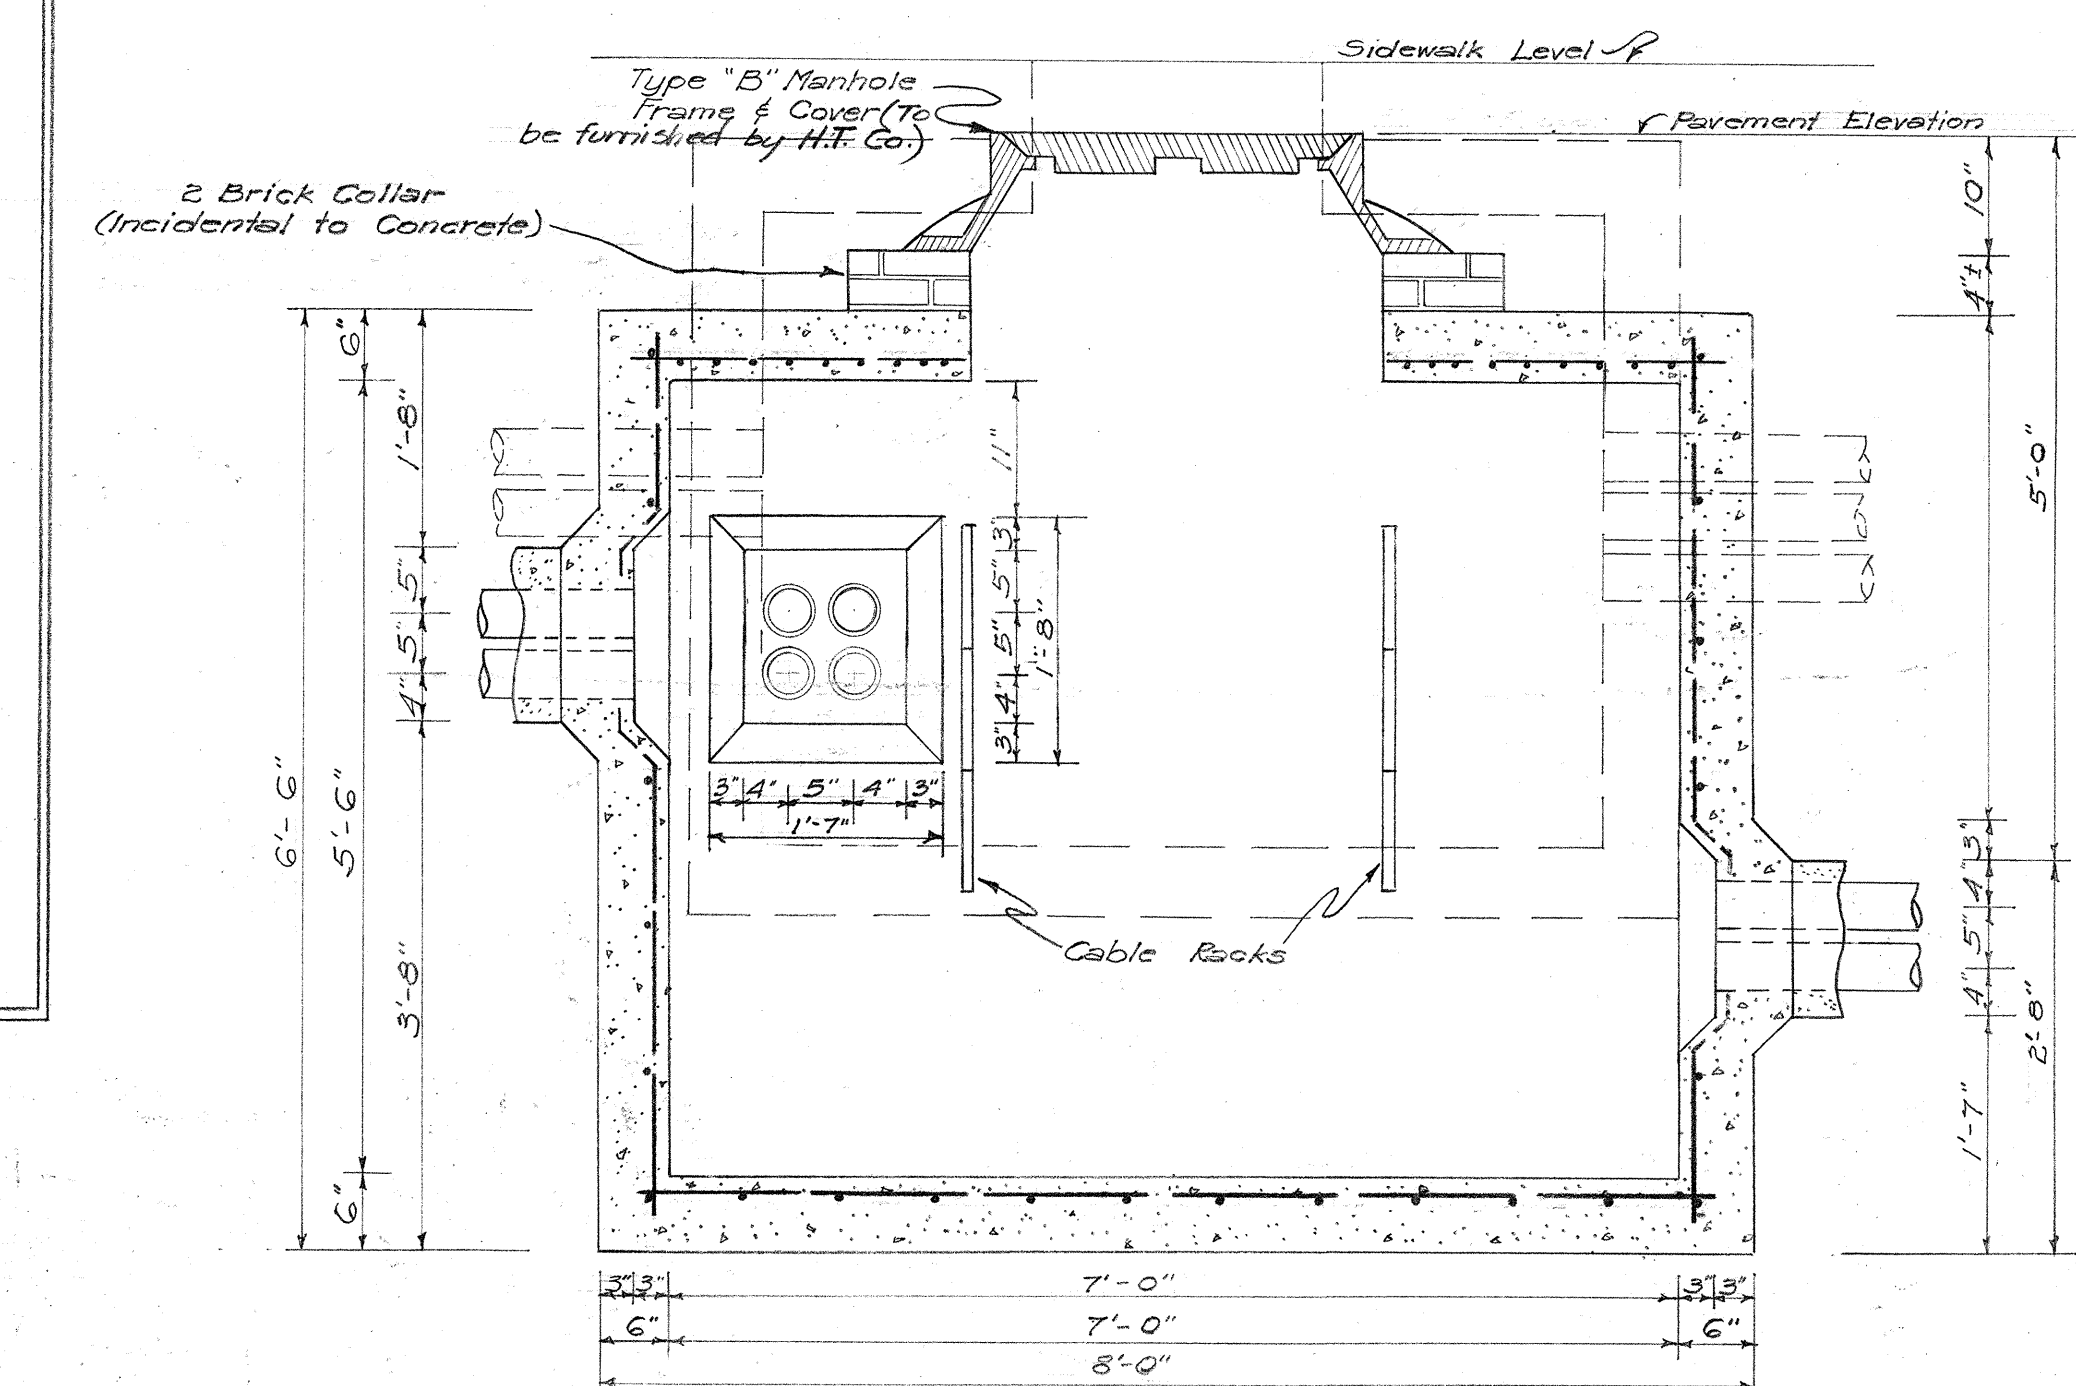

SECTION "B-B"
SCALE: $\frac{3}{4}$ " = 1'-0"

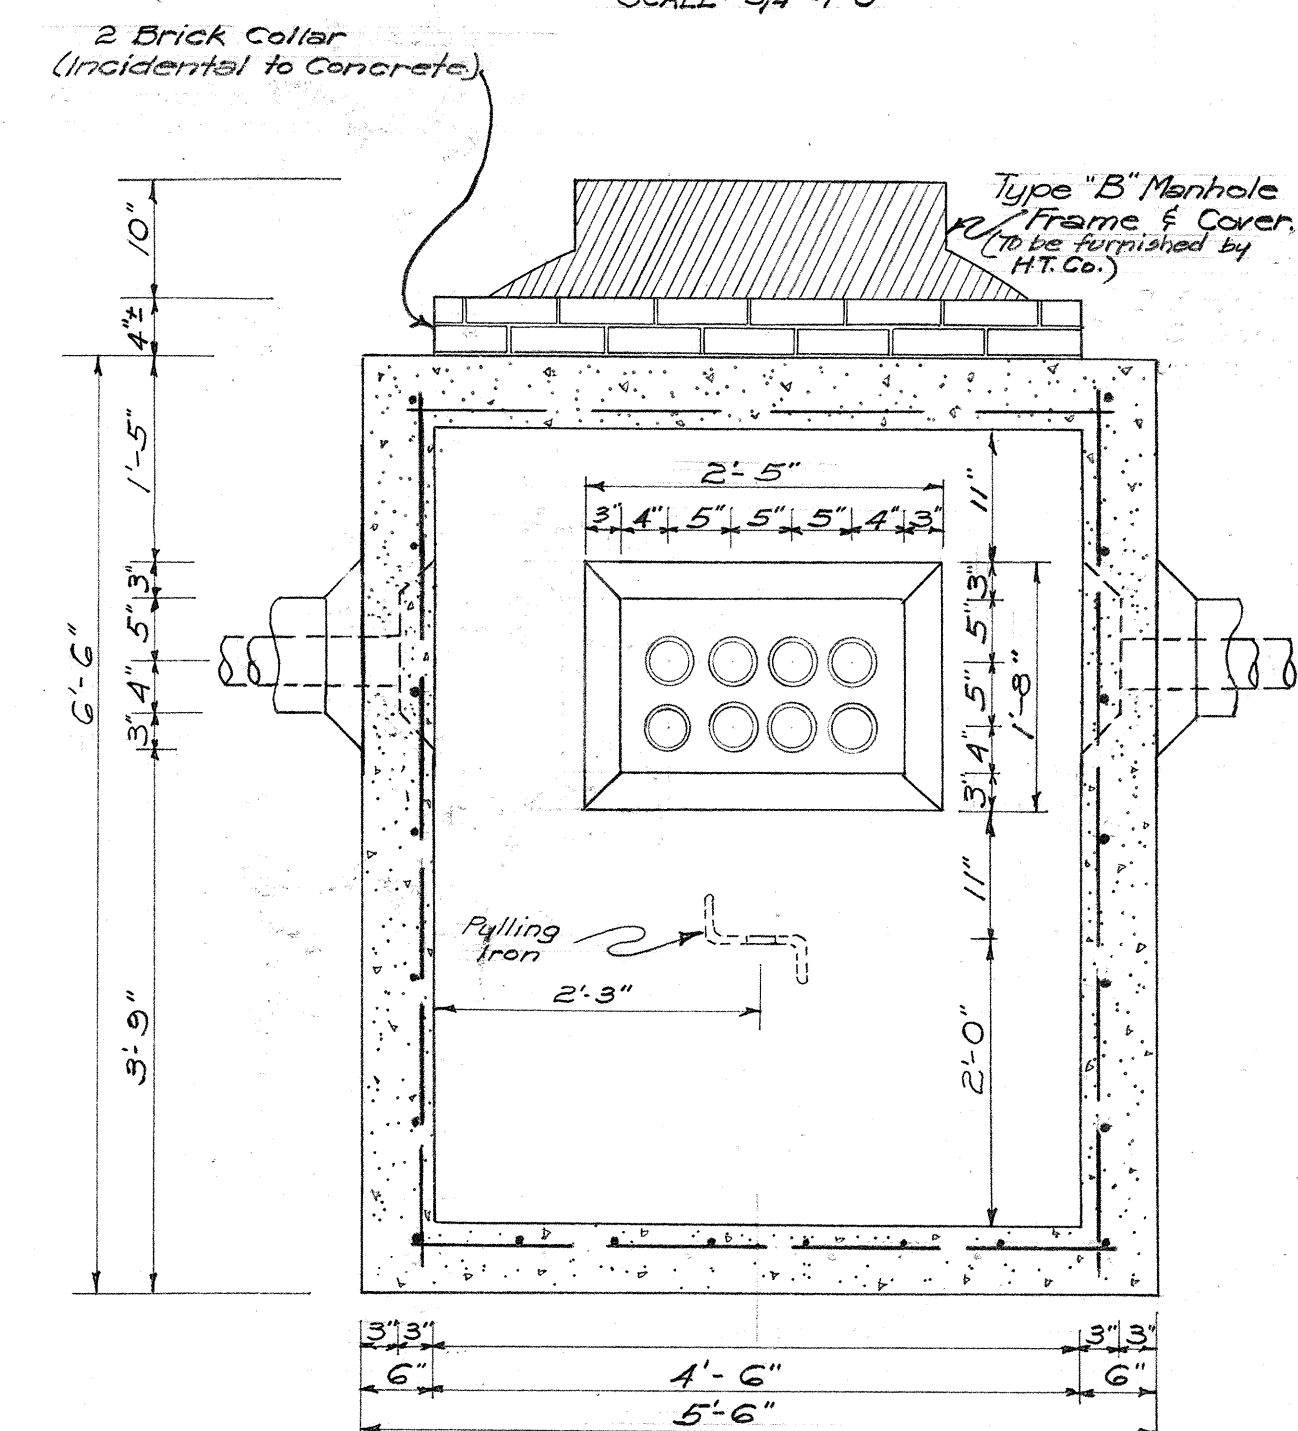

SECTION "C-C"
SCALE: $\frac{3}{4}$ " = 1'-0"

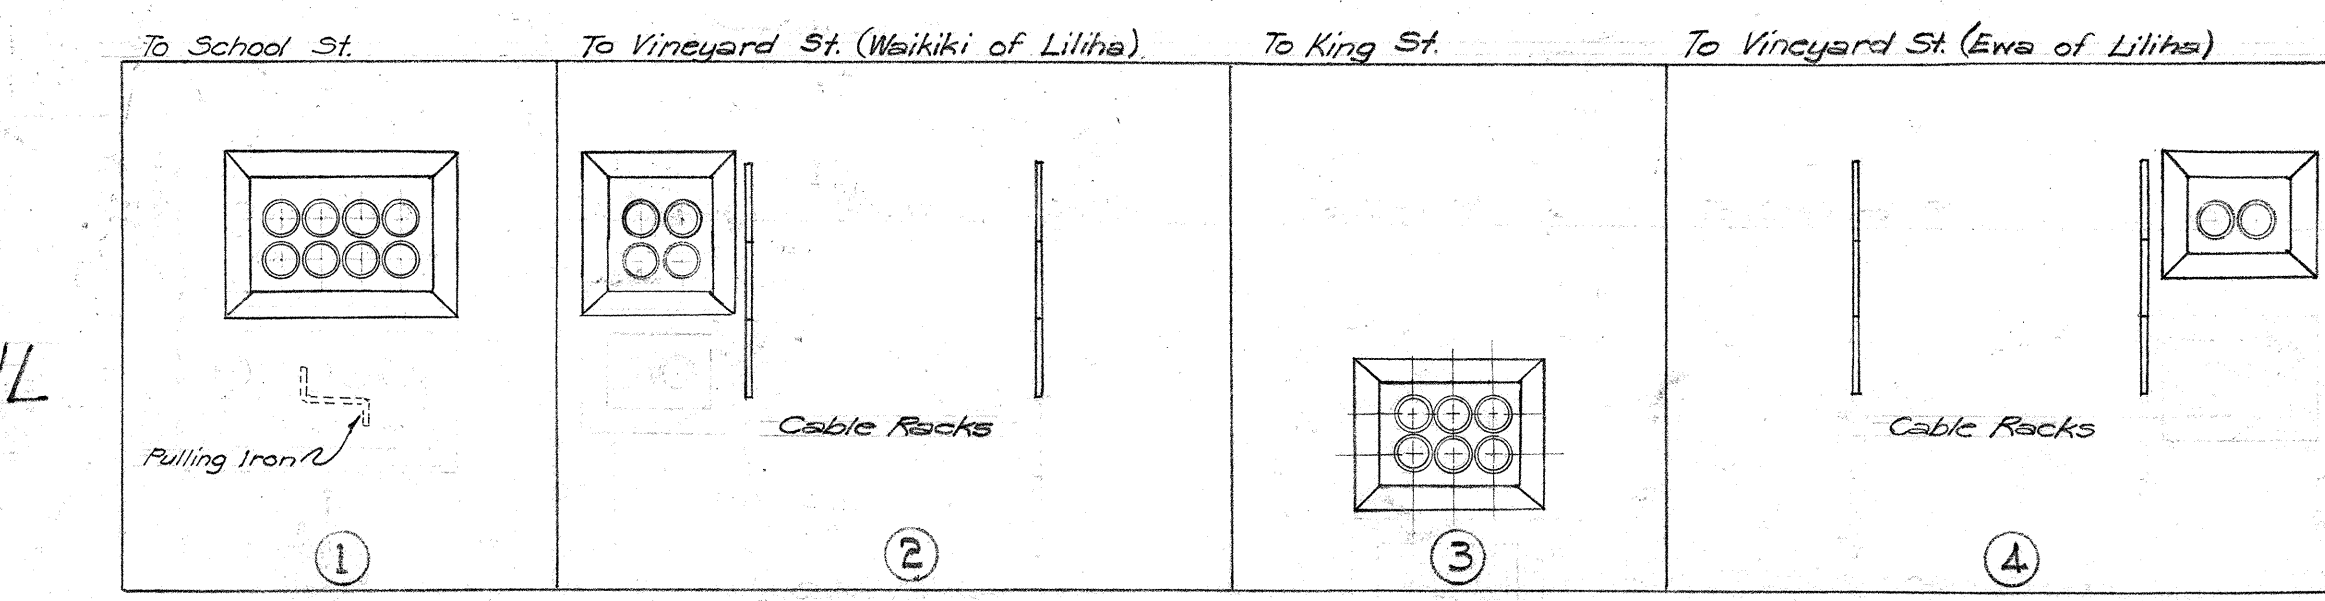

DEVELOPED VIEW OF WALLS
SCALE: $\frac{1}{2}$ " = 1'-0"

MANHOLE NO 234
(FOR HAWAIIAN TELEPHONE CO. ONLY)

(NO AS-BUILT CHANGES ON THIS SHEET)


H.T. CO. APPROVED: *[Signature]*
TITLE: *[Signature]* 4-23-58
DATE

TERRITORIAL HIGHWAY DEPARTMENT
TERRITORY OF HAWAII
DETAILS OF HAWAIIAN TELEPHONE CO.
PRECAST CONCRETE PULL BOXES
AND MANHOLE NO. 234
VINEYARD THOROUGHFARE
PALAMA ST. TO FORT ST.
PROJECT NO. DF-098-1(5)
Scale: As Noted Feb. 3, 1958


SHEET NO. 2 OF 3 SHEETS

5882.62


DATE: _____
DRAWN BY: _____
CHECKED BY: _____
NOTE BOOK No. _____

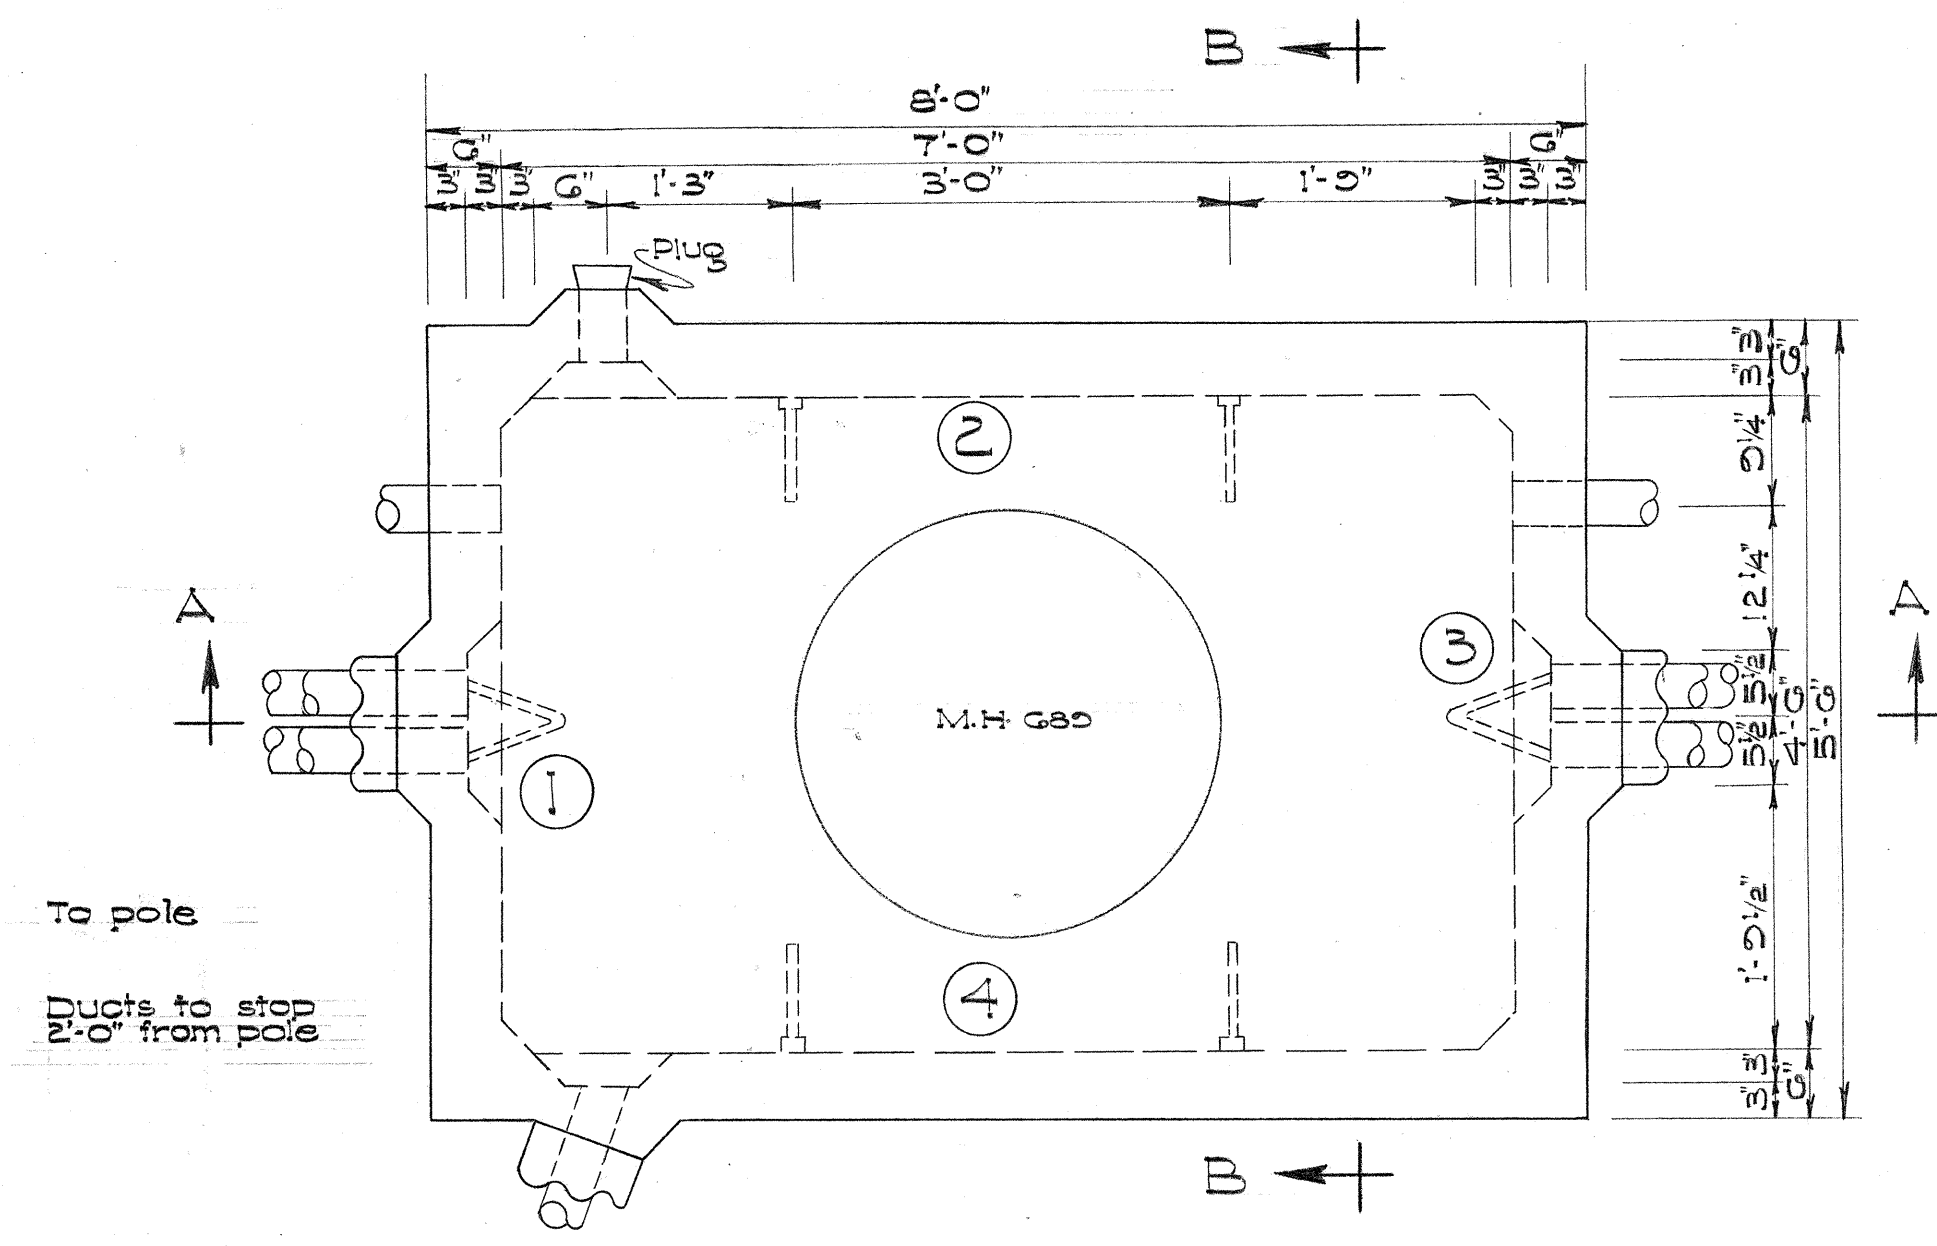


PLAN VIEW
Scale: 3/4"=1'-0"

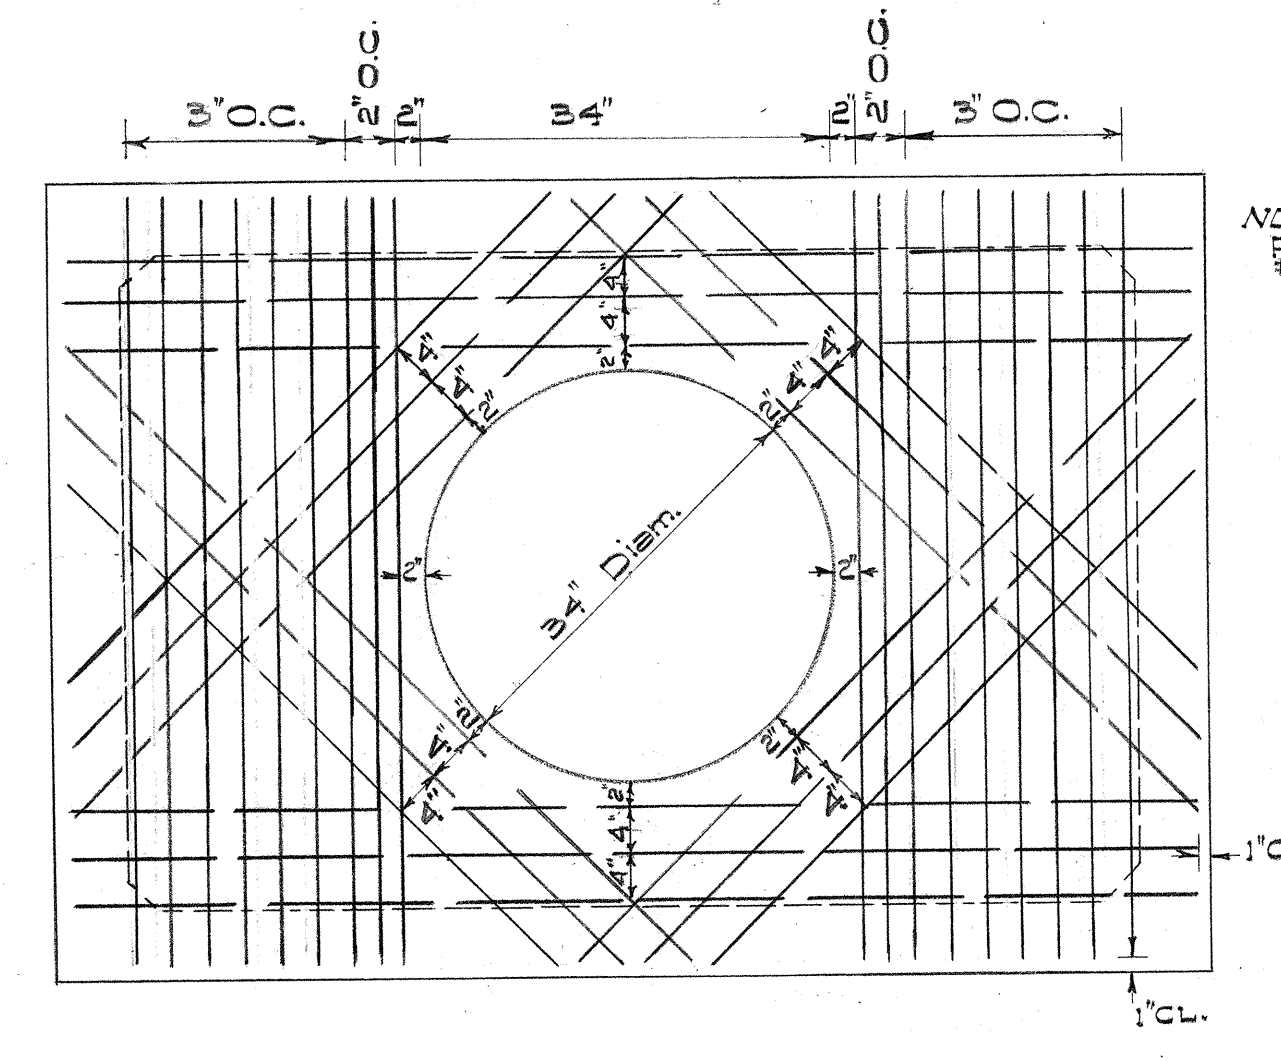


ROOF SLAB
Scale: 3/4"=1'-0"

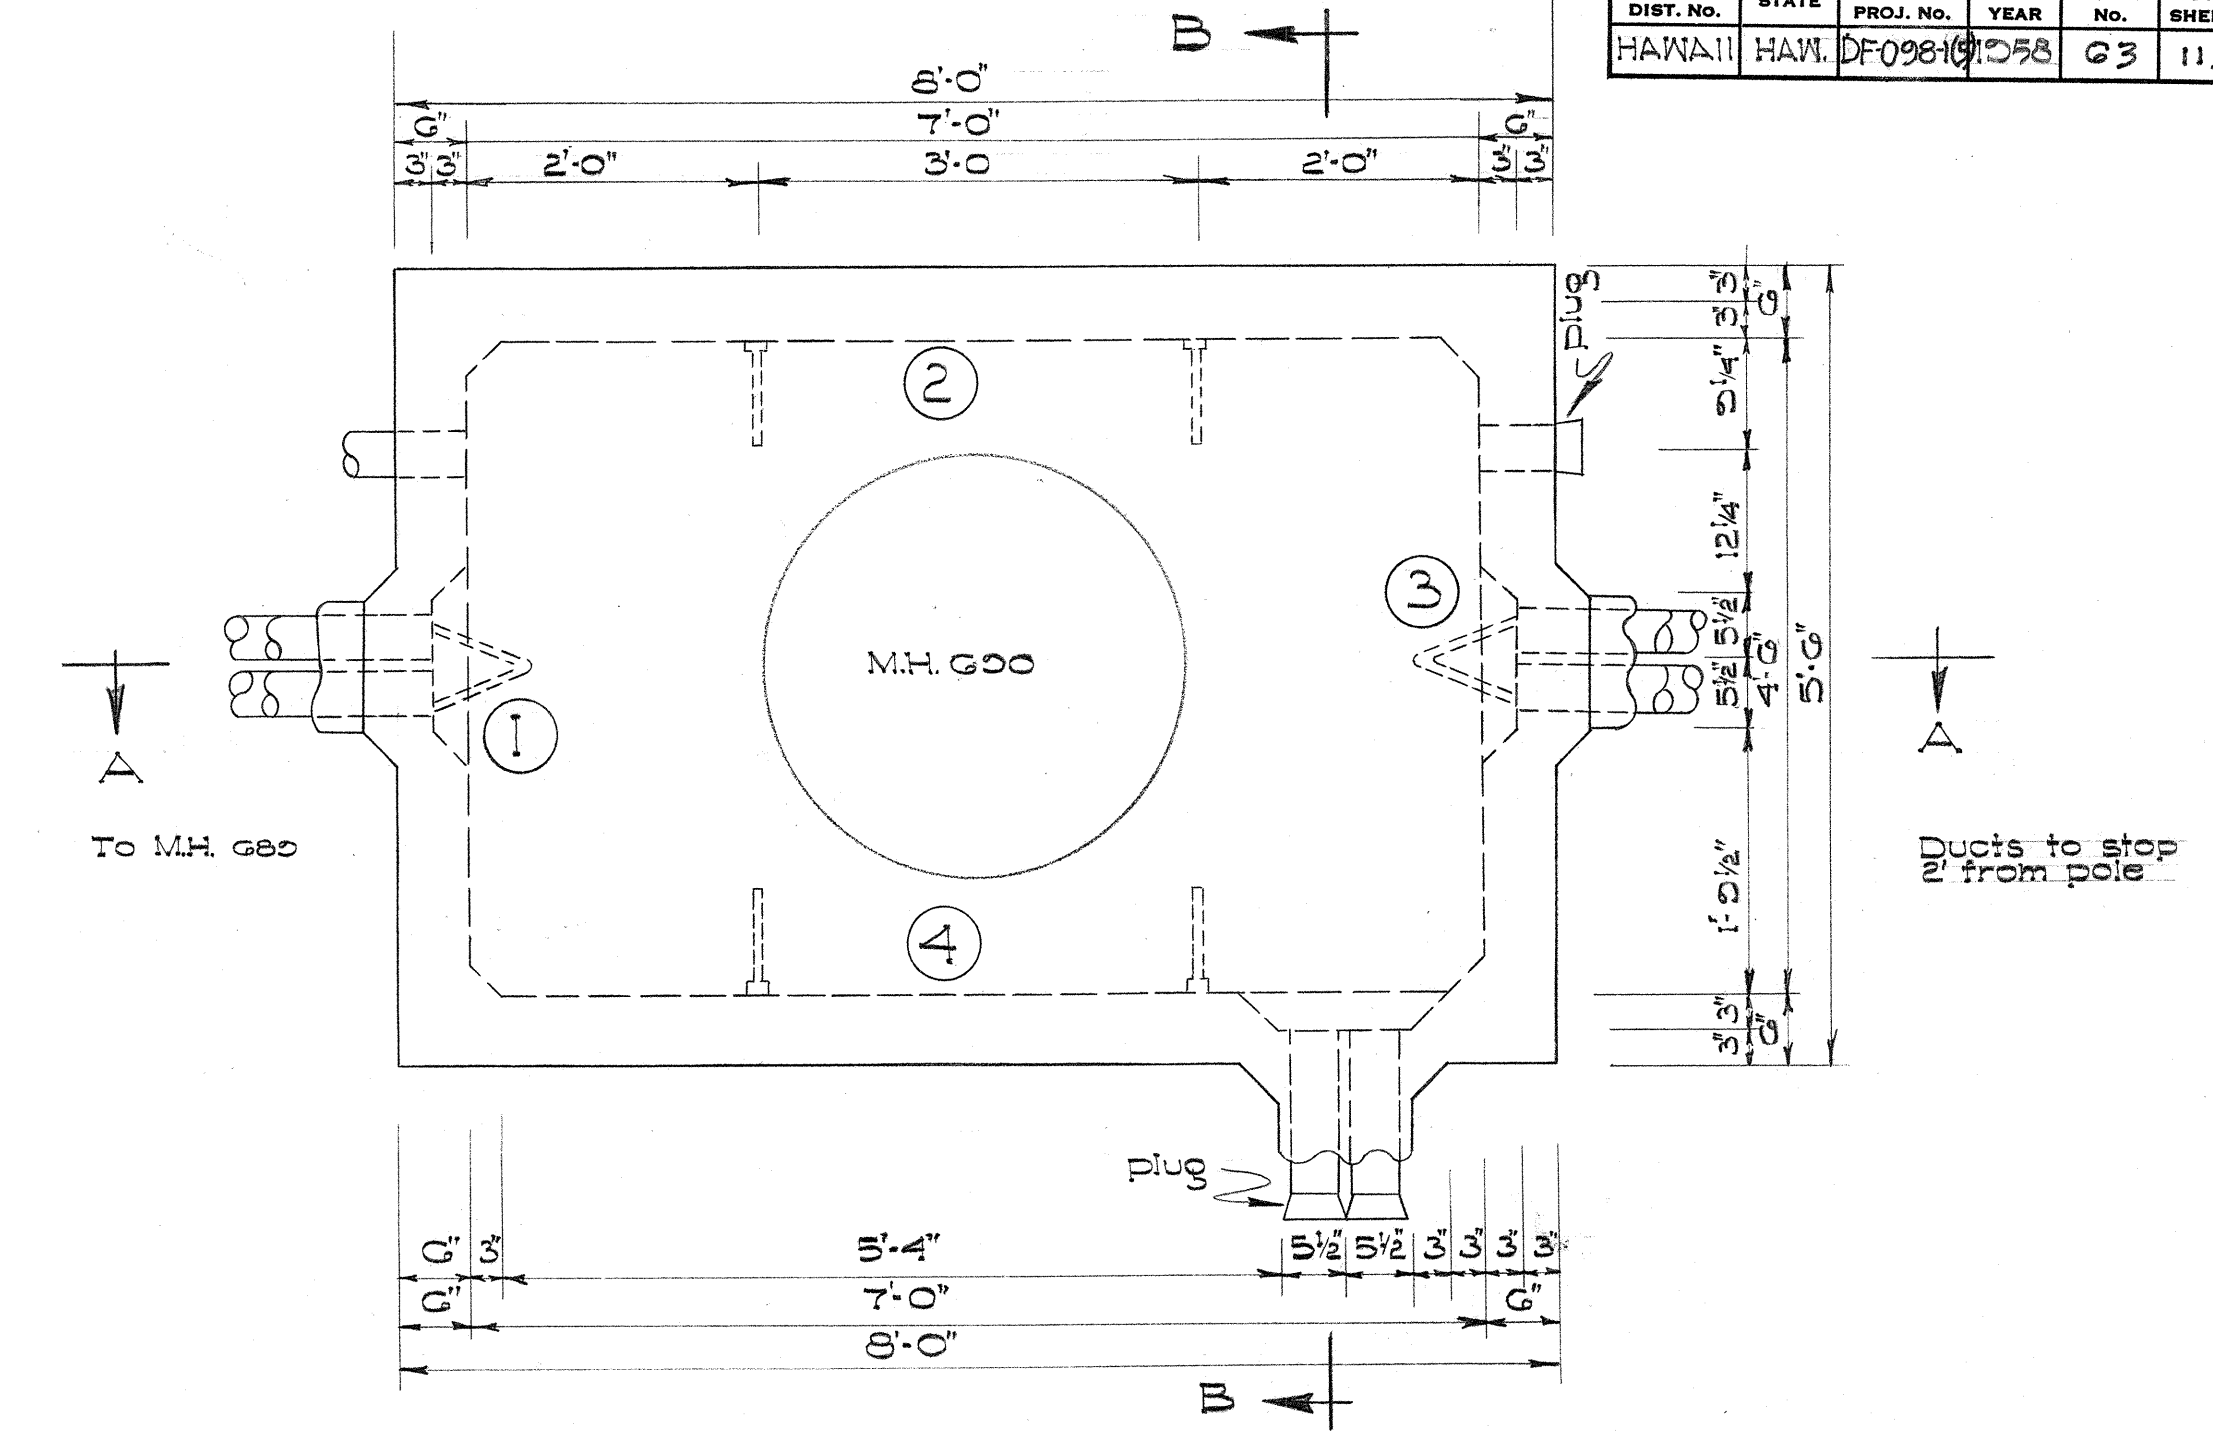


PLAN VIEW
Scale: 3/4"=1'-0"

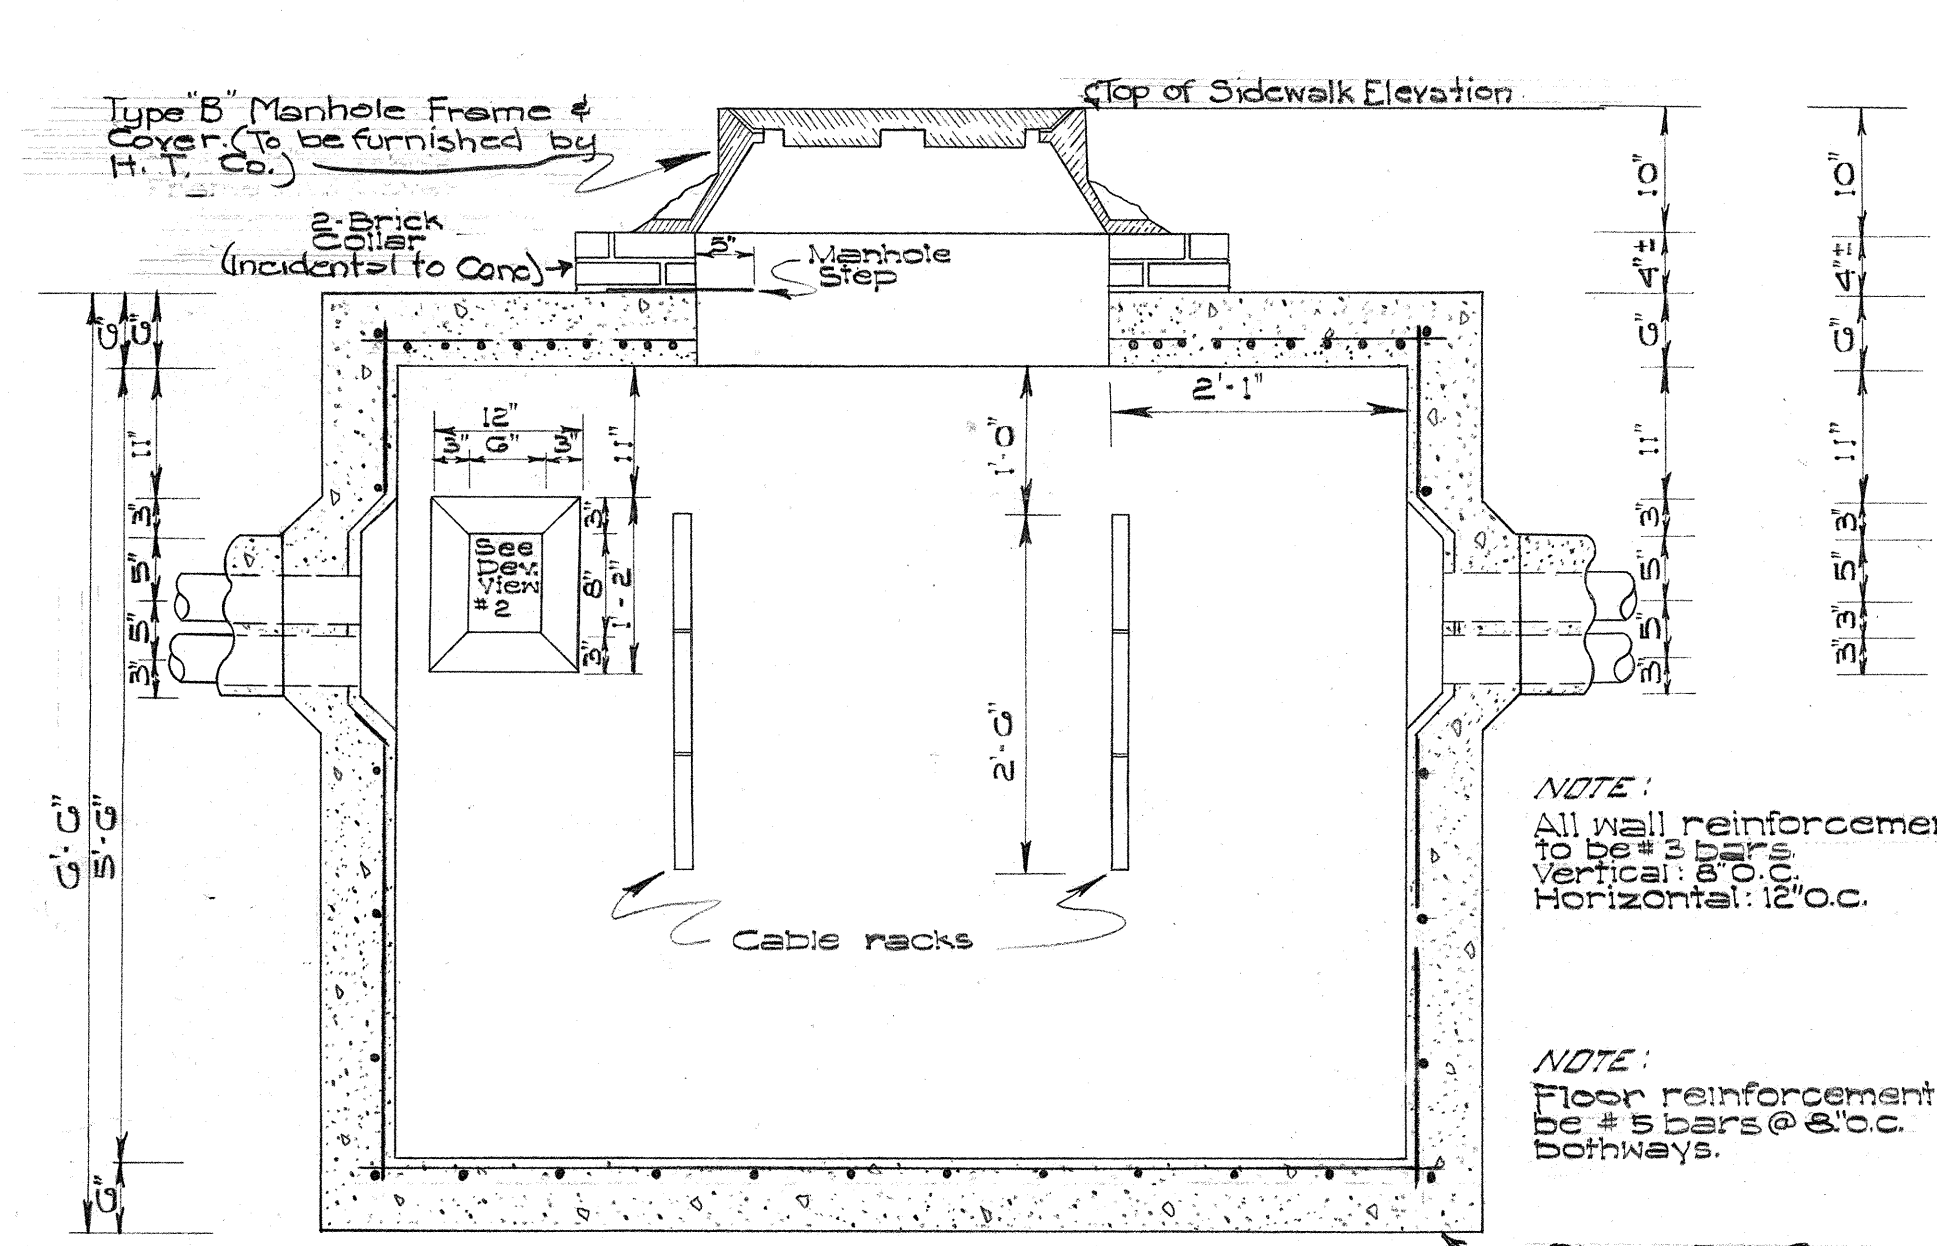


SECTION "A-A"
Scale: 3/4"=1'-0"

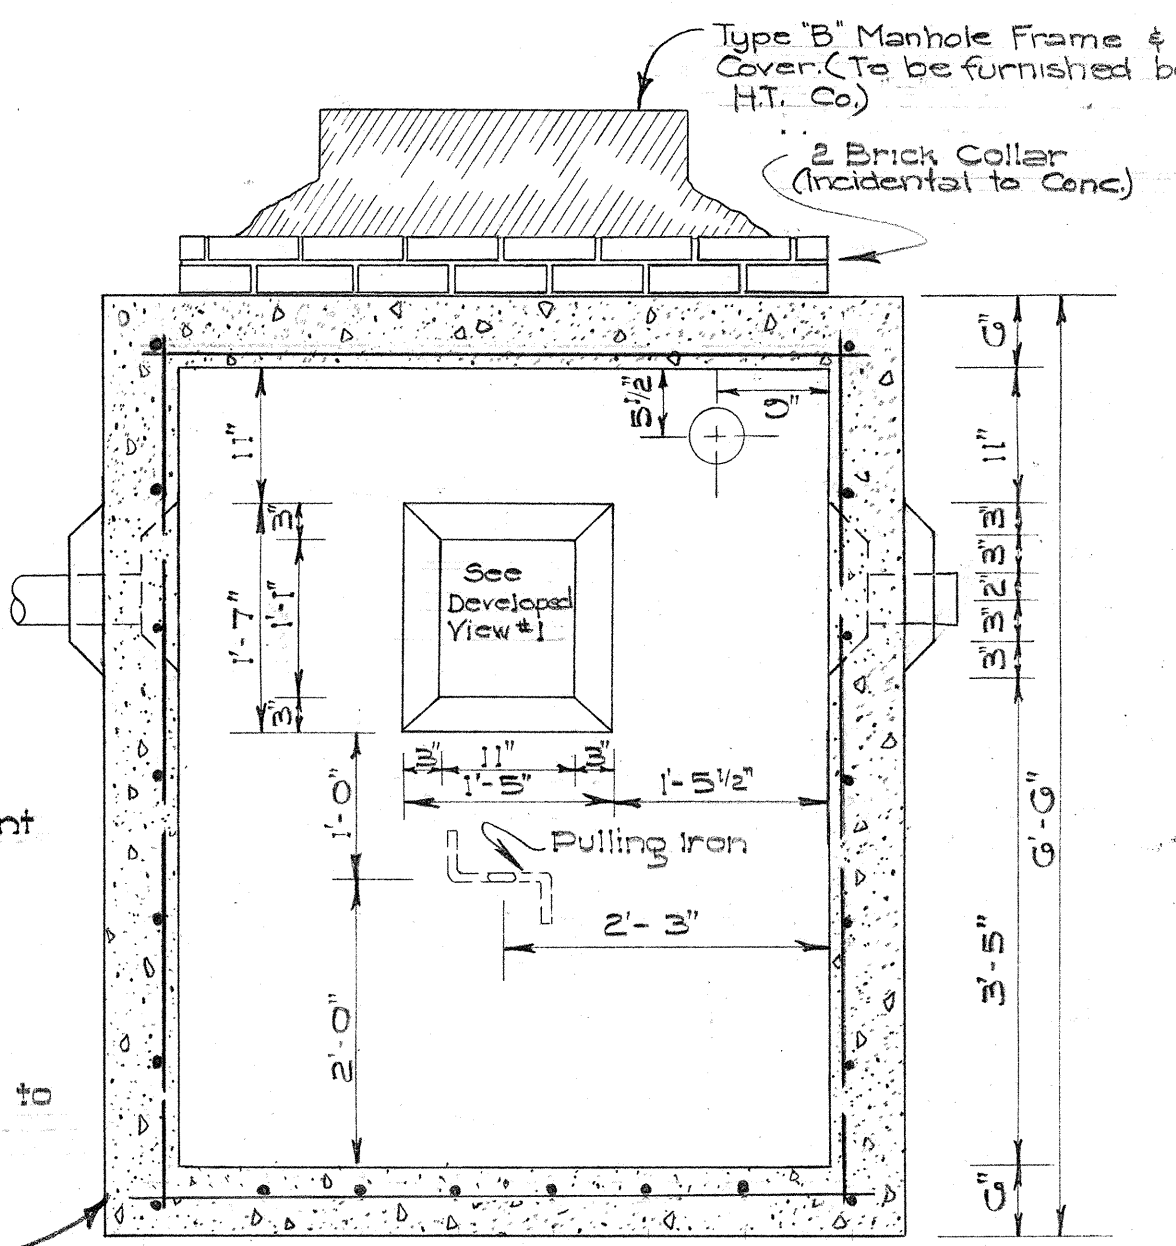


SECTION "B-B"
Scale: 3/4"=1'-0"

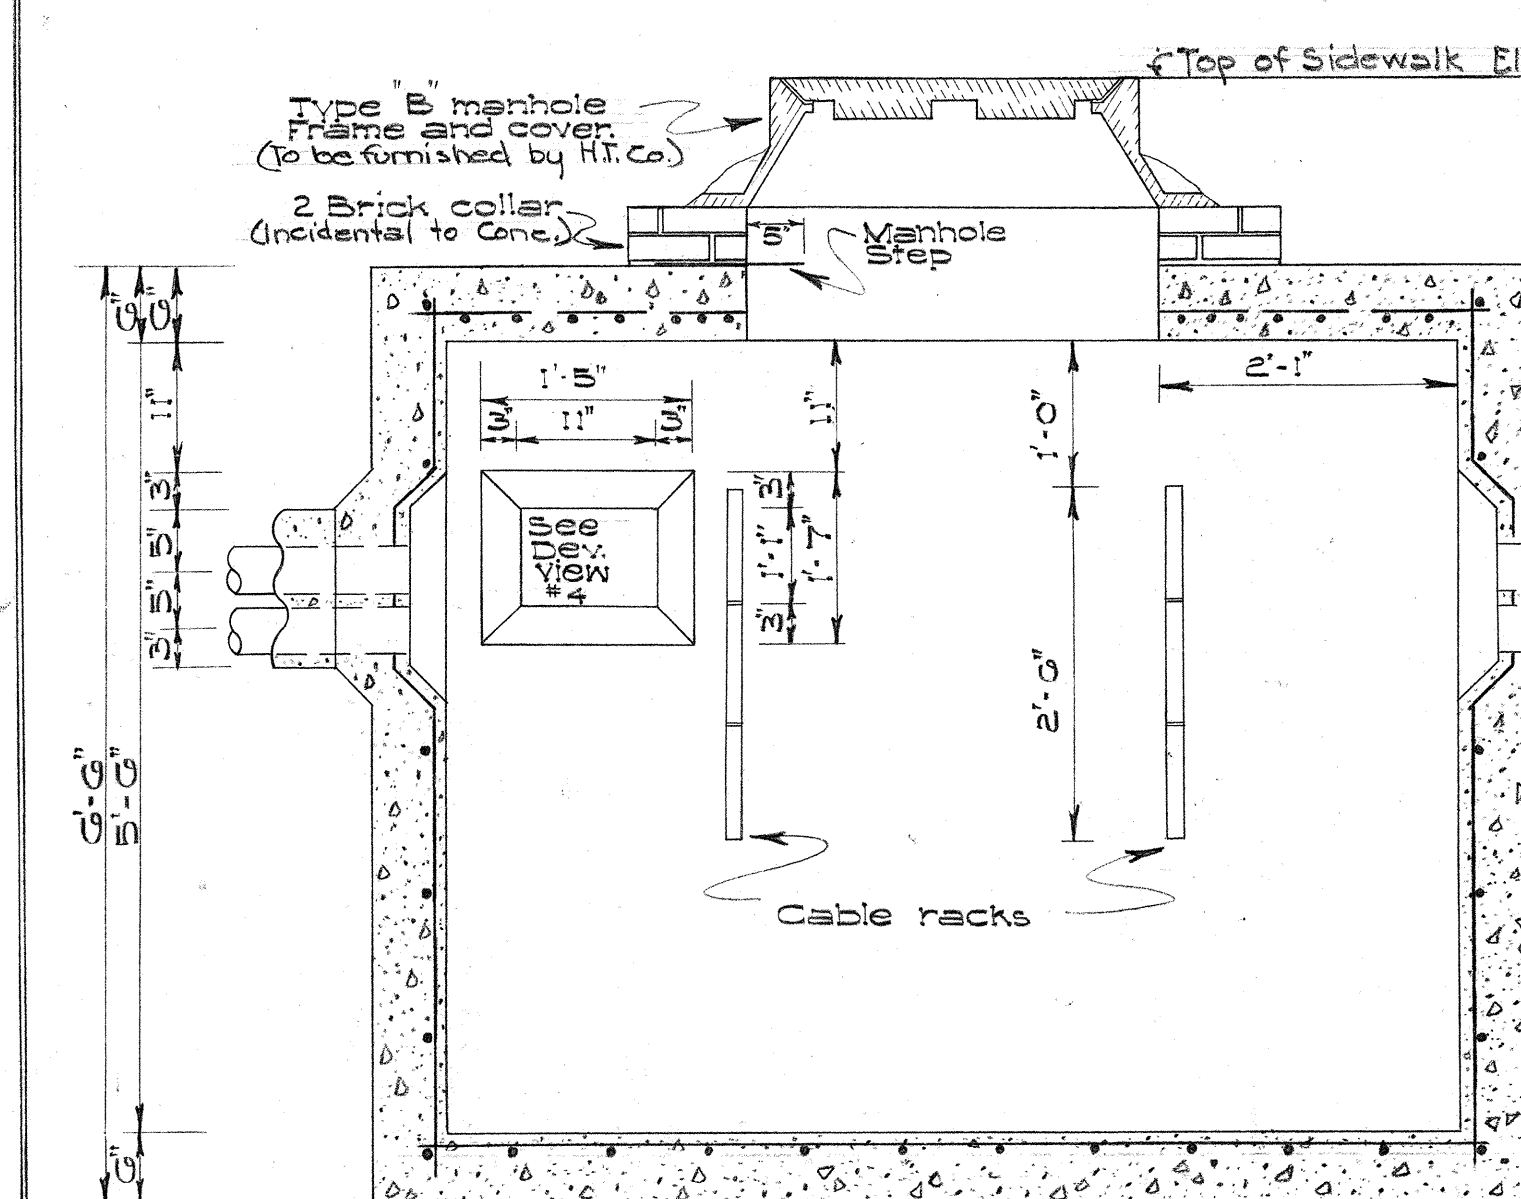

SECTION "A-A"
Scale: 3/4"=1'-0"

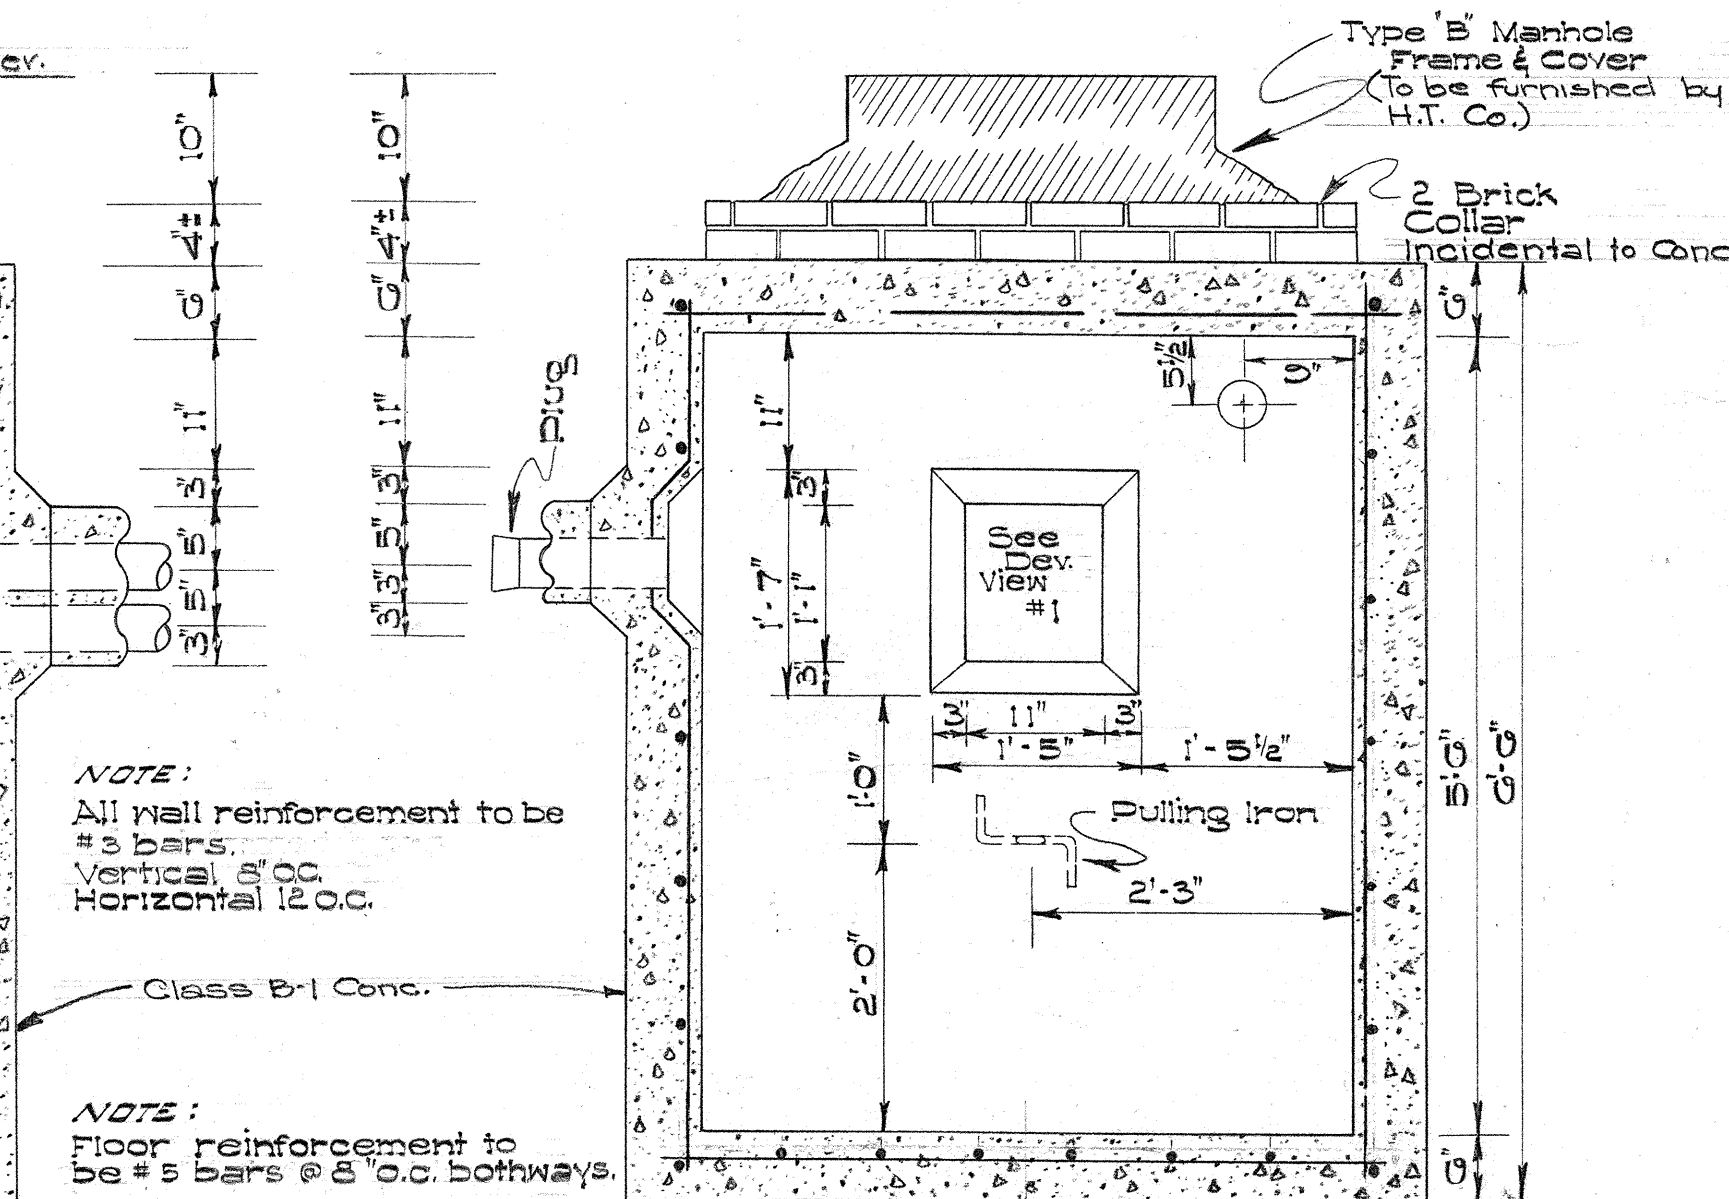


SECTION "B-B"
Scale: 3/4"=1'-0"

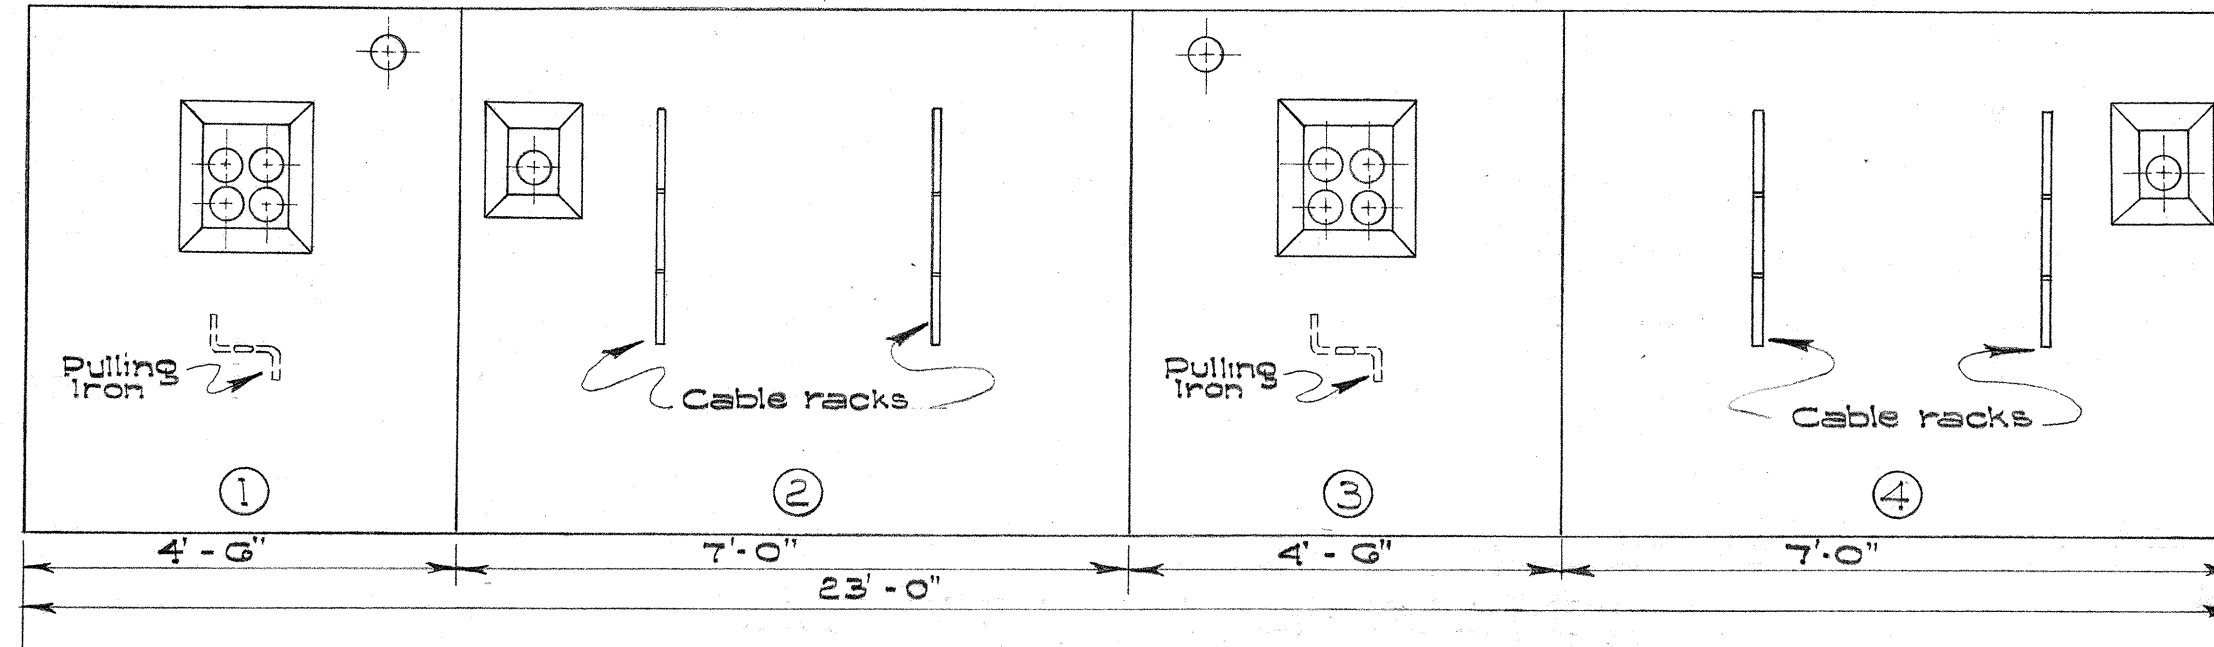

DEVELOPED VIEW OF WALLS
Scale: 1/2"=1'-0"

DETAIL OF MANHOLE NO. G80

NOTE:
For additional reinforcing at Duct openings, see Sht. 5882.61.

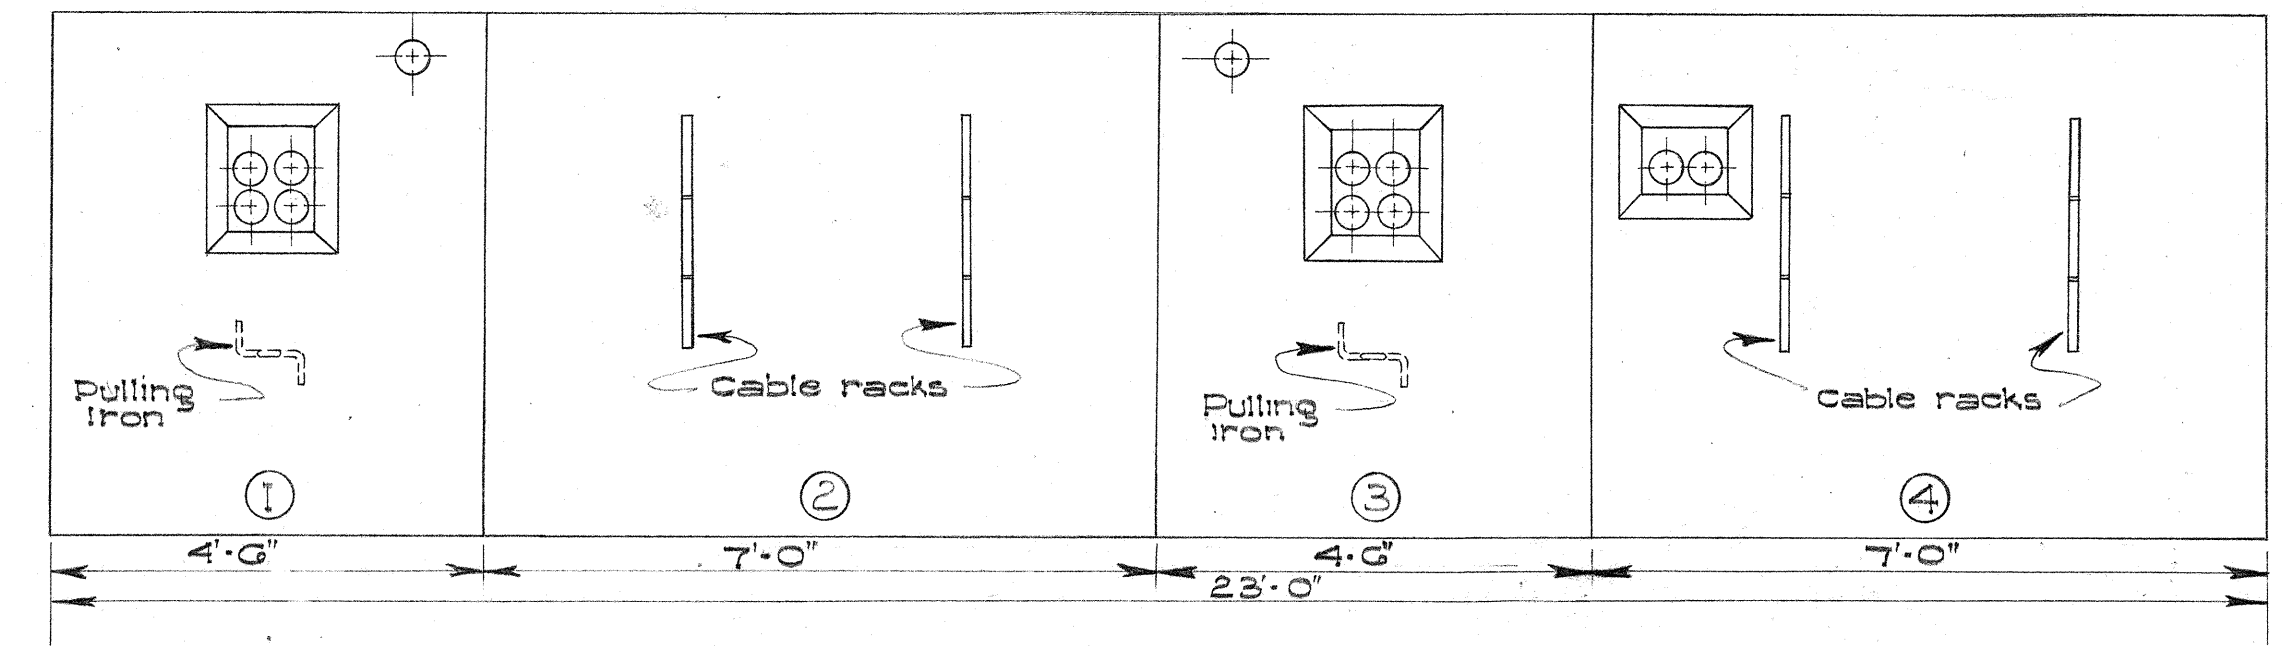

DEVELOPED VIEW OF WALLS
Scale: 1/2"=1'-0"

DETAIL OF MANHOLE NO. G90


NOTE:
For additional reinforcing at Duct openings, see Sheet 5882.61.

H.T. CO. APPROVED: *[Signature]*
TITLE: *[Signature]* 4-23-57
DATE


(NO AS-BUILT CHANGES ON THIS SHEET)

TERRITORIAL HIGHWAY DEPARTMENT
TERRITORY OF HAWAII
DETAILS OF HAWAIIAN TELEPHONE COMPANY MANHOLES NO. G80 AND MANHOLE NO. G90
VINEYARD THOROUGHFARE
PALAMA ST. TO FORT ST.
PROJECT NO. DF-098-1 (5)
Scale: As Noted Feb. 2, 1958


FED. ROAD DIST. NO.	STATE	FED. AID PROJ. NO.	FISCAL YEAR	SHEET NO.	TOTAL SHEETS
Hawaii	HAW.	DF0281(8)	1958	64	115

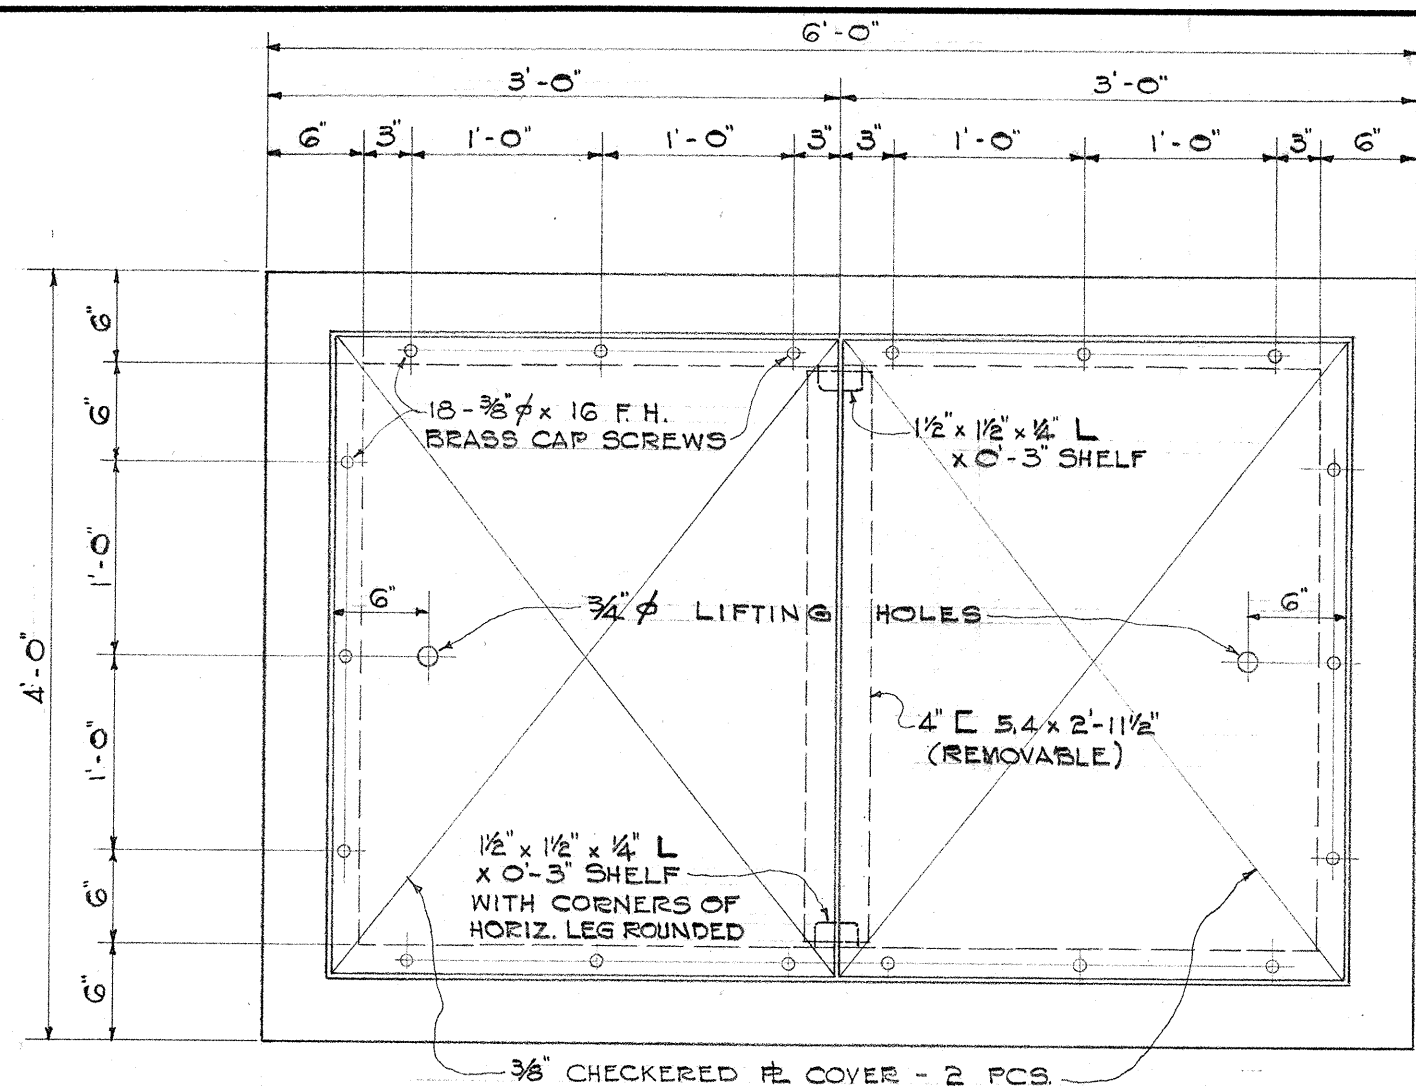


TOP PLAN
Scale: 1"=1'-0"

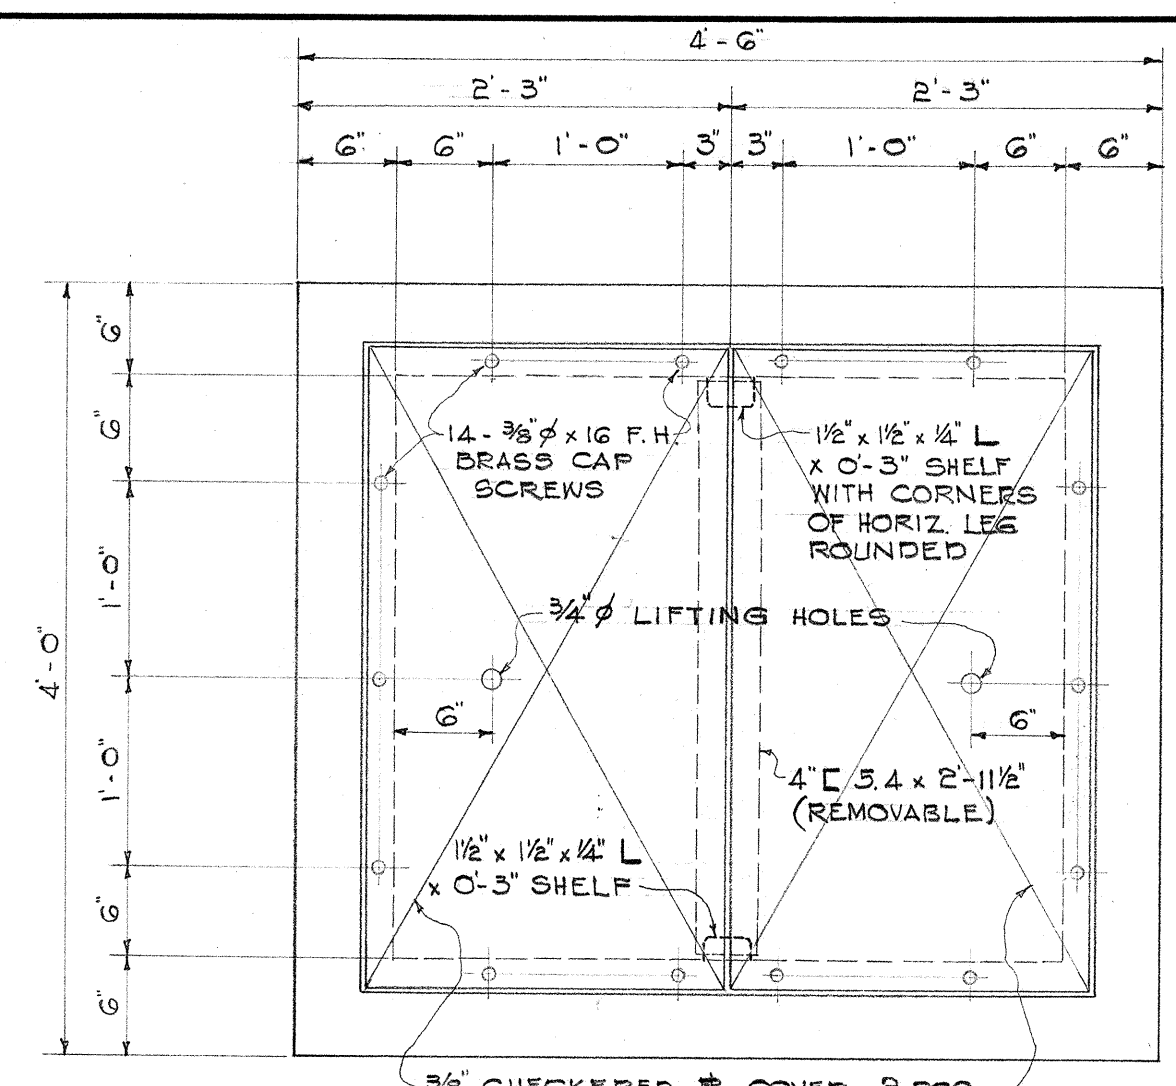


TOP PLAN
Scale: 1"=1'-0"

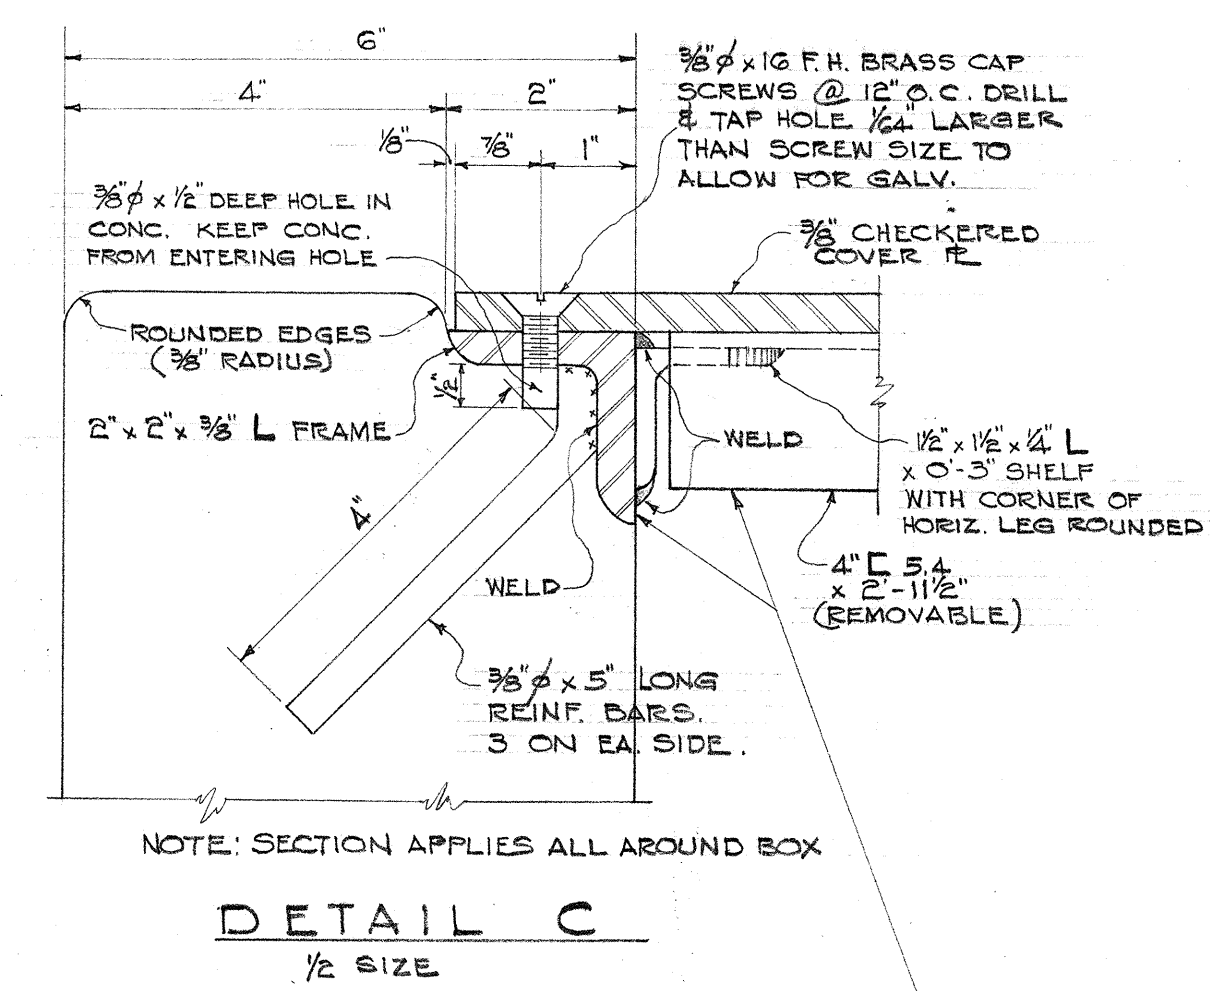


DETAIL C
1/2 SIZE

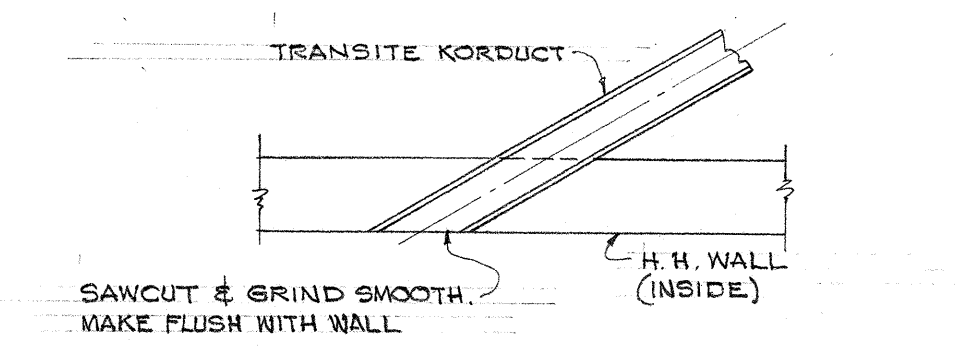


DIAGONAL ENTRANCE

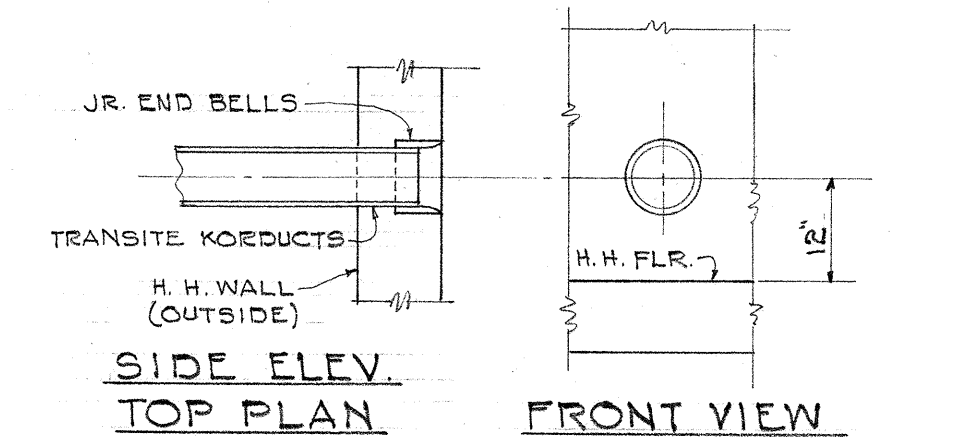


1 - DUCT

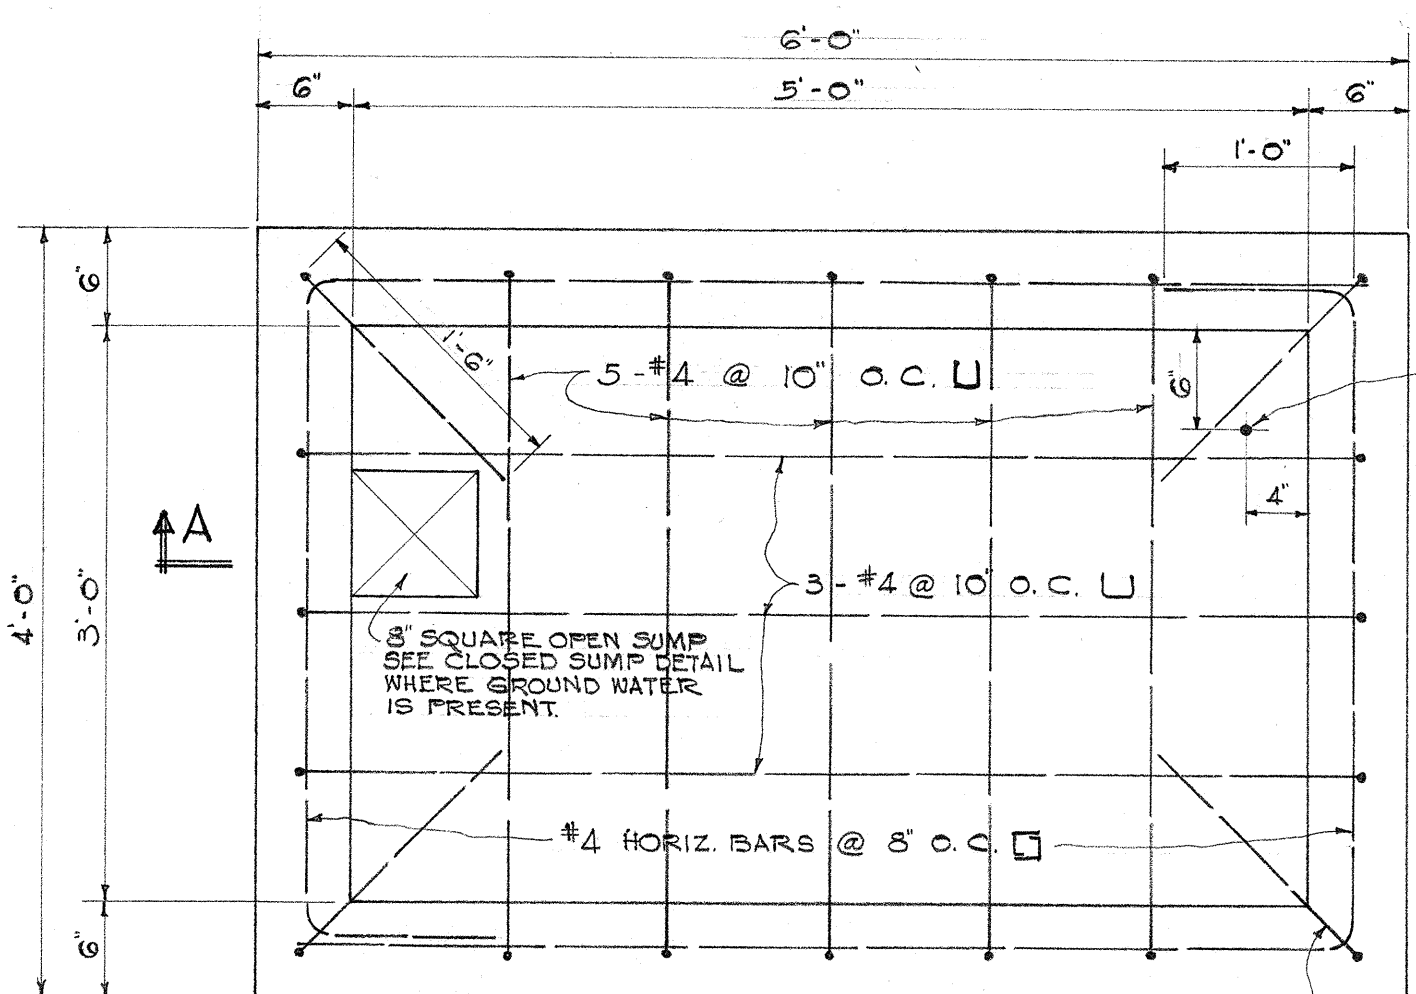


SECTIONAL PLAN
Scale: 1"=1'-0"

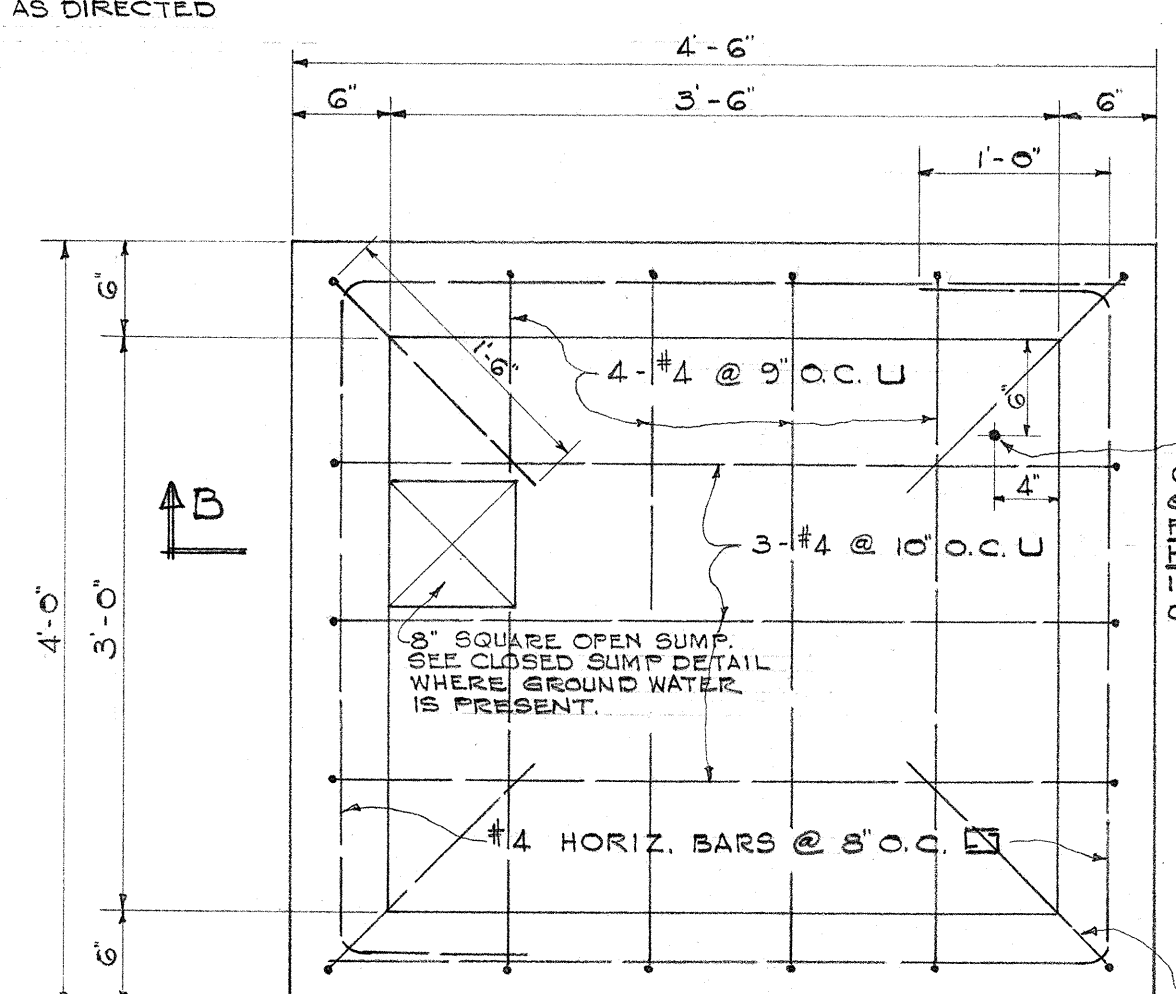


SECTIONAL PLAN
Scale: 1"=1'-0"

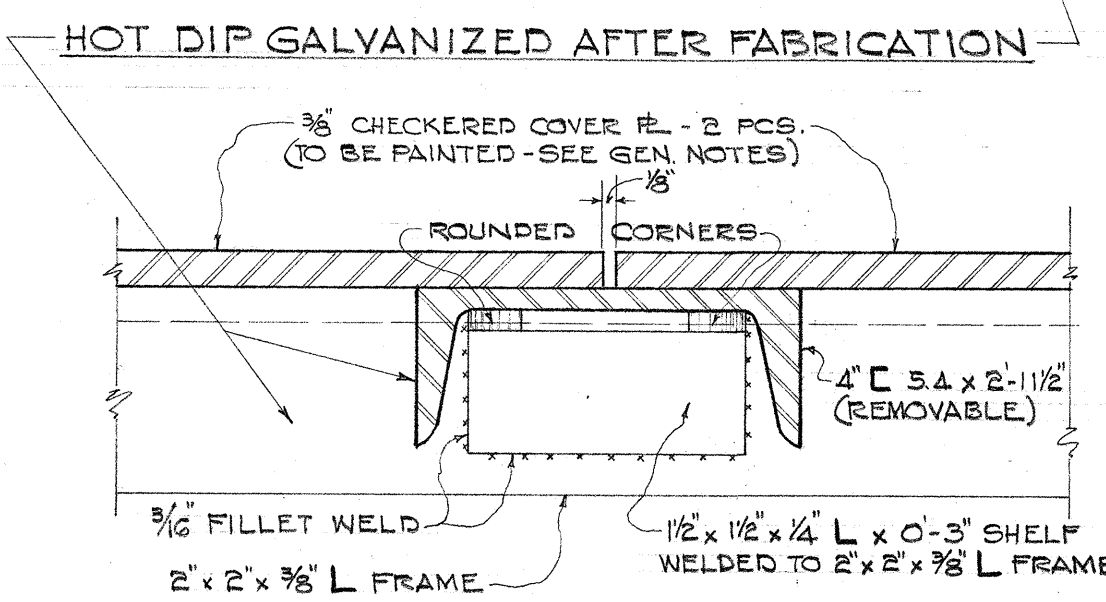


DETAIL D
1/2 SIZE

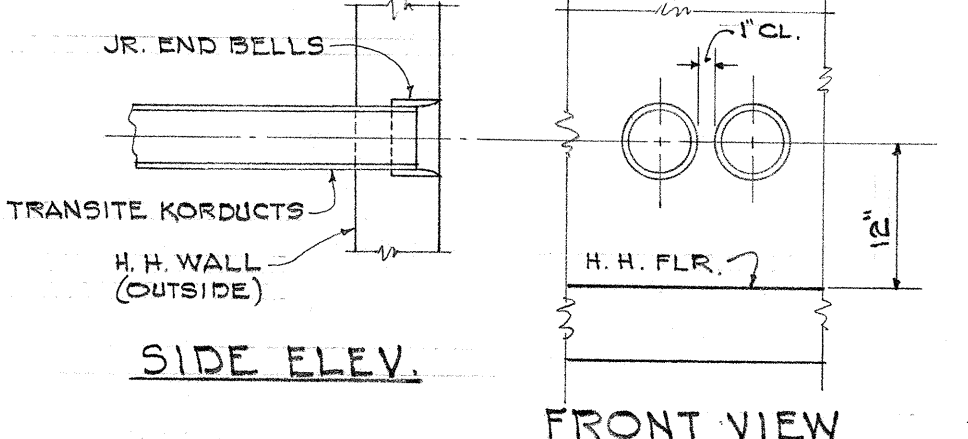


2 - DUCTS

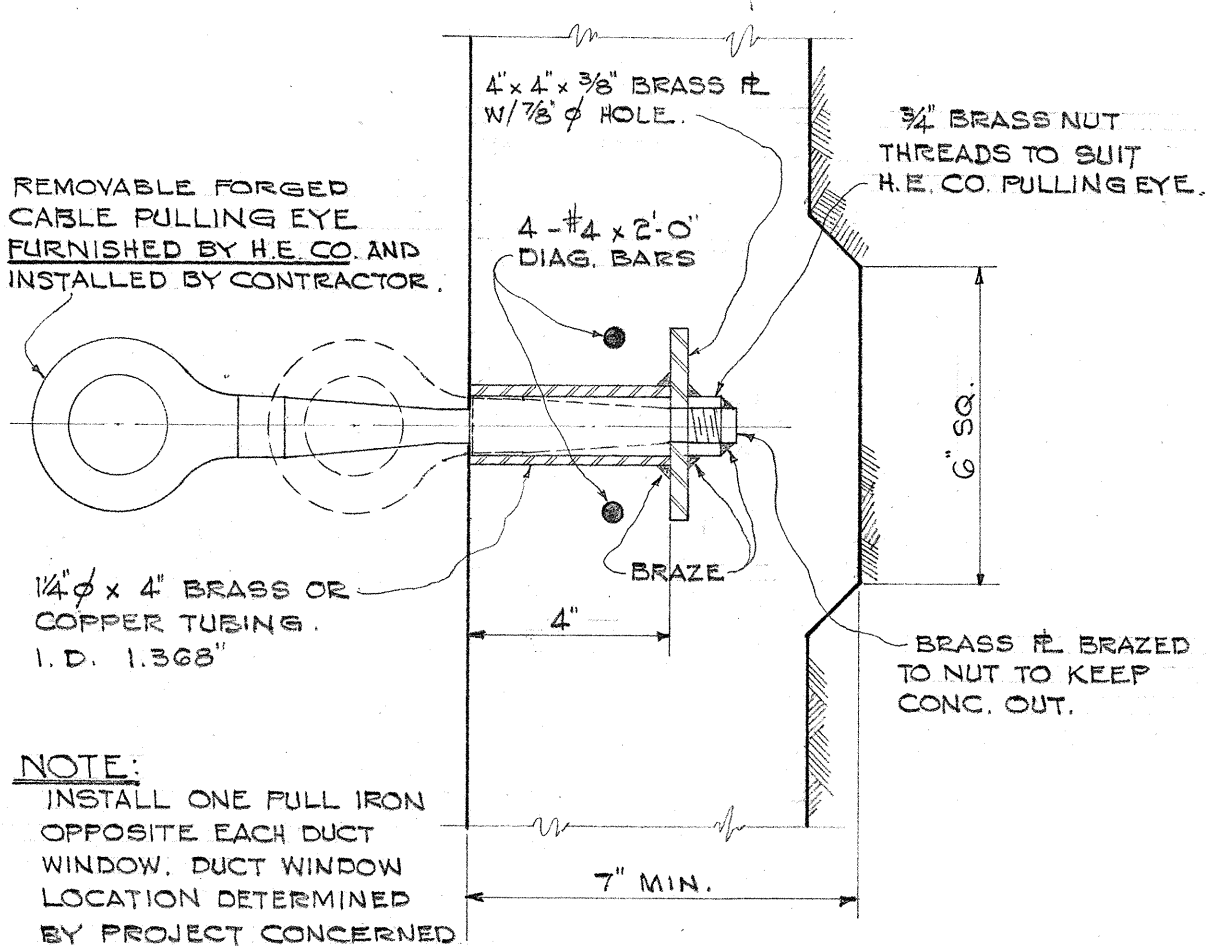


PULL IRON DETAIL
Scale: 3"=1'-0"

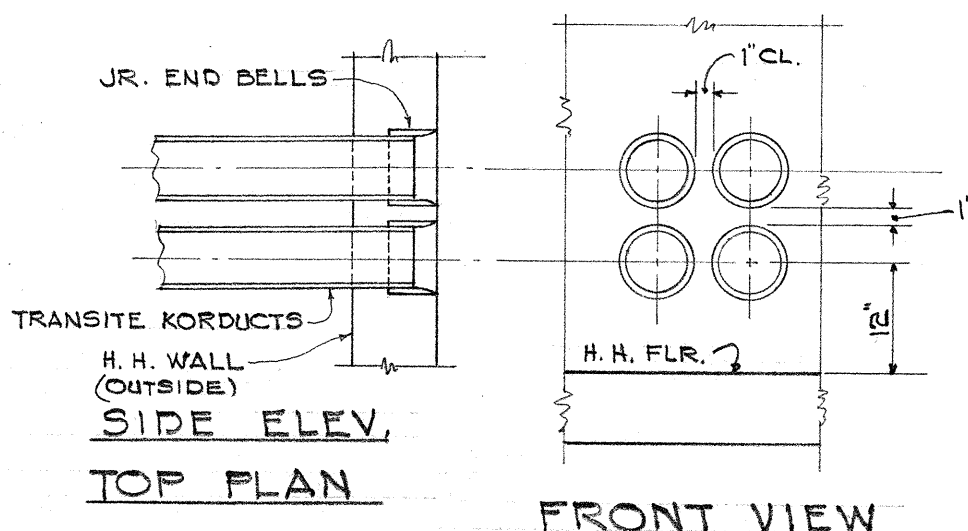


4 - DUCTS

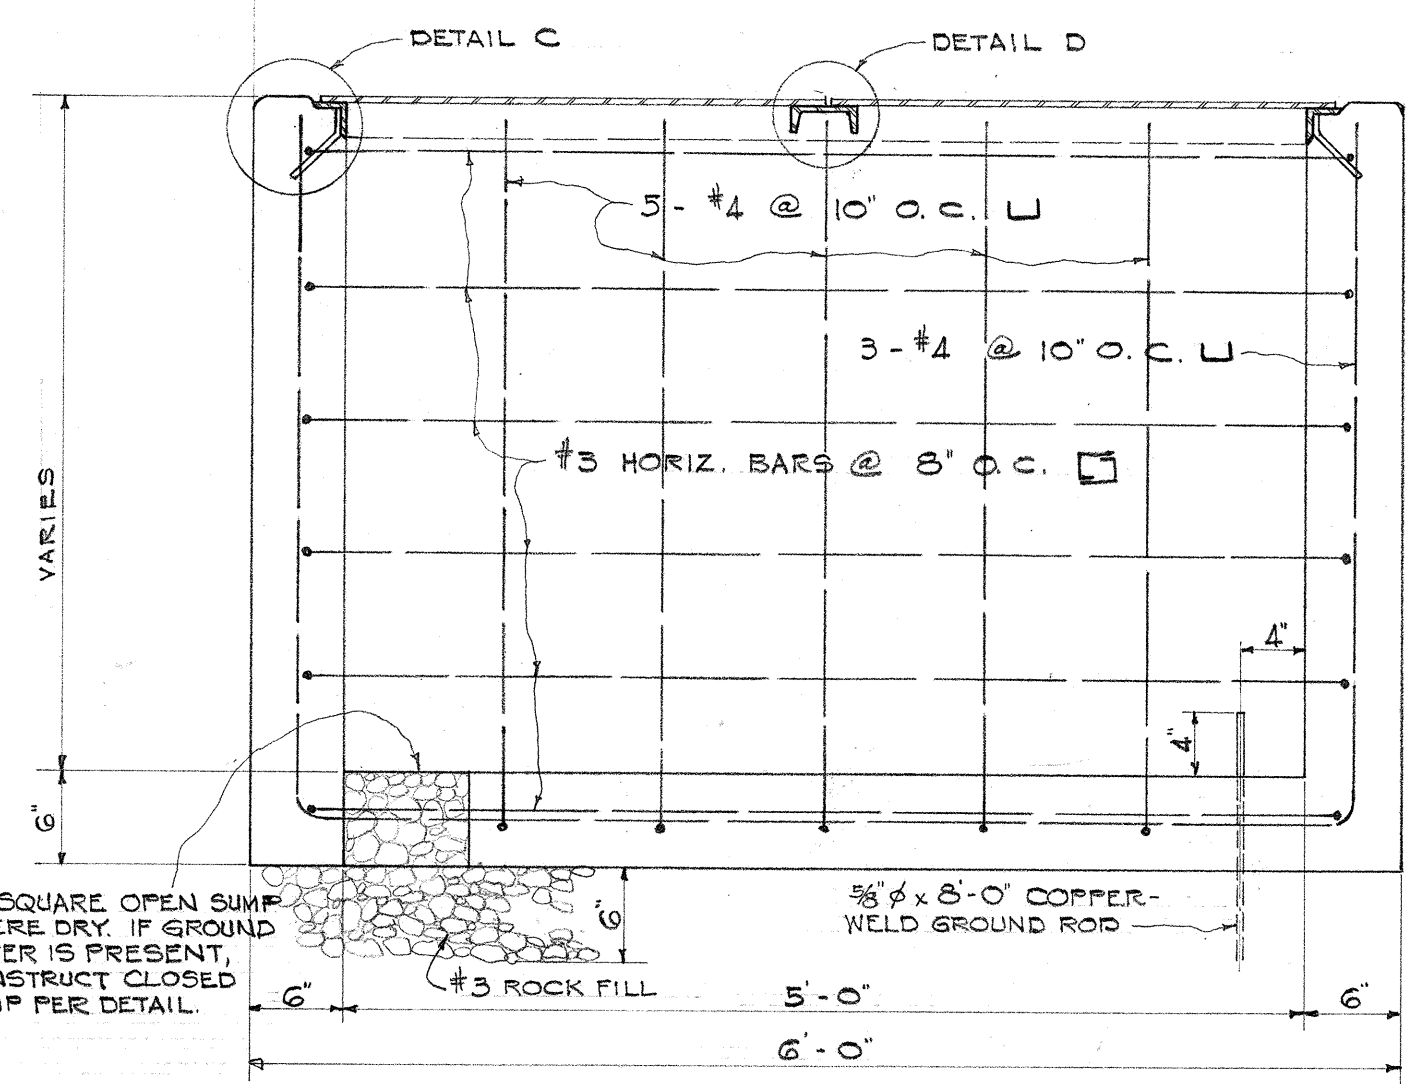

SECTION A-A
Scale: 1"=1'-0"

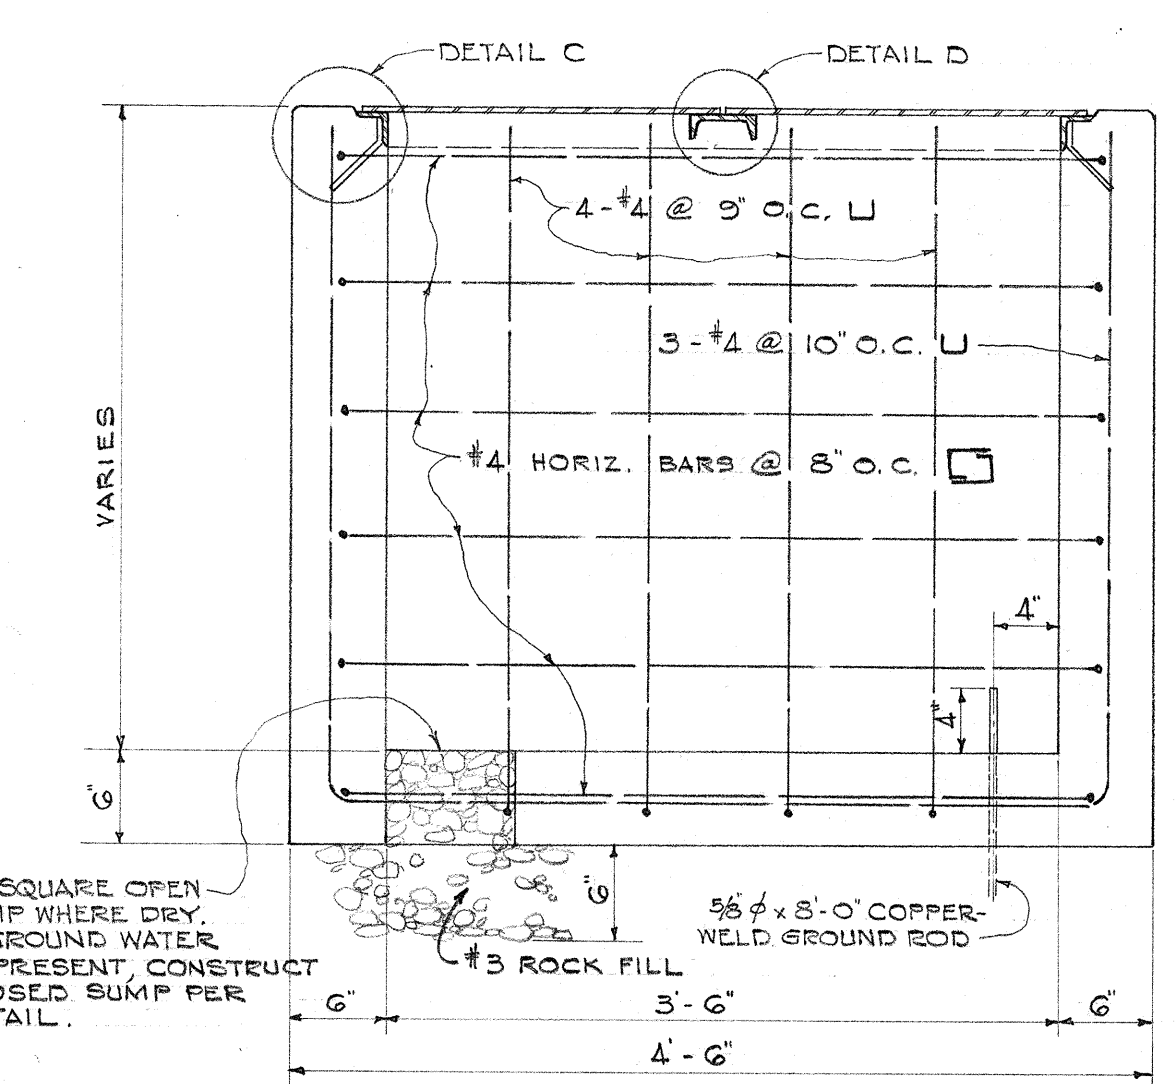

SECTION B-B
Scale: 1"=1'-0"

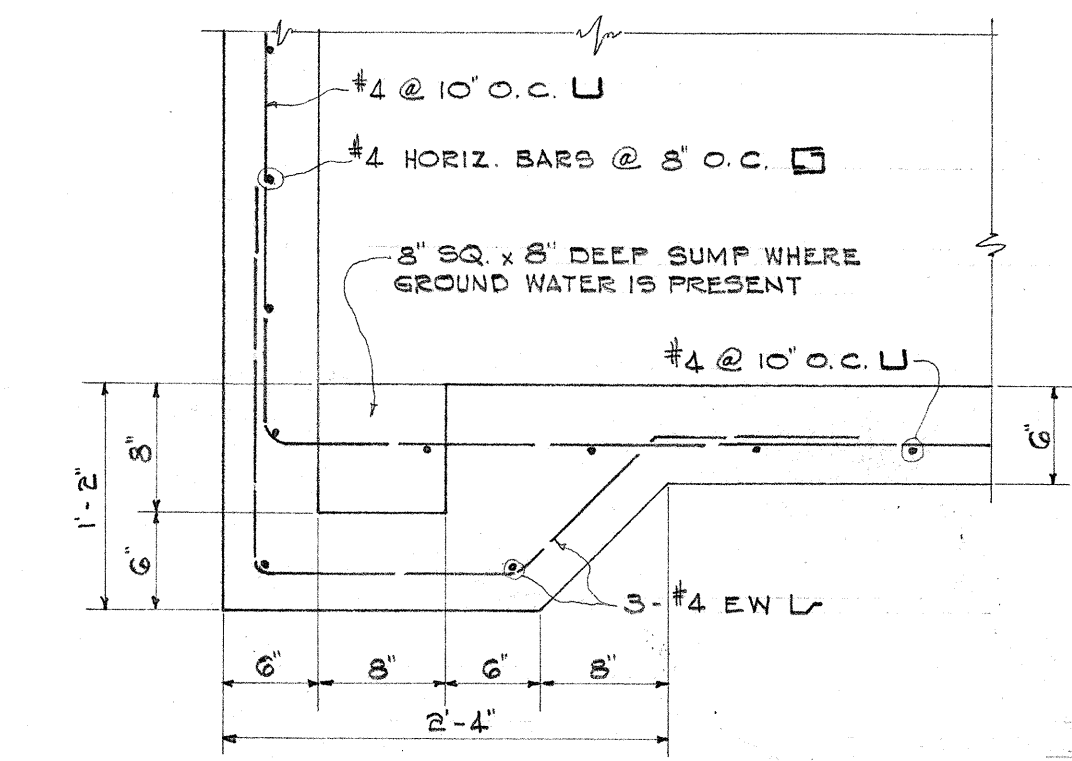

DETAIL OF CLOSED SUMP
Scale: 1"=1'-0"

DUCT ENTRANCE DETAILS

NOTE: SIZE & LOCATION OF DUCTS AS SHOWN ON PLANS OR AS DIRECTED BY THE ENGINEER.

GENERAL NOTES:

- 1- CONCRETE FINISH: FLOORS - SMOOTH METAL TROWELLED. EXPOSED WALL SURFACES & EDGES - SMOOTH AND FREE FROM DEFECTS.
- 2- CONCRETE TO DEVELOP COMPRESSIVE STRENGTH OF 3000 P.S.I. IN 28 DAYS.
- 3- FINISH STEEL WORK AS FOLLOWS:
 - A. 2" ANGLE FRAME & 4" CHANNEL TO BE HOT DIP GALVANIZED AFTER FABRICATION.
 - B. 3/8" CHECKERED PLATE COVERS TO BE THOROUGHLY CLEANED AND GIVEN ONE BASE COAT OF QUIGLEY'S TRIPLE A NO. 10 AND ONE FINISH COAT OF QUIGLEY'S TRIPLE A NO. 20.
- 4- FOR DUCT LINE CONSTRUCTION STANDARDS, SEE H. E. CO. DWG. U-18244
- 5- THESE HANDHOLES ARE DESIGNED FOR INSTALLATION IN AREAS OTHER THAN ROADWAYS.
- 6- CONTRACTOR TO FURNISH & INSTALL ALL MATERIALS FOR HANDHOLE EXCEPT ITEMS AS SHOWN ON DRAWING.


TERRITORIAL HIGHWAY DEPARTMENT
TERRITORY OF HAWAII
DETAILS OF HAWAIIAN
ELECTRIC CO. HANDHOLES
UNDERGROUND STANDARD U-18366
VINEYARD THOROUGHFARE
PALAMA ST. TO FORT ST
PROJECT NO. DF-008-1(5)

SCALE: AS NOTED JAN. 27, 1958










SHEET NO. 1 OF 2 SHEETS

5882.64

DESIGNED BY	DATE
PLANNED BY	
QUANTITIES BY	
CHECKED BY	
NO.	

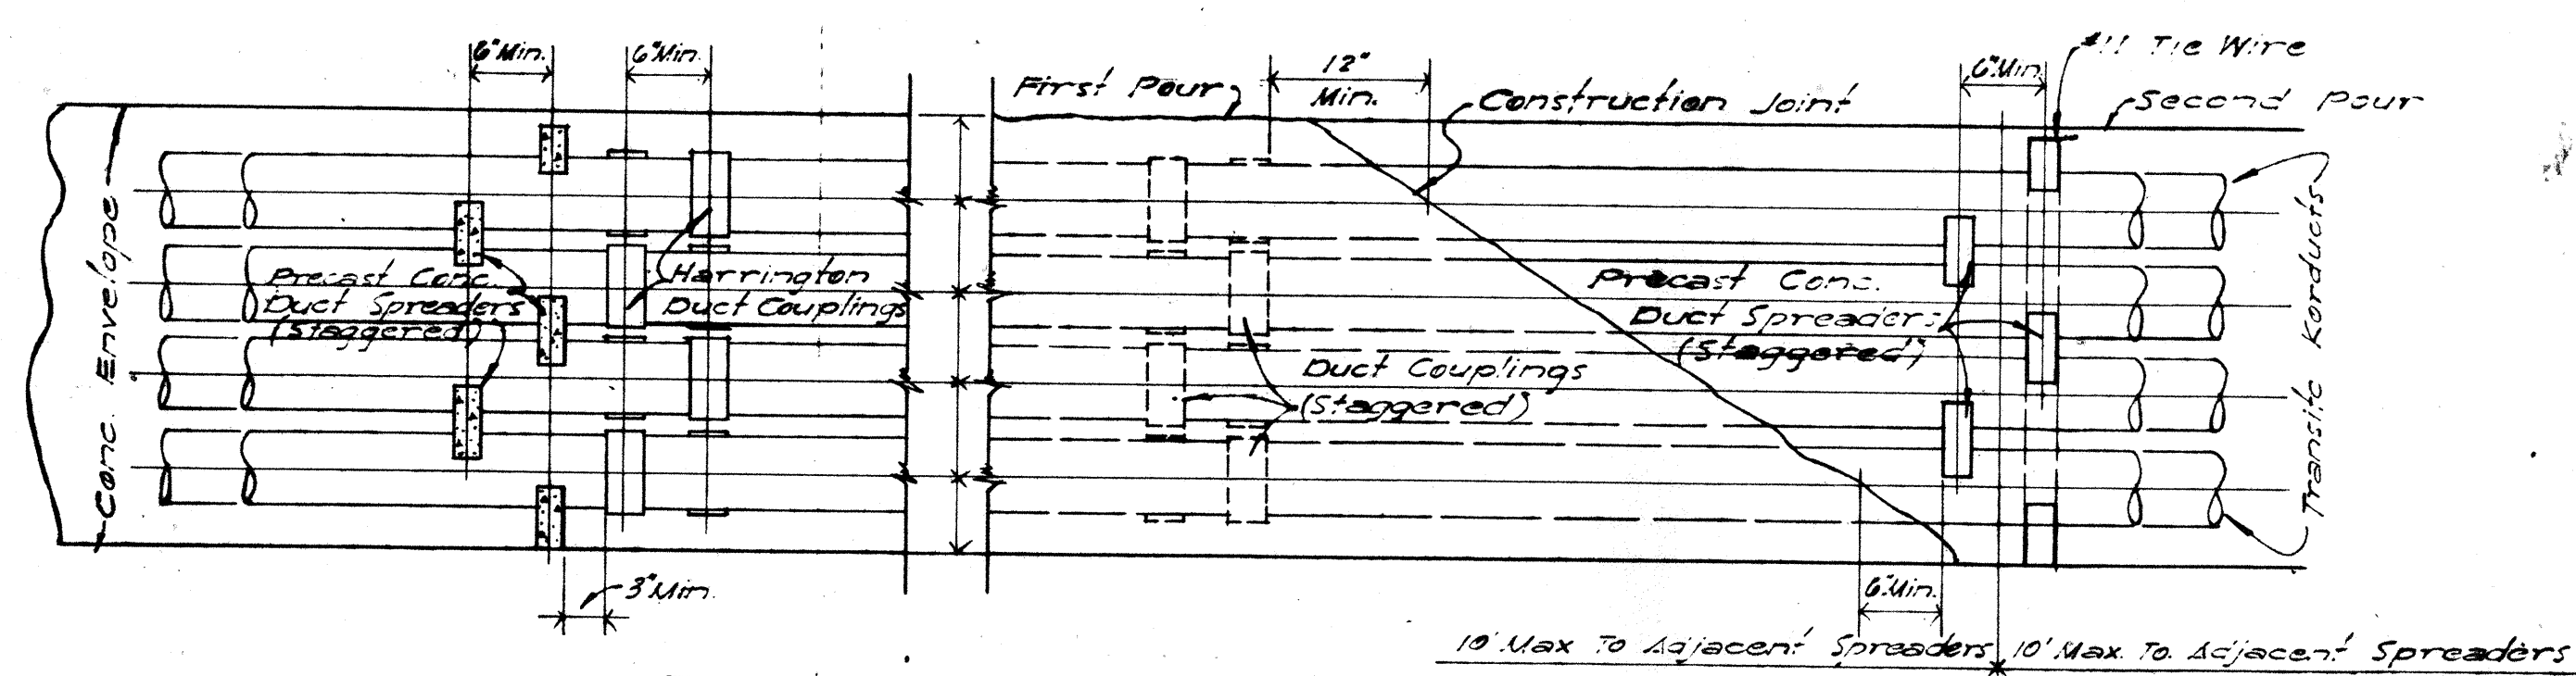

SIZE	H	S ₁	S ₂	S ₃	T ₁	T ₂	T ₃
3"	4	3 $\frac{3}{8}$	2 $\frac{5}{8}$	2	$\frac{5}{16}$	$\frac{11}{16}$	$\frac{3}{4}$
4"	4 $\frac{1}{2}$	4 $\frac{27}{64}$	3 $\frac{37}{64}$	2 $\frac{3}{4}$	$\frac{13}{32}$	$\frac{27}{32}$	$\frac{2}{3}$
4 $\frac{1}{2}$ "	4 $\frac{1}{2}$	4 $\frac{29}{64}$	4 $\frac{5}{8}$	3	$\frac{3}{8}$	$\frac{31}{32}$	$\frac{3}{4}$
5"	4 $\frac{1}{2}$	5 $\frac{27}{64}$	4 $\frac{37}{64}$	3 $\frac{1}{2}$	$\frac{3}{8}$	$\frac{31}{32}$	$\frac{2}{3}$

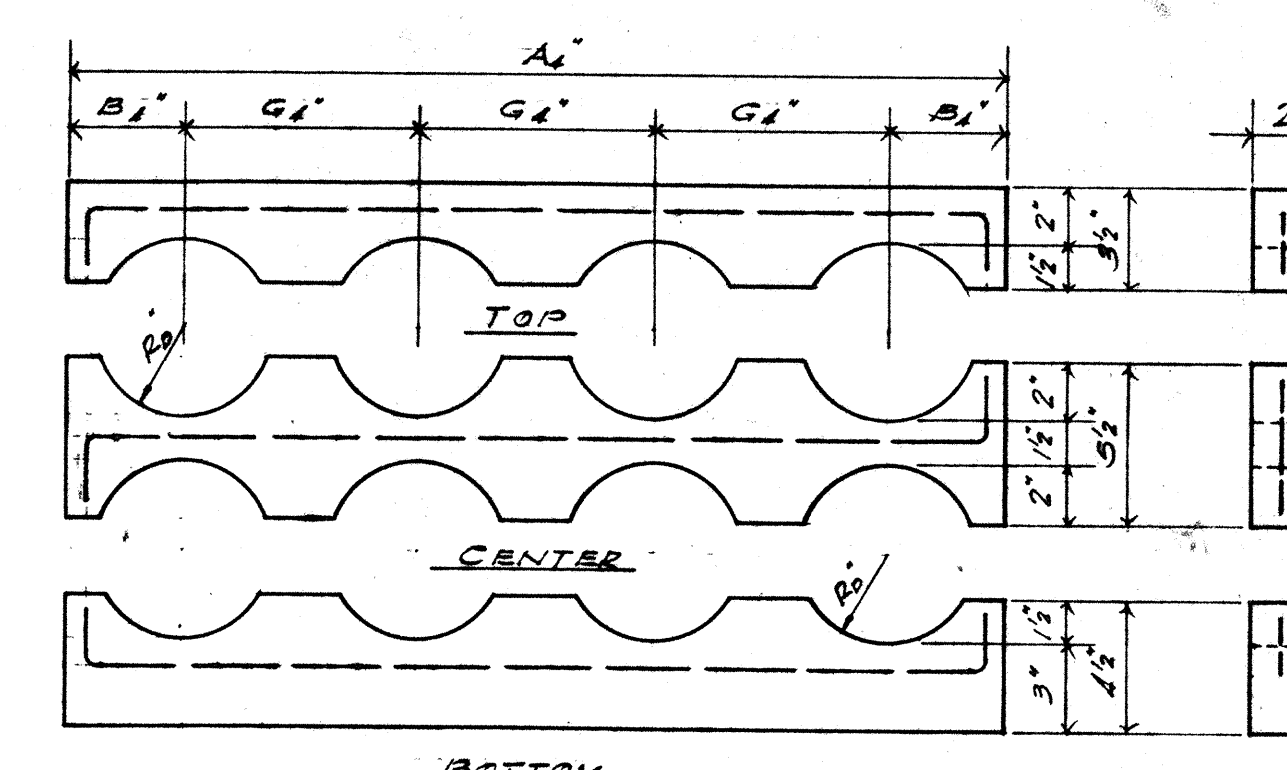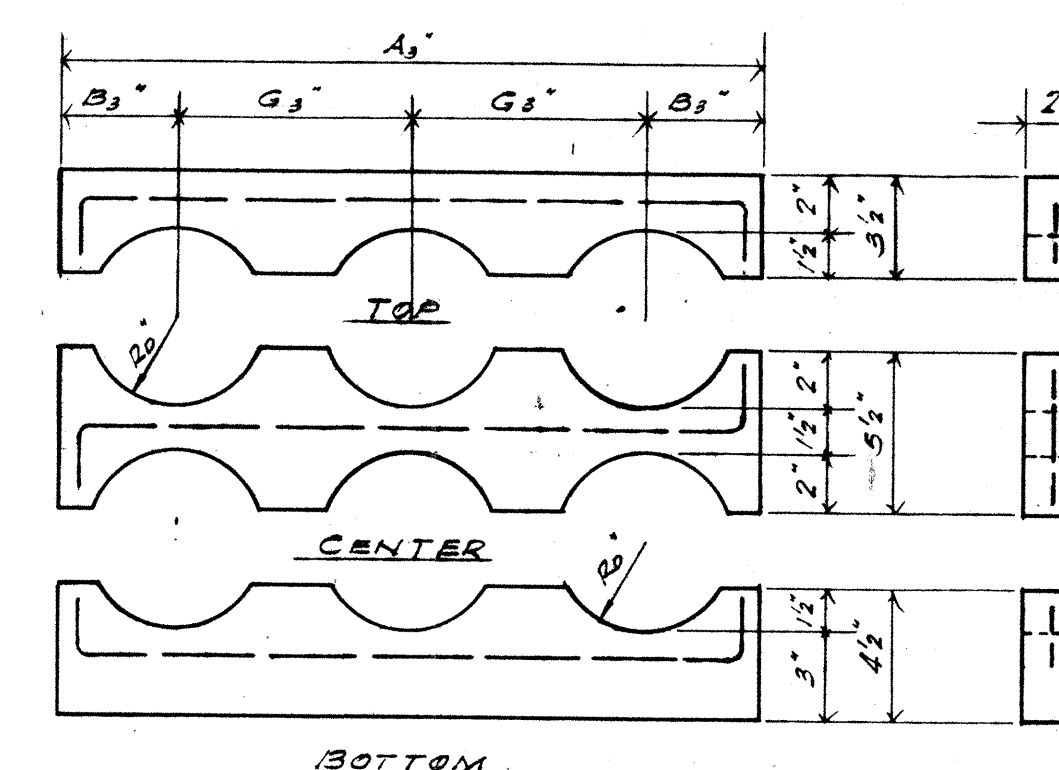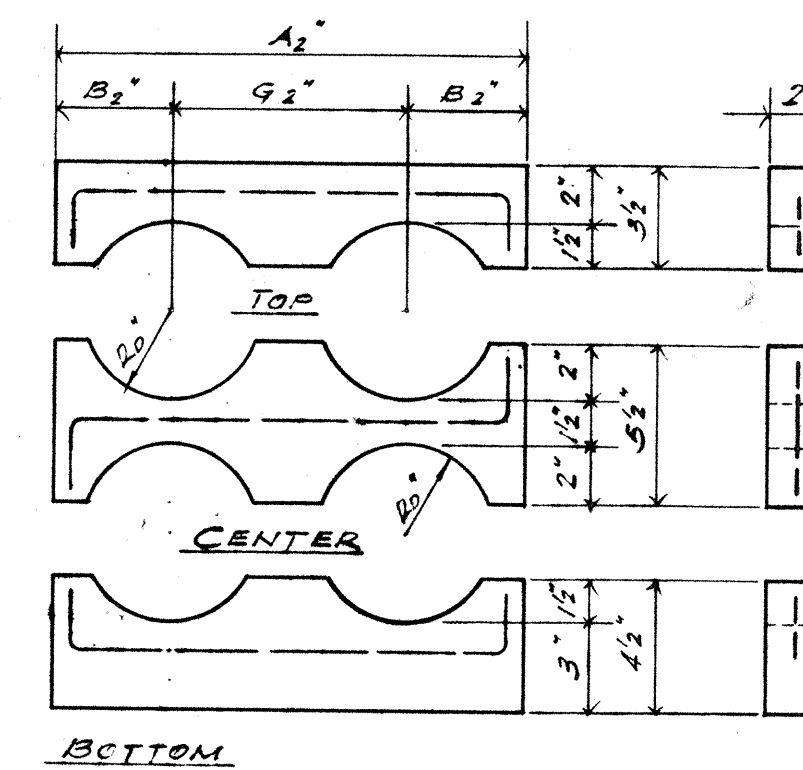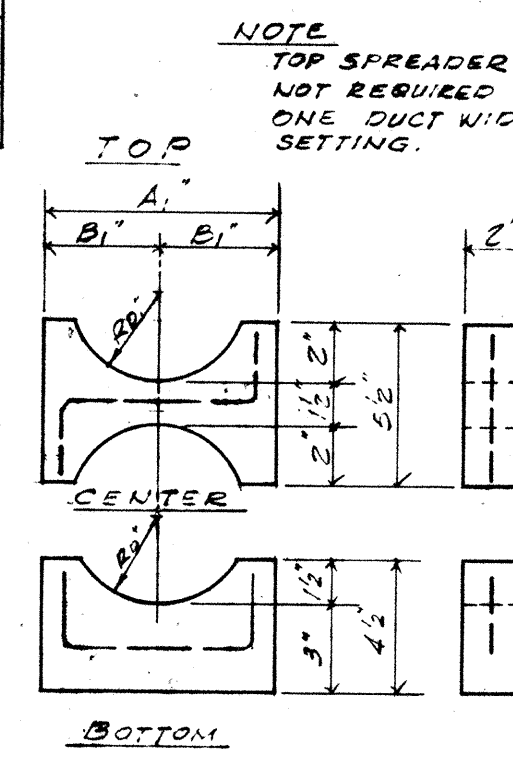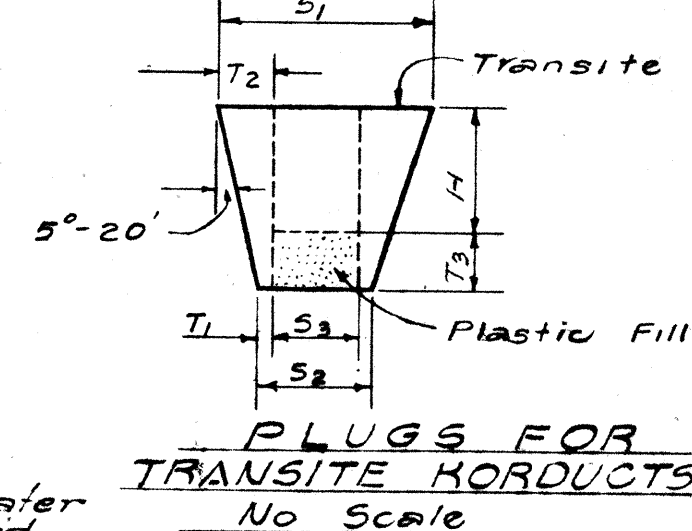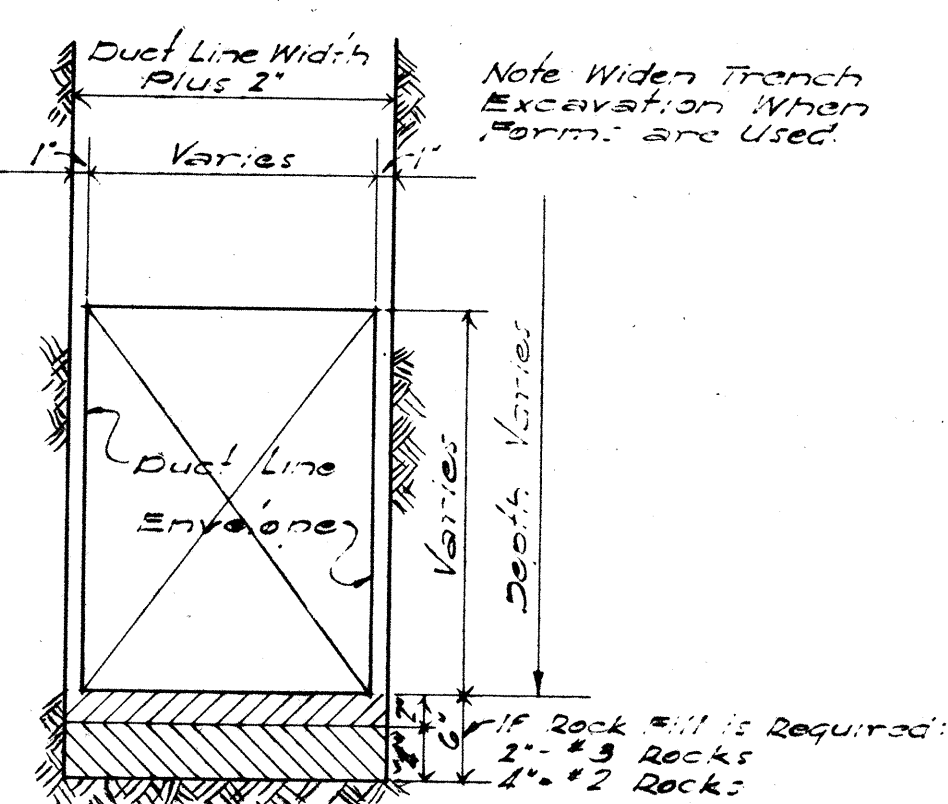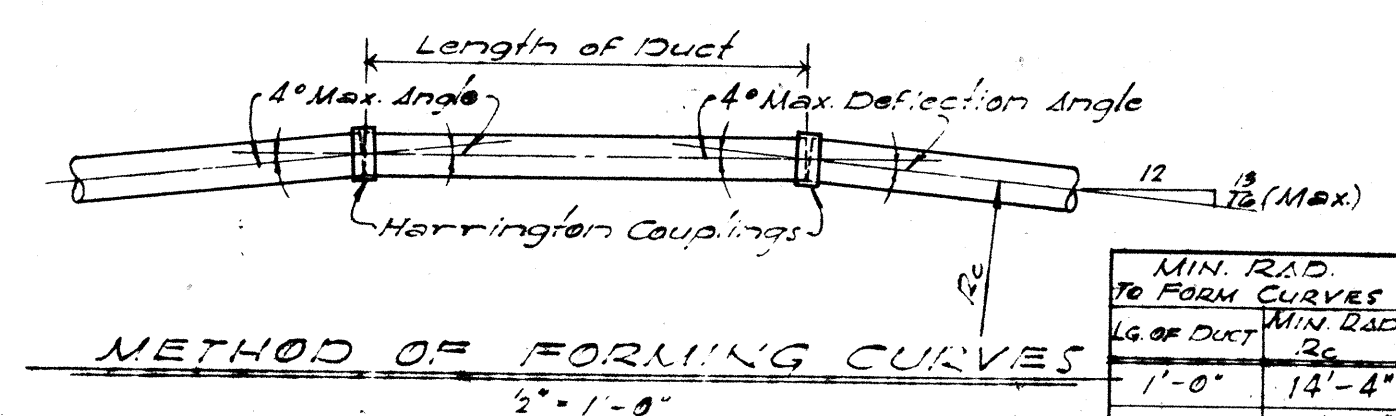
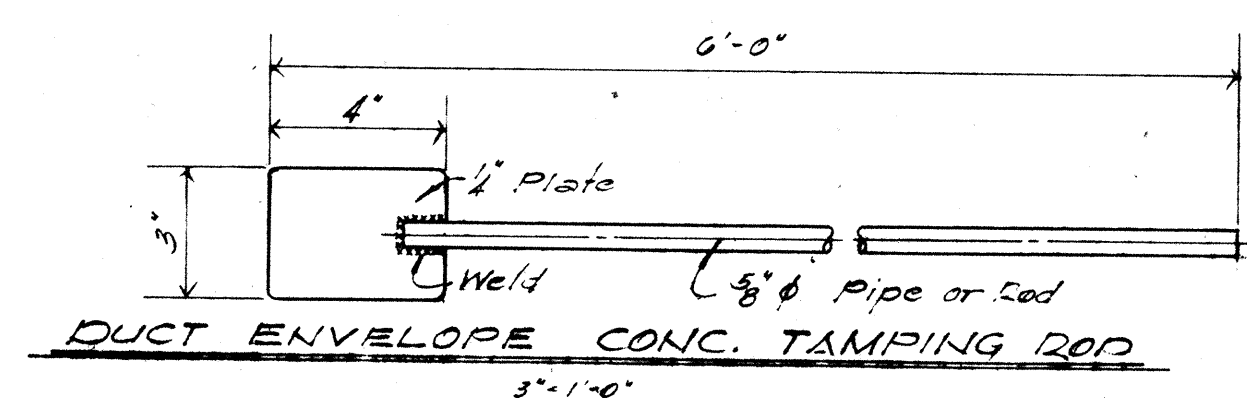
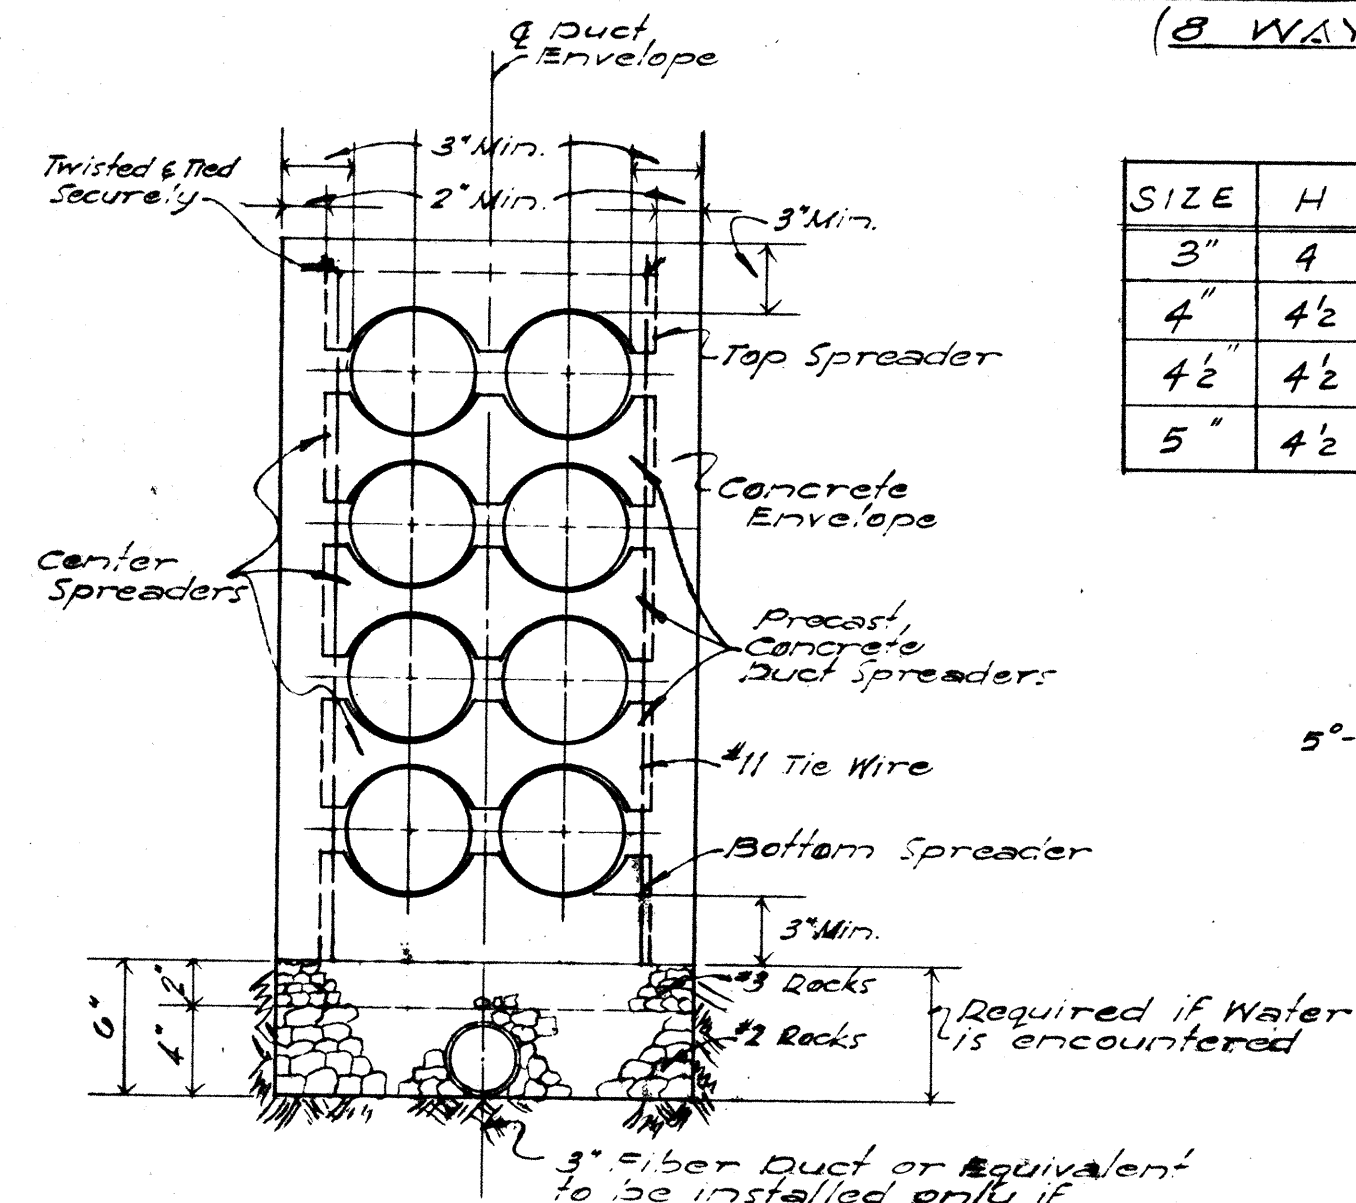


SIZE	D_1^*	D_2^*	F^*	X^*	E^*	R
3"	$3\frac{23}{32}$	$4\frac{1}{2}$	$1\frac{11}{32}$	$1\frac{23}{32}$	$1\frac{1}{2}$	1
4"	$4\frac{23}{32}$	$5\frac{1}{2}$	$1\frac{7}{8}$	$1\frac{7}{8}$	$1\frac{3}{8}$	2
4½"	$4\frac{57}{64}$	$6\frac{1}{2}$	$1\frac{7}{8}$	$1\frac{7}{8}$	$1\frac{3}{8}$	2
5"	$5\frac{59}{64}$	$7\frac{1}{2}$	$1\frac{7}{8}$	$1\frac{7}{8}$	$1\frac{1}{2}$	2

SIZE	D_1 "	D_2 "	C "	P°	T "
3"	$3\frac{23}{64}$	$3\frac{23}{64}$	$1\frac{1}{8}$	$\frac{7}{8}$	$\frac{1}{2}$
4"	$4\frac{43}{64}$	$4\frac{43}{64}$	$1\frac{1}{2}$	1	$\frac{3}{4}$
4½"	$4\frac{43}{64}$	$5\frac{1}{8}$	$1\frac{1}{2}$	1	$\frac{3}{4}$
5"	$5\frac{43}{64}$	$5\frac{43}{64}$	$1\frac{3}{4}$	$1\frac{1}{8}$	$\frac{3}{4}$

SIZE	D_1	D_2	L
3"	$3\frac{3}{8}$	$4\frac{1}{4}$	$2\frac{1}{4}$
4	$4\frac{5}{8}$	$5\frac{3}{16}$	$2\frac{1}{2}$
$4\frac{1}{2}$	$4\frac{7}{8}$	$5\frac{5}{8}$	$2\frac{1}{2}$
5"	$5\frac{17}{16}$	$6\frac{3}{4}$	$2\frac{3}{4}$

SIZE	M"	N
3"	5	6
4"	5½	7
4½"	5½	7½
5"	6	8

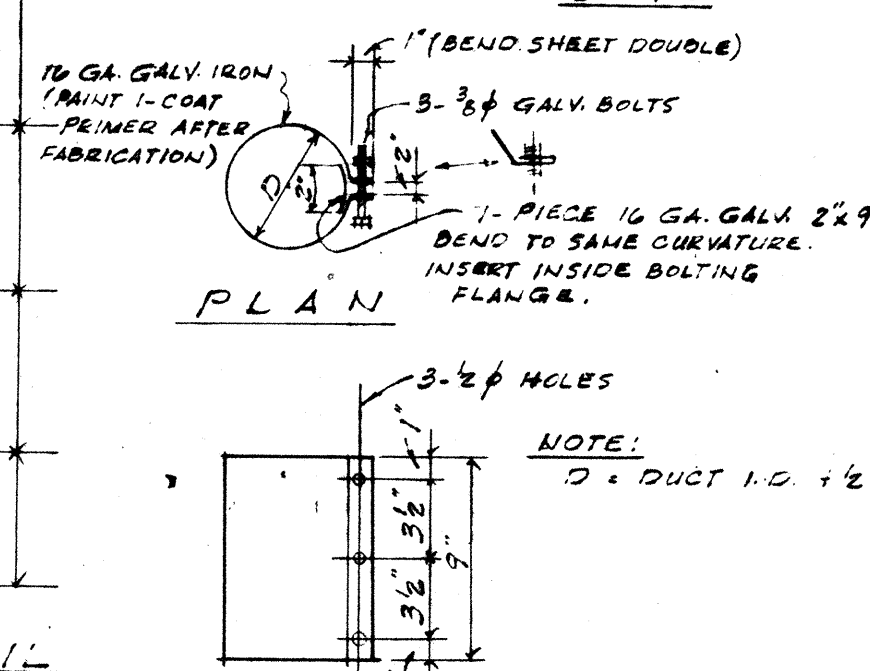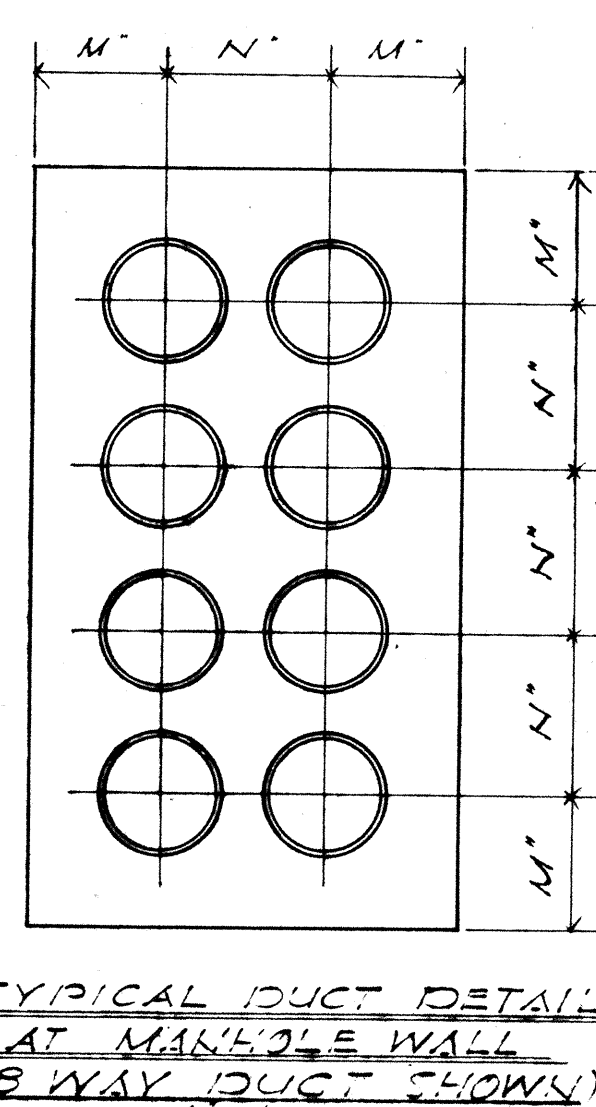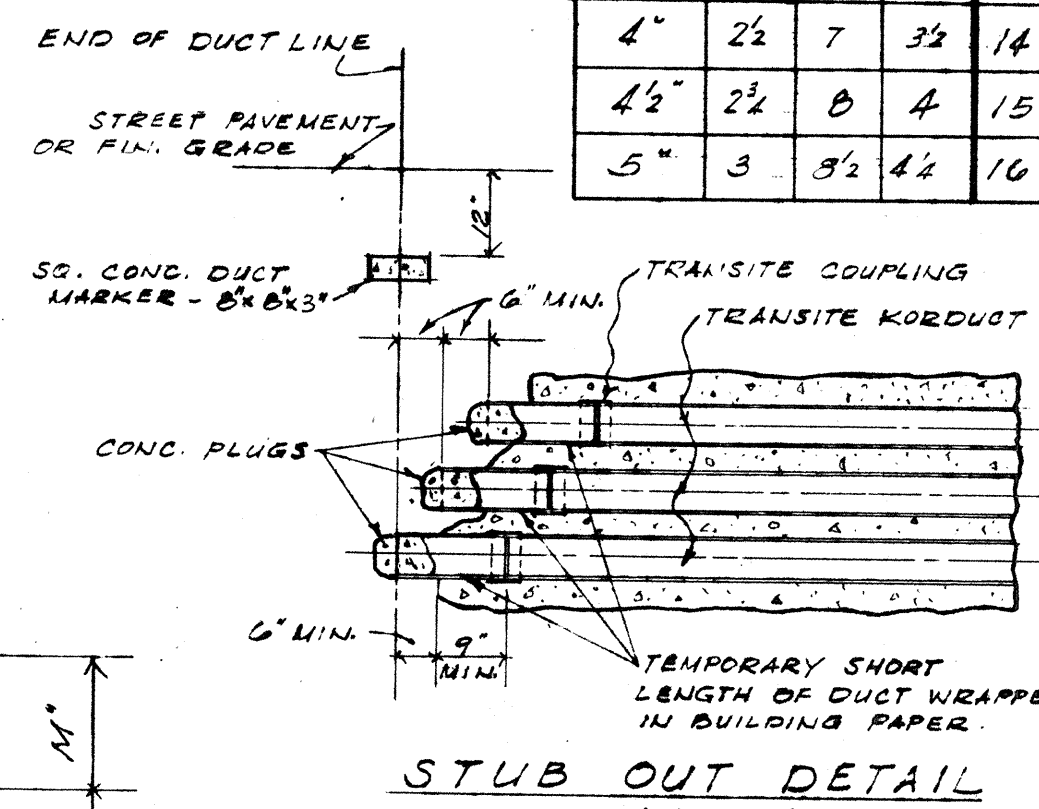

2" 1'-0"												
		1 DUCT WIDE		2 DUCTS WIDE			3 DUCTS WIDE			4 DUCTS WIDE		
SIZE	RO"	A ₁ "	B ₁ "	A ₂	B ₂	G ₂	A ₃	B ₃ "	G ₃ "	A ₄ "	B ₄ "	G ₄ "
3"	2	6	3	12	3 $\frac{1}{2}$	5 $\frac{1}{2}$	17 $\frac{1}{2}$	3 $\frac{1}{2}$	5 $\frac{1}{2}$	23	3 $\frac{1}{2}$	5 $\frac{1}{2}$
4"	2 $\frac{1}{2}$	7	3 $\frac{1}{2}$	14	3 $\frac{3}{4}$	6 $\frac{1}{2}$	20 $\frac{1}{2}$	3 $\frac{3}{4}$	6 $\frac{1}{2}$	27	3 $\frac{3}{4}$	6 $\frac{1}{2}$
4 $\frac{1}{2}$ "	2 $\frac{1}{2}$	8	4	15	4	7	22	4	7	29	4	7
5"	3	9 $\frac{1}{2}$	4 $\frac{1}{2}$	16	4 $\frac{1}{2}$	7 $\frac{1}{2}$	23 $\frac{1}{2}$	4 $\frac{1}{2}$	7 $\frac{1}{2}$	31	4 $\frac{1}{2}$	7 $\frac{1}{2}$

NOTES: DUCT SPREADERS
Reinforcing
1- 4" ϕ Bar each Spreader
Concrete Mix
One Part Cement.
Two Parts Beach Sand.
Two Parts Gravel #4 (Fine).
Measurements by Weight.

REDUCED PLANS
SCALES REDUCED
ACCORDINGLY


TERRITORIAL HIGHWAY DEPARTMENT
TERRITORY OF HAWAII
HAWAIIAN ELECTRIC CO.
STANDARD DETAILS
VINEYARD THOROUGHFARE
PALAMA ST. TO FORT ST.
PROJECT NO. DF-098-1 (5)
Scale: As Noted Feb. 28, 1953

SHEET No. 2 OF 2 SHEETS

CONSTRUCTION STANDARDS
TRANSITE KORJUKTS
UNDERGROUND DUCTLINES

Engineering Department
The Hawaiian Electric Company Ltd.
Hono. H. U. T. U-18244

5 S S 2. 65

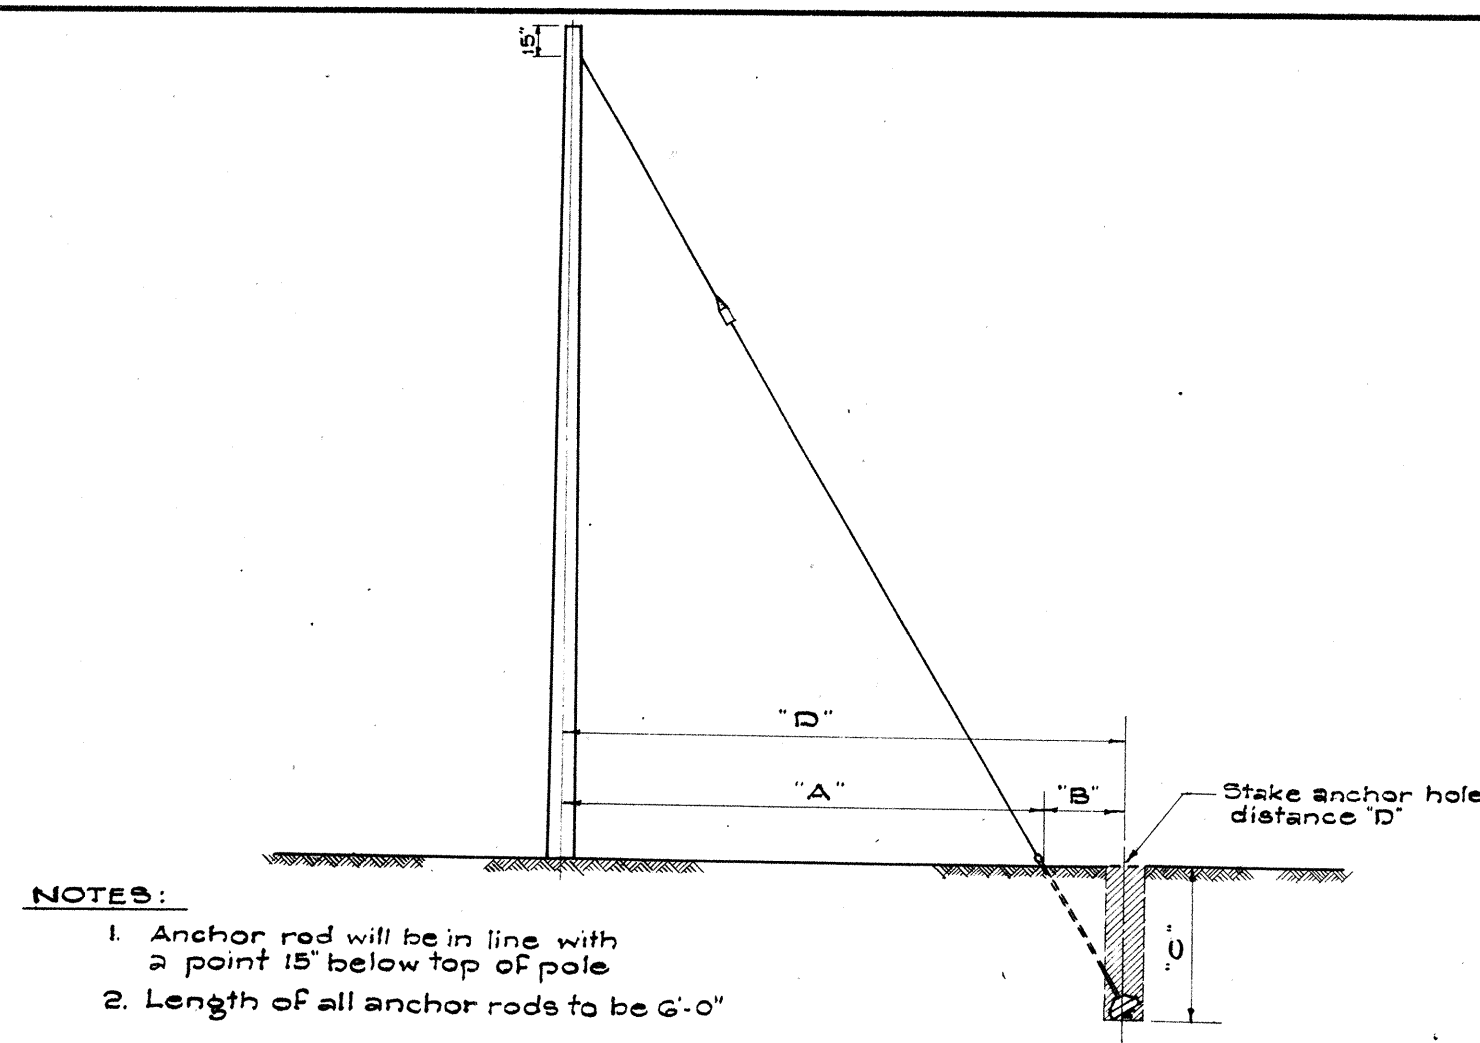

FOR 35', 40', 45', 50' & 55' POLES					
LEAD ANCHOR ROD TO E. OF POLE	ANCHOR ROD TO E. OF HOLE	VERTICAL DEPTH 18" D.M.	VERTICAL DEPTH 24" D.M.	TOTAL DISTANCE POLE TO HOLE	
"A"	"B"	"C"	"D"	"D" (A+B)	
5'-0"	1'-0"	7'-3"	7'-4"	8'-0"	
10'-0"	1'-11"	7'-1"	7'-5"	11'-11"	
15'-0"	2'-8"	6'-5"	7'-1"	17'-8"	
20'-0"	3'-3"	6'-6"	6'-10"	23'-3"	
25'-0"	3'-10"	6'-2"	6'-7"	28'-10"	


FOR 25' & 30' POLES					
LEAD ANCHOR ROD TO E. OF POLE	ANCHOR ROD TO E. OF HOLE	VERTICAL DEPTH 18" D.M.	VERTICAL DEPTH 24" D.M.	TOTAL DISTANCE POLE TO HOLE	
"A"	"B"	"C"	"D"	"D" (A+B)	
5'-0"	1'-8"	7'-1"	7'-4"	8'-5"	
10'-0"	3'-0"	6'-7"	7'-0"	13'-0"	
15'-0"	4'-0"	6'-1"	6'-6"	15'-0"	
20'-0"	4'-8"	5'-6"	5'-10"	24'-8"	
25'-0"	5'-2"	4'-11"	5'-4"	30'-2"	

D.M. = DEADMAN
Lead (Dimension "A") for H.T.Co. anchors (H.T.Co. ONLY) shown on plan.

ANCHORING DATA

Not to Scale

05-101

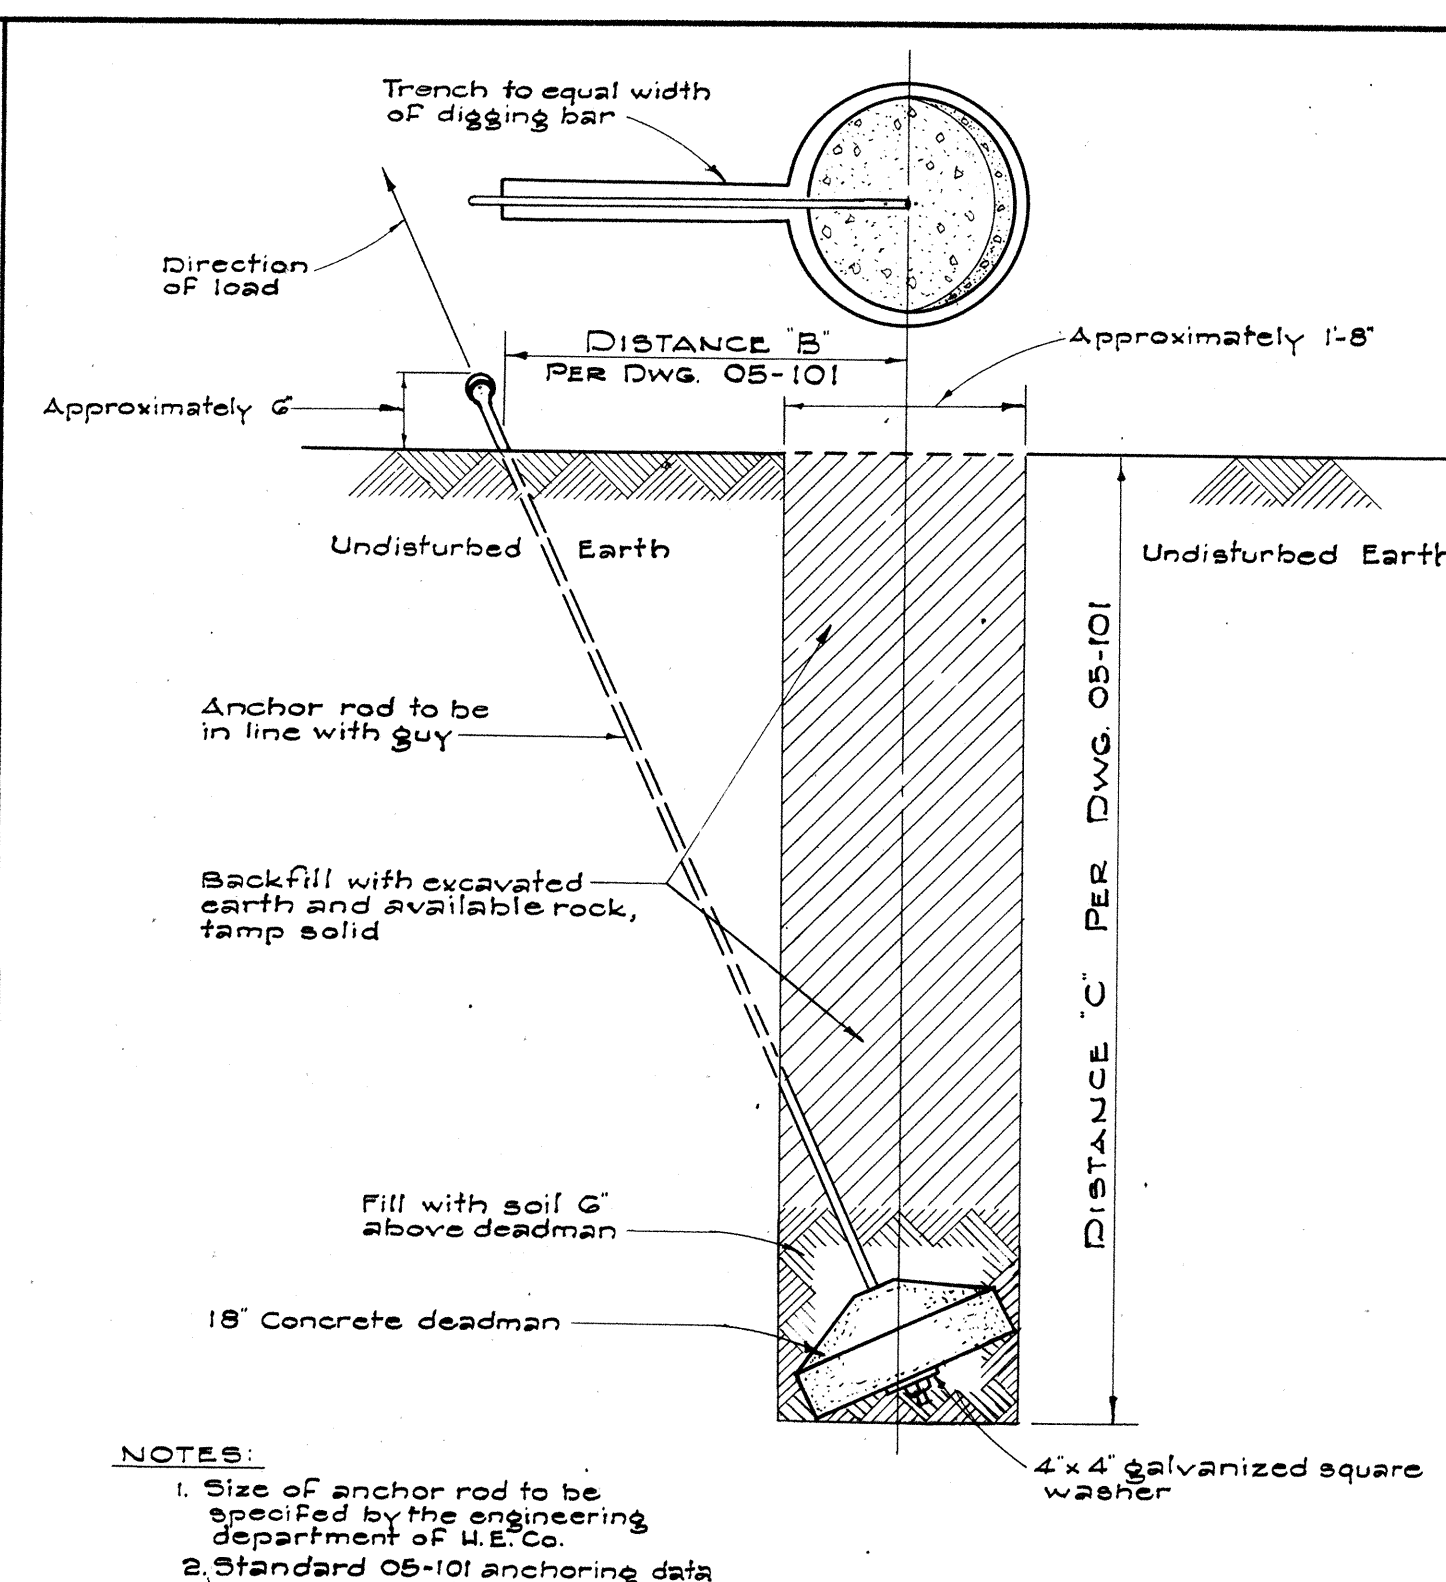


ALLOWABLE LOAD (1/2 OF ULTIMATE)

5/8" Anchor rod	8,000 lbs.
3/4" Anchor rod	12,500 lbs.
5/8" Copperweld anchor rod	9,250 lbs.

GUY ANCHOR, 18" DEADMAN

Scale: 3/4" = 1' - 0"

05-102

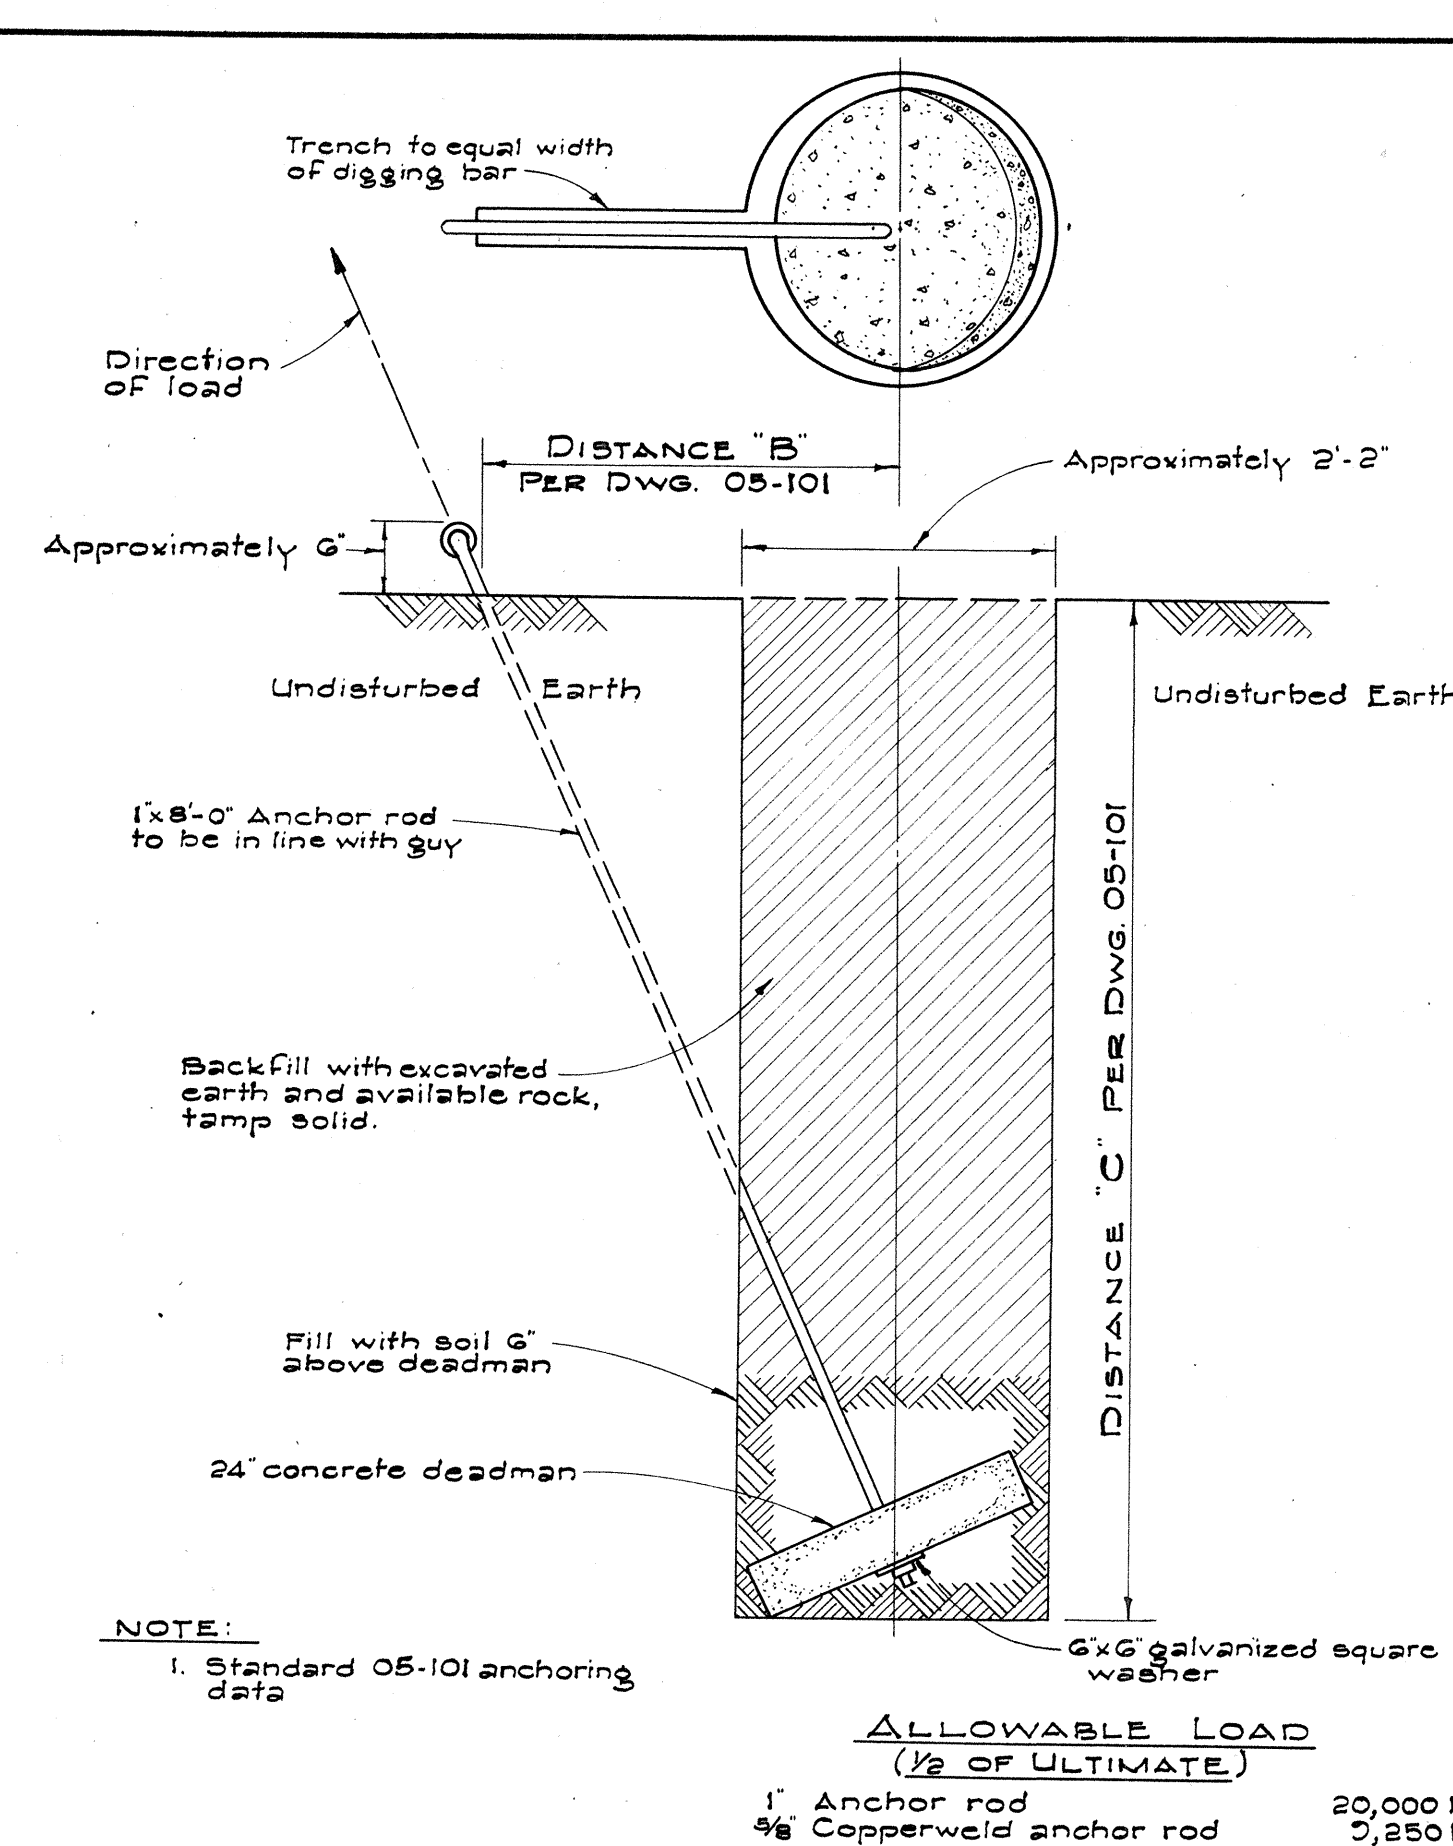


ALLOWABLE LOAD (1/2 OF ULTIMATE)

1" Anchor rod	20,000 lbs.
5/8" Copperweld anchor rod	9,250 lbs.

GUY ANCHOR, 24" DEADMAN

Scale: 3/4" = 1' - 0"

05-103

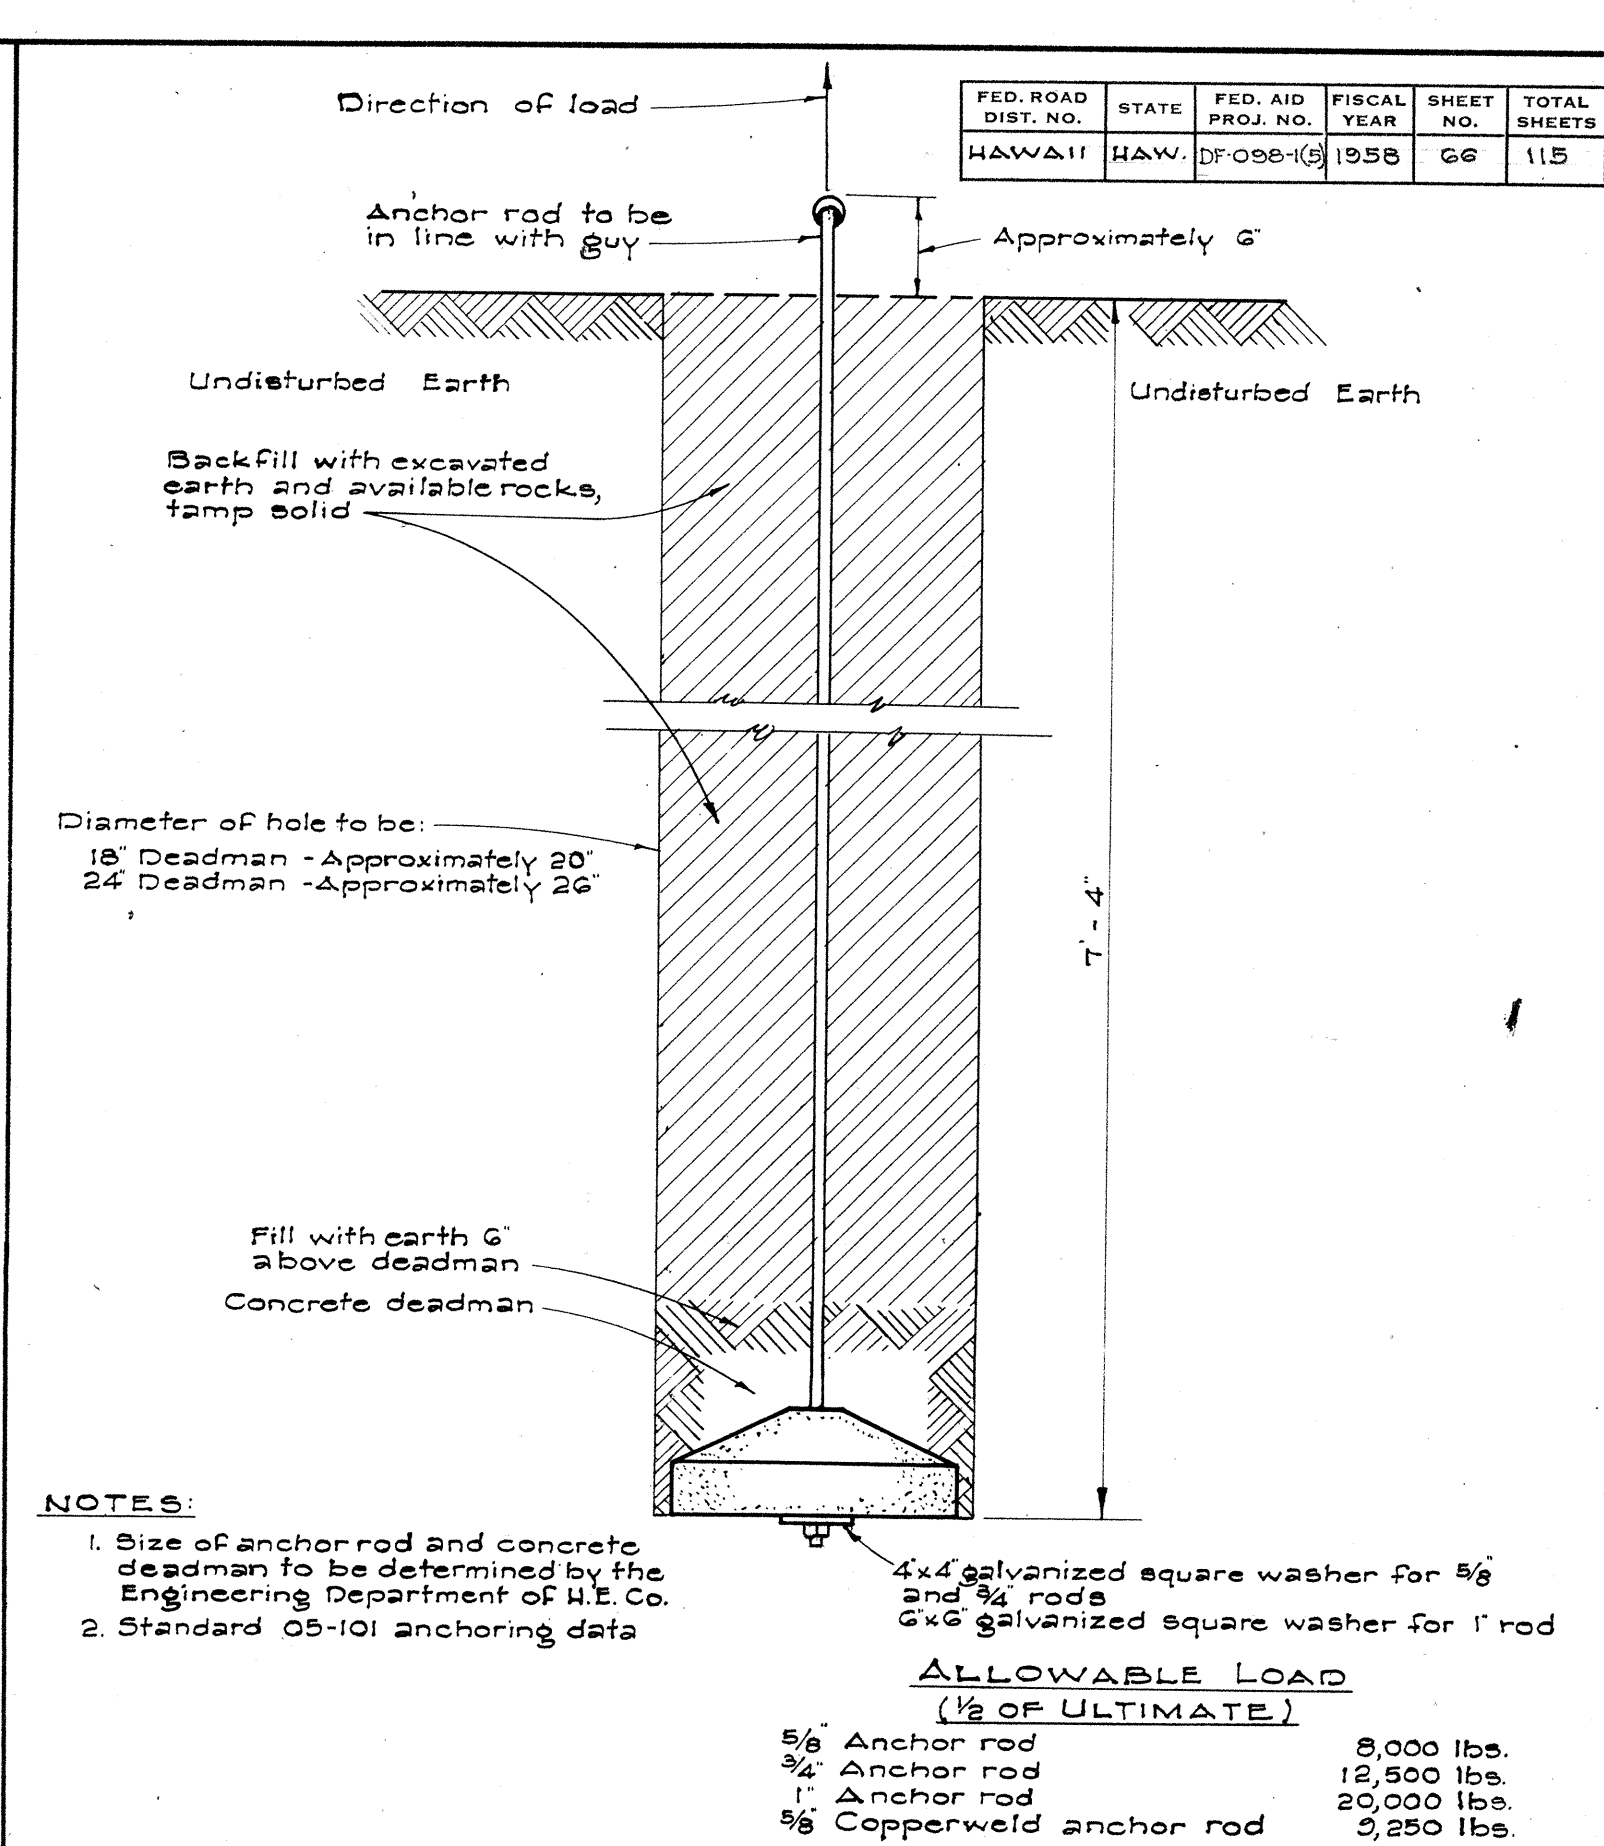


ALLOWABLE LOAD (1/2 OF ULTIMATE)

5/8" Anchor rod	8,000 lbs.
3/4" Anchor rod	12,500 lbs.
1" Anchor rod	20,000 lbs.
5/8" Copperweld anchor rod	9,250 lbs.

SIDE-WALK ANCHOR

Scale: 1" = 1' - 0"

05-104

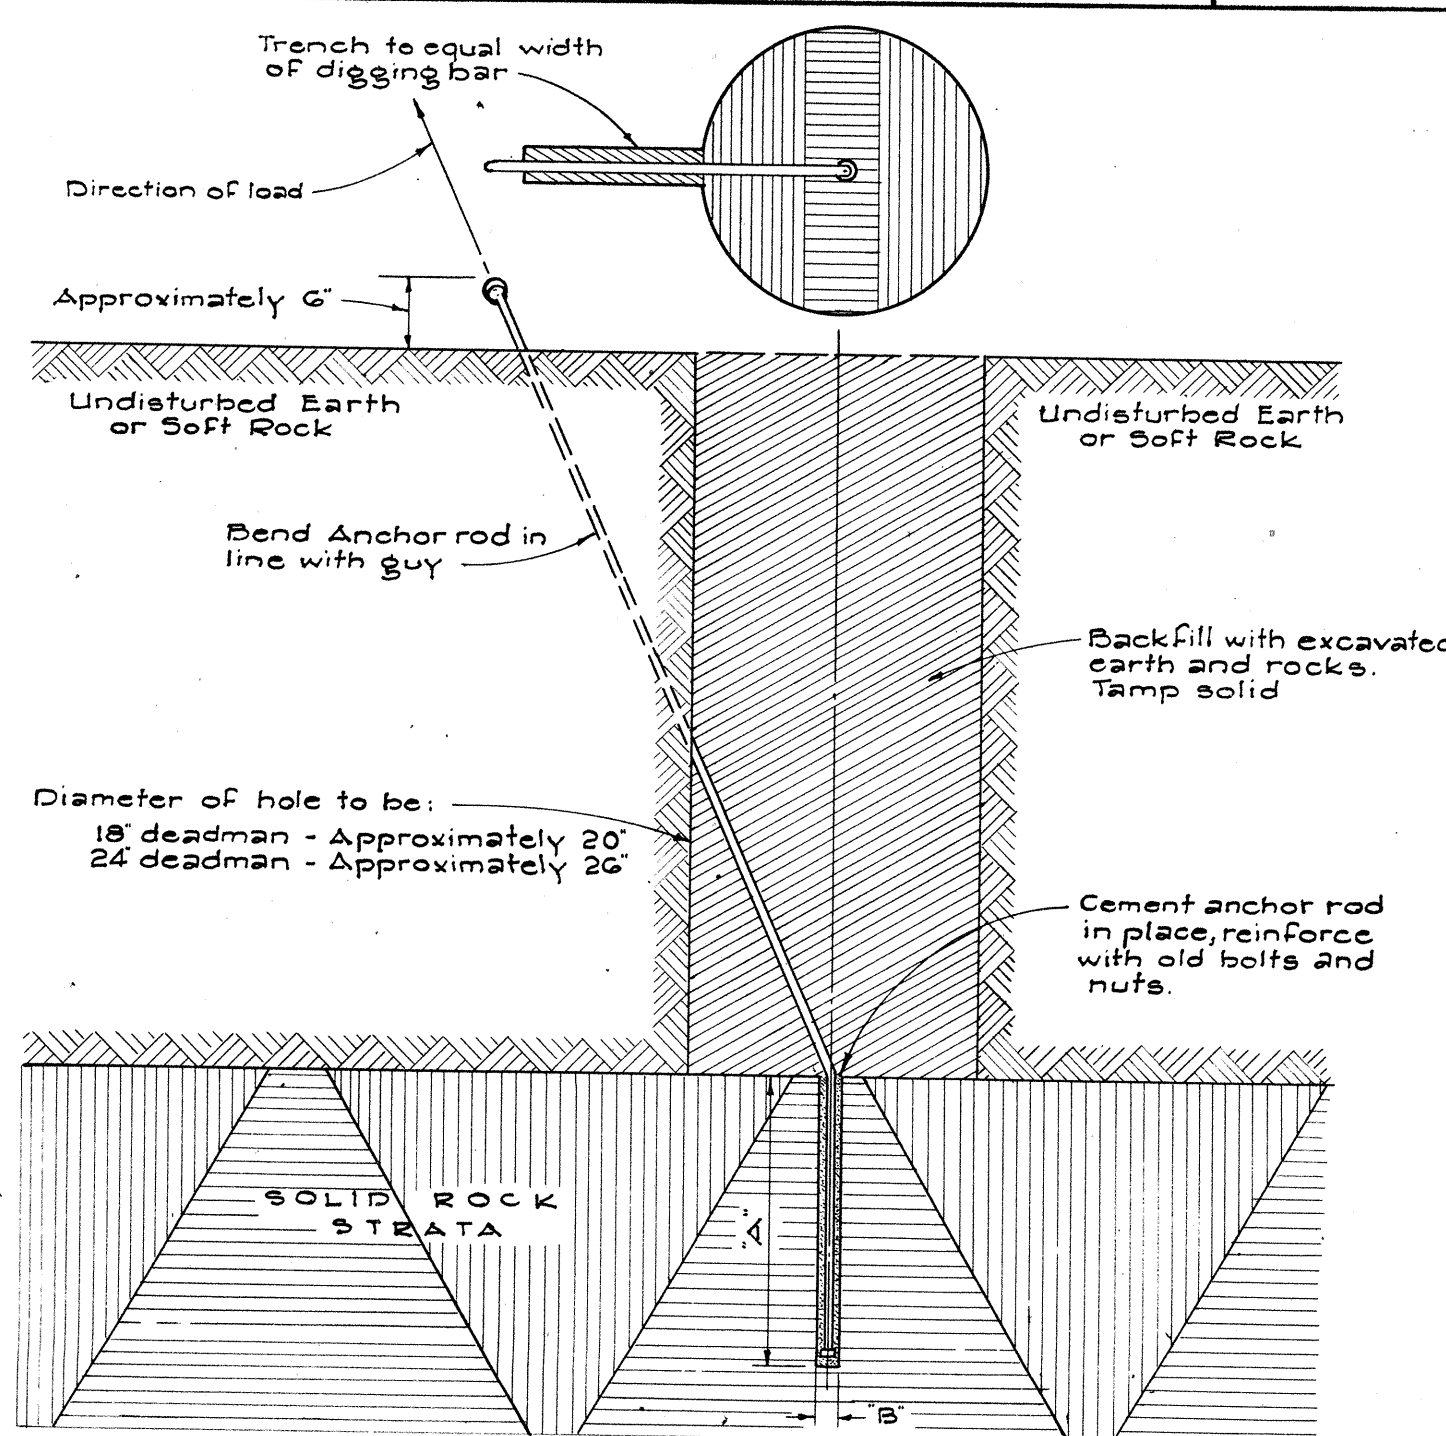


ALLOWABLE LOAD (1/2 OF ULTIMATE)

5/8" anchor rod	8,000 lbs.
3/4" anchor rod	12,500 lbs.
1" anchor rod	20,000 lbs.

ROCK ANCHOR

Scale: 3/4" = 1' - 0"

05-105

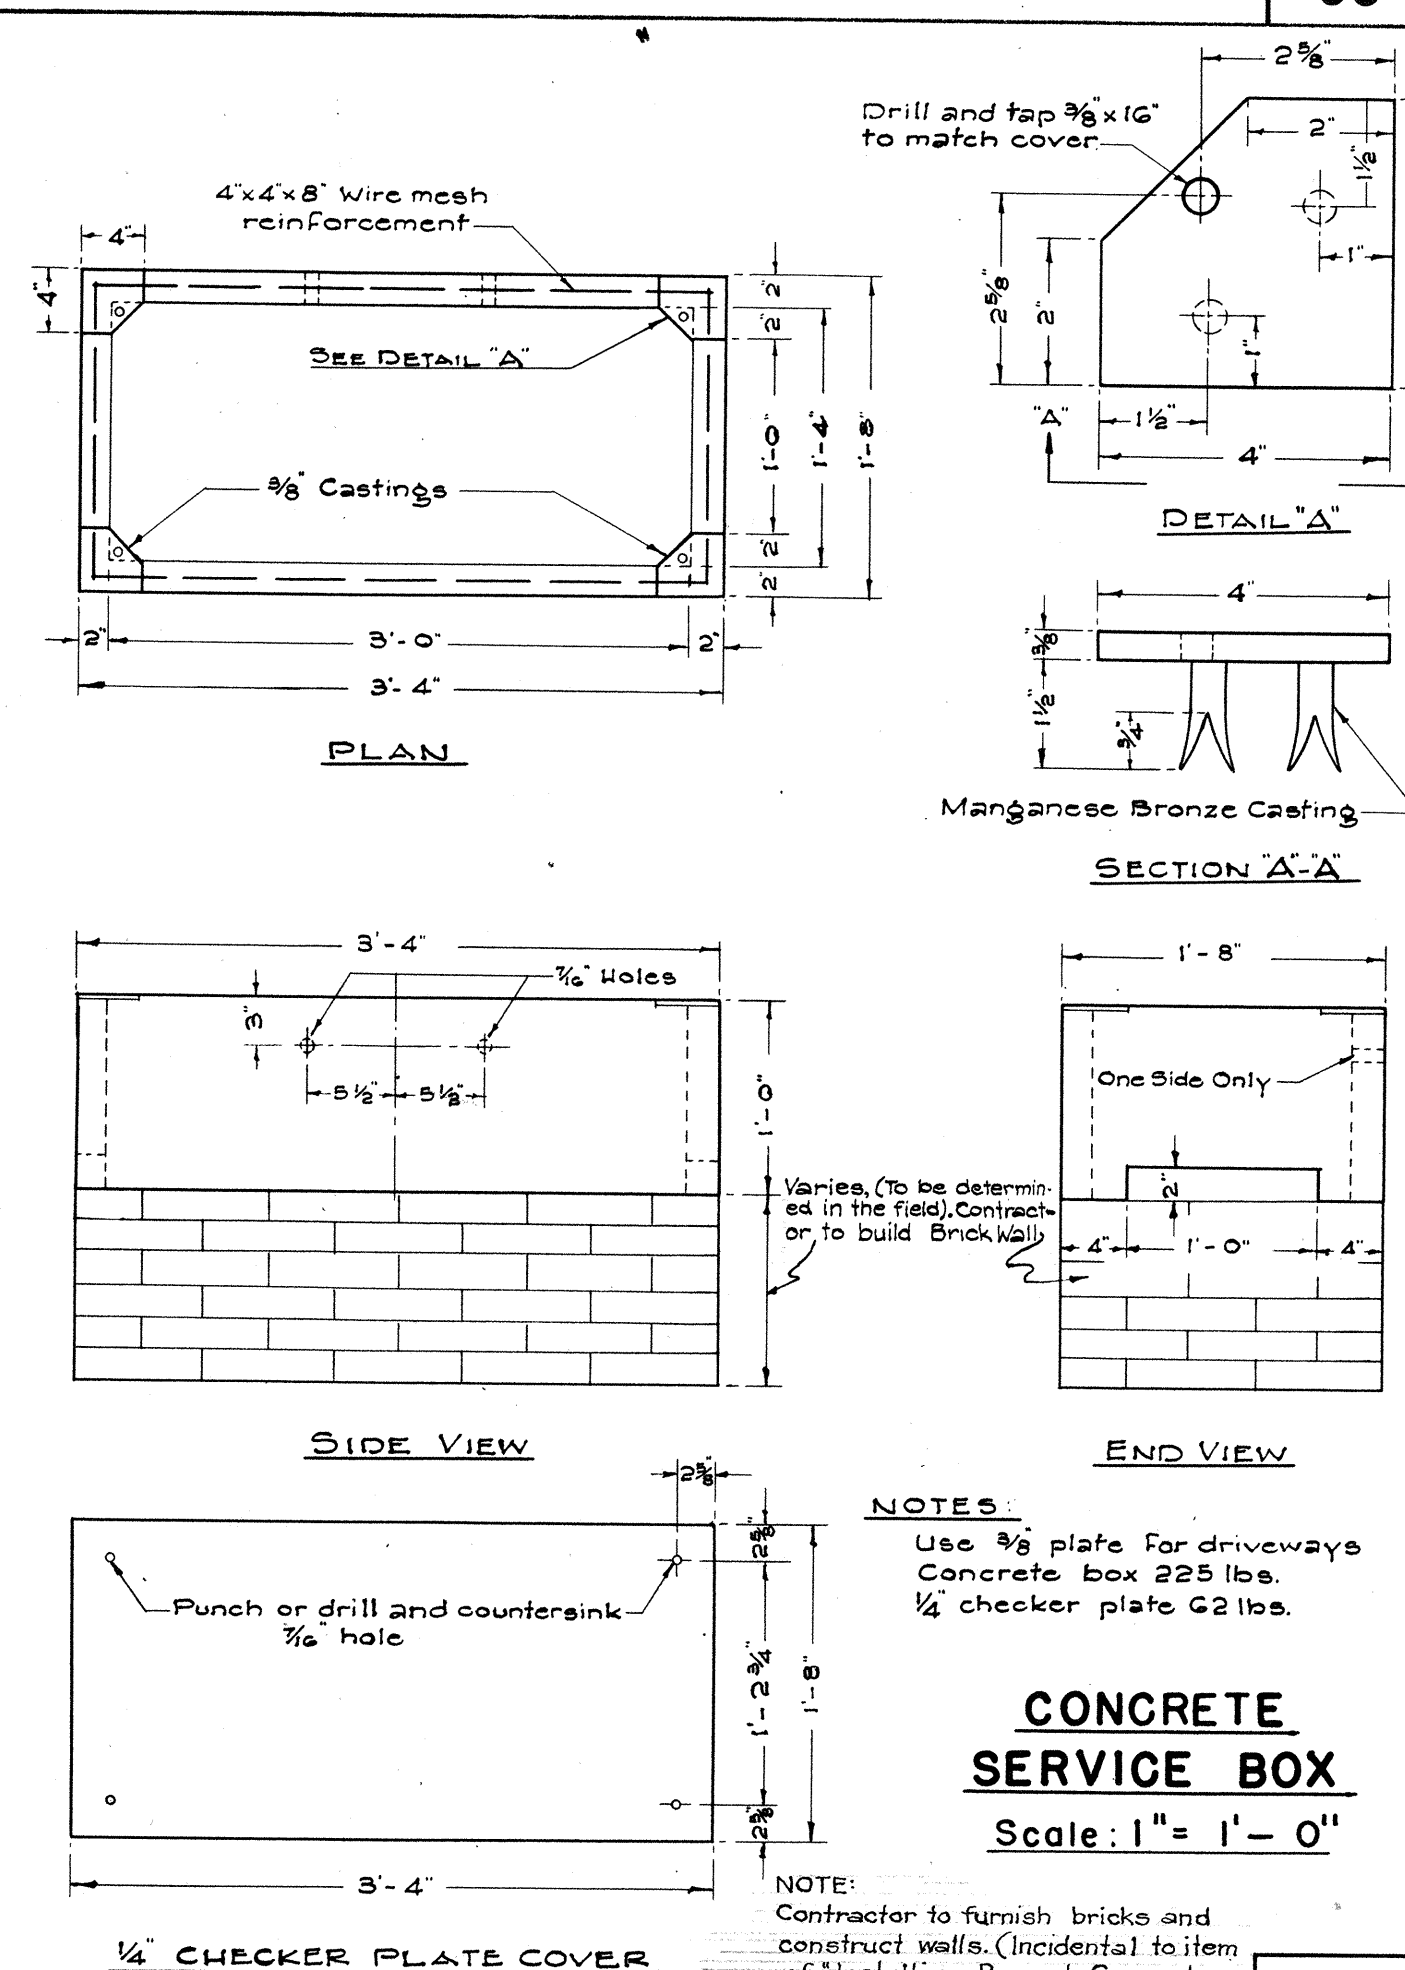

CONCRETE SERVICE BOX

Scale: 1" = 1' - 0"

UI-103

SOUTHERN PINE & DOUGLAS FIR 8lb. CREOSOTED TREATMENT											
LENGTH IN FEET	CLASS	APPROXIMATE MINIMUM DIMENSIONS — INCHES				AVERAGE WEIGHT IN POUNDS		POLE SETTING DEPTH		BREAKING LOAD 2'-0" BELOW TOP	
		AT TOP		6'0" FROM BUTT				DEPTH IN SOIL	DEPTH IN ROCK		
		DIA.	CIR.	DIA.	CIR.						
JOINT POLES (J.P. POLES)											
25	5	6.05	19	8.28	26.0	491	525	4'-6"	3'-0"	1,900	
30	5	6.05	19	8.92	28.0	660	600	5'-0"	3'-0"	1,900	
35	5	6.05	19	9.55	30.0	862	770	5'-0"	3'-6"	1,900	
40	3	7.32	23	11.79	37.0	1403	1320	5'-6"	3'-6"	3,000	
45	3	7.32	23	12.26	38.5	1664	1575	6'-0"	4'-0"	3,000	
50	3	7.32	23	12.73	40.0	1925	1850	6'-6"	4'-0"	3,000	
55	3	7.32	23	13.23	41.5	2200	2145	7'-0"	4'-6"	3,000	
TRANSMISSION POLES (T POLES)											
45	2	7.96	25	13.23	41.5	1911	1845	6'-0"	4'-0"	3,700	
50	2	7.96	25	13.69	43.0	2214	2150	6'-6"	4'-0"	3,700	
60	1	8.59	27	15.77	49.5	3451	3360	7'-0"	4'-6"	4,500	

S. P. — SOUTHERN YELLOW PINE
D. F. — DOUGLAS FIR

NOTE:


THE ULTIMATE FIBER STRESS FOR CREOSOTED SOUTHERN YELLOW PINE & DOUGLAS FIR IS 7,400 lbs. PER SQUARE INCH.

REFERENCES:

AMERICAN STANDARDS ASSOCIATION 05.4-1941, 05.6-1945
STANDARD HANDBOOK FOR ELECTRICAL ENGINEERS, EIGHTH EDITION
H.E. CO. SPECIFICATIONS FOR POLES.

WOOD POLE DATA

05-501

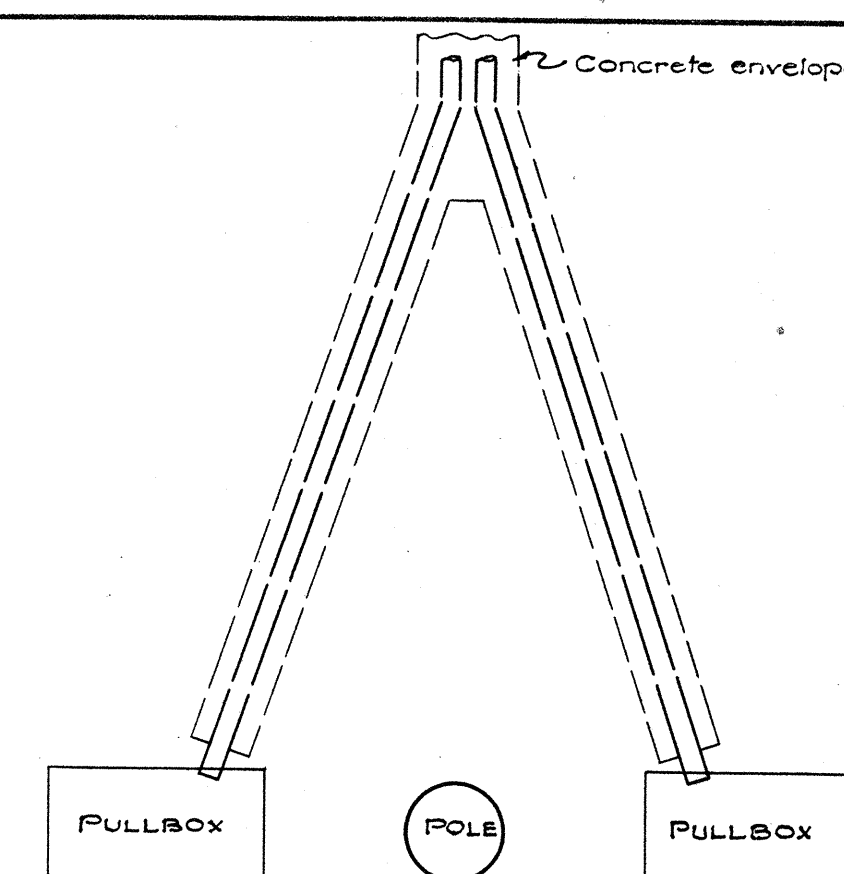

TYPICAL BOX AND DUCT DETAIL

Scale: 3/8" = 1' - 0"

TERRITORIAL HIGHWAY DEPARTMENT
TERRITORY OF HAWAII
HAWAIIAN ELECTRIC &
HAWAIIAN TELEPHONE

STANDARD DETAILS

VINEYARD THOROUGHFARE

PALAMA ST. TO FORT ST.


PROJECT NO. DP-098-1(5)

Scale: As Noted Oct. 17, 1957

SHEET NO. 1 OF SHEETS

5882.66

FINAL SURVEY	SURVEYED	BY	DATE
NOTE BOOK	PLOTTED		
	TEMPLATE		
	AREAS		
NO.	AREAS CHECKED		

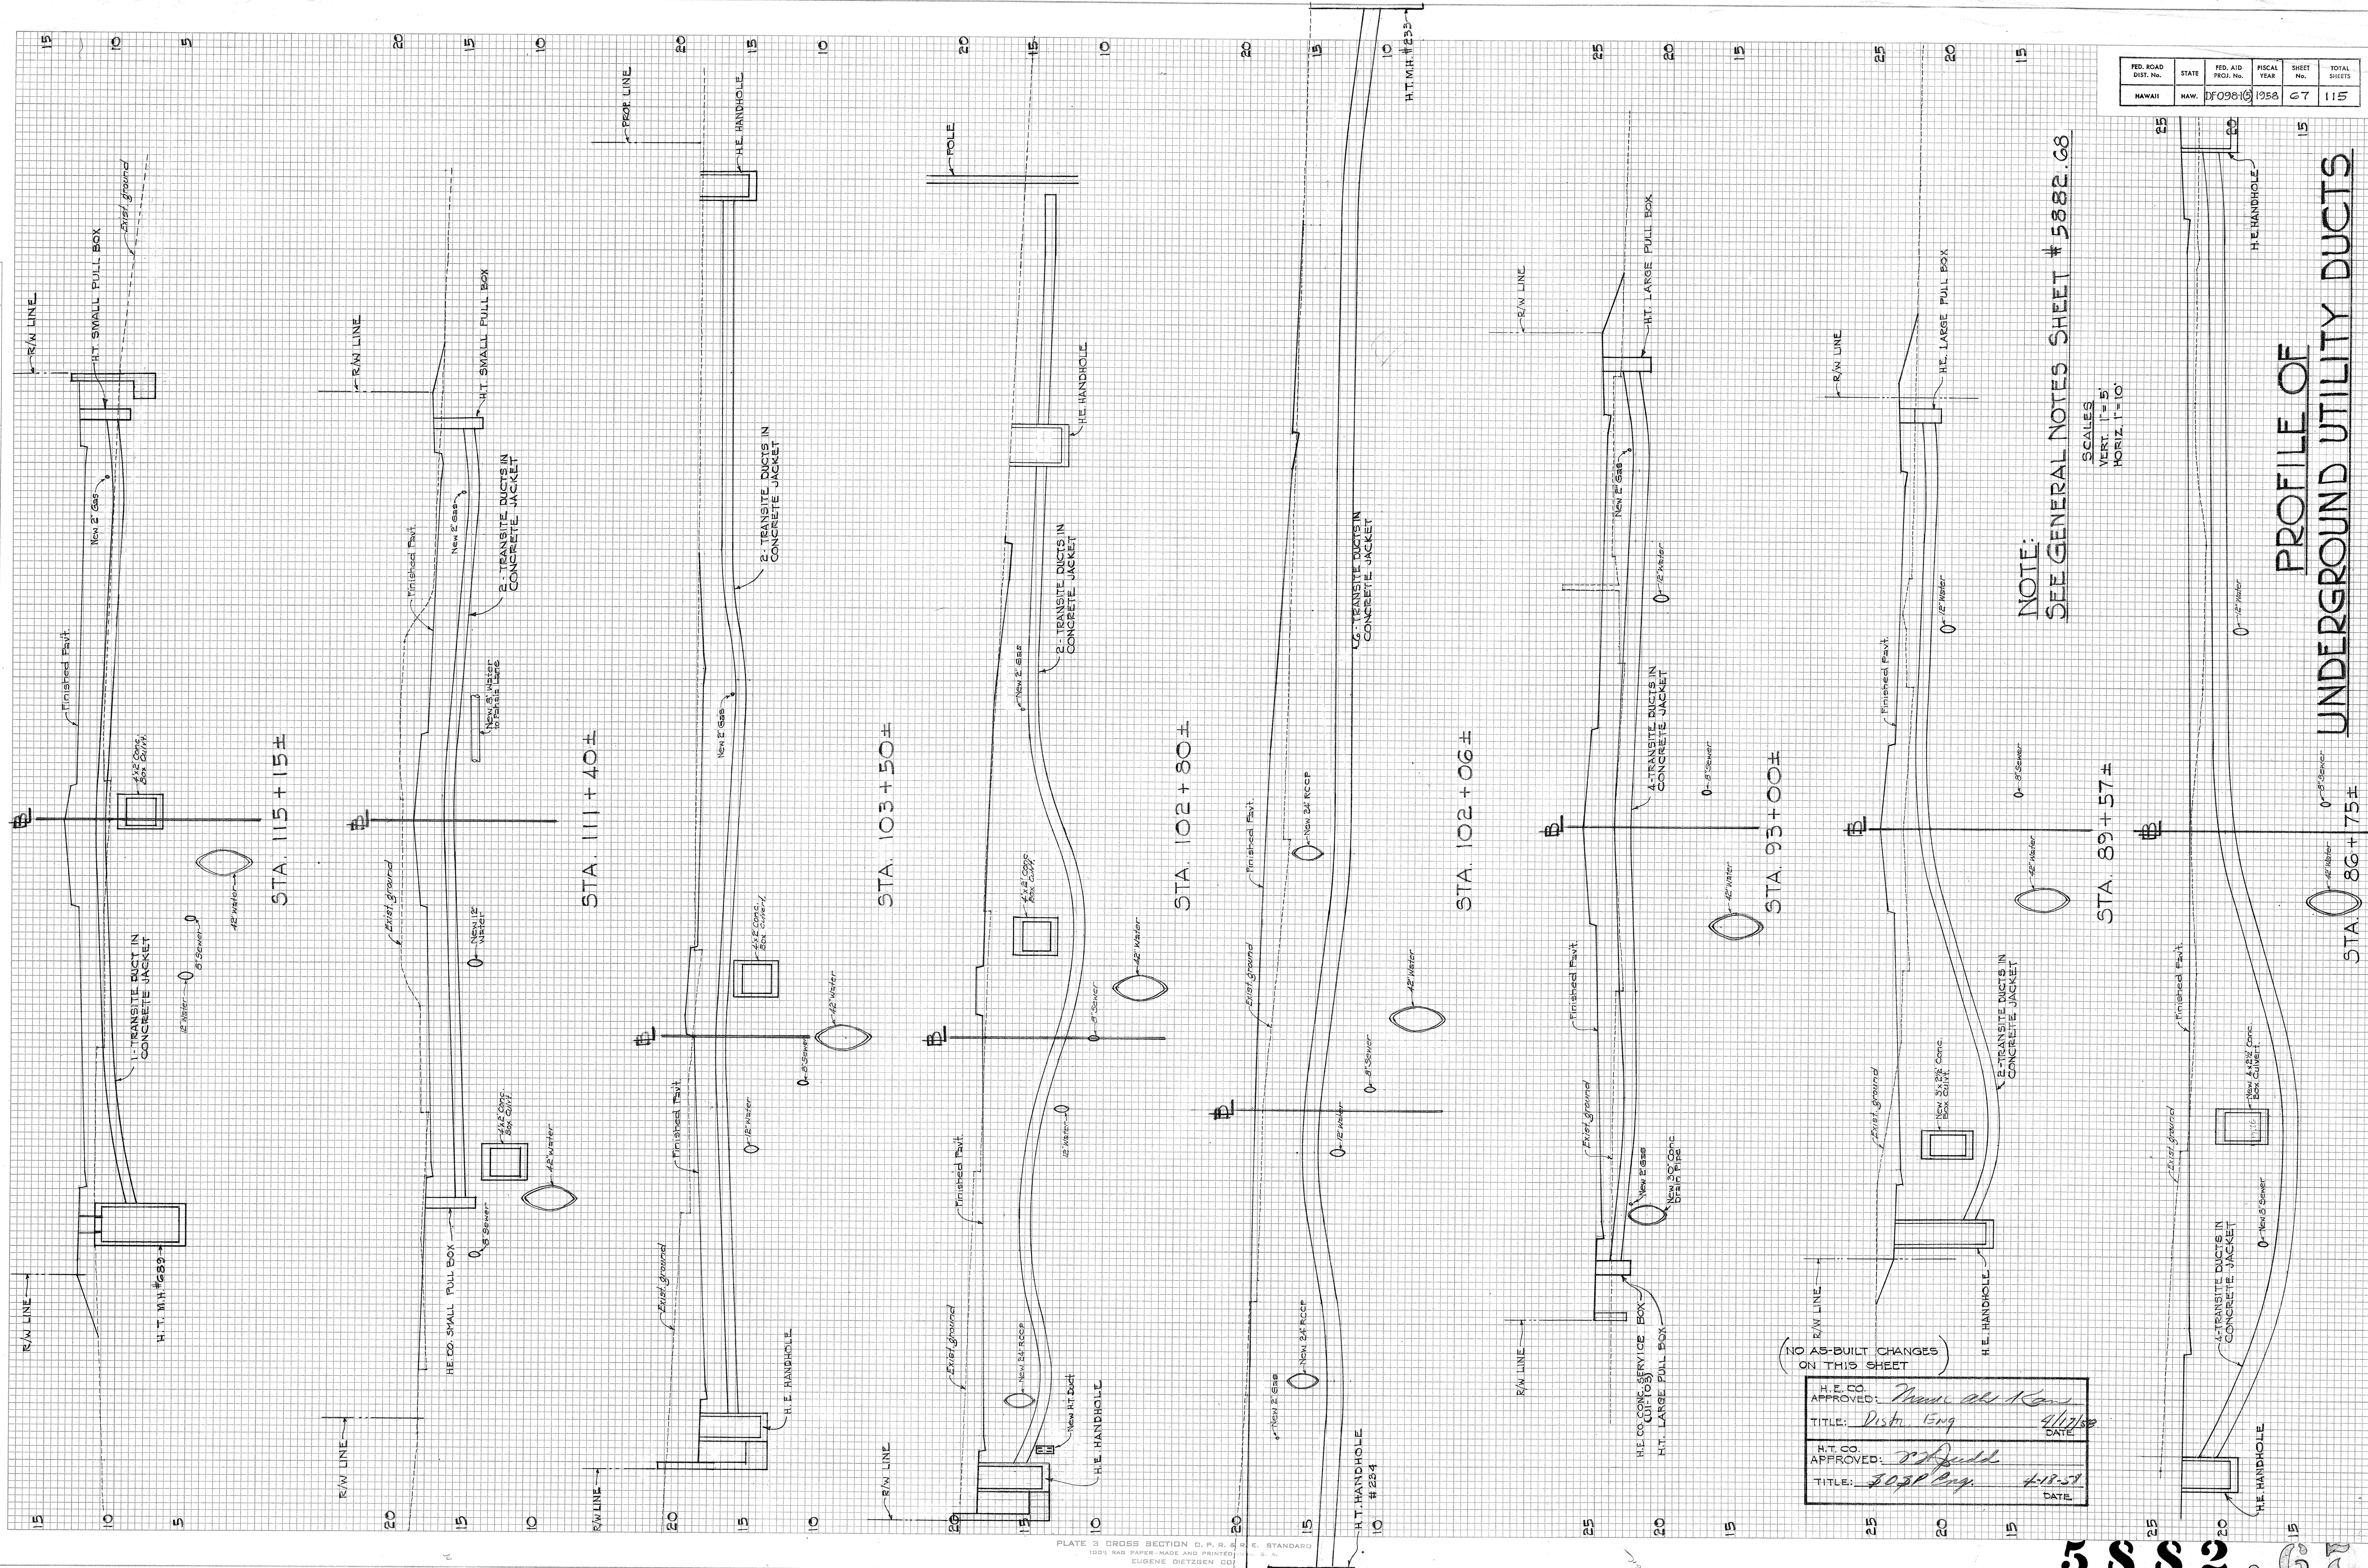

FED. ROAD DIST. No.	STATE	FED. AID PROJ. No.	FISCAL YEAR	SHEET No.	TOTAL SHEETS
HAWAII	HAW.	DF098-15	1958	67	115

PROFILE OF UNDERGROUND UTILITY DUCTS

