




FED. ROAD DIST. NO.	STATE	FED. AID PROJ. NO.	FISCAL YEAR	SHEET NO.	TOTAL SHEETS
HAWAII	HAW.	U-072-1(3)	1965	38	246
		U-098-1(4)	1965	10	88

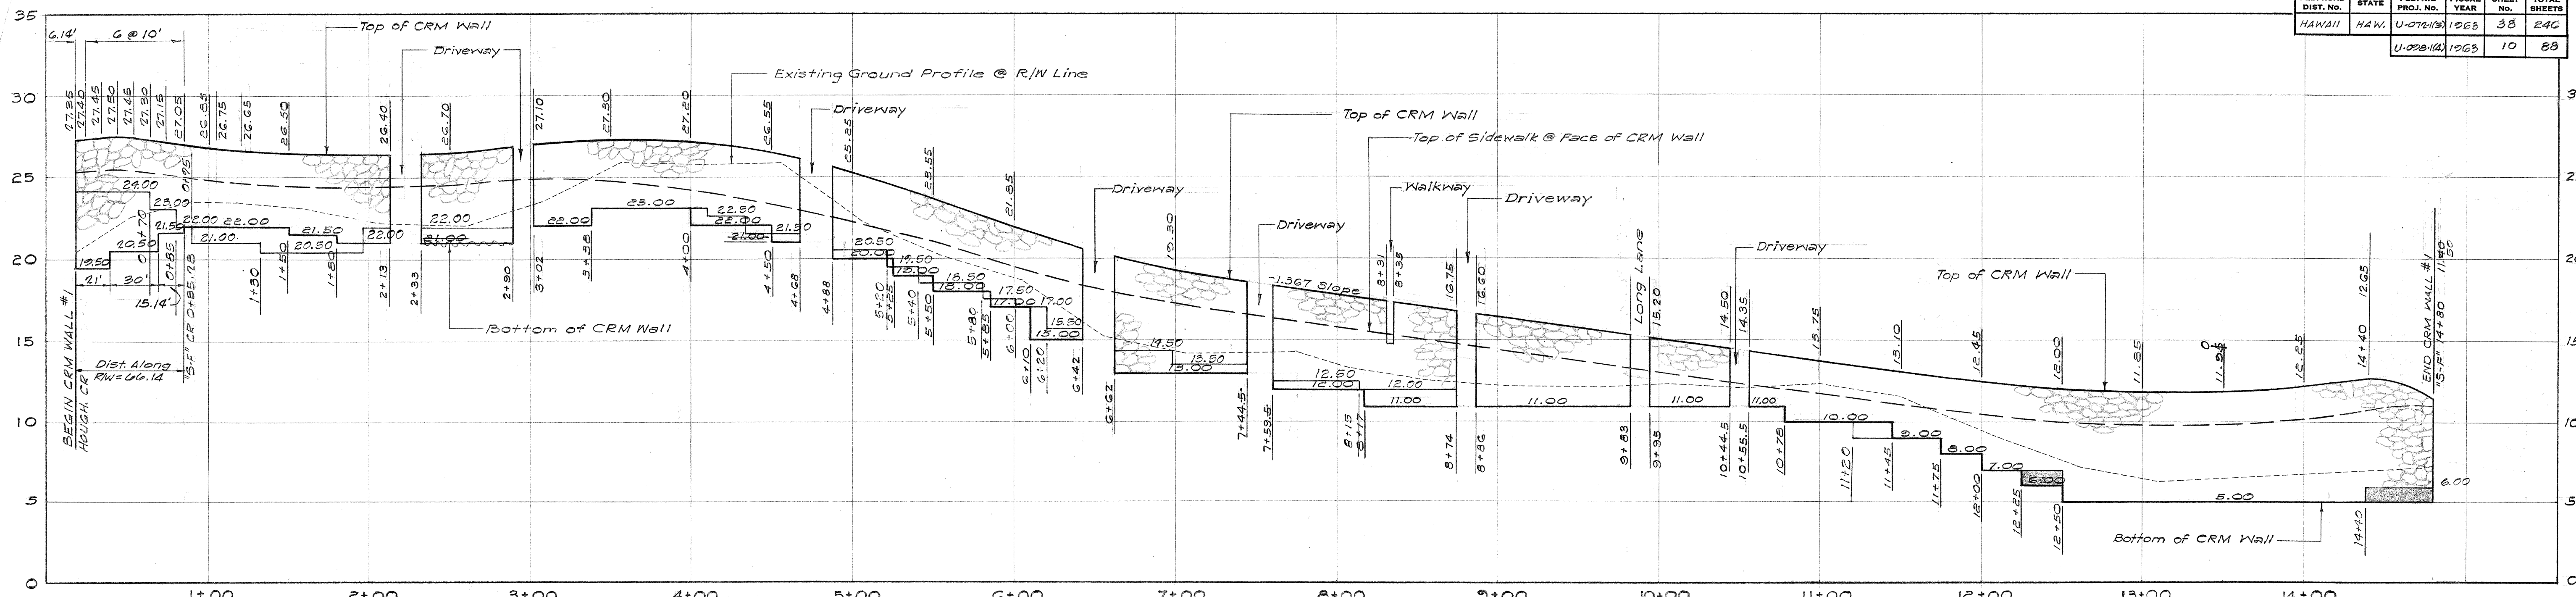


PROFILE - CRM RET. WALL #1 (SOUTH FRONTAGE)
 Scales: Hor. 1" = 50'
 Vert. 1" = 5'

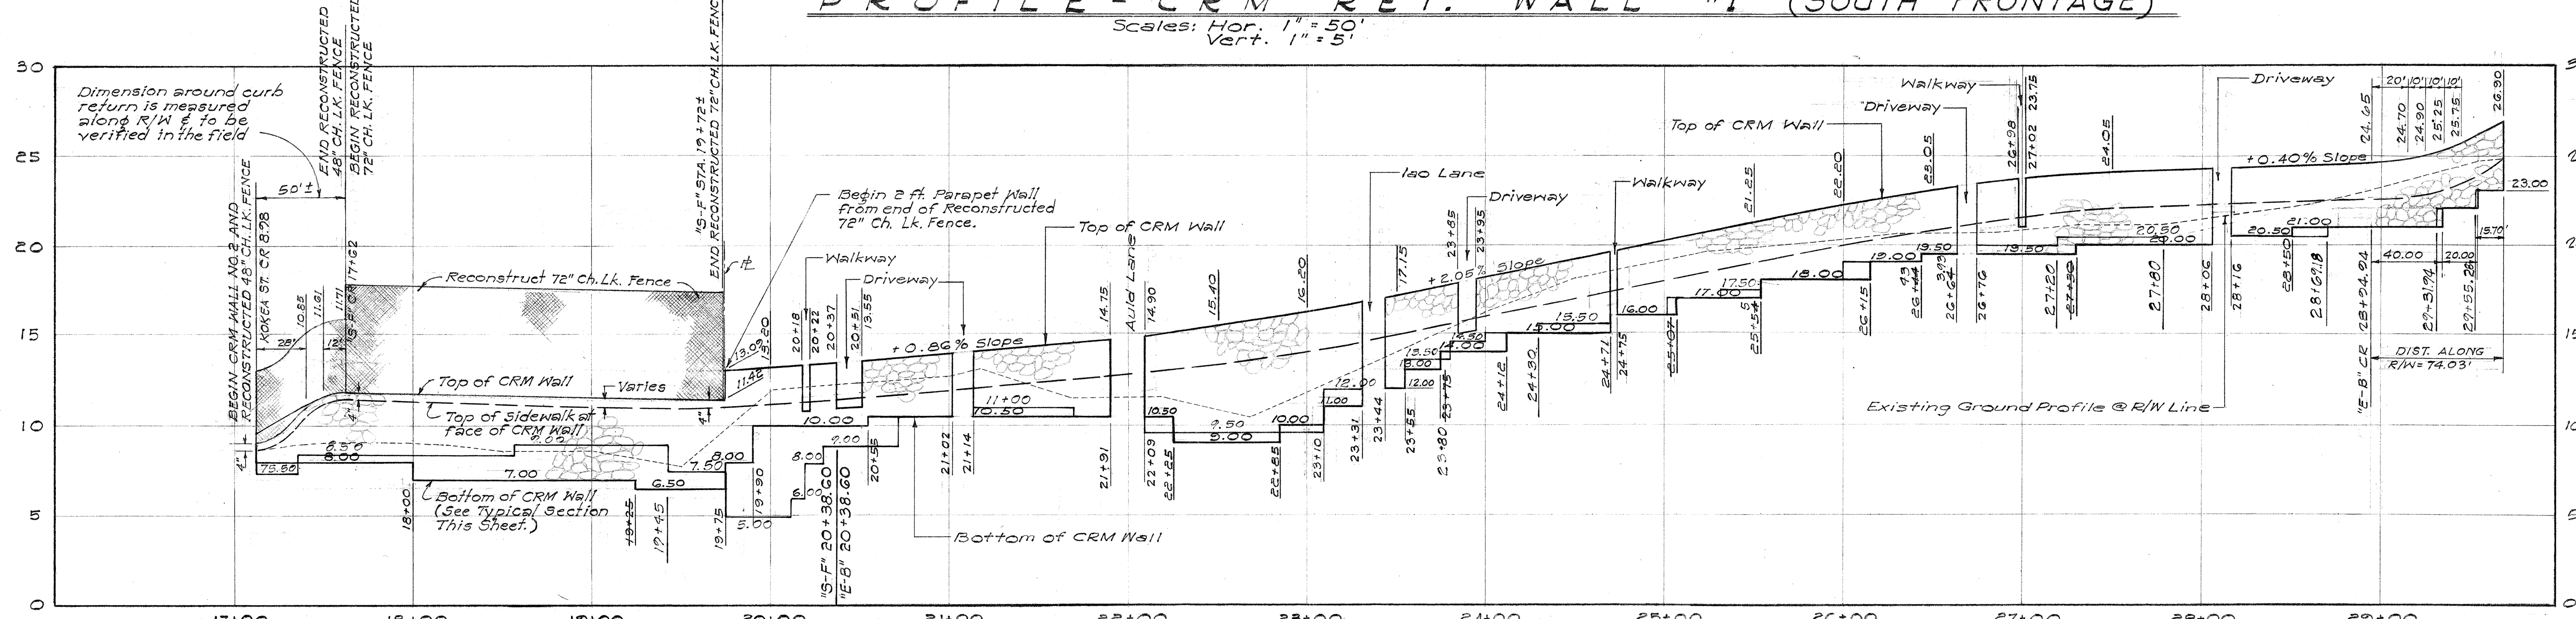

PROFILE - CRM RET. WALL #2 (SOUTH FRONTAGE AND VINEYARD BLVD.-EAST BOUND LANES)
 Scales: Hor. 1" = 50'
 Vert. 1" = 5'

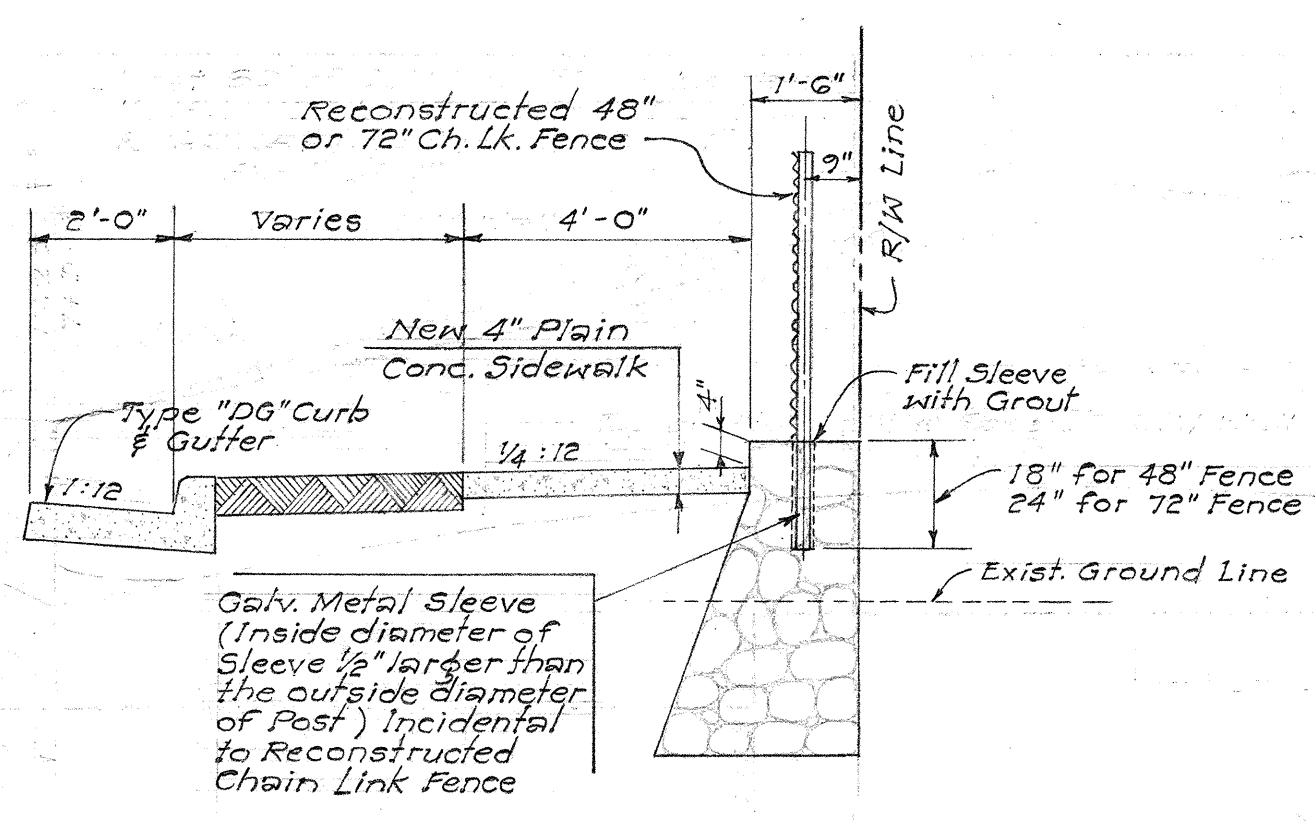

TYPICAL SECTION ~ CRM WALL NO. 2
 FROM BEG. WALL TO "S-F" STA. 19+72±
 SCALE: 3/8" = 1'-0"

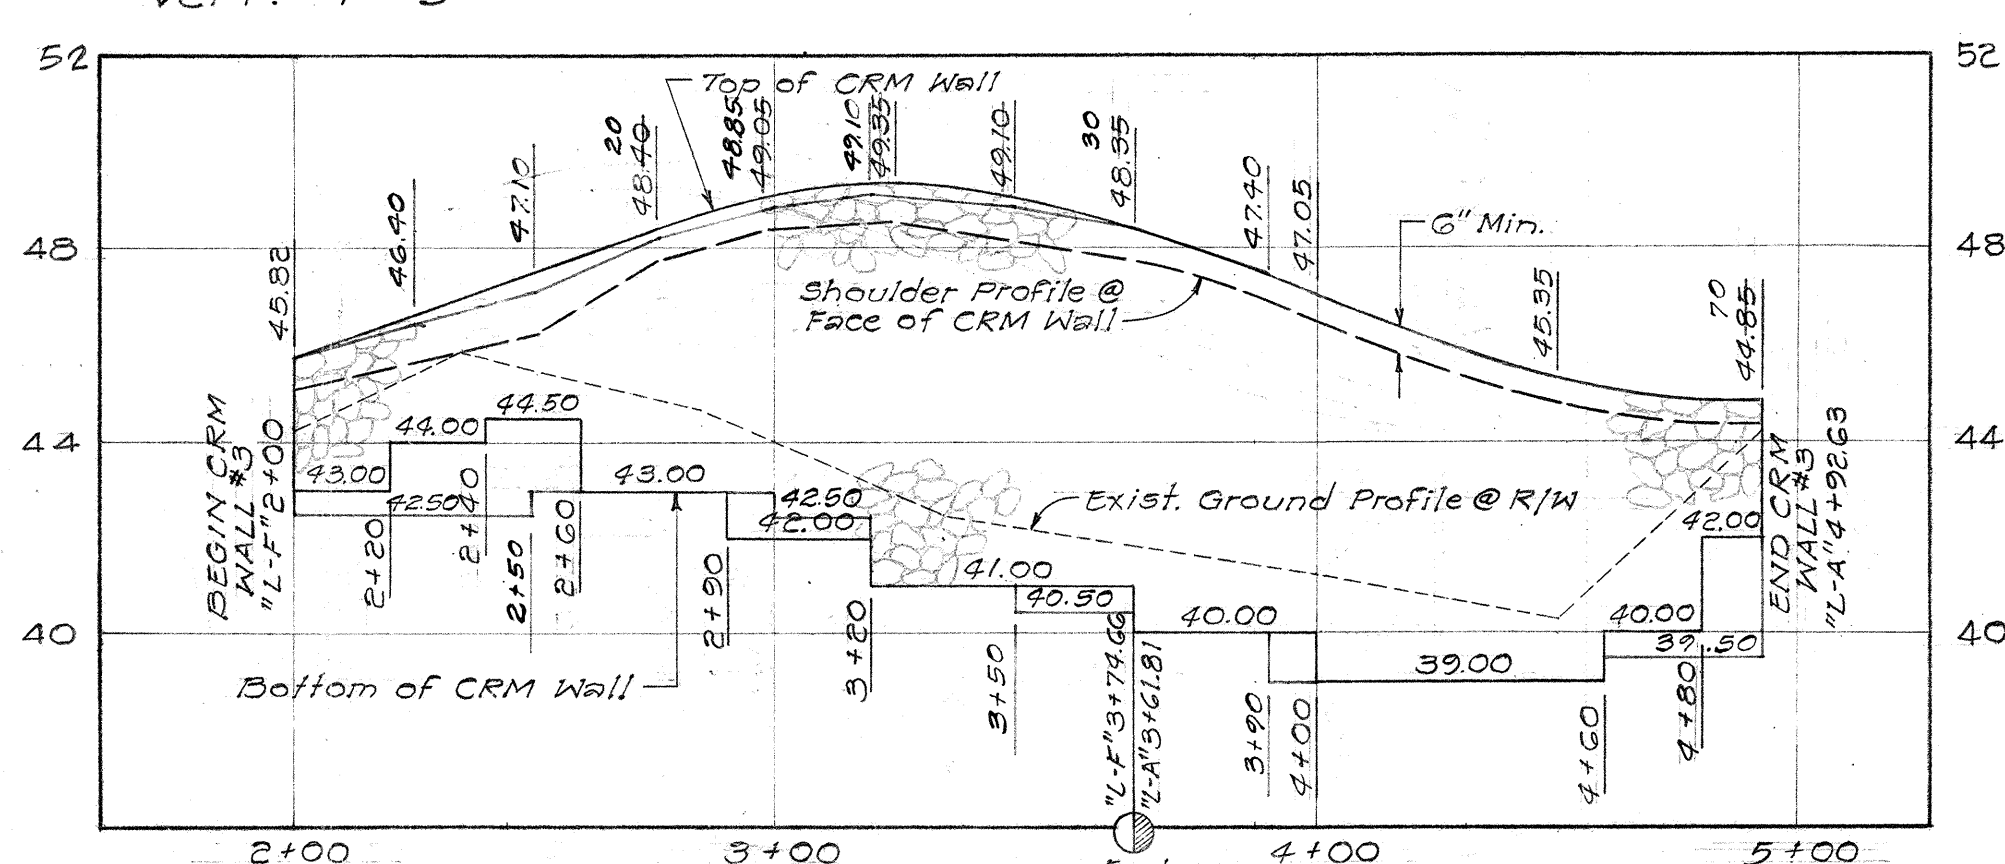

PROFILE - CRM RET. WALL #3
 (LILIHA FRONTAGE AND LILIHA ACCESS ROAD)
 Scales: Hor. 1" = 40'
 Vert. 1" = 4'

NOTE:
 Dimensions & stations of driveways & all ground profile to be verified in the field. Contractor to make adjustments wherever necessary as directed by the Engineer.

DEPARTMENT OF TRANSPORTATION
 HIGHWAYS DIVISION
 STATE OF HAWAII

ROADWAY DETAILS
 PROFILE - CRM WALL #1, #2, #3

LUNALILO FREEWAY
 VINEYARD BOULEVARD

U-072-1(3)
 U-098-1(4)

SURVEY PLOTTED BY	DATE
DRAWN BY	
CHECKED BY	
NOTED BY	
NO.	

U09810400.10

U07210300.38