

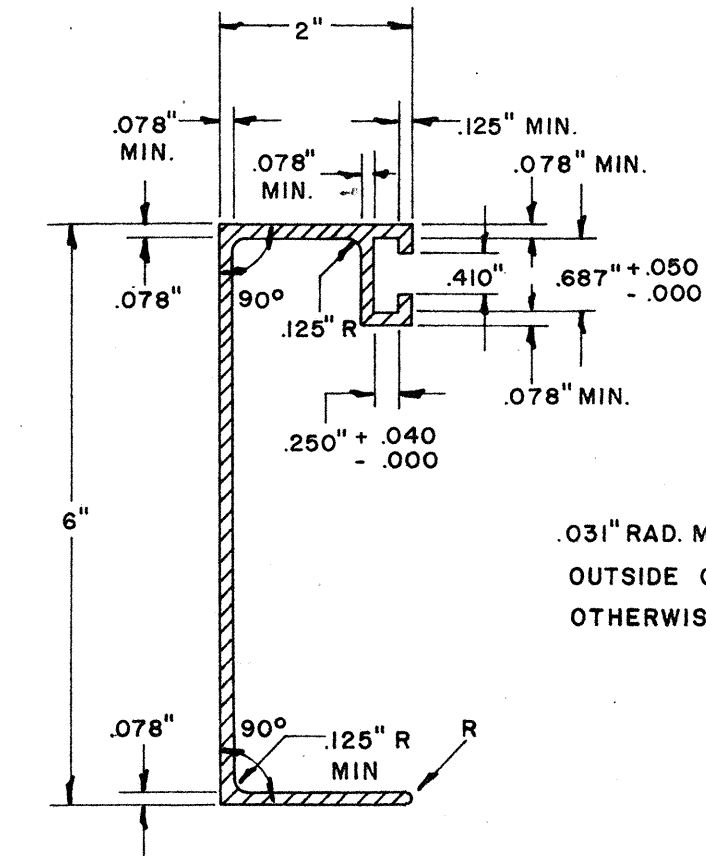
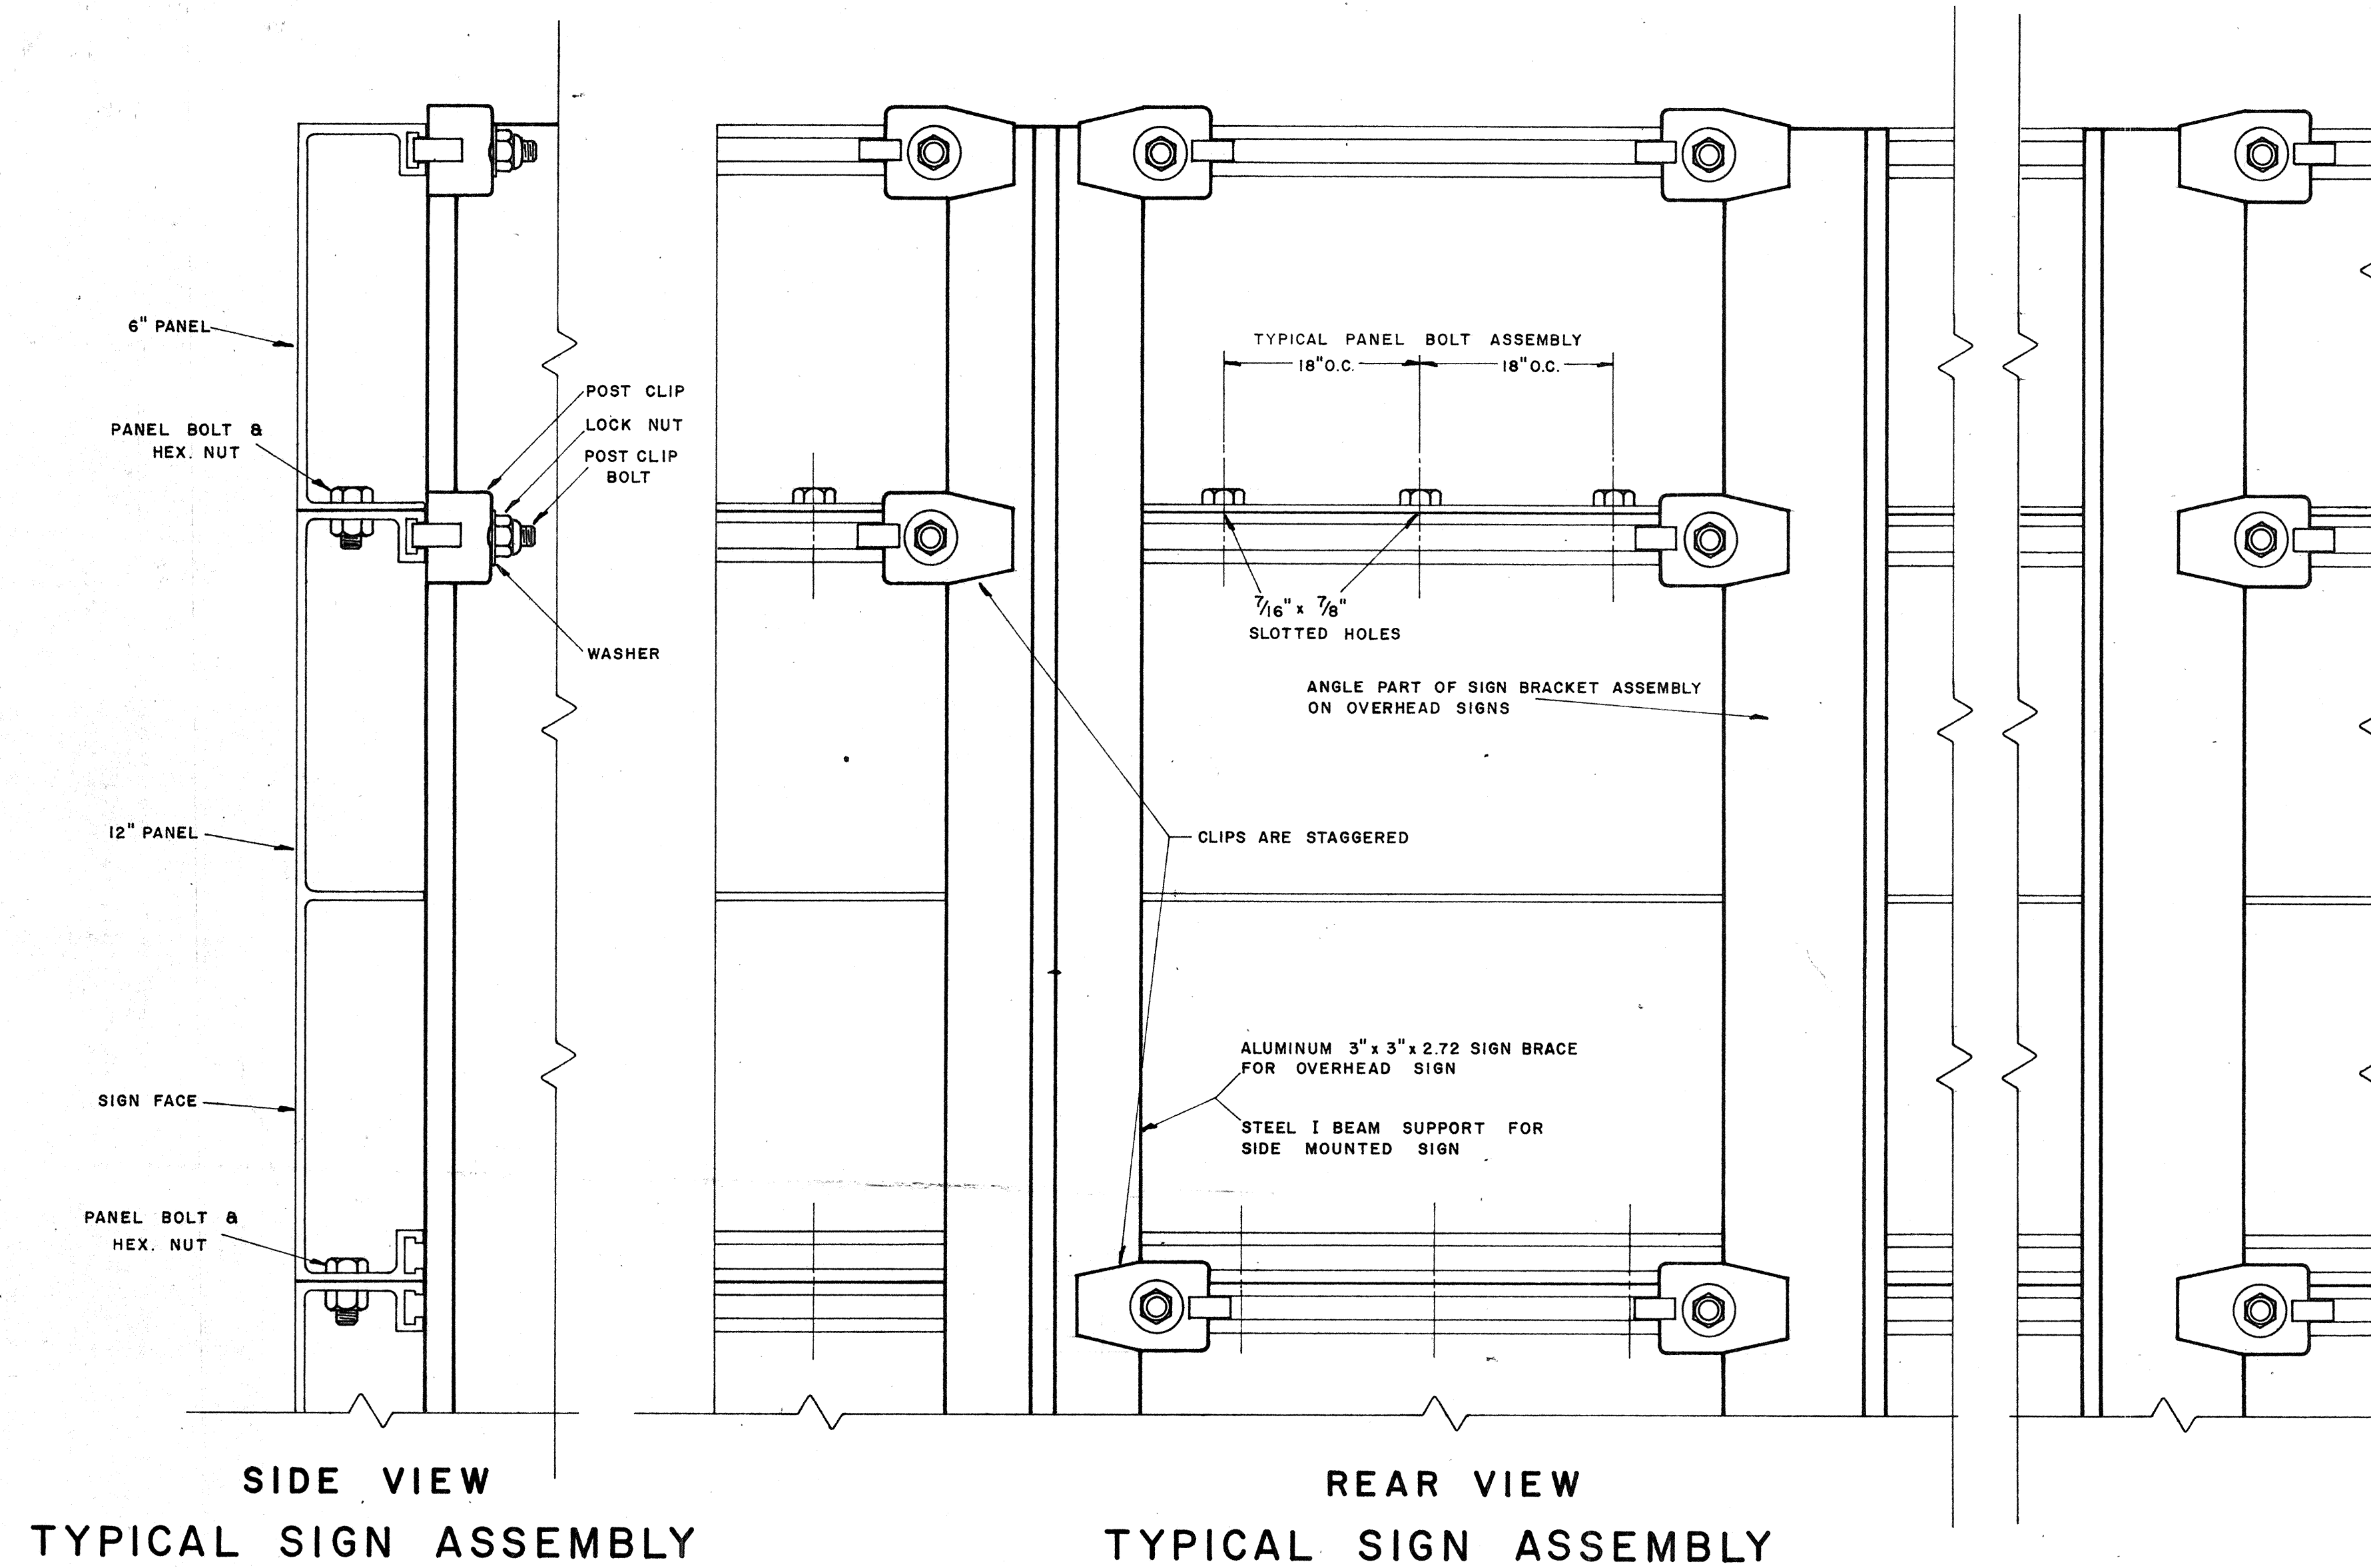
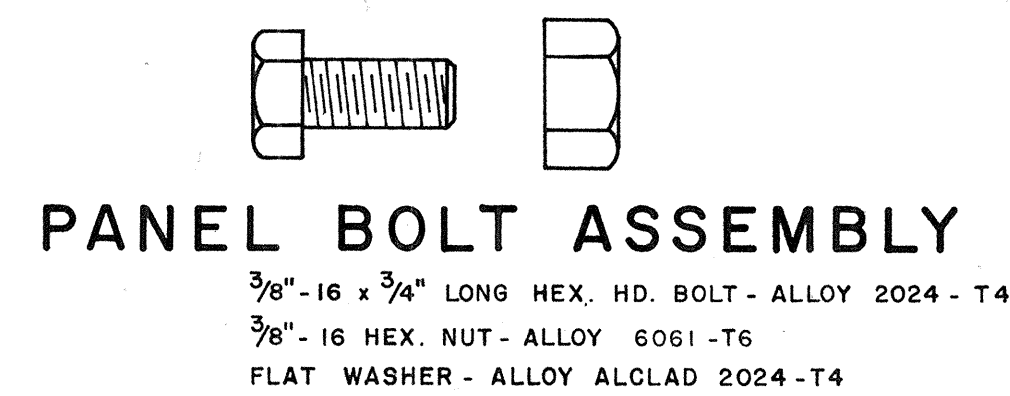
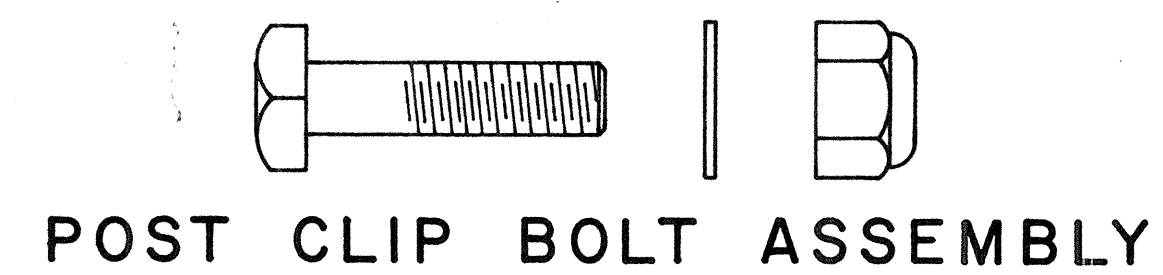


FED. ROAD DIST. NO.	STATE	FED. AID PROJ. NO.	FISCAL YEAR	SHEET NO.	TOTAL SHEETS
HAWAII	HAW	U-072-1(5)	1963	149	246
		U-072-1(4)	1963	65	58

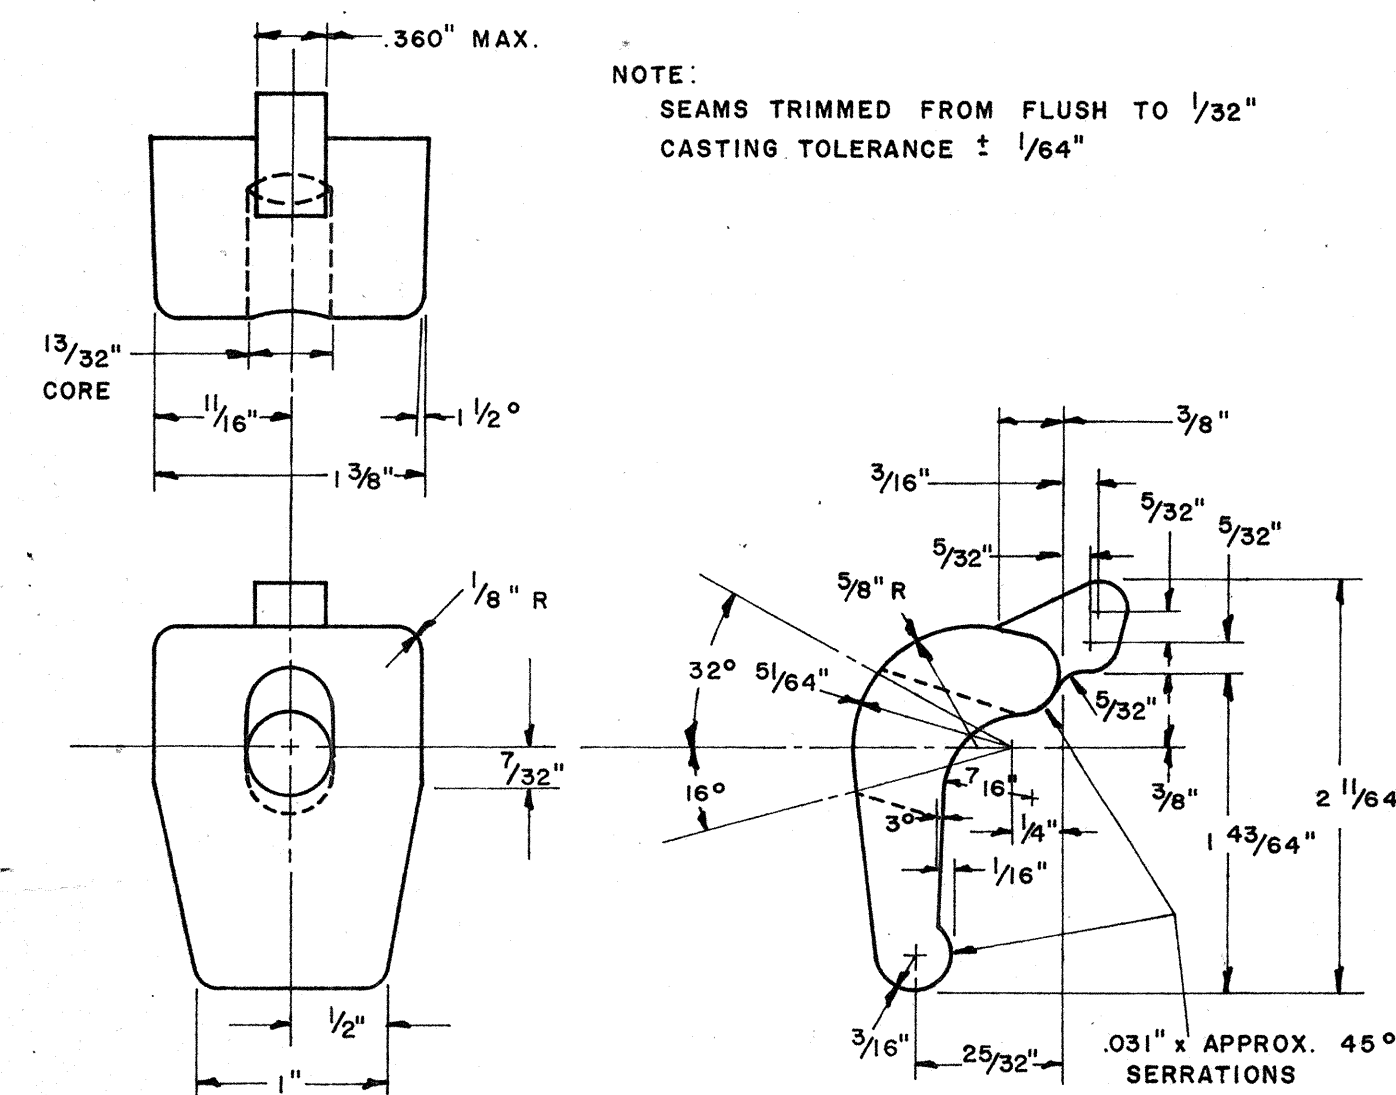

SOLID EXTRUDED SIGN PANEL DETAILS

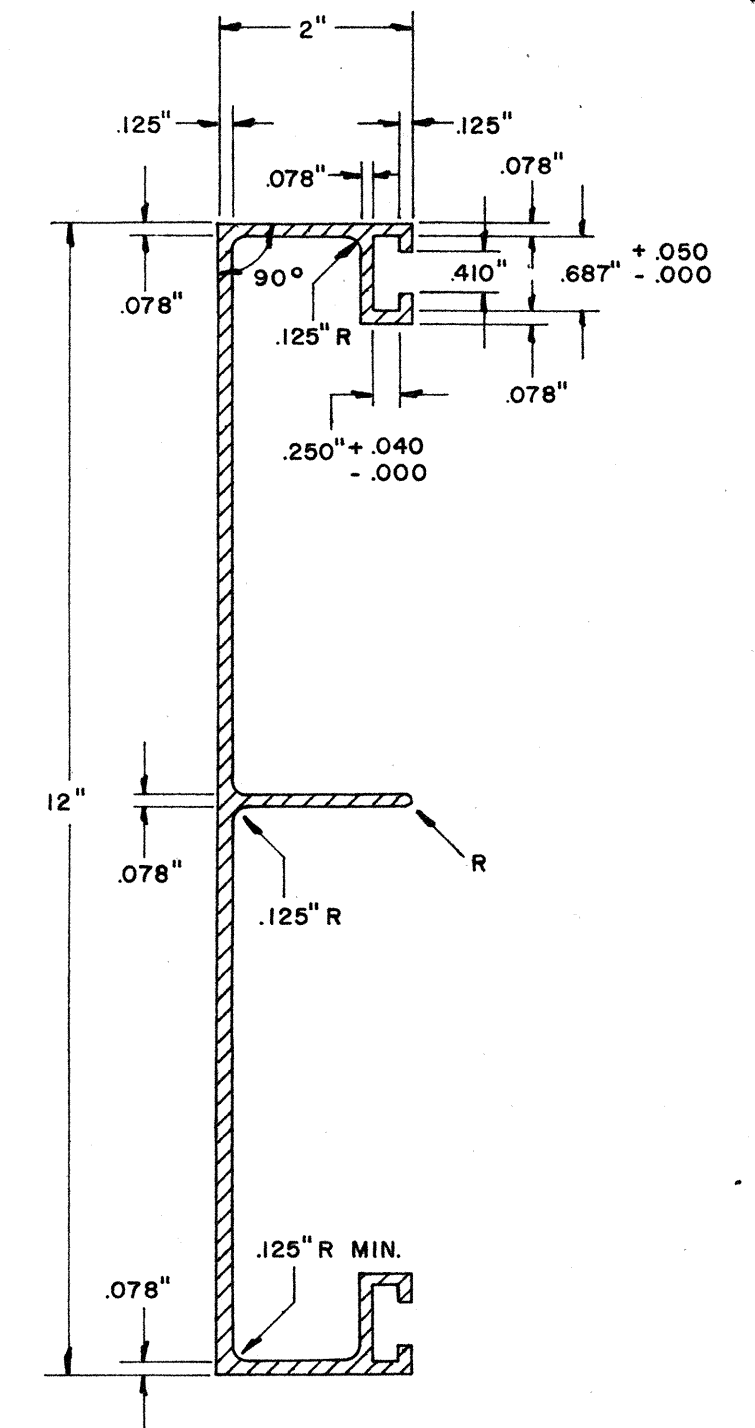

NOTE: Extruded Aluminum Panels shall be used for Destination ~~and~~ signonly. ~~Expressway signs~~

See Previous Sheet for Changes

STATE OF HAWAII DEPARTMENT OF TRANSPORTATION HIGHWAYS DIVISION DETAILS OF SOLID ALUMINUM EXTRUDED SIGN PANEL AND ACCESSORY DETAILS NO SCALE
--

SHEET NO. 6 OF 10 SHEETS

U09810400.65

U07210300.149