

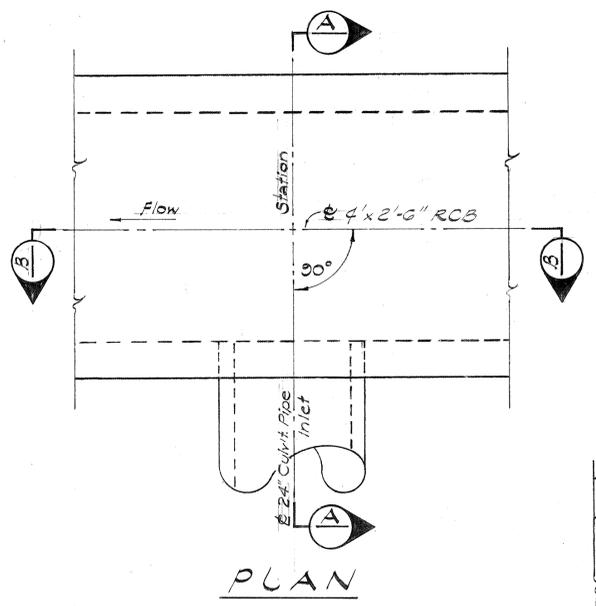


FED. ROAD DIST. No.	STATE	FED. AID PROJ. No.	FISCAL YEAR	SHEET No.	TOTAL SHEETS
HAWAII	HAW.	U-072(13)	1963	71	240
		U-008-104	1963	26	88

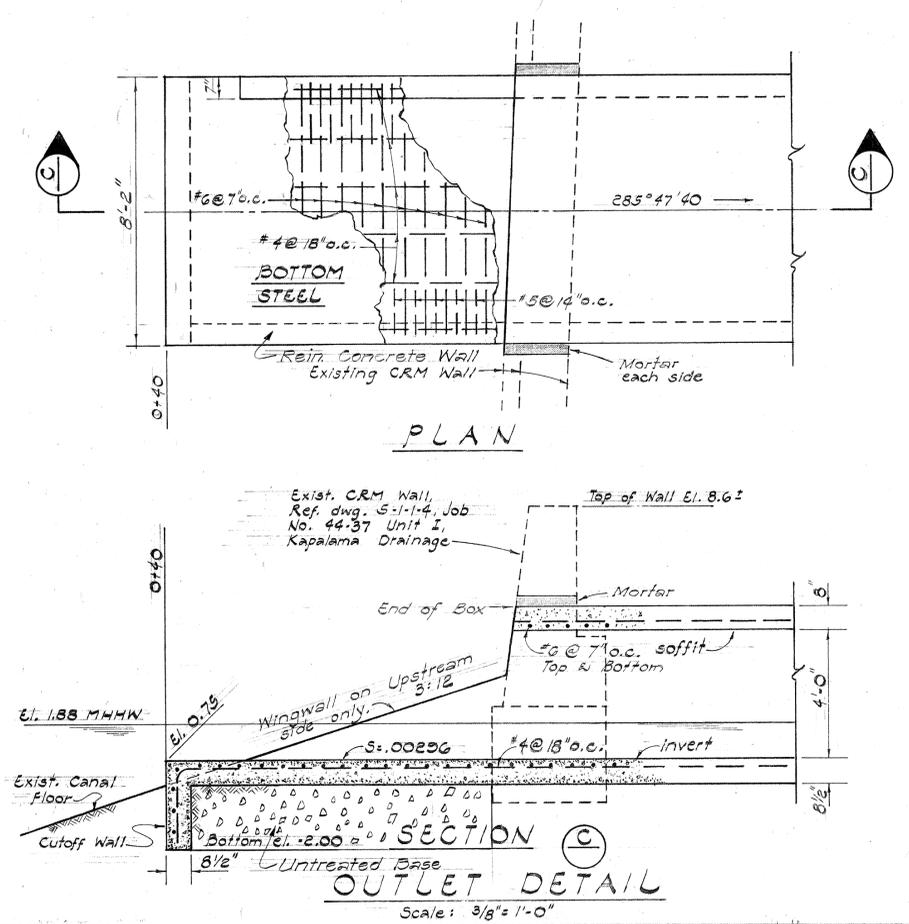

JUNCTION NO.	BOX CULVERT STATION	Fl. El.	Inv. El.	So
4	1+33.19 Rt.	3.72	3.97	.0842
5	1+63.06 Lt.	4.00	4.25	.1047
6	2+27.78 Lt.	4.73	5.00	.1054
7	3+43.37 Lt.	6.09	6.34	.0053
8	8+26.04 Rt.	12.82	13.07	.0839


TYPICAL 24" CULVERT PIPE INLET DETAILS
BOX CULVERT NO. 3
(Box Culvert No. 2 to Palama St.)

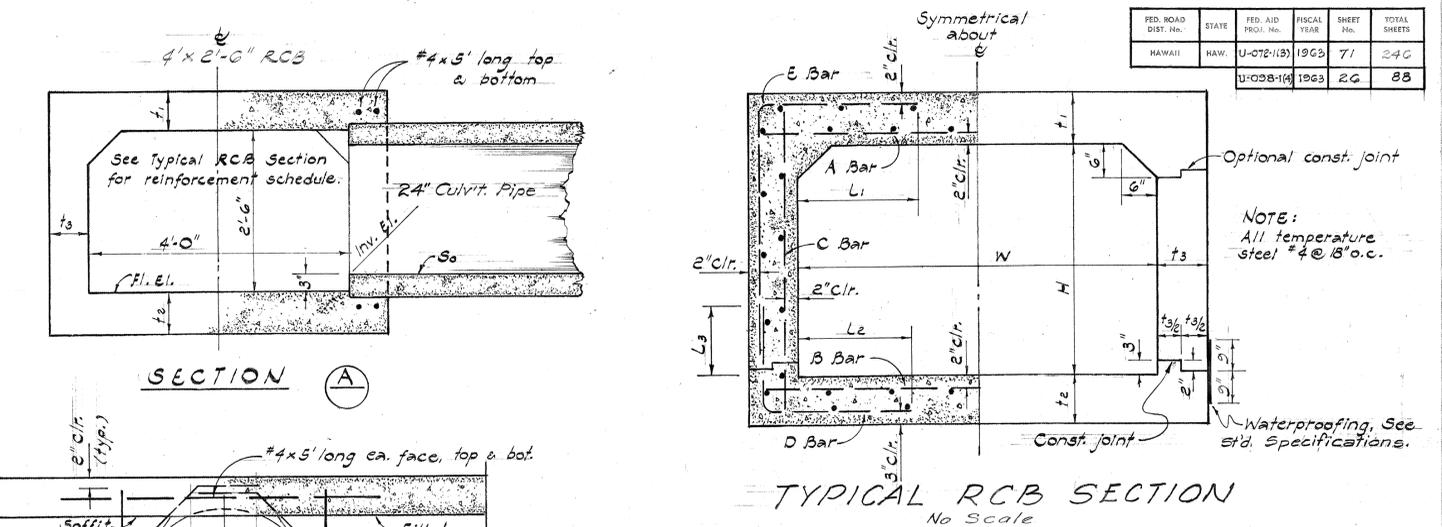


* For Estimated Quantity see sht. #1
** For Estimated Quantity see sht. #5
*** For Estimated Quantity see sht. #5.

BOX CULVERT STATIONS	DIMENSIONS												
	W	H	t1	t2	t3	L1	L2	L3	A Bar	B Bar	C Bar	D Bar	E Bar
* BOX CULVERT NO. 1 (Houghtailing St. to Kapalama Canal)													
-0+07.50 to 4+15	6'-0"	4'-0"	8"	8 1/2"	8"	18"	17"	15"	#6 @ 7 1/2" o.c.	#6 @ 7 1/2" o.c.	#4 @ 17" o.c.	#5 @ 15" o.c.	#5 @ 15" o.c.
4+25 to 9+50	4'-2"	4'-0"	7"	7 1/2"	7"	12"	12"	12"	#4 @ 5" o.c.	#4 @ 5" o.c.	#4 @ 15" o.c.	#4 @ 15" o.c.	#4 @ 15" o.c.
9+50 to 13+50	4'-2"	4'-0"	7"	7 1/2"	7"	13"	13"	12"	#4 @ 6" o.c.	#4 @ 6" o.c.	#4 @ 15" o.c.	#4 @ 15" o.c.	#4 @ 15" o.c.
13+50 to 15+28	4'-2"	4'-0"	7"	7 1/2"	7"	12"	12"	12"	#4 @ 5" o.c.	#4 @ 5" o.c.	#4 @ 15" o.c.	#4 @ 15" o.c.	#4 @ 15" o.c.
15+48.13 to 17+53.22	4'-2"	4'-0"	7"	7 1/2"	7"	12"	12"	12"	#4 @ 5" o.c.	#4 @ 5" o.c.	#4 @ 15" o.c.	#4 @ 15" o.c.	#4 @ 15" o.c.
** BOX CULVERT NO. 2 (Kapalama Canal to Auld Lane)													
0+40 to 1+73.72	7'-0"	4'-0"	8"	8 1/2"	7"	10"	18"	15"	#6 @ 7" o.c.	#6 @ 7" o.c.	#4 @ 18" o.c.	#5 @ 14" o.c.	#5 @ 14" o.c.
1+88.72 to 3+34.16	6'-0"	3'-6"	8"	8 1/2"	7"	17"	16"	15"	#6 @ 8 1/2" o.c.	#6 @ 8 1/2" o.c.	#4 @ 18" o.c.	#5 @ 17" o.c.	#5 @ 17" o.c.
*** BOX CULVERT NO. 3 (Box Culvert No. 2 to Palama St.)													
0+03.75 to 11+48.34	4'-0"	2'-6"	7"	8"	7"	16"	15"	12"	#4 @ 6" o.c.	#4 @ 6" o.c.	#4 @ 18" o.c.	#4 @ 18" o.c.	#4 @ 18" o.c.

REINFORCEMENT SCHEDULE BELT, COLLINS & ASSOC., LTD.
Civil and Structural Engineers

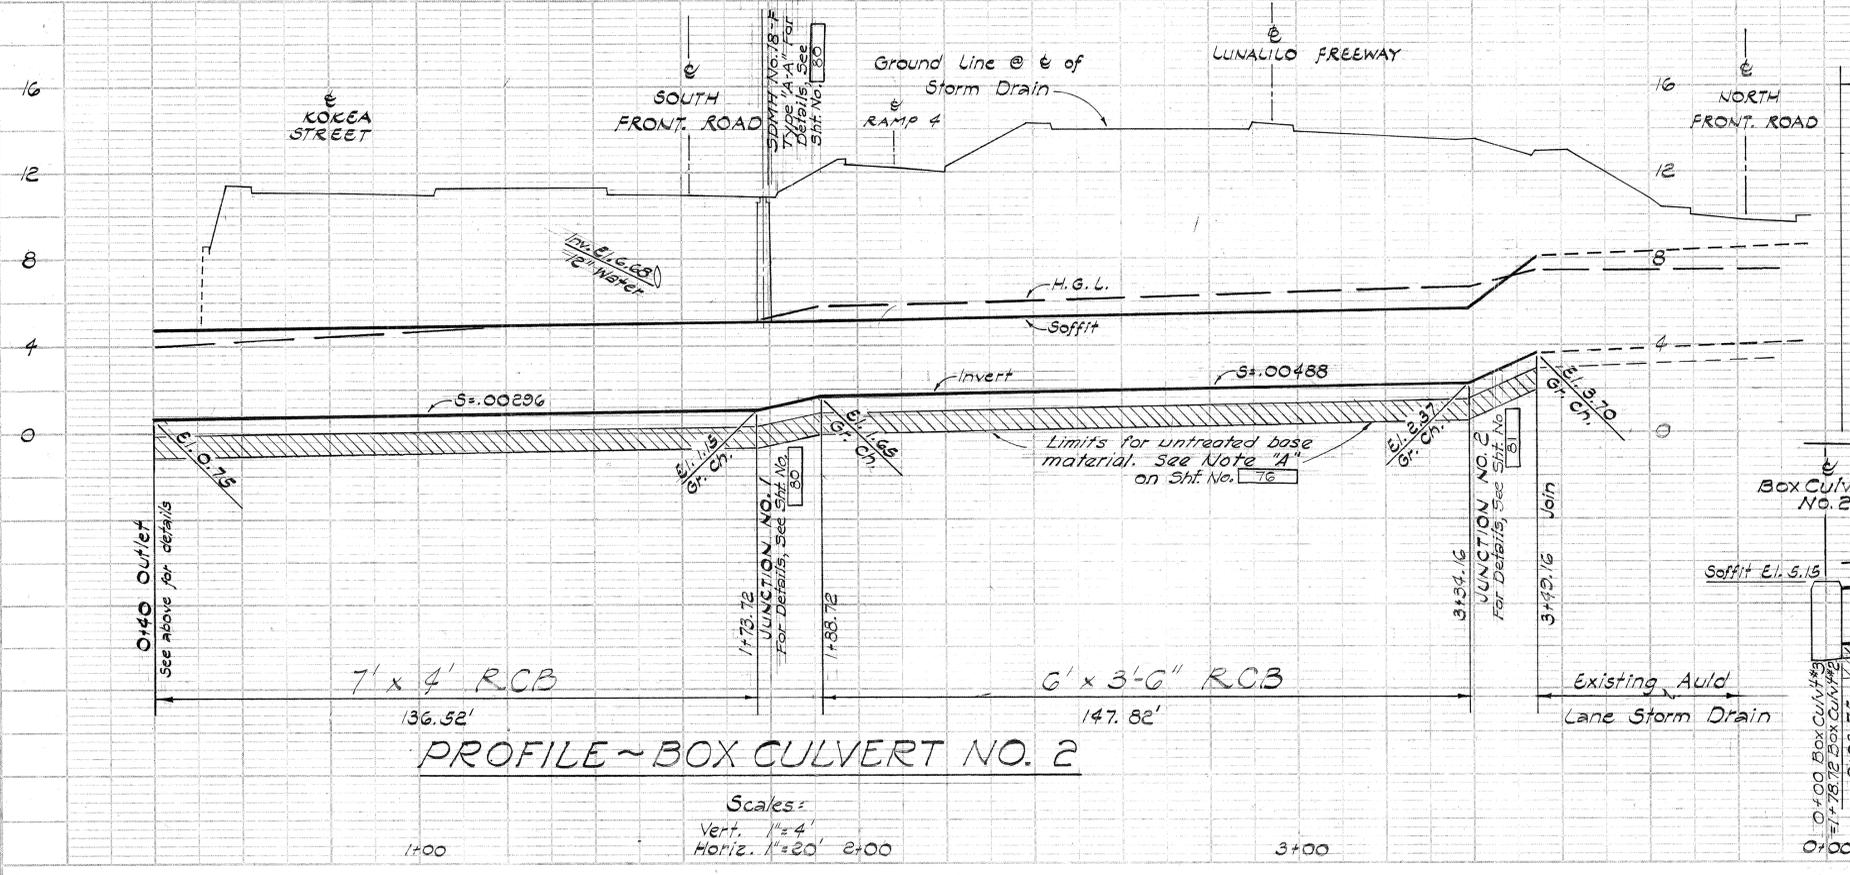

PROFILE - BOX CULVERT NO. 2
Scales: Vert. 1"=4', Horiz. 1"=20' 2+00

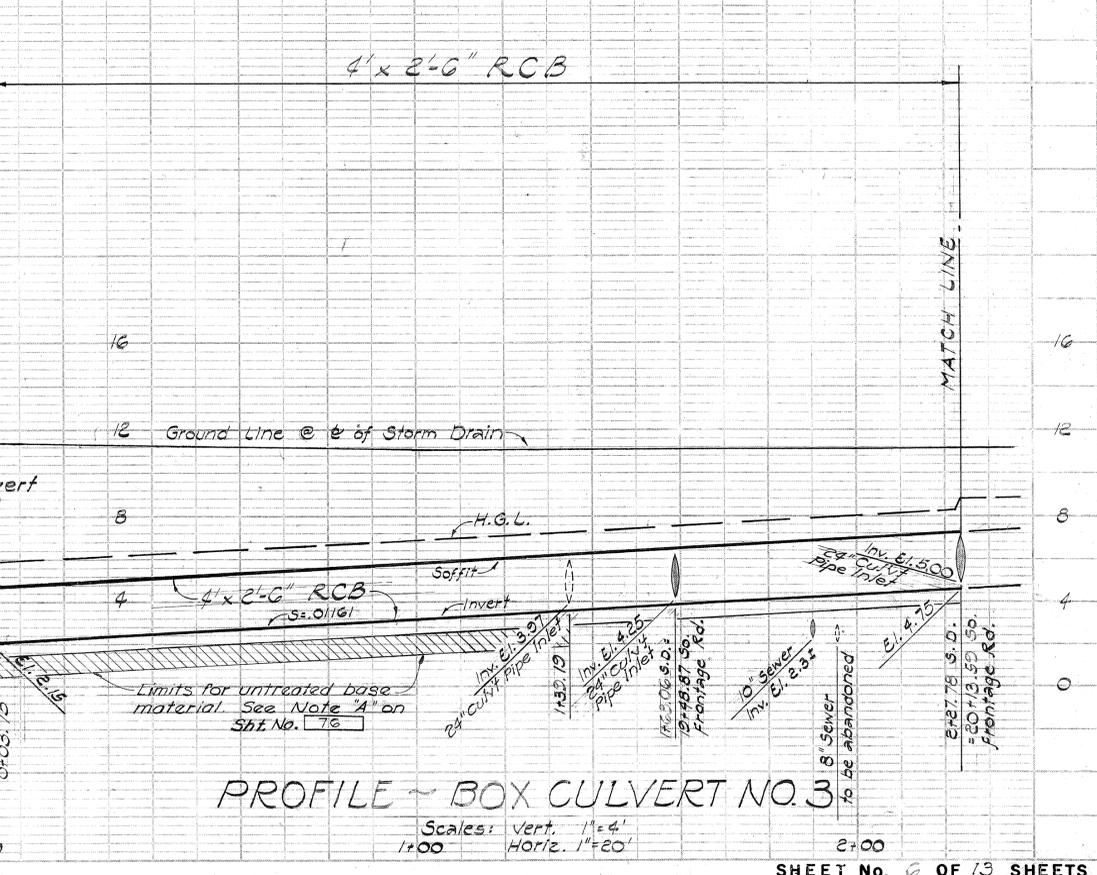


PROFILE - BOX CULVERT NO. 3
Scales: Vert. 1"=4', Horiz. 1"=20' 2+00

U09810400.26


U07210300.71

FED. ROAD DIST. No.	STATE	FED. AID PROJ. No.	FISCAL YEAR	SHEET No.	TOTAL SHEETS
HAWAII	HAW.	U-098-16	1968	28	88

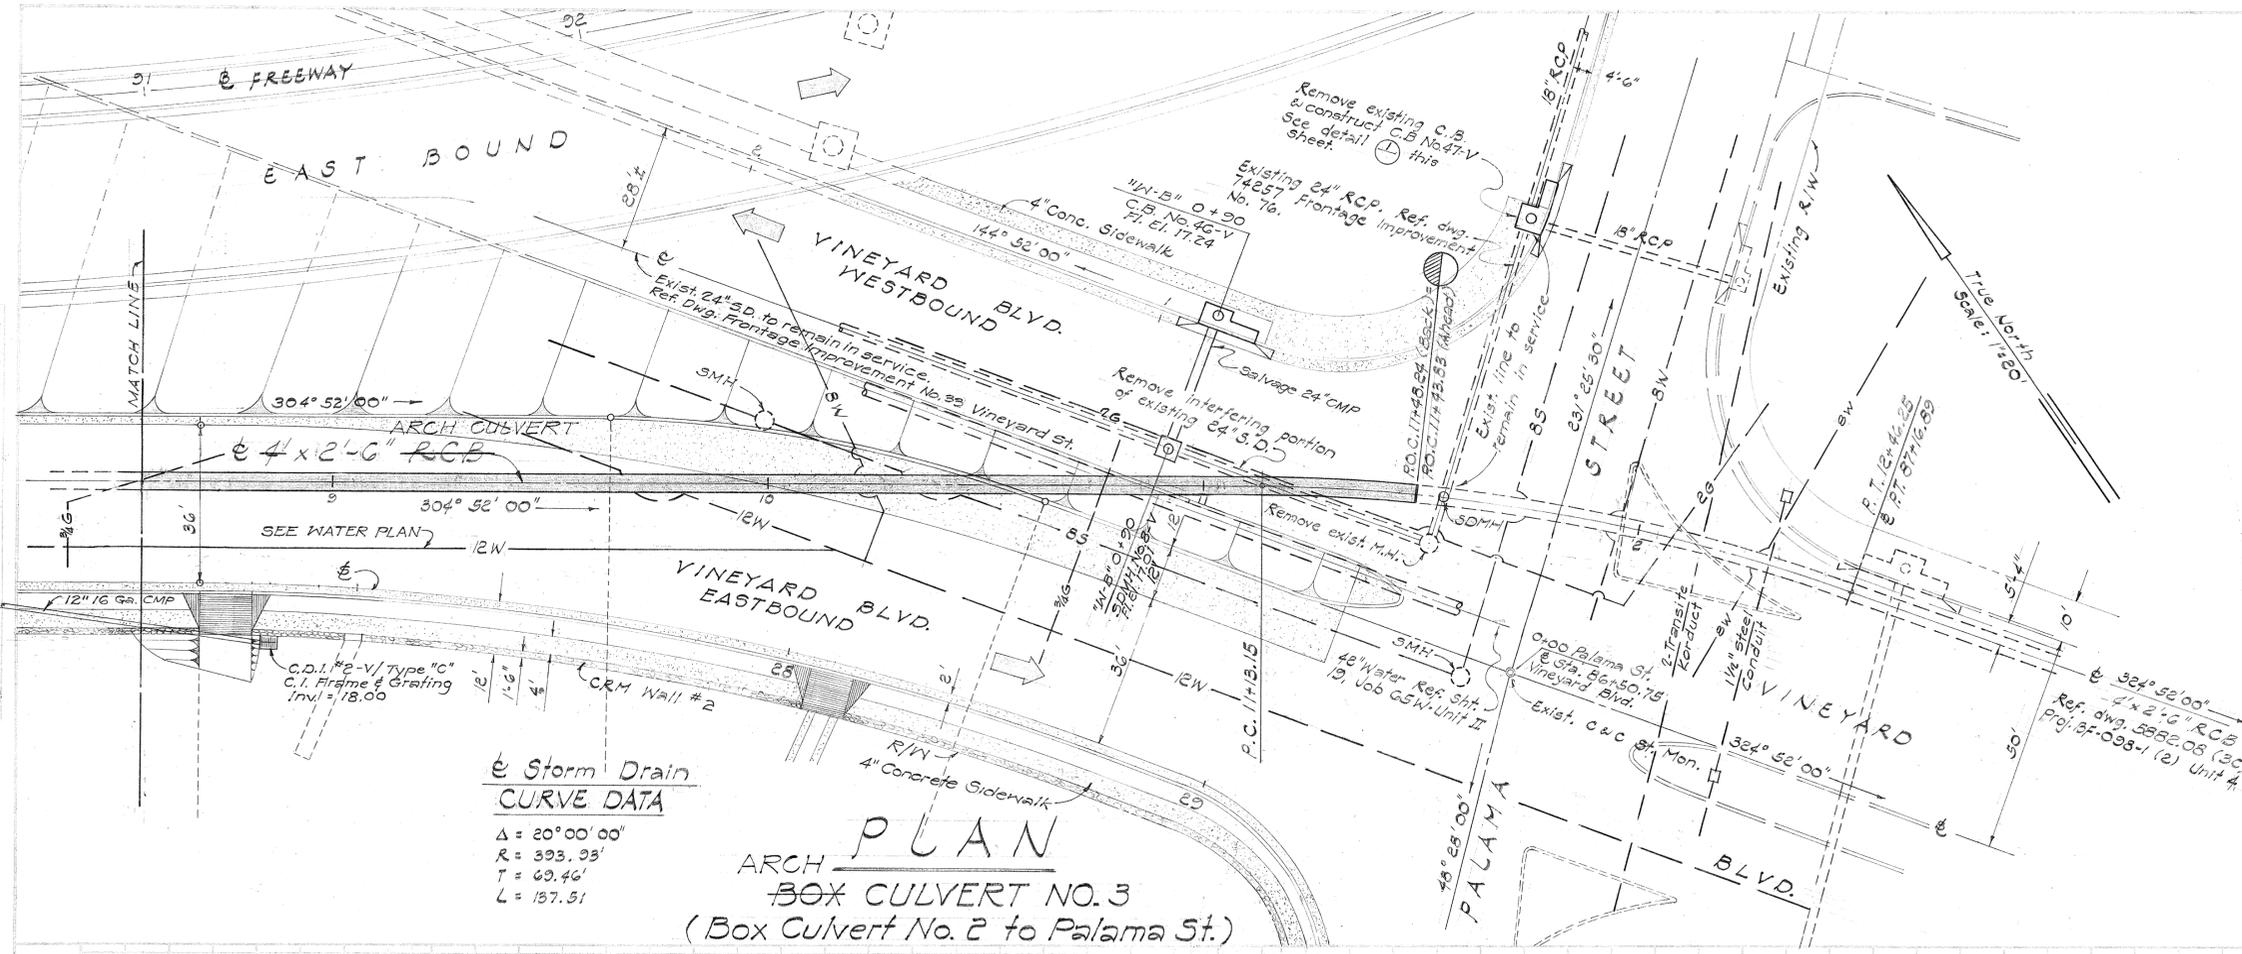


Storm Drain
CURVE DATA
 $\Delta = 20^{\circ}00'00''$
 $R = 393.23'$
 $T = 69.46'$
 $L = 137.51'$

ARCH PLAN
BOX CULVERT NO. 3
 (Box Culvert No. 2 to Palama St.)

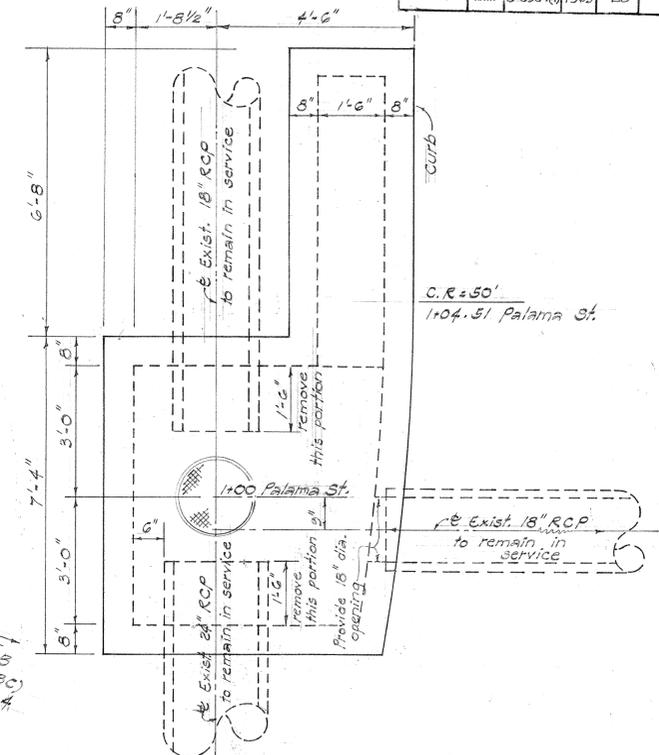

DETAIL
CATCH BASIN No. 47-V
 Scale: 1/2" = 1'-0"


BELT, COLLINS & ASSOC. LTD.
 Civil and Structural Engineers

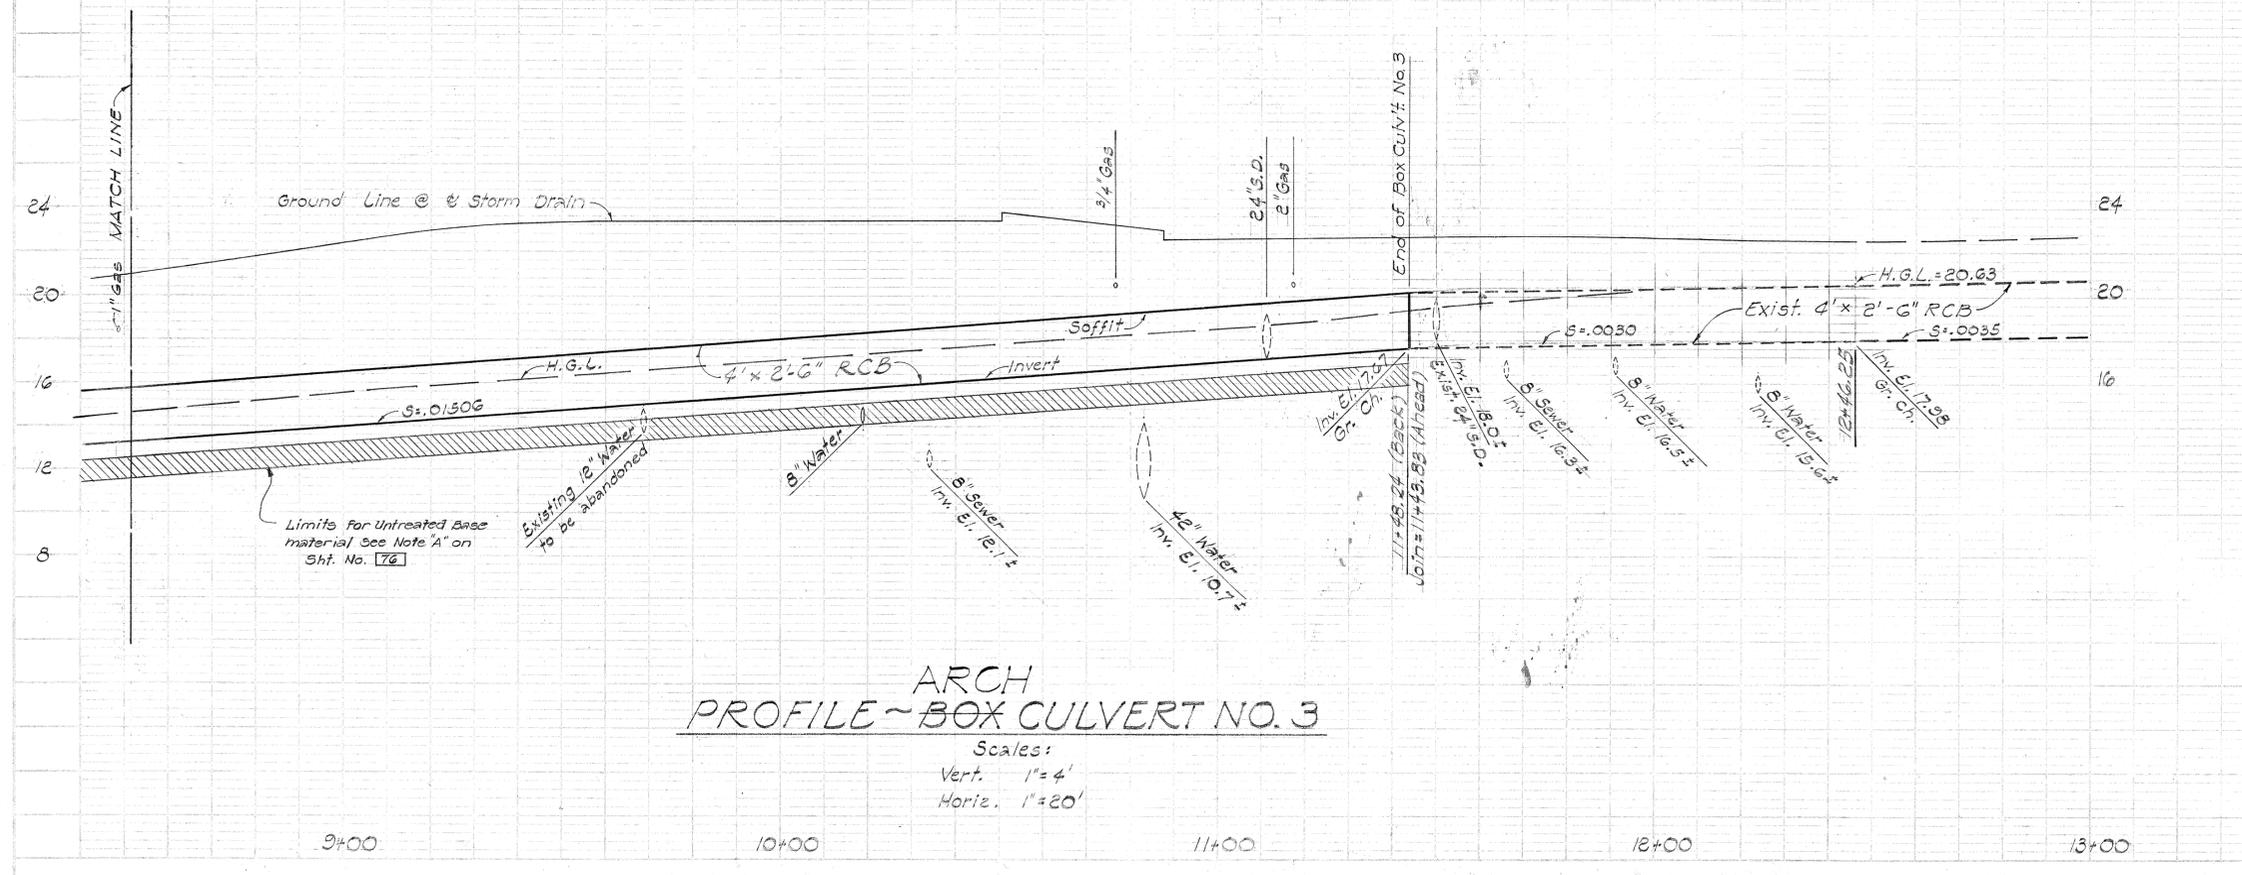


ARCH PROFILE - BOX CULVERT NO. 3
 Scales:
 Vert. 1" = 4'
 Horiz. 1" = 20'

U 0 9 S 1 0 4 0 0 . 2 S


FED. ROAD DIST. NO.	STATE	FED. AID PROJ. NO.	FISCAL YEAR	SHEET NO.	TOTAL SHEETS
HAWAII	HAW.	U-072-1(3)	1963	73	246
			U-098-1(4)	29	88

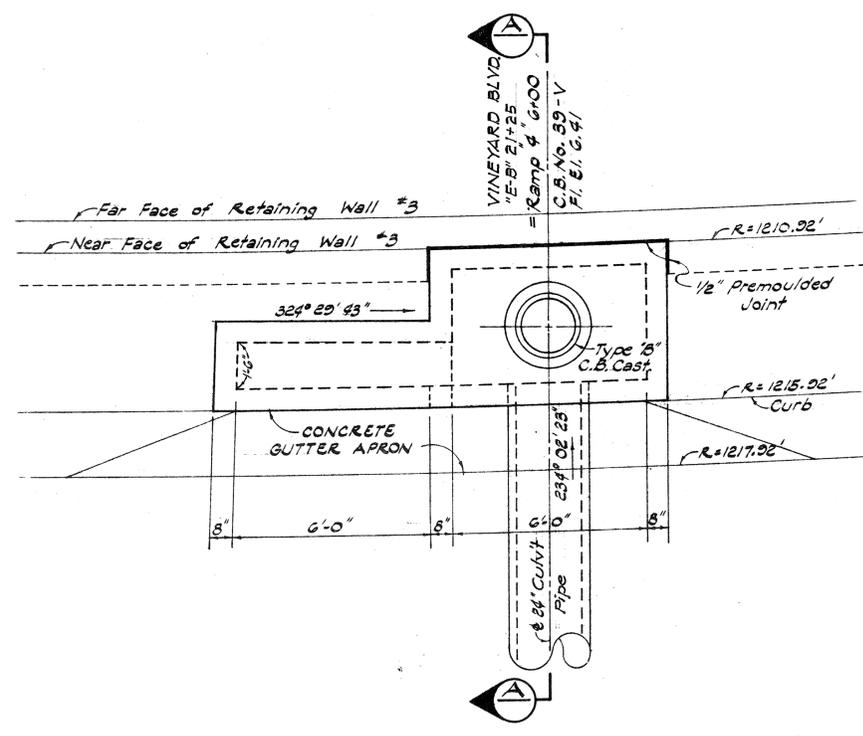



PLAN
CATCH BASIN NO. 39-V
Scale: 3/8"=1'-0"

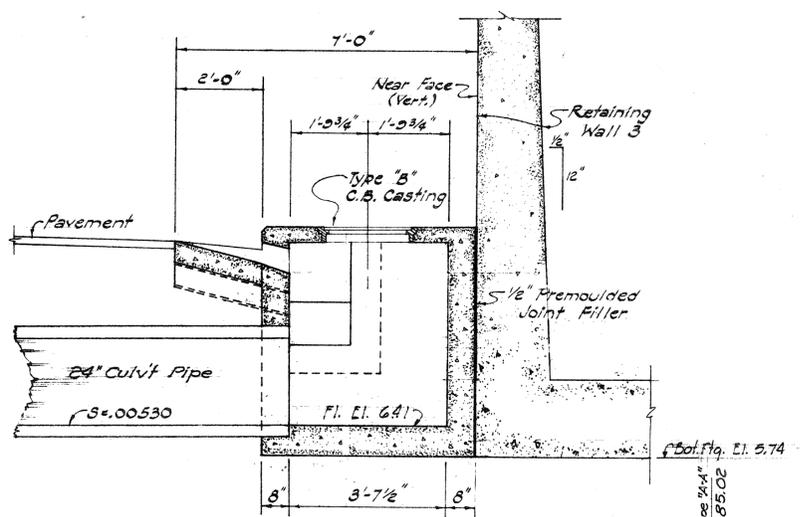


SECTION A-A
Scale: 1/2"=1'-0"

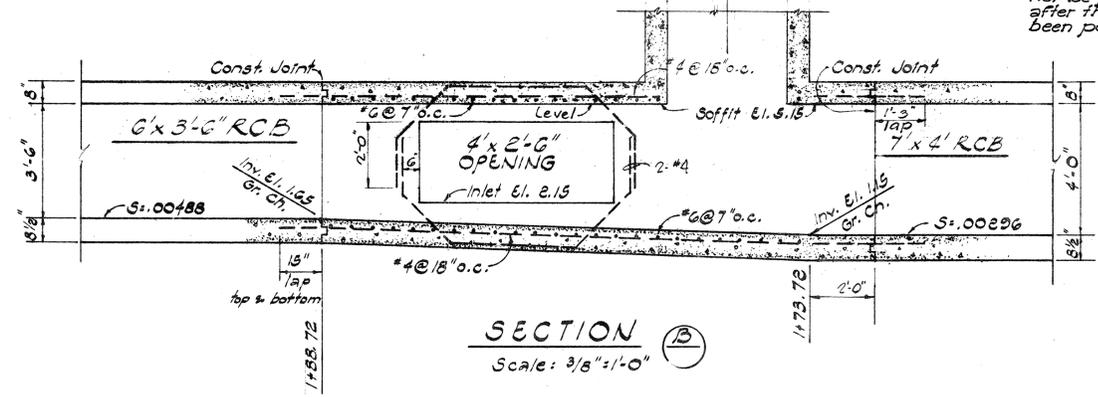


SECTION B-B
Scale: 3/8"=1'-0"

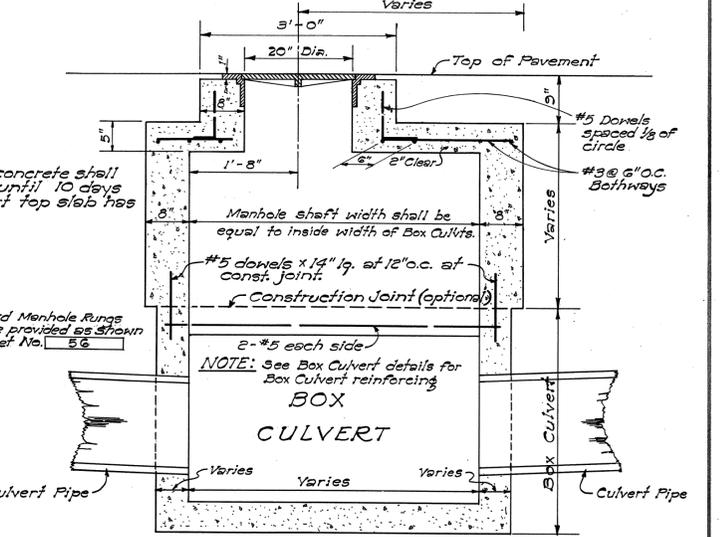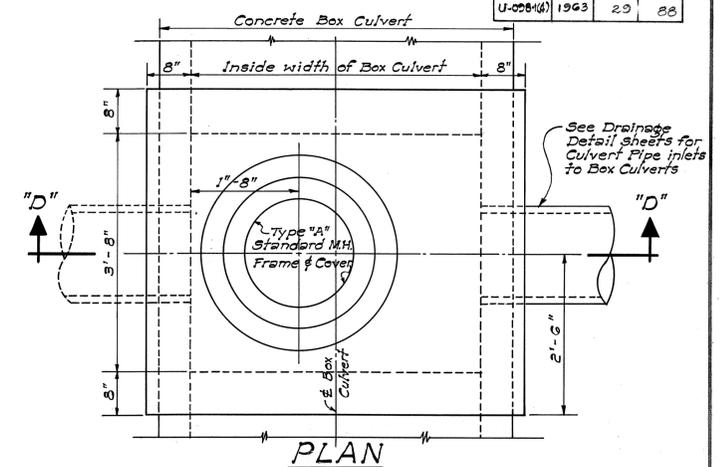

SECTION "D-D"
TYPICAL DETAIL OF TYPE "A-A" SDMH
M.H. ON R.C. BOX CULVERT
Not to Scale

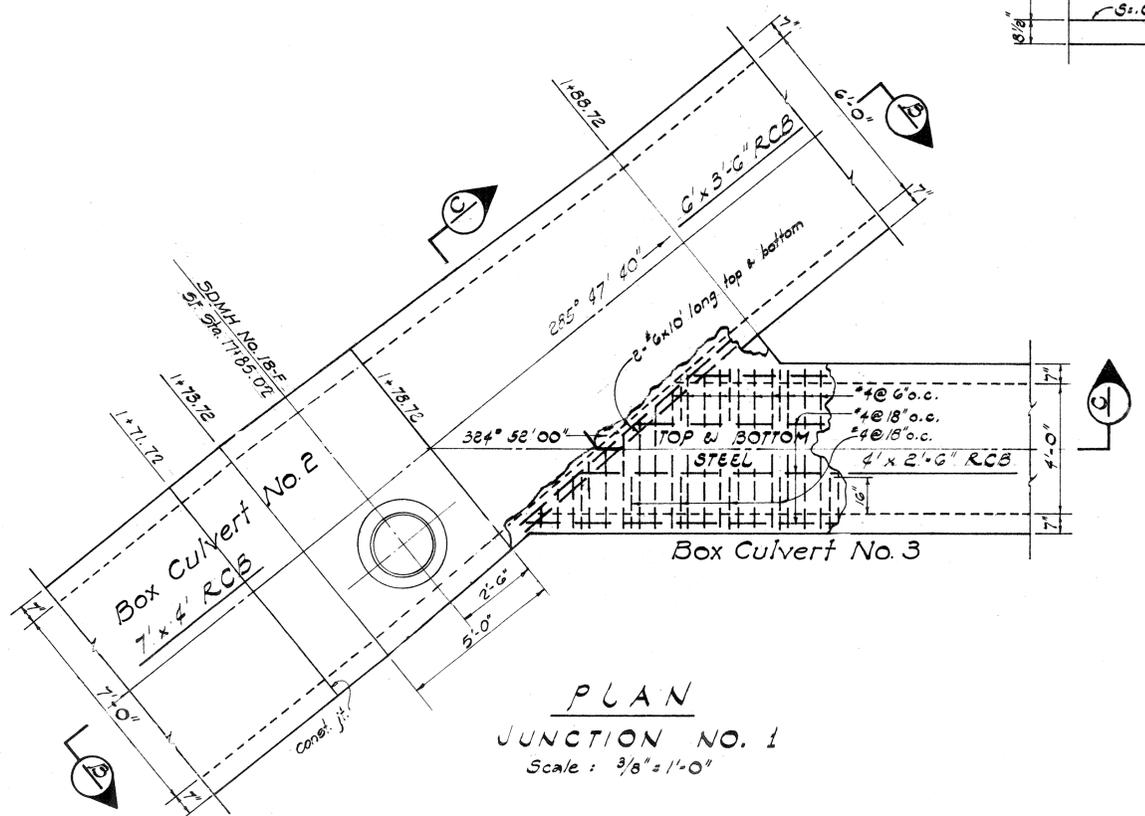

PLAN
JUNCTION NO. 1
Scale: 3/8"=1'-0"

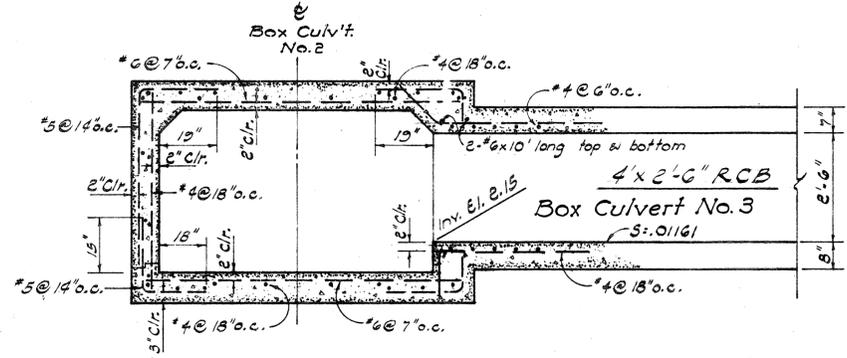

SECTION C-C
Scale: 1/2"=1'-0"

NOTE:
Manhole shaft concrete shall not be poured until 10 days after the culvert top slab has been poured.

NOTE:
Standard Manhole Rings shall be provided as shown on Sheet No. 56

SURVEY PLOTTED BY	DATE
DESIGNED BY	
TRACED BY	
QUANTITIES BY	
CHECKED BY	
ORIGINAL PLAN	
NOTE BOOK	
NO.	

BELT, COLLINS & ASSOC., LTD.
Civil and Structural Engineers


DEPARTMENT OF TRANSPORTATION
HIGHWAYS DIVISIONS
STATE OF HAWAII
DRAINAGE
BOX CULVERT NO. 3
SPECIAL CATCH BASINS DETAILS
AND DETAILS OF TYPE "A-A" S.D.M.H.
LUNALILO FREEWAY U-072-1(3)
VINEYARD BOULEVARD U-098-1(4)

SHEET No. 9 OF 13 SHEETS


U09S10400.29

U07210300.73


FED. ROAD DIST. NO.	STATE	FED. AID PROJ. NO.	FISCAL YEAR	SHEET NO.	TOTAL SHEETS
HAWAII	HAW.	U-072-1(3)	1963	76	246
		U-098-1(4)	1963	30	83

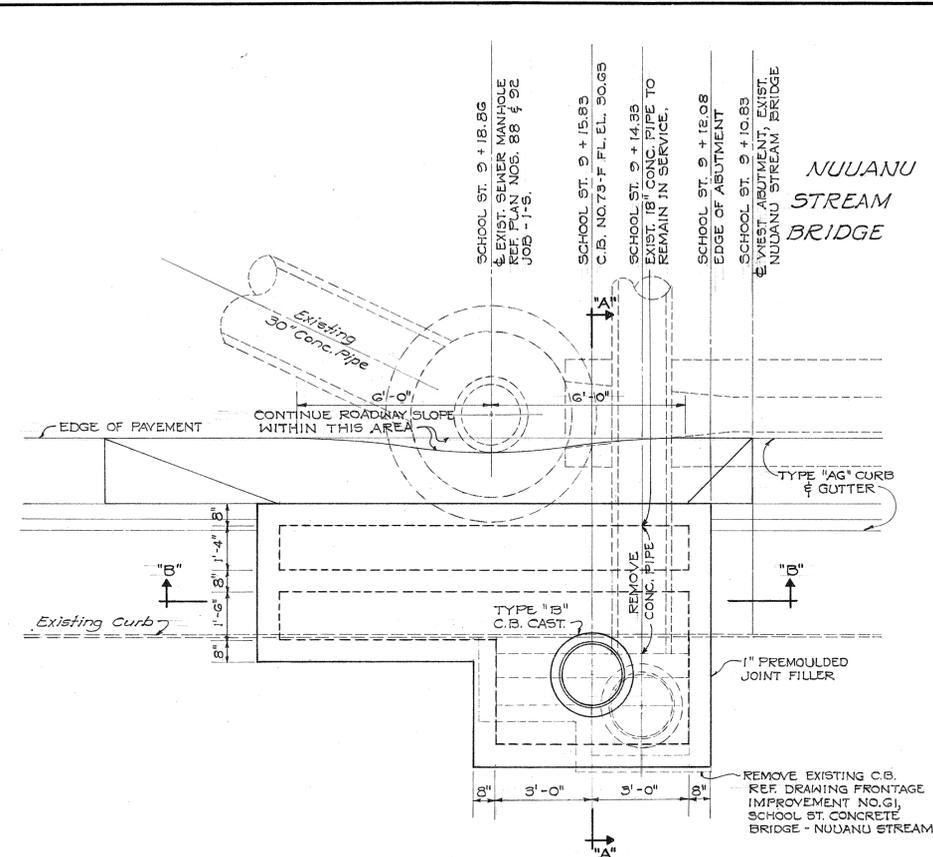


PLAN
CATCH BASIN NO. 73-F
SCALE: 3/8" = 1'-0"

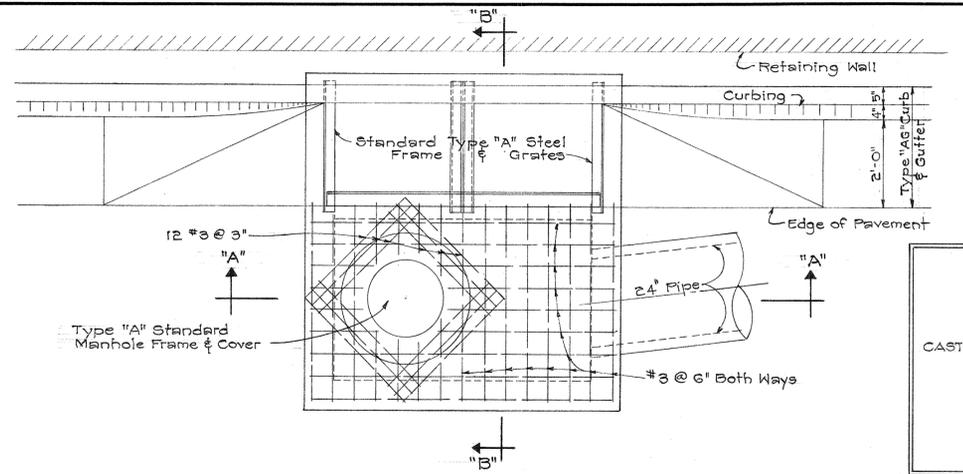

PLAN
C.B. NO. 48-F (Special)
SCALE: 1/2" = 1'-0"

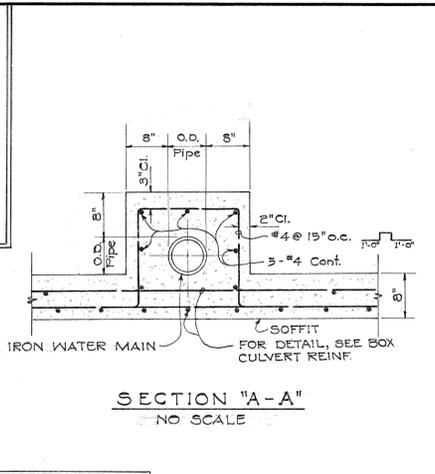


SECTION "A-A"
NO SCALE

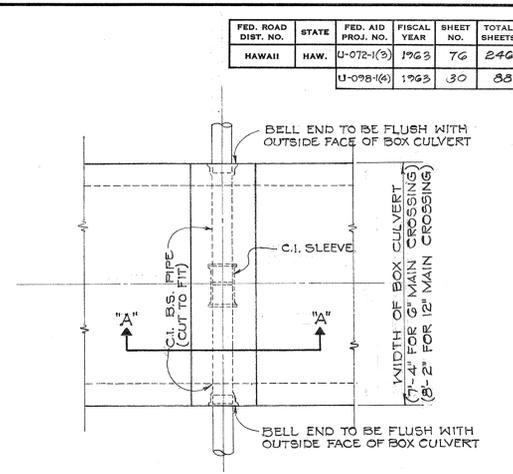


PLAN
NO SCALE


TYPICAL DETAILS OF CONCRETE JACKETS FOR 6" F. H. PIPE CROSSING NEW 6'x4' BOX CULVERT AT "5-F" STA. 14+31 AND FOR 12" MAIN CROSSING NEW 7'x4' BOX CULVERT AT KOKEA STREET

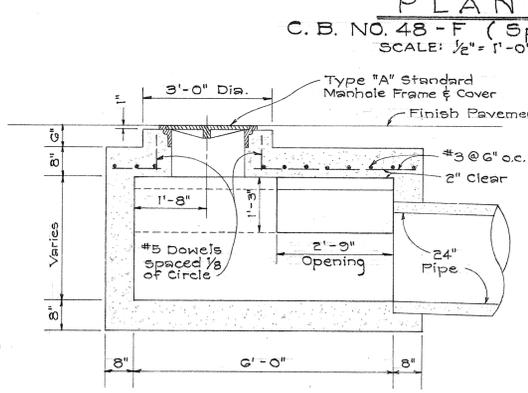


SECTION "A-A"
C.B. NO. 48-F (Special)
SCALE: 1/2" = 1'-0"

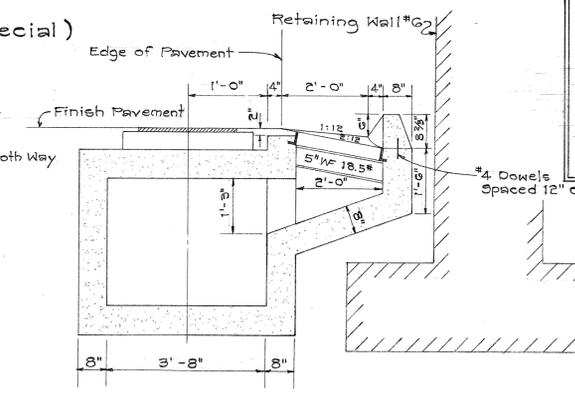

SECTION "B-B"
C.B. NO. 48-F (Special)
SCALE: 1/2" = 1'-0"

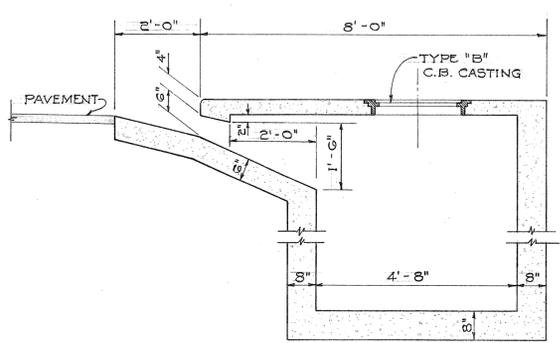


SECTION "A-A"
CATCH BASIN NO. 73-F
SCALE: 1/2" = 1'-0"

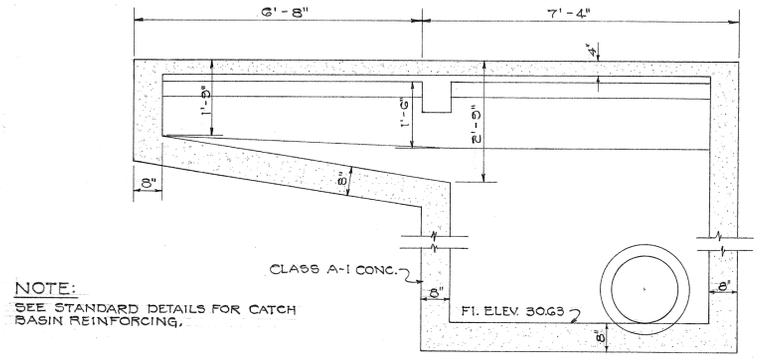


SECTION "B-B"
CATCH BASIN NO. 73-F
SCALE: 1/2" = 1'-0"


NOTE: SEE STANDARD DETAILS FOR CATCH BASIN REINFORCING.

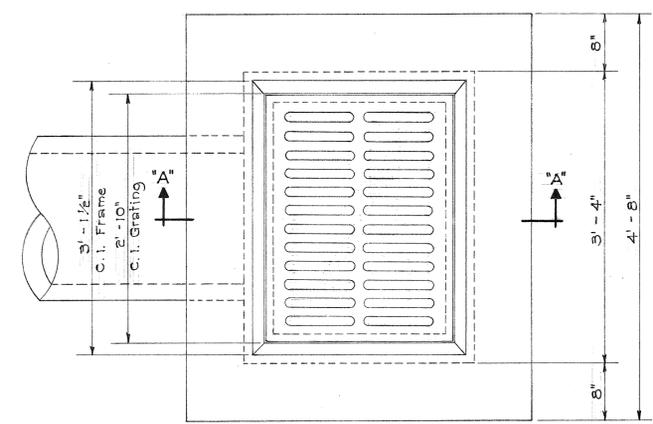

PLAN
TYPICAL DETAIL OF CONCRETE DROP INTAKE
SCALE: 1" = 1'-0"

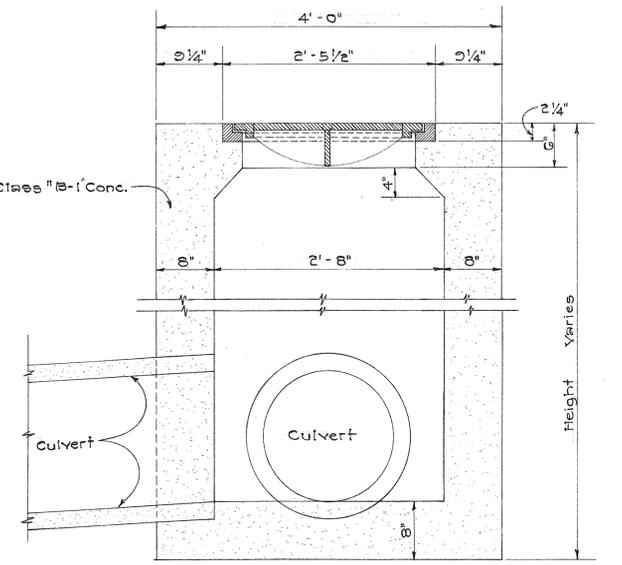

SECTION "A-A"

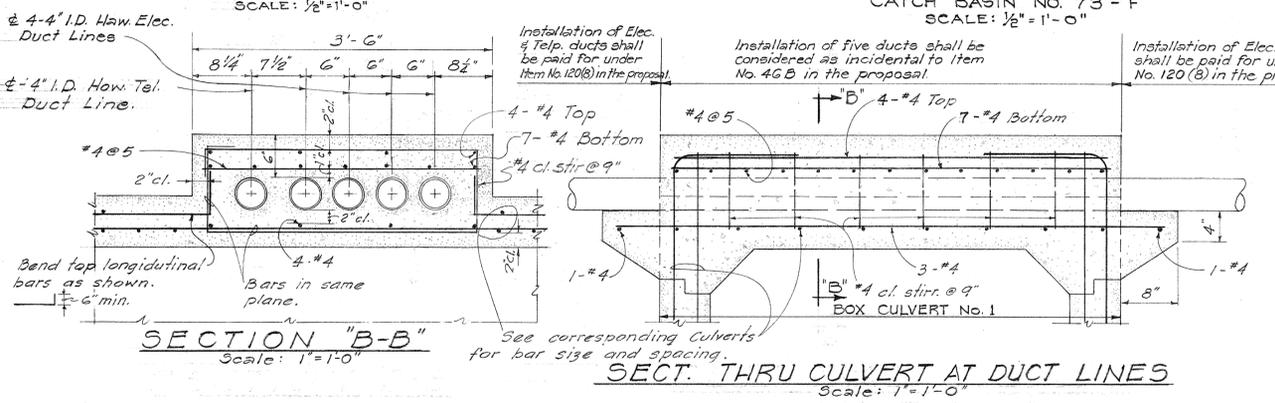

SECTION "B-B"
Scale: 1" = 1'-0"

SECT. THRU CULVERT AT DUCT LINES
Scale: 1" = 1'-0"

NOTE: Quantities of concrete and reinf. bars for beam enveloping Elec. & Telp. ducts are included in the respective quantities for Box Culvert No. 1.

APPROVED:
[Signature]
ASST. CHIEF ENGINEER
BOARD OF WATER SUPPLY
DATE

STATE OF HAWAII
DEPARTMENT OF TRANSPORTATION
HIGHWAYS DIVISION
DRAINAGE DETAILS
LUNALILO FREEWAY
PROJ. NO. U-072-1(3)
VINEYARD BOULEVARD
PROJ. NO. U-098-1(4)
SCALES: AS NOTED
1963

DATE: _____
DESIGNED BY: _____
CHECKED BY: _____
NO. _____

