




FED. ROAD DIST. No.	STATE	FED. AID PROJ. No.	FISCAL YEAR	SHEET No.	TOTAL SHEETS
HAWAII	HAW.	U-078-(A)	1963	12	246
		U-008-(A)	1963	5	88

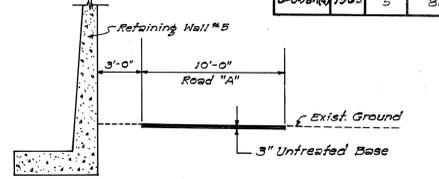

PLAN

DATE: \_\_\_\_\_

BY: \_\_\_\_\_

NO. \_\_\_\_\_

NOTE: SURVEYED, PLOTTED, CHECKED, RT. OF WAY CHECKED



PROFILE

DATE: \_\_\_\_\_

BY: \_\_\_\_\_

NO. \_\_\_\_\_

NOTE: SURVEYED, GRADES CHECKED, B.M.'S NOTED, STRUCTURE NOTATIONS CHECKED

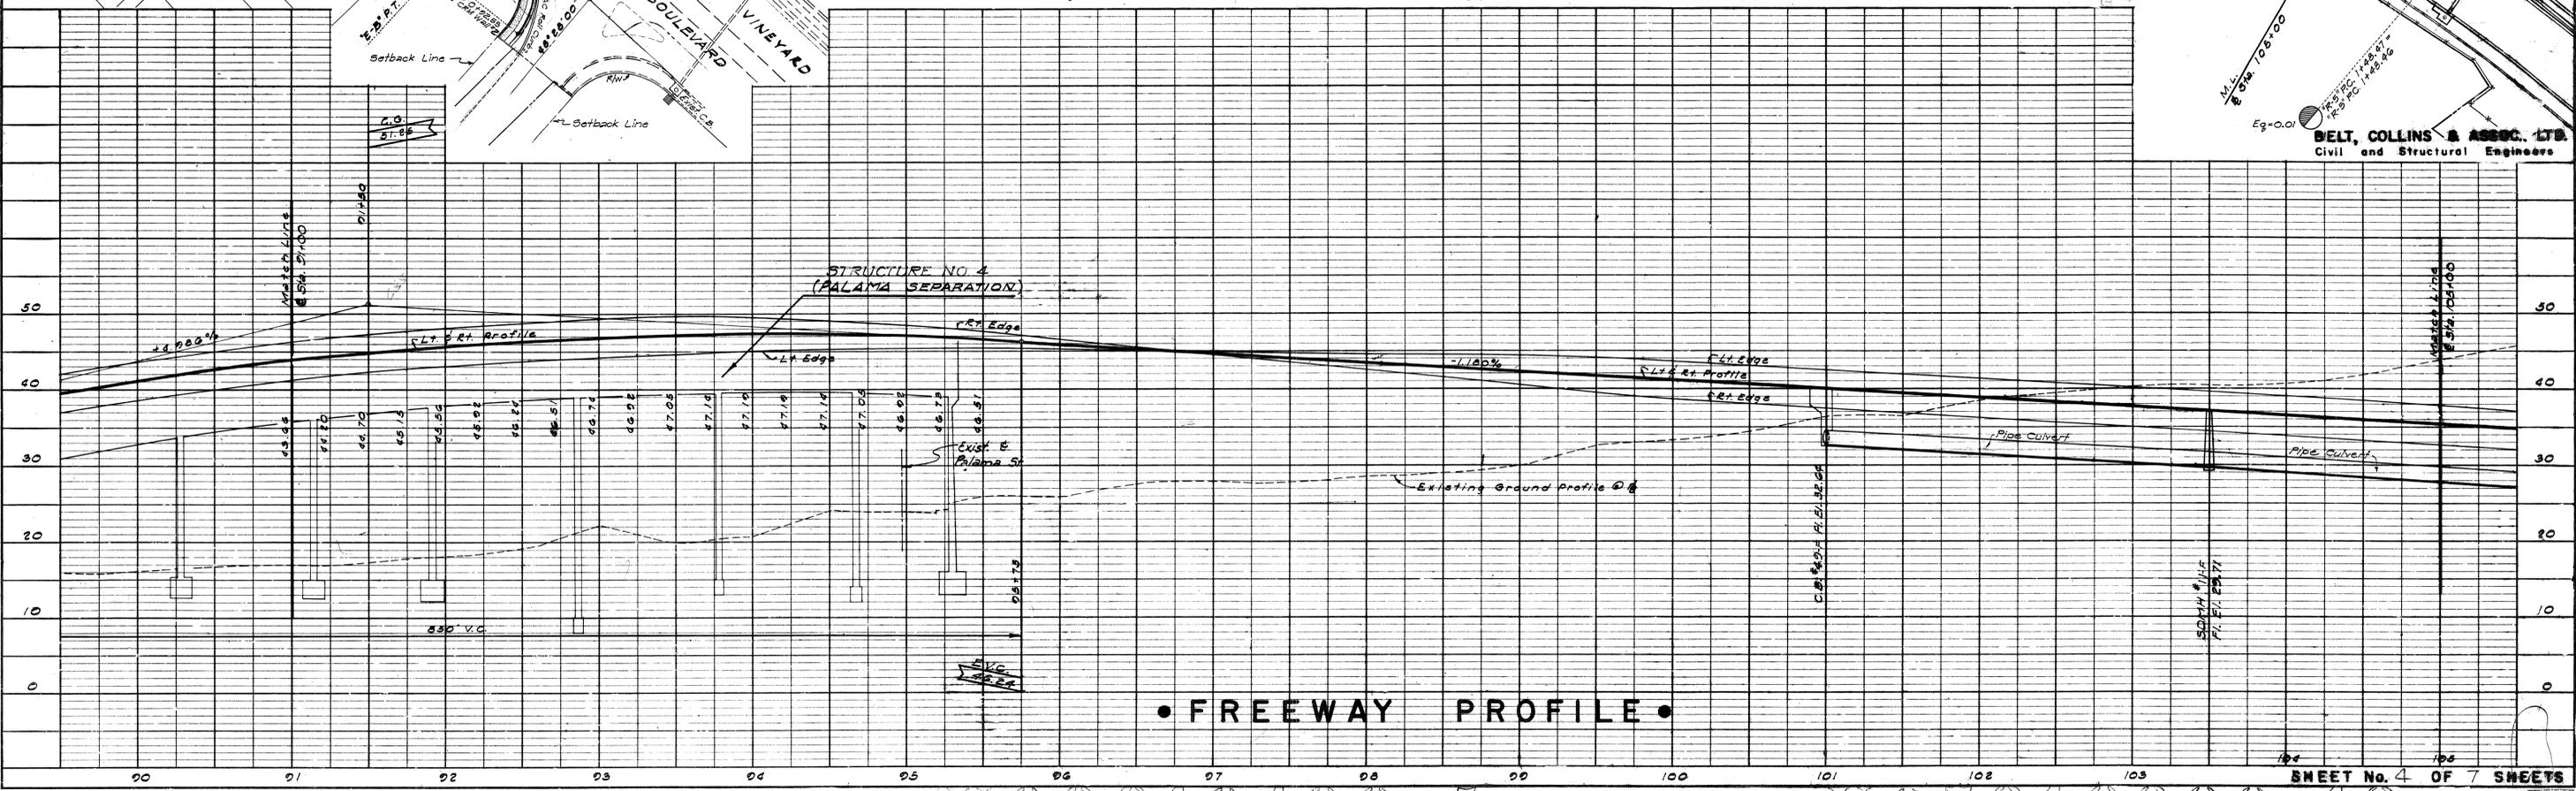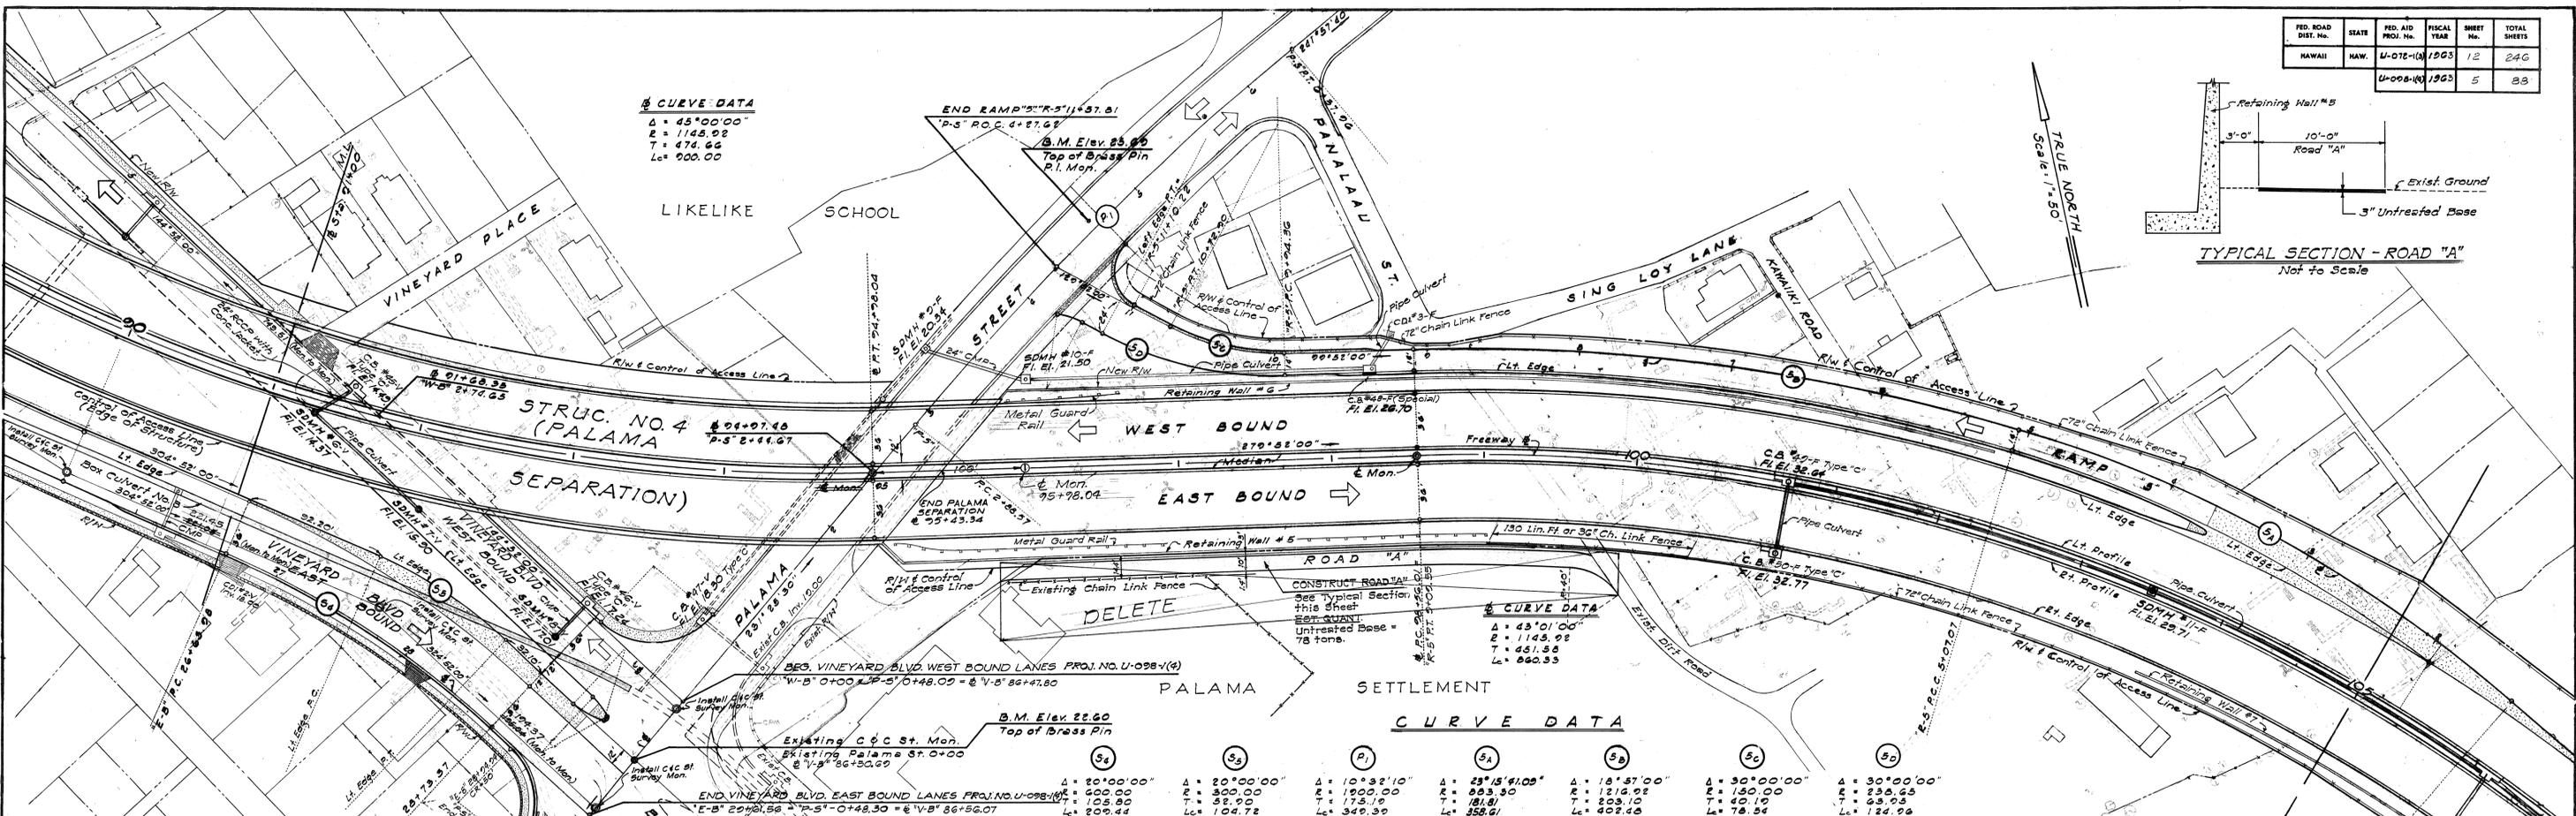

• FREEWAY PROFILE •

007210300.12