



FED. ROAD DIST. No.	STATE	FED. AID PROJ. No.	FISCAL YEAR	SHEET No.	TOTAL SHEETS
U-072-1(4)	HAW.	U-072-1(3)	1963	15	246
U-072-1(4)	HAW.	U-072-1(3)	1963	6	88

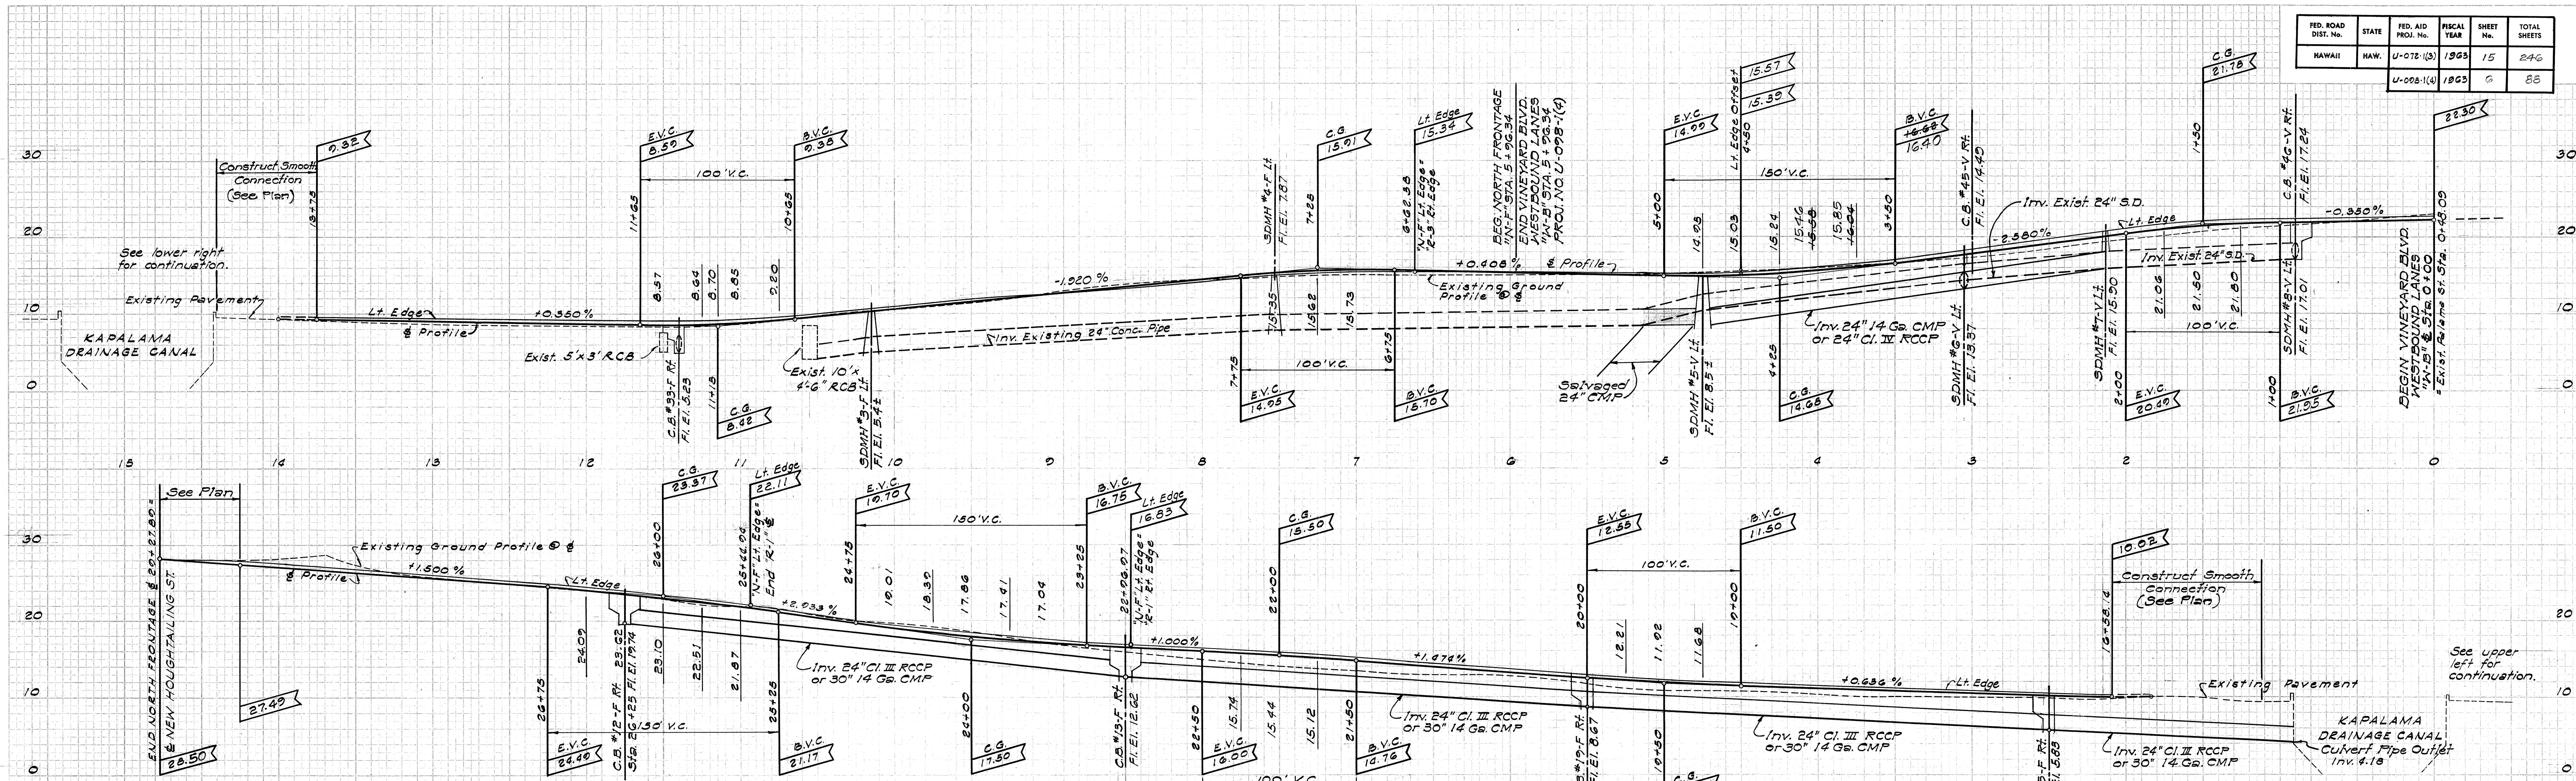

PROFILE NORTH FRONTAGE AND VINEYARD BLVD. WEST BOUND LANES.

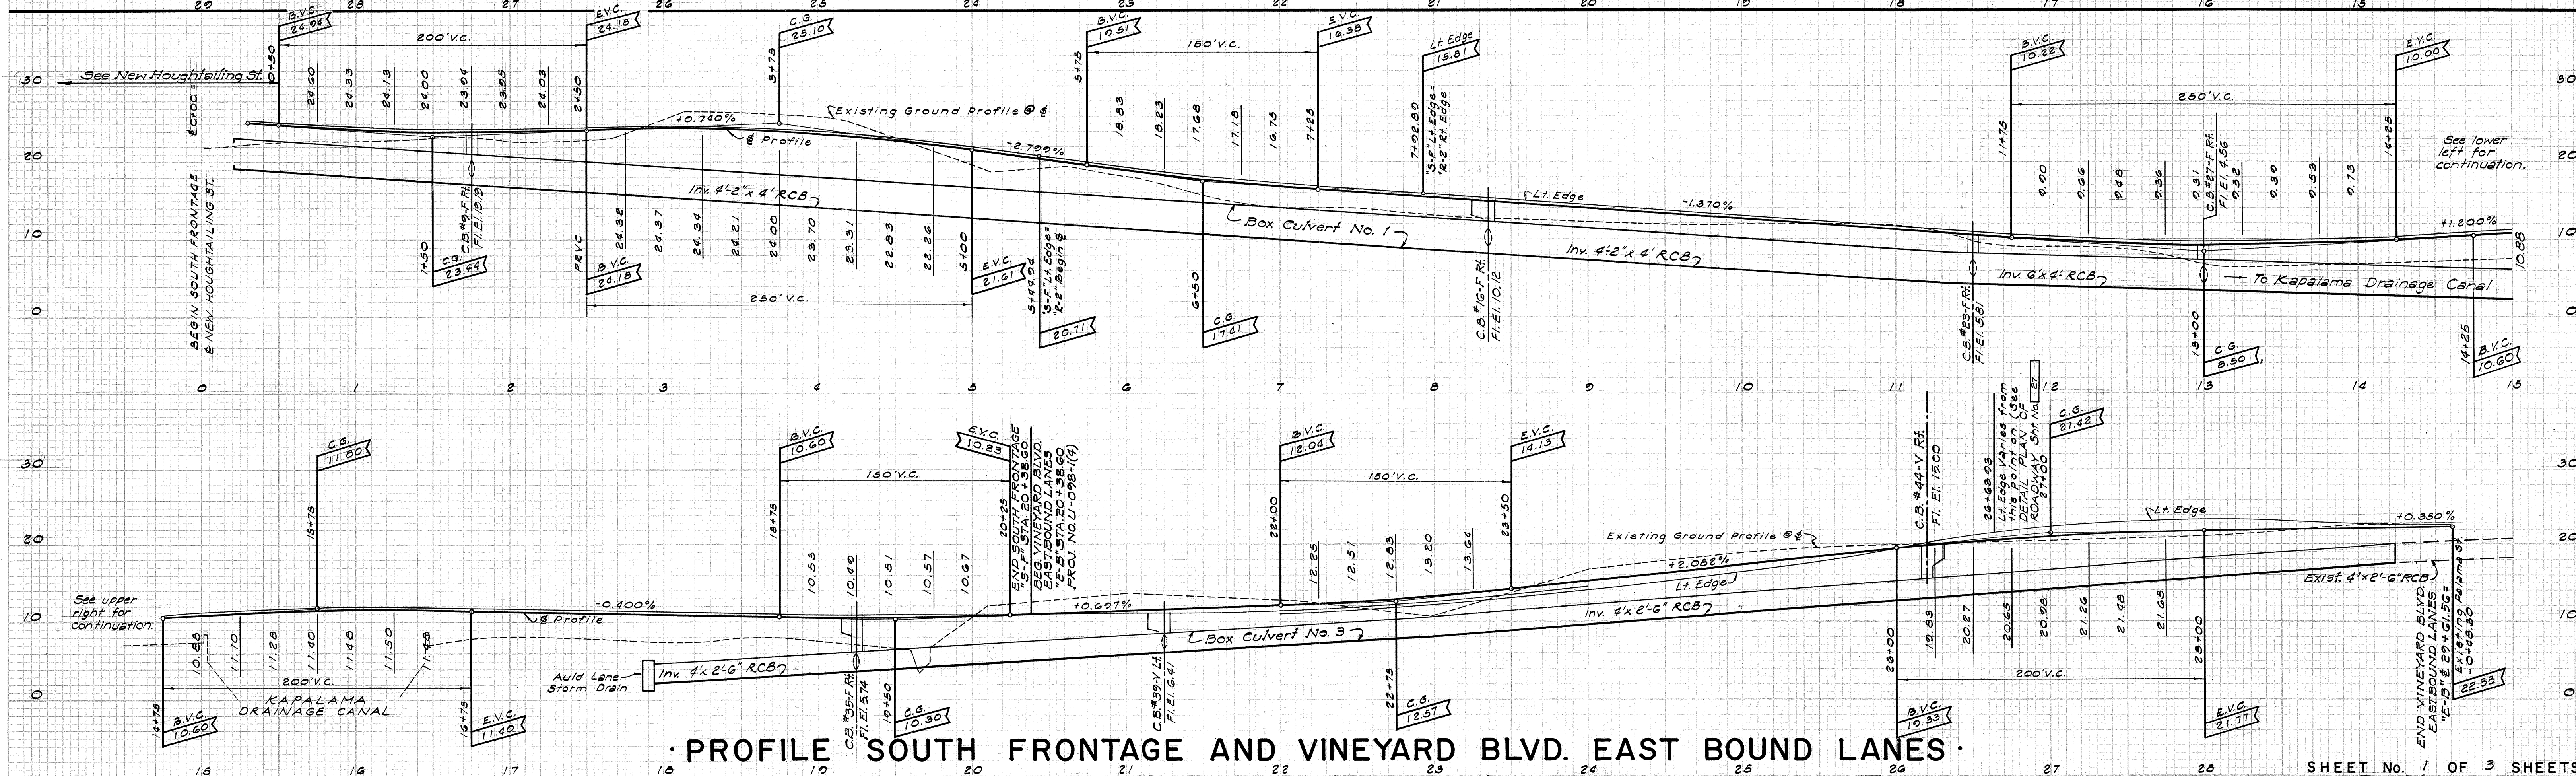

PROFILE SOUTH FRONTAGE AND VINEYARD BLVD. EAST BOUND LANES.