


PLAN (ALTERED)
Scale: 1/4" = 1'-0"




NORTHWEST ELEVATION (ALTERED)
Scale: 1/4" = 1'-0"

REVISED NOV. 20, 1963

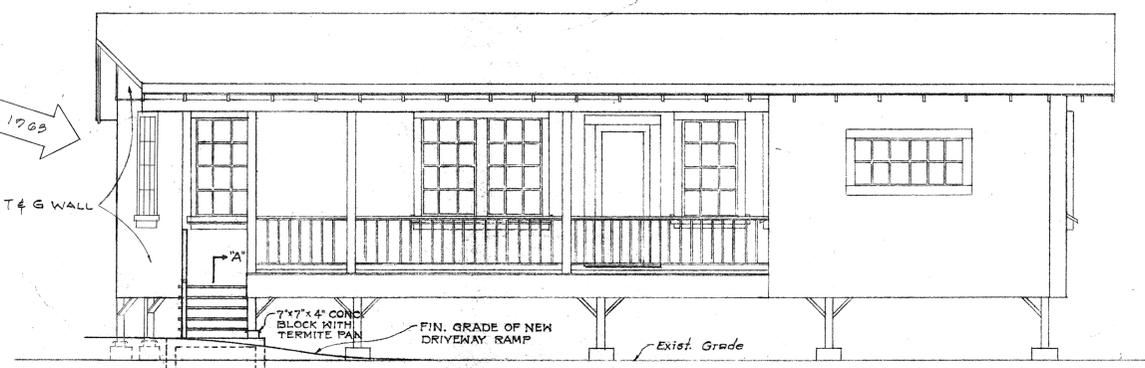

NORTHWEST ELEVATION (ALTERED)
Scale: 1/4" = 1'-0"

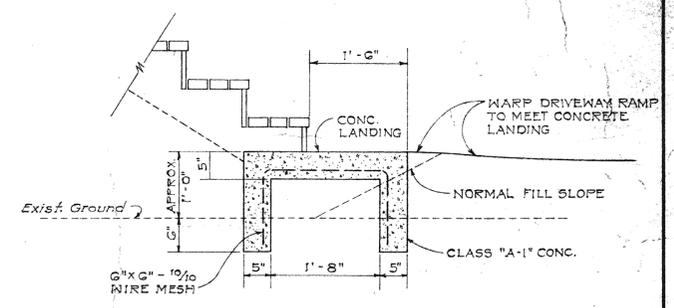

SECTION "A-A"
SCALE: 3/4" = 1'-0"

SCOPE OF WORK

1. CUT OFF AND REMOVE PORTIONS OF BEDROOM #3 AND KITCHEN.
2. CONSTRUCT NEW WALLS OF BEDROOM #3 AND KITCHEN.
3. RELOCATE TWO WINDOWS IN BEDROOM #3.
4. ROOF OVERHANG ALONG THE FRONT OF THE BUILDING SHALL BE CUT OFF AND REMOVED TO CLEAR HIGHWAY RIGHT-OF-WAY LINE.
5. CONSTRUCT NEW WOOD STEPS TO PORCH SIMILAR IN DETAILS TO EXISTING STEPS, AND NEW CONCRETE LANDING AS SHOWN.
6. PAINT NEW AND REPLACED OR DAMAGED WOOD SURFACES AS PER SPECIFICATIONS.
7. RECONSTRUCT REINFORCED CONCRETE DRIVEWAY STRIPS MAKING SMOOTH CONNECTION AS SHOWN.
8. CONTINUOUS UTILITY SERVICES TO BE MAINTAINED DURING THE ENTIRE ALTERATION WORK.
9. CLEAN UP ALL DEBRIS IN WORK AREA AFTER COMPLETION OF WORK.
10. LAWN DAMAGED DUE TO WORK TO BE REPAIRED.
11. PROVIDE ACCESS TO PORCH AT ALL TIMES DURING PERIOD OF ALTERATION WORK.

ITEM 124 C

DEPARTMENT OF TRANSPORTATION
HIGHWAYS DIVISION
STATE OF HAWAII

REHABILITATION OF A DWELLING
AT 913 N. VINEYARD STREET
(TANG LEONG WONG, OWNER)
FAX KEY NO. 1-6-01-96
VINEYARD BOULEVARD
PROJ. NO. U-098-1(4)
SCALE: AS NOTED DATE: 1963

DATE	DESIGNED BY
.....	DRAWN BY
	QUANTITIES BY
	CHECKED BY
ORIGINAL PLAN	NOTE BOOK NO.