

INDEX TO DRAWINGS		COMPOSITE SHEET NO.
SHEET NO.	DESCRIPTION	
1	TITLE SHEET	2
2, 3	TYPICAL SECTIONS	4, 7
4, 5	PLAN AND PROFILE	13, 14
6	PROFILE - VINEYARD BOULEVARD	18
7, 8	DETAIL PLAN OF ROADWAY	26, 27
9	CONSTRUCTION PHASES	36
10	C.R.M. RET. WALL NOS. 1, 2 & 3	43
11, 12, 13	MISC. ROADWAY DETAILS	44, 46, 47
14, 15	PROFILES-DRIVEWAYS & SIDE LANES	49, 51
16-23	STANDARD DETAILS - HIGHWAY	52-59
24, 25	BORING LOG	69, 70
26-34	DRAINAGE SYSTEM	77-80
35, 36	RELOC. & REHAB. OF BLDGS. & IMPROVEMENTS	83, 85-88
37-42	UTILITIES- WATER	95, 96
43-47	UTILITIES- SEWER	112, 113
48-55	UTILITIES- ELECTRIC AND TELEPHONE	117-120
56	UTILITIES- GAS	122, 123
57-60	HIGHWAY LIGHTING SYSTEM	127-129
61-63	TRAFFIC SIGNAL SYSTEM	131, 141, 142, 148
64	TRAFFIC SIGNS	149, 151-153
65	DETAIL OF SOLID ALUMINUM SIGN PANEL	155
66-77	STANDARD DETAILS-TRAFFIC SIGNS	160, 161, 163, 164
78-80	LANDSCAPE & SPRINKLER	165, 167, 168
81-84	CROSS SECTIONS	171
85-88	STANDARD DETAILS-BRIDGE	179
		184-195
		201, 202, 209
		219-222
		280-283

STATE OF HAWAII
DEPARTMENT OF TRANSPORTATION
HIGHWAYS DIVISION

"AS BUILT" PLANS OF
VINEYARD BOULEVARD
AULD LANE TO PALAMA STREET
FEDERAL AID PROJECT NO. U-098-1(4)

DISTRICT OF HONOLULU
ISLAND OF OAHU

SCALES


PLAN 1" = 50'-0"
PROFILE HOR. 1" = 50'-0"
VER. 1" = 10'-0"
CROSS SECTION HOR. 1" = 10'-0"
VER. 1" = 10'-0"

NOTE:

ALL CHANGES MADE DURING
CONSTRUCTION HAVE BEEN NOTED
IN RED ON THESE TRACINGS AND
CHECKED BY:

Ronald T. Sasaki
PROJECT ENGINEER

10/30/68
DATE

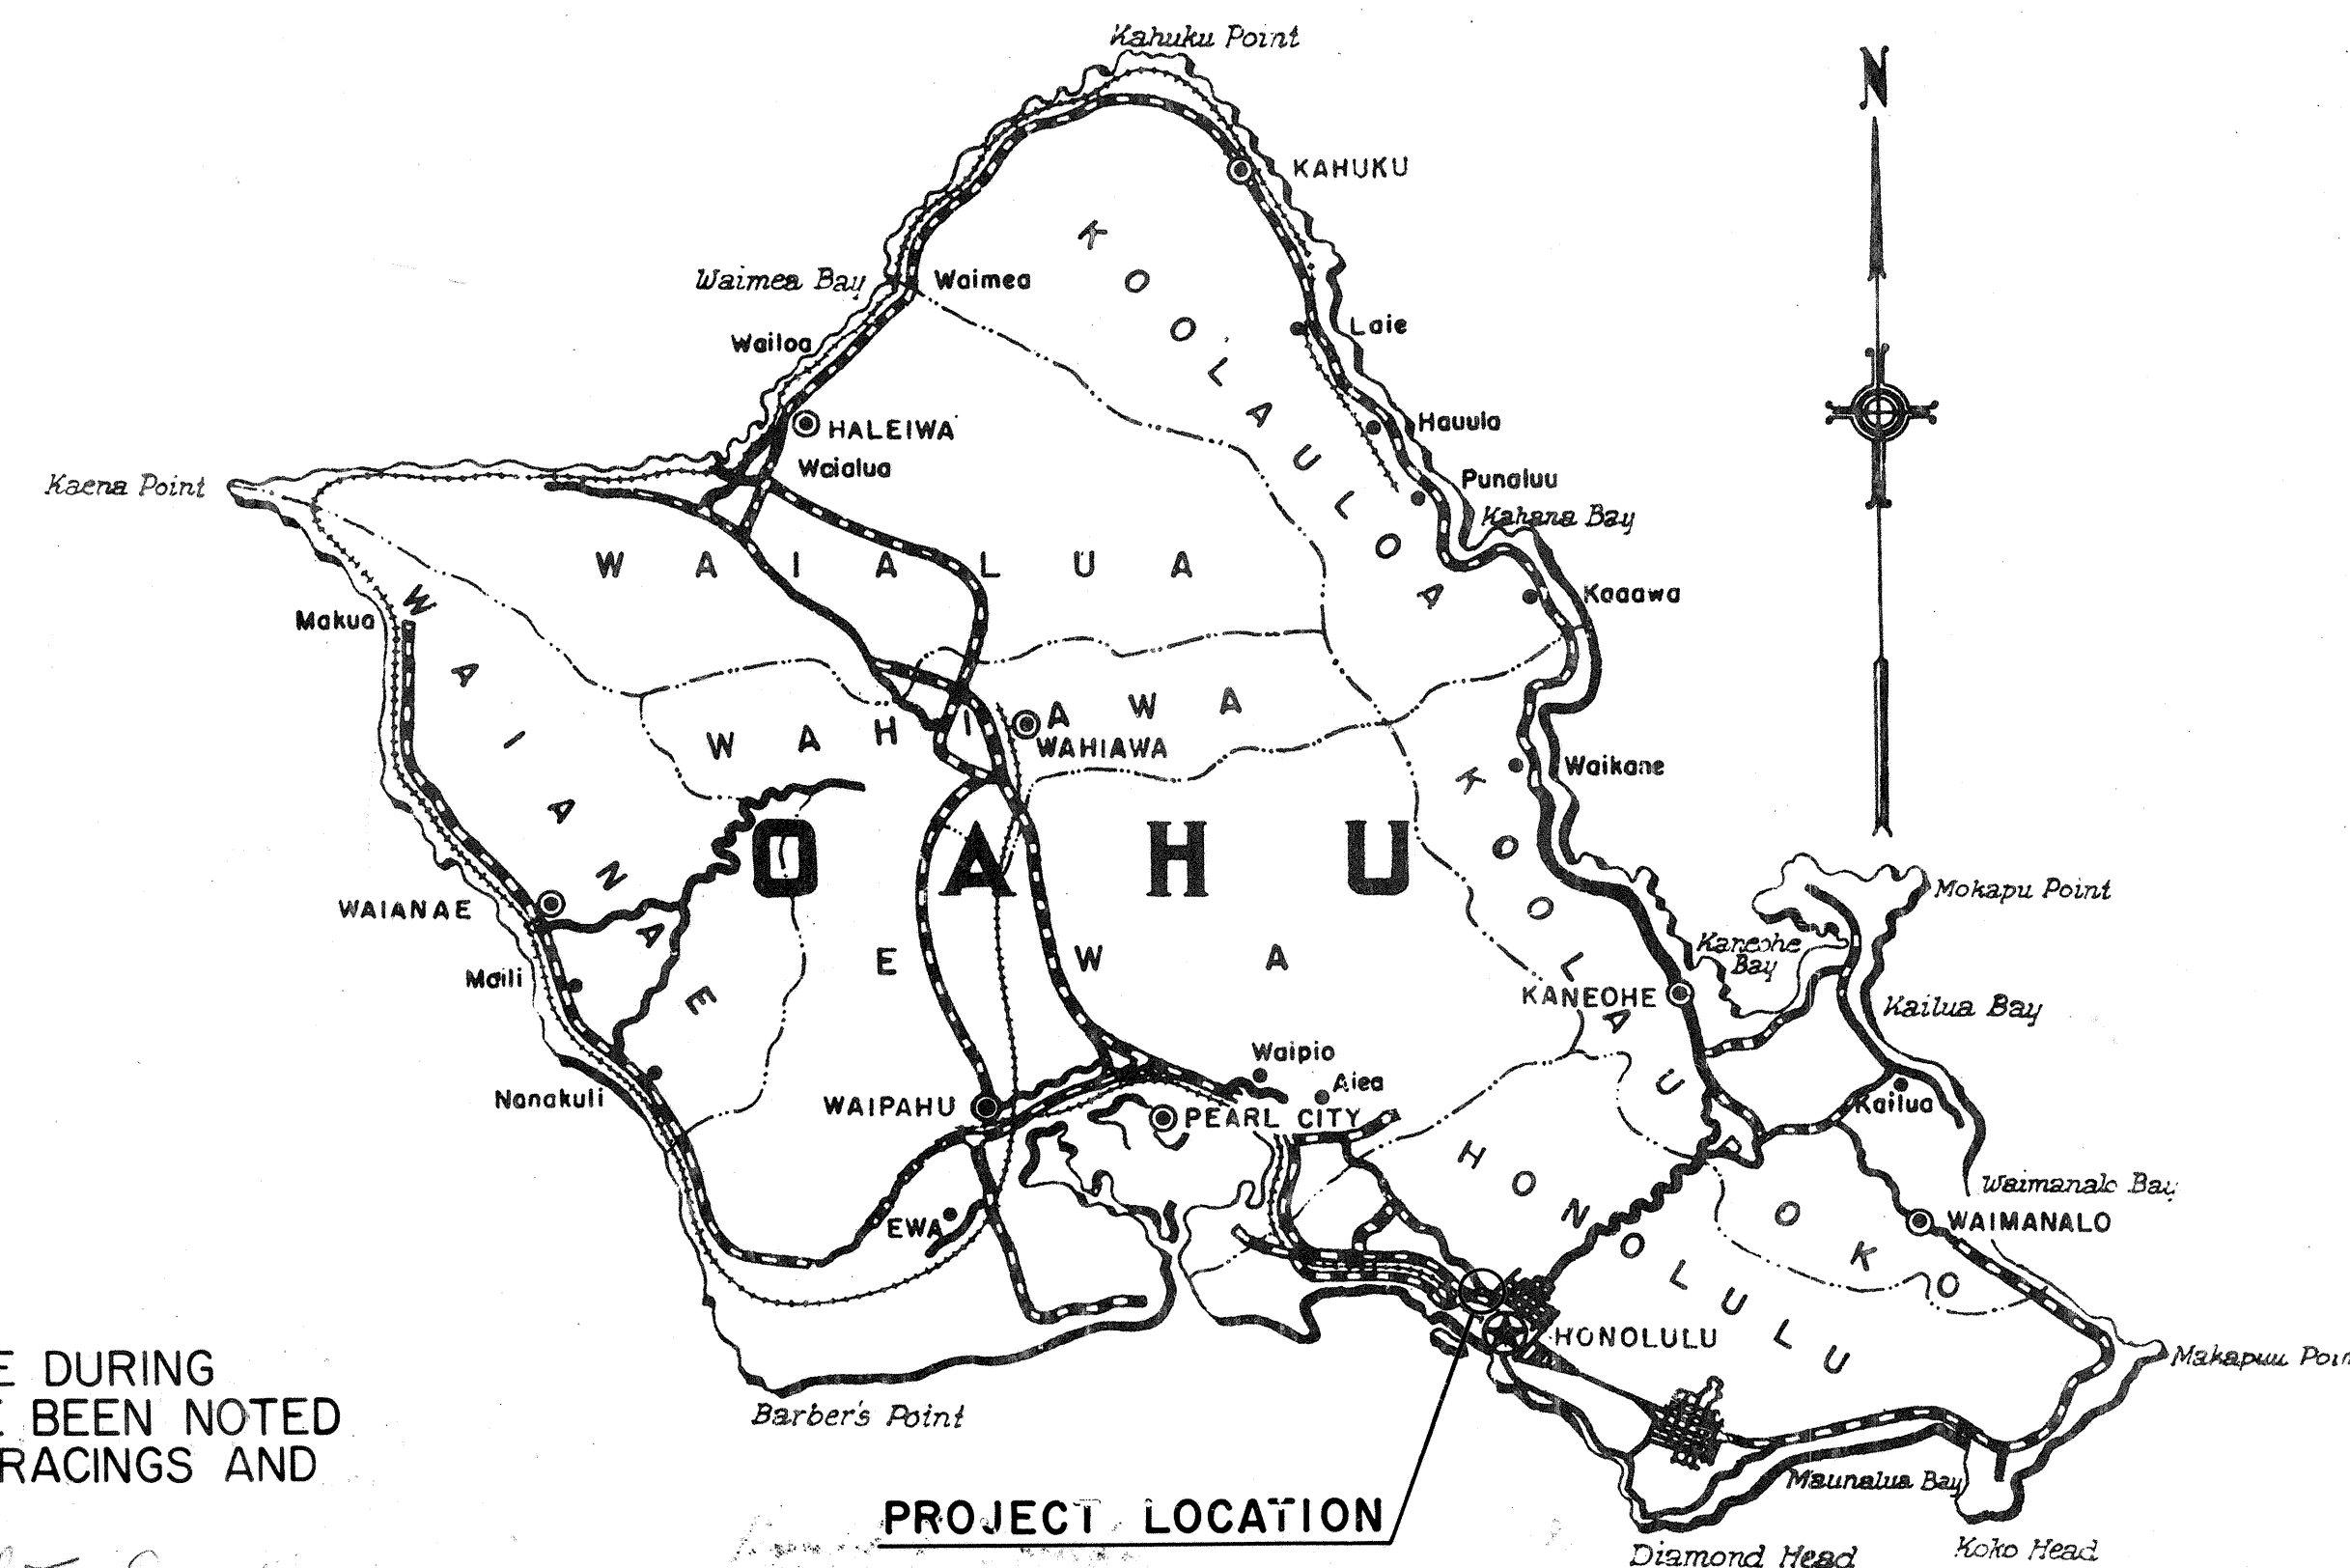

Federal Aid Projects Previously Constructed Or Under Construction

BELT, COLLINS & ASSOCIATES, LTD.
Civil and Structural Engineers

• ASSOCIATES •

MOFFATT, NICHOL & TAYLOR - Structural Engineers

WALTER P. THOMPSON - Surveyor

PAUL R. WEISSICH - Landscape Architect

WYNN NAKAMURA - Electrical Engineer

DESIGN CLASSIFICATION

ADT (1962) 23,584
DESIGN ADT (1983) ... 15,500
DHV 11%
D 55/45
T 2%

APPROVED:

DATE 4/18/63


Luis Hatanaka
DIRECTOR OF TRANSPORTATION

APPROVED:

DIVISION ENGINEER DATE

DEPARTMENT OF COMMERCE
BUREAU OF PUBLIC ROADS

LAYOUT PLAN

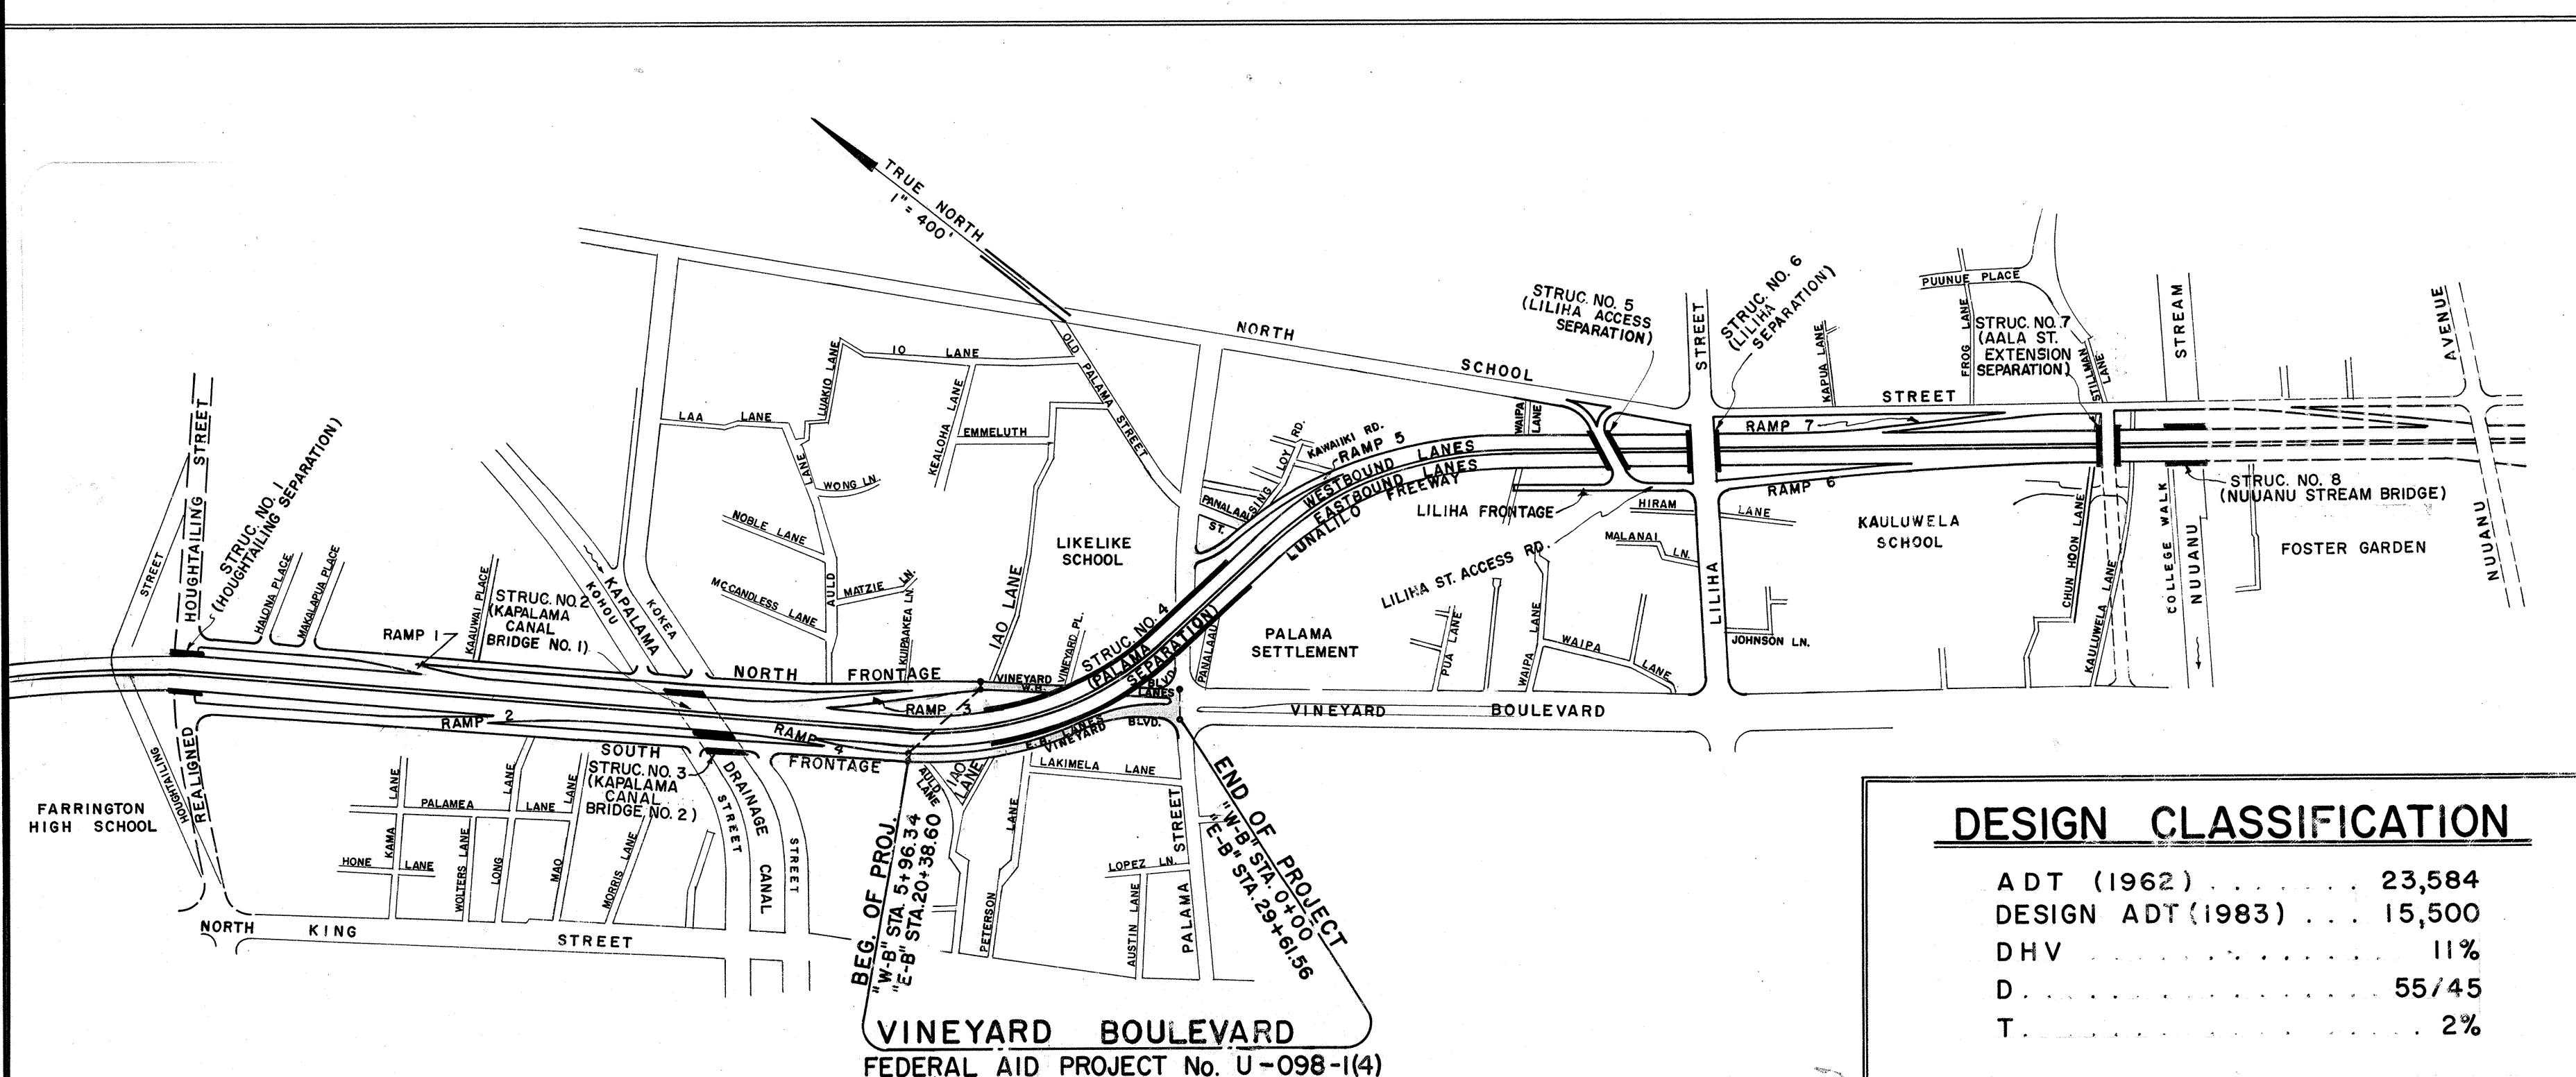

GRAPHIC SCALE
400 0 400 800

GROSS AND NET LENGTH OF PROJECT. 0.1439 MILE