


FED. ROAD DIST. NO.	STATE	FED. AID PROJ. NO.	FISCAL YEAR	SHEET NO.	TOTAL SHEETS
HAWAII	HAW.	U-072-1(3)	1963	127	246
		U-028-1(4)	1963	50	88

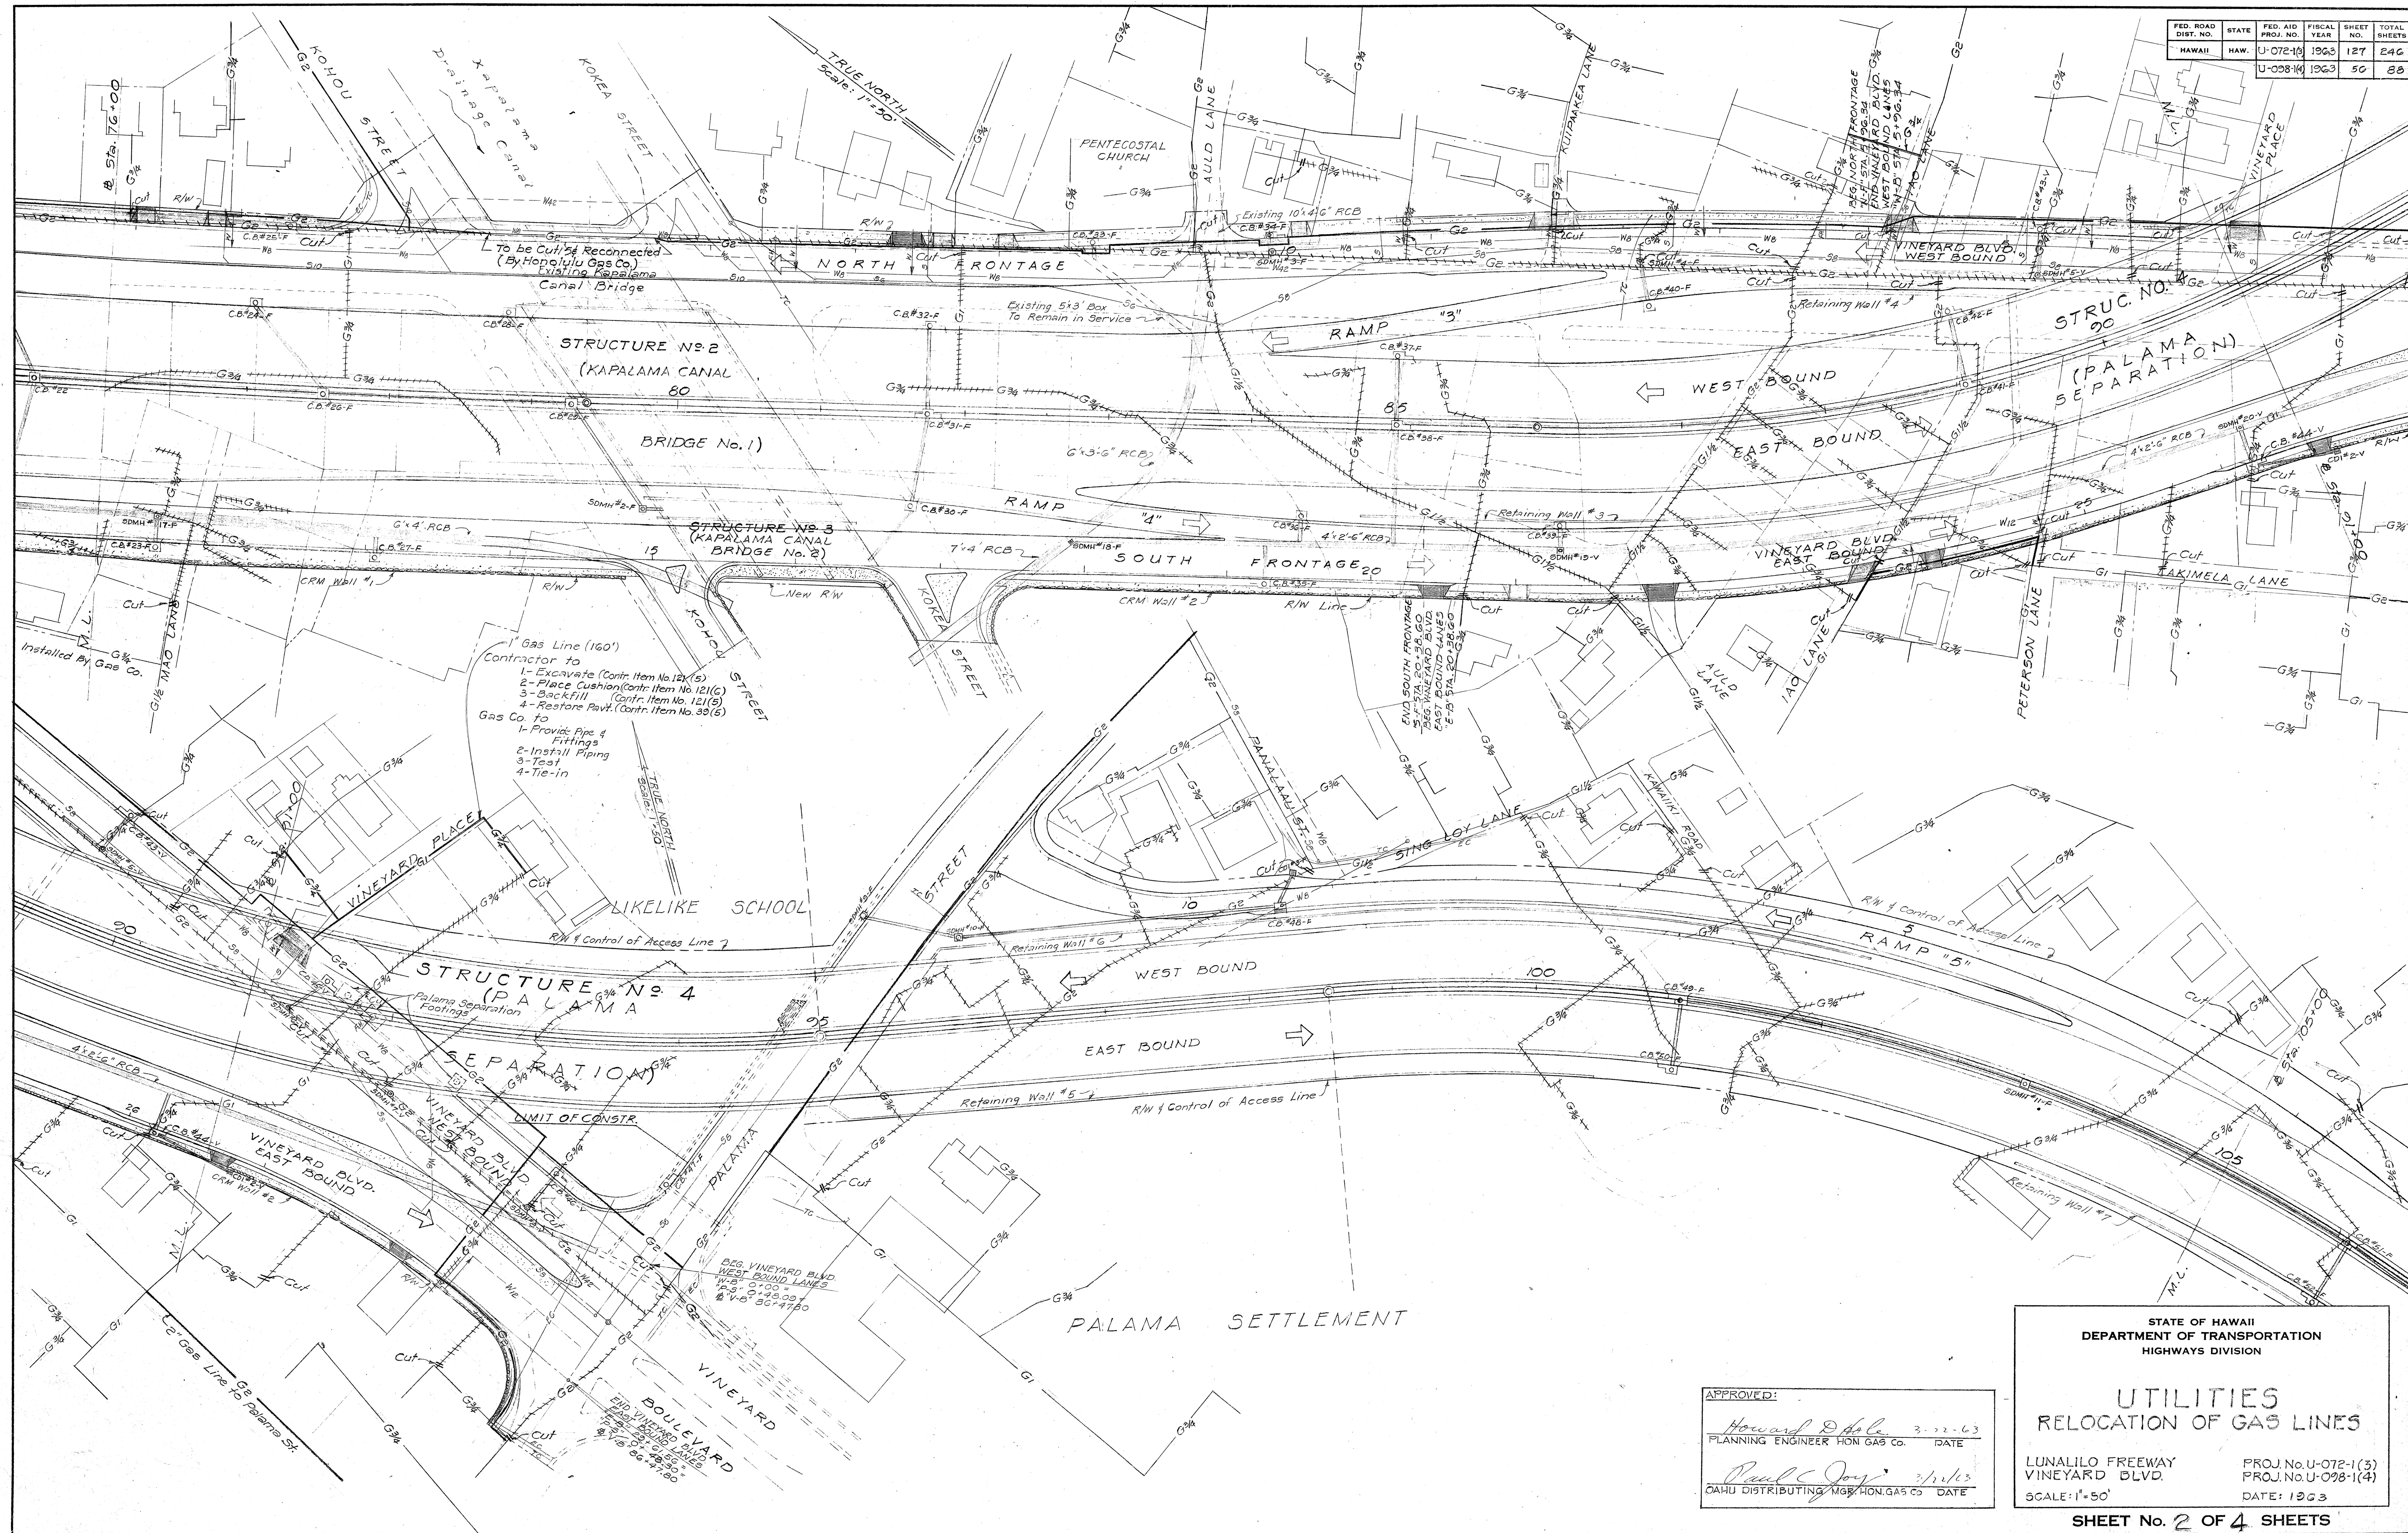

ORIGINAL PLAN	DATE
DRAWN BY	
DESIGNED BY	
NOTED BY	
CHECKED BY	

APPROVED:
Howard D. Hale 3-22-63
 PLANNING ENGINEER HON GAS CO. DATE
Paul C. Joy 3/21/63
 OAHU DISTRIBUTING MGR. HON GAS CO. DATE

STATE OF HAWAII
 DEPARTMENT OF TRANSPORTATION
 HIGHWAYS DIVISION
 UTILITIES
 RELOCATION OF GAS LINES
 LUNALILO FREEWAY
 VINEYARD BLVD.
 SCALE: 1"=50'
 PROJ. No. U-072-1(3)
 PROJ. No. U-028-1(4)
 DATE: 1963

SHEET No. 2 OF 4 SHEETS

U 0 9 8 1 0 4 0 0 . 5 6

U 0 7 2 1 0 3 0 0 . 1 2 7