
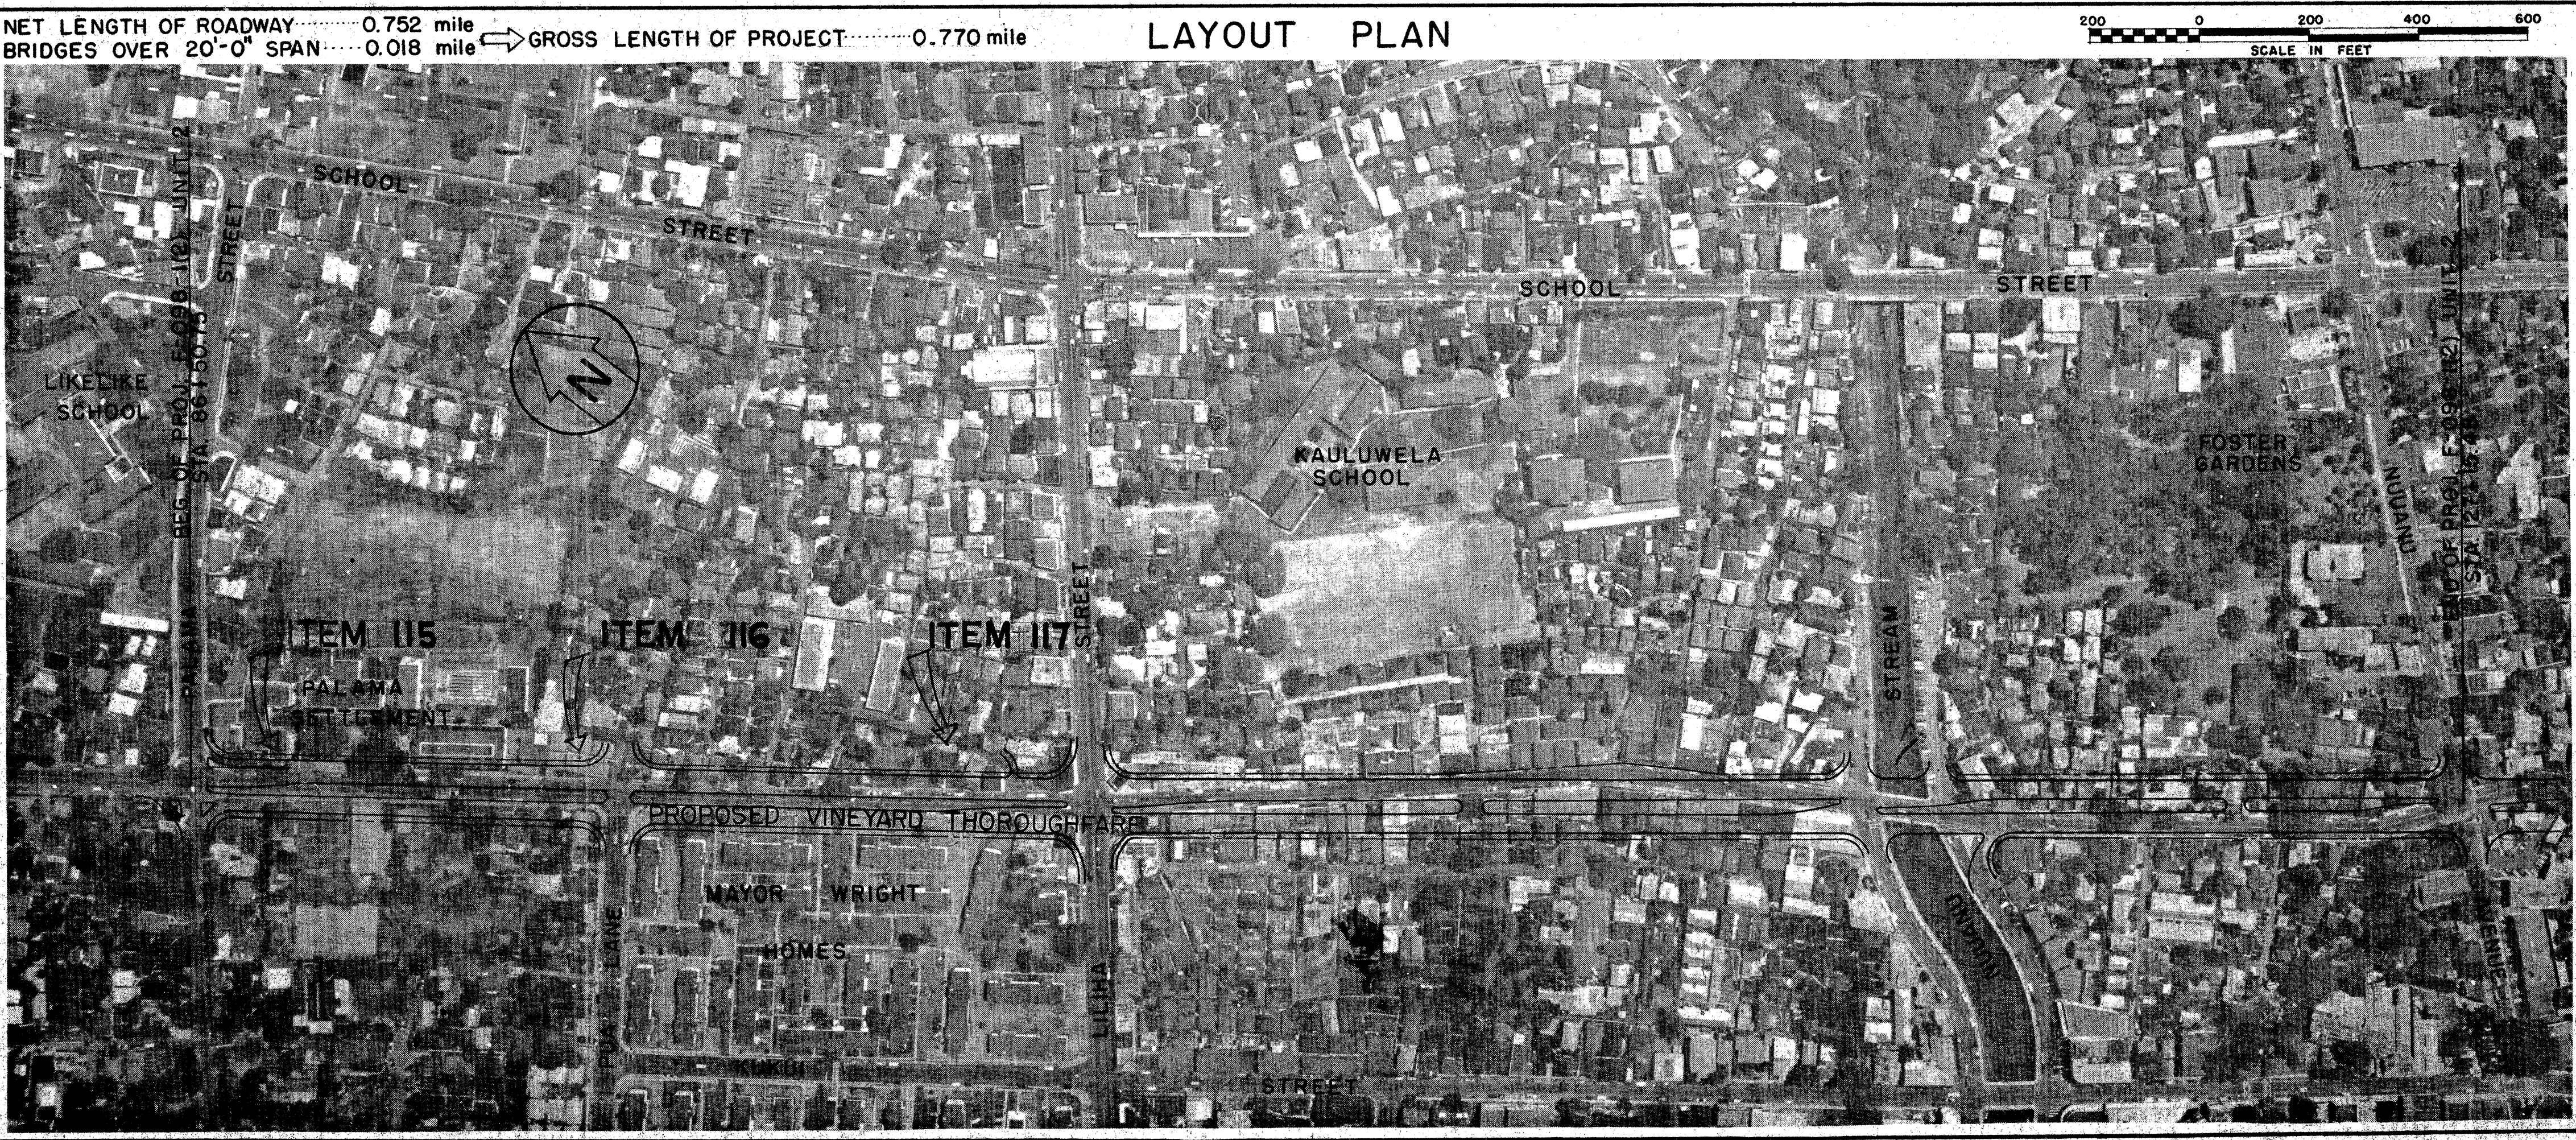


REHABILITATION OF CERTAIN BUILDINGS

VINEYARD THOROUGHFARE

PALAMA STREET TO FORT STREET

PROJECT NO. F-59 (2)

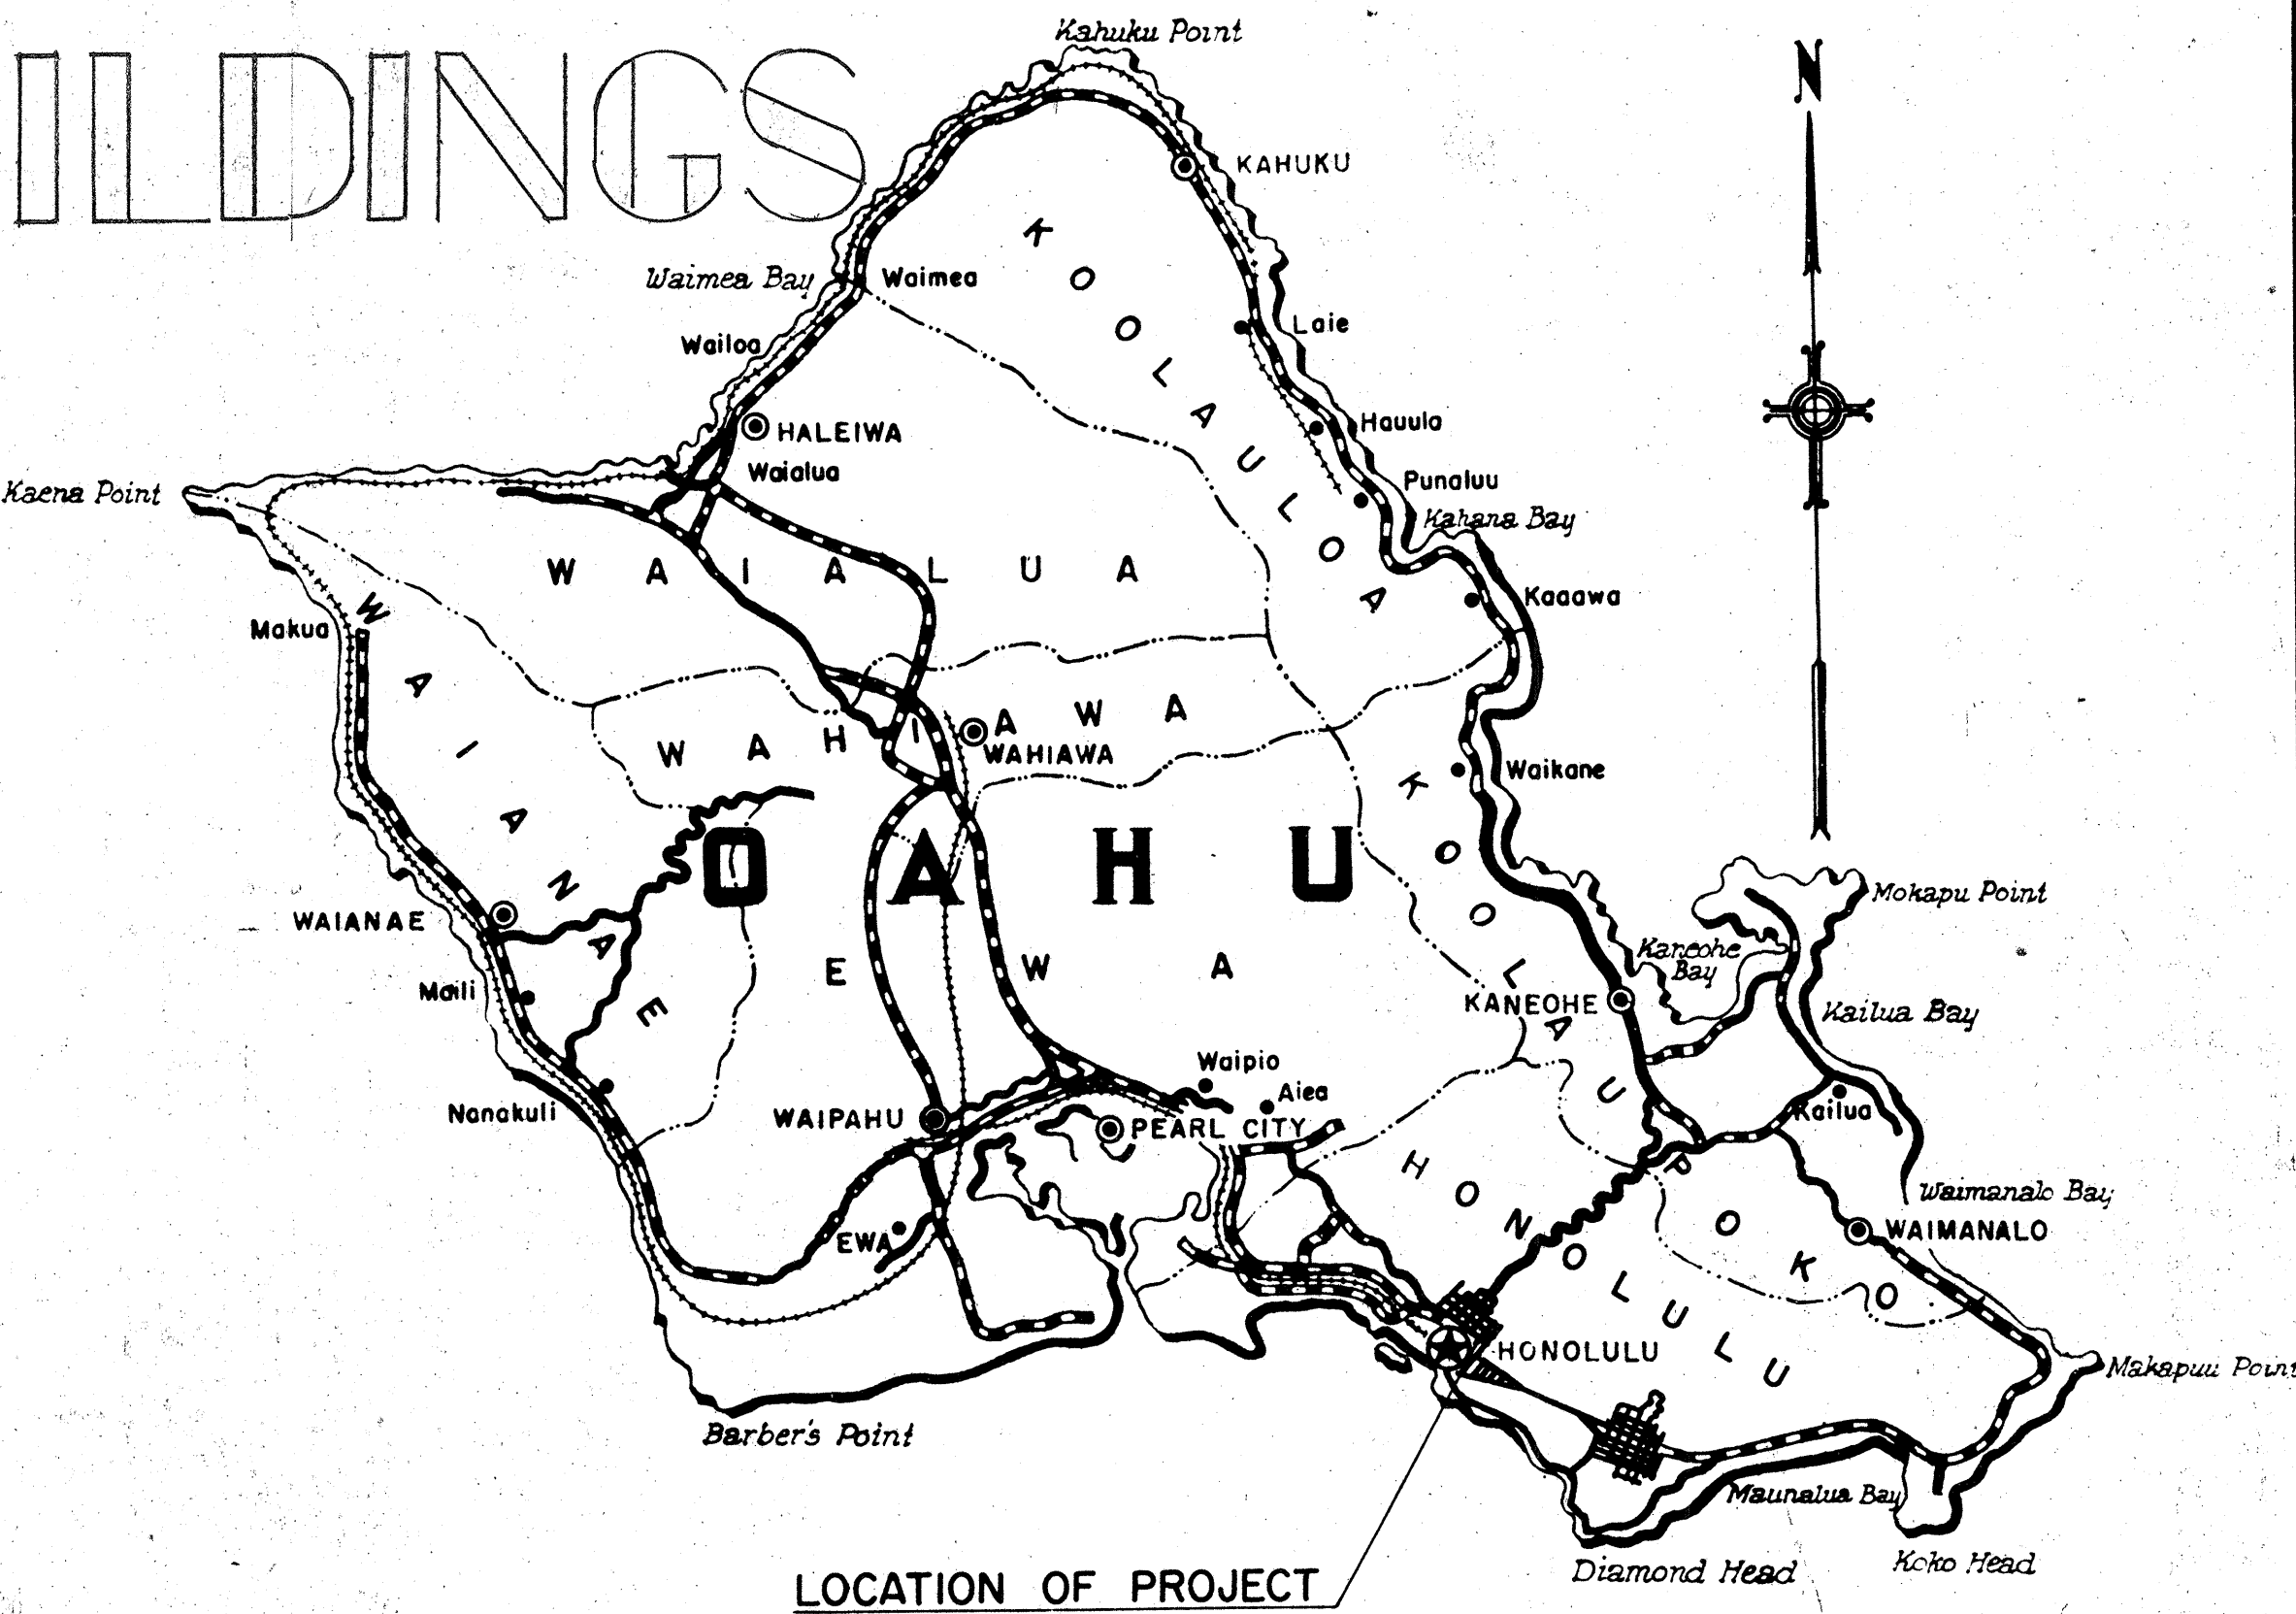

Federal Aid Projects Previously Constructed Or Under Construction

LEGEND	
ITEM 115 - PARCEL 6-	REHABILITATION TO STRONG CARTER DENTAL CLINIC BUILDING PALAMA SETTLEMENT TAX KEY 1-7-45-1
ITEM 117 - PARCEL 31-	RELOCATION OF ON TONG TUNG HEONG SOCIETY BLDG TAX KEY 1-7-32-82
ITEM 116 - PARCEL 13-	RELOCATION OF FOUR FRAME DWELLINGS TAX KEY 1-7-32-57

Approved: *Wm. Hachtler* 11/18/57
TERRITORIAL HIGHWAY ENGINEER DATE