

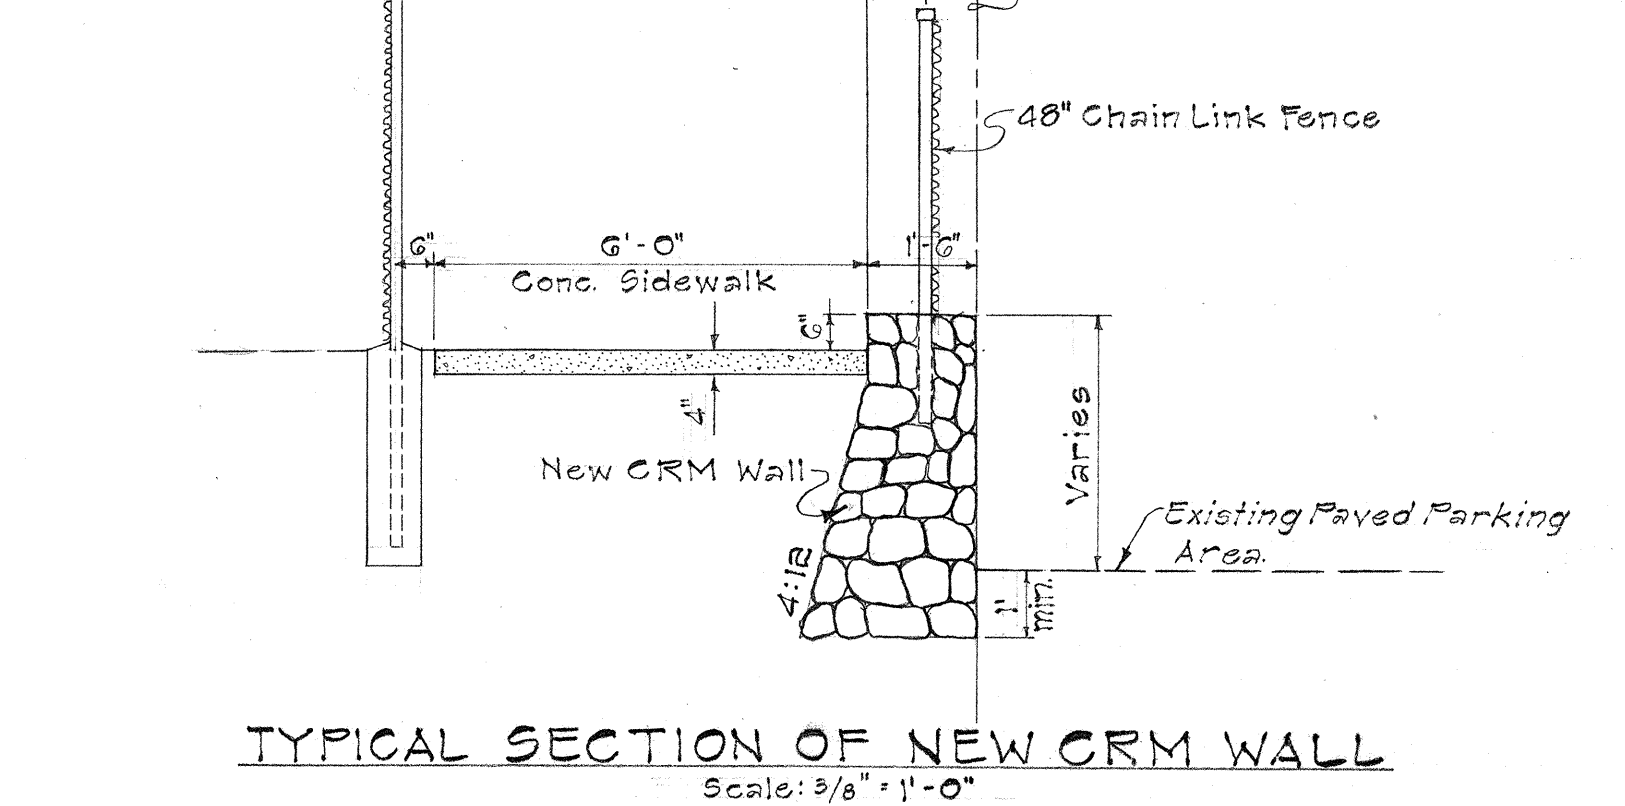
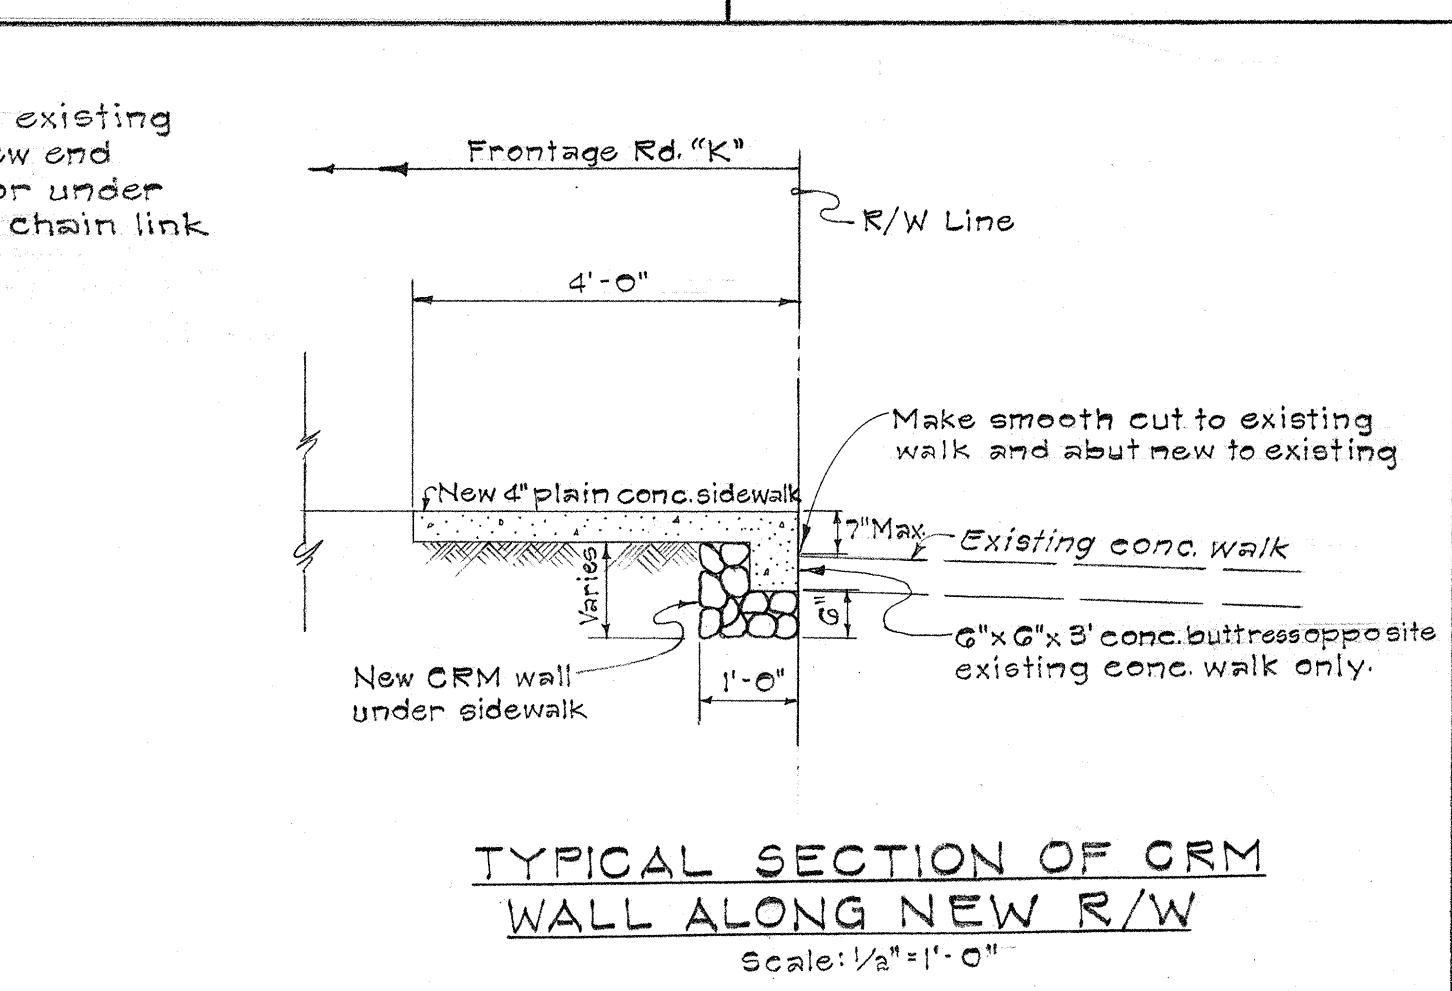
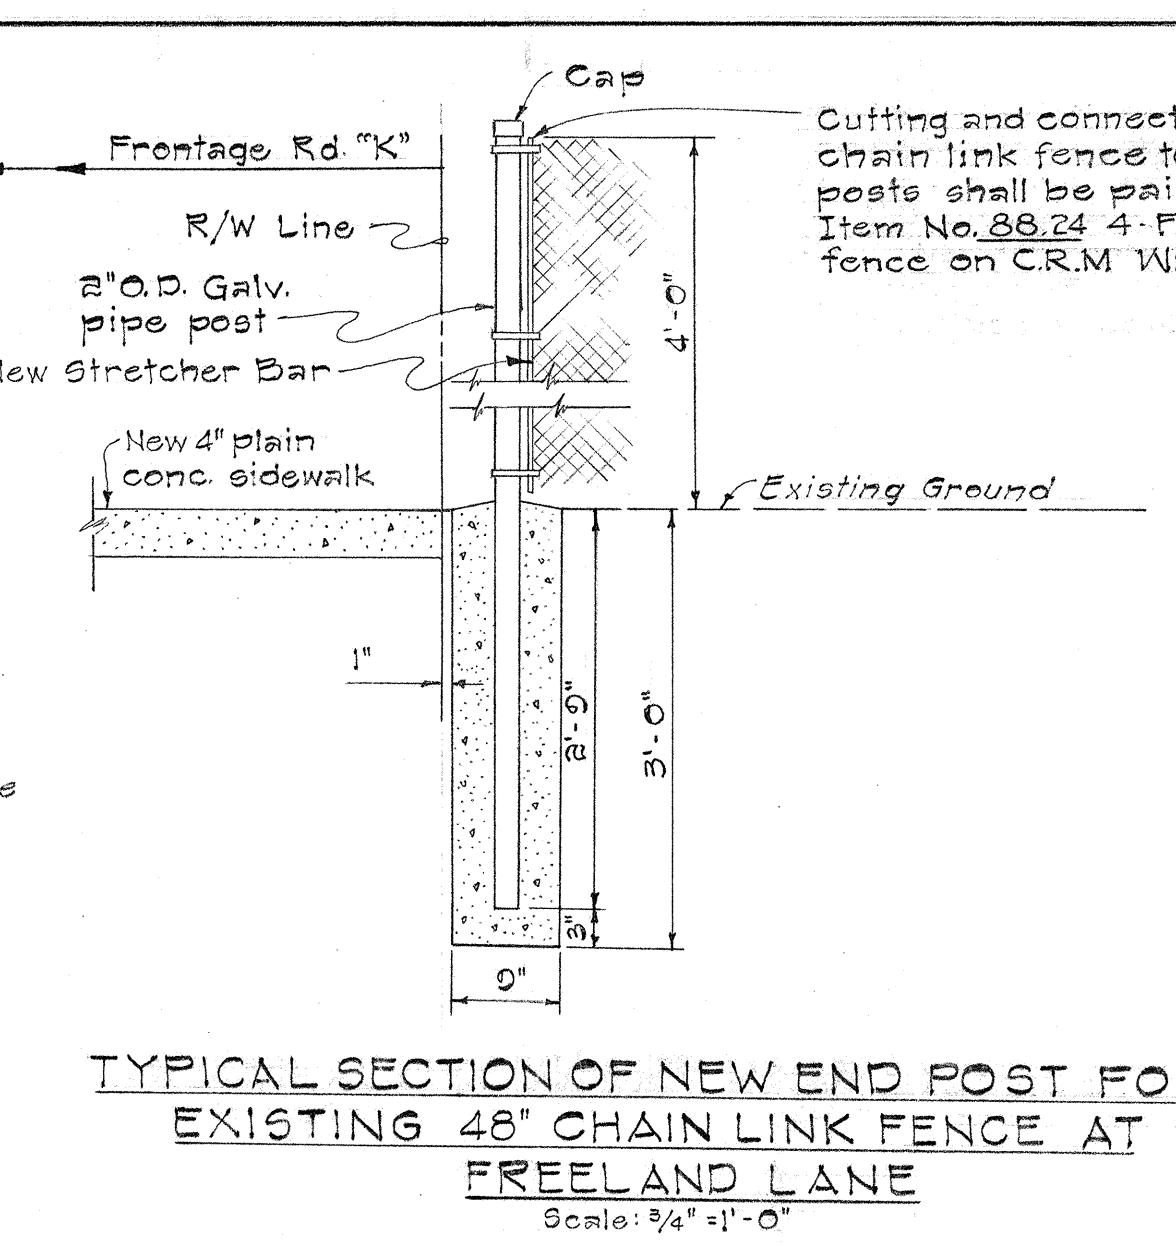
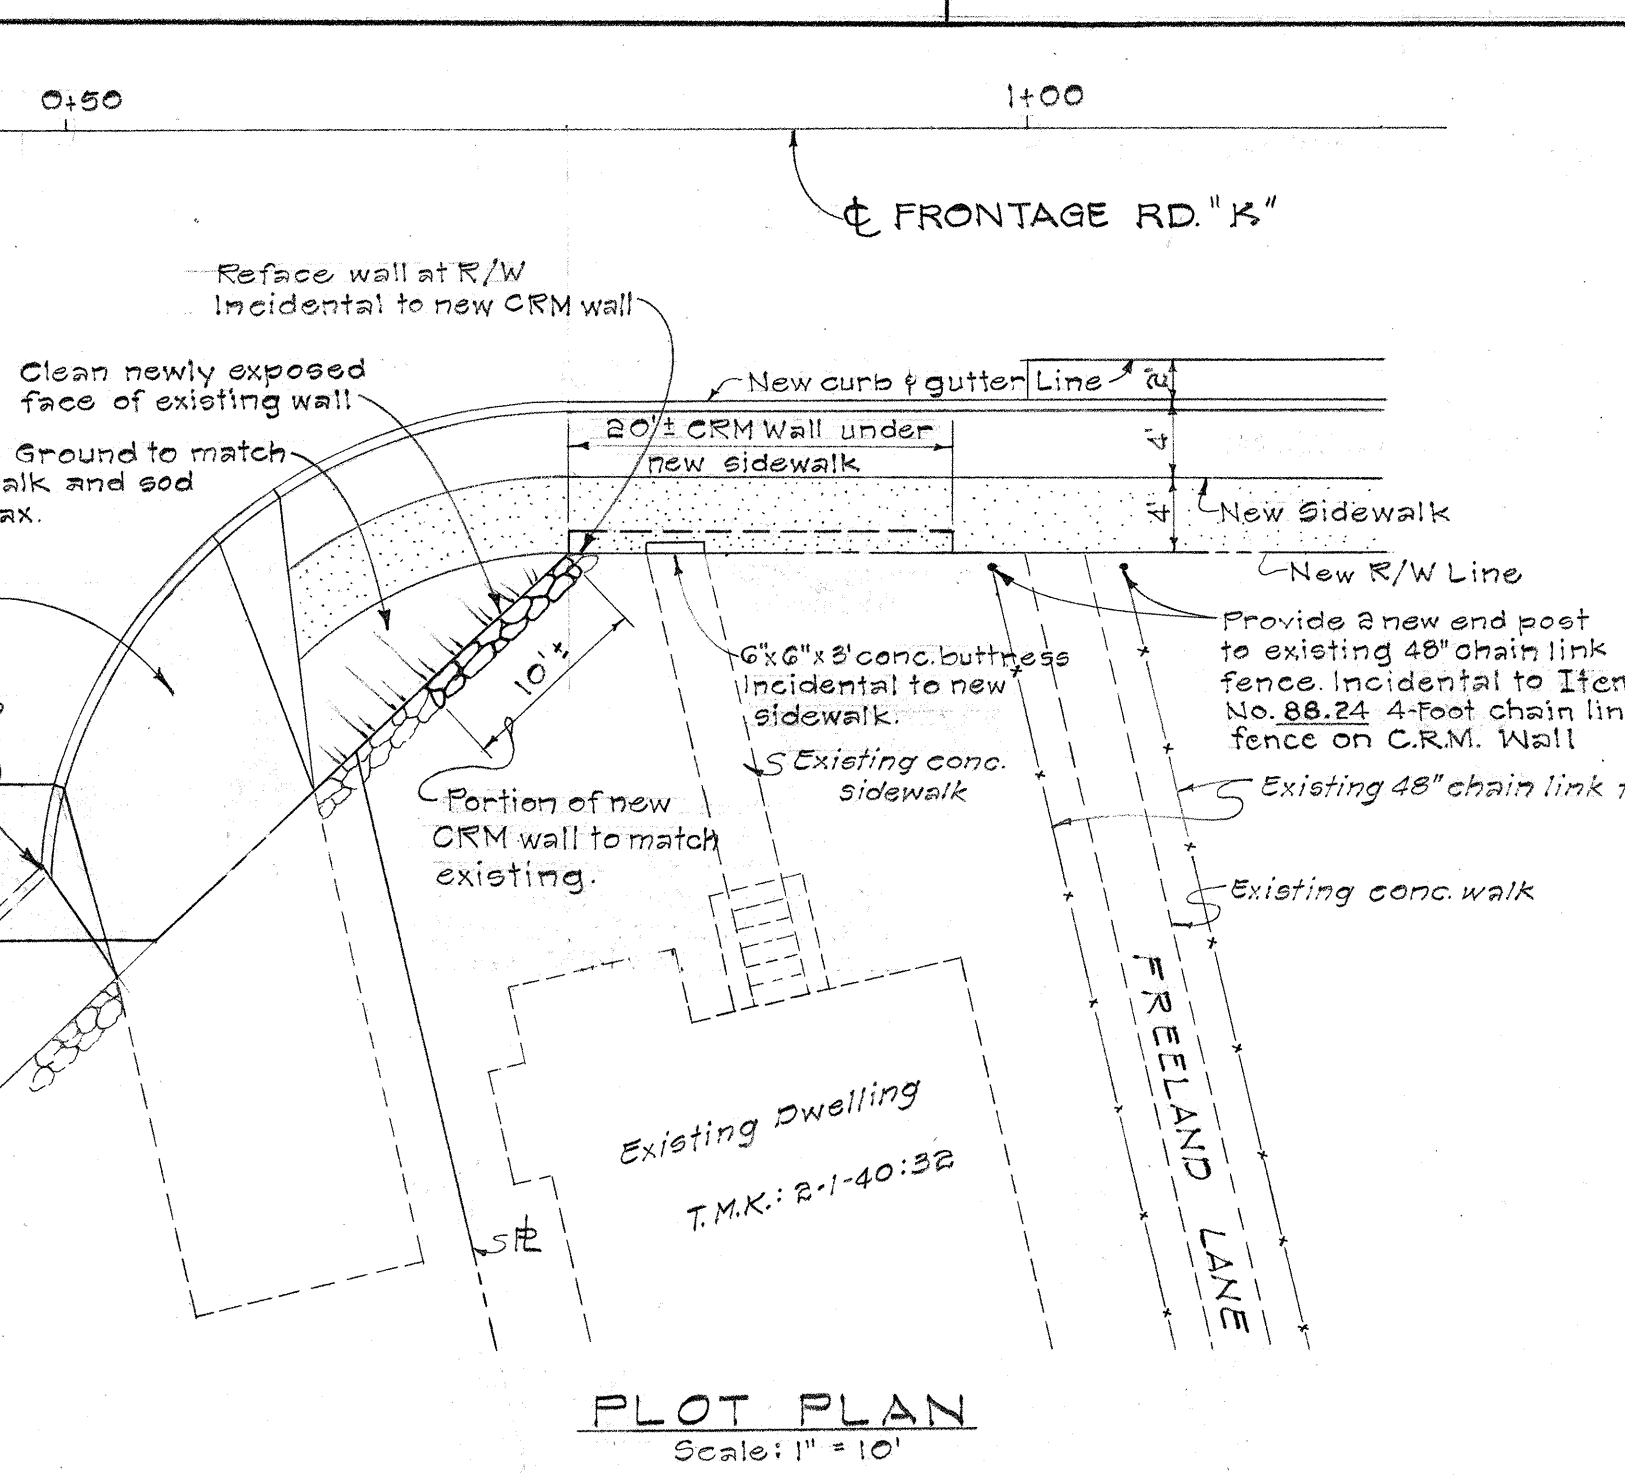
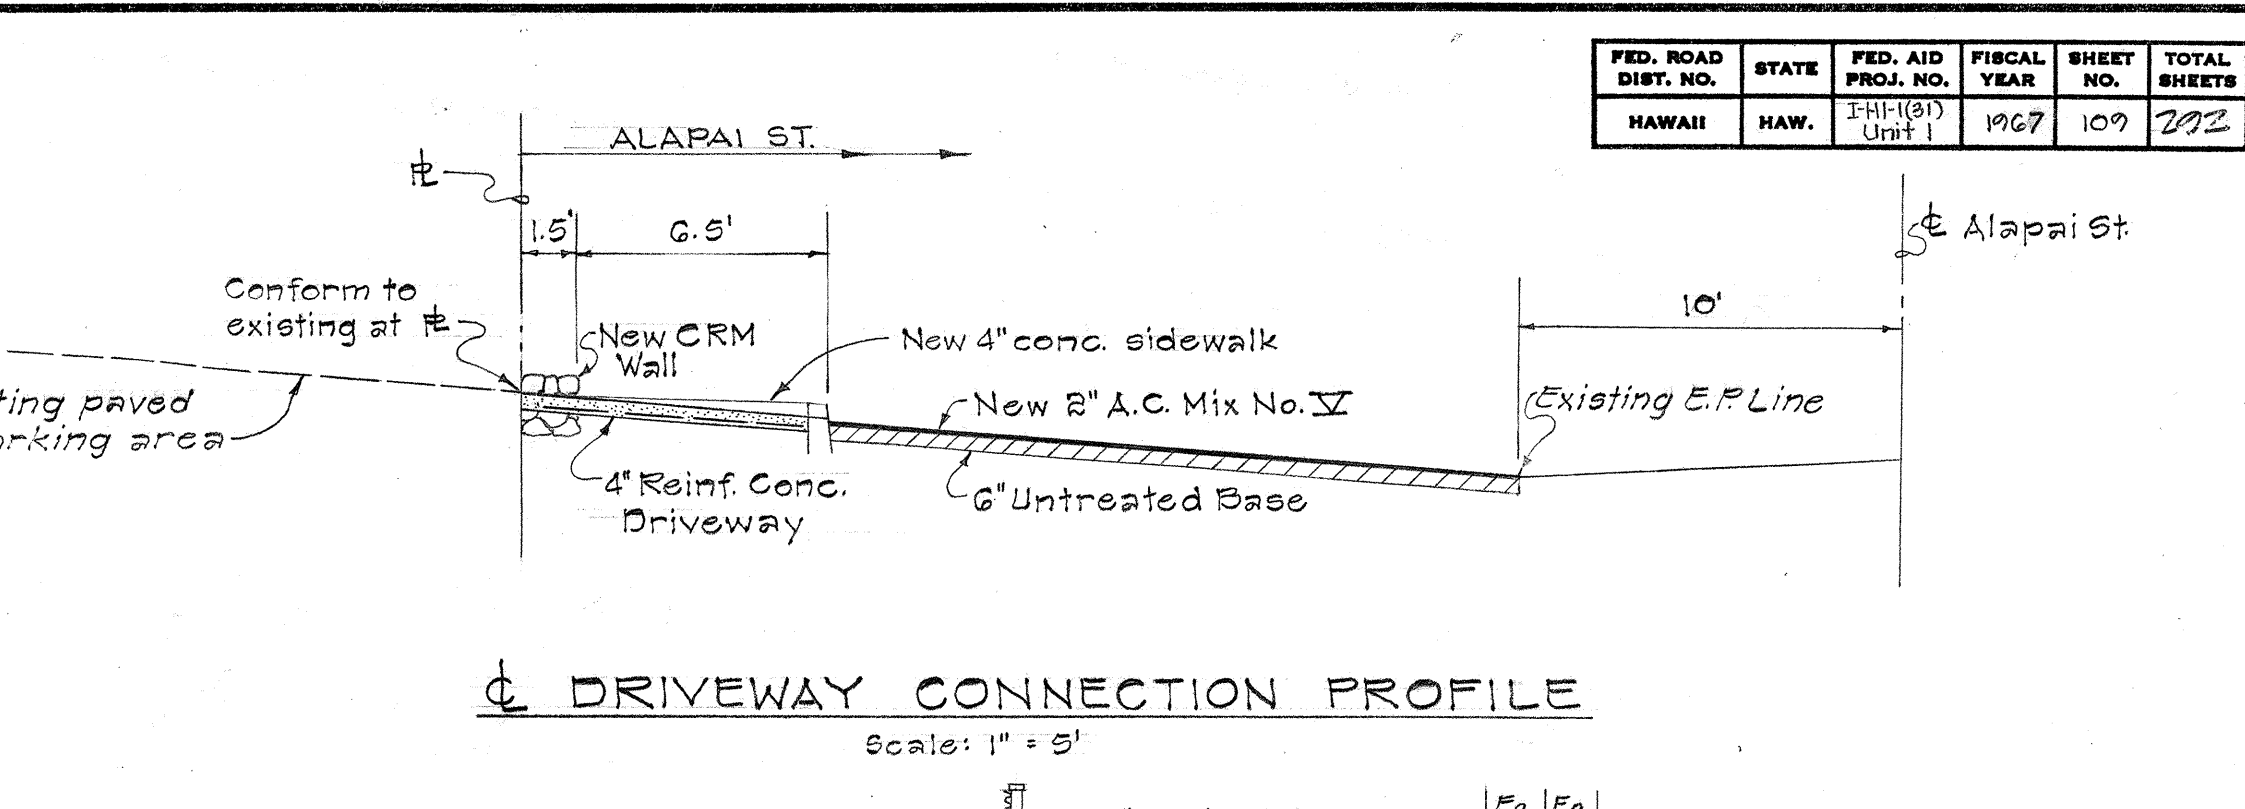
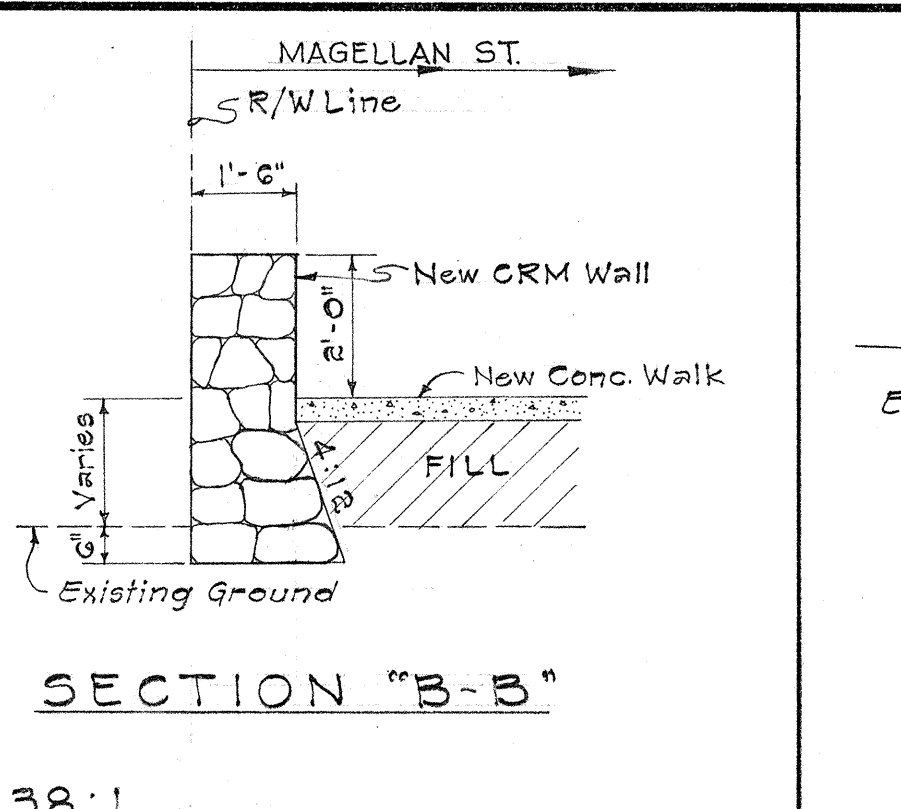
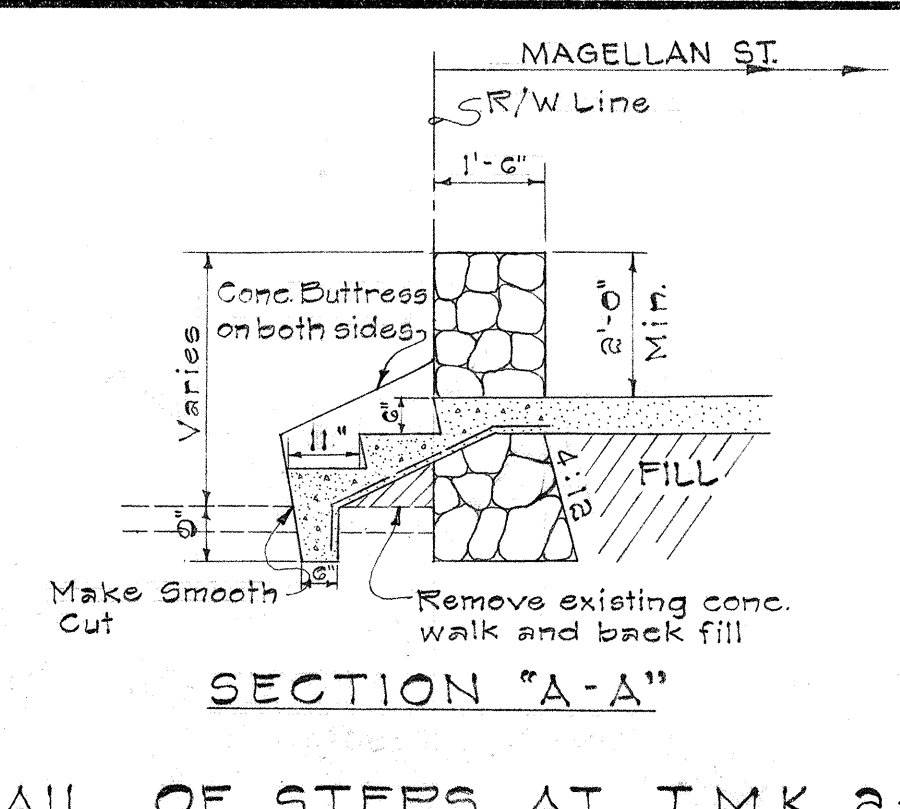
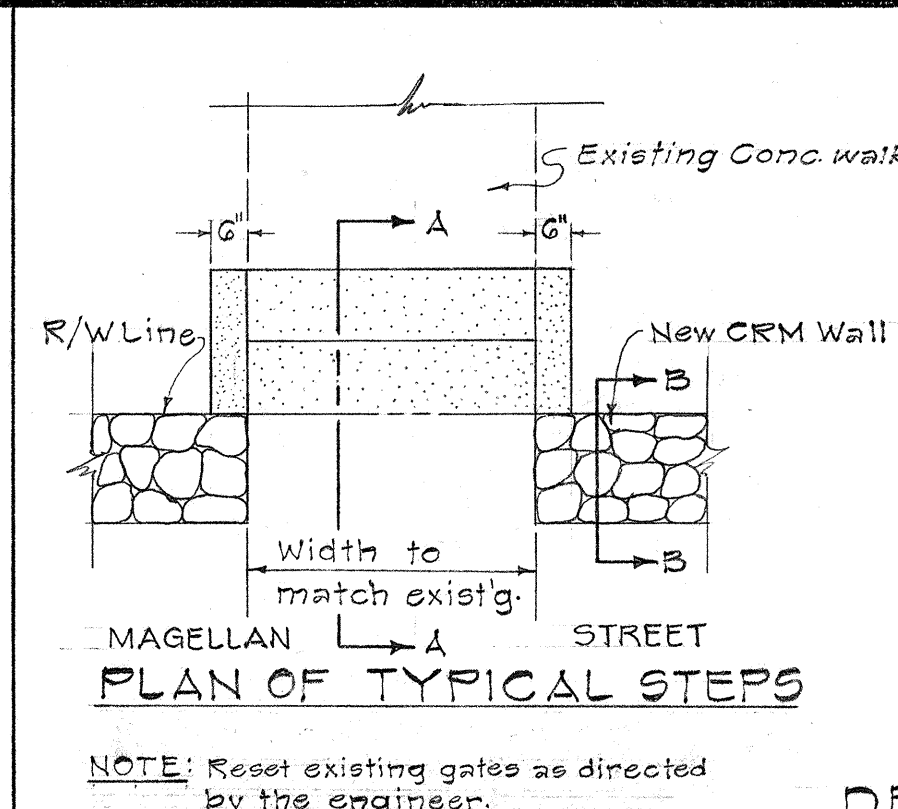
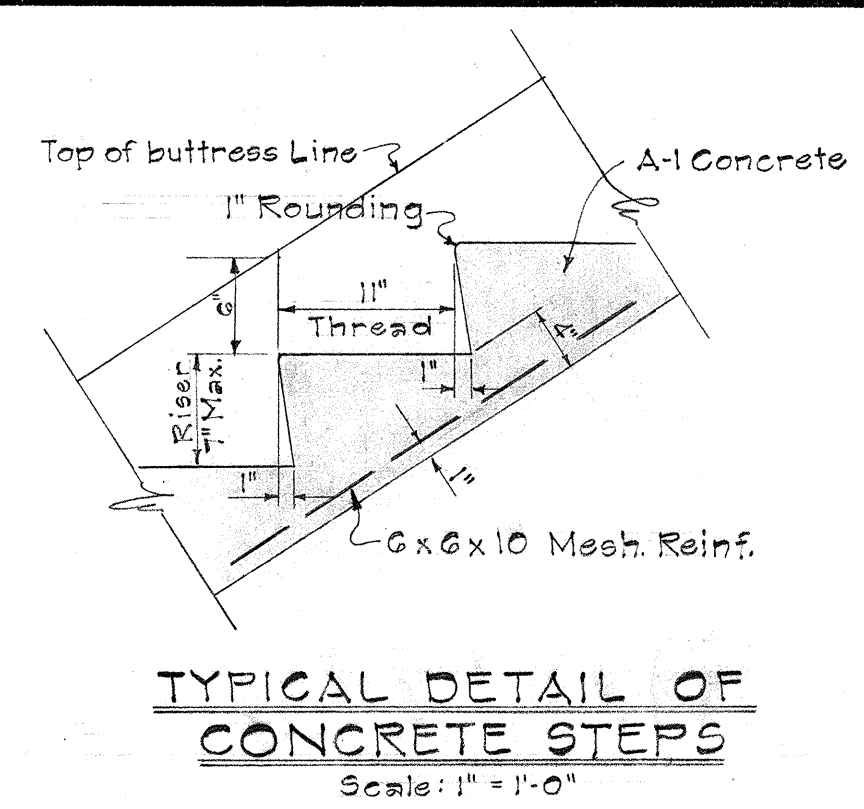
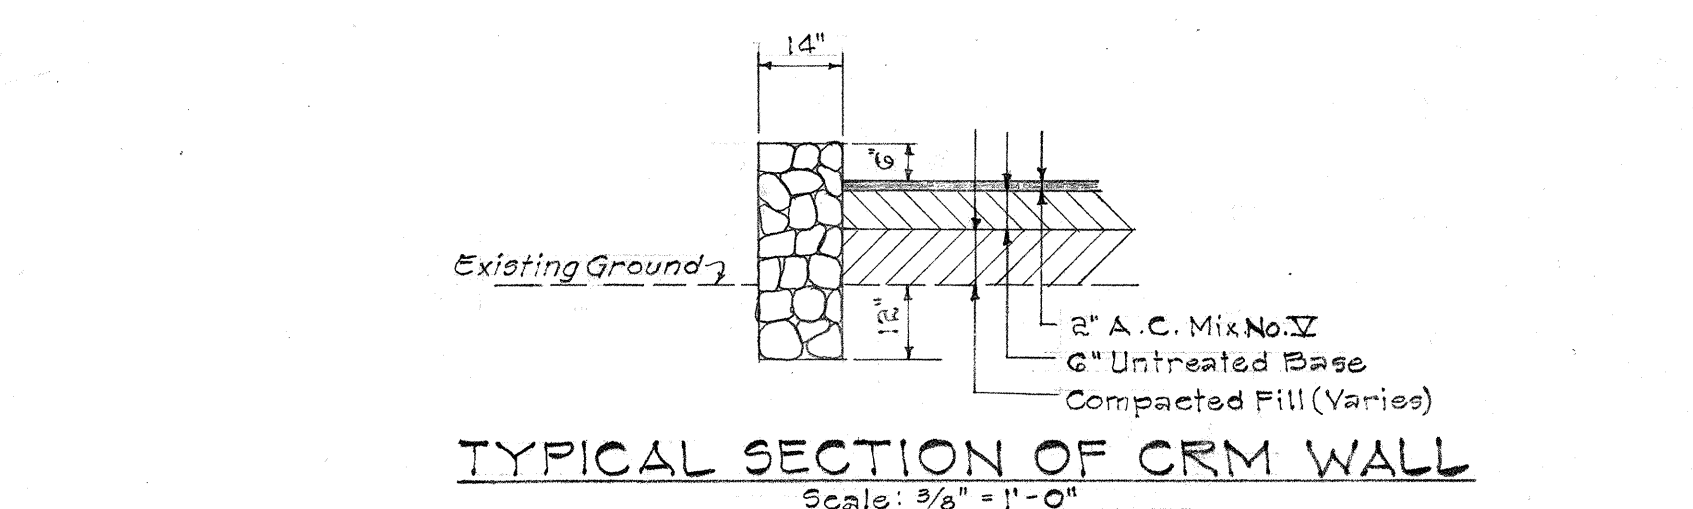






| FED. ROAD DIST. NO. | STATE | FED. AID PROJ. NO. | FISCAL YEAR | SHEET NO. | TOTAL SHEETS |
|---------------------|-------|--------------------|-------------|-----------|--------------|
| HAWAII              | HAW.  | 100-100            | 1967        | 109       | 202          |

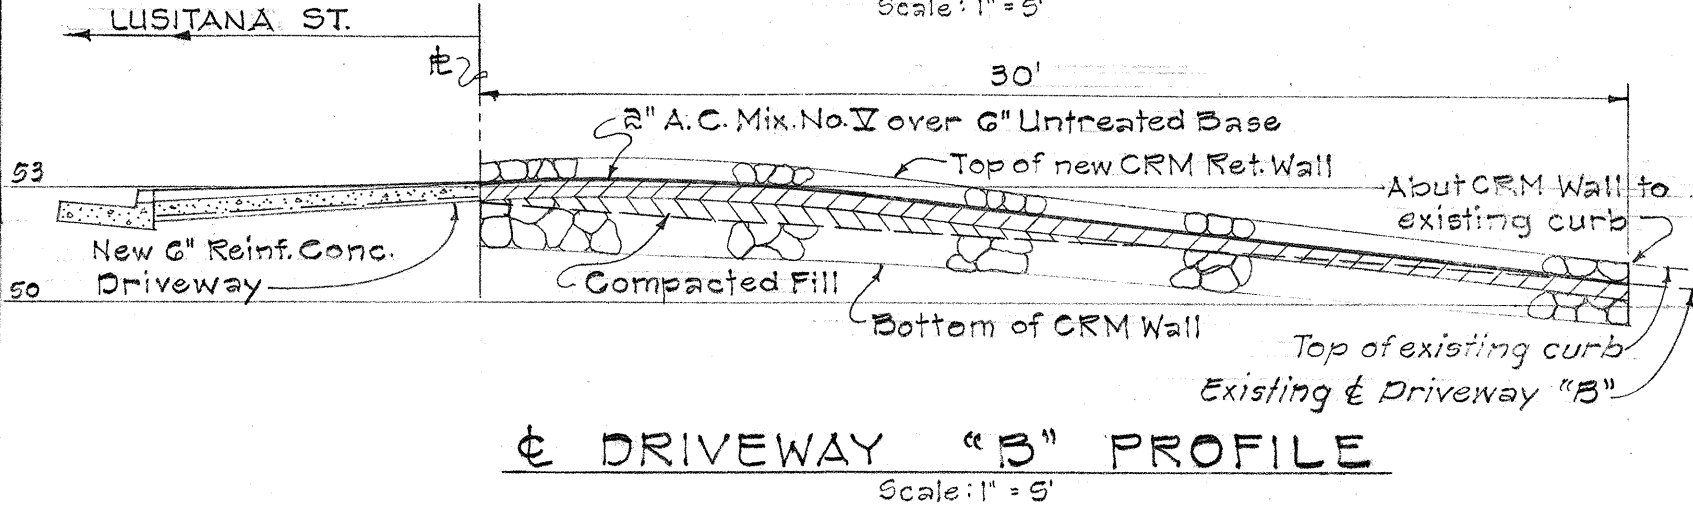

DETAIL OF R/W ADJUSTMENT AT T.M.K. 2-1-40:32

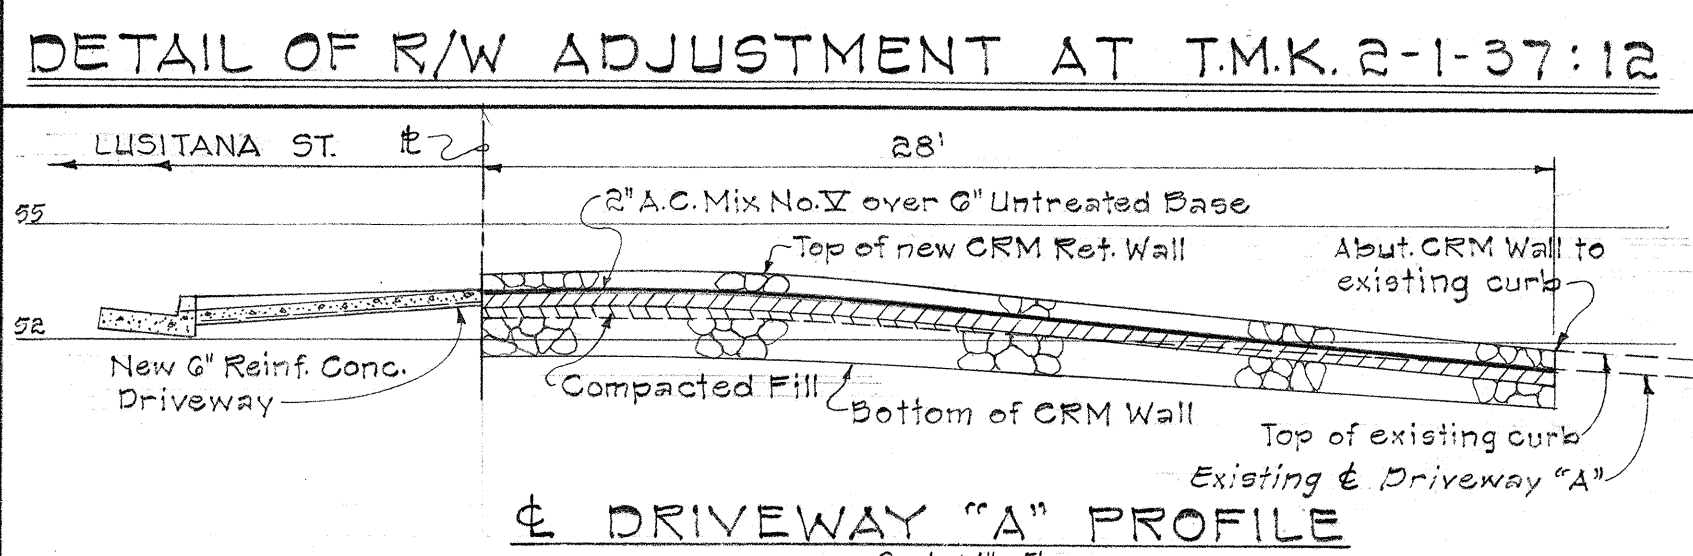

DETAIL OF R/W ADJUSTMENT AT T.M.K. 2-1-35:3

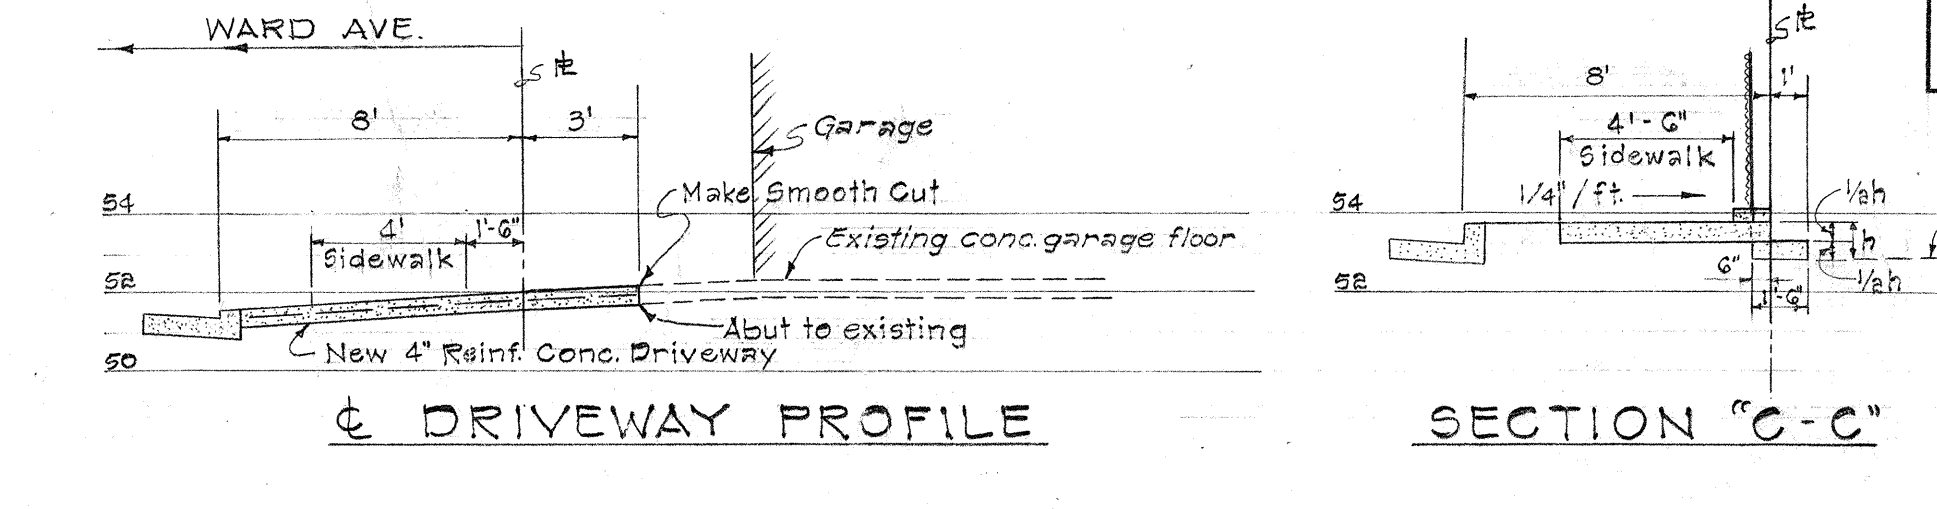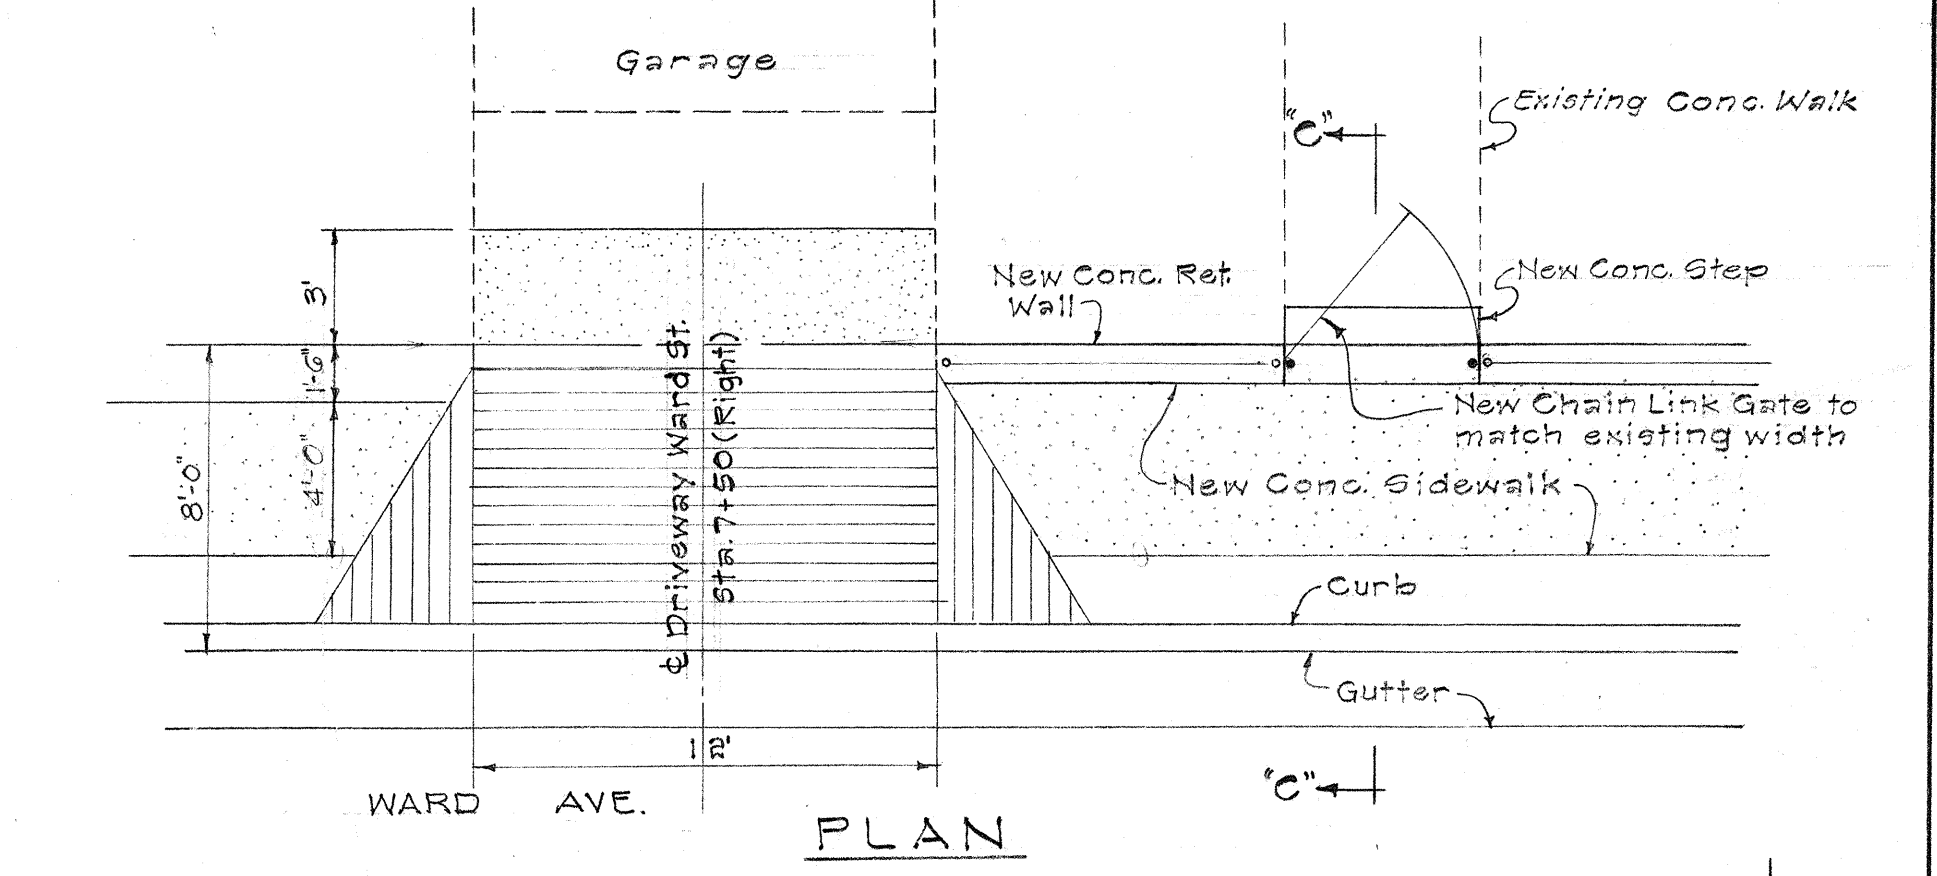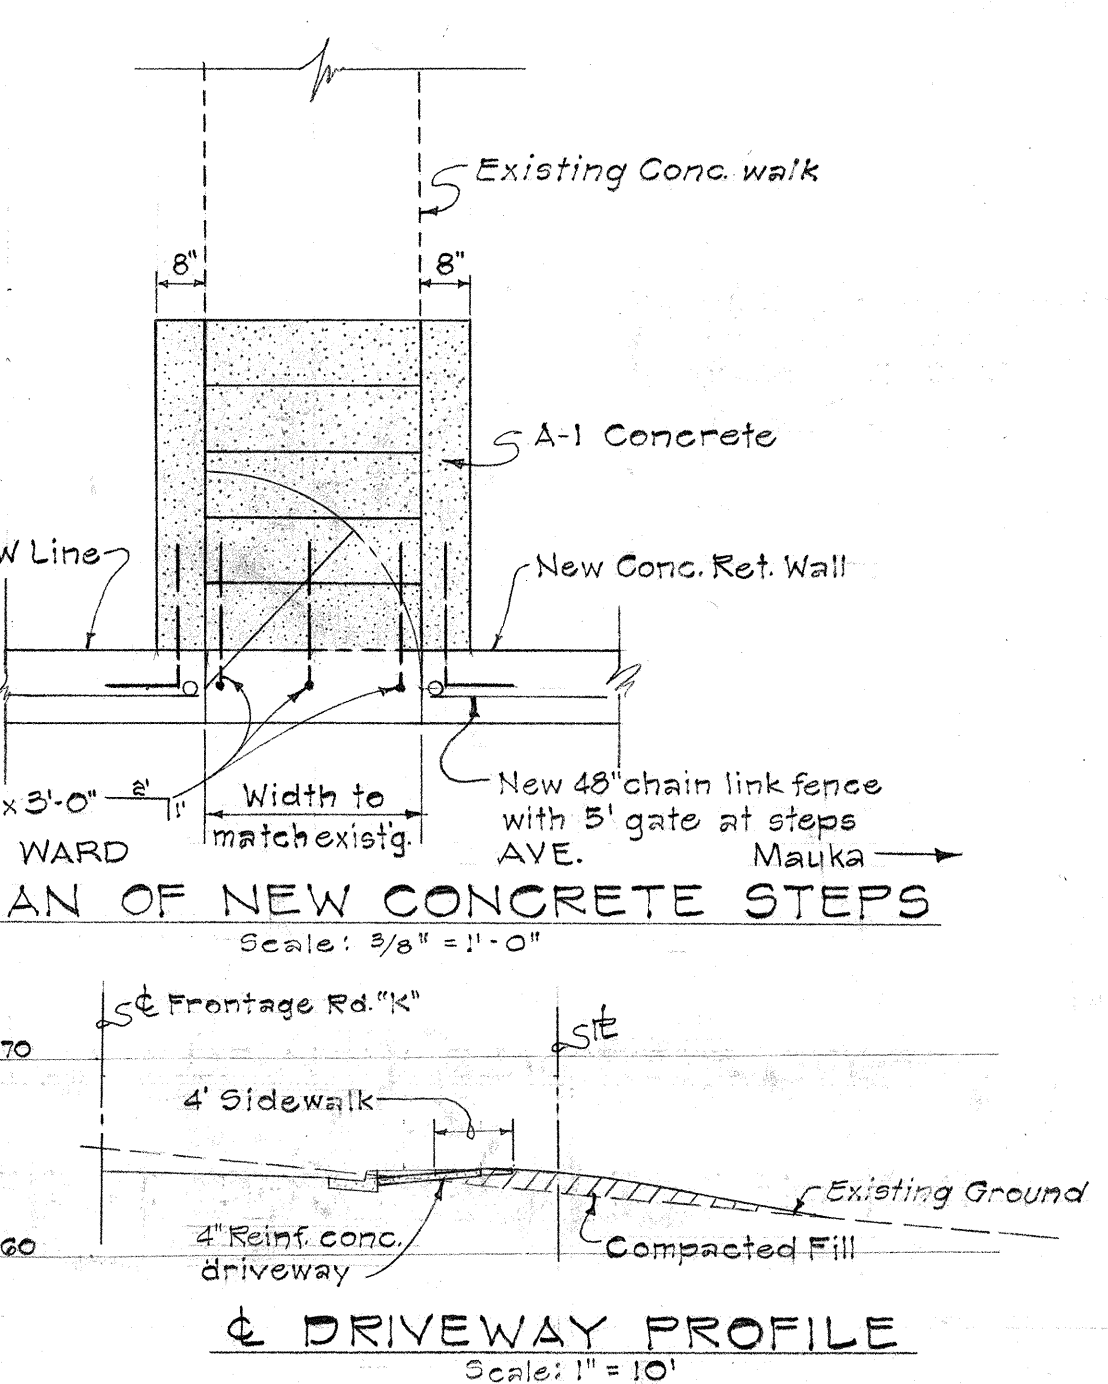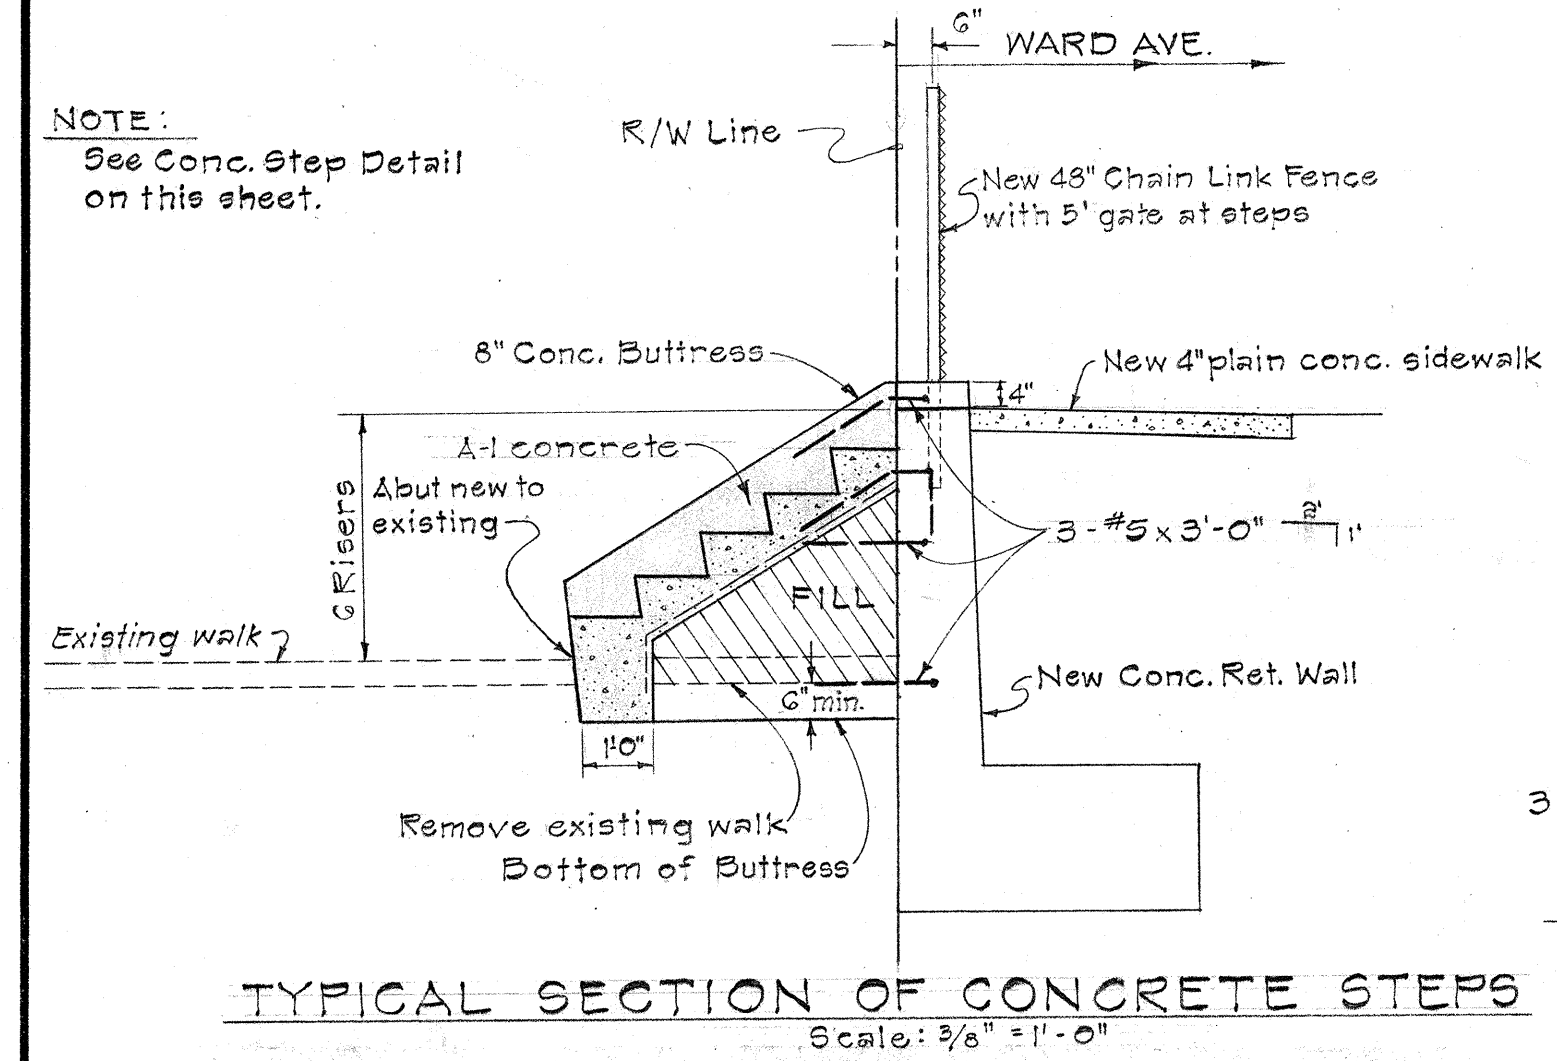

NOTE: New concrete steps incidental to new concrete retaining wall S-VII

DETAIL OF R/W ADJUSTMENT AT T.M.K. 2-1-40:11  
SHT. No. 109

DETAIL OF R/W ADJUSTMENT AT T.M.K. 2-1-40:1  
Scale: 1" = 5'  
SHT. No. 109


STATE OF HAWAII  
DEPARTMENT OF TRANSPORTATION  
HIGHWAYS DIVISION

DRIVEWAY, SIDEWALKS AND STEPS  
ADJUSTMENT PLANS


INTERSTATE ROUTE H-1  
(LUNALILO FREEWAY)  
Pele Street to Victoria Street  
FAI. Proj. No. I-H-1(31), Unit 1

Scale: As Shown Date: April, 1966  
SHEET No. 1 OF 1 SHEETS


| FED. ROAD DIST. NO. | STATE | FED. AID PROJ. NO. | FISCAL YEAR | SHEET NO. | TOTAL SHEETS |
|---------------------|-------|--------------------|-------------|-----------|--------------|
| HAWAII              | HAW.  | I-HI-1(31) Unit 1  | 1967        | 001098    | 202          |

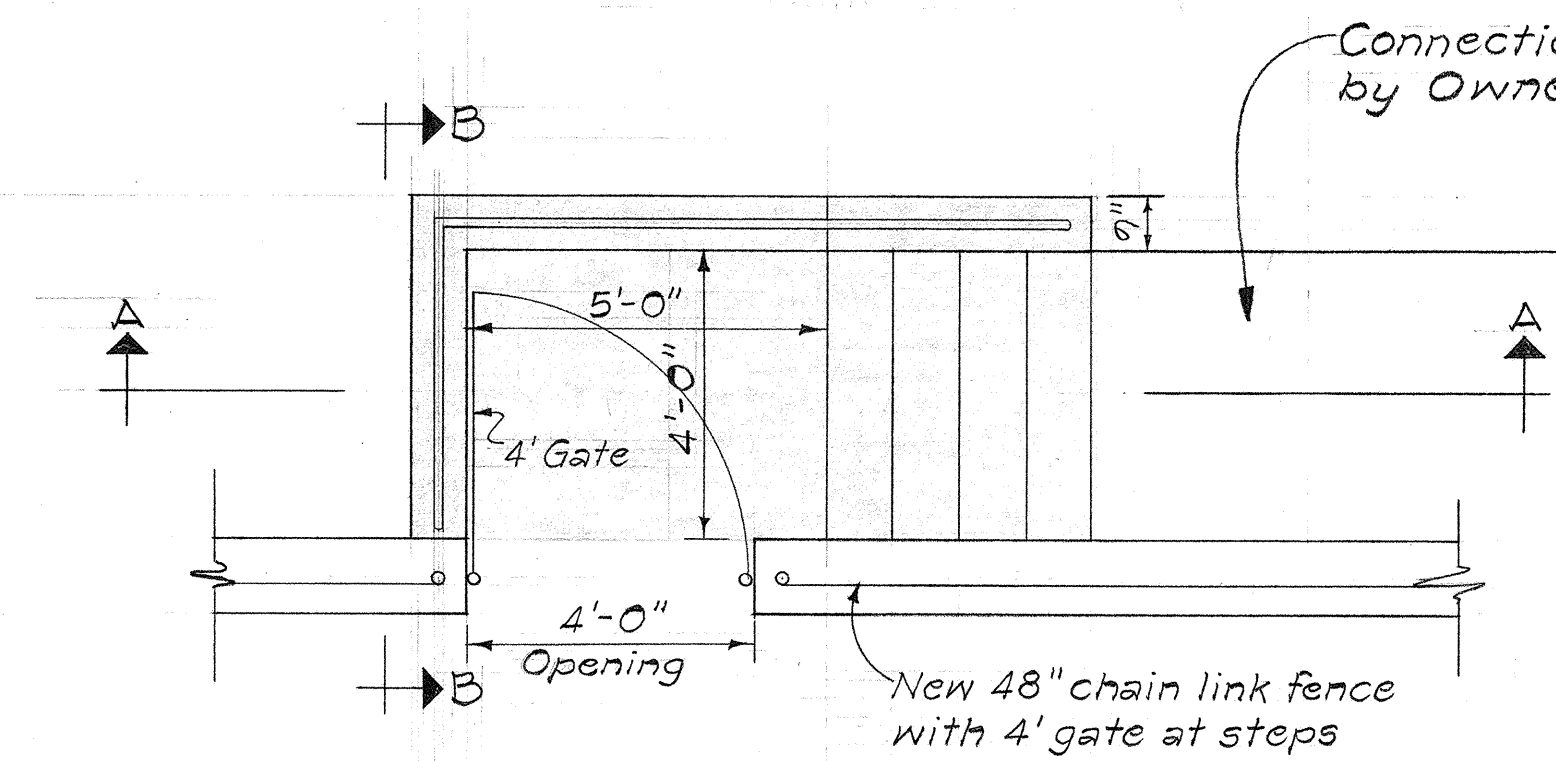


PLAN  
Scale: 3/8"=1'-0"

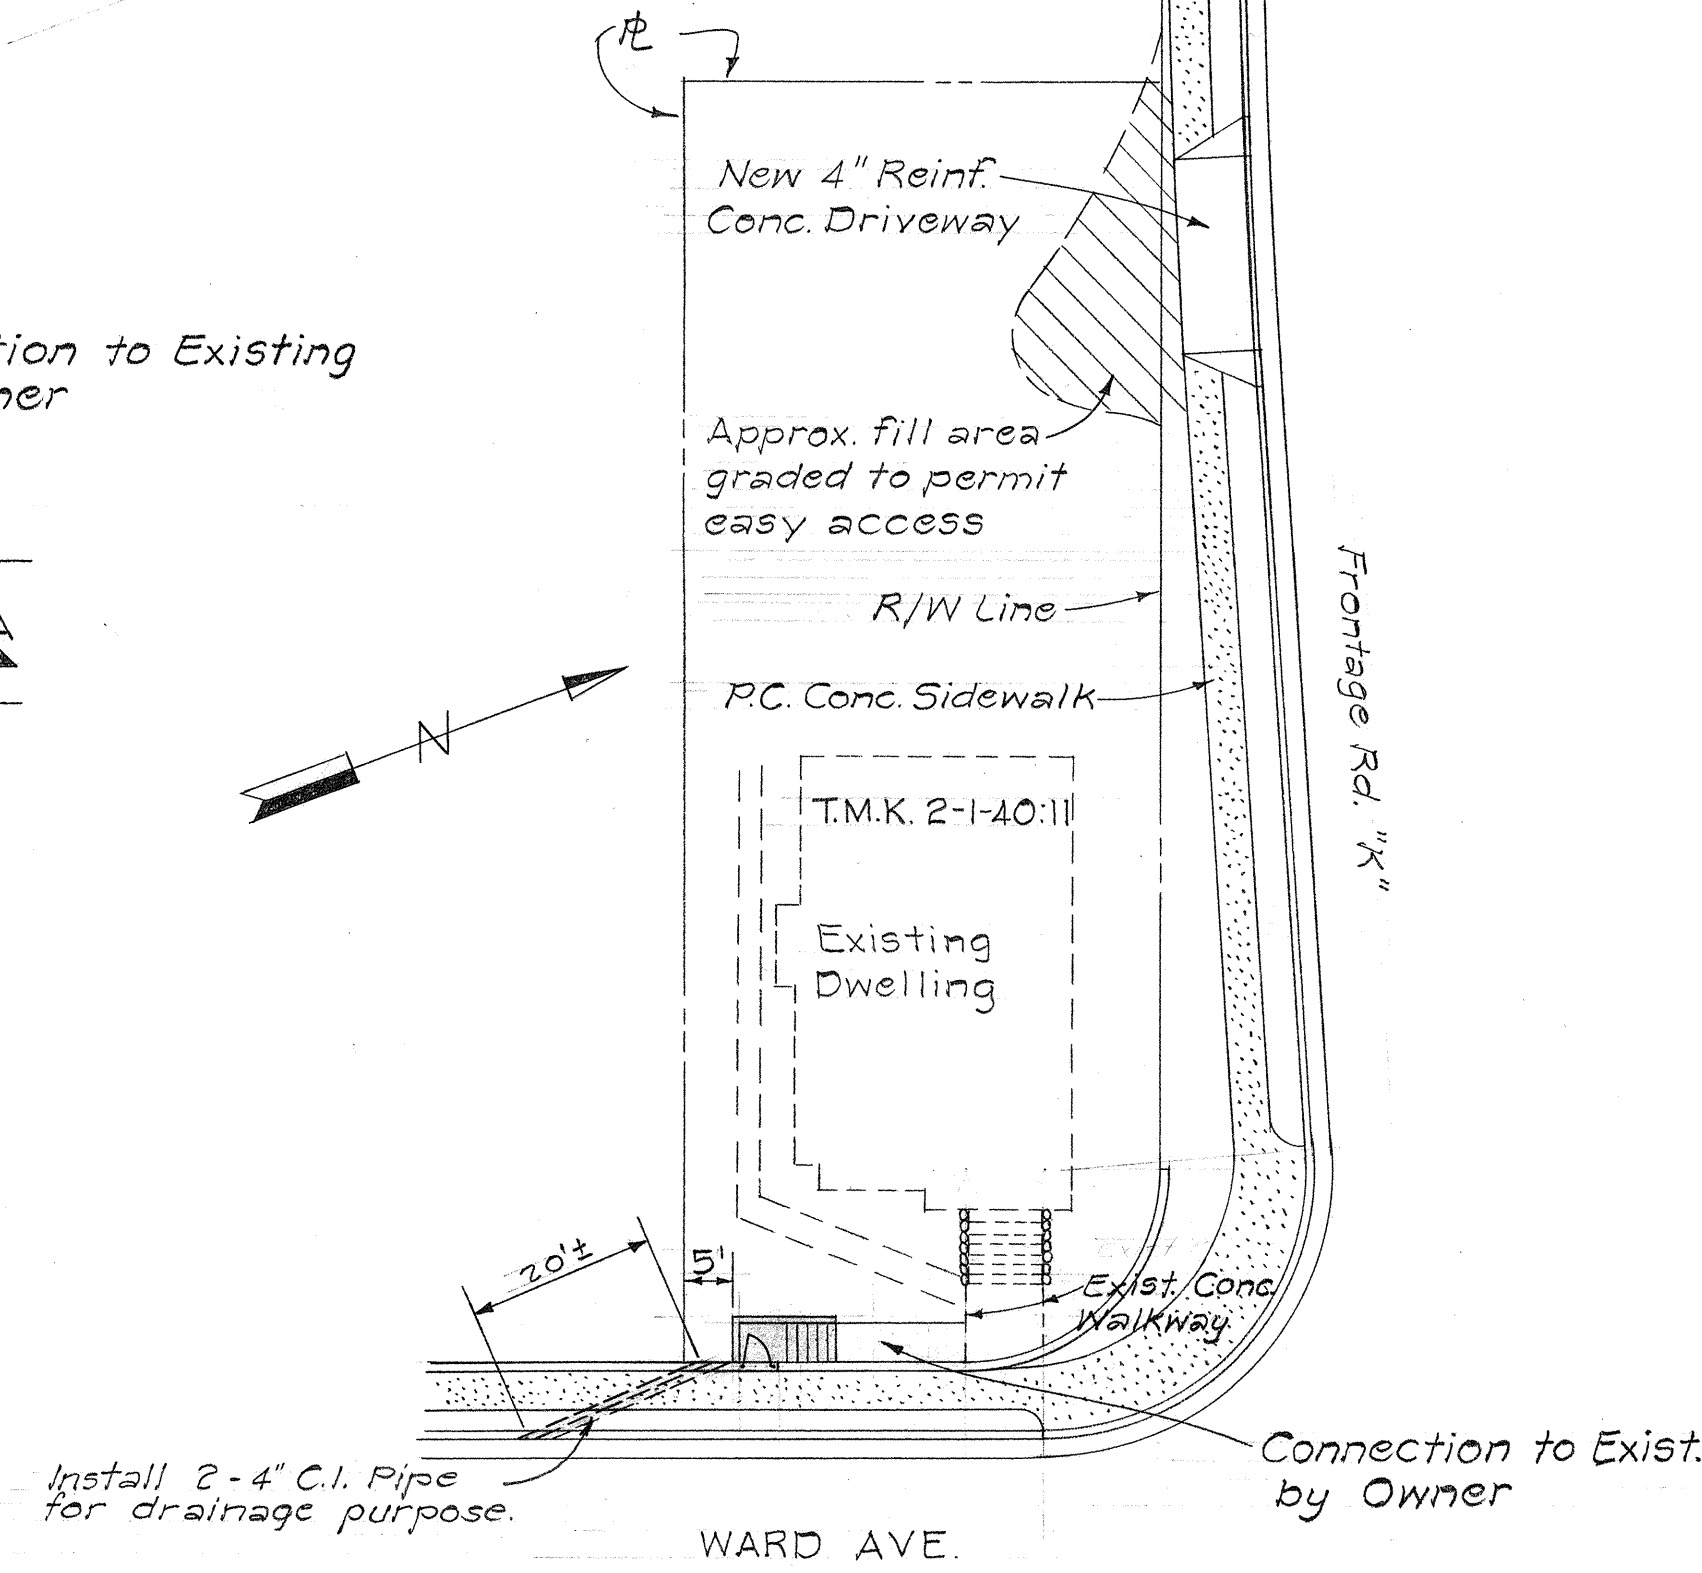

PLOT PLAN  
Scale: 1"=20'

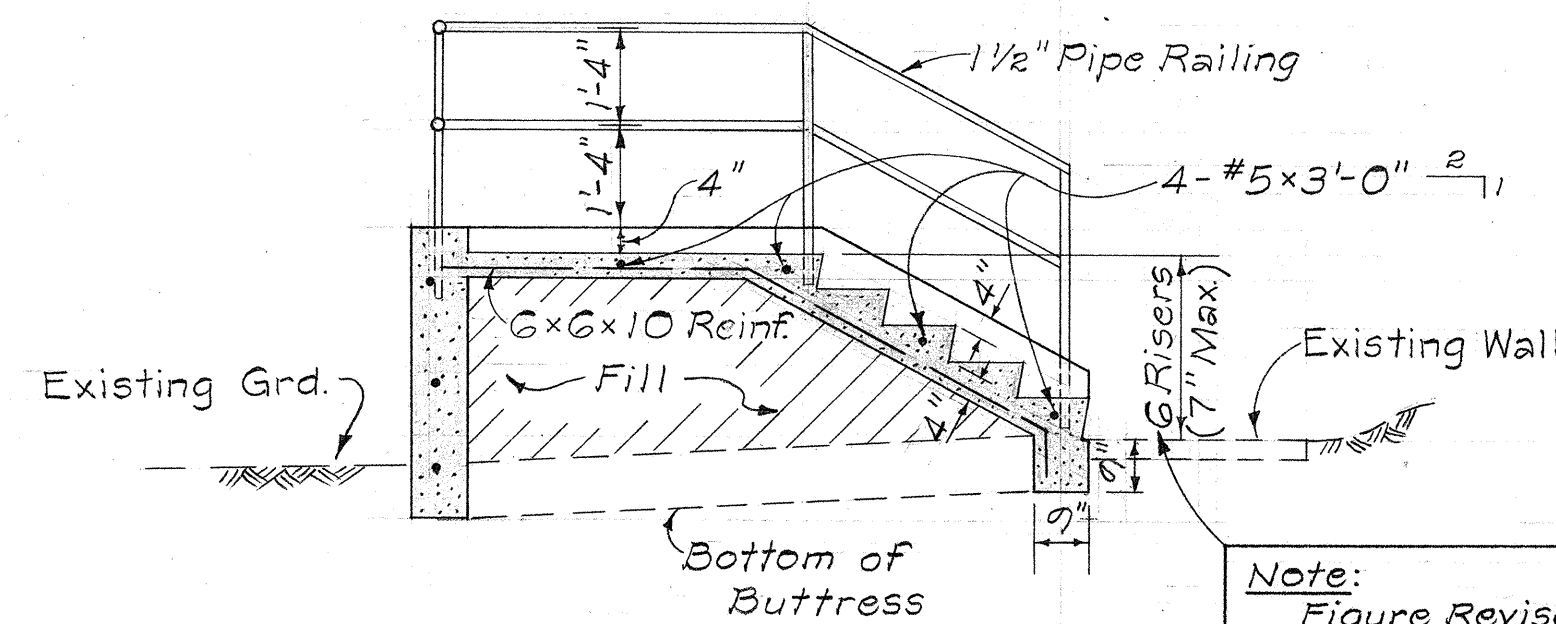

SECTION "A-A"  
Scale: 3/8"=1'-0"

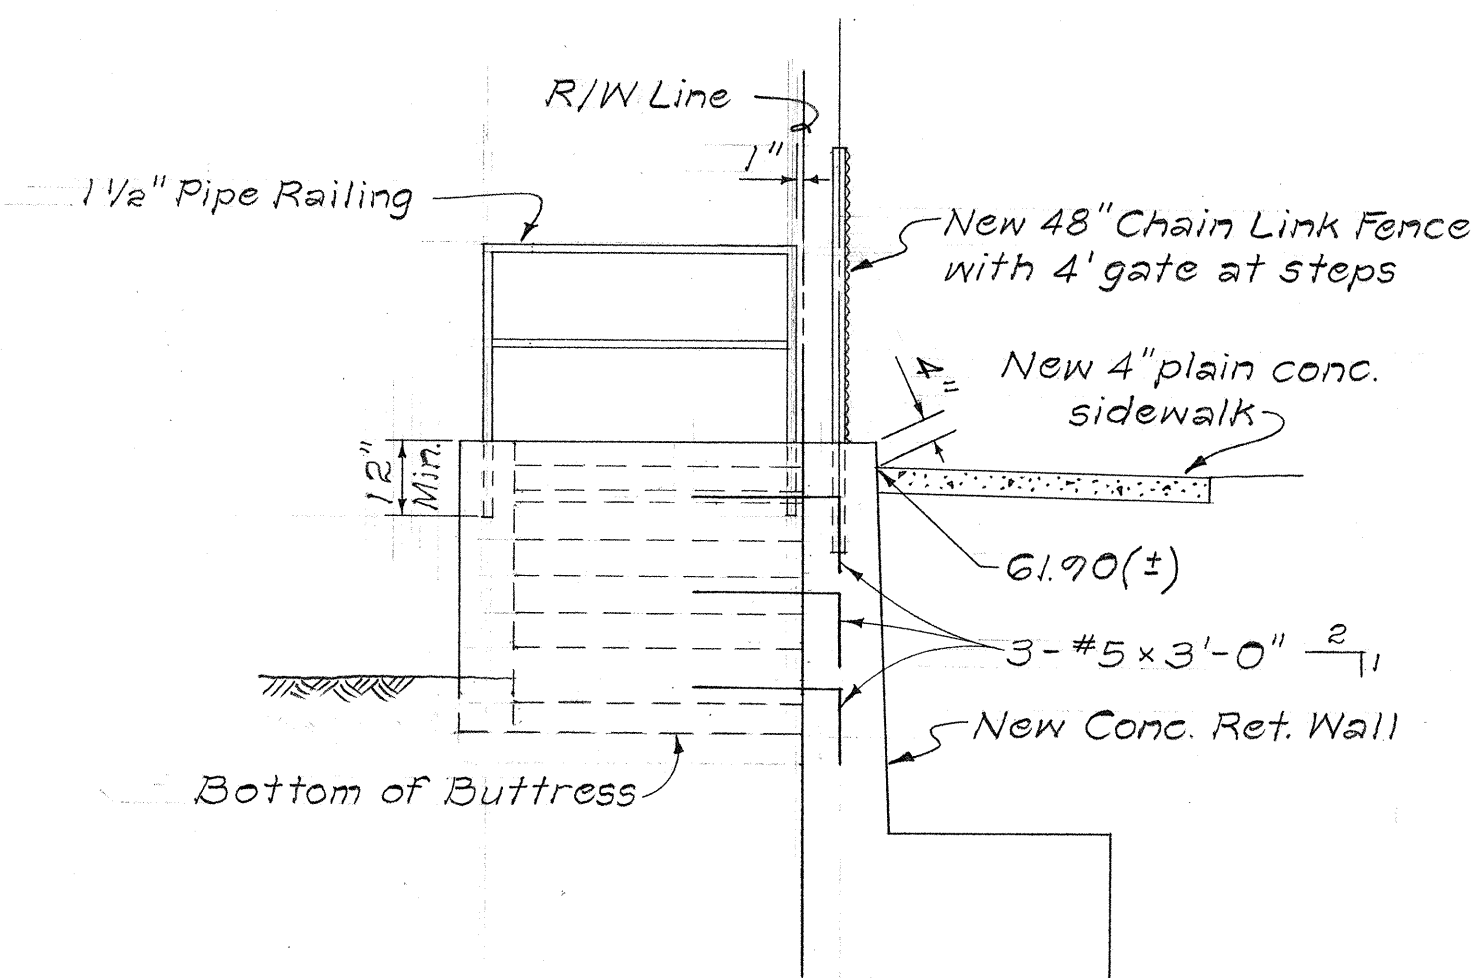

SECTION "B-B"  
Scale: 3/8"=1'-0"

THESE DETAILS SUPERSEDES  
DRAWING OF R/W ADJUSTMENT  
AT T.M.K. 2-1-40:11 AS SHOWN  
ON SHEET NO. 109

NEW CONCRETE STEPS AT 1316 WARD AVE. T.M.K. 2-1-40:11

Scale: As Shown

STATE OF HAWAII  
DEPARTMENT OF TRANSPORTATION  
HIGHWAYS DIVISION




R/W ADJUSTMENT DETAILS

INTERSTATE HIGHWAY (LUNALILO FREEWAY)  
F.A.I. Proj. No. I-HI-1(31), Unit 1

Scale: As Shown Date: Jan. 16, 1968




SHEET No. OF SHEETS

001098

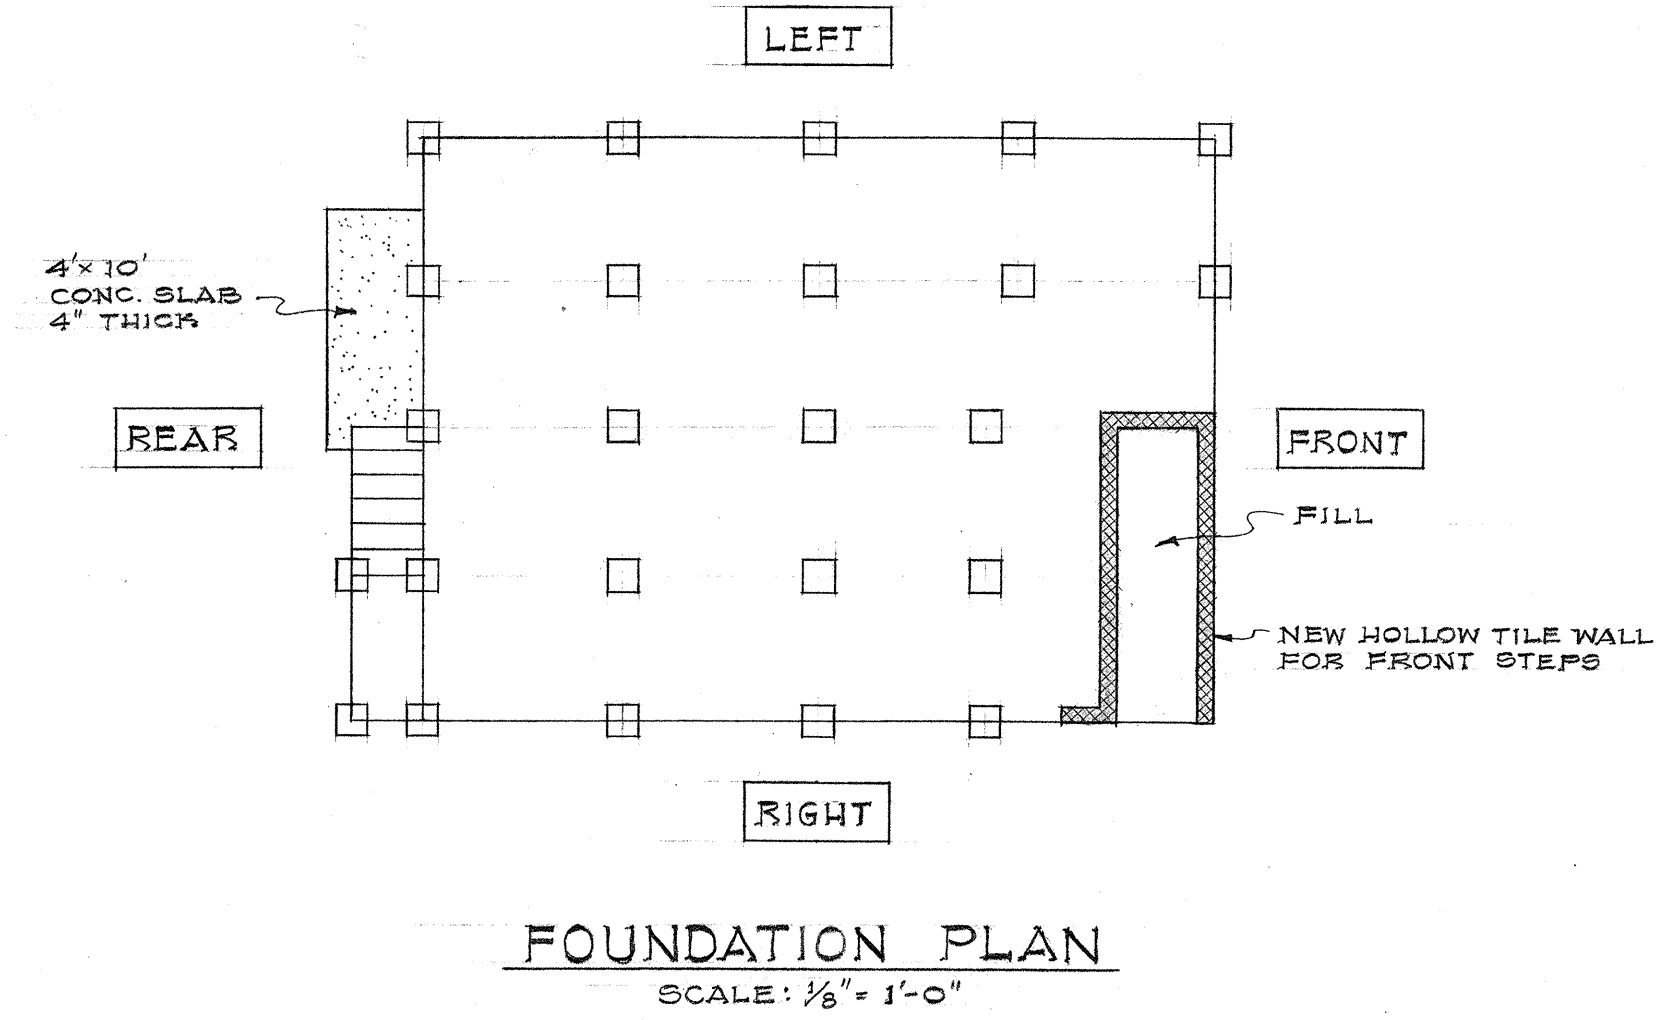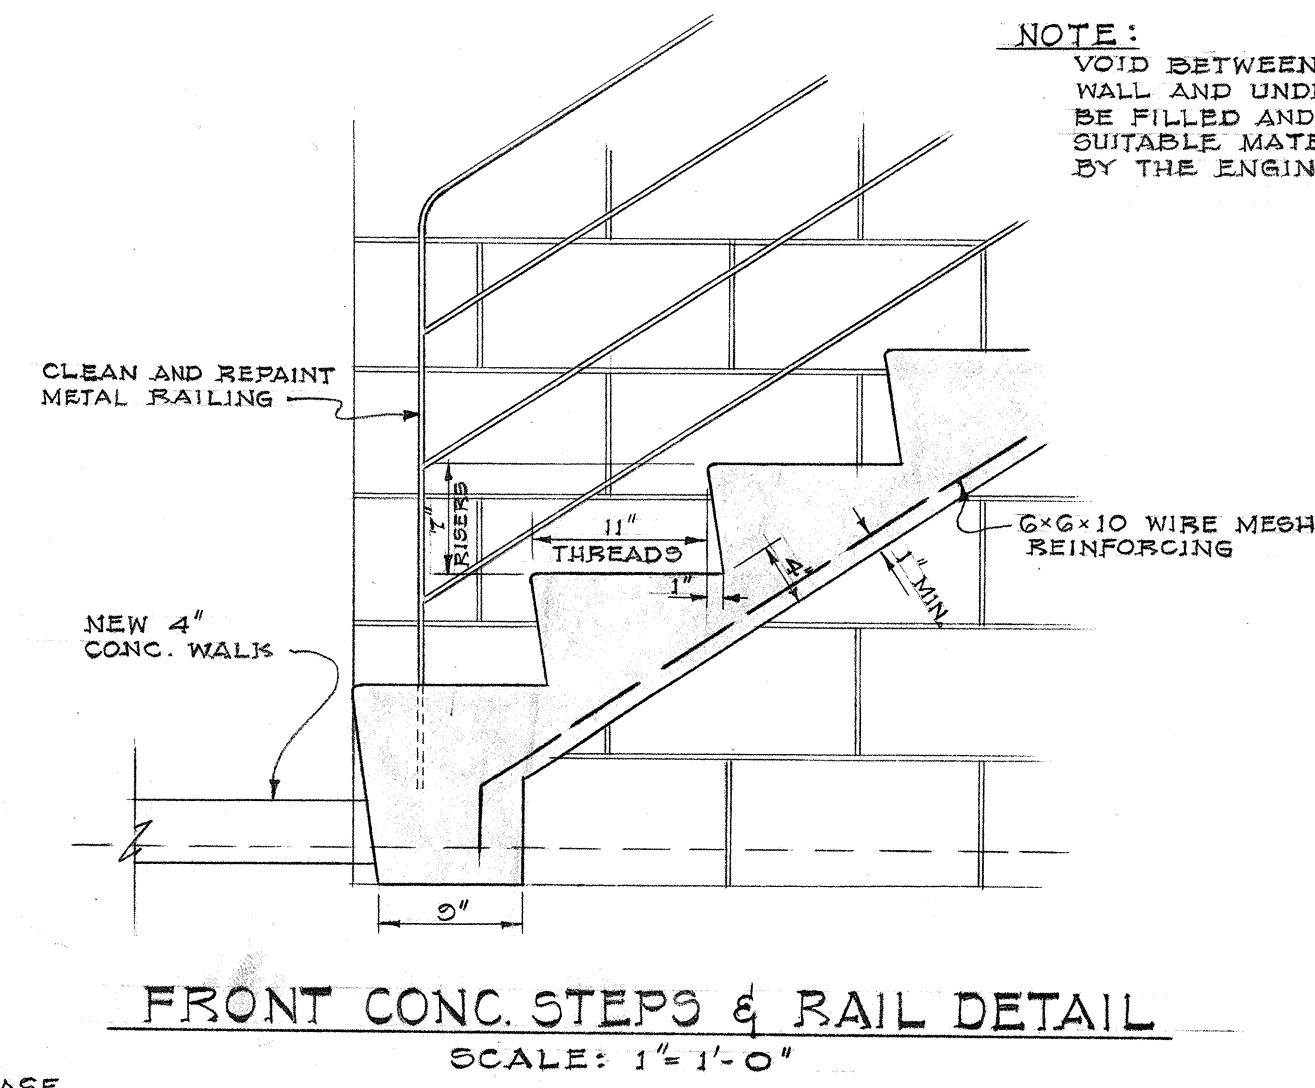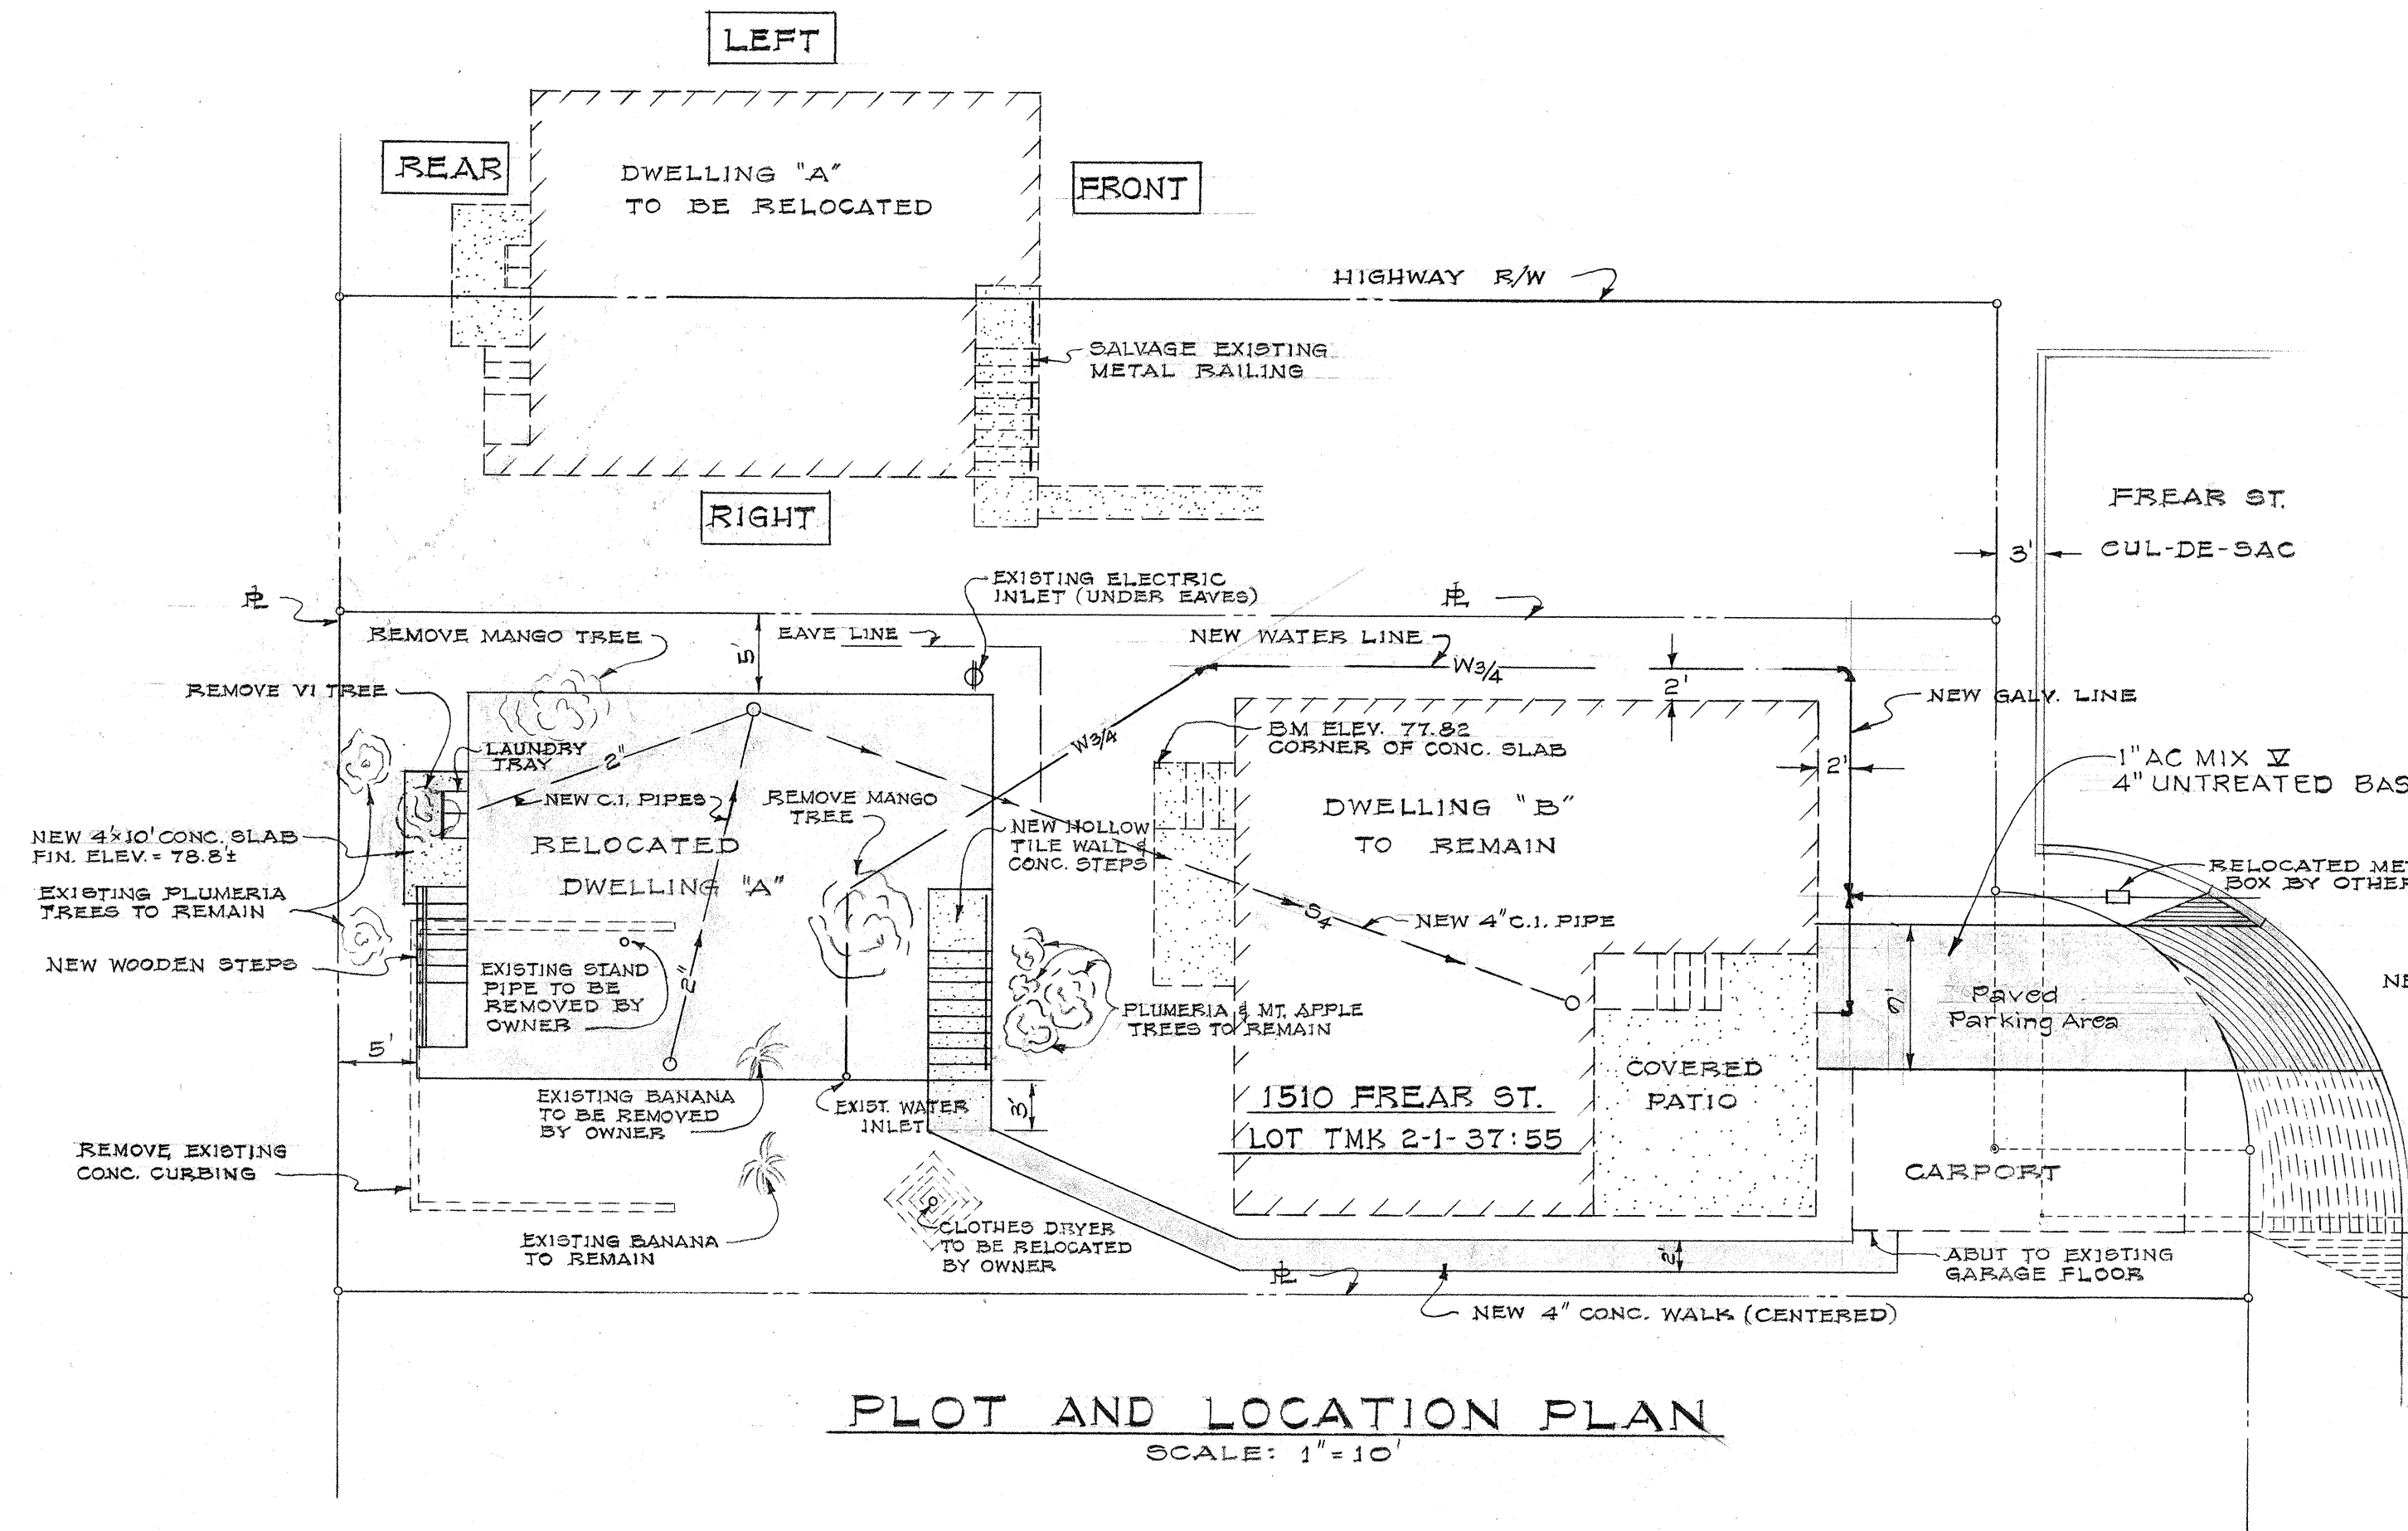

### SCOPE OF WORK

1. REMOVE ALL PLANTS AND TREES (2-MANGOES, 1-VI) AT NEW LOCATION.
2. DISCONNECT ALL EXISTING UTILITIES, DEMOLISH CONCRETE STEPS.
3. RELOCATE DWELLING "A" INCLUDING LAUNDRY TRAY.
4. CONNECT SEWER, WATER AND ELECTRICITY TO DWELLING "B" WHERE SHOWN. PROVIDE CONTINUOUS SERVICE FOR ALL UTILITIES.
5. CONSTRUCT NEW 4x10 CONCRETE SLAB IN REAR OF RELOCATED DWELLING "A" FOR EXISTING LAUNDRY TRAY.
6. PROVIDE REAR STEPS TO FIT.
7. CONSTRUCT FRONT STEPS AND INSTALL METAL RAILING. SALVAGE AND REUSE EXISTING METAL RAILING.
8. PROVIDE NEW 2' WIDE CONC. WALK AS SHOWN ON PLAN.

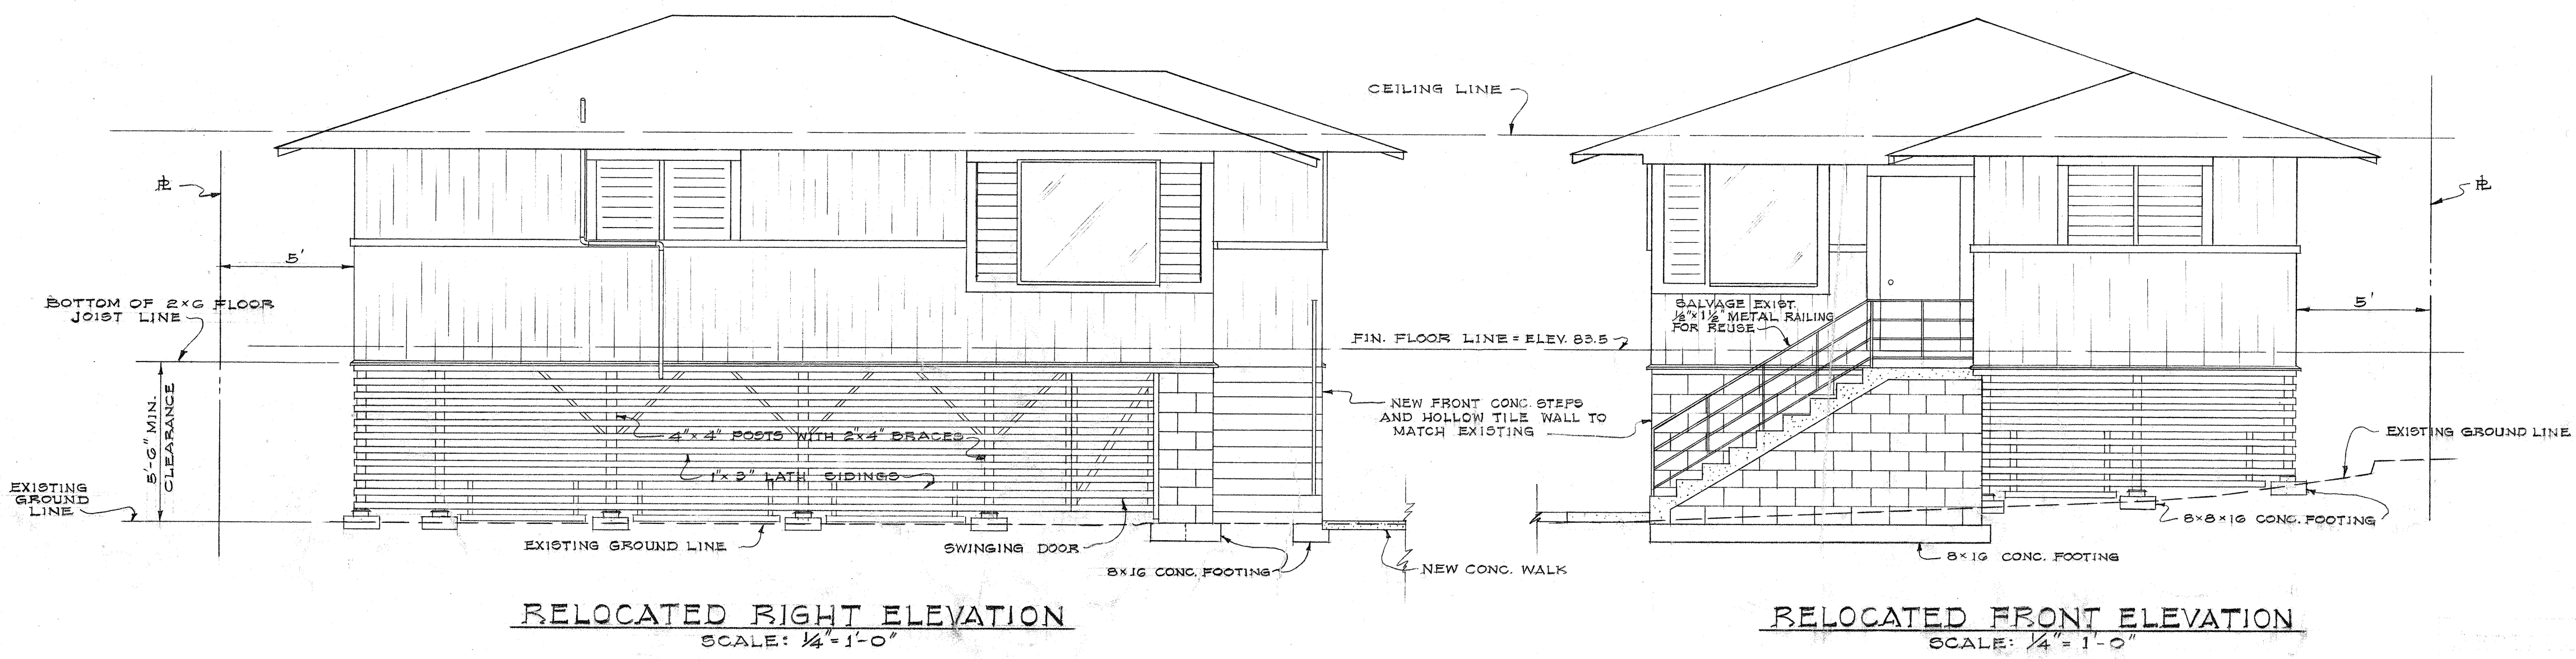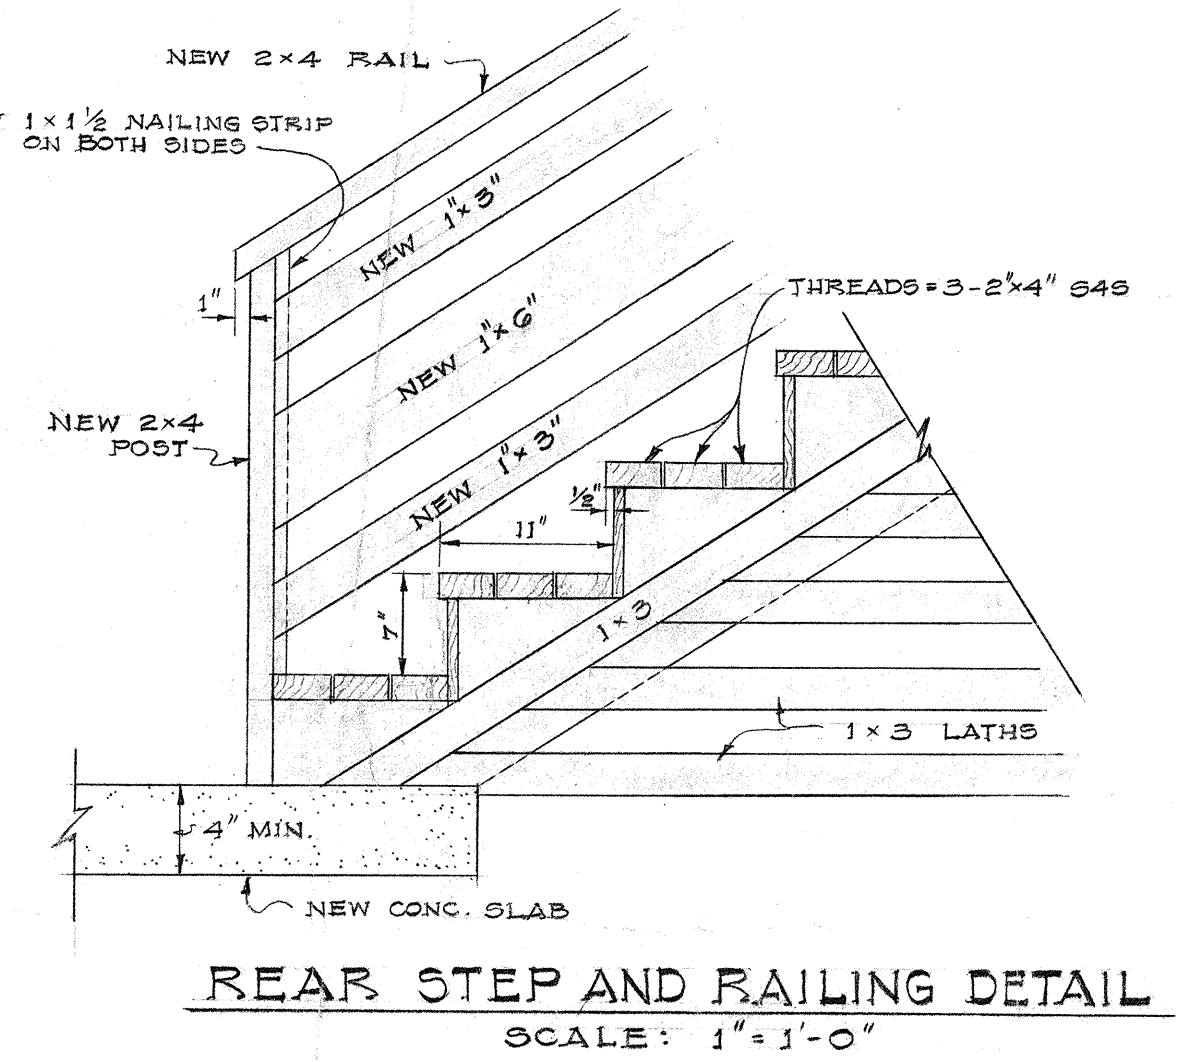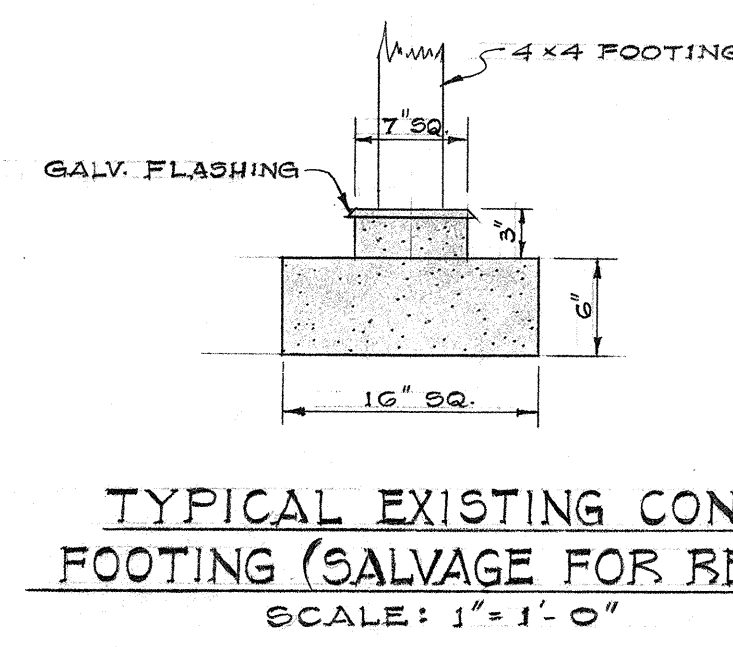

ITEM NO. 123.01

STATE OF HAWAII

DEPARTMENT OF TRANSPORTATION

HIGHWAYS DIVISION

R/W ADJUSTMENT PLANS

INTERSTATE ROUTE H-1

(LUNALILO FREEWAY)

Pele Street to Victoria Street

F.A.I. Proj. No. I-H-1(31) Unit 1

Scale: As Shown

Date: April, 1966

SHEET No. 1 OF 1 SHEETS

C.O. 110

|                   |               |
|-------------------|---------------|
| SURVEY PLOTTED BY | DATE          |
| DRAWN BY          | DESIGNED BY   |
| NOTE BOOK         | QUANTITIES BY |
| CHECKED BY        |               |

