


FED. ROAD DIST. NO.	STATE	FED. AID PROJ. NO.	FISCAL YEAR	SHEET NO.	TOTAL SHEETS
HAWAII	HAW.	Unit 1	1967	265	292

DATE	BY	REVISION

DATE	BY	REVISION

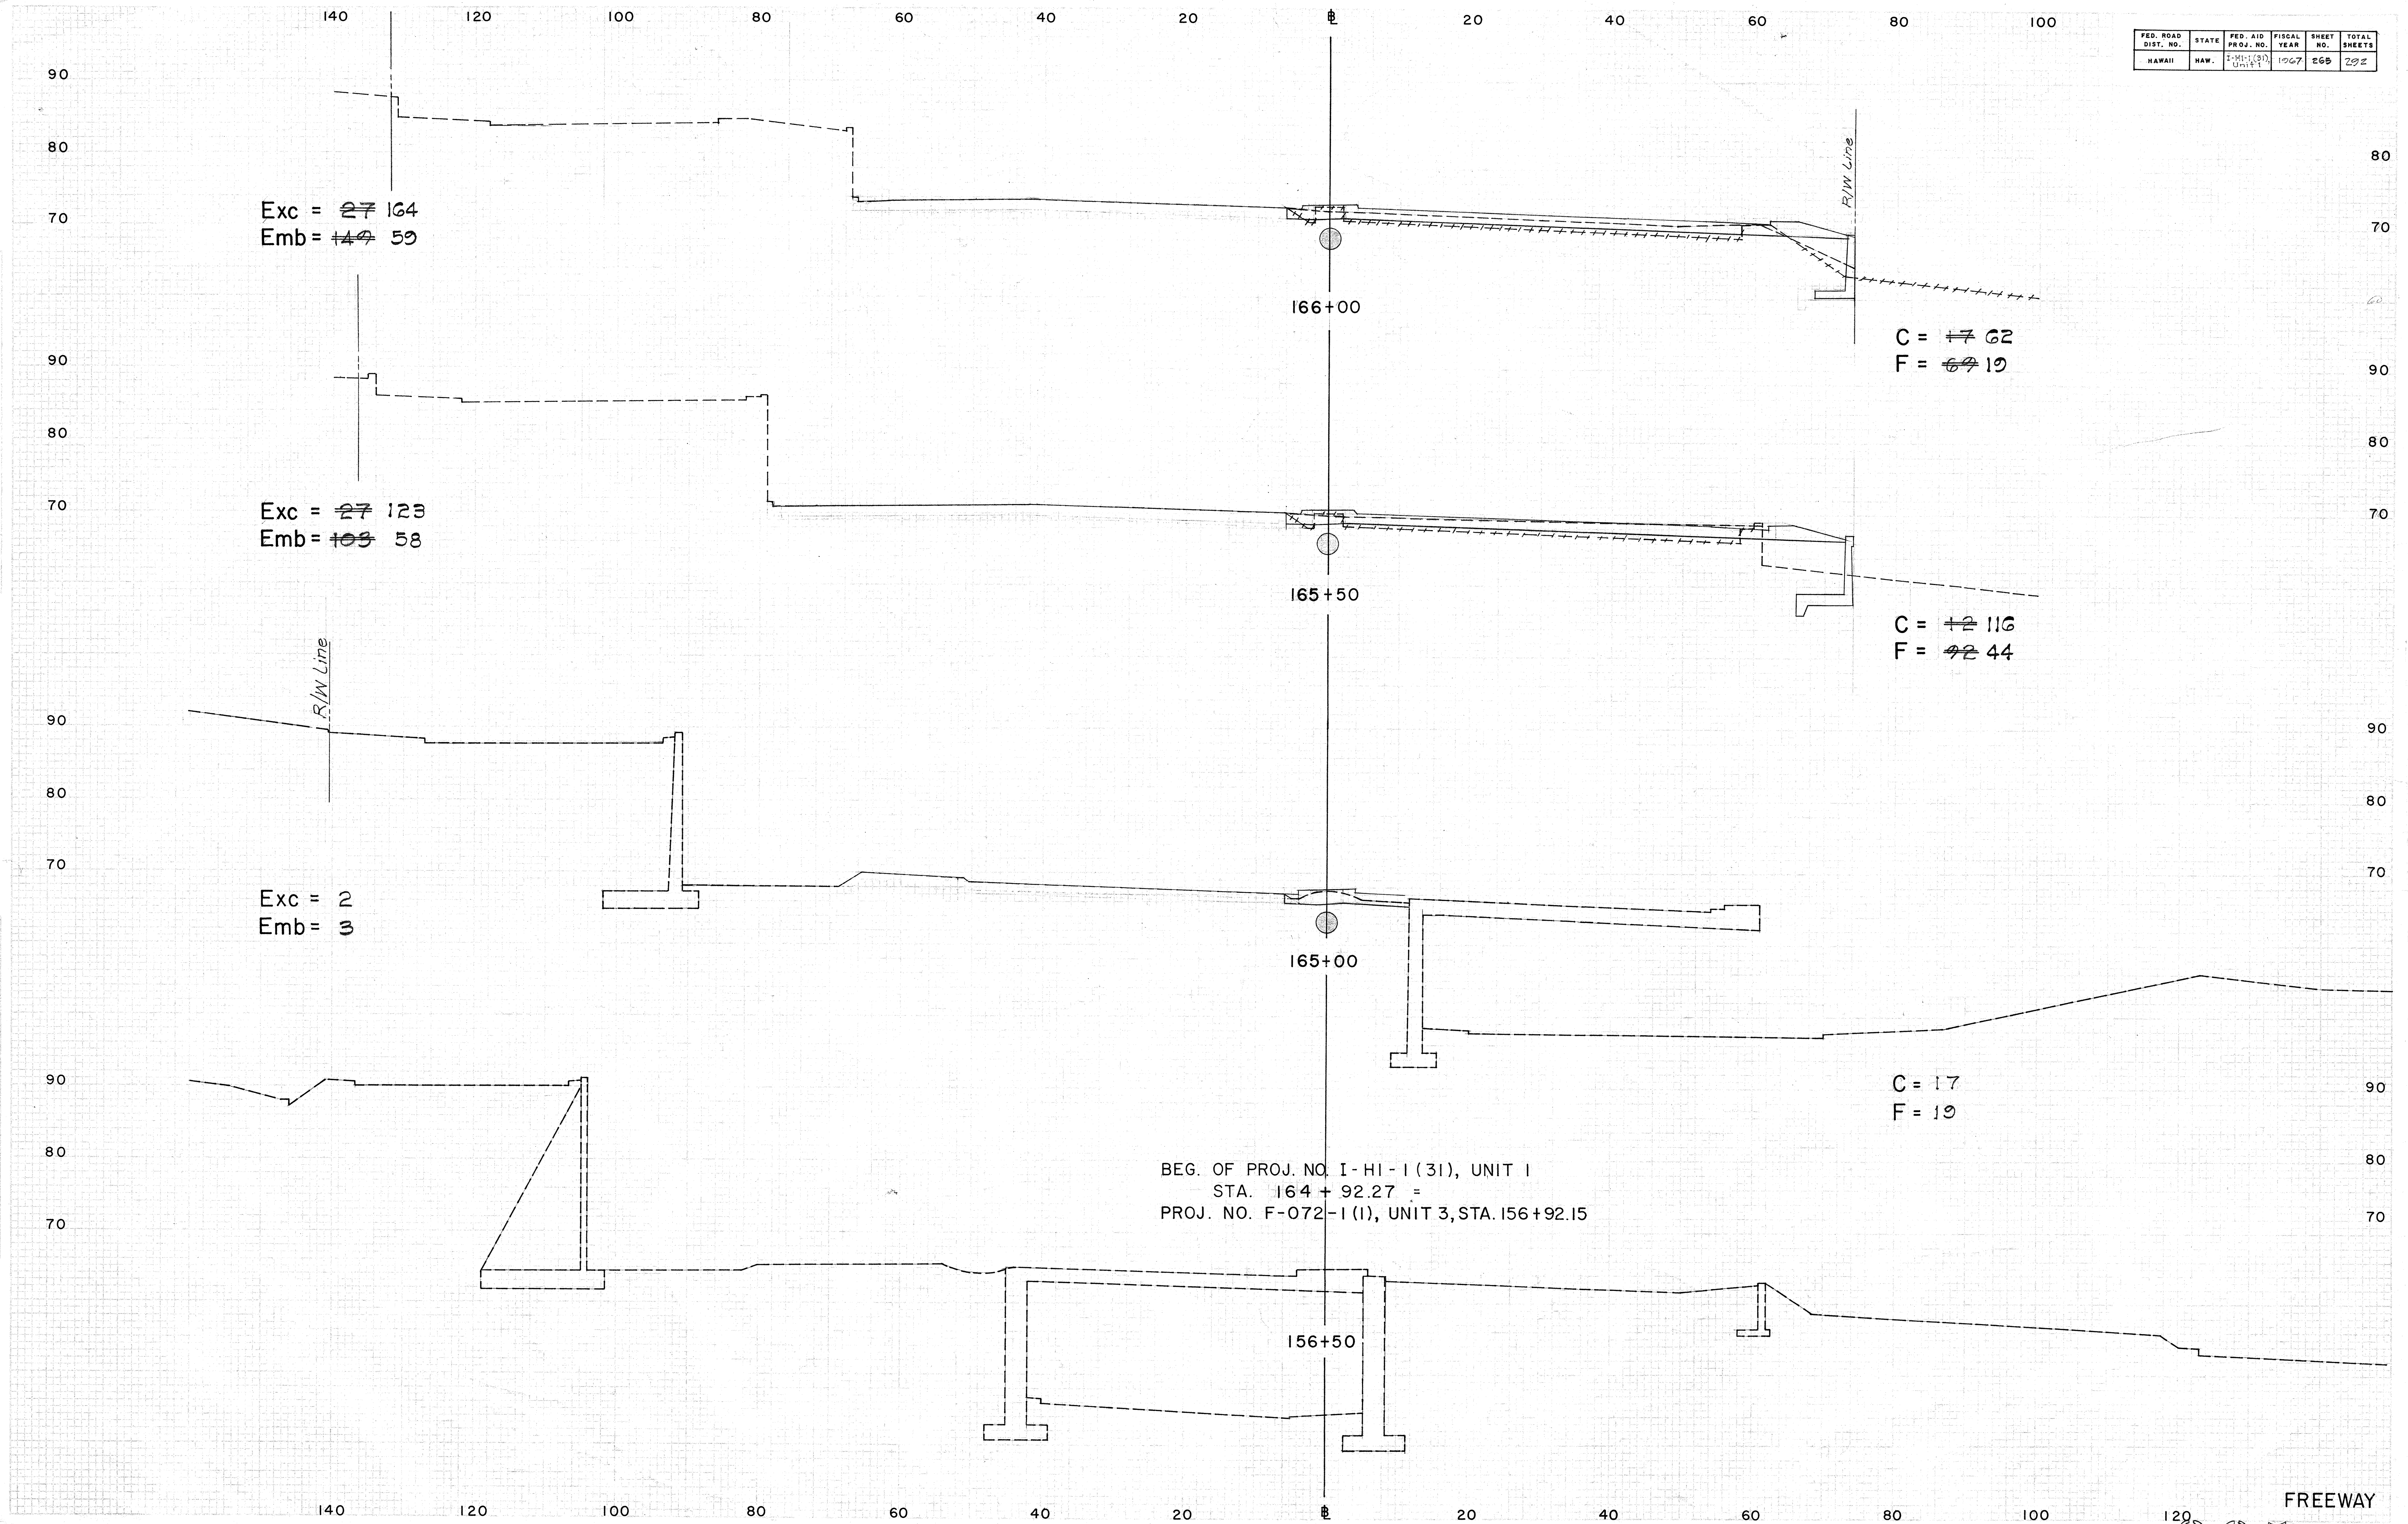



BEG. OF PROJ. NO. I-HI-1(31), UNIT 1
 STA. 164 + 92.27 =
 PROJ. NO. F-072-1(1), UNIT 3, STA. 156+92.15

FED. ROAD DIST. NO.	STATE	FED. AID PROJ. NO.	FISCAL YEAR	SHEET NO.	TOTAL SHEETS
HAWAII	HAW.	2-111(19)	1967	266	272


DATE	BY	NO.
DESIGNED	SURVEY	PLATTED
NOTED	BOOK	AREA

DATE	BY	NO.
DESIGNED	SURVEY	PLATTED
NOTED	BOOK	AREA

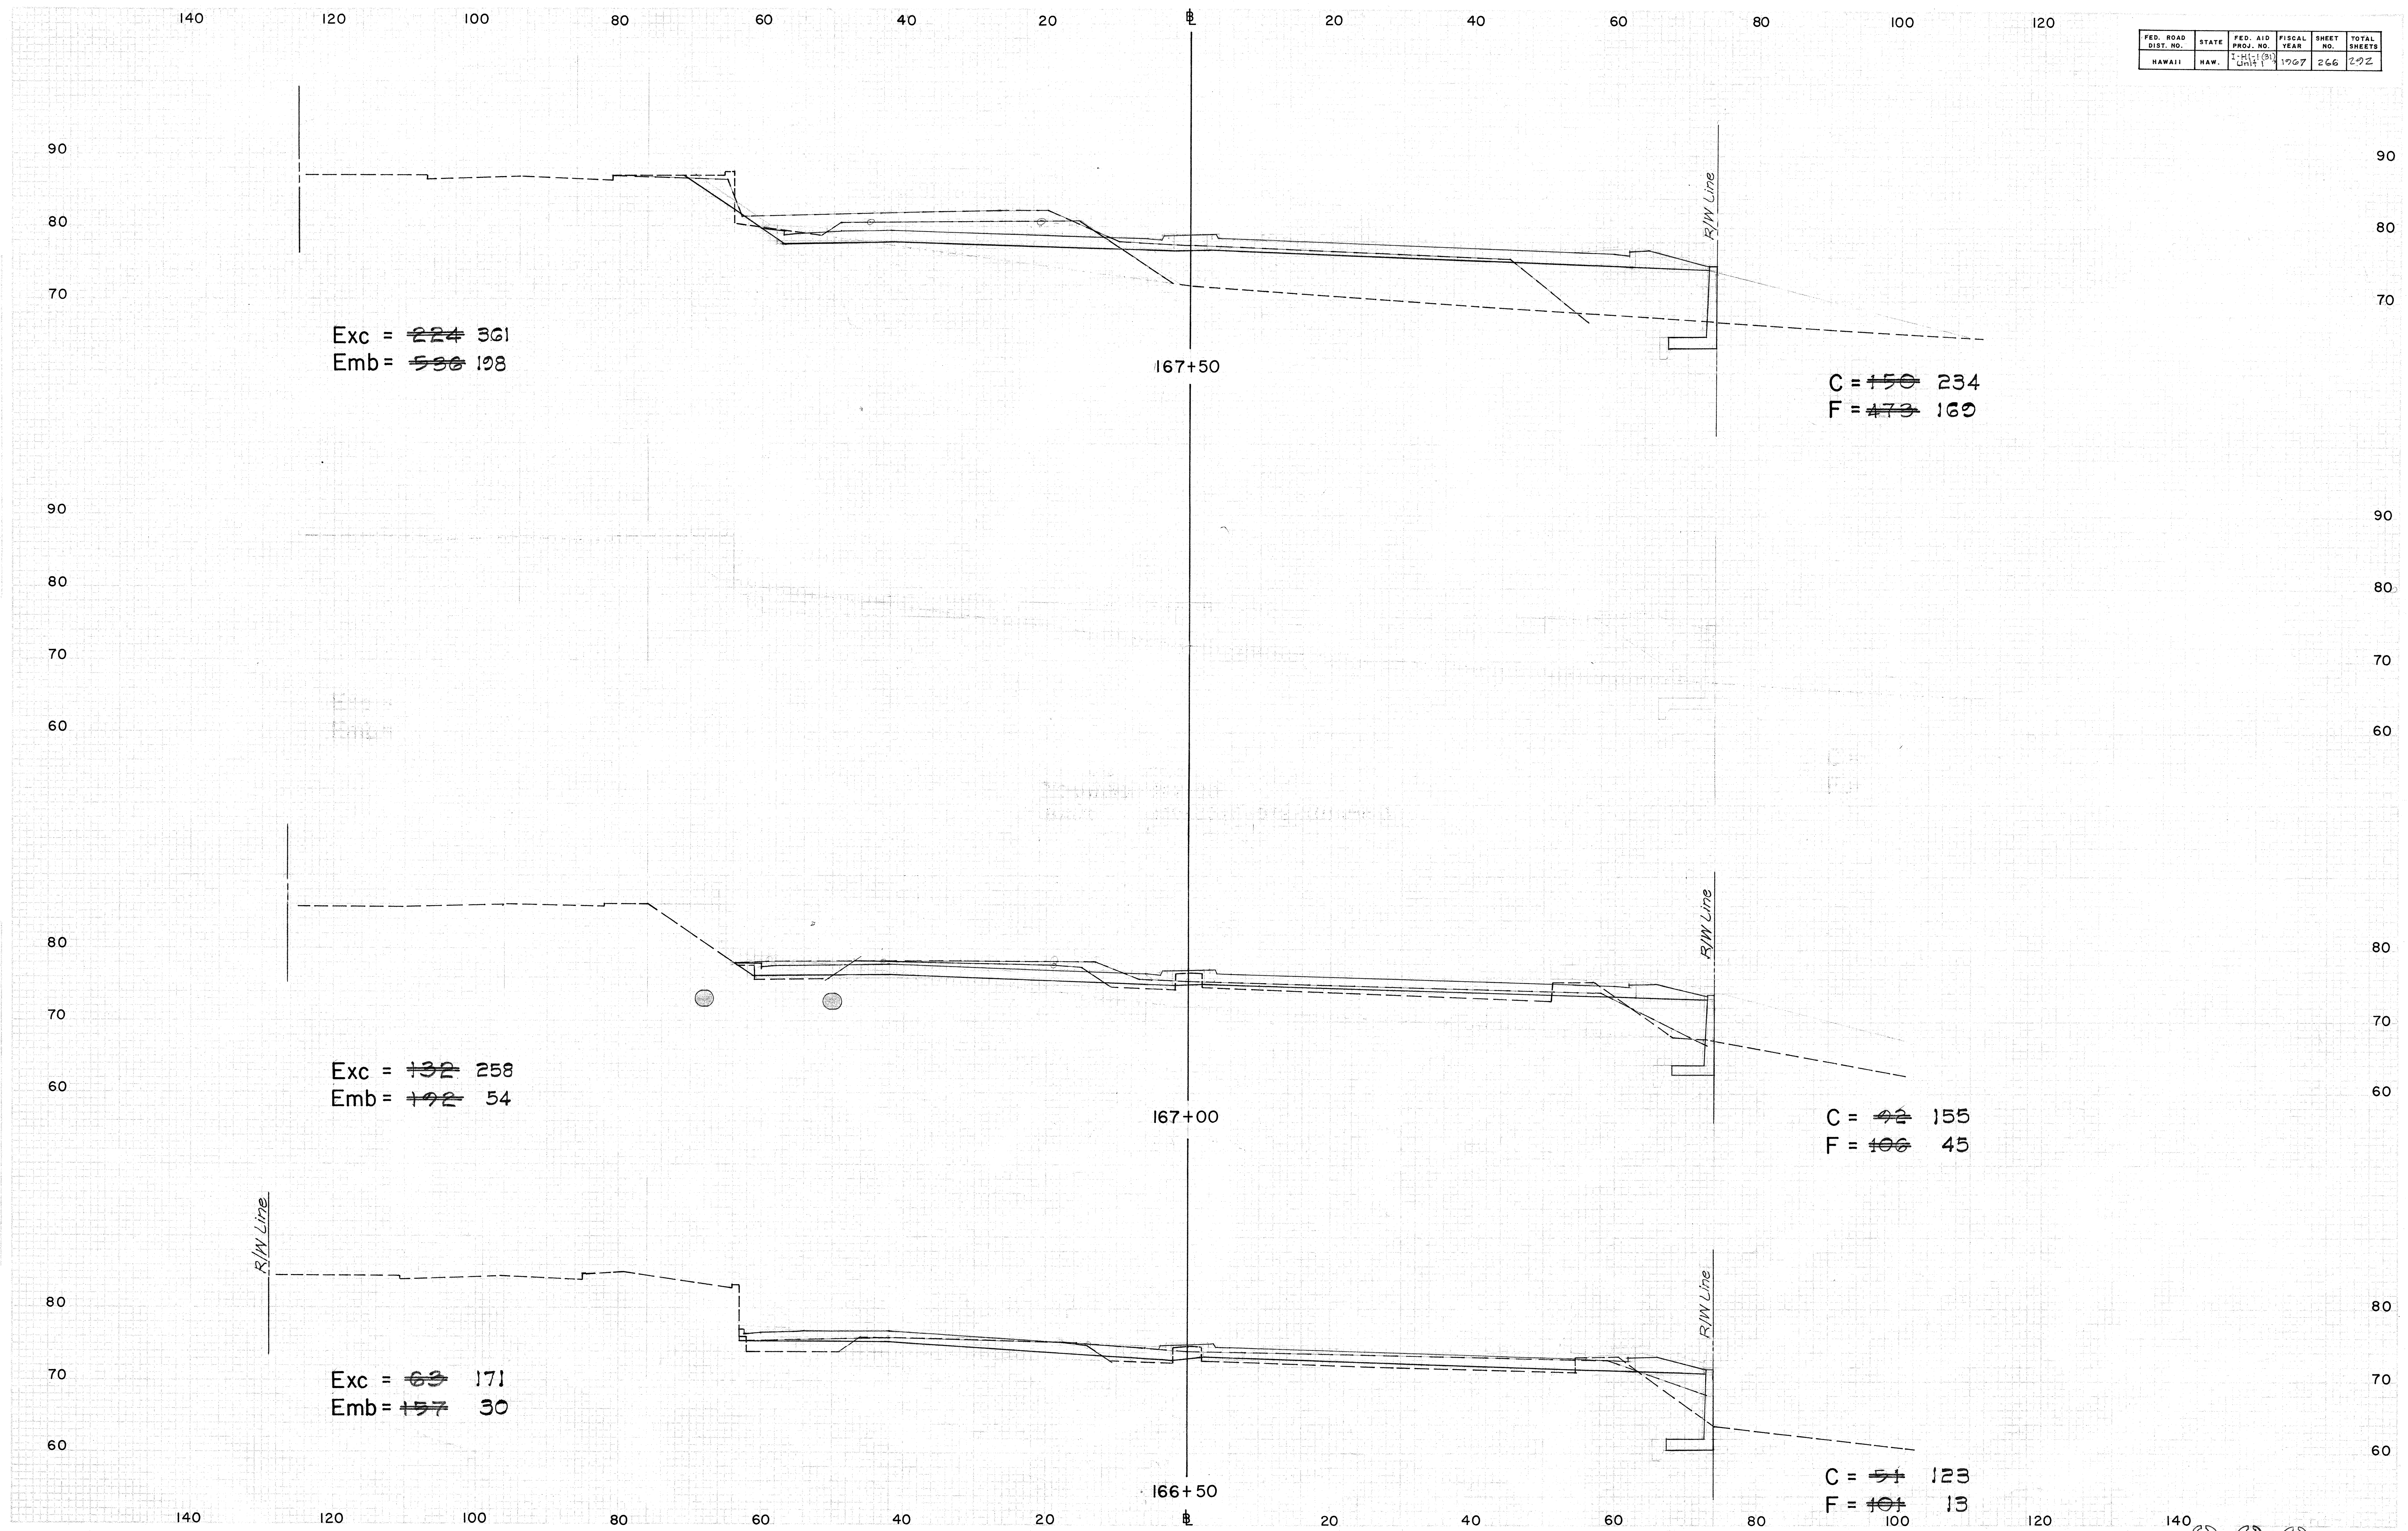

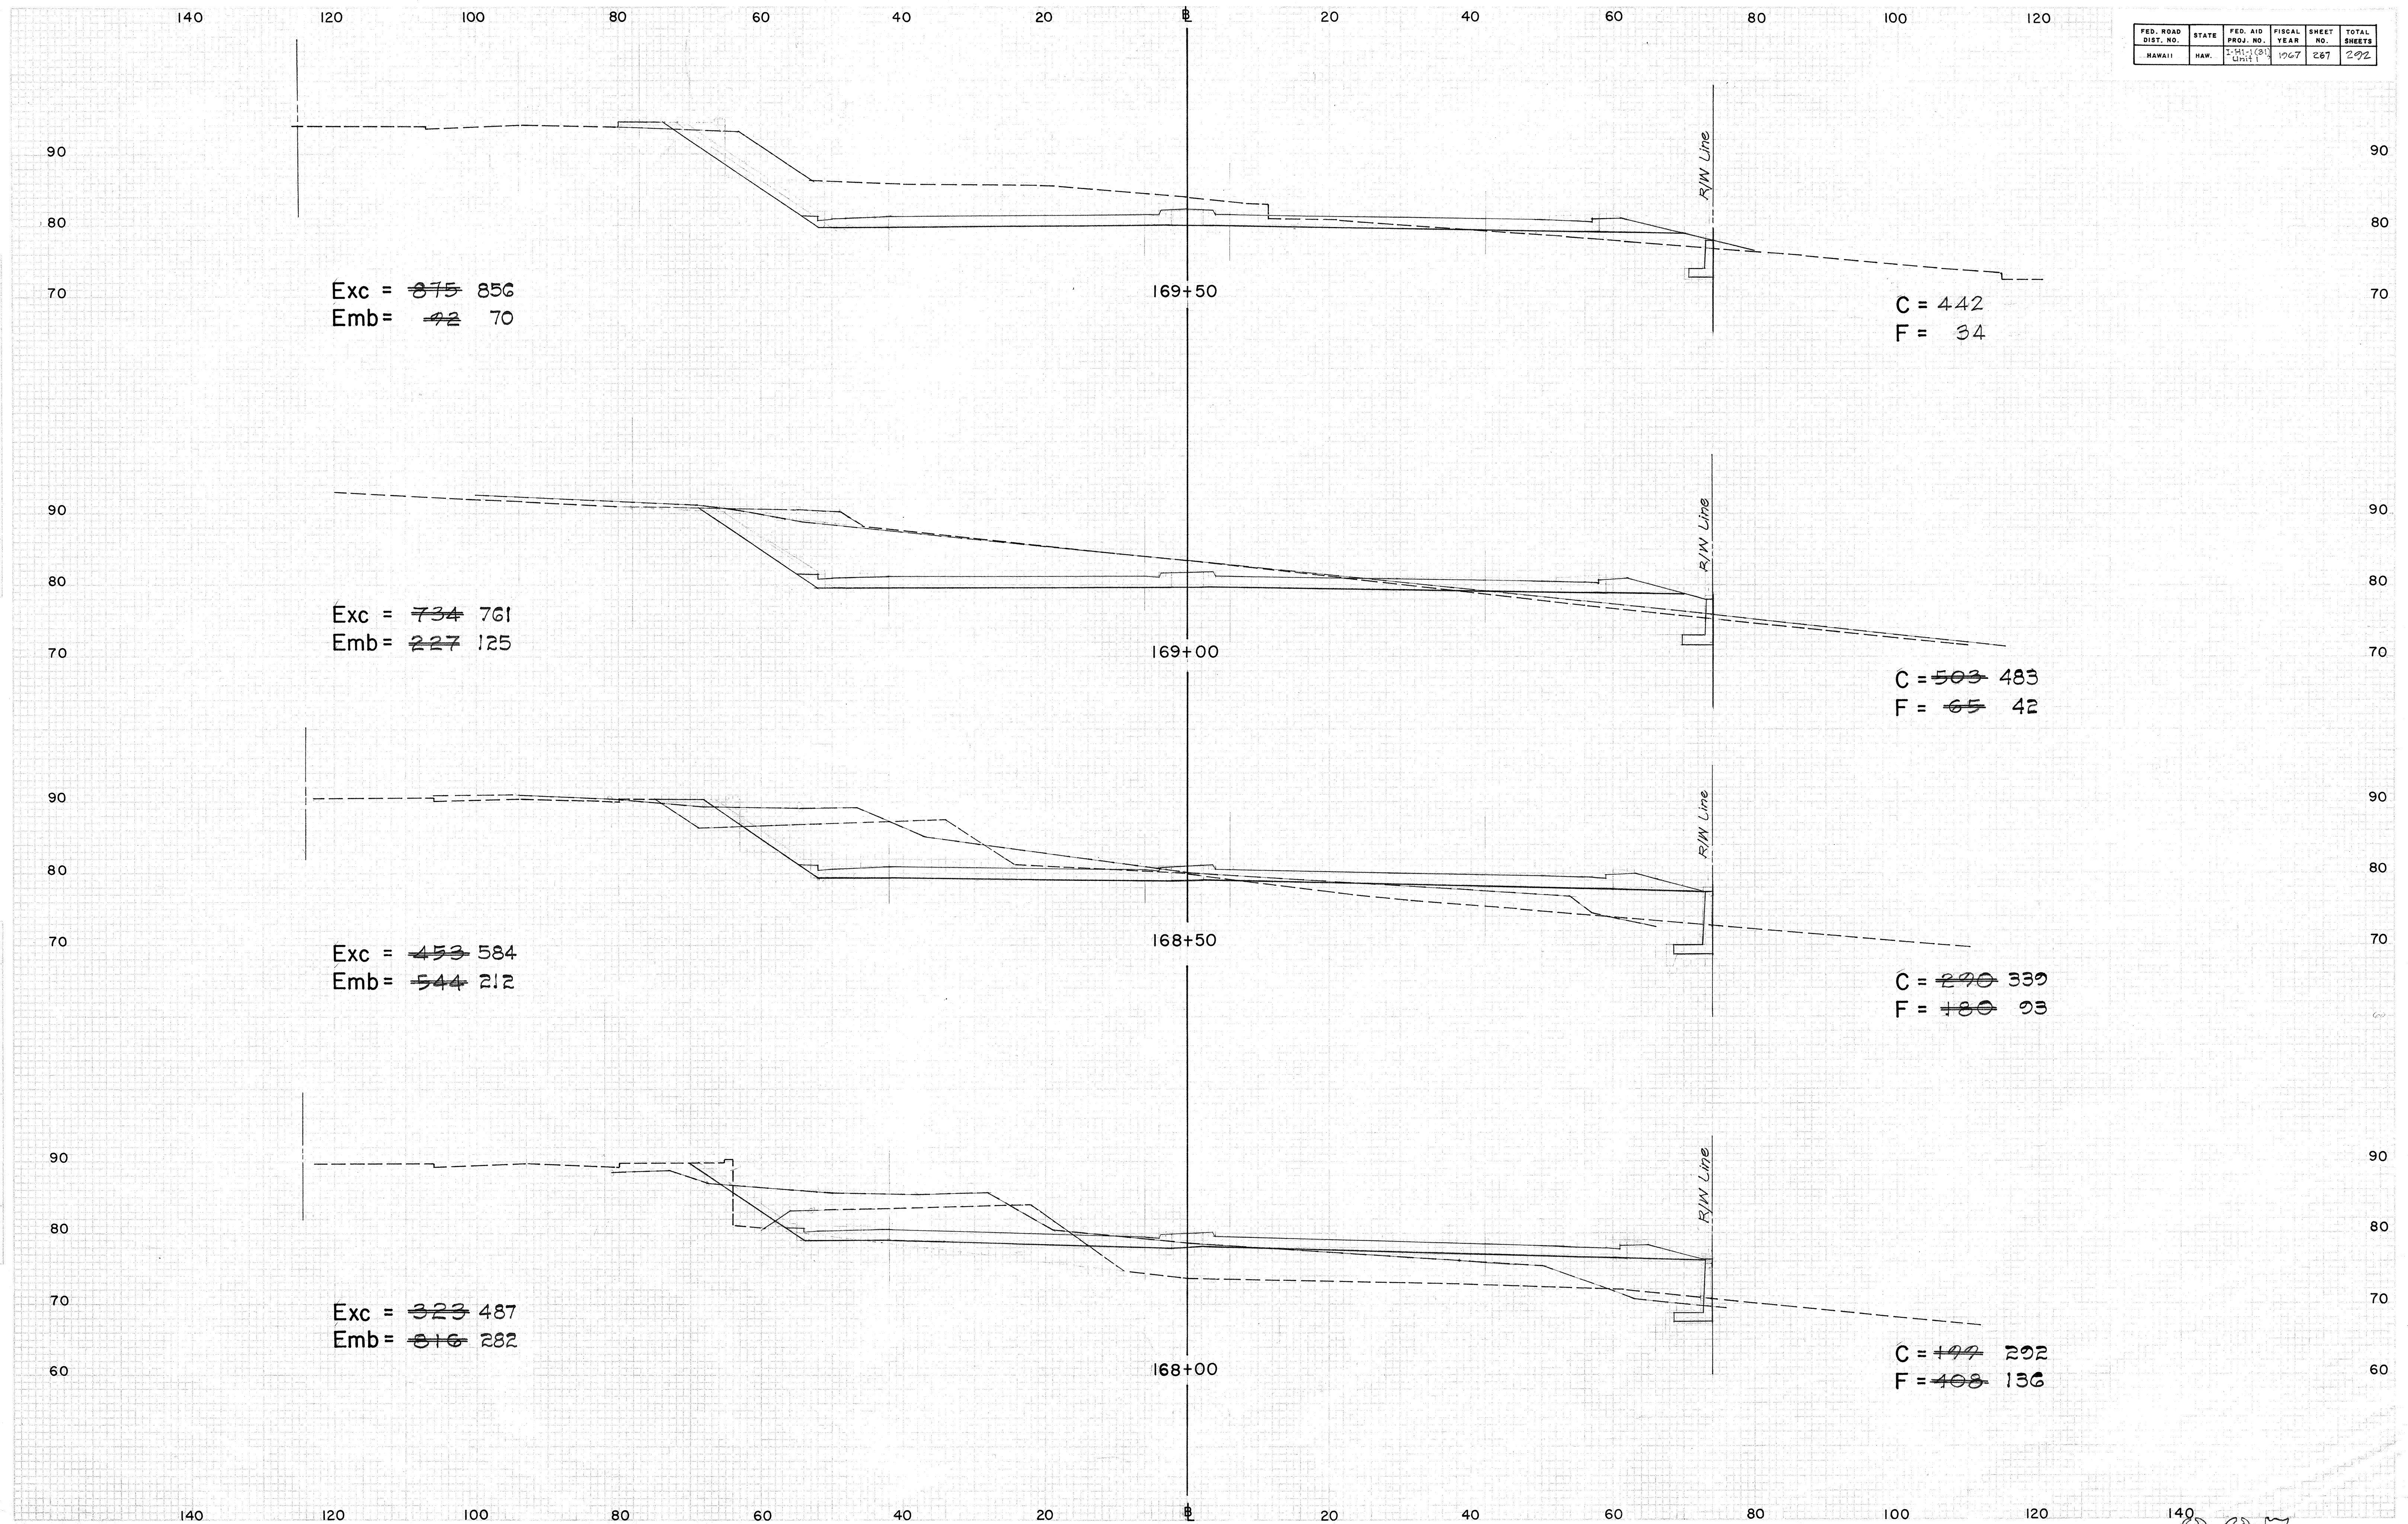


FED. ROAD DIST. NO.	STATE	FED. AID PROJ. NO.	FISCAL YEAR	SHEET NO.	TOTAL SHEETS
HAWAII	HAW.	1-HW-1(31) 2007	2007	268	292

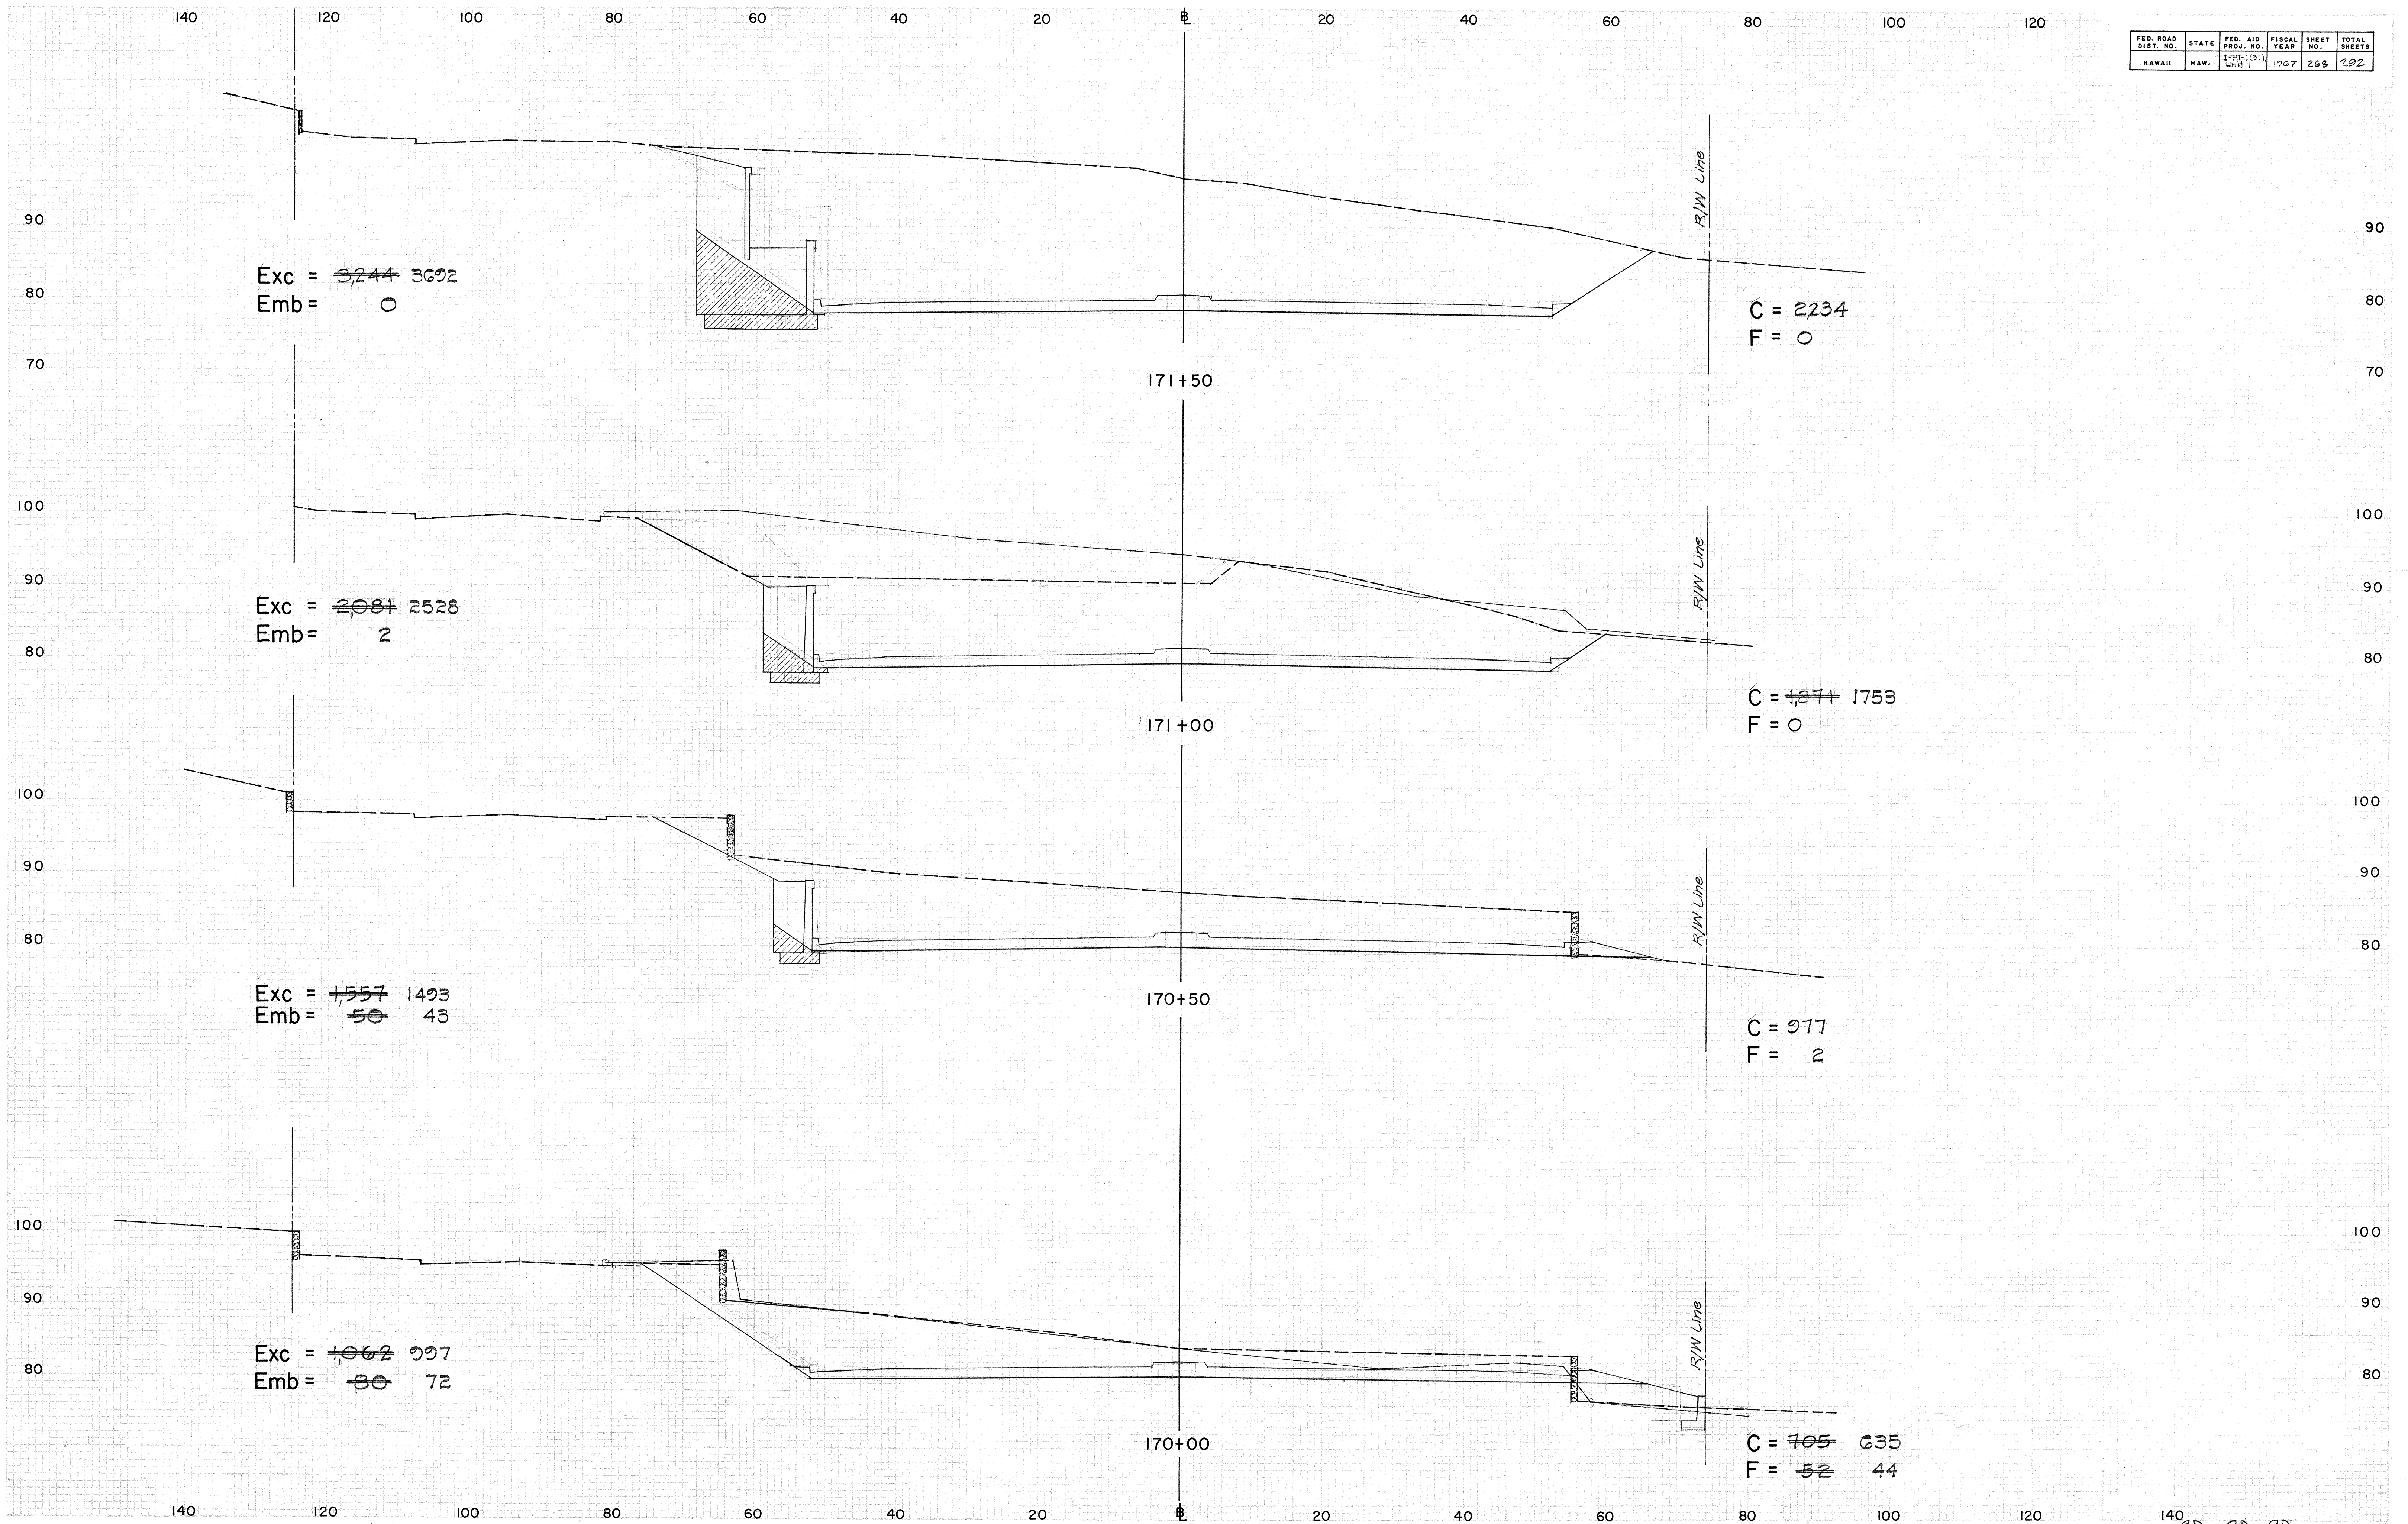

FED. ROAD DIST. NO.	STATE	FED. AID PROJ. NO.	FISCAL YEAR	SHEET NO.	TOTAL SHEETS
HAWAII	HAW.	1007	1967	269	292


DATE	
BY	
REVIEWED	
APPROVED	
DESIGNED	
NOTED	
NO.	

DATE	
BY	
REVIEWED	
APPROVED	
DESIGNED	
NOTED	
NO.	

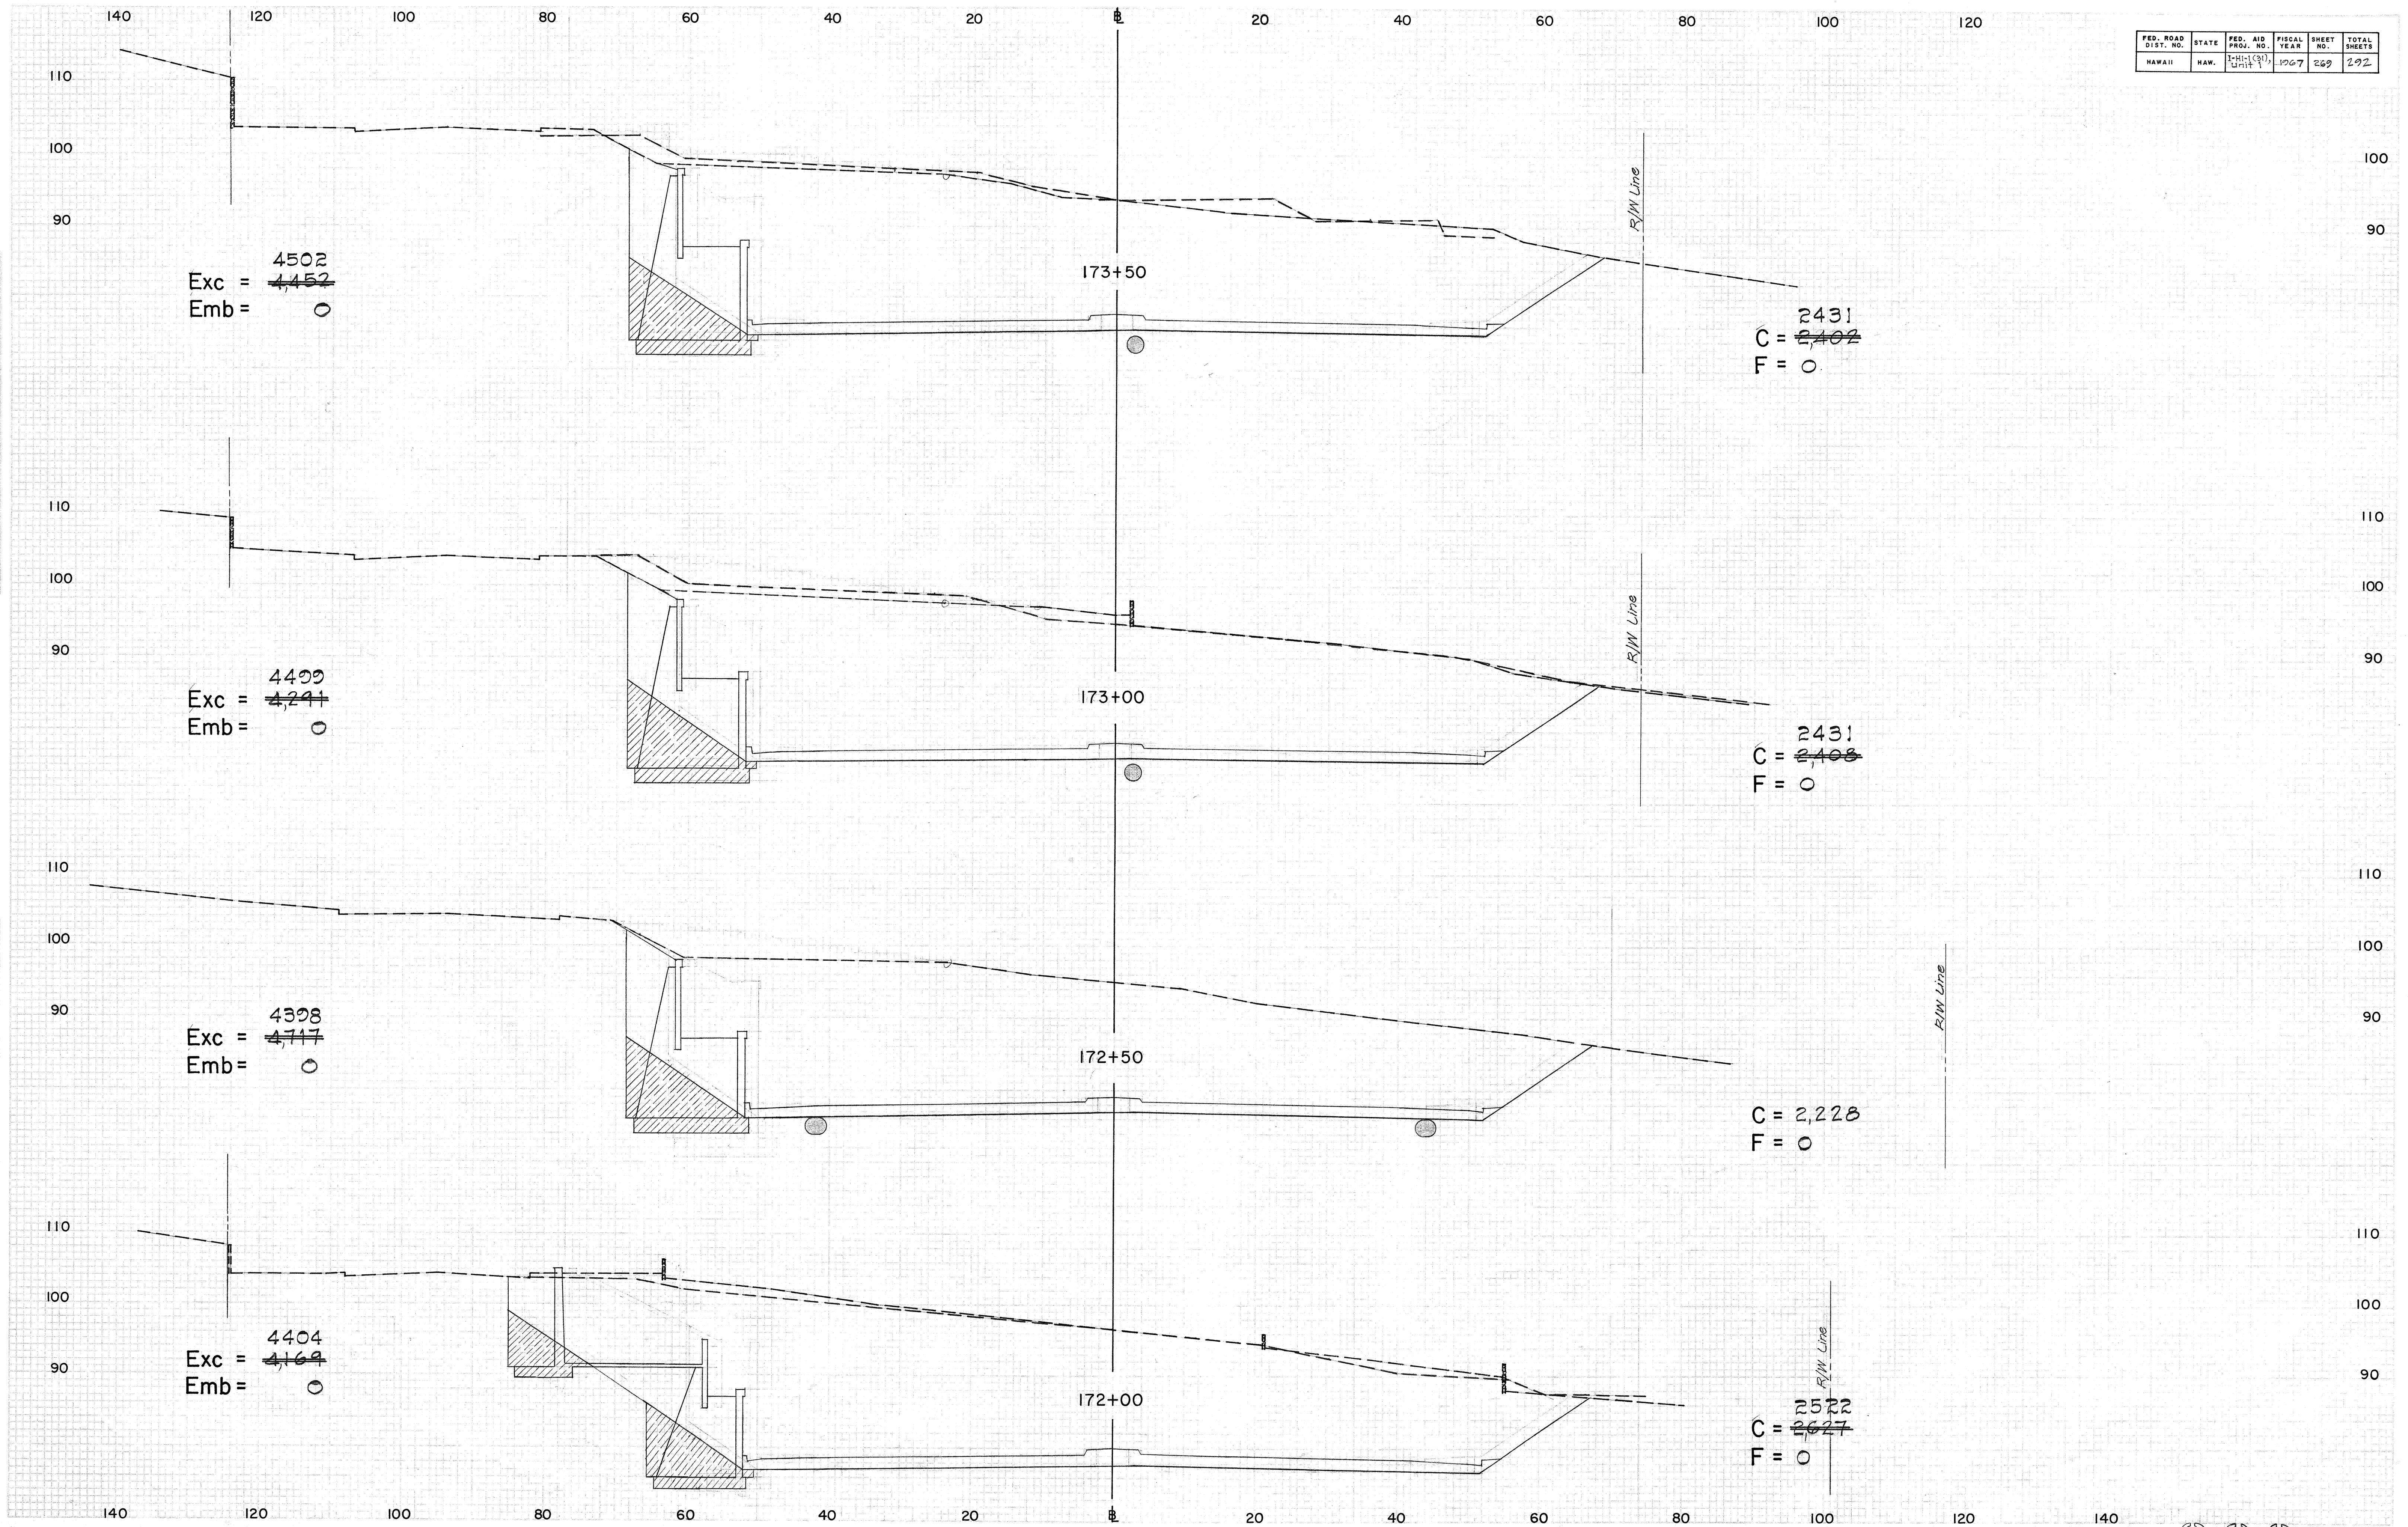

FED. ROAD DIST. NO.	STATE	FED. AID PROJ. NO.	FISCAL YEAR	SHEET NO.	TOTAL SHEETS
HAWAII	HAW.	211(81)	1967	270	292

Revised: April 3, 1968

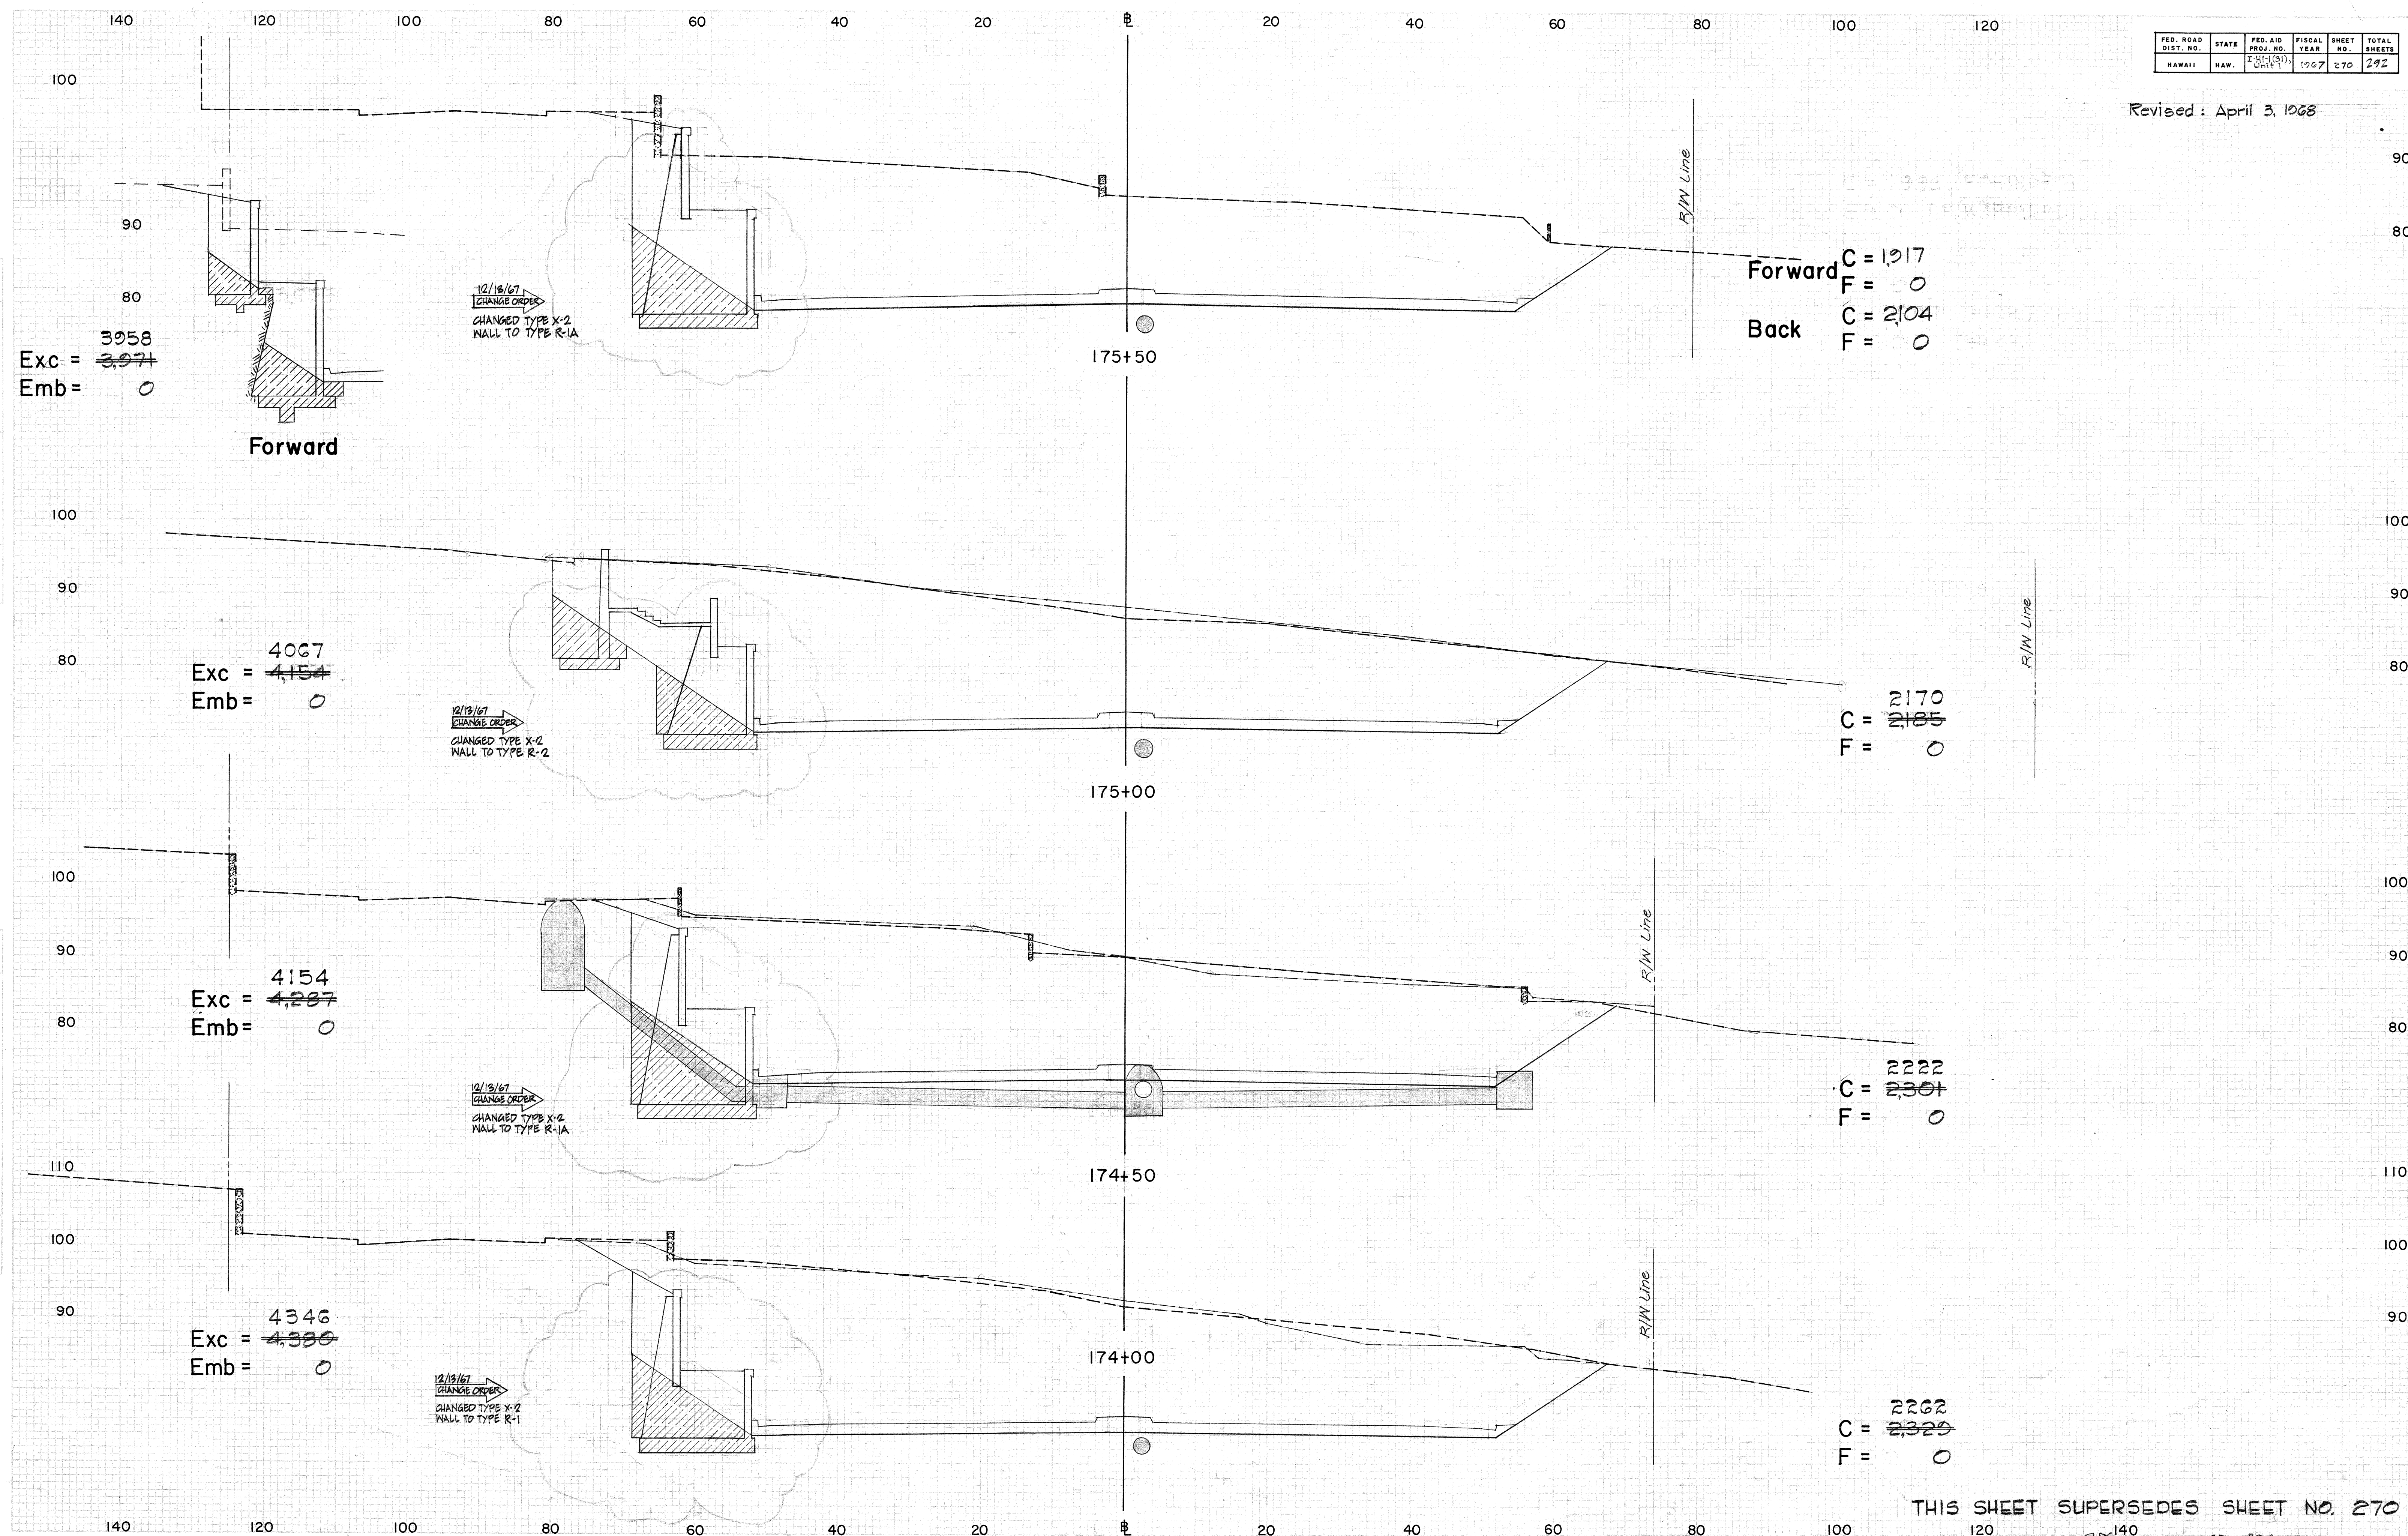


THIS SHEET SUPERSEDES SHEET NO. 270

(C) 140 270

FED. ROAD DIST. NO.	STATE	FED. AID PROJ. NO.	FISCAL YEAR	SHEET NO.	TOTAL SHEETS
HAWAII	HAW.	100	1967	271	292

Revised: April 3, 1968

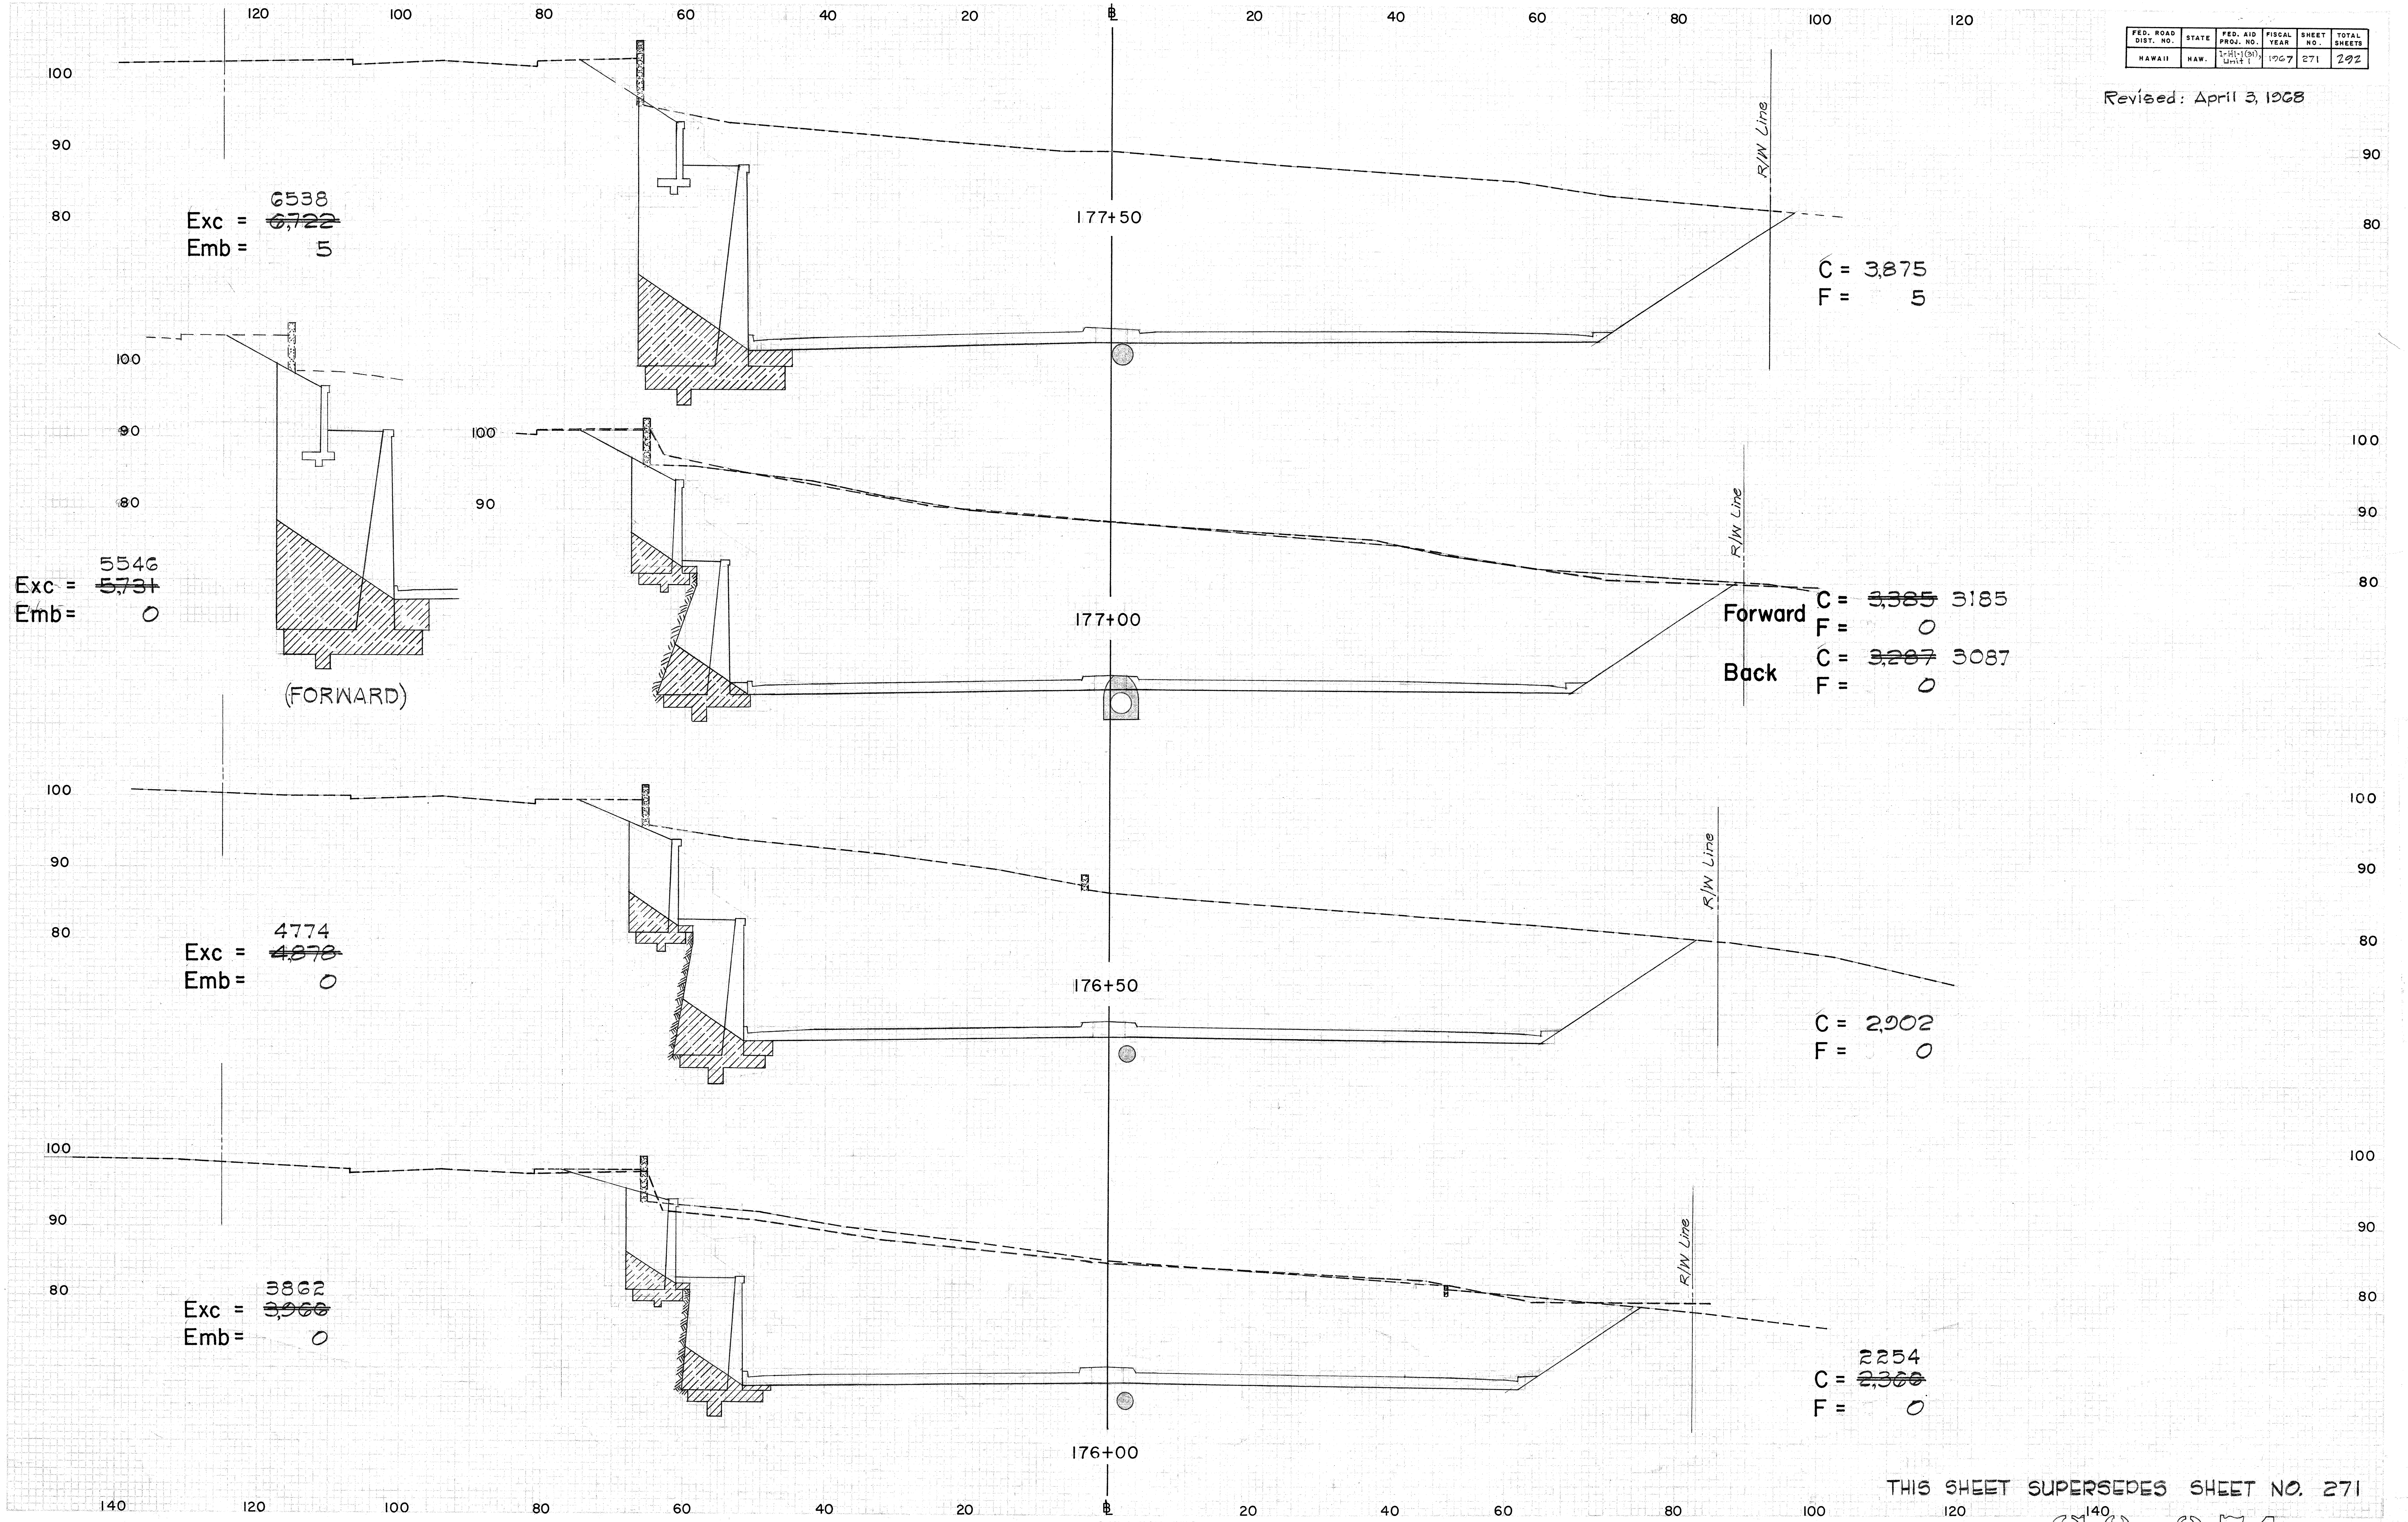

THIS SHEET SUPERSEDES SHEET NO. 271


(10) 271

FED. ROAD DIST. NO.	STATE	FED. AID PROJ. NO.	FISCAL YEAR	SHEET NO.	TOTAL SHEETS
HAWAII	HAW.	1067	1967	272	292

Revised: April 3, 1968

DATE	BY

DATE	BY

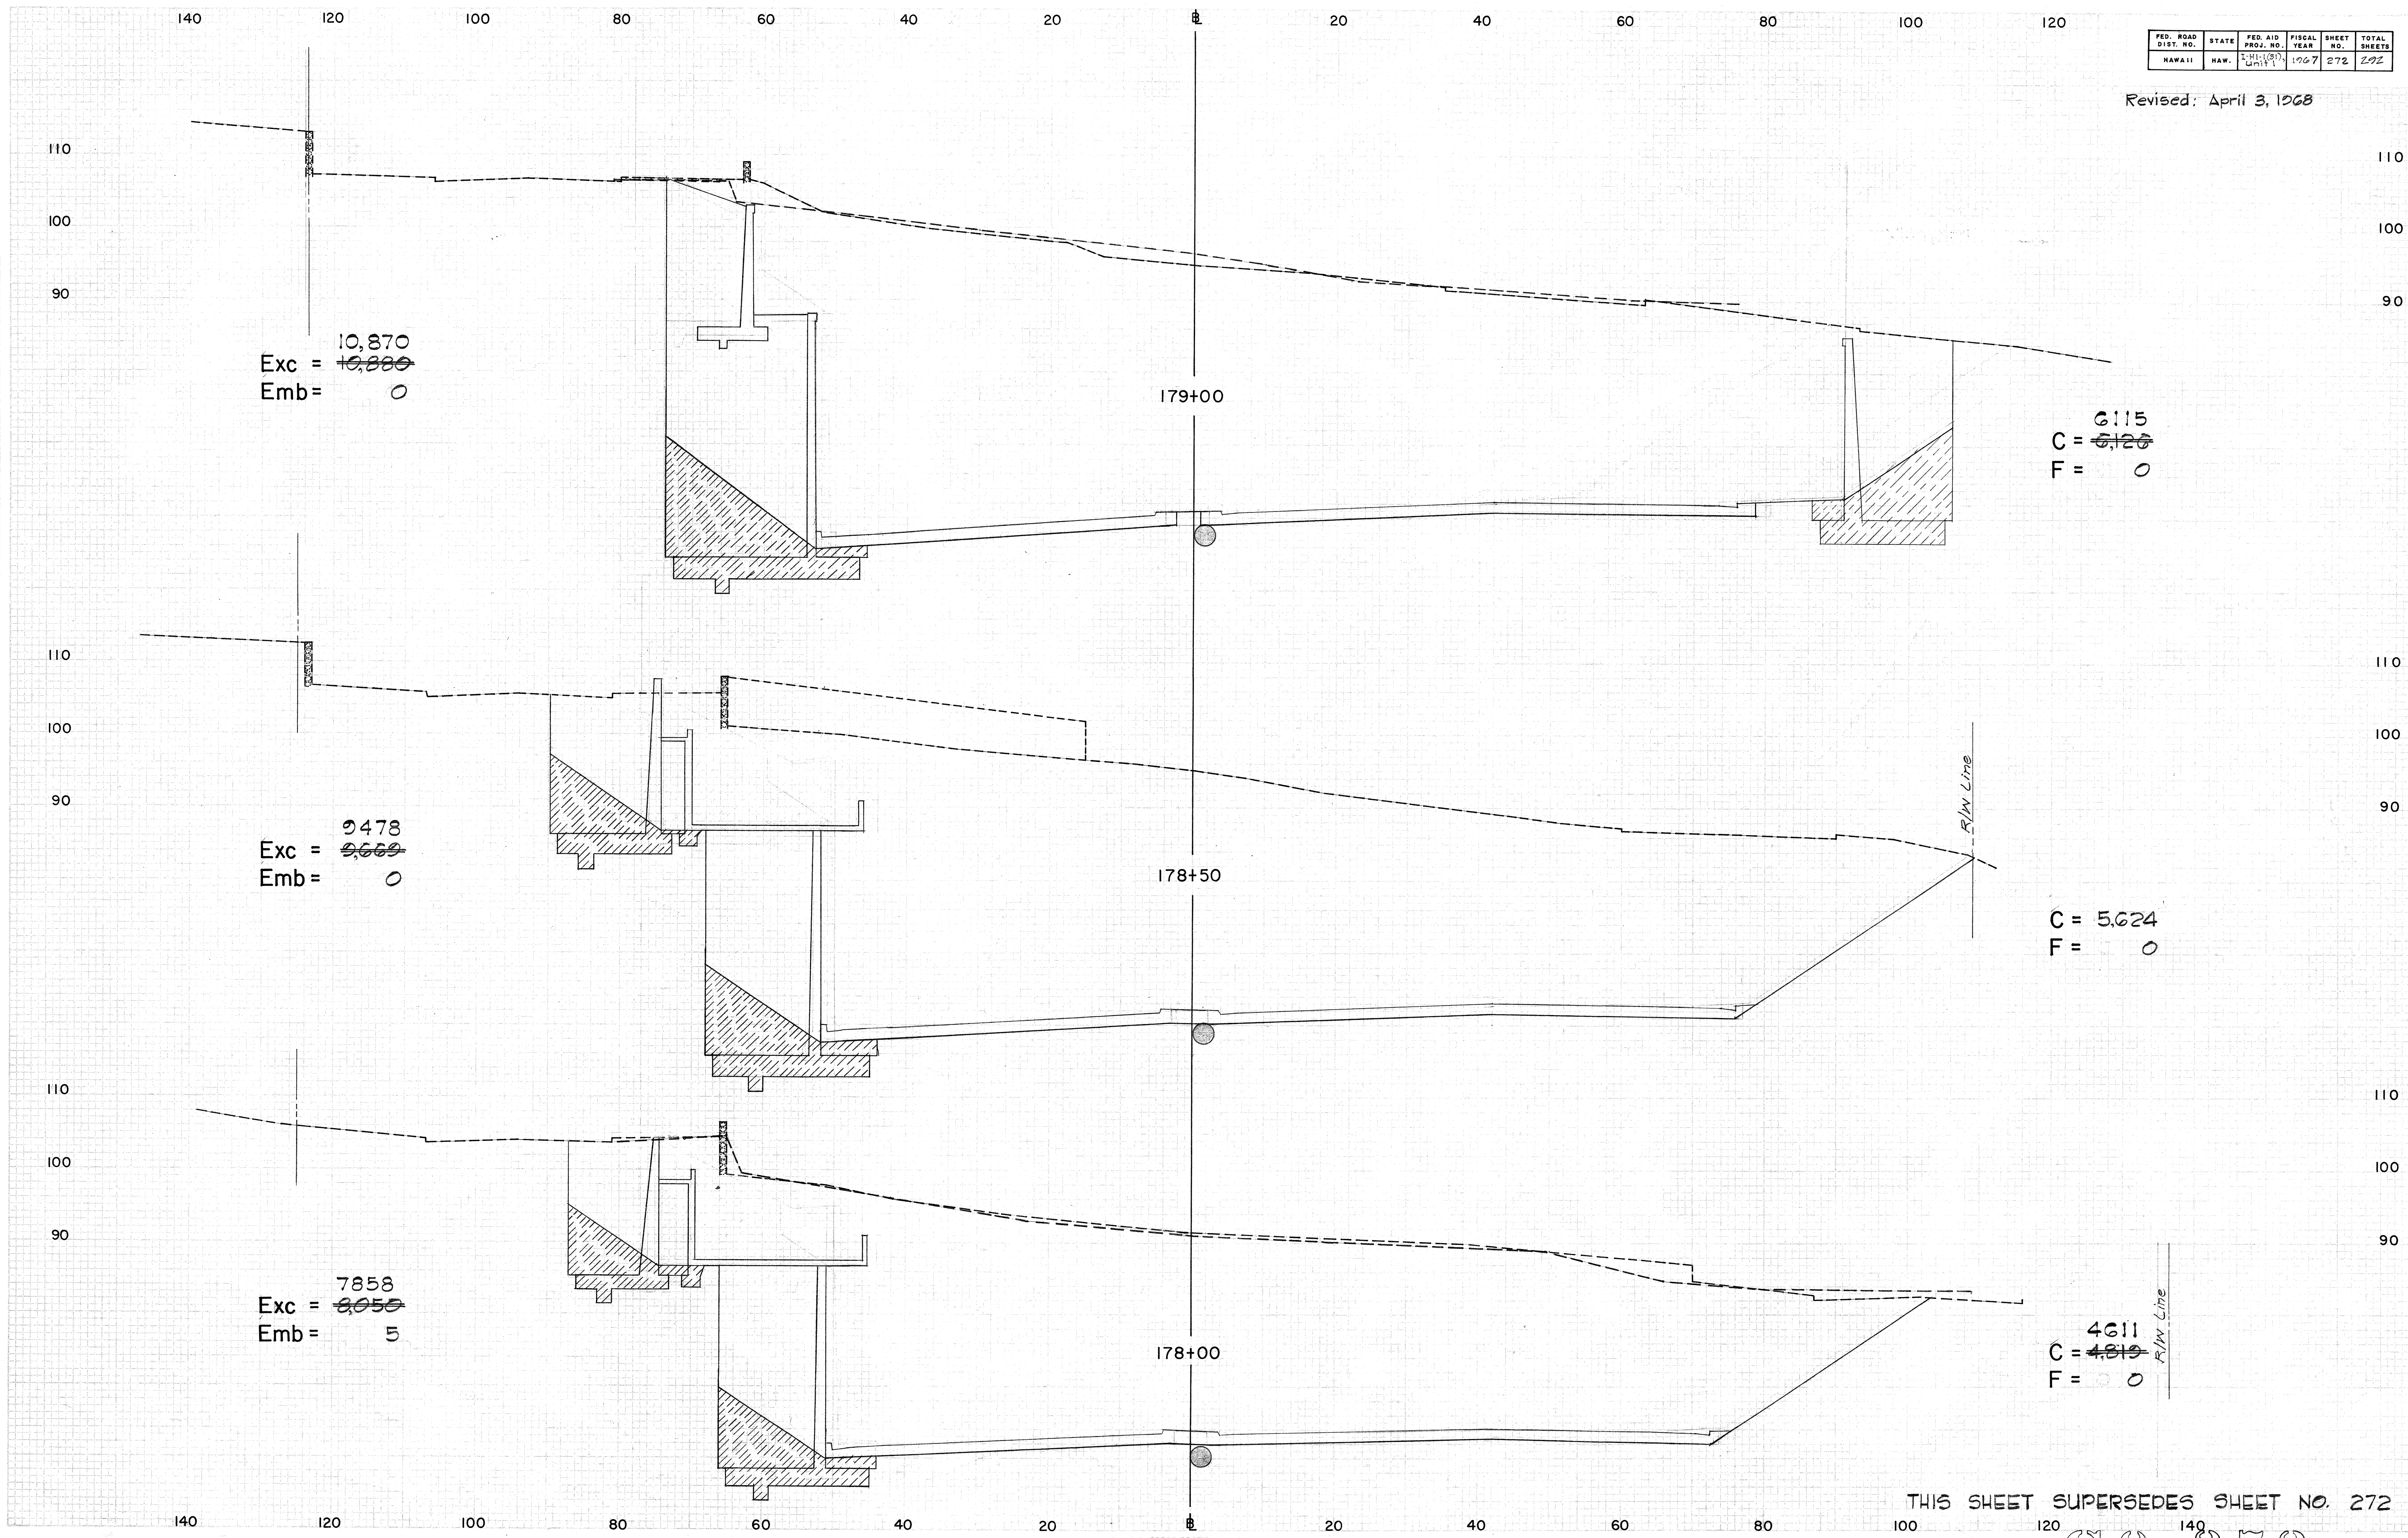

Exc = 10,870
Emb = 0

C = 6.115
F = 0

Exc = 2478
Emb = 0

C = 5.624
F = 0

Exc = 7858
Emb = 5


C = 4.611
F = 0

THIS SHEET SUPERSEDES SHEET NO. 272

(11) 272

FED. ROAD DIST. NO.	STATE	FED. AID PROJ. NO.	FISCAL YEAR	SHEET NO.	TOTAL SHEETS
HAWAII	HAW.	2-101 (201) Unit 1	1967	273	292

Revised: April 3, 1968

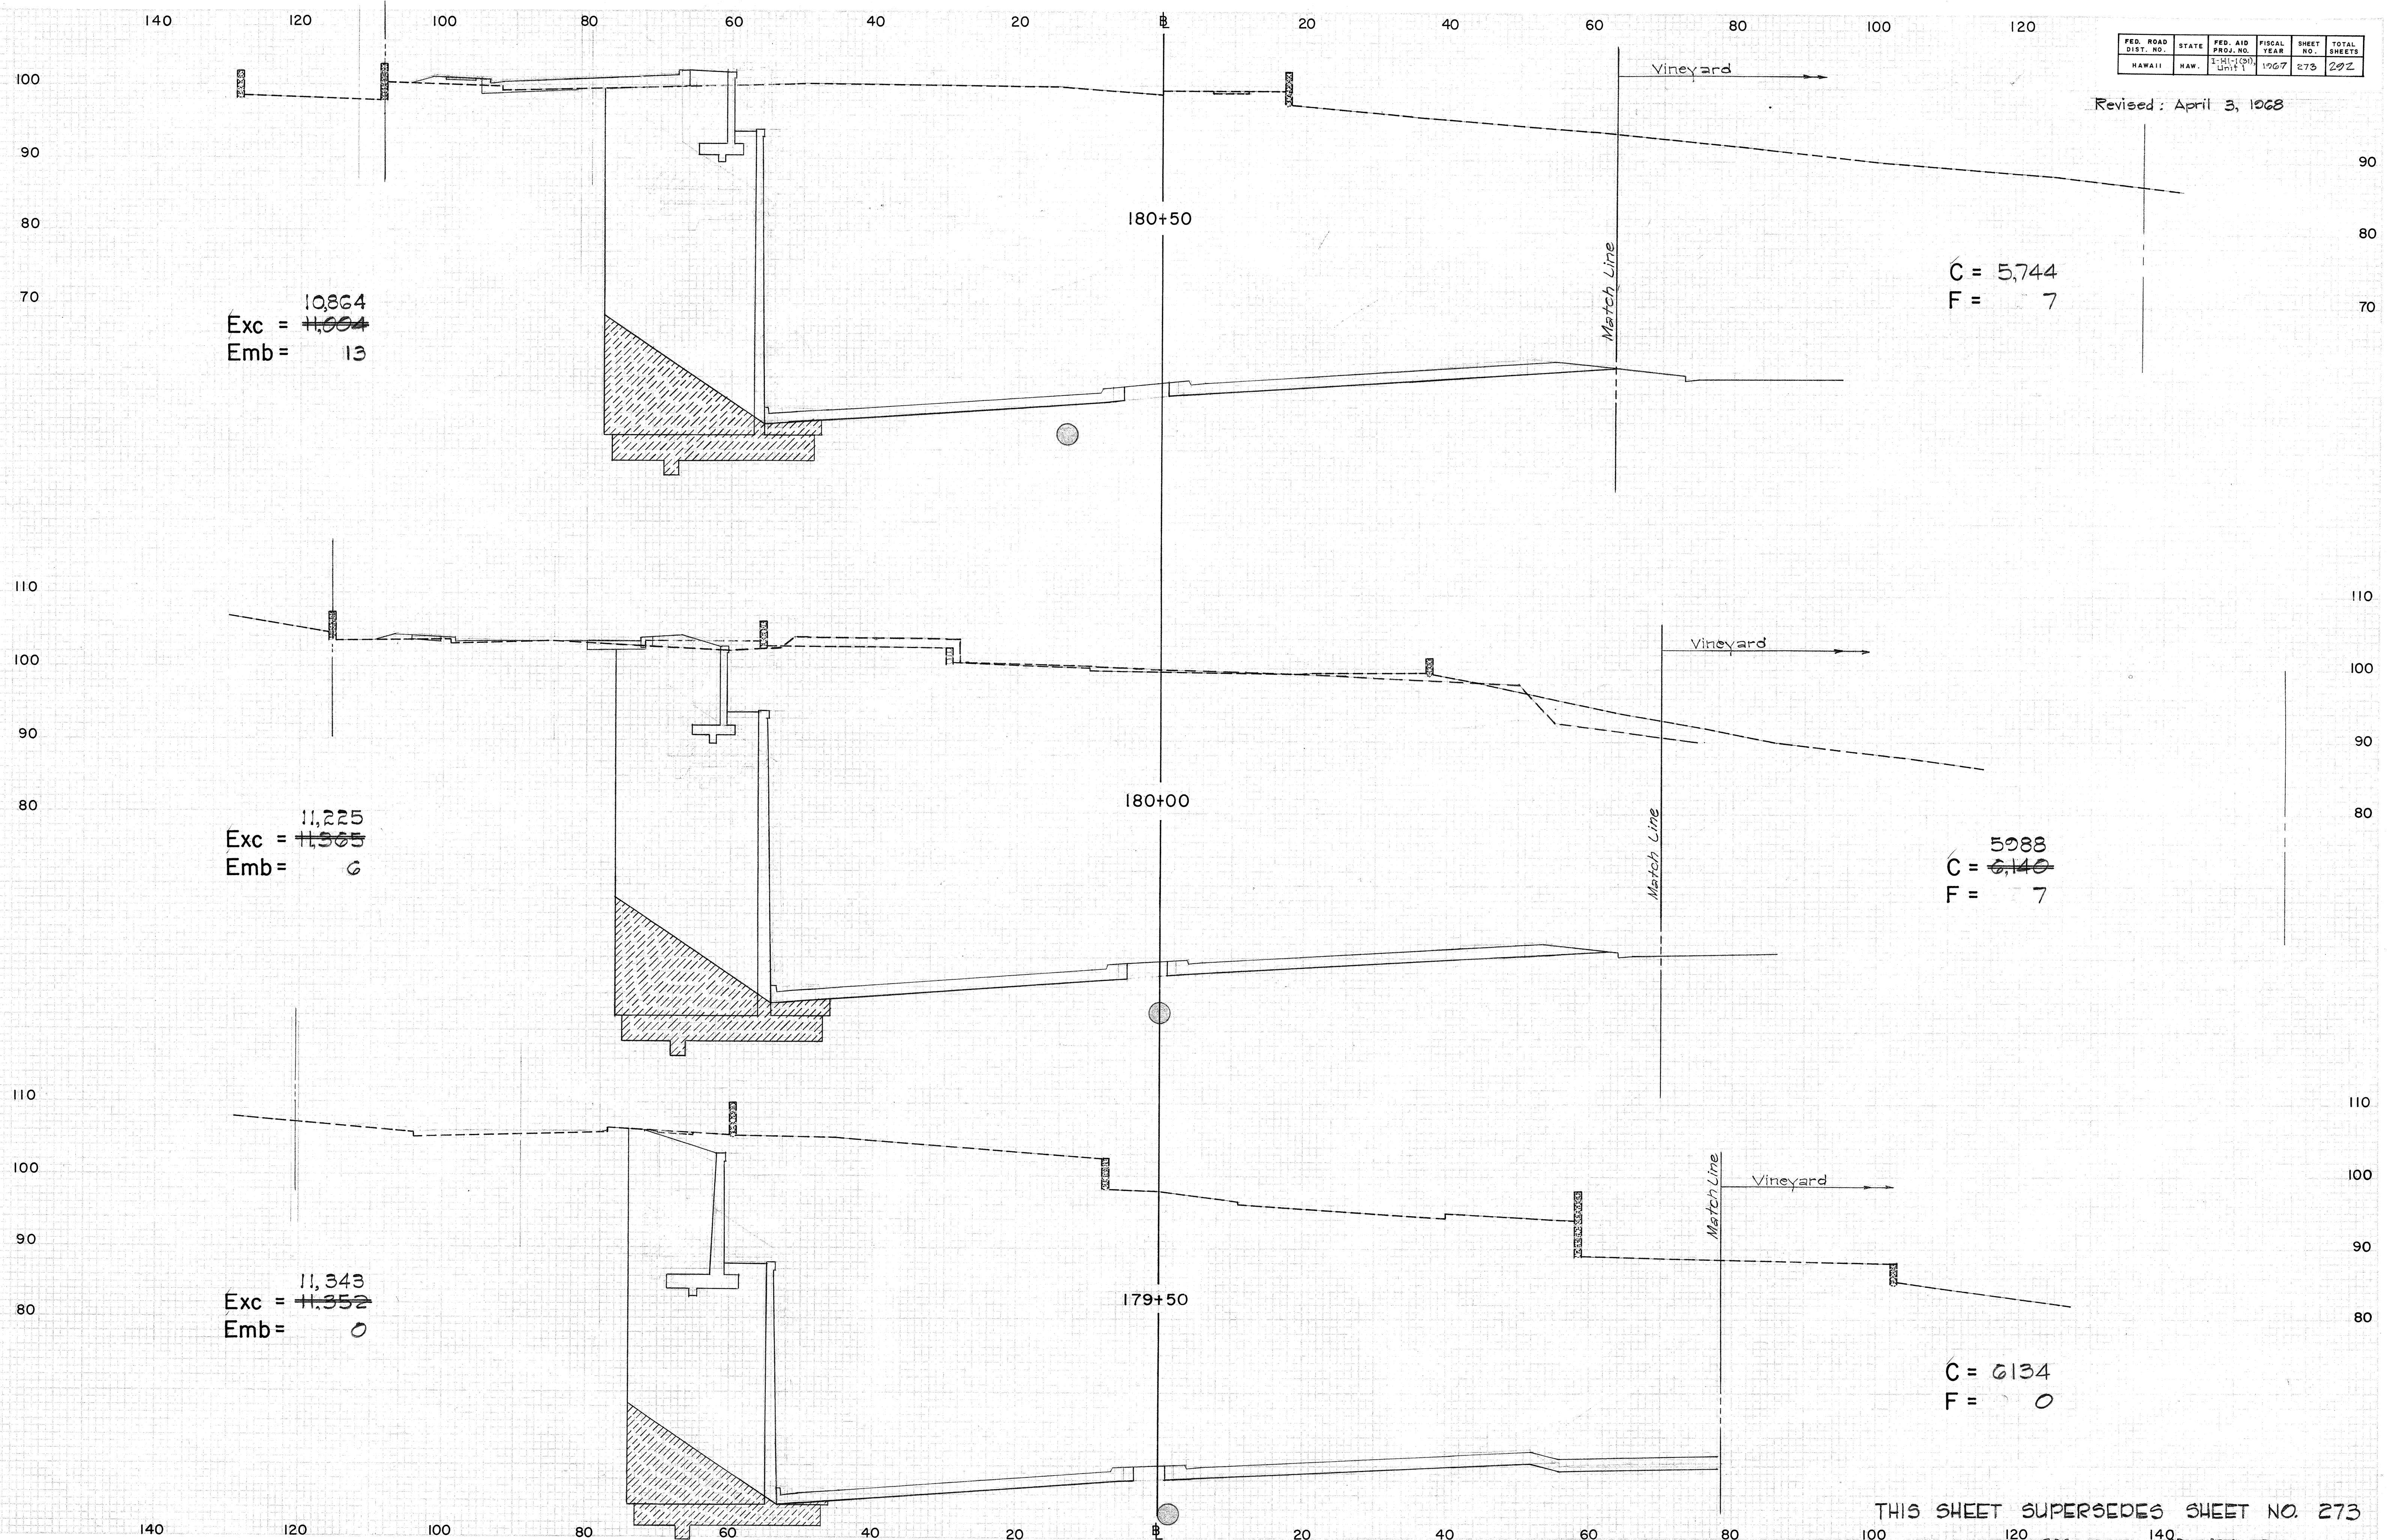

THIS SHEET SUPERSEDES SHEET NO. 273

(C) 1 273

FED. ROAD DIST. NO.	STATE	FED. AID PROJ. NO.	FISCAL YEAR	SHEET NO.	TOTAL SHEETS
HAWAII	HAW.	1067	1967	274	292

Revised: April 3, 1968

Exc = ~~8840~~
Emb = ~~17~~
7

182+50

Forward C = 4,033
F = 144
Back C = 4,033
F = 7

Exc = ~~8283~~
Emb = ~~36~~
26

182+00

C = 4,624
C = ~~4,717~~
F = ~~11~~
0

Exc = ~~8773~~
Emb = ~~72~~
72

181+50

C = 4,322
F = 28

Exc = ~~10,001~~
Emb = ~~10,145~~
50

181+00

C = 5,153
C = ~~5,210~~
F = 57

THIS SHEET SUPERSEDES SHEET NO. 274


(C) 274

FED. ROAD DIST. NO.	STATE	FED. AID PROJ. NO.	FISCAL YEAR	SHEET NO.	TOTAL SHEETS
HAWAII	HAW.	1-111(01) Unit 1	1967	275	292

Revised: April 3, 1968

FINAL
SURVEY
NOTE BOOK
NO.

ORIGINAL
SURVEY
NOTE BOOK
NO.

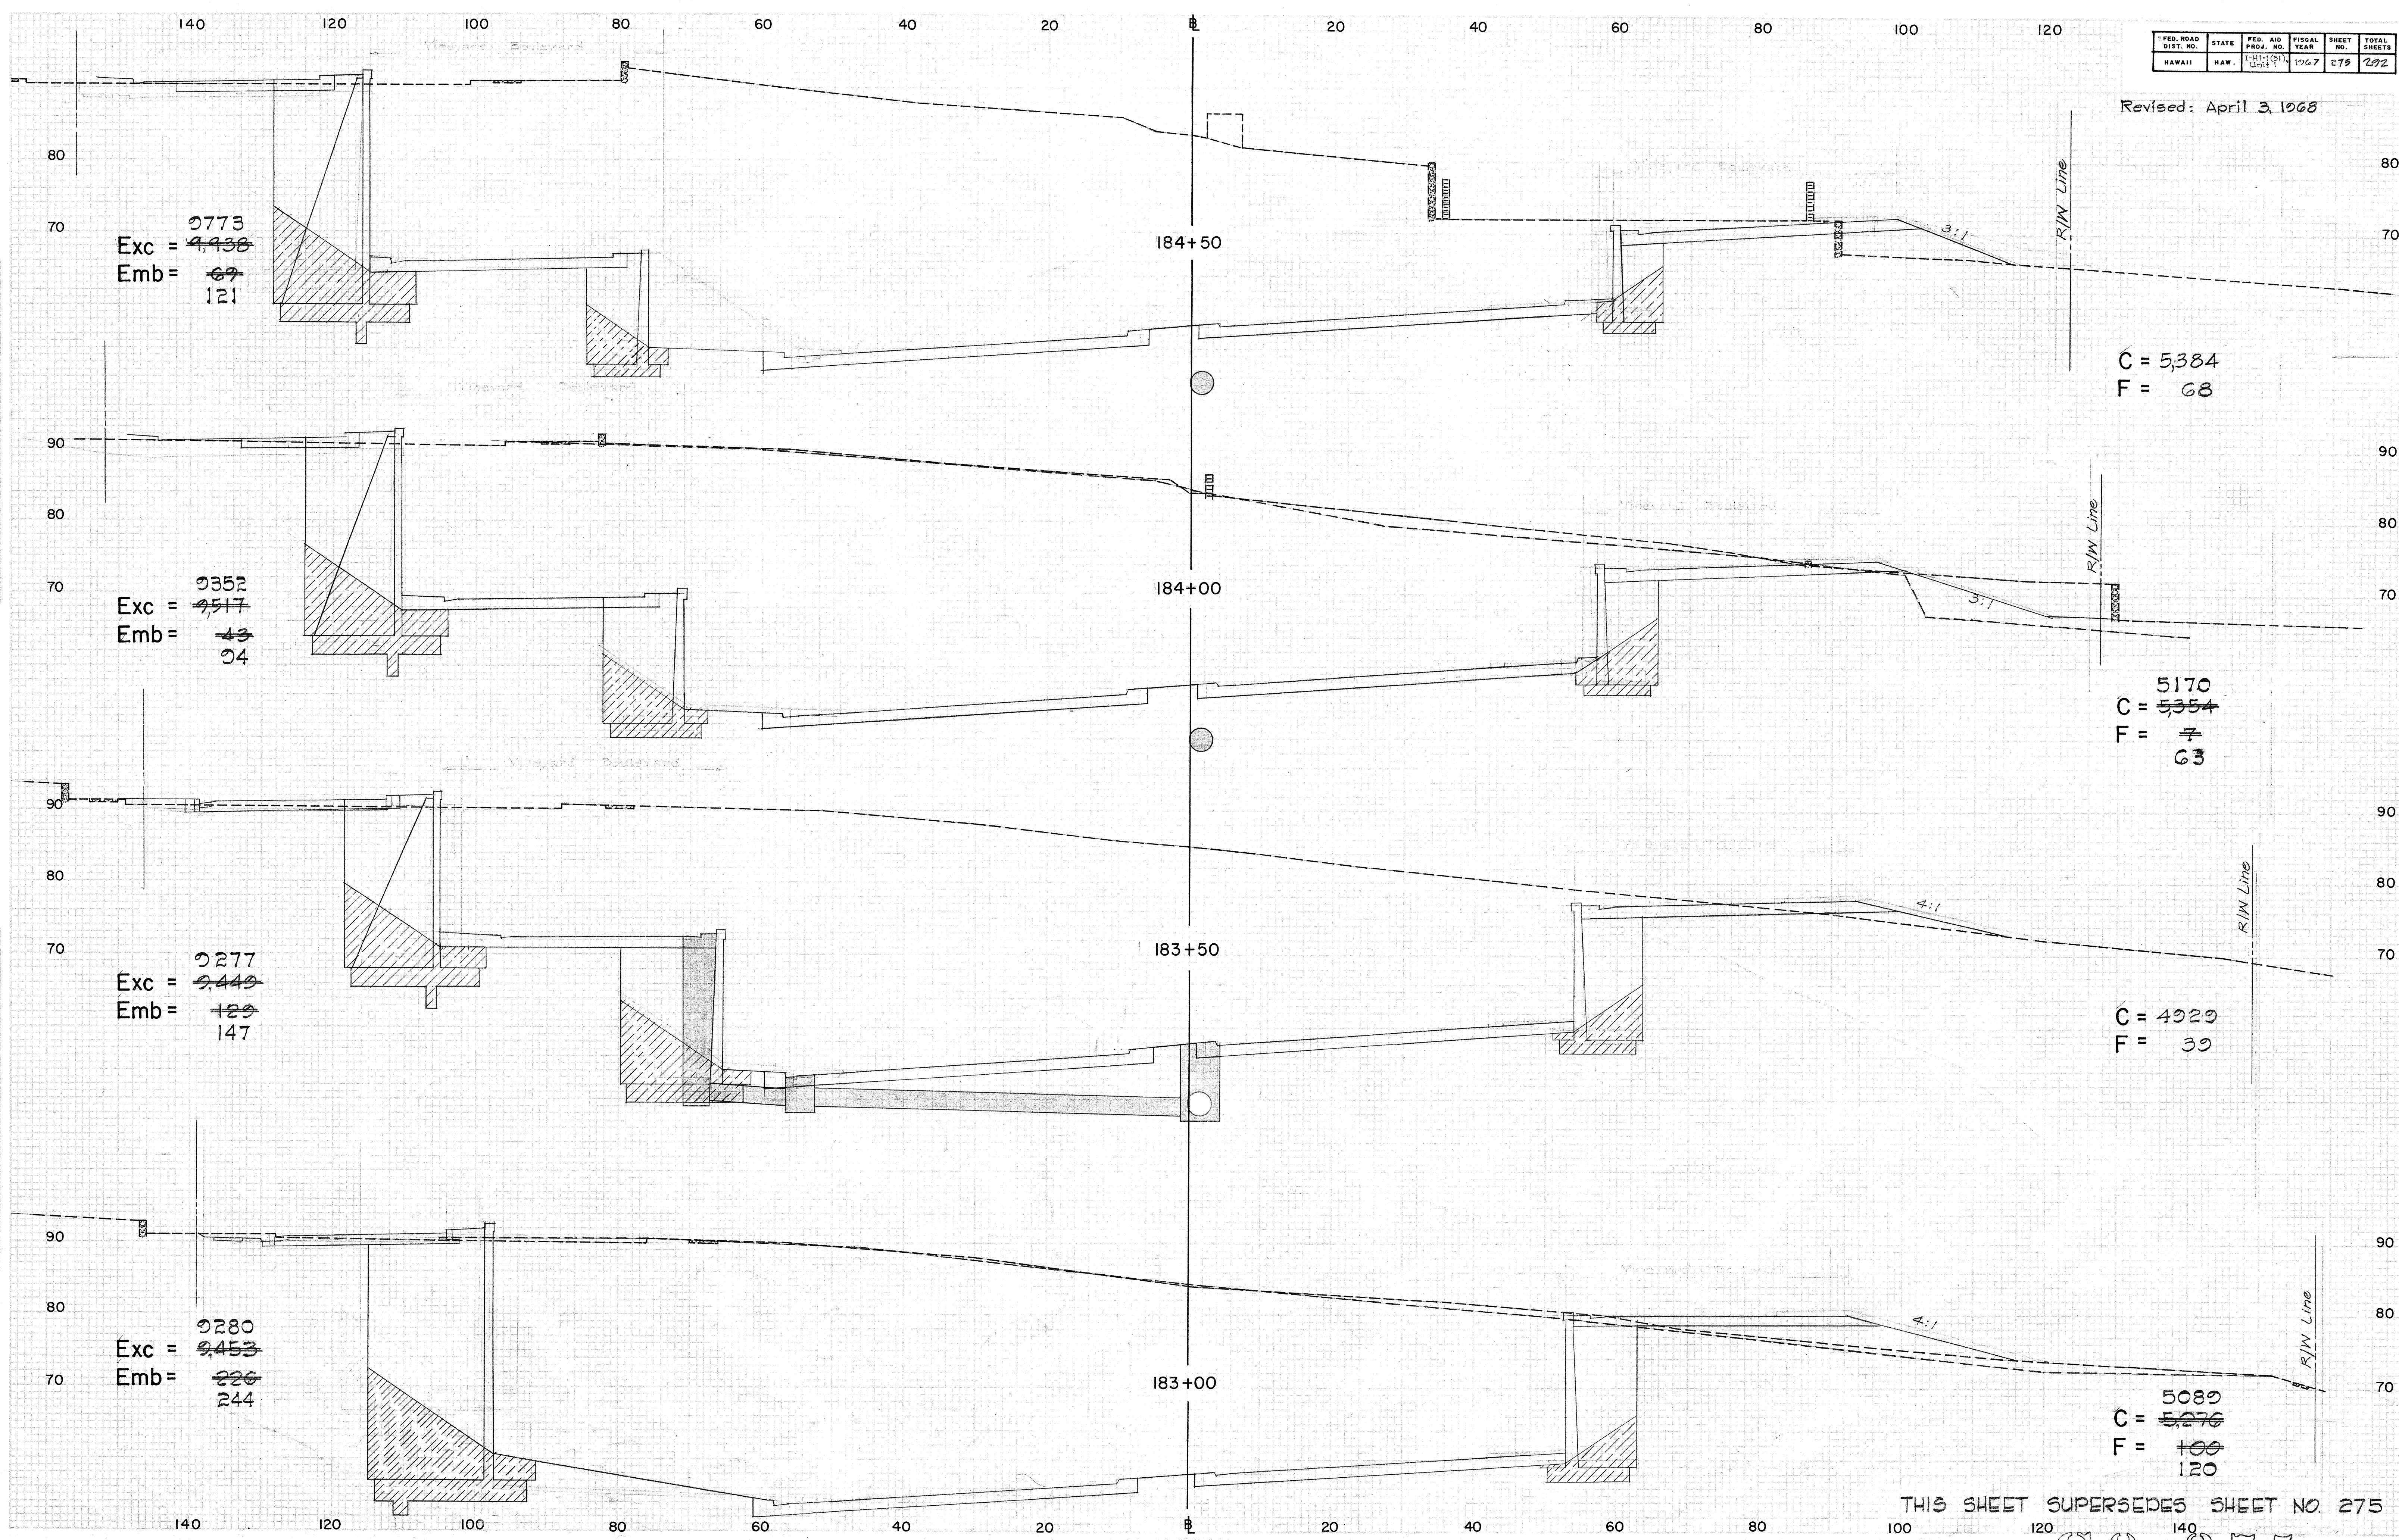

2773
Exc = ~~4,436~~
Emb = ~~67~~
121

C = 5,384
F = 68

2352
Exc = ~~2,517~~
Emb = ~~43~~
24

5170
C = ~~5,354~~
F = ~~7~~
63

2277
Exc = ~~2,449~~
Emb = ~~129~~
147

C = 4929
F = 39

2280
Exc = ~~2,453~~
Emb = ~~226~~
244

5089
C = ~~5,276~~
F = ~~100~~
120


THIS SHEET SUPERSEDES SHEET NO. 275

(C) 275

FED. ROAD DIST. NO.	STATE	FED. AID PROJ. NO.	FISCAL YEAR	SHEET NO.	TOTAL SHEETS
HAWAII	HAW	1-HI-1(51) Unit 1	1967	276	292

ORIGINAL SURVEY
DATE: 10/1/67
BY: [Signature]
CHECKED: [Signature]
APPROVED: [Signature]


ORIGINAL SURVEY
DATE: 10/1/67
BY: [Signature]
CHECKED: [Signature]
APPROVED: [Signature]

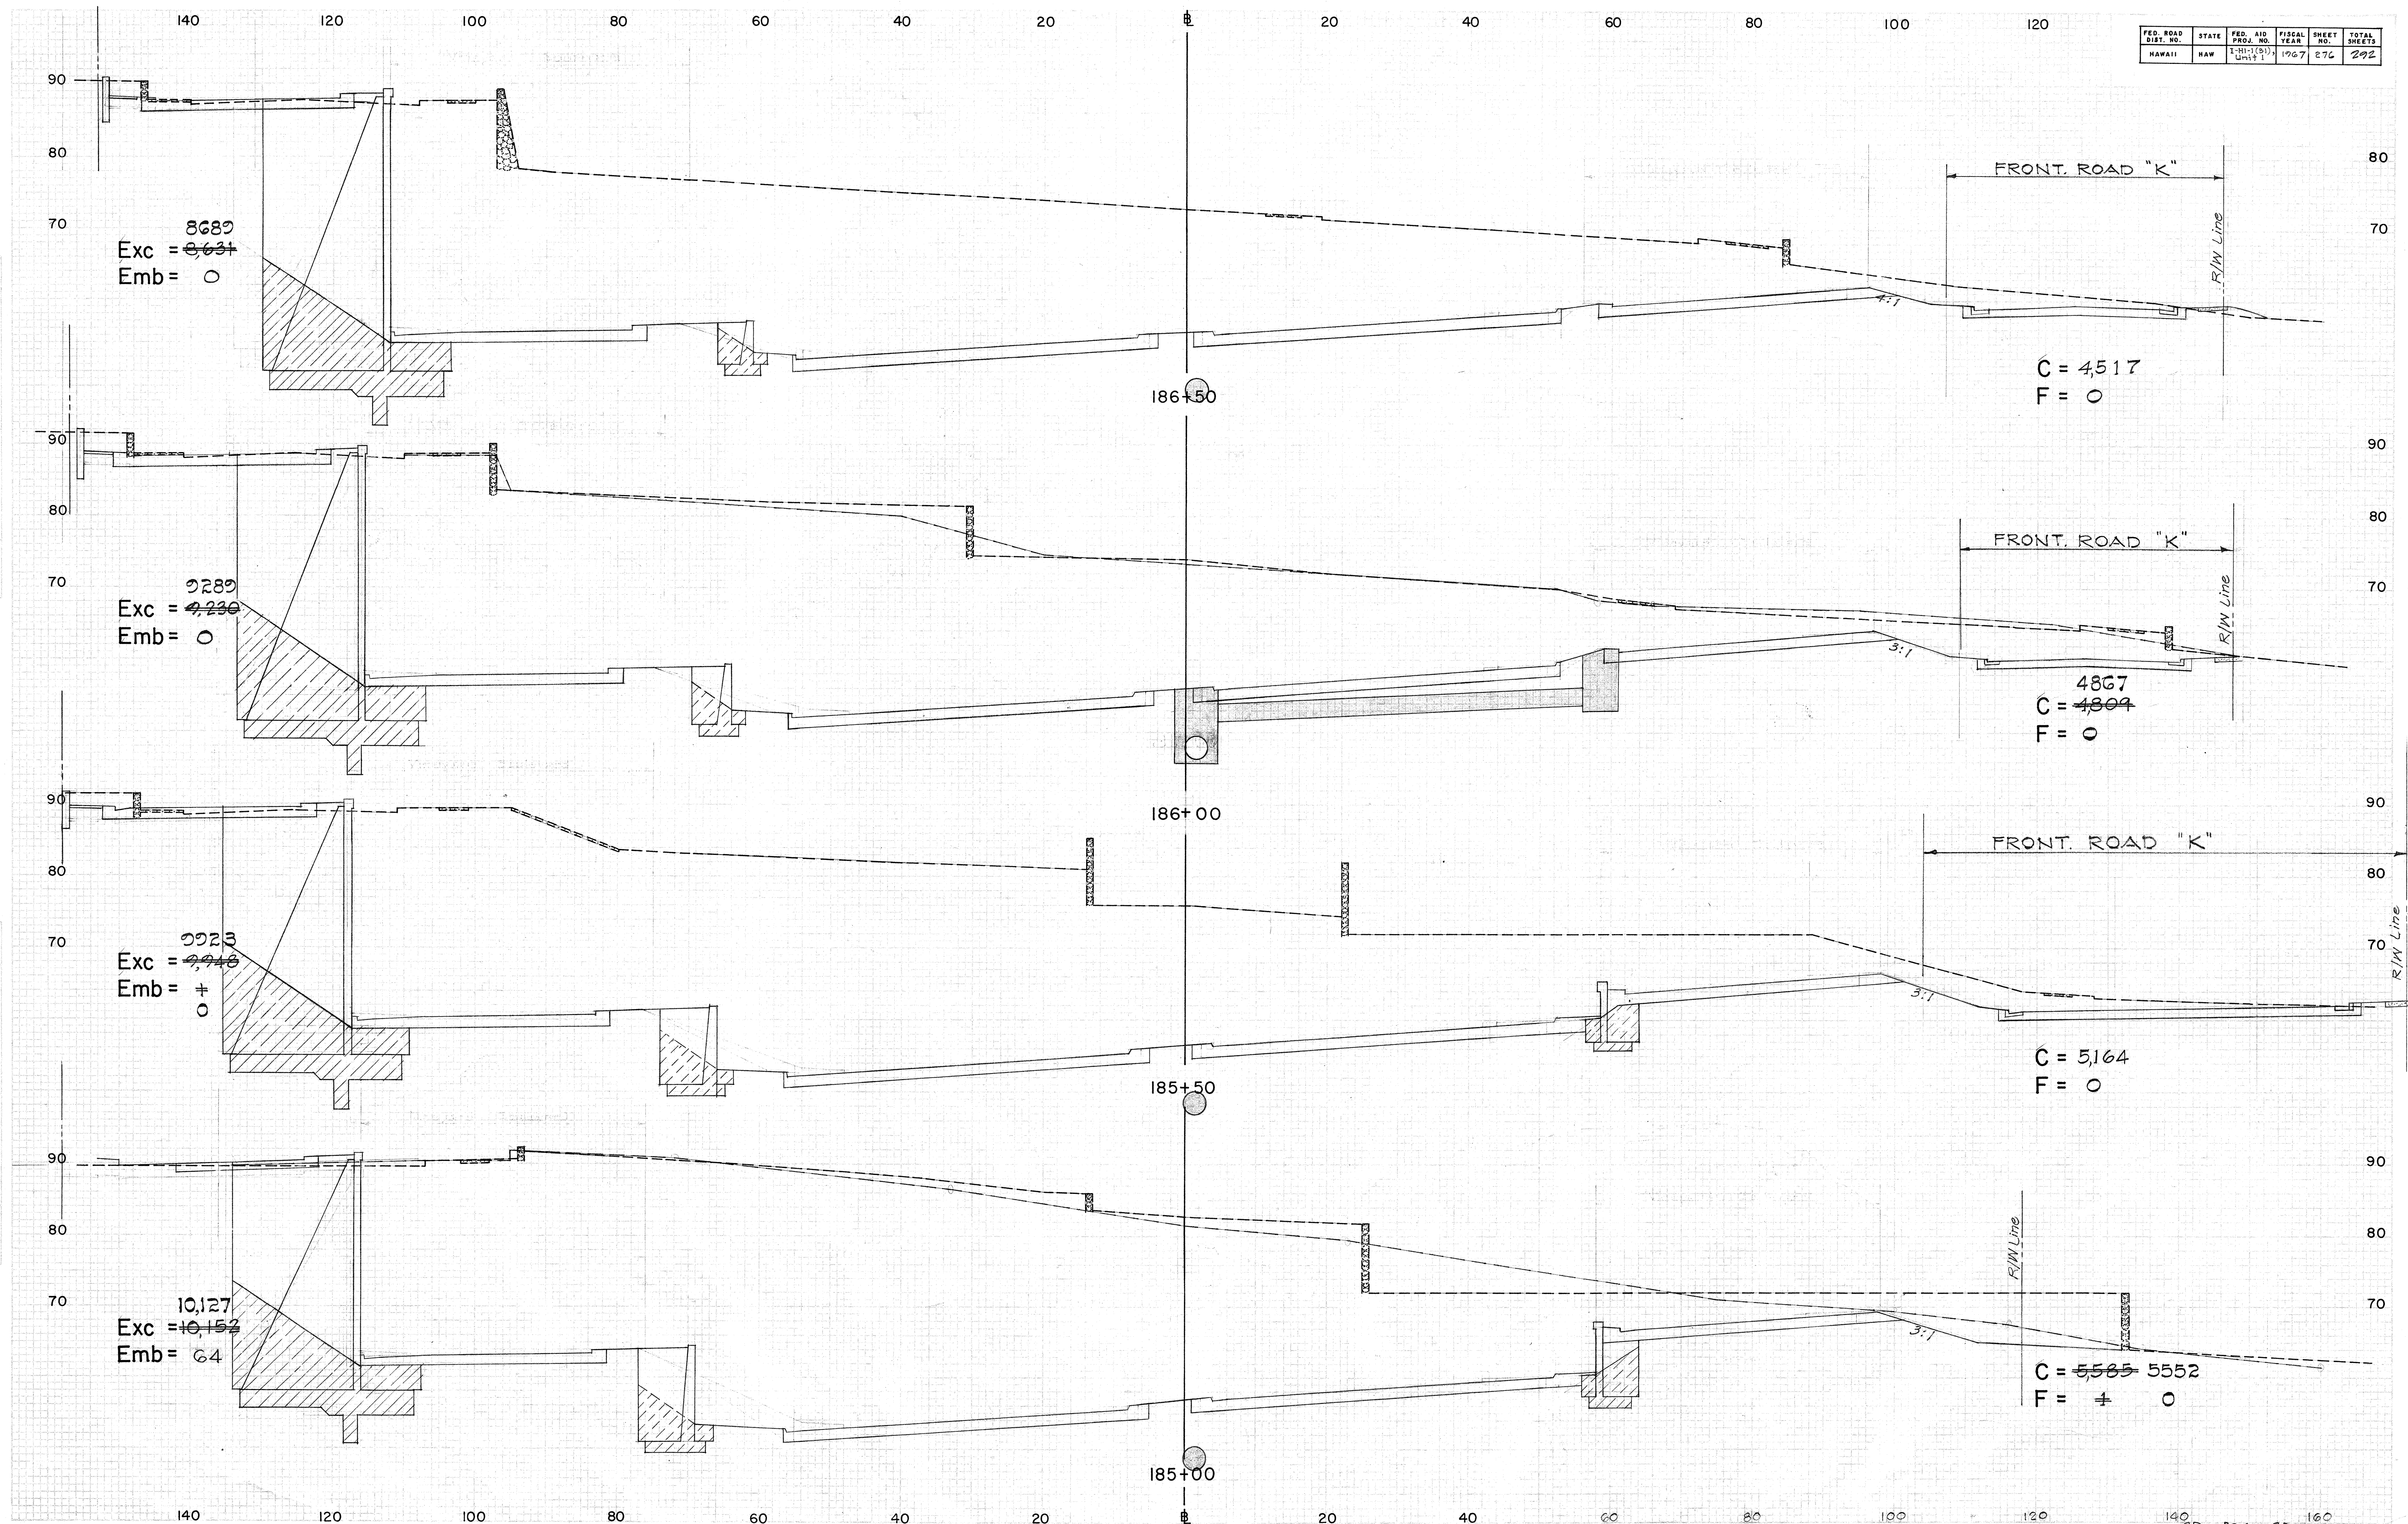

FED. ROAD DIST. NO.	STATE	FED. AID PROJ. NO.	FISCAL YEAR	SHEET NO.	TOTAL SHEETS
HAWAII	HAW	1-101-100	1967	277	292

FINAL SURVEY	SUPPLEMENT	DATE
NO. 1	NO. 1	NO. 1


ORIGINAL SURVEY	DATE
NO. 1	NO. 1

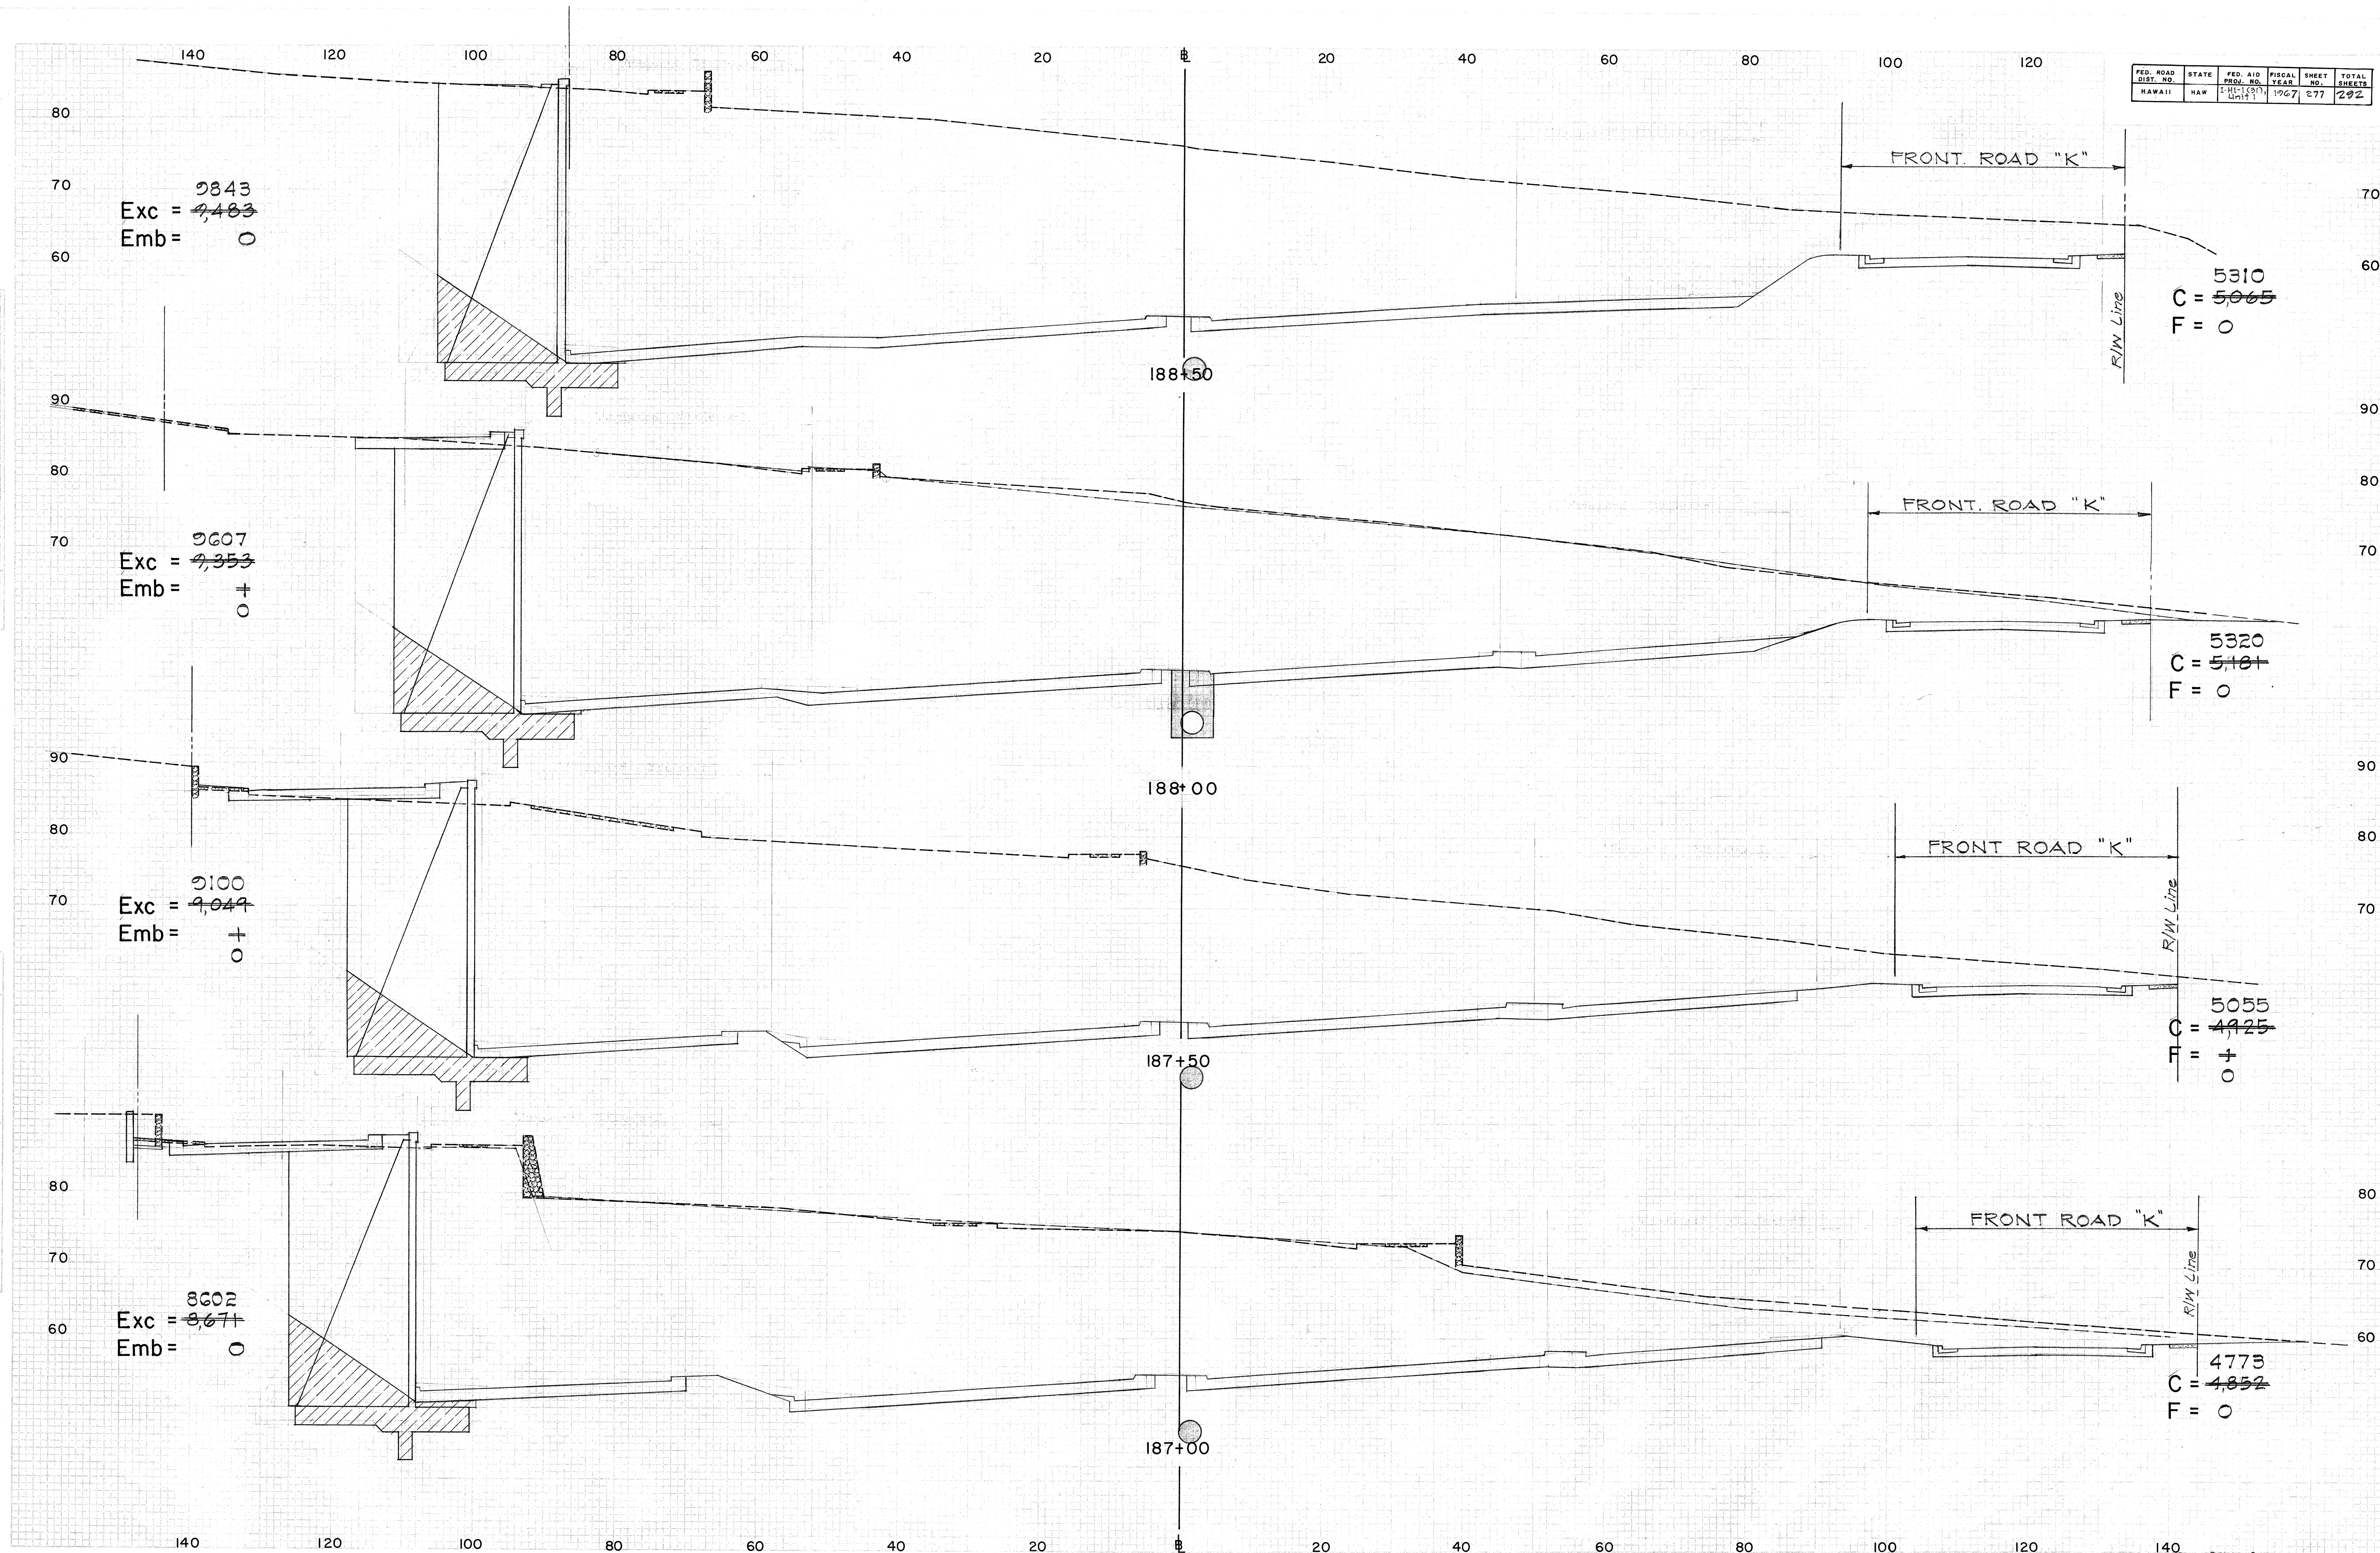

FED. ROAD DIST. NO.	STATE	FED. AID PROJ. NO.	FISCAL YEAR	SHEET NO.	TOTAL SHEETS
HAWAII	HAW	141(51) Unit 1	1967	278	292

DESIGNED BY	DATE
SURVEYED BY	
NOTED BY	
APPROVED BY	


DESIGNED BY	DATE
SURVEYED BY	
NOTED BY	
APPROVED BY	

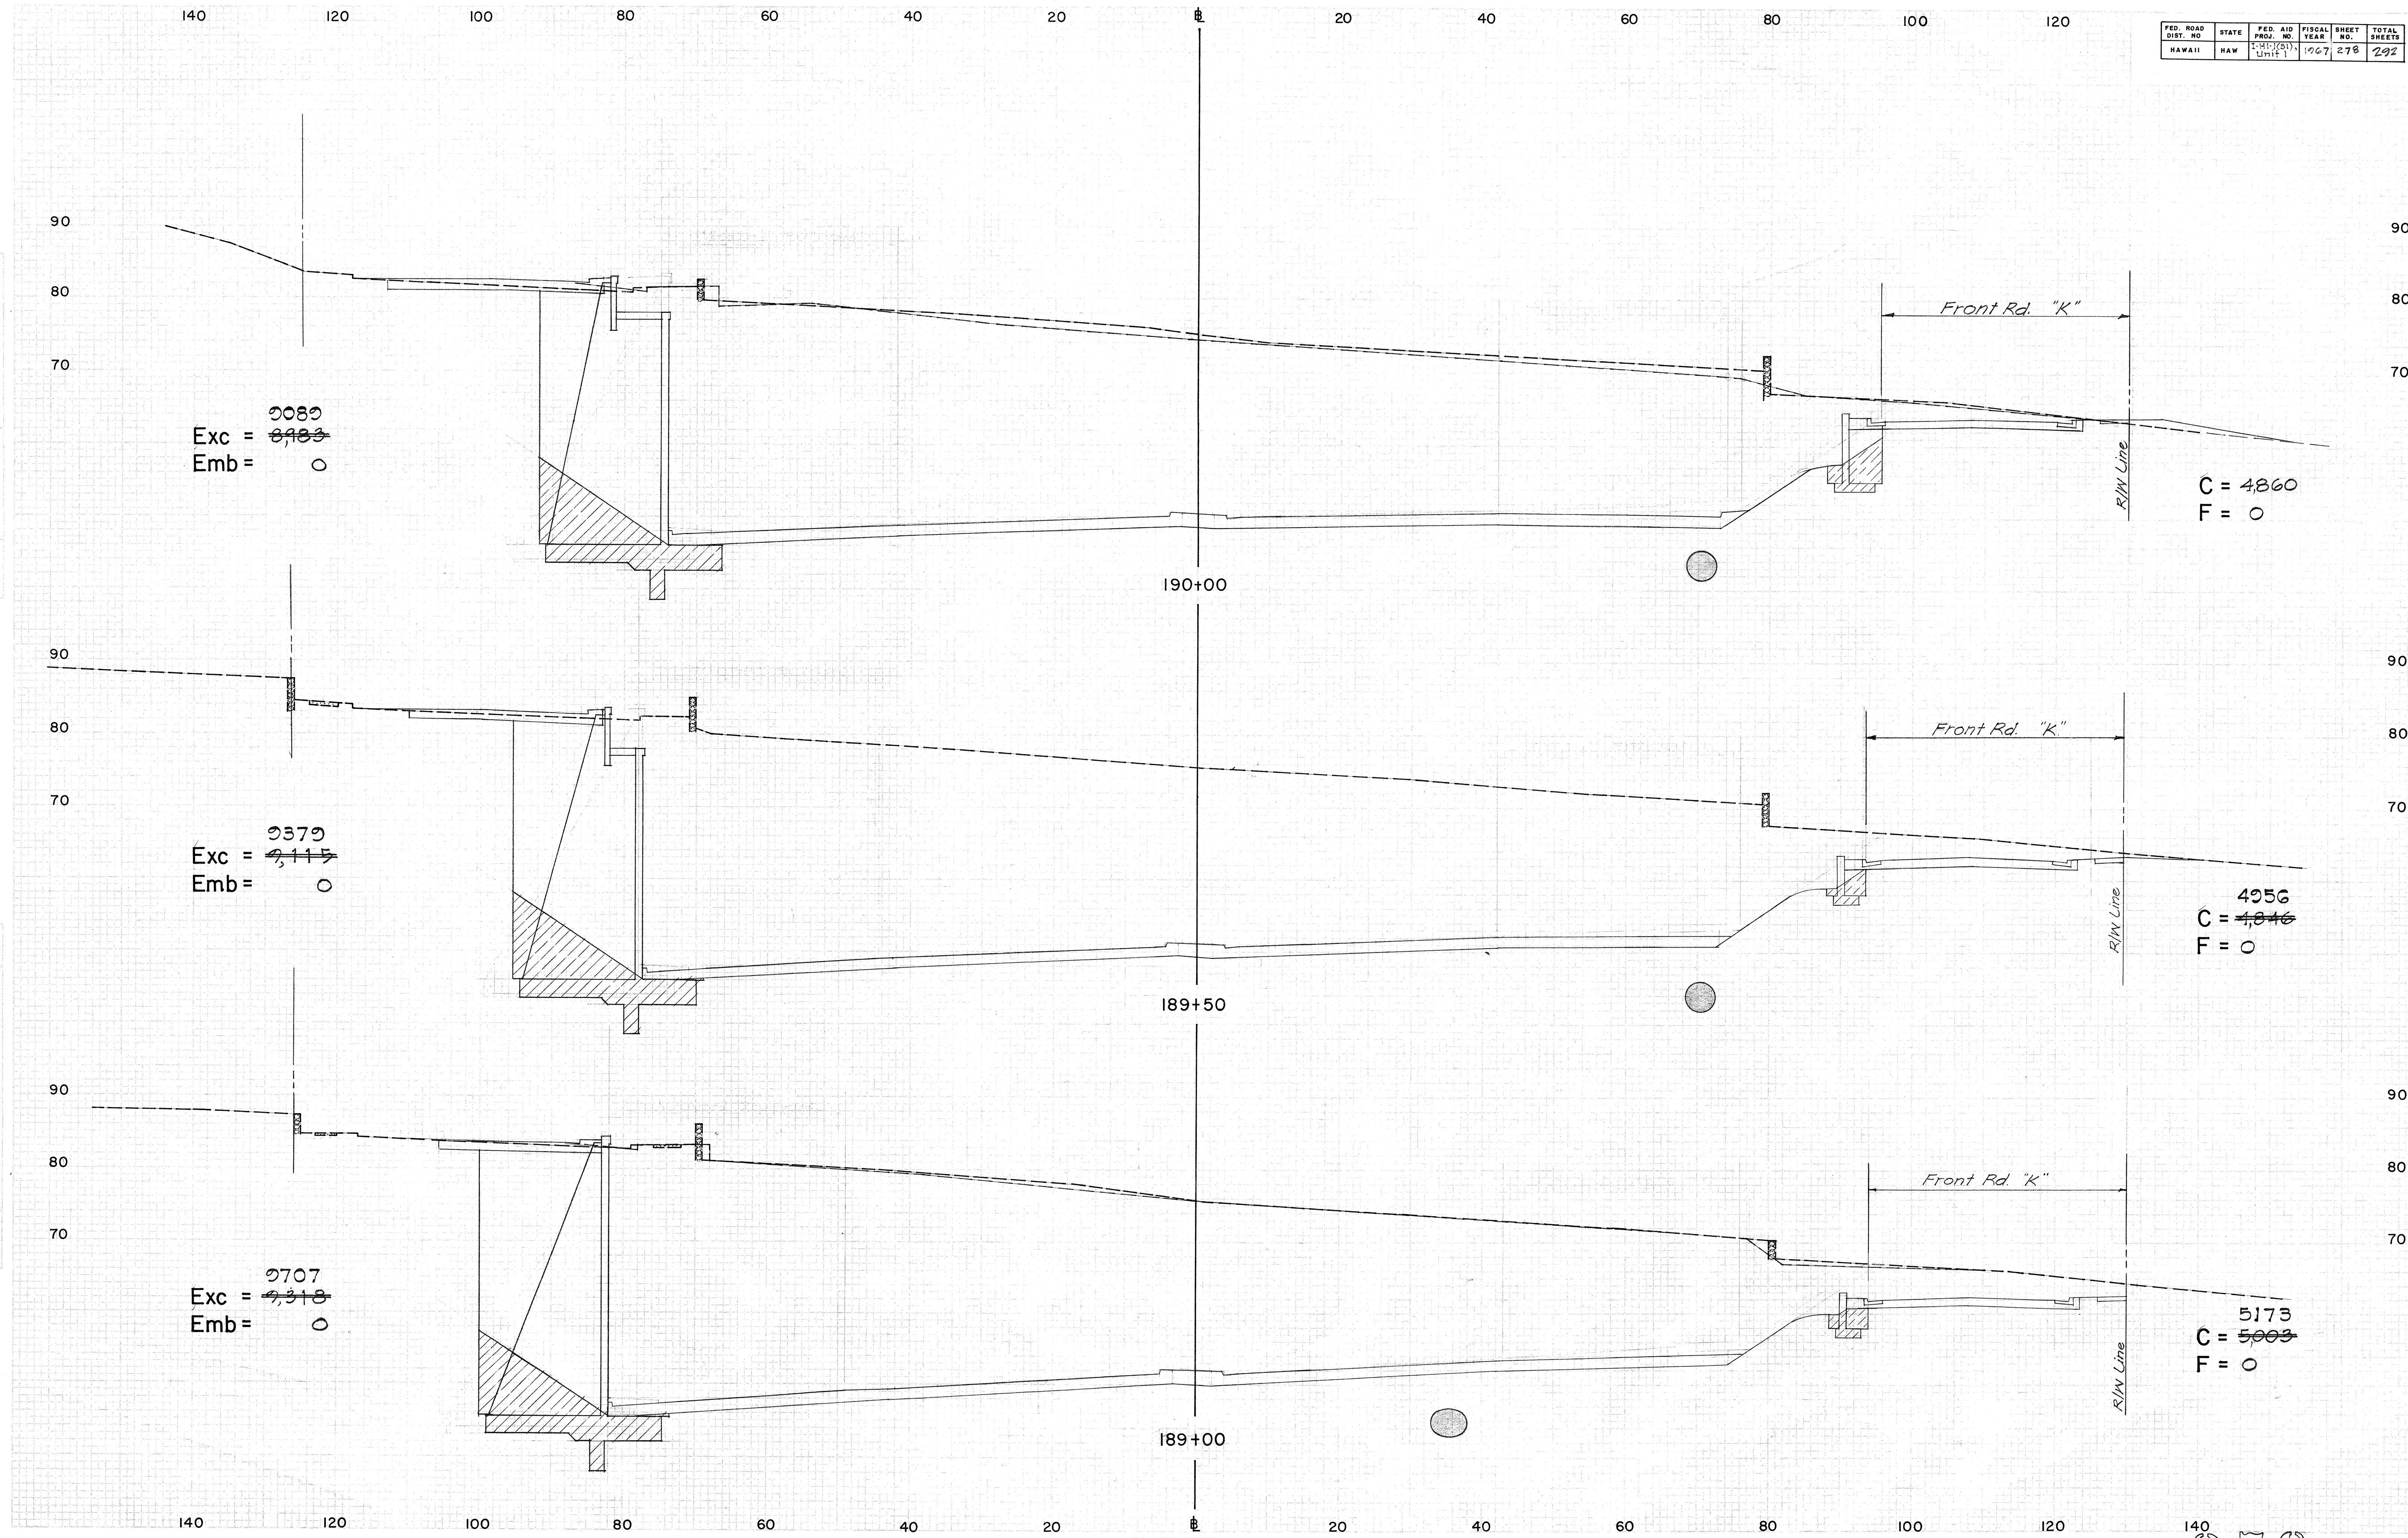

FED. ROAD DIST. NO.	STATE	FED. AID PROJ. NO.	FISCAL YEAR	SHEET NO.	TOTAL SHEETS
HAWAII	HAW	1-111(31)	1967	279	292

ORIGINAL SURVEY	DATE
NOTED BOOK	AREA
AREA	CHIEF
AREA	CHIEF

ORIGINAL SURVEY	DATE
NOTED BOOK	AREA
AREA	CHIEF
AREA	CHIEF

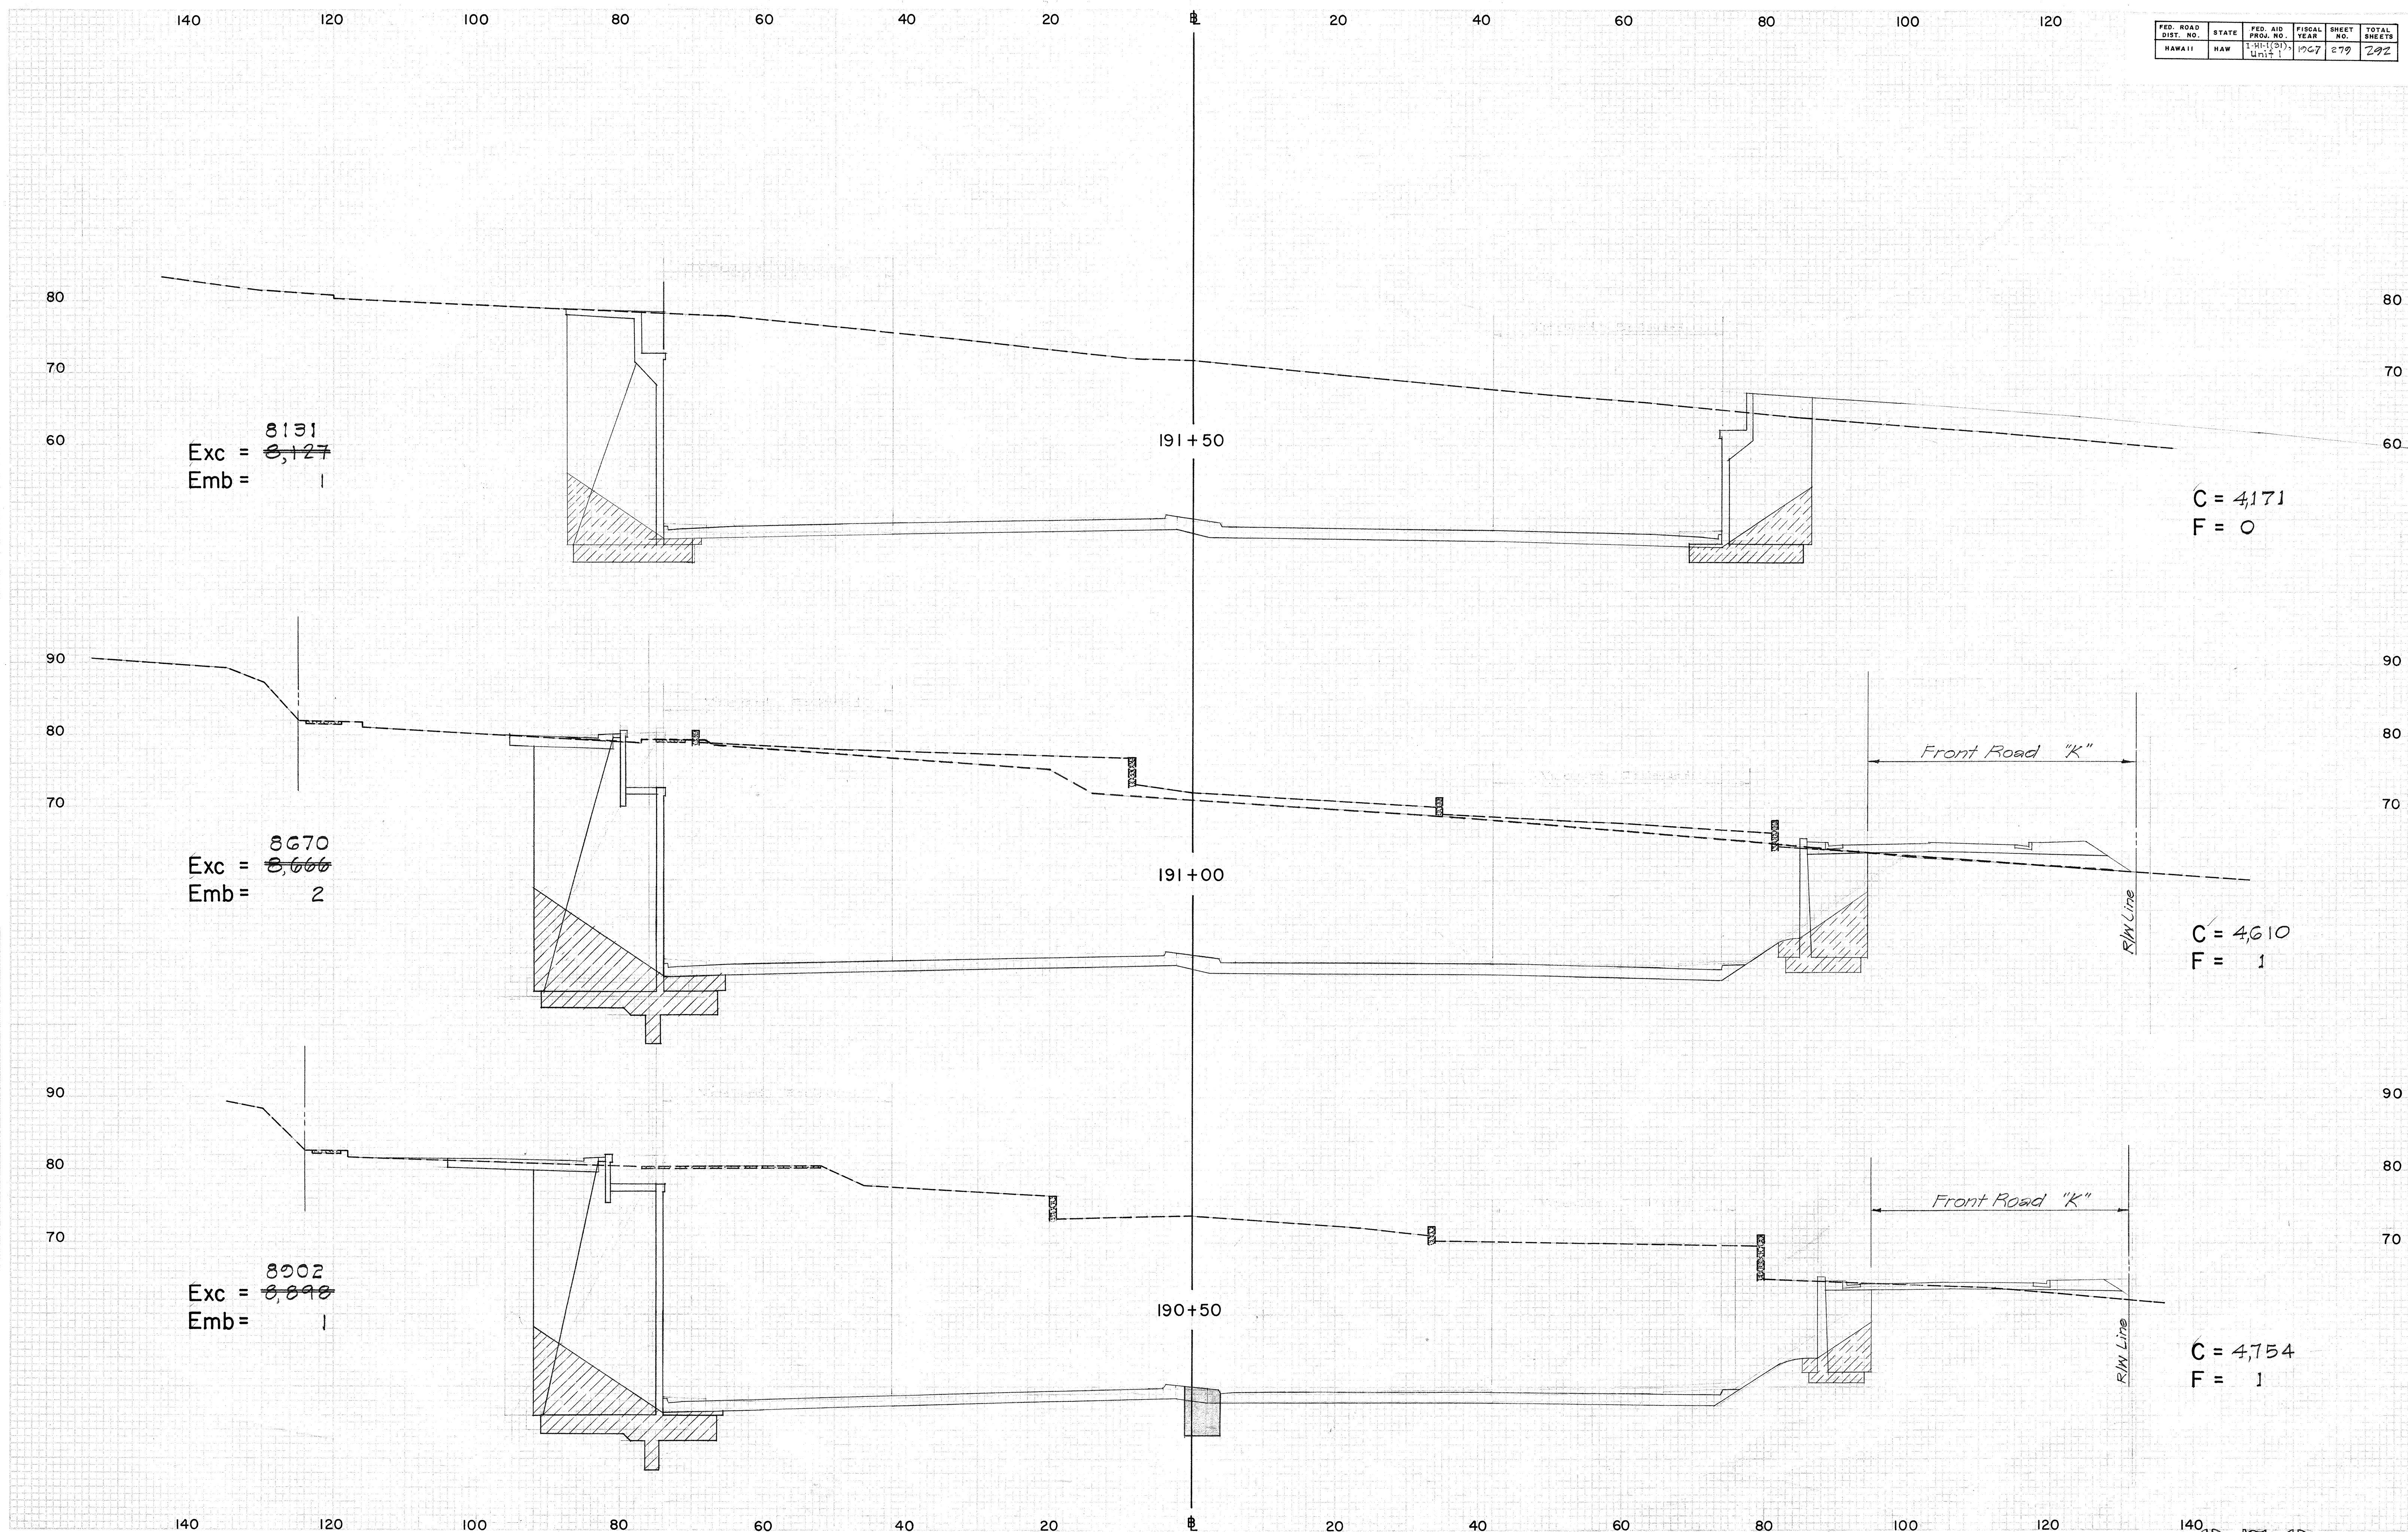

C = 4,171
F = 0


C = 4,610
F = 1

C = 4,754
F = 1

FED. ROAD DIST. NO.	STATE	FED. AID PROJ. NO.	FISCAL YEAR	SHEET NO.	TOTAL SHEETS
HAWAII	HAW	1-111(87)	1967	280	292

DATE	BY	REVISION


DATE	BY	REVISION

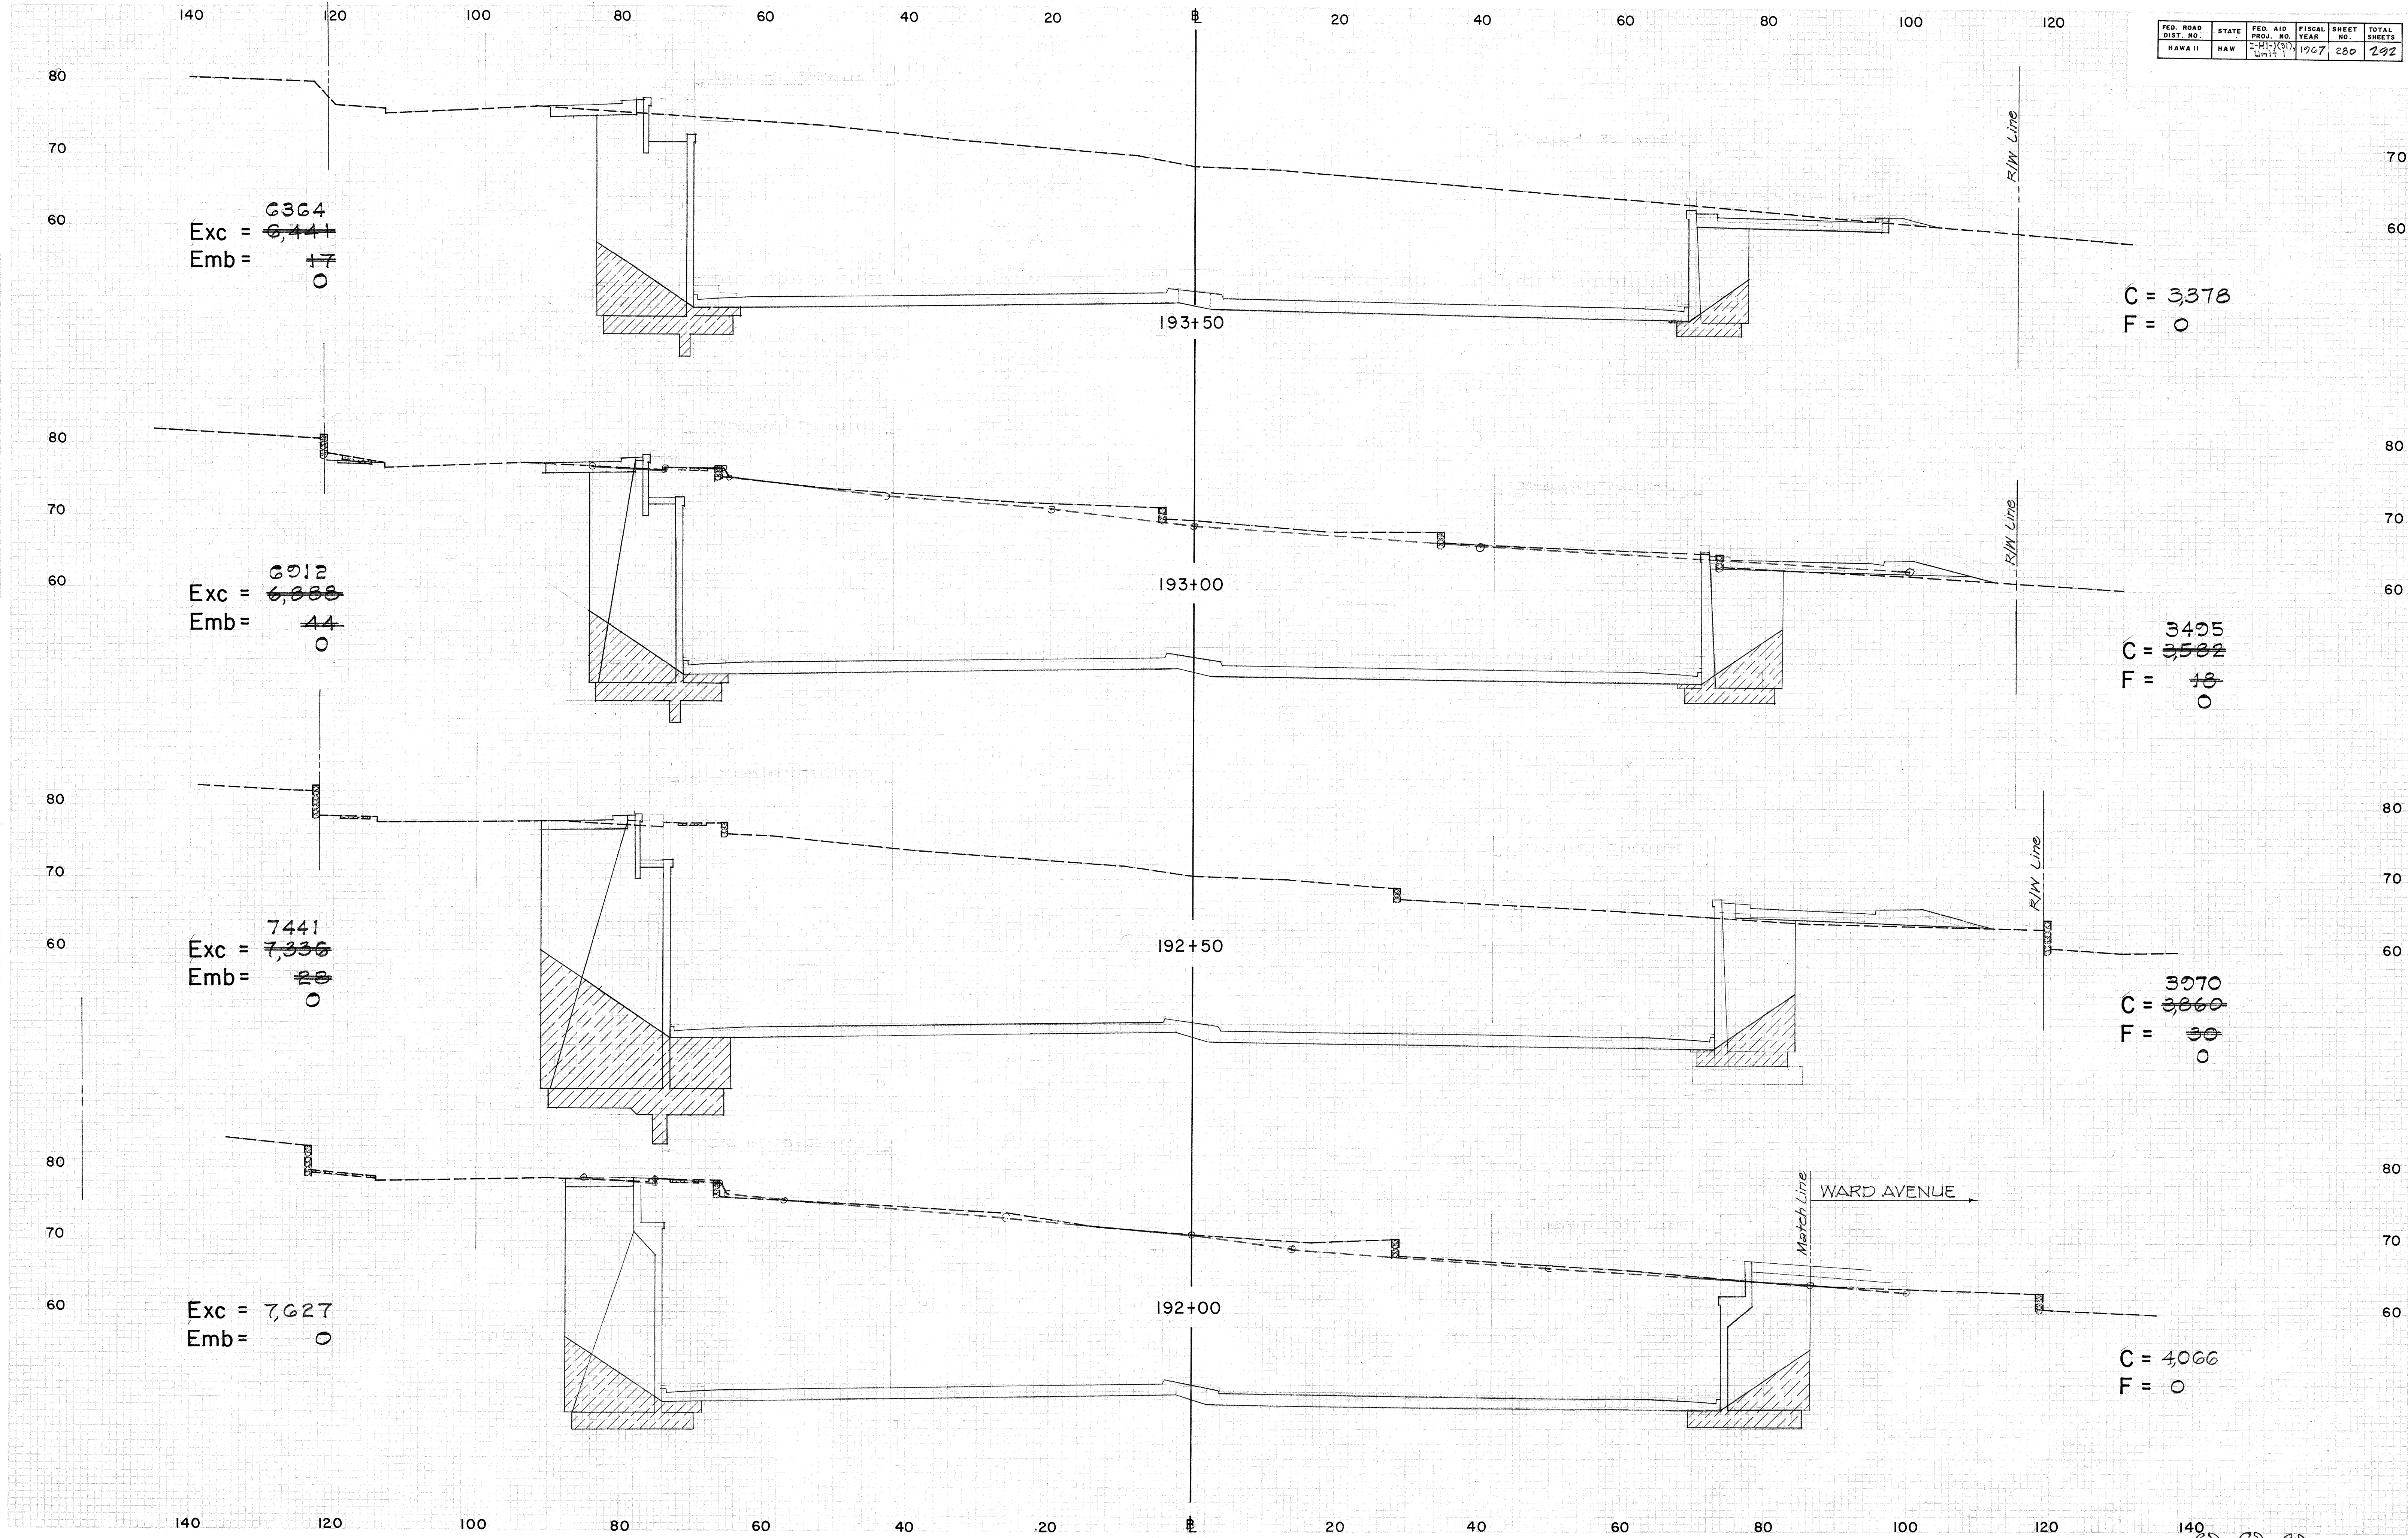

FED. ROAD DIST. NO.	STATE	FED. AID PROJ. NO.	FISCAL YEAR	SHEET NO.	TOTAL SHEETS
HAWAII	HAW	1-41(51) CH 11	1967	281	292

ORIGINAL SURVEY
 SURVEYED
 PLATTED
 DATE BOOK
 AREA
 NO.


ORIGINAL SURVEY
 SURVEYED
 PLATTED
 DATE BOOK
 AREA
 NO.

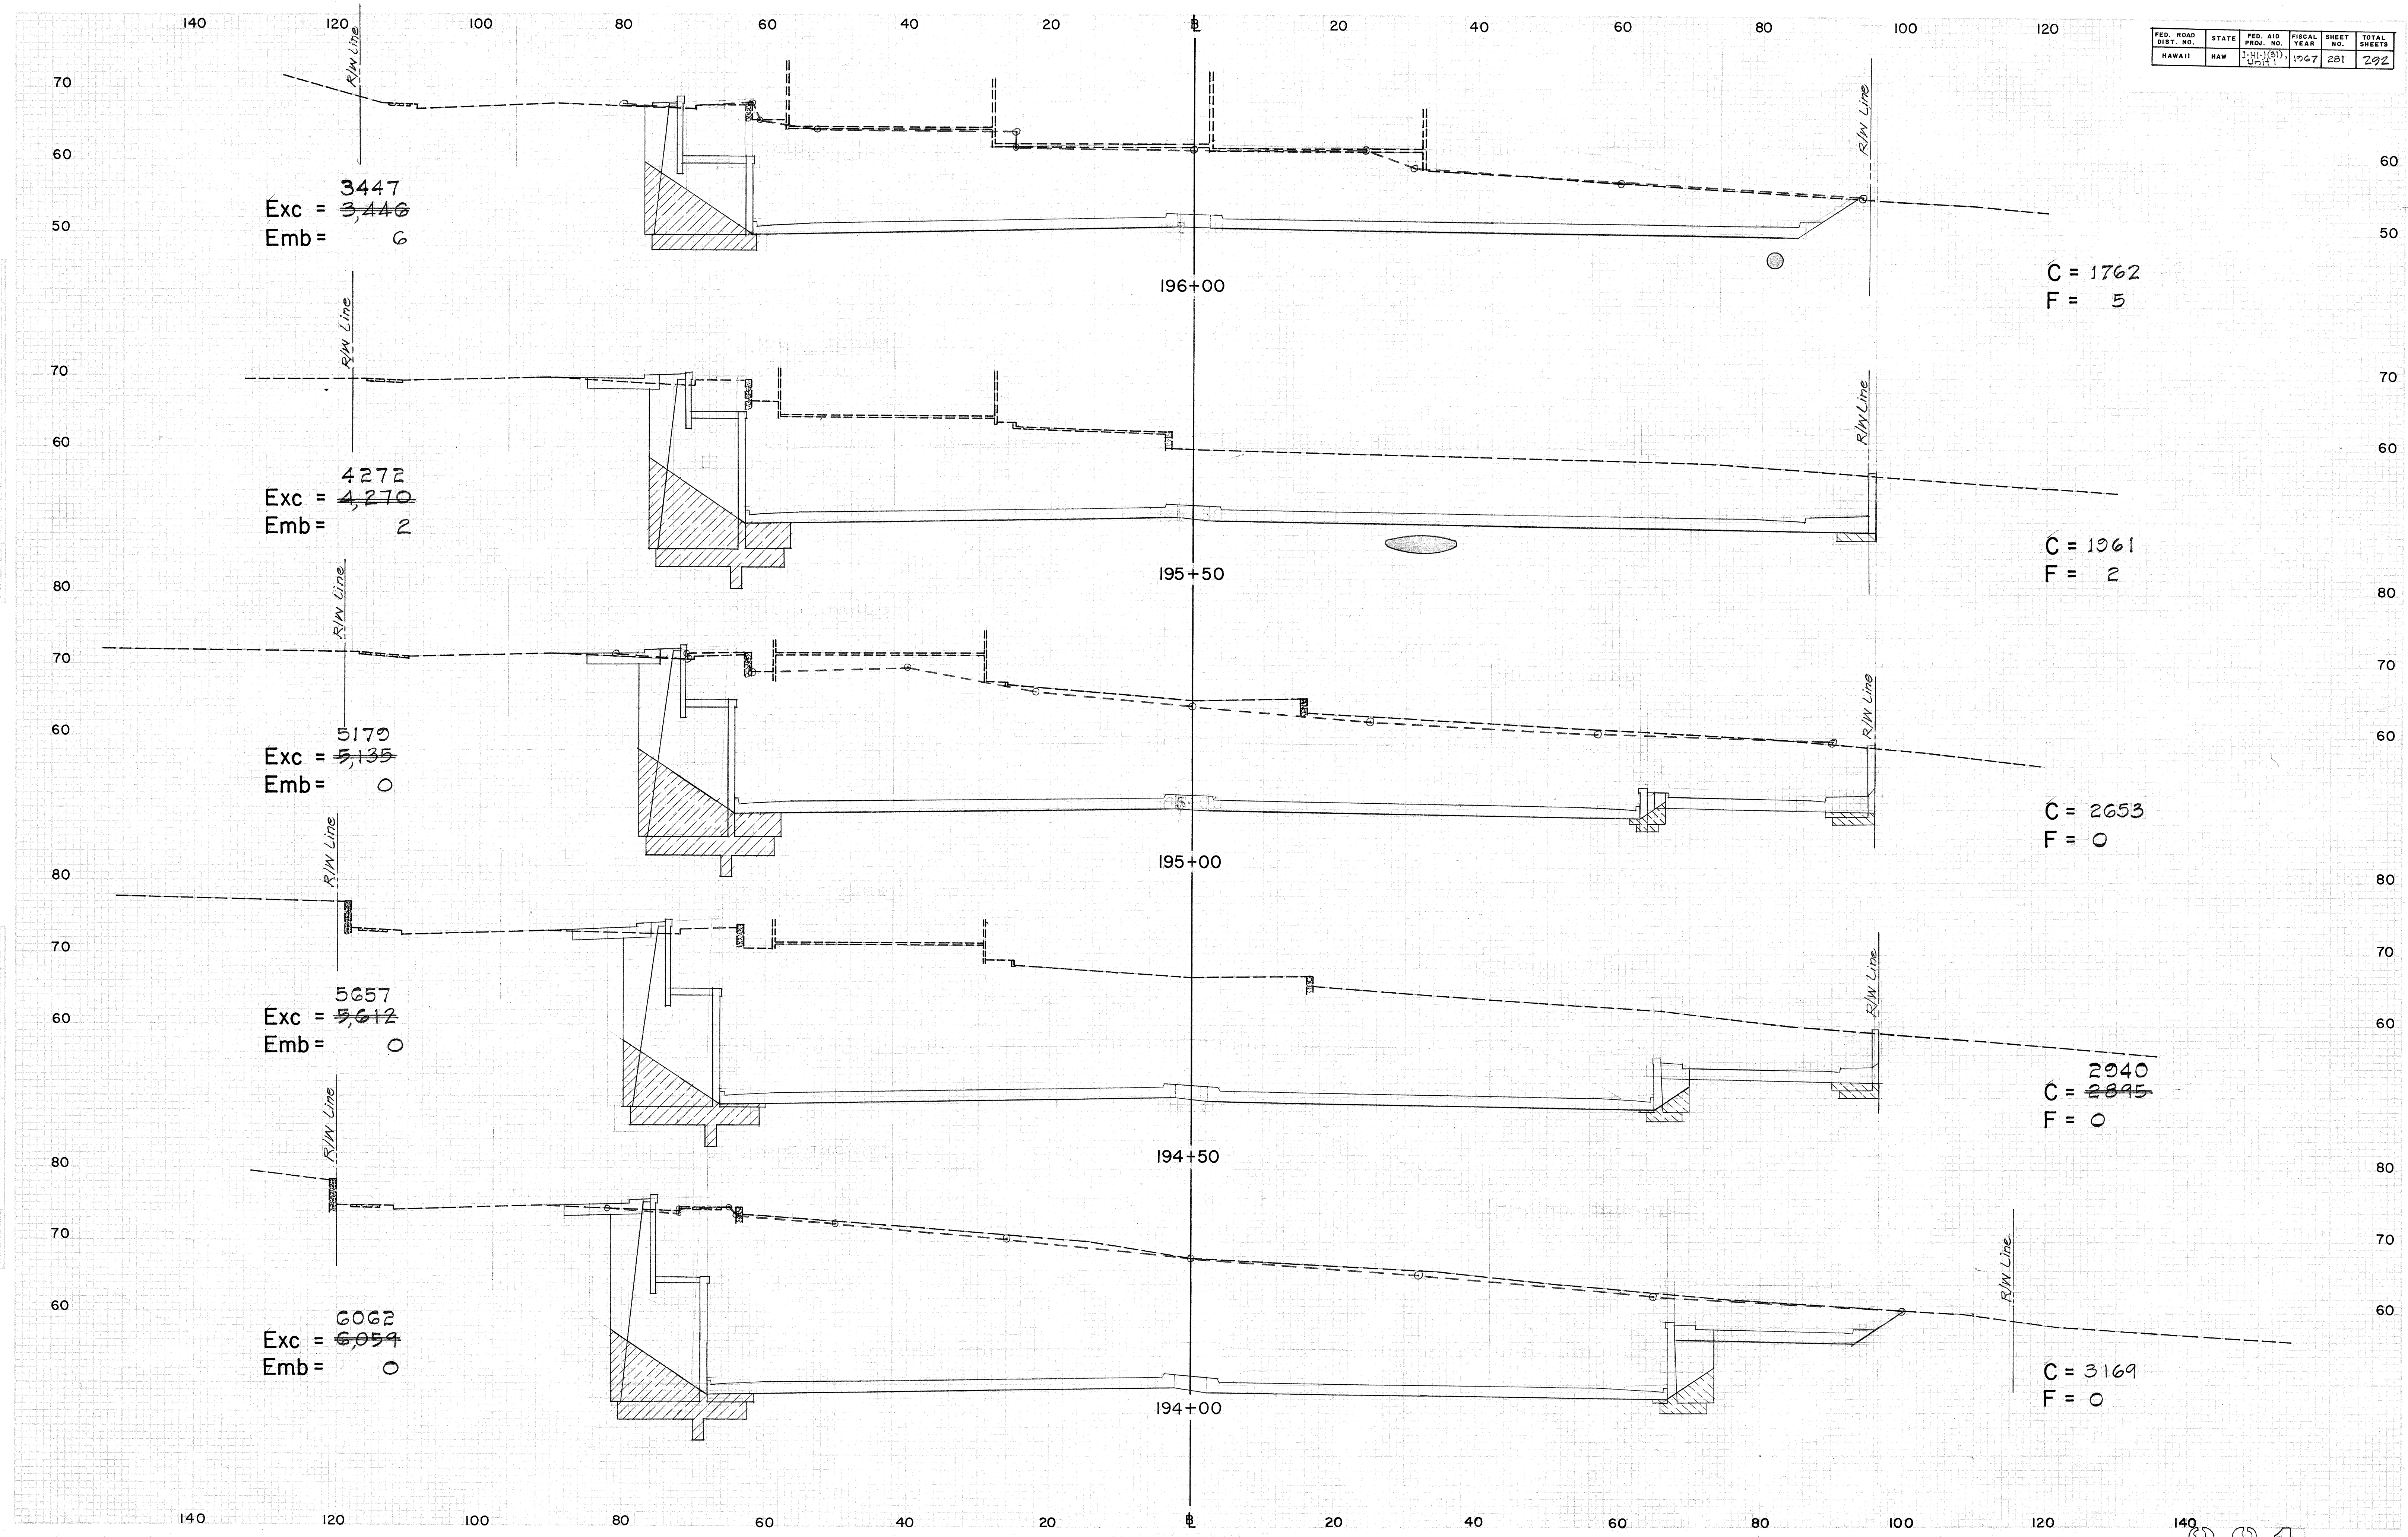


FED. ROAD DIST. NO.	STATE	FED. AID PROJ. NO.	FISCAL YEAR	SHEET NO.	TOTAL SHEETS
HAWAII	HAW.	104-1(31)	1967	282	292

ORIGINAL SURVEY PLOTTED
DATE: 10/1/67
BY: [Signature]
CHECKED: [Signature]
NO.

ORIGINAL SURVEY PLOTTED
DATE: 10/1/67
BY: [Signature]
CHECKED: [Signature]
NO.

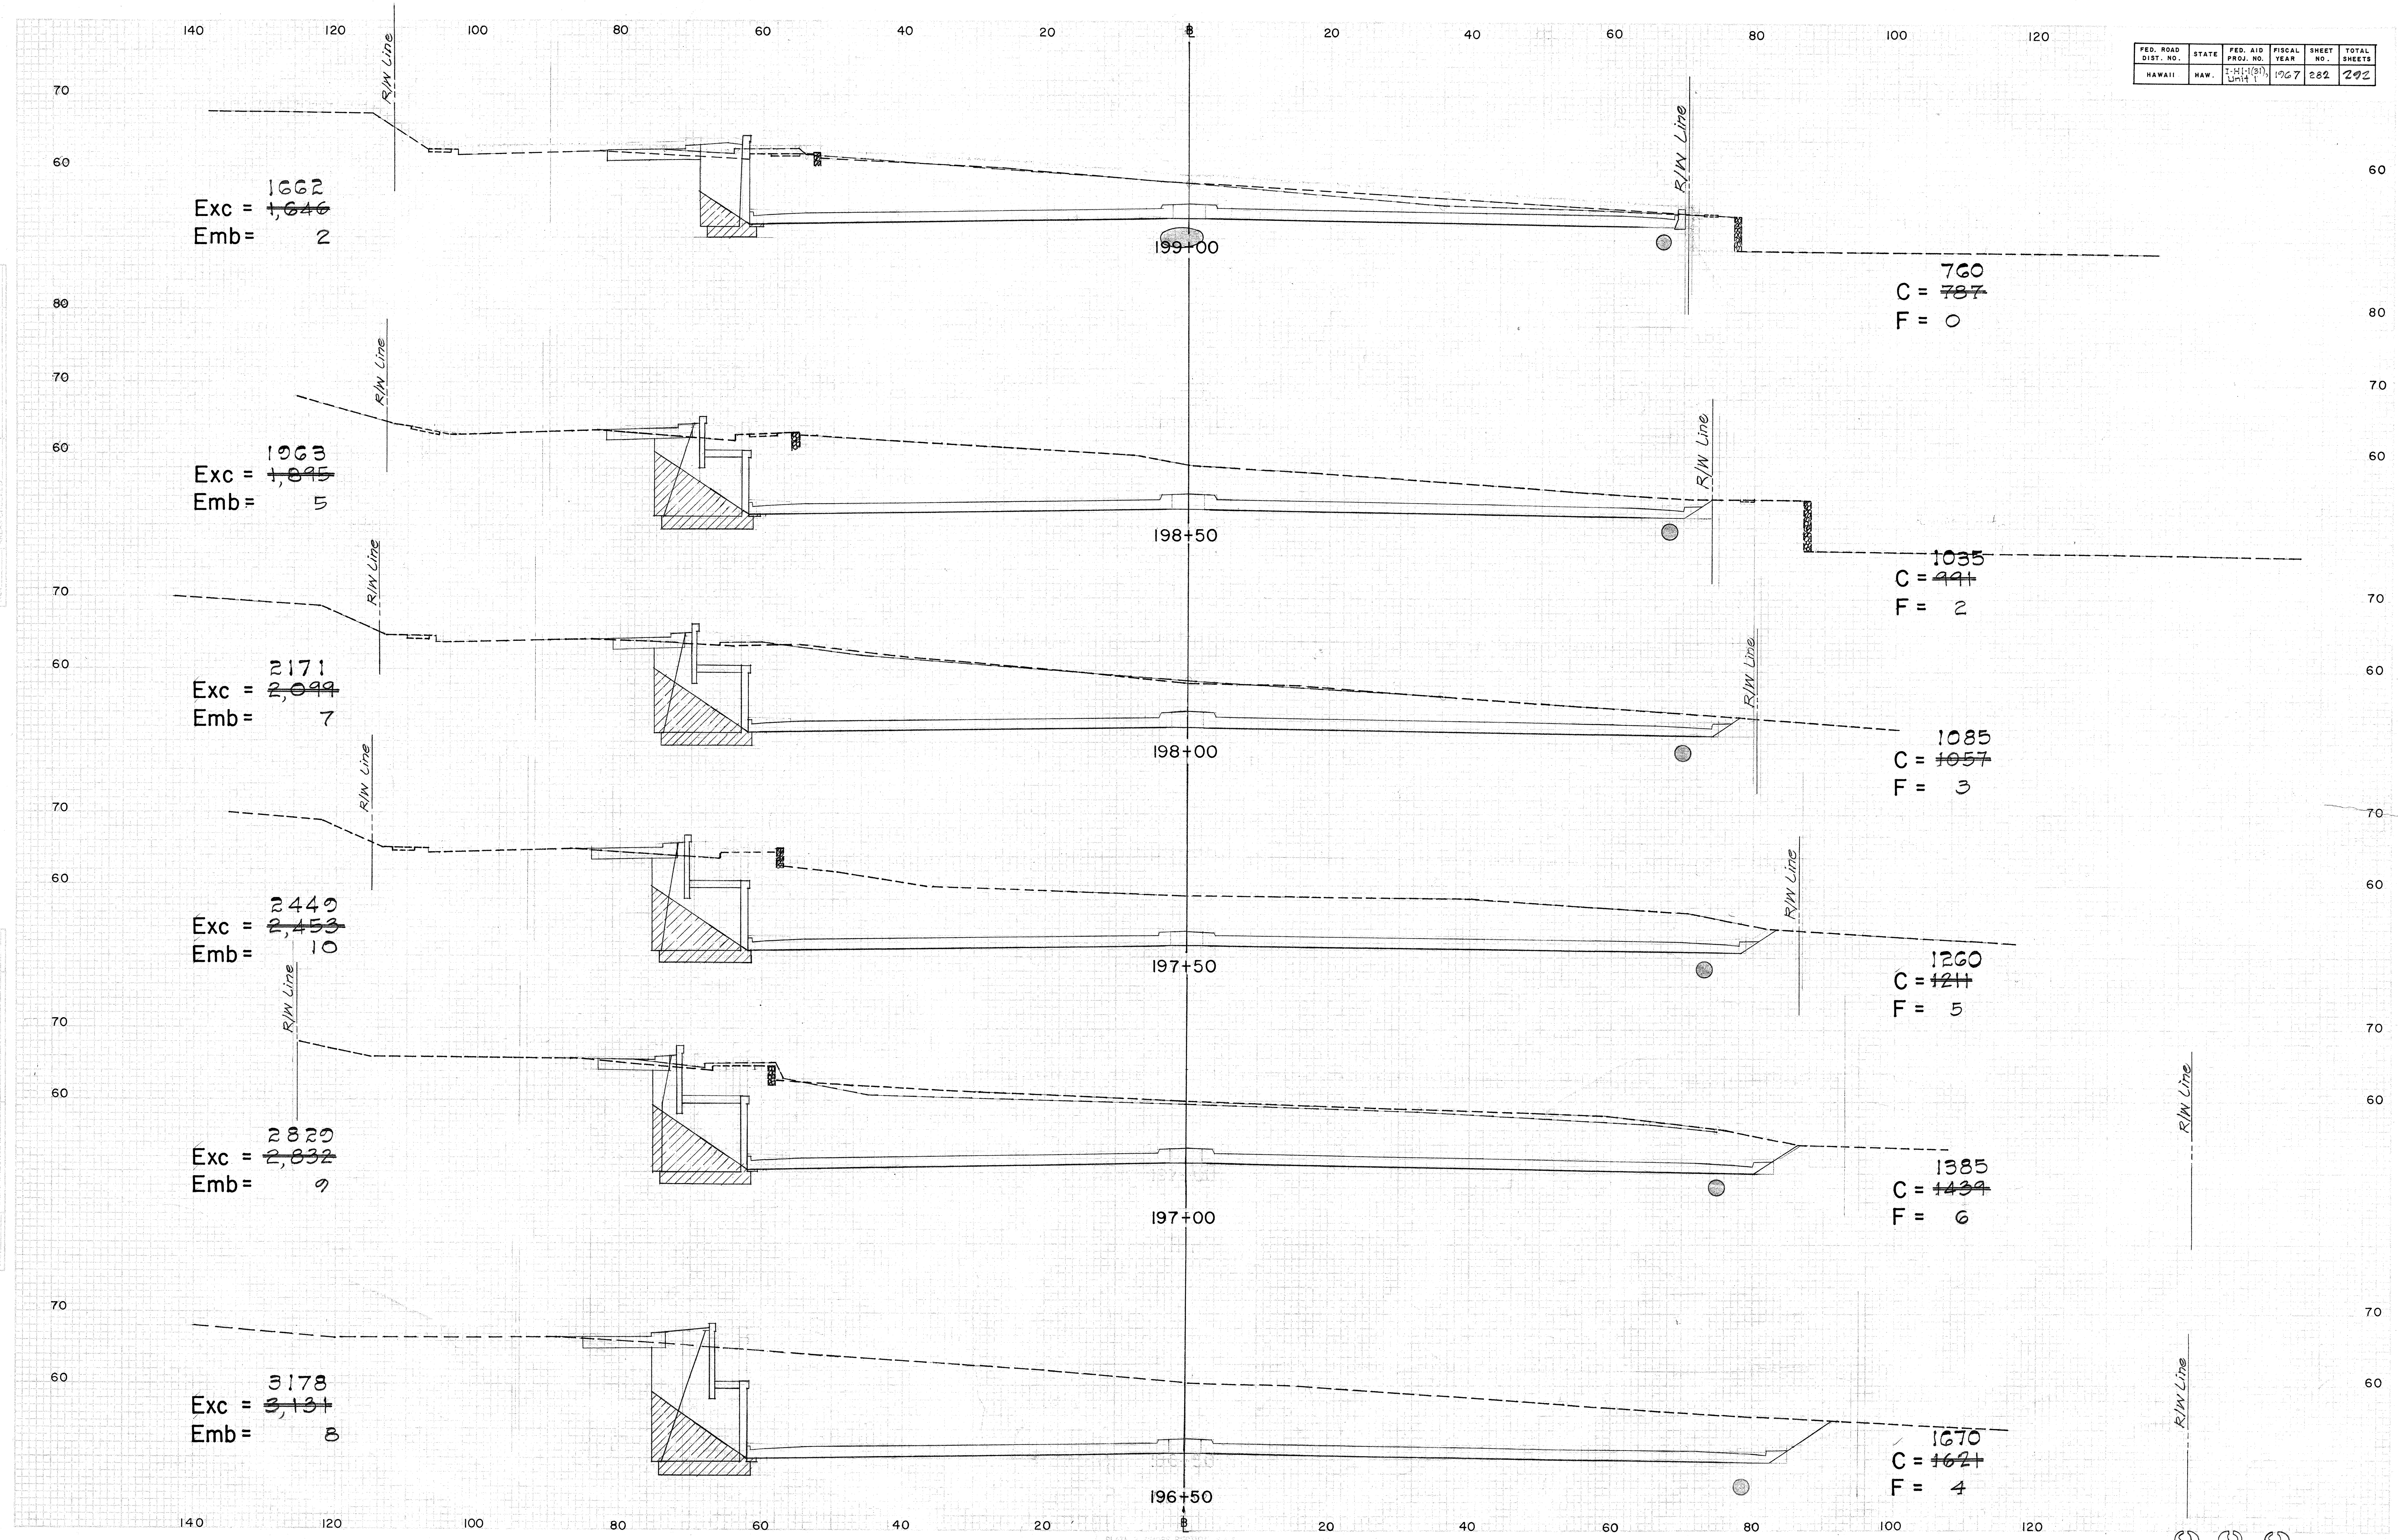


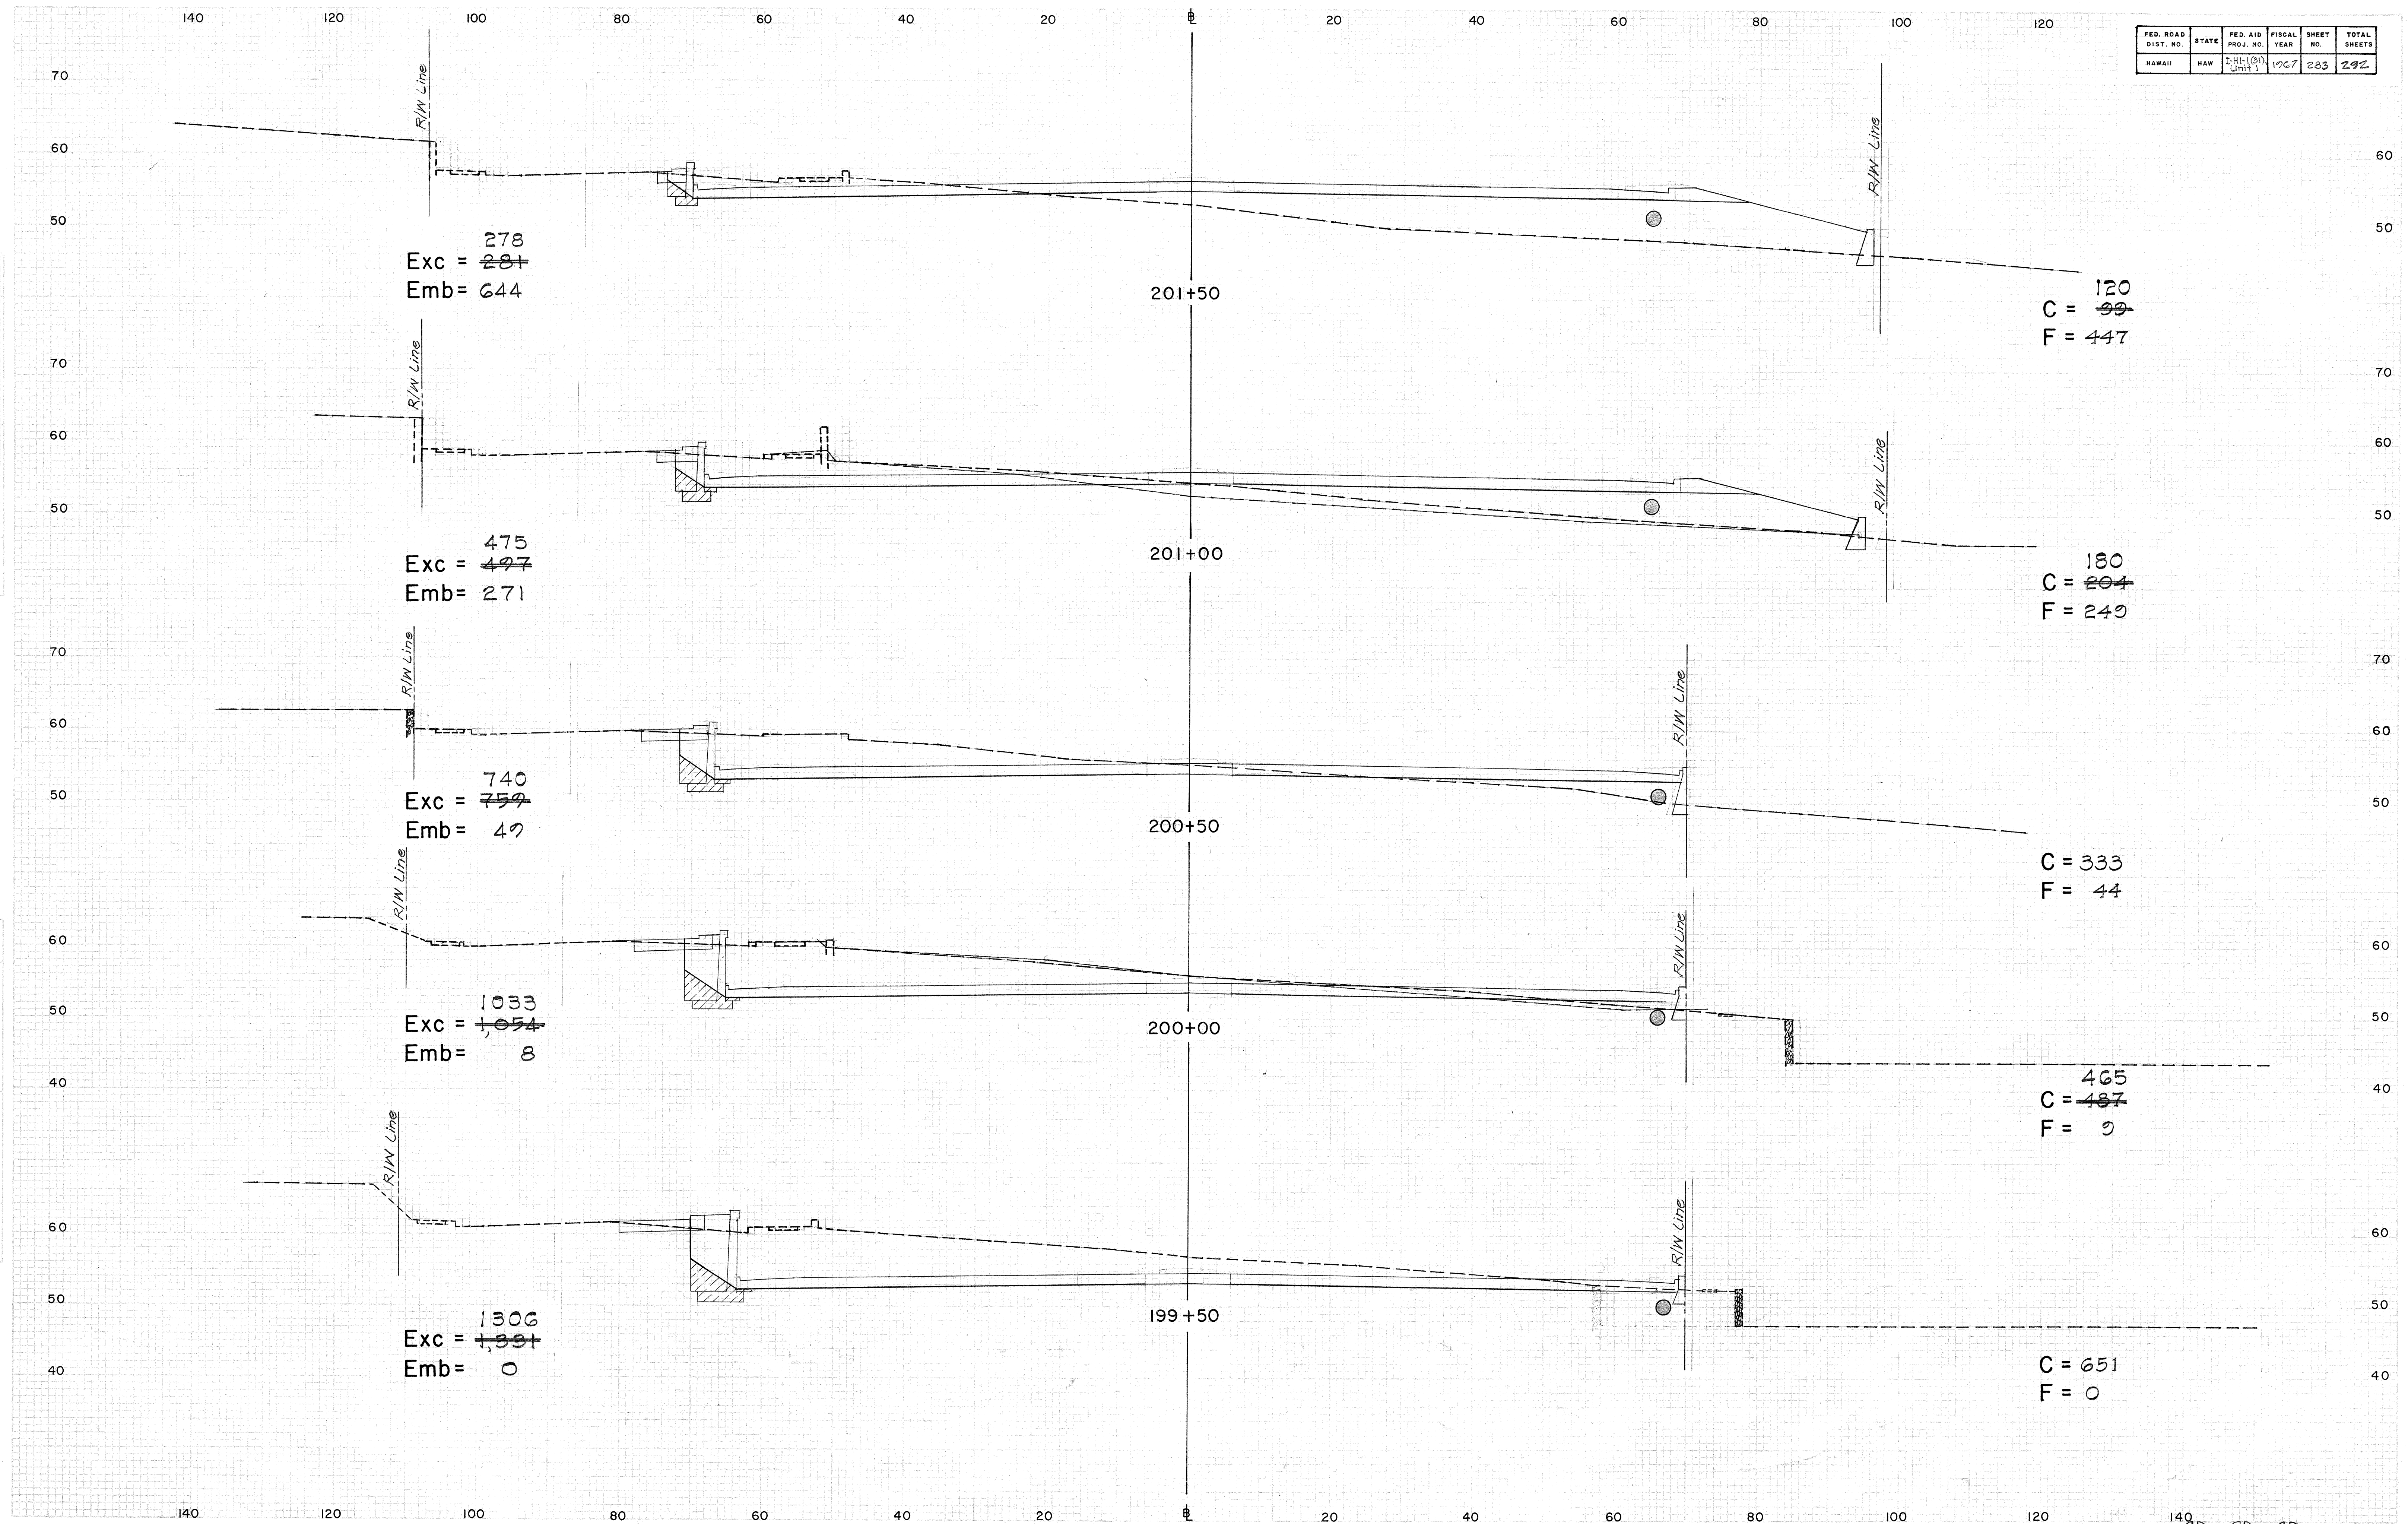

FED. ROAD DIST. NO.	STATE	FED. AID PROJ. NO.	FISCAL YEAR	SHEET NO.	TOTAL SHEETS
HAWAII	HAW.	1-141(30) 41111	1967	284	292

DESIGN	DATE	BY	CHECKED	APPROVED
10/10/67	10/10/67	W. J. HARRIS	W. J. HARRIS	W. J. HARRIS


DESIGN	DATE	BY	CHECKED	APPROVED
10/10/67	10/10/67	W. J. HARRIS	W. J. HARRIS	W. J. HARRIS

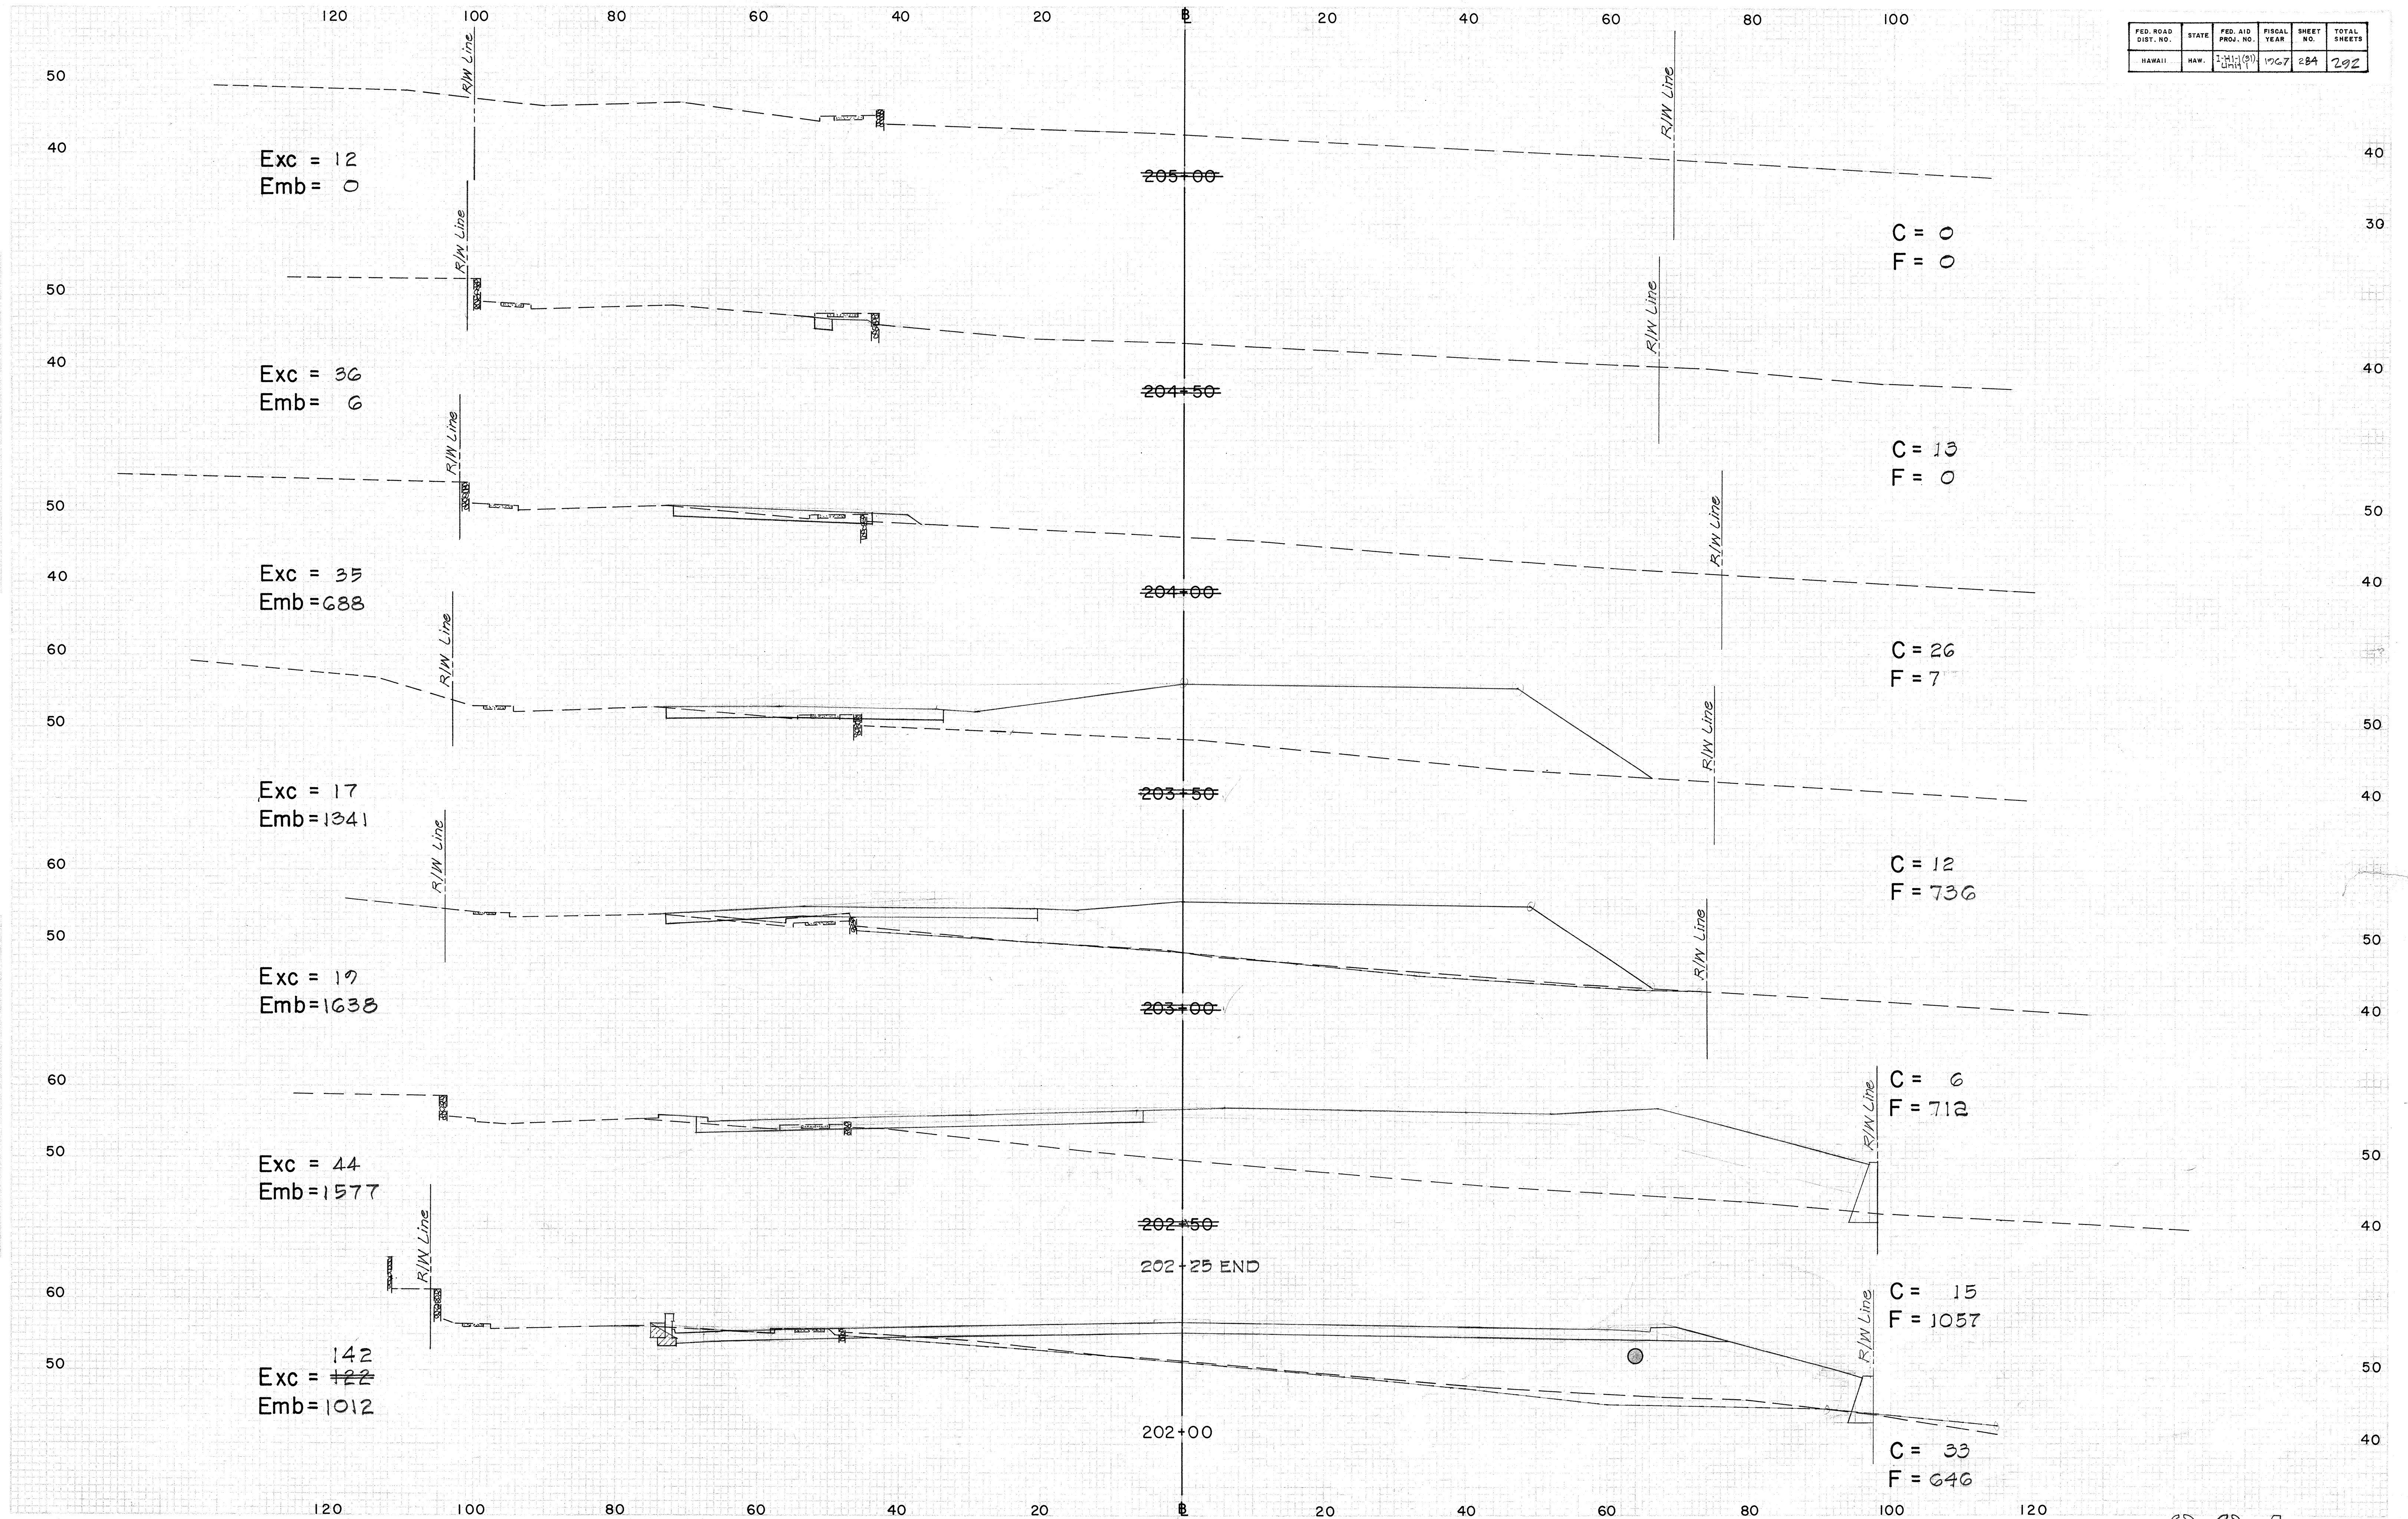

FED. ROAD DIST. NO.	STATE	FED. AID PROJ. NO.	FISCAL YEAR	SHEET NO.	TOTAL SHEETS
HAWAII	HAW.	Unit 1	1967	285	292

DATE	BY	NO.

DATE	BY	NO.

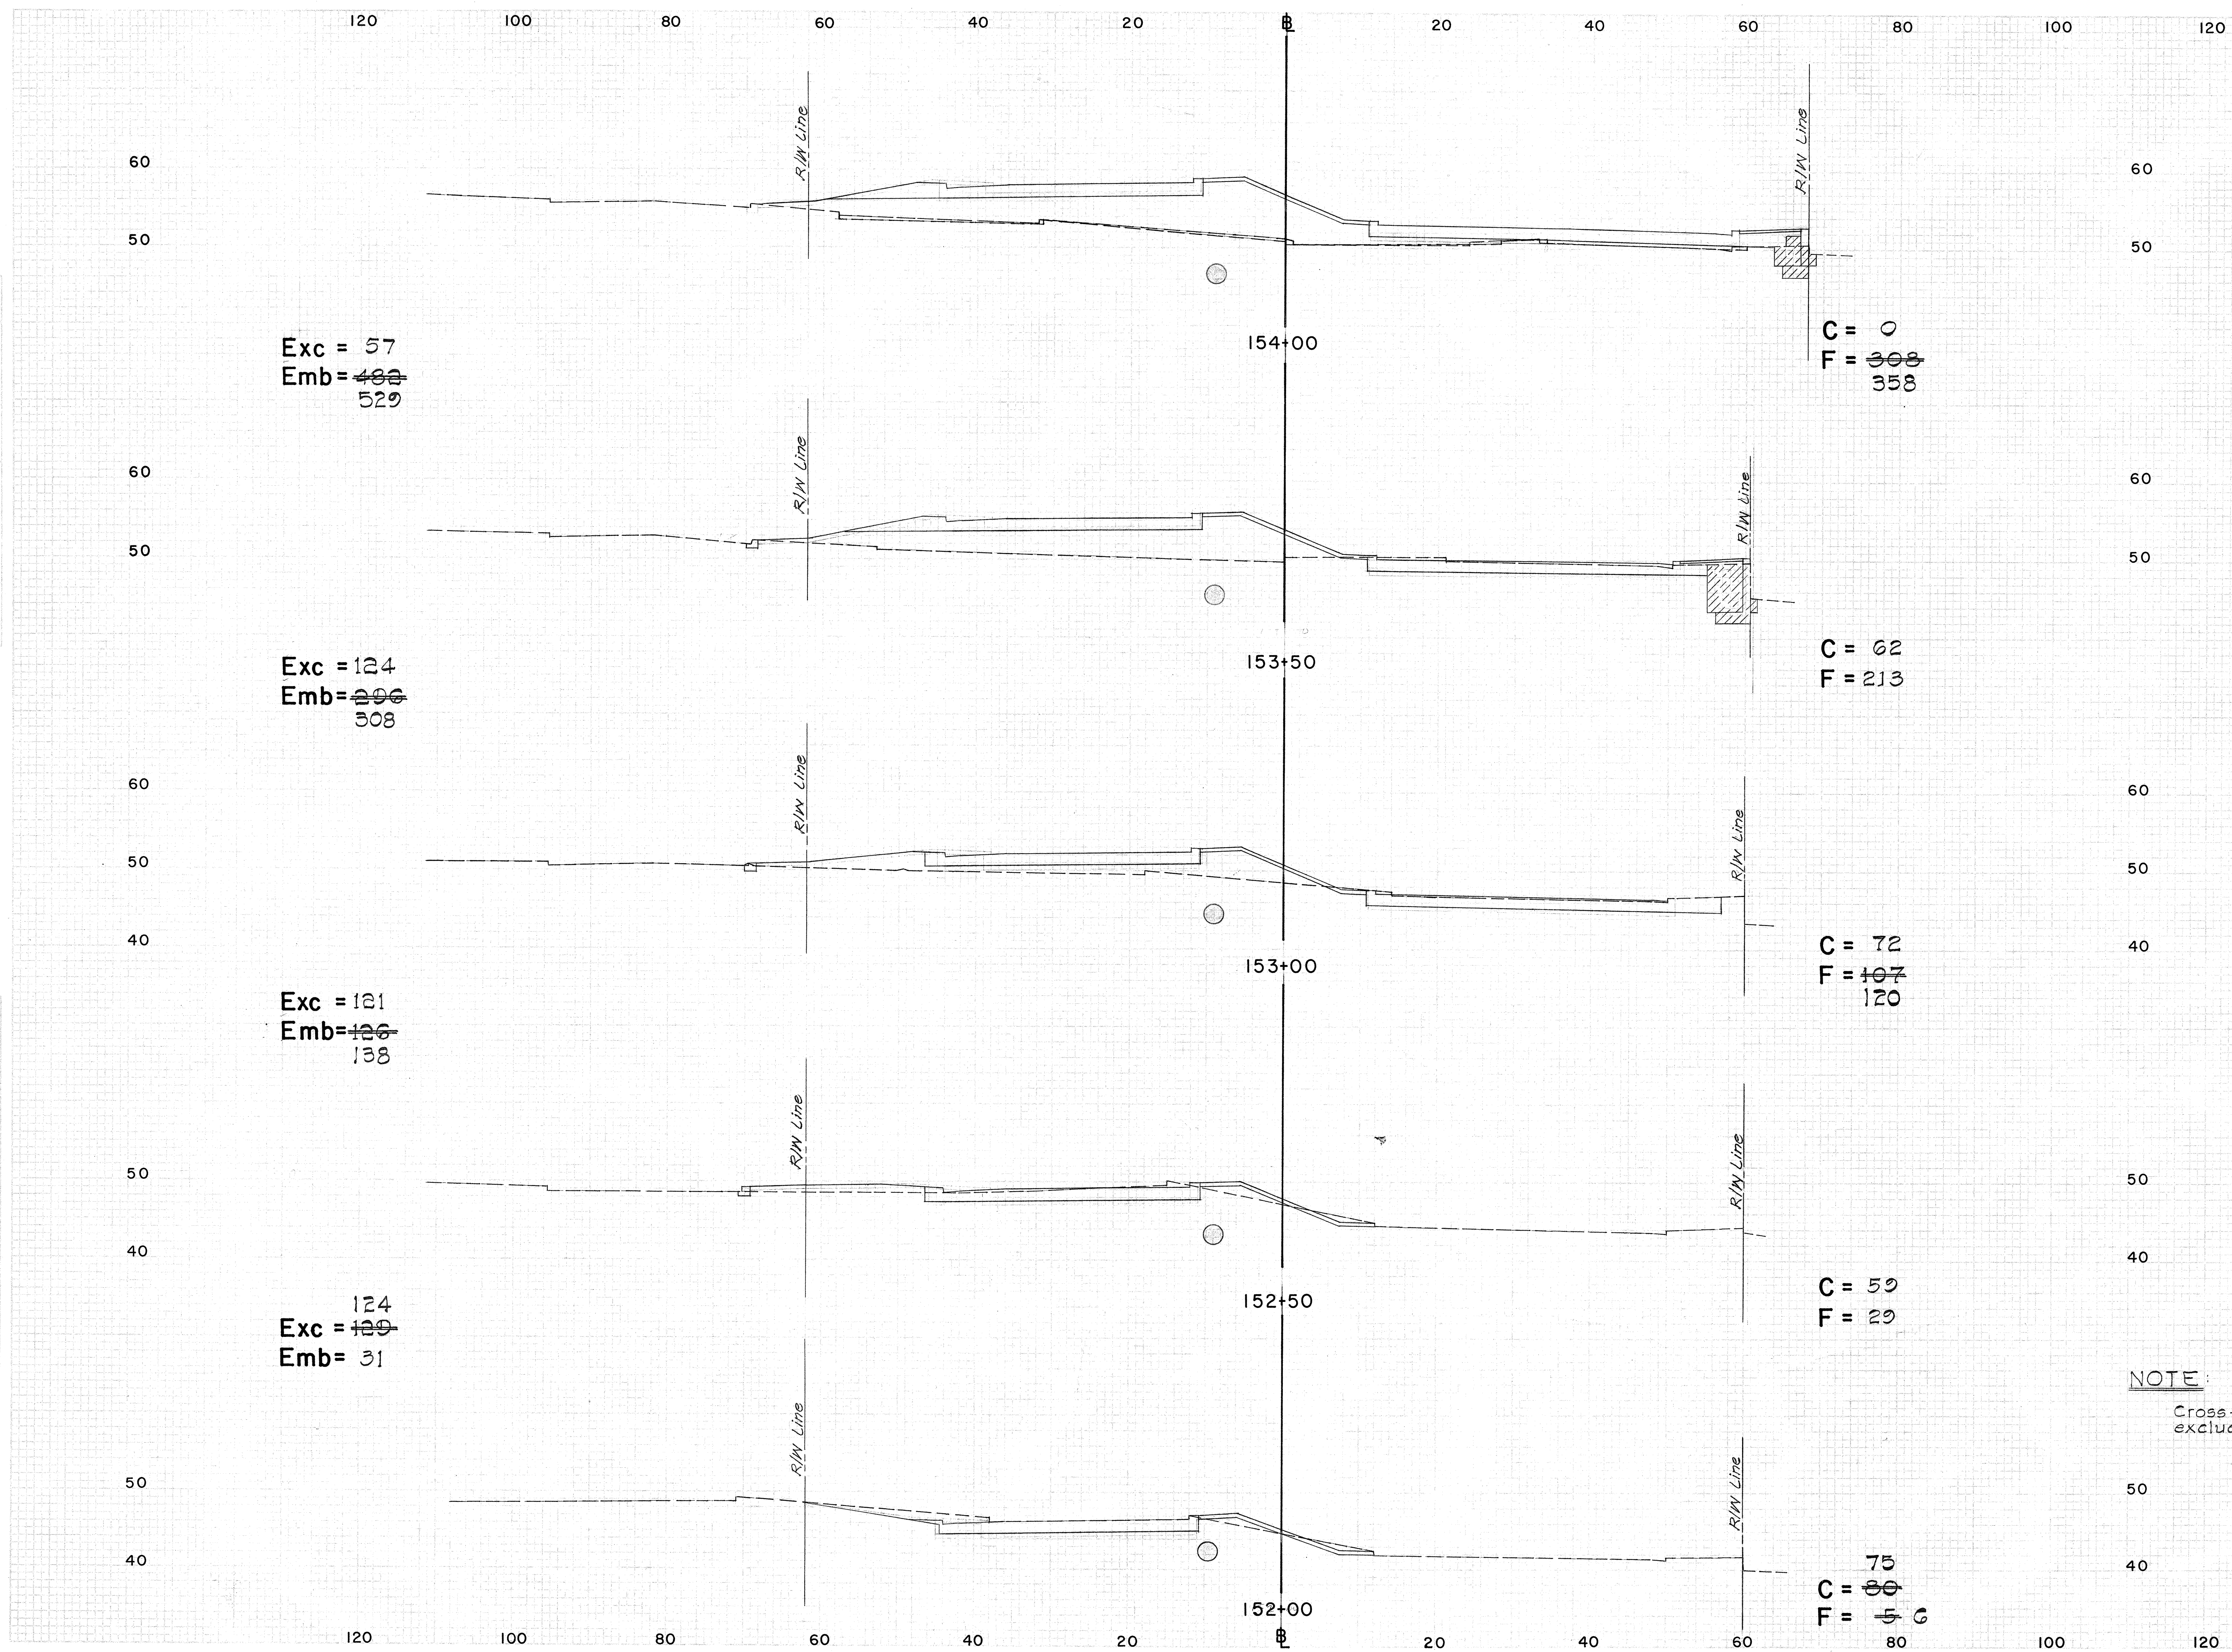


NOTE:
Cross-hatching indicates those areas excluded from roadway excavation.

FED. ROAD DIST. NO.	STATE	FED. AID PROJ. NO.	FISCAL YEAR	SHEET NO.	TOTAL SHEETS
HAWAII	HAW.	1-11-1(5) Unit 1	1967	286	292

DATE	BY	CHKD.	APP'D.
3/15/71	W. J. L.	W. J. L.	W. J. L.
3/15/71	W. J. L.	W. J. L.	W. J. L.
3/15/71	W. J. L.	W. J. L.	W. J. L.

DATE	BY	CHKD.	APP'D.
3/15/71	W. J. L.	W. J. L.	W. J. L.
3/15/71	W. J. L.	W. J. L.	W. J. L.
3/15/71	W. J. L.	W. J. L.	W. J. L.

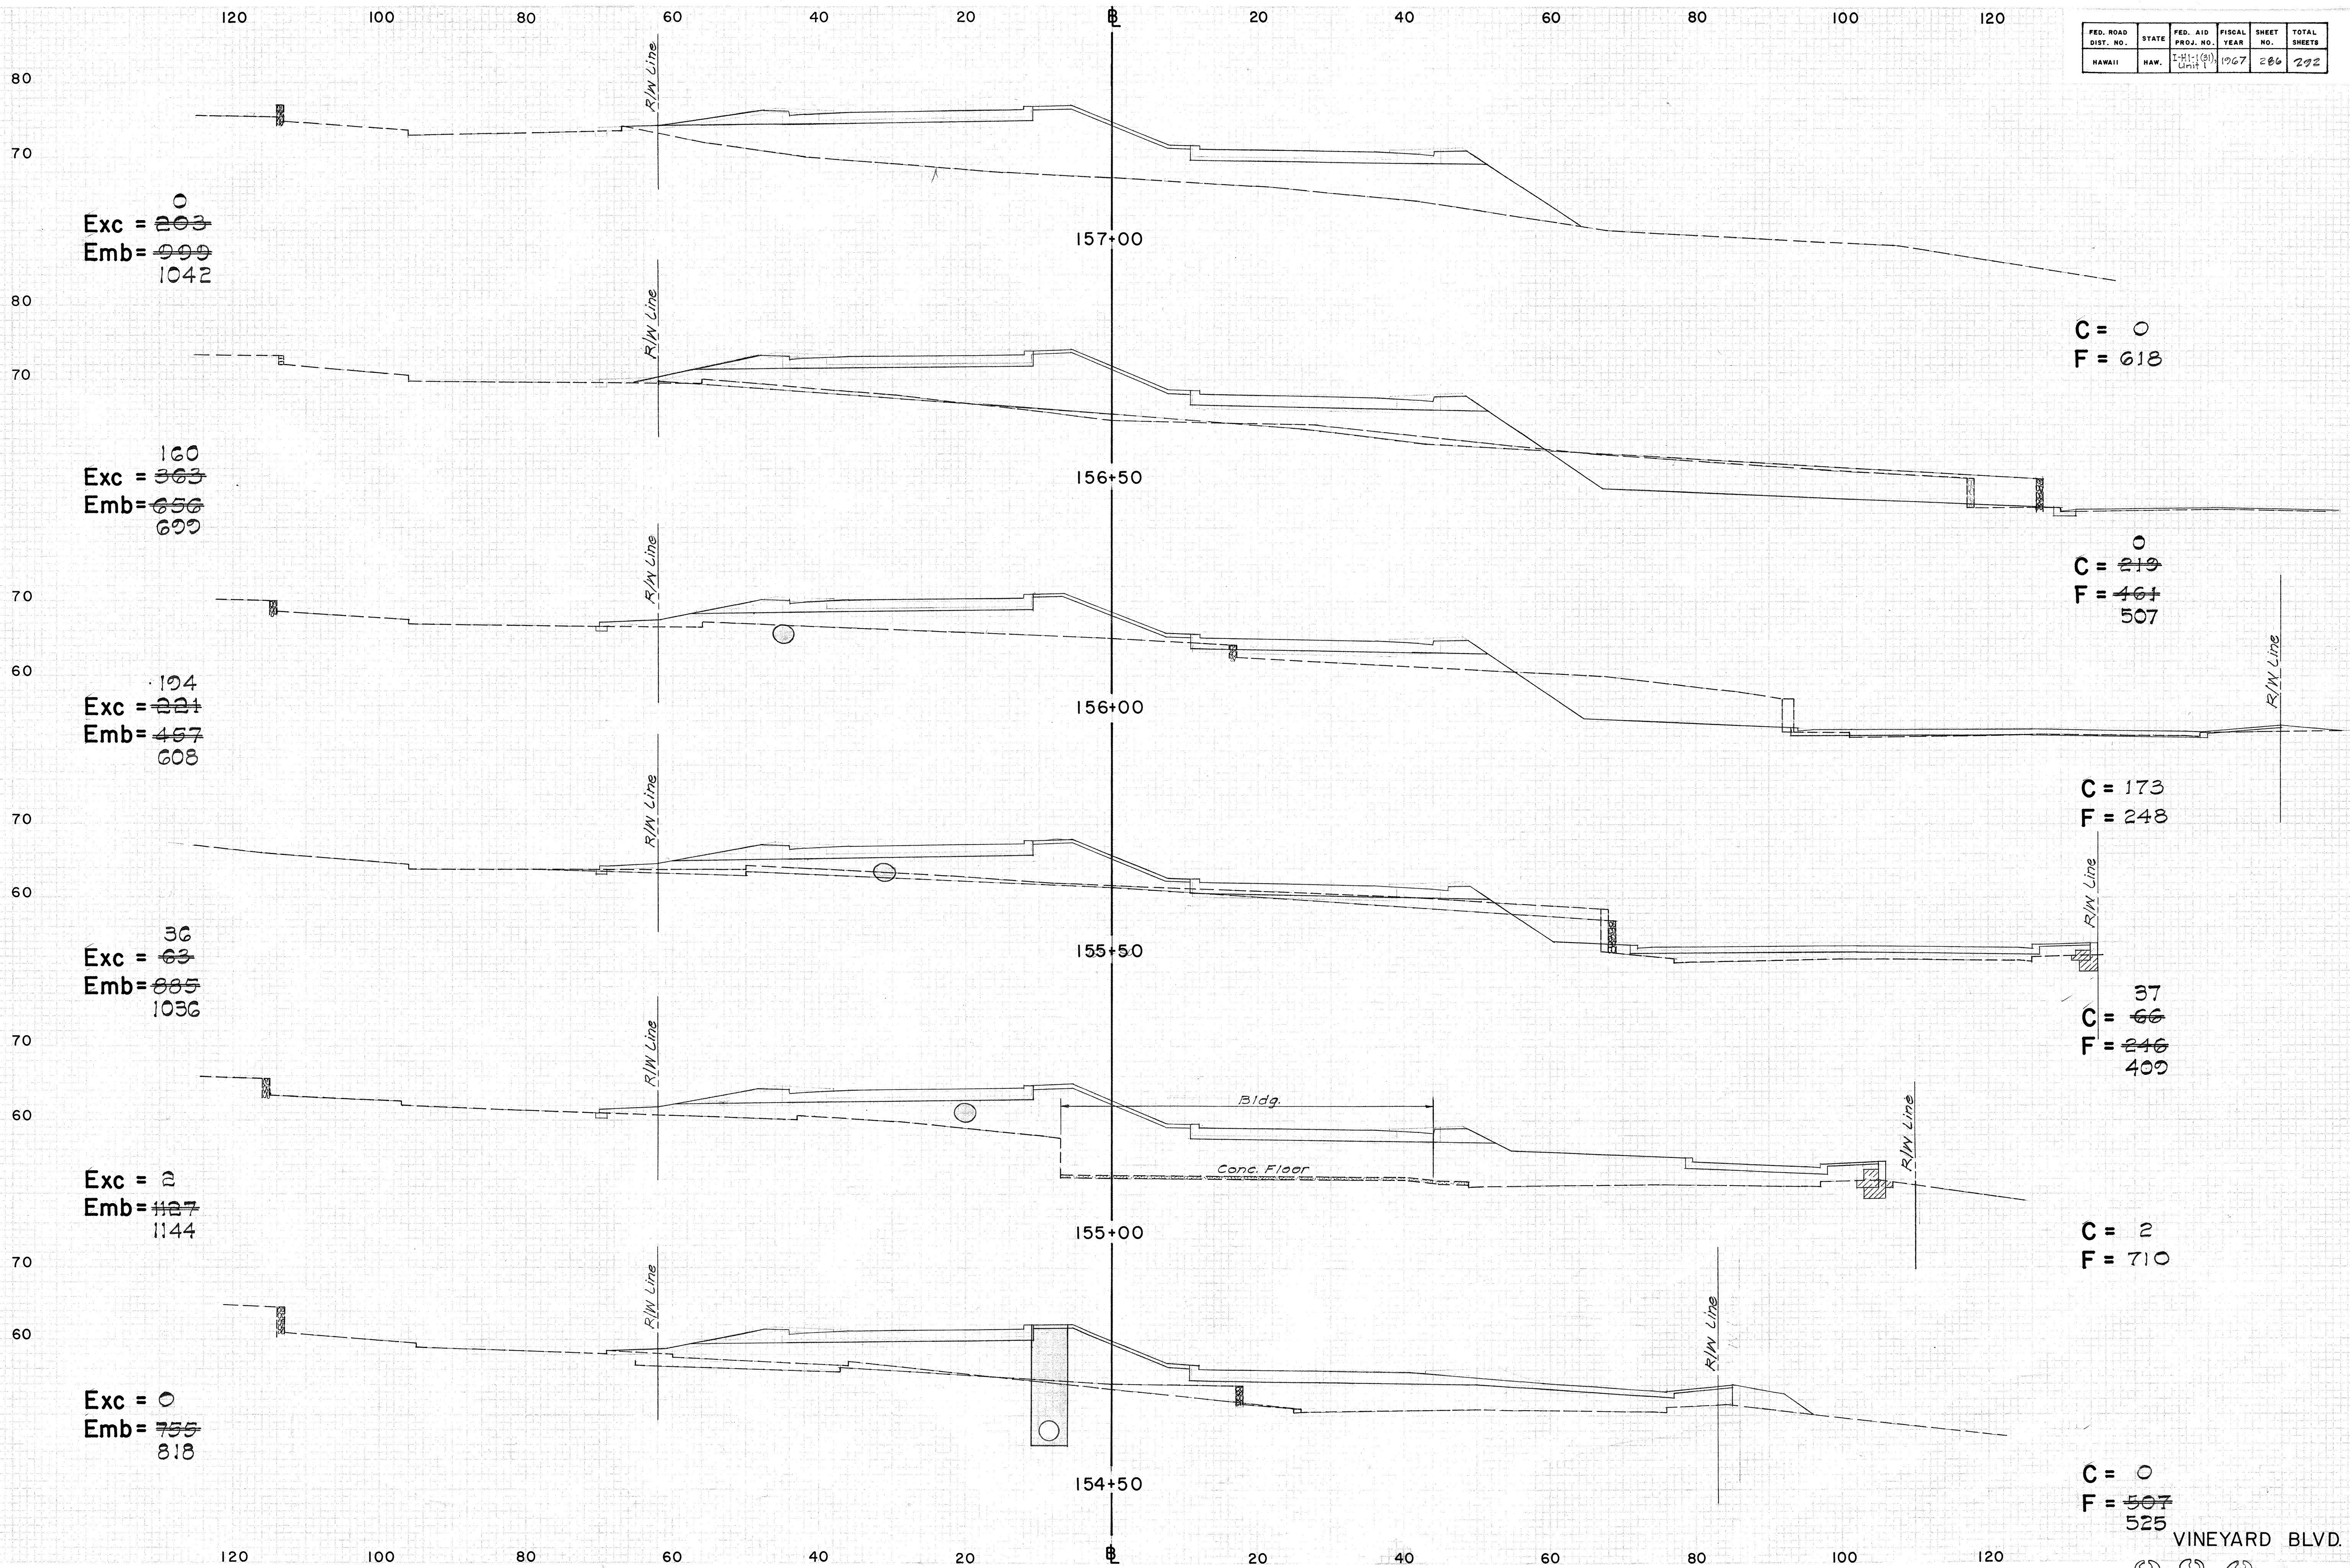


VINEYARD BLVD.

286

FED. ROAD DIST. NO.	STATE	FED. AID PROJ. NO.	FISCAL YEAR	SHEET NO.	TOTAL SHEETS
HAWAII	HAW.	1-31-1(3)	1967	287	292


FINAL SURVEY PLANS
SITE BOOK NO.

ORIGINAL SURVEY PLANS
SITE BOOK NO.

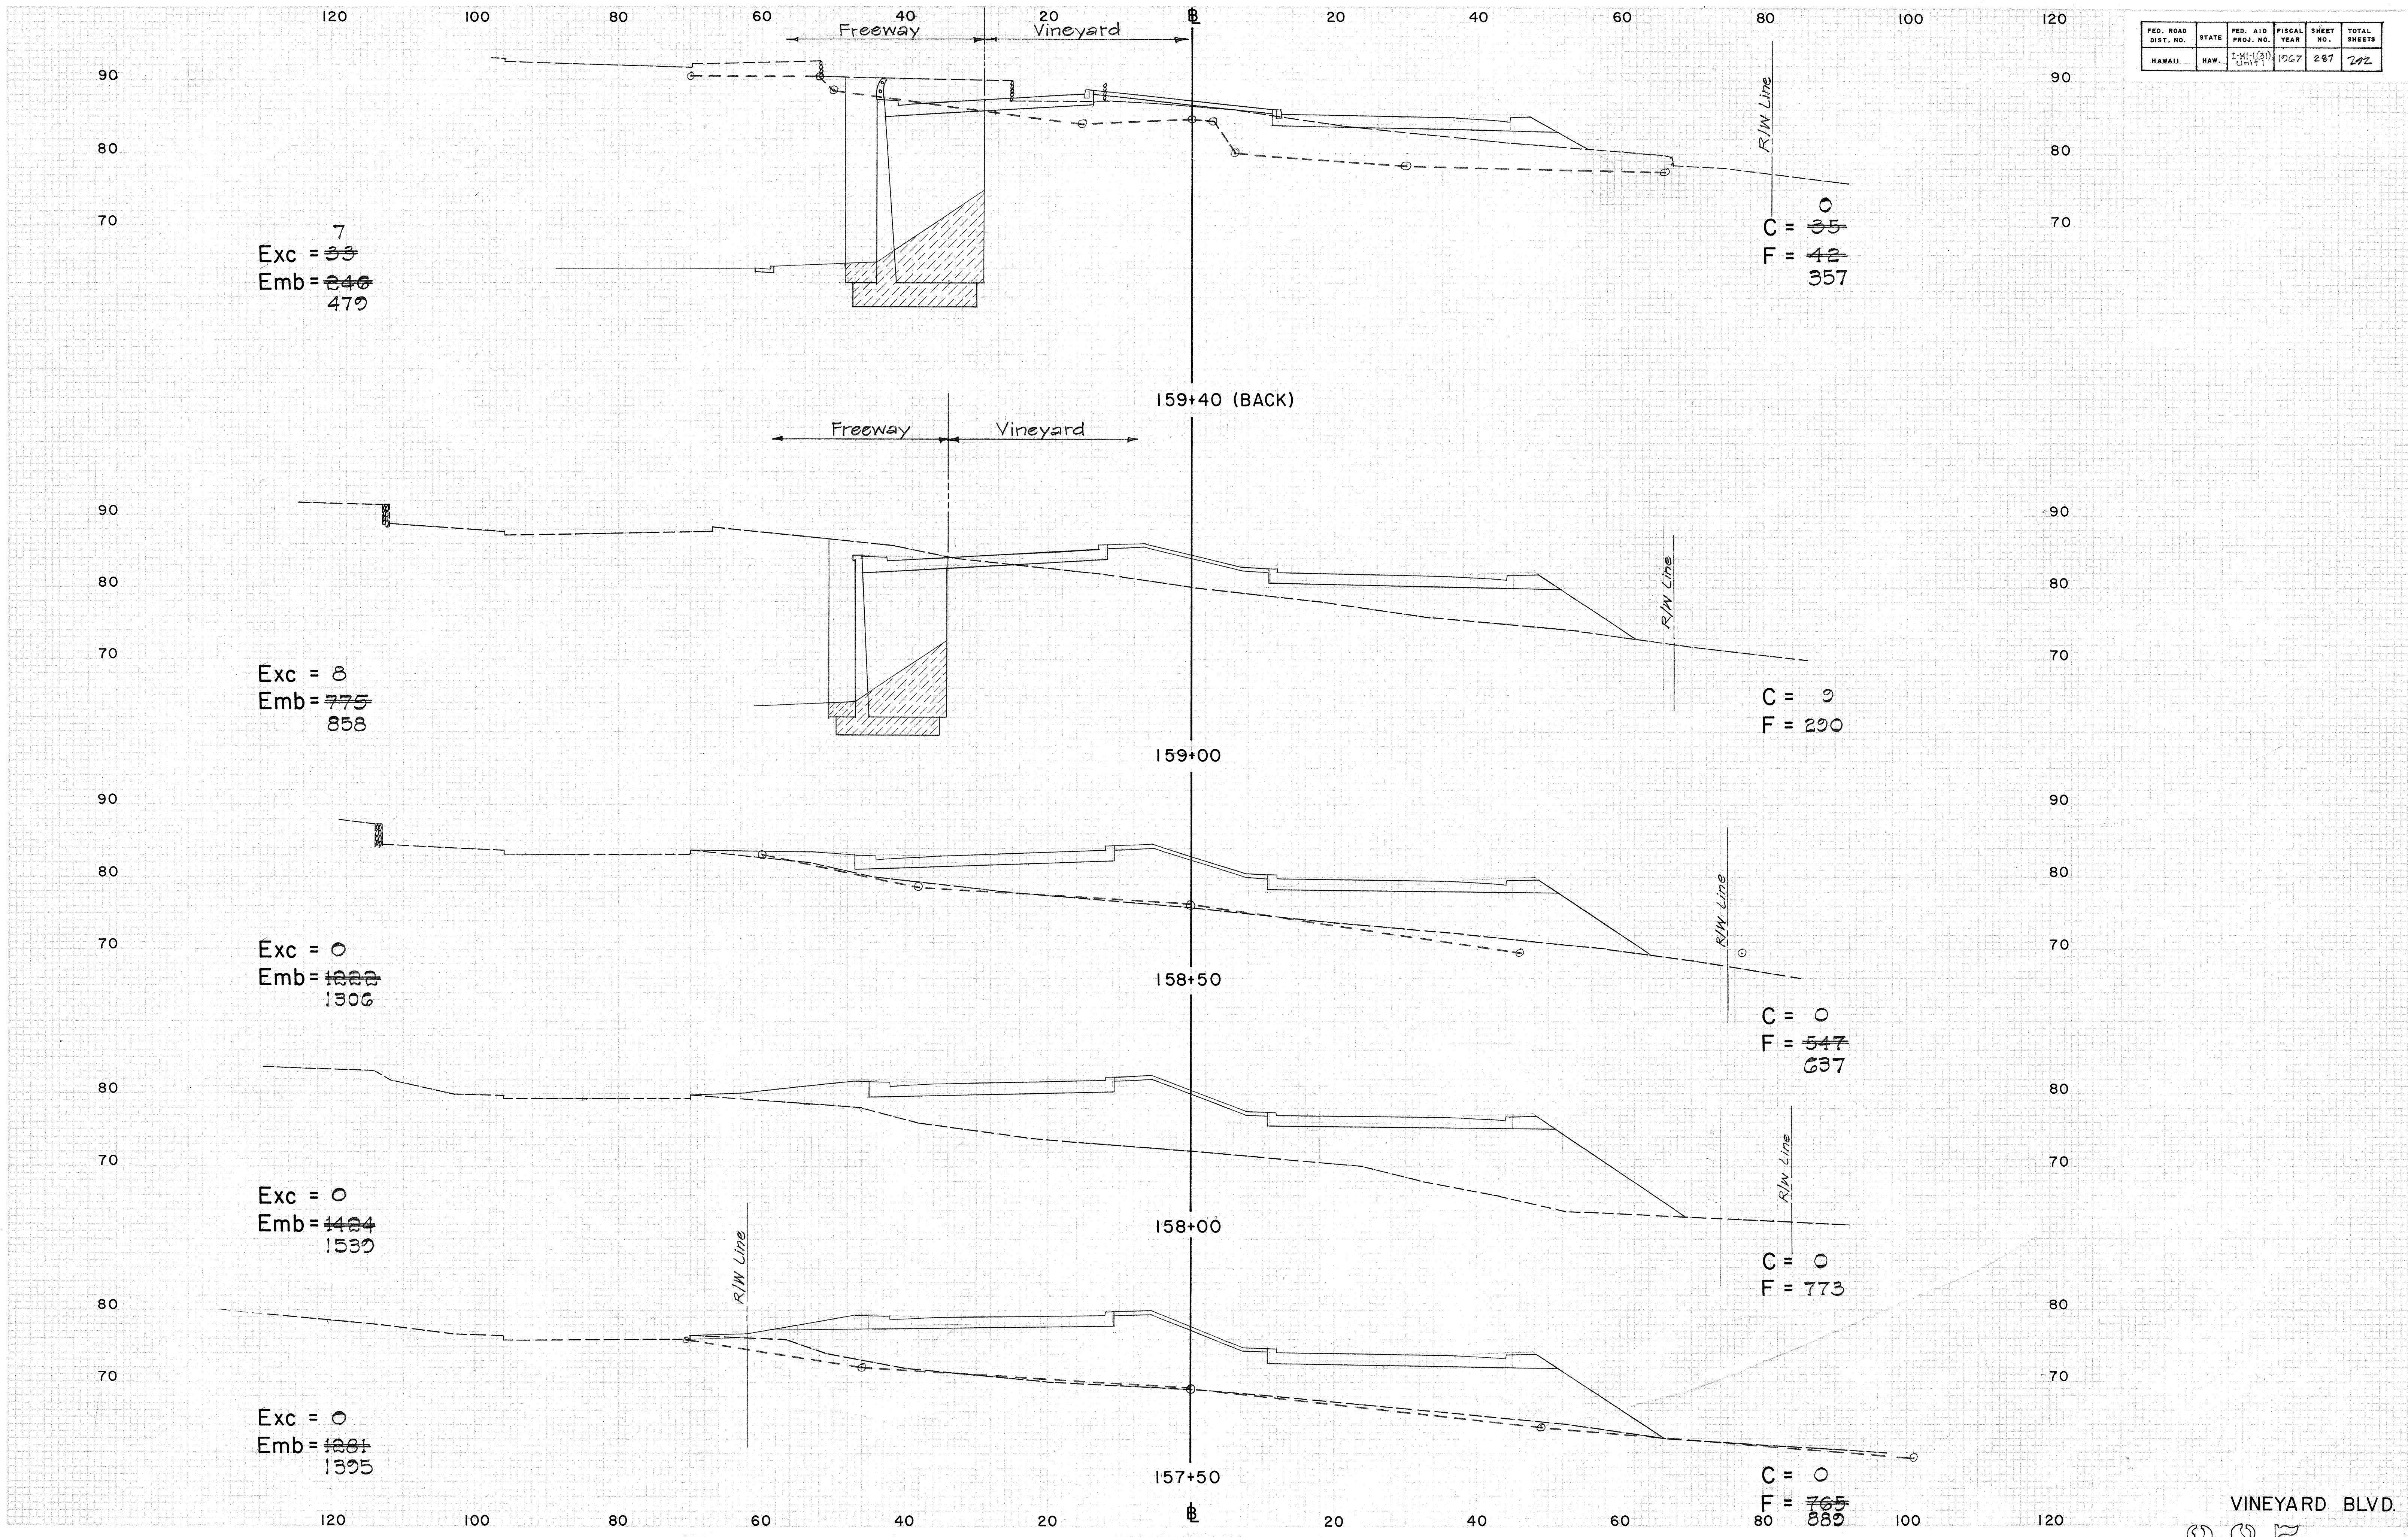

VINEYARD BLVD.


FED. ROAD DIST. NO.	STATE	FED. AID PROJ. NO.	FISCAL YEAR	SHEET NO.	TOTAL SHEETS
HAWAII	HAW.	1-101-1(90) Unit 1	1967	268	292

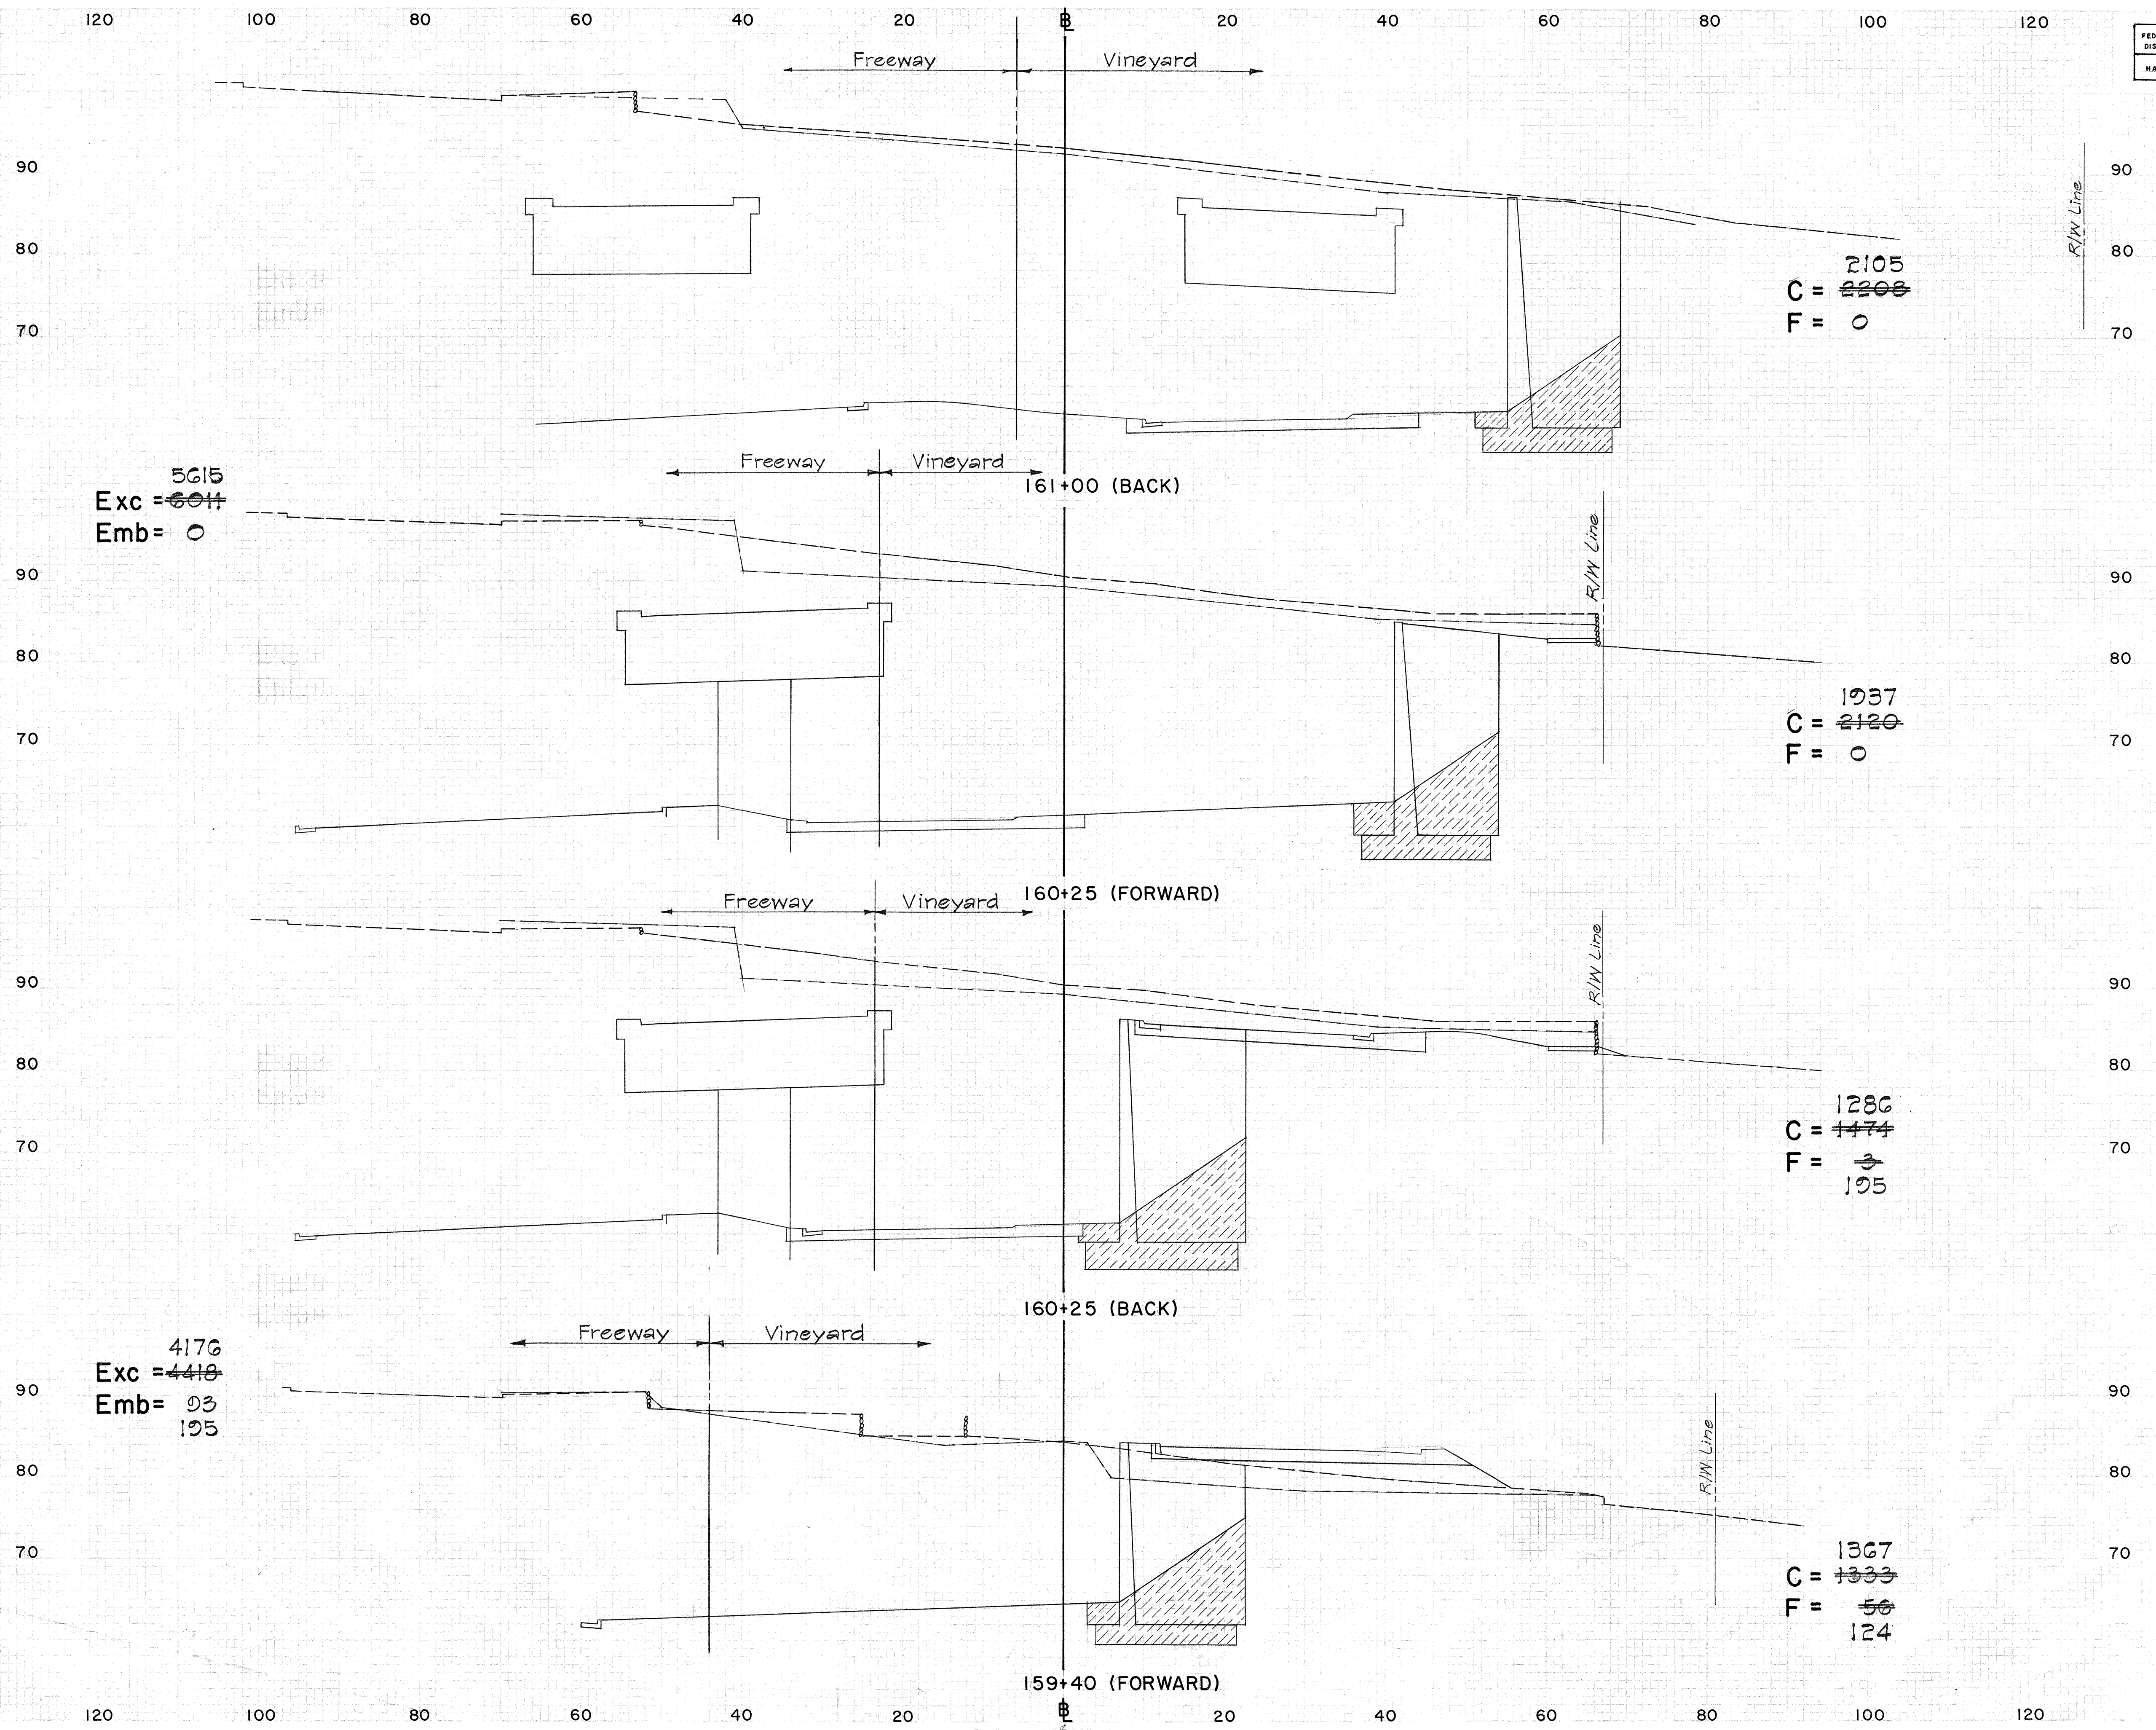

VINEYARD BLVD.

288

FED. ROAD DIST. NO.	STATE	FED. AID PROJ. NO.	FISCAL YEAR	SHEET NO.	TOTAL SHEETS
HAWAII	HAW.	1-111(91) Unit 1	1967	289	292

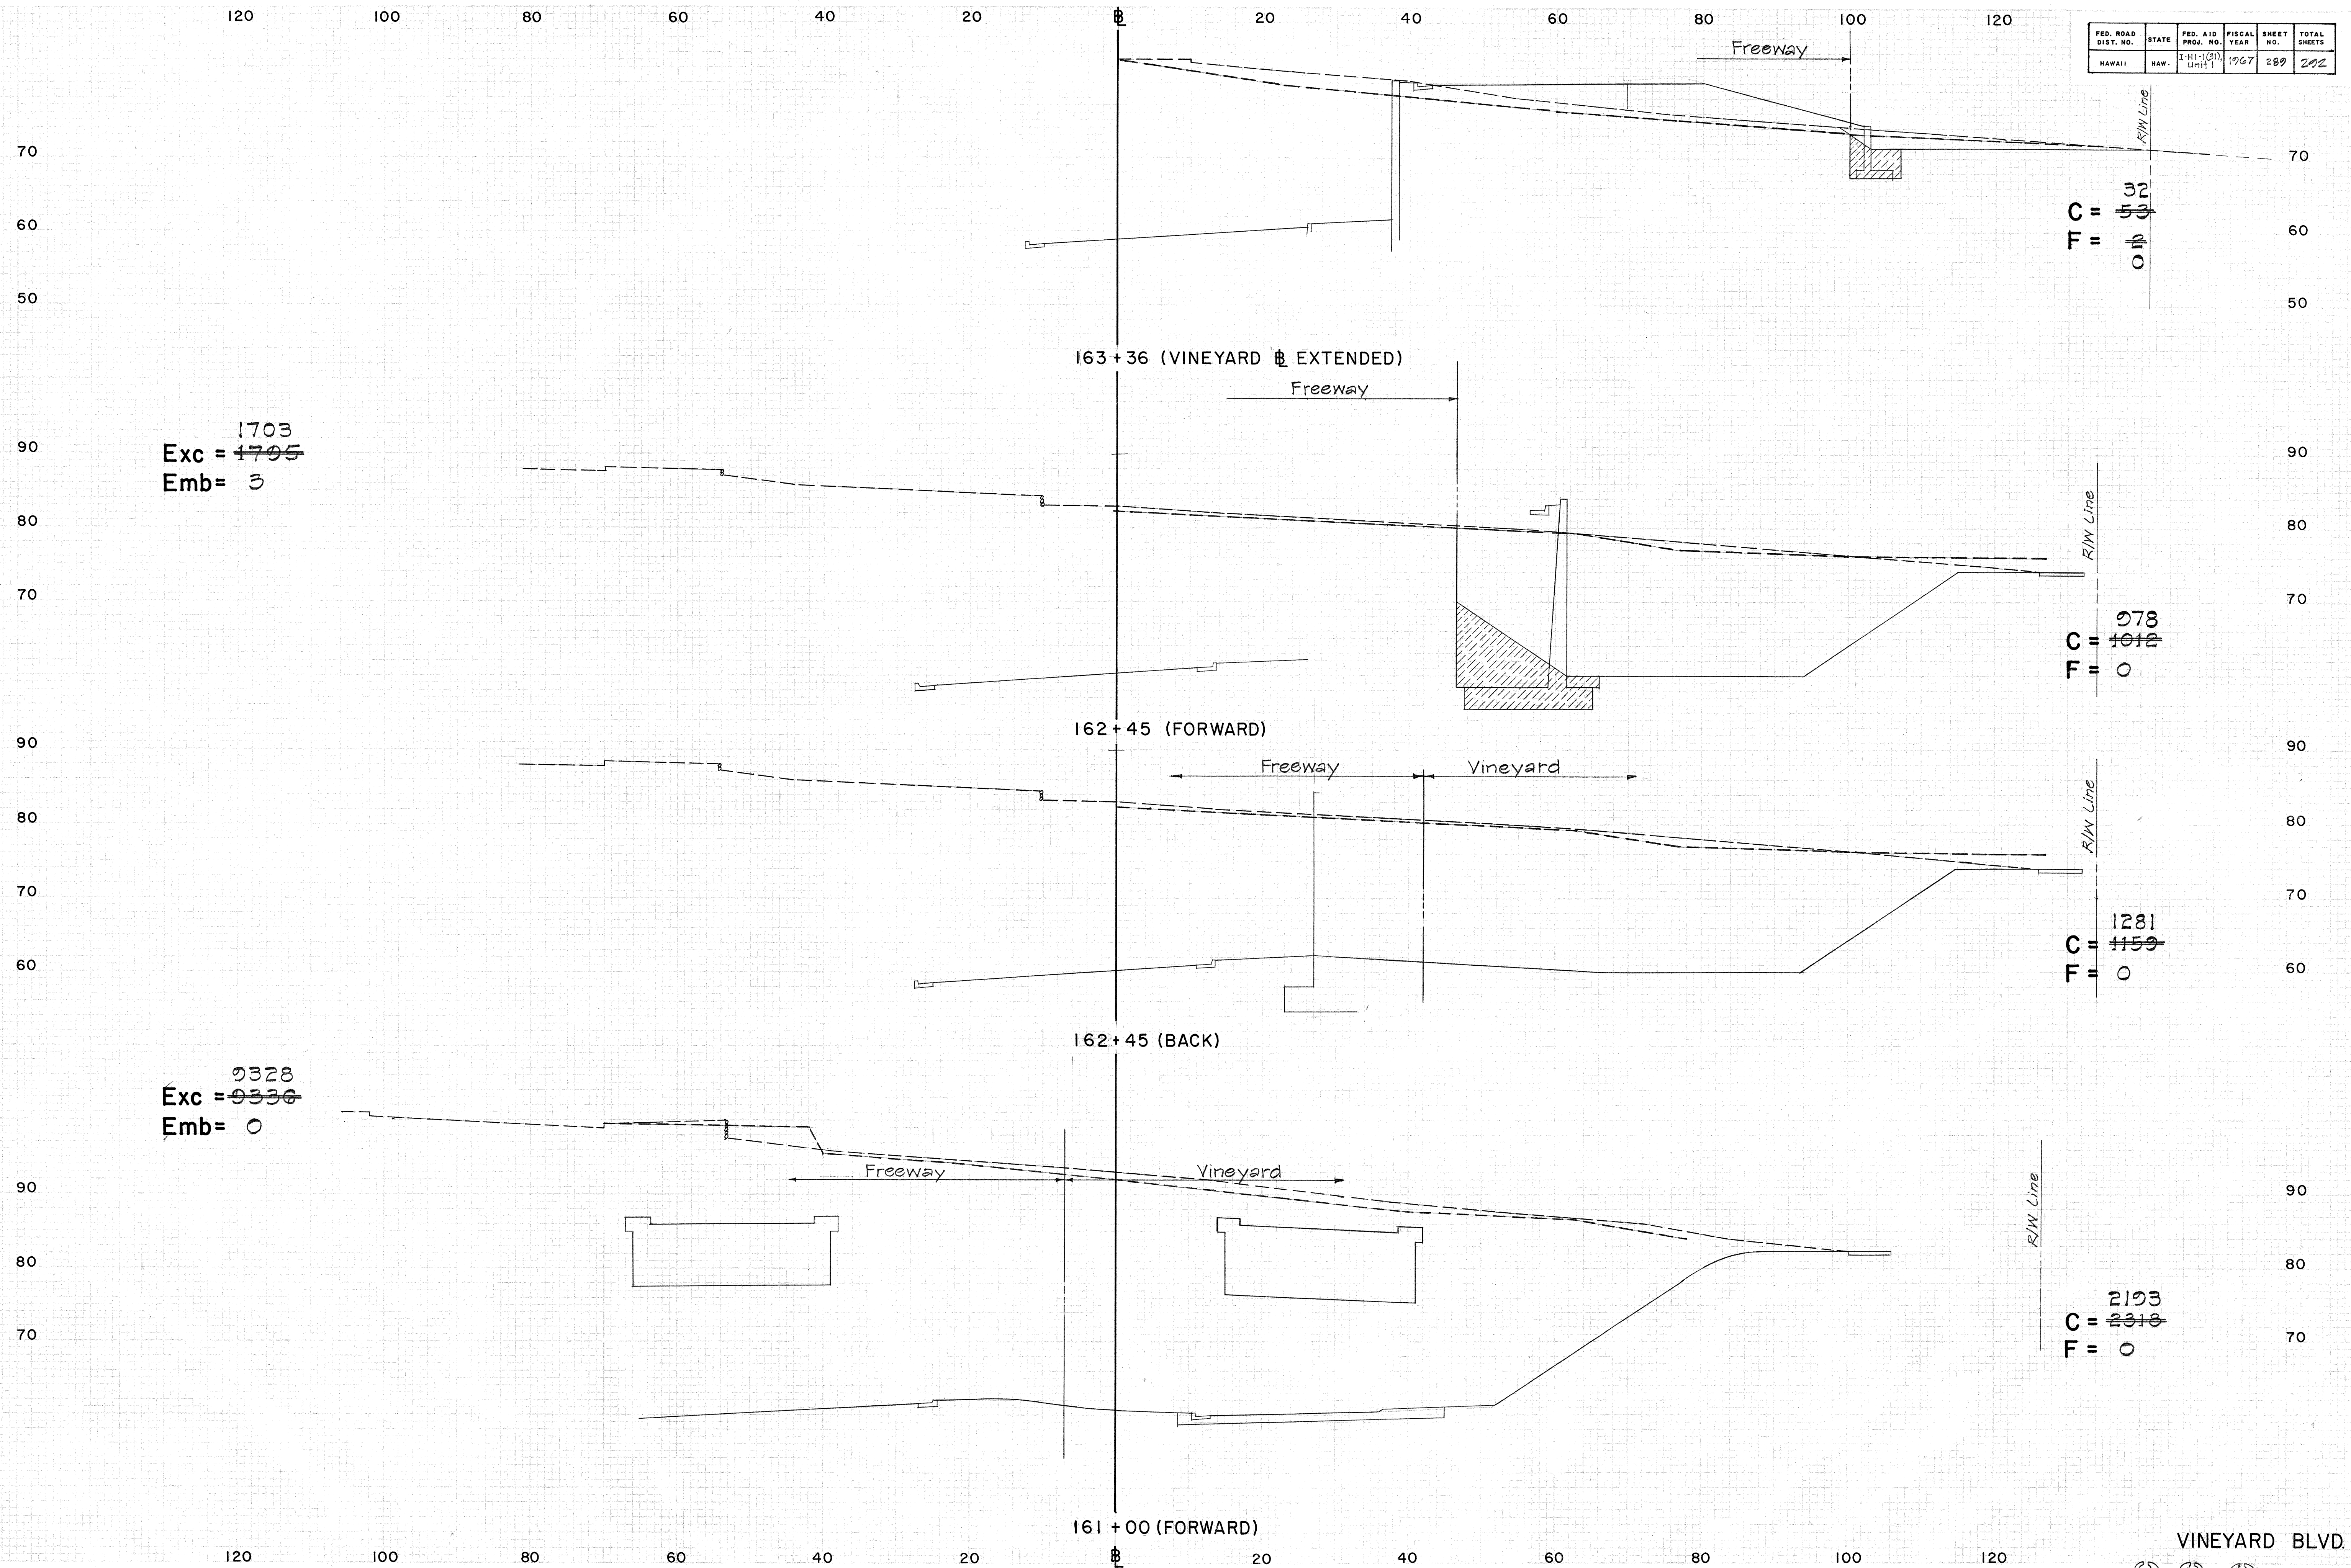

VINEYARD BLVD.



289

FED. ROAD DIST. NO.	STATE	FED. AID PROJ. NO.	FISCAL YEAR	SHEET NO.	TOTAL SHEETS
HAWAII	HAW	1-41-1(31) Unit	1967	290A	292

4/11/67

DATE	BY	REVISION

DATE	BY	REVISION

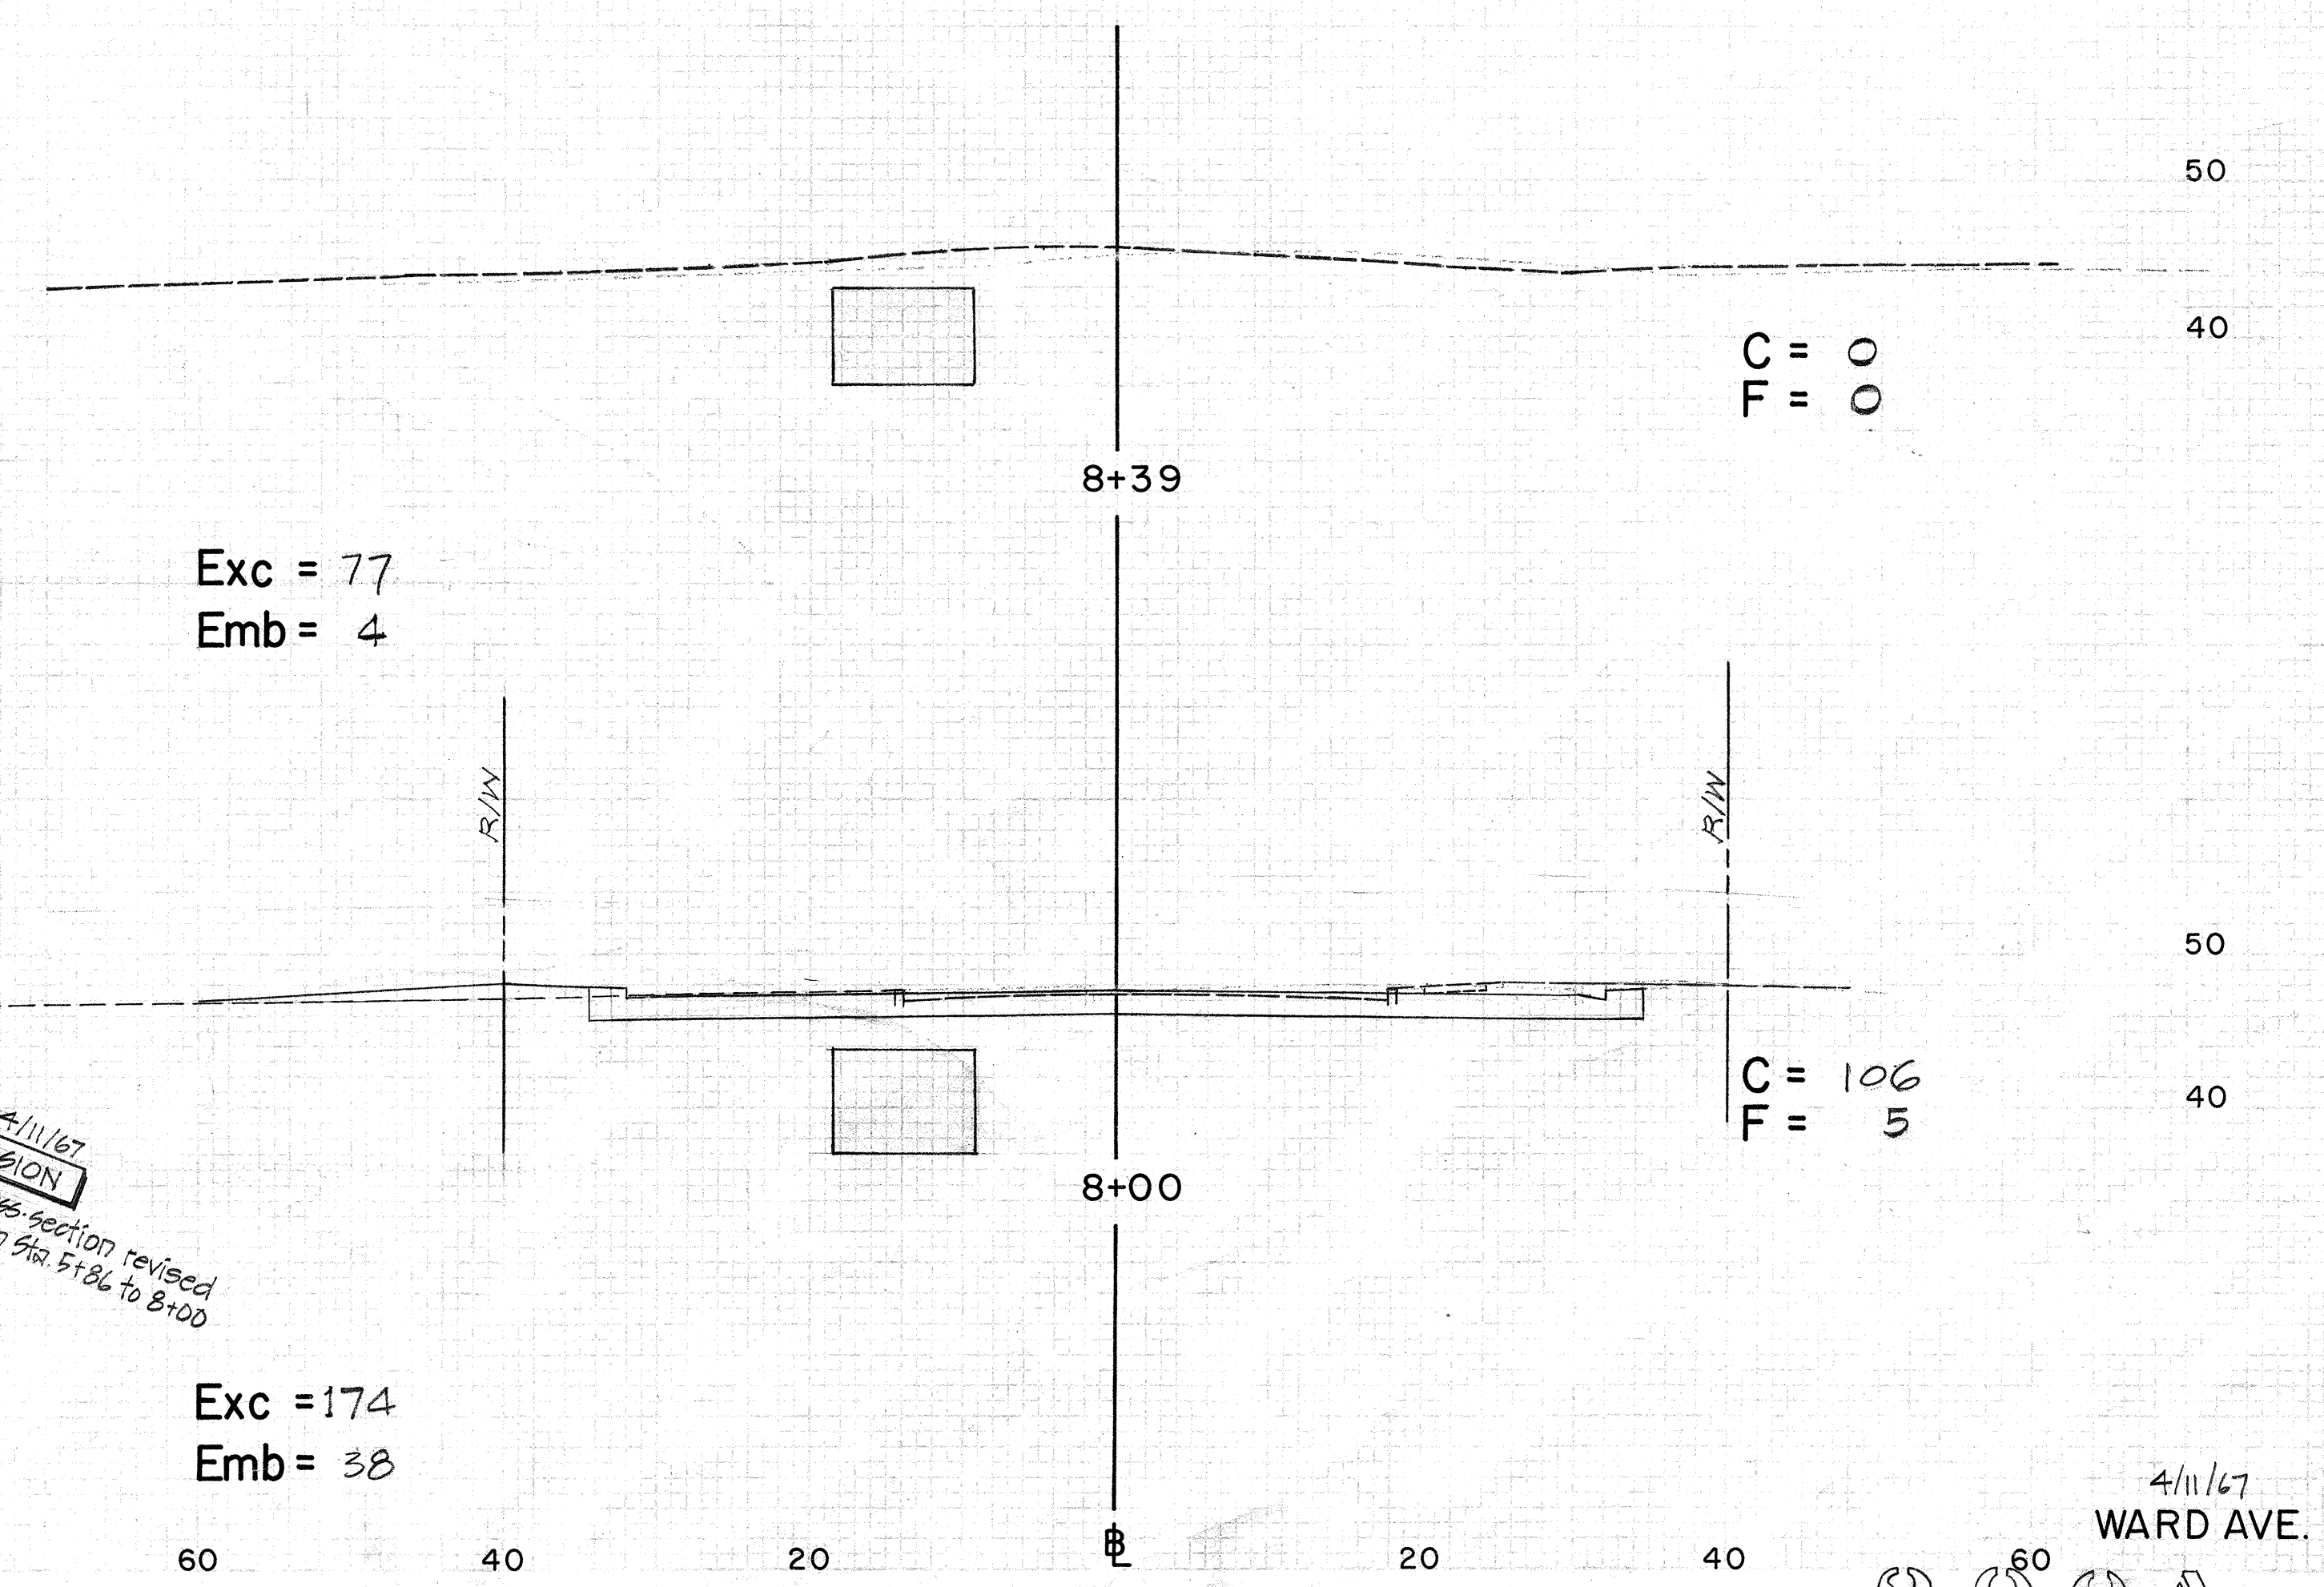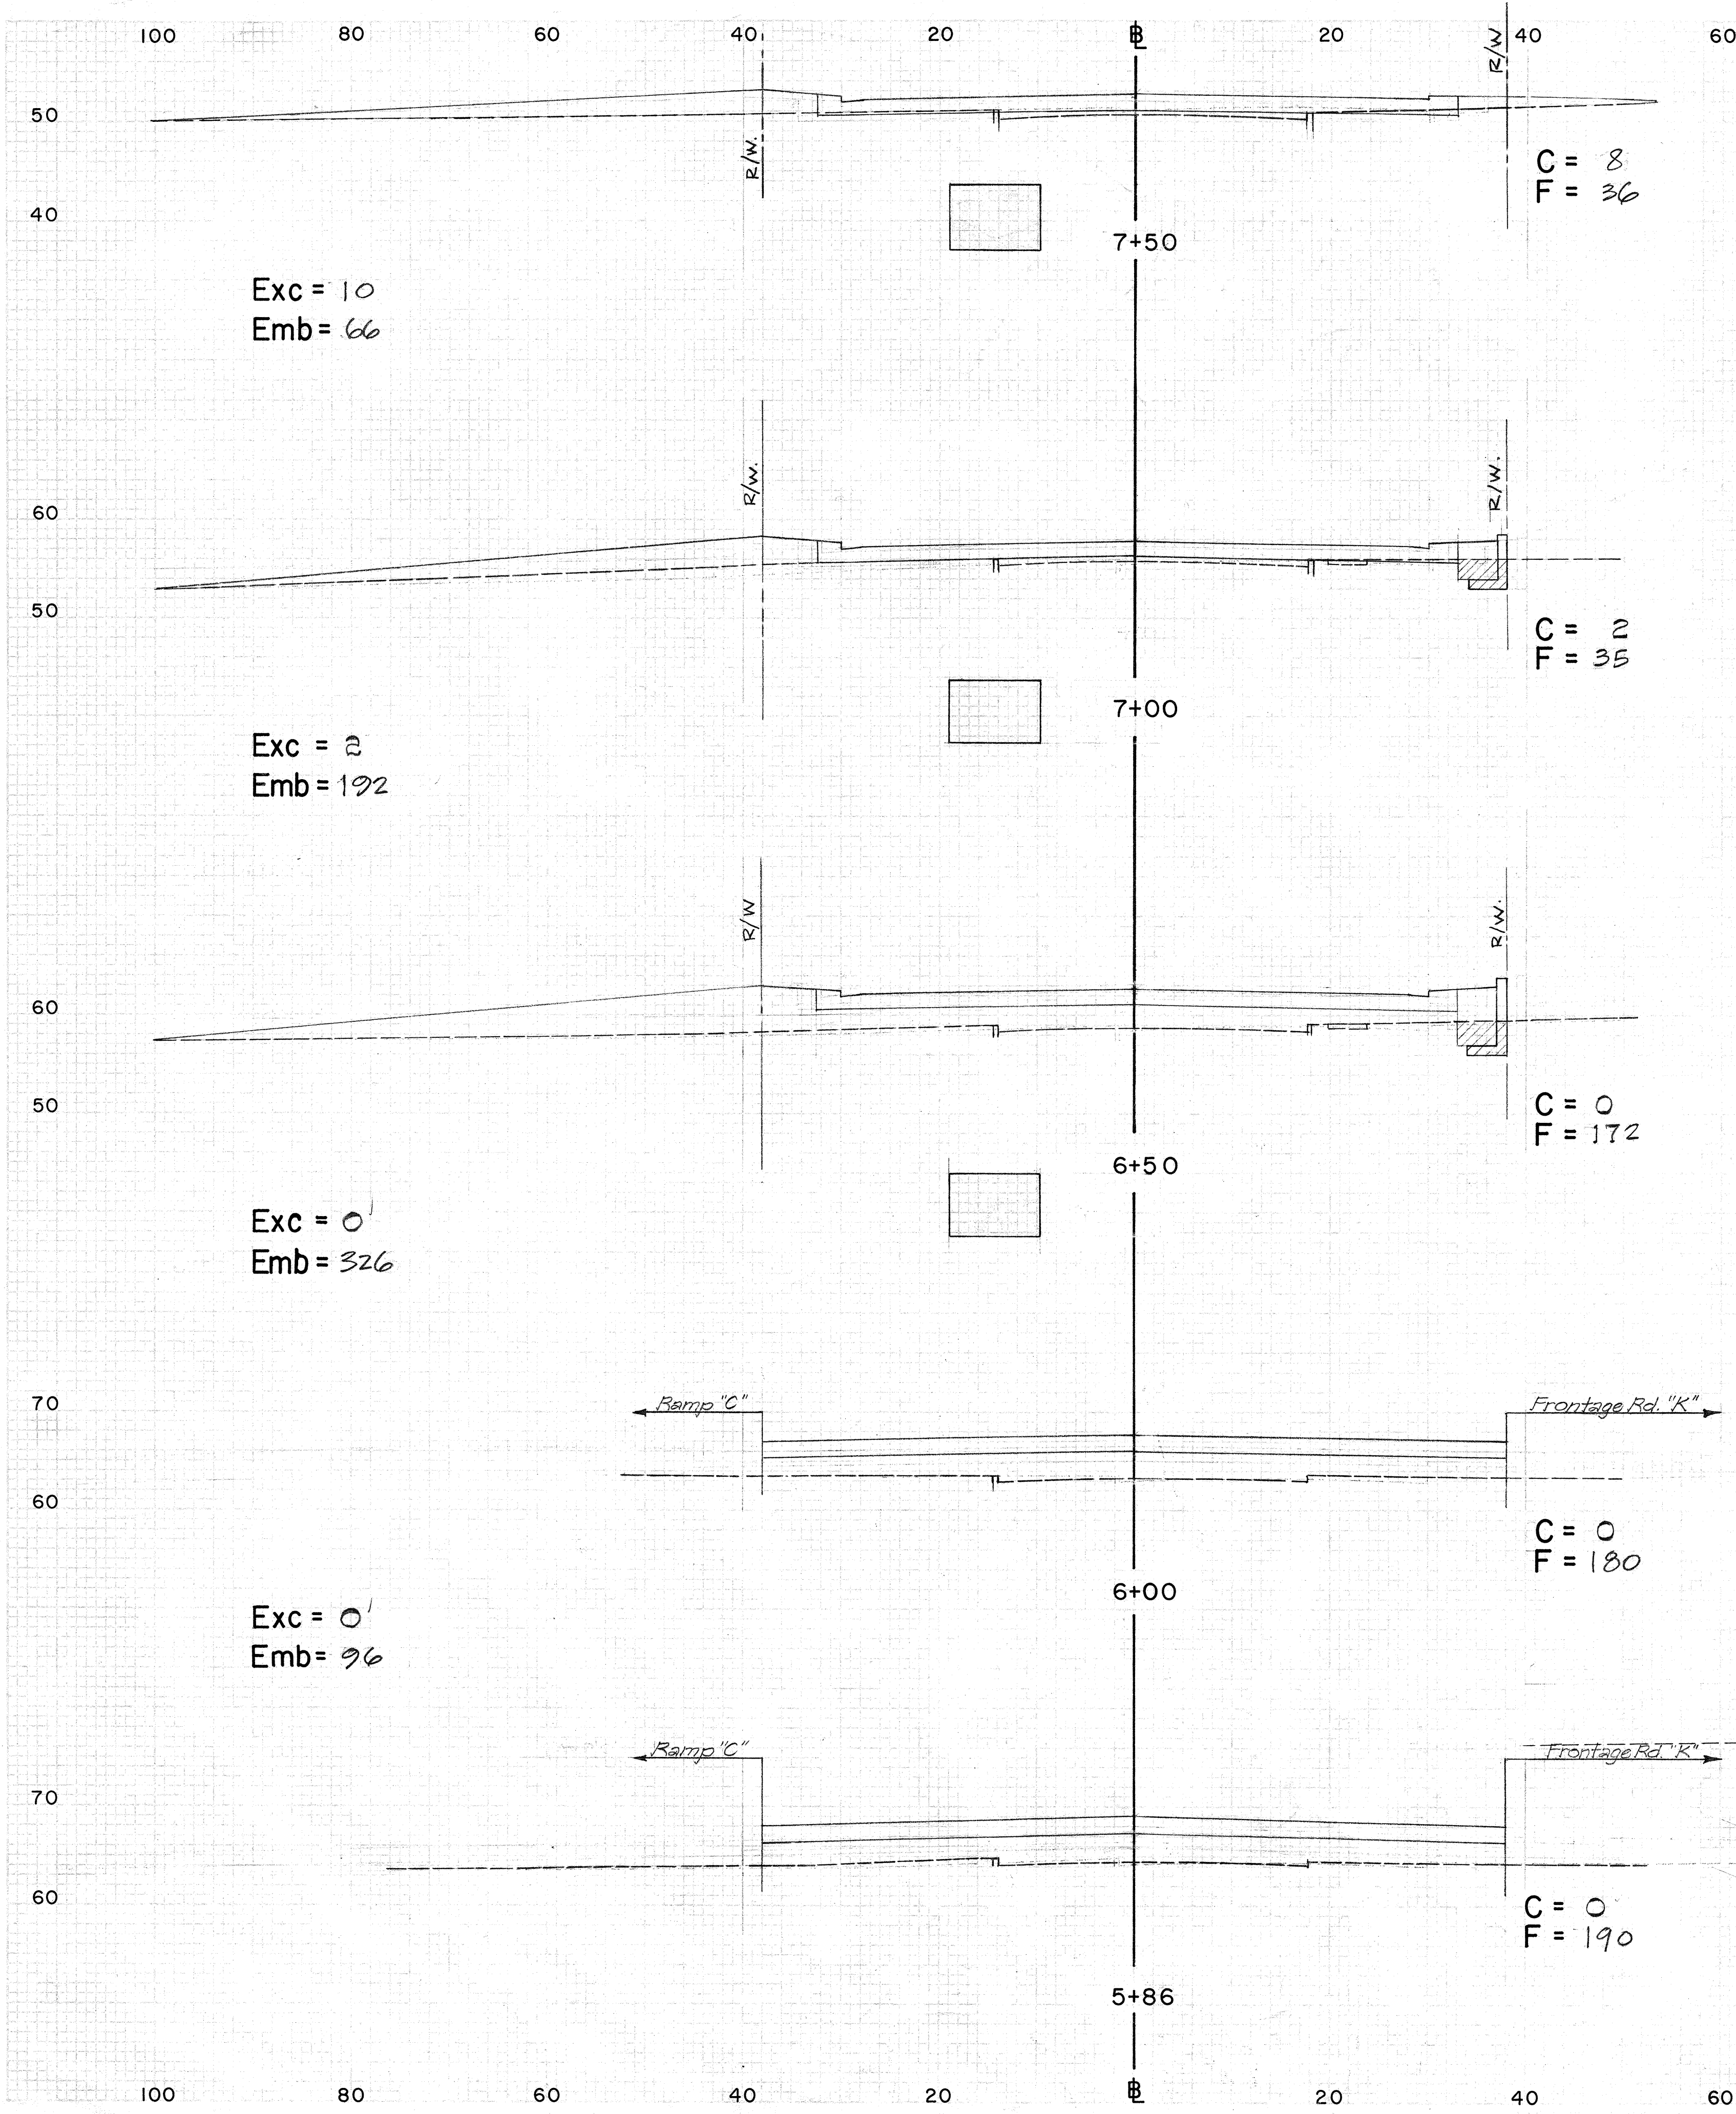

4/11/67
REVISION
Cross-section revised
from Sta 5+86 to 8+00

THIS SHEET SUPERCEDES SHEET 290

290A



4/11/67
WARD AVE.

DS-1-11

FED. ROAD DIST. NO.	STATE	FED. AID PROJ. NO.	FISCAL YEAR	SHEET NO.	TOTAL SHEETS
HAWAII	HAW.	1-51-(51) Unit 1	1967	291	292


ORIGINAL SURVEY
 DATE: 8/20/66
 BY: [illegible]
 CHECKED: [illegible]
 NO. [illegible]

ORIGINAL SURVEY
 DATE: 8/20/66
 BY: [illegible]
 CHECKED: [illegible]
 NO. [illegible]

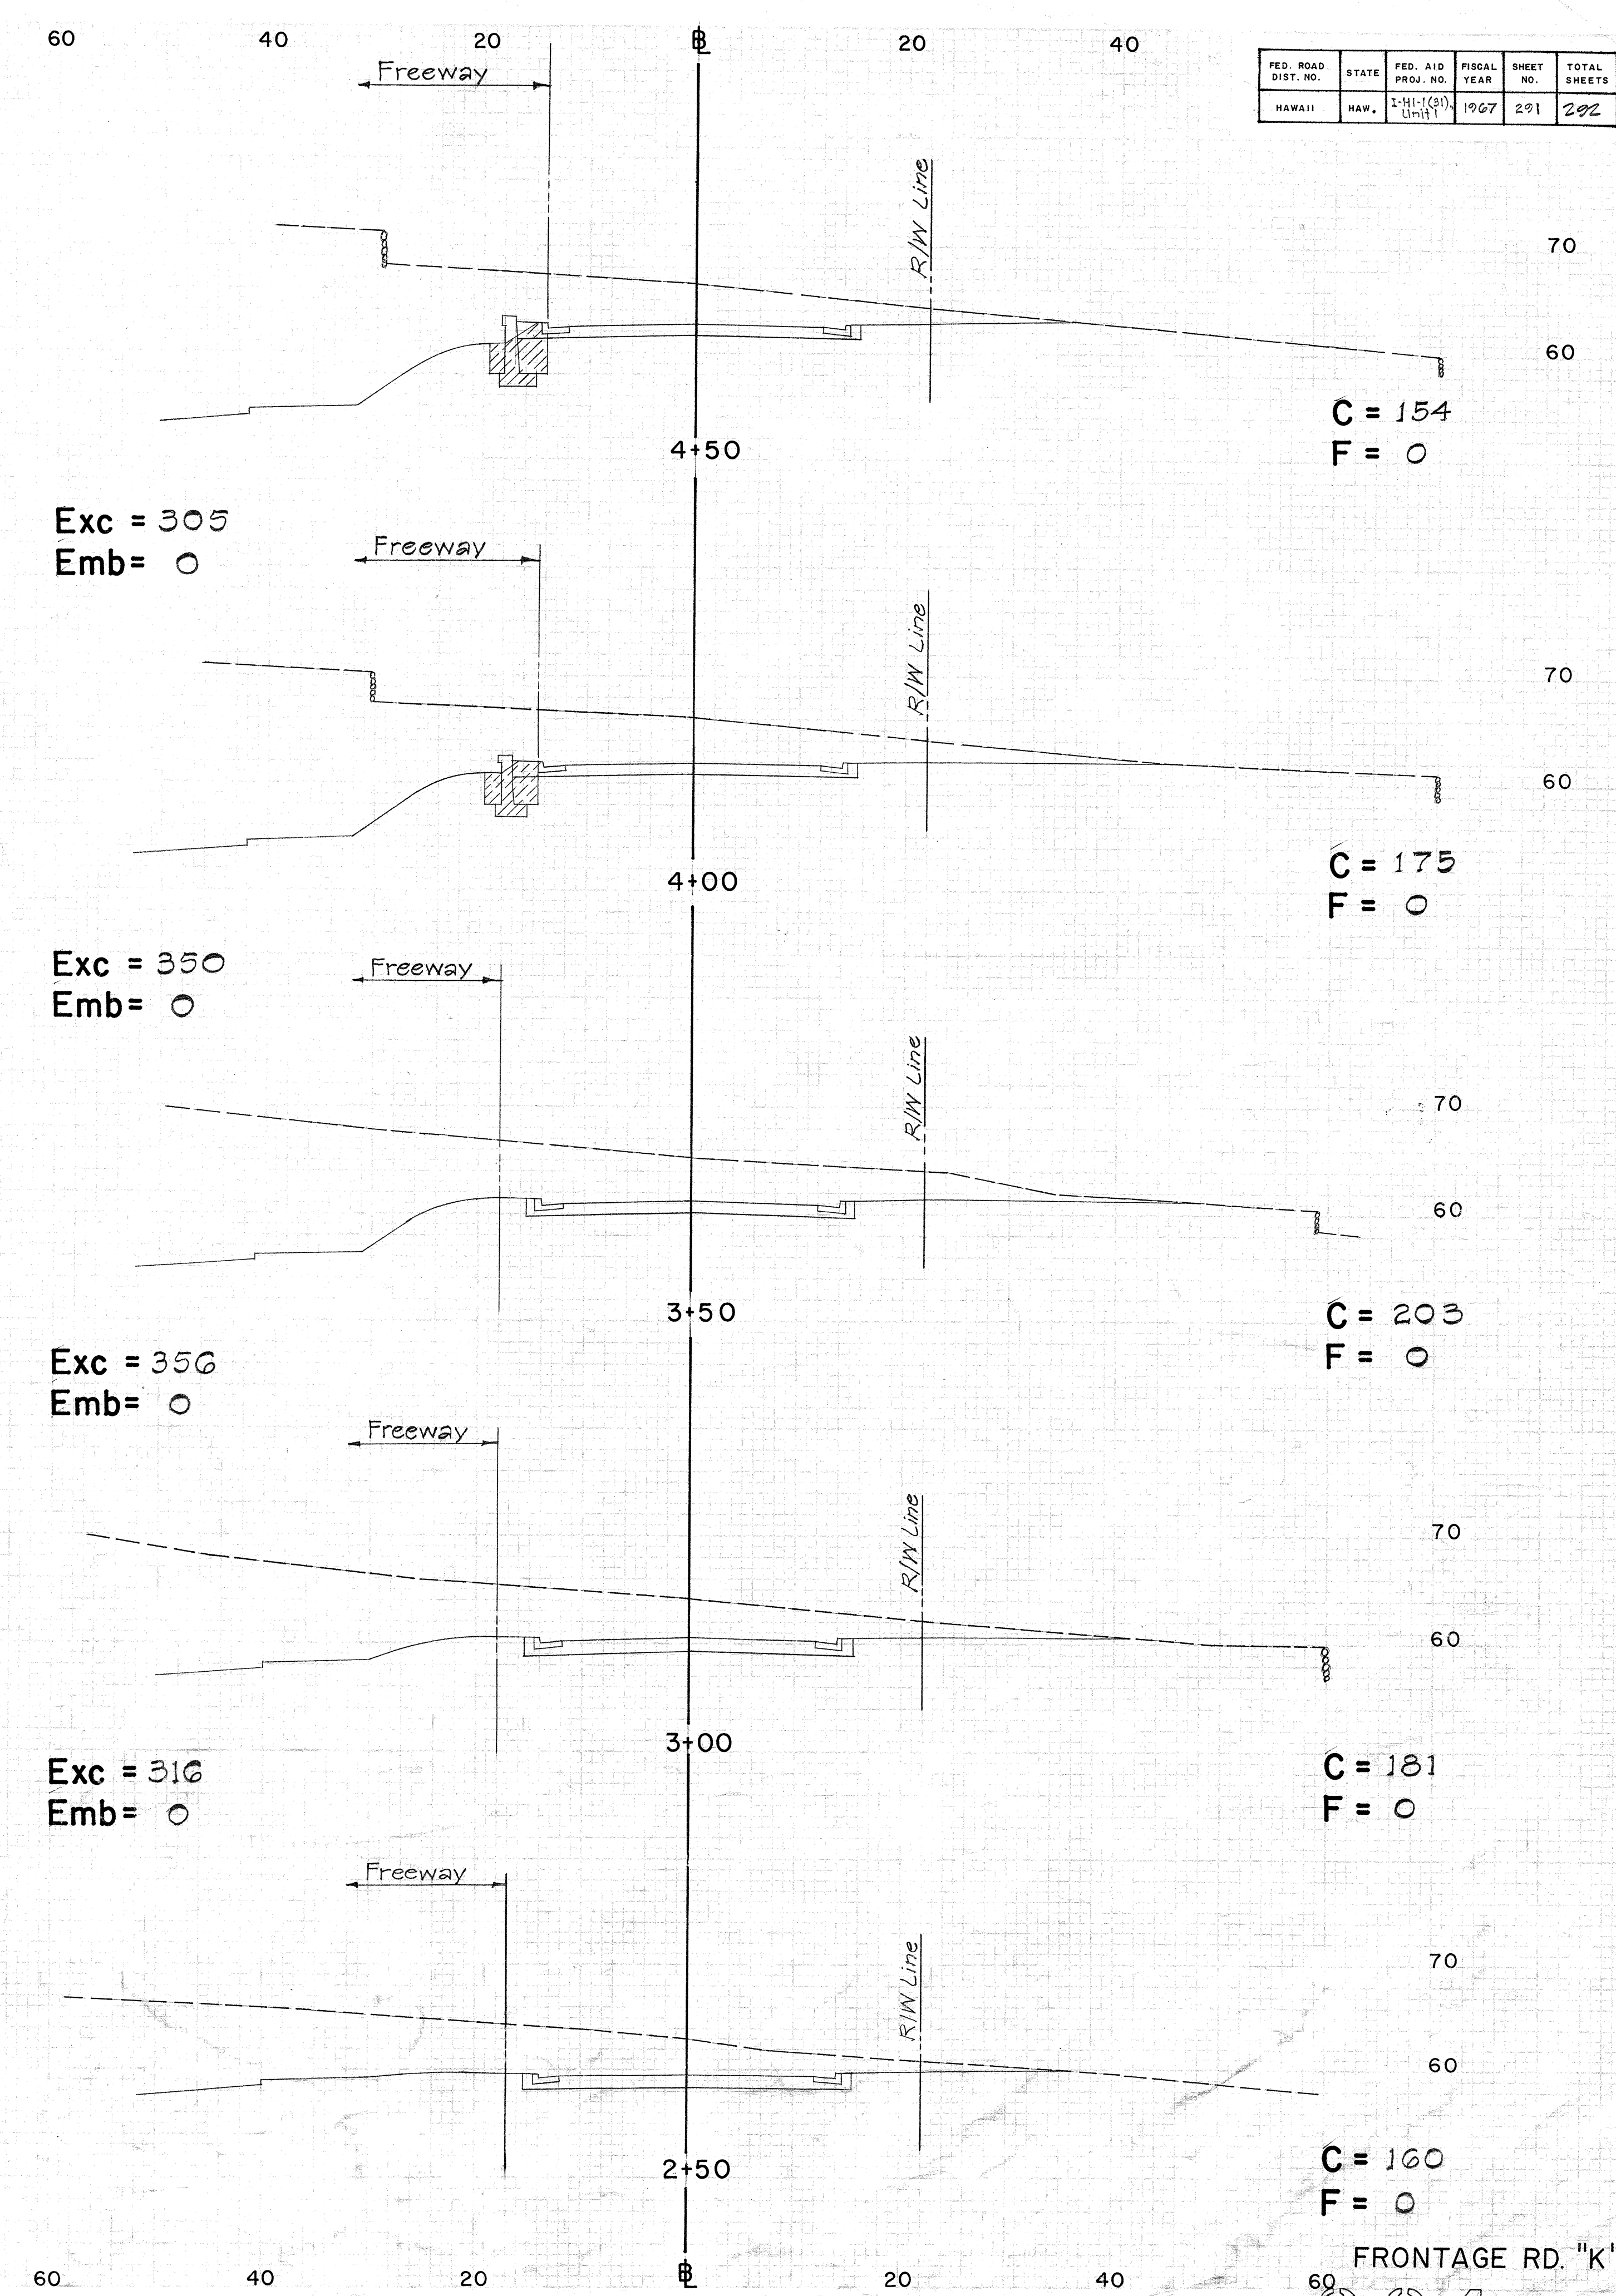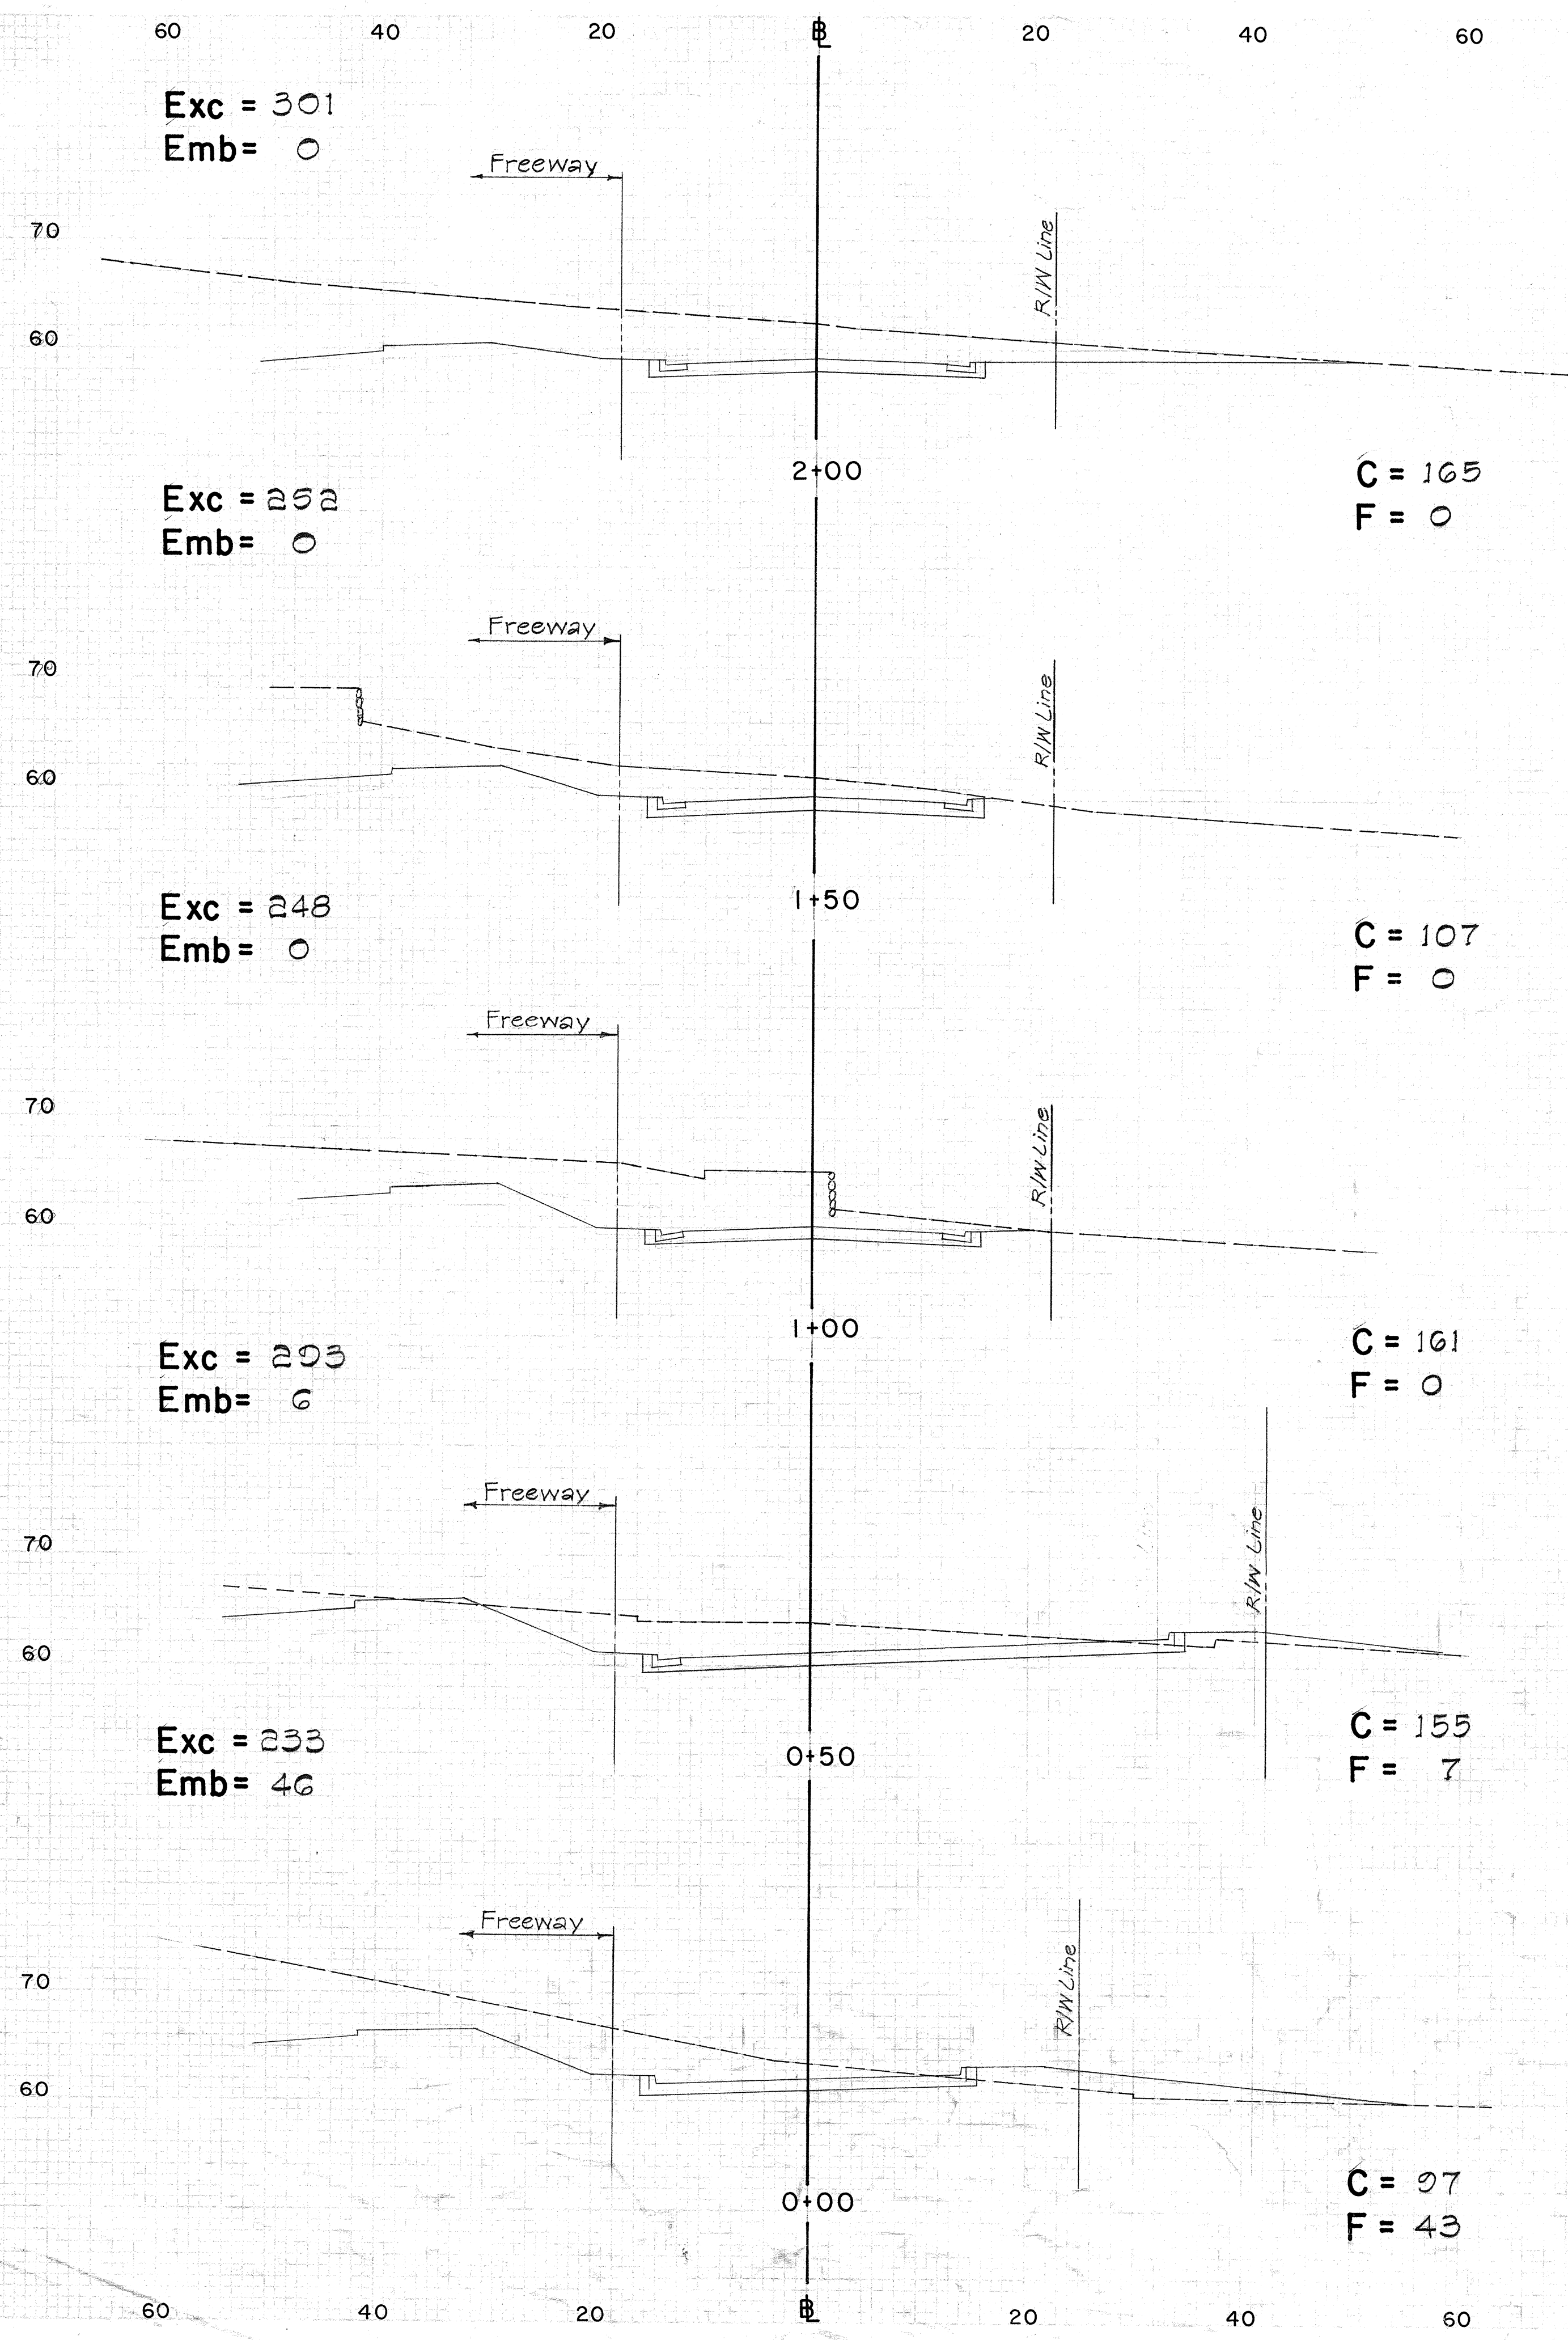

077

FED. ROAD DIST. NO.	STATE	FED. AID PROJ. NO.	FISCAL YEAR	SHEET NO.	TOTAL SHEETS
HAWAII	HAW.	1-41-1(81) Unit 1	1967	292A	292

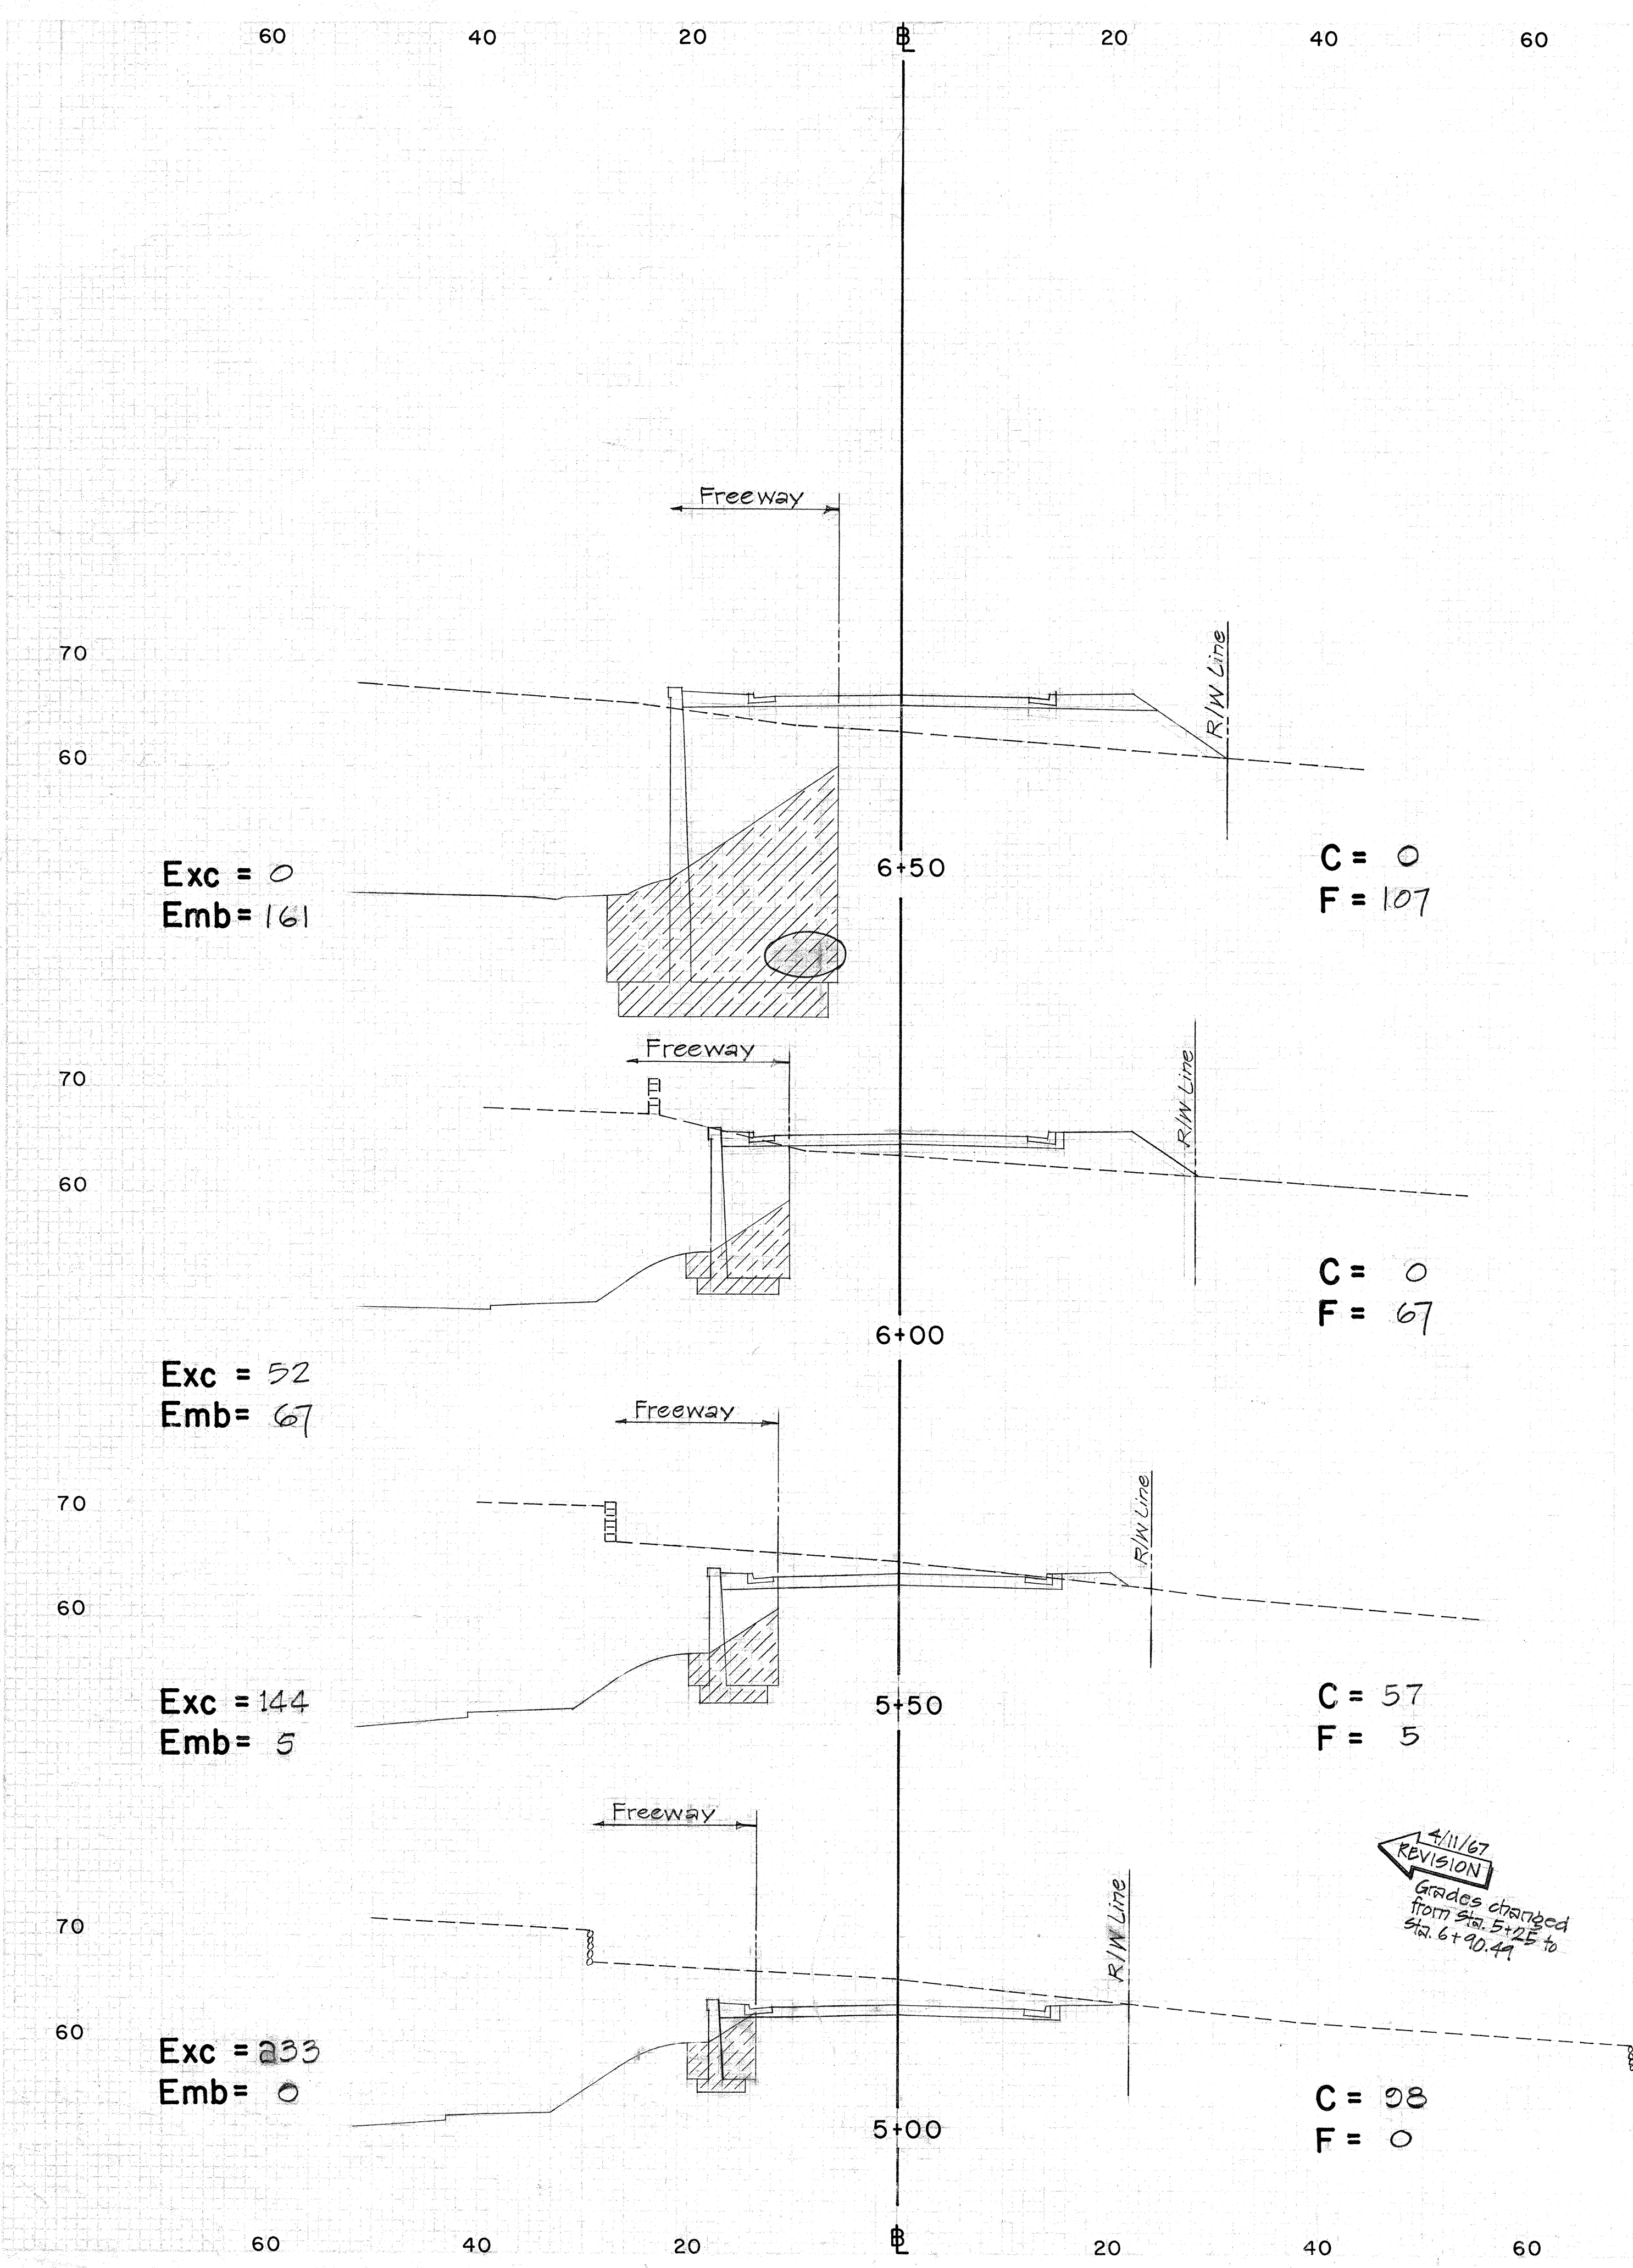

THIS SHEET SUPERCEDES SHEET 292

4/11/67
FRONTAGE RD. "K"
292A