



TRUE NORTH
Scale: 1" = 20'


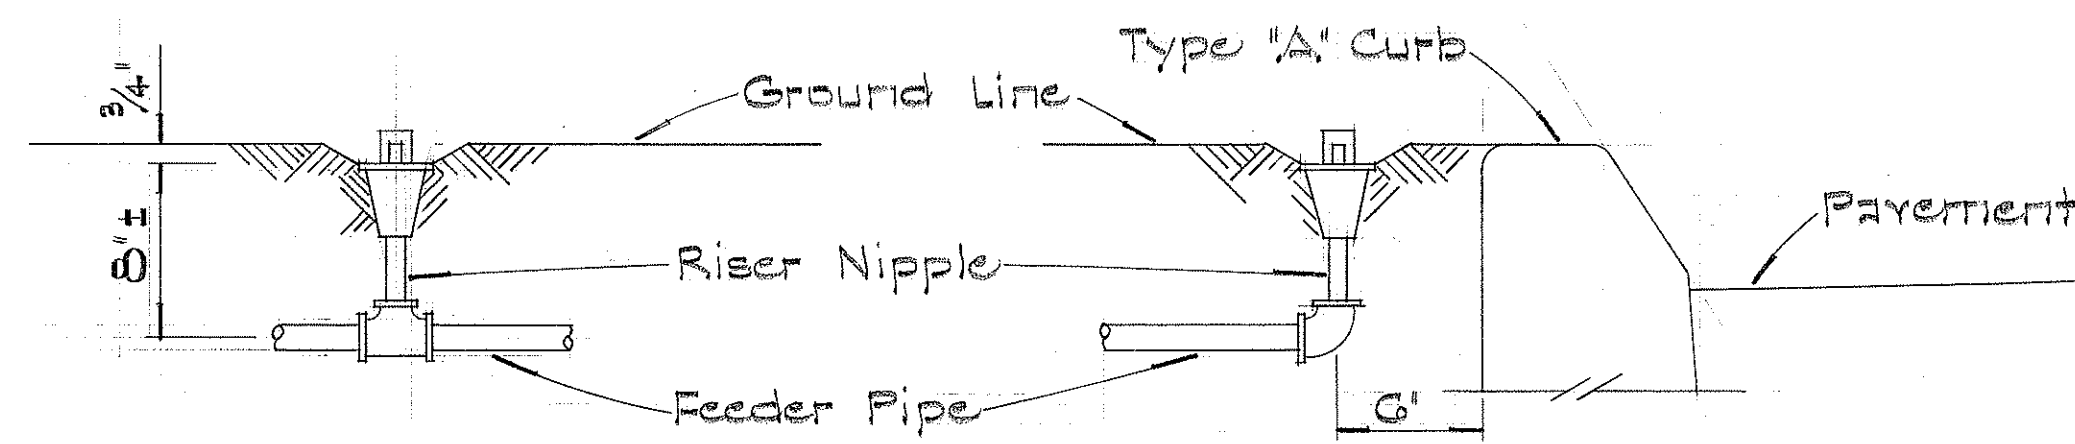


CURVE DATA
R = 320.00'
Δ = 10°23'20"
T = 30.00'

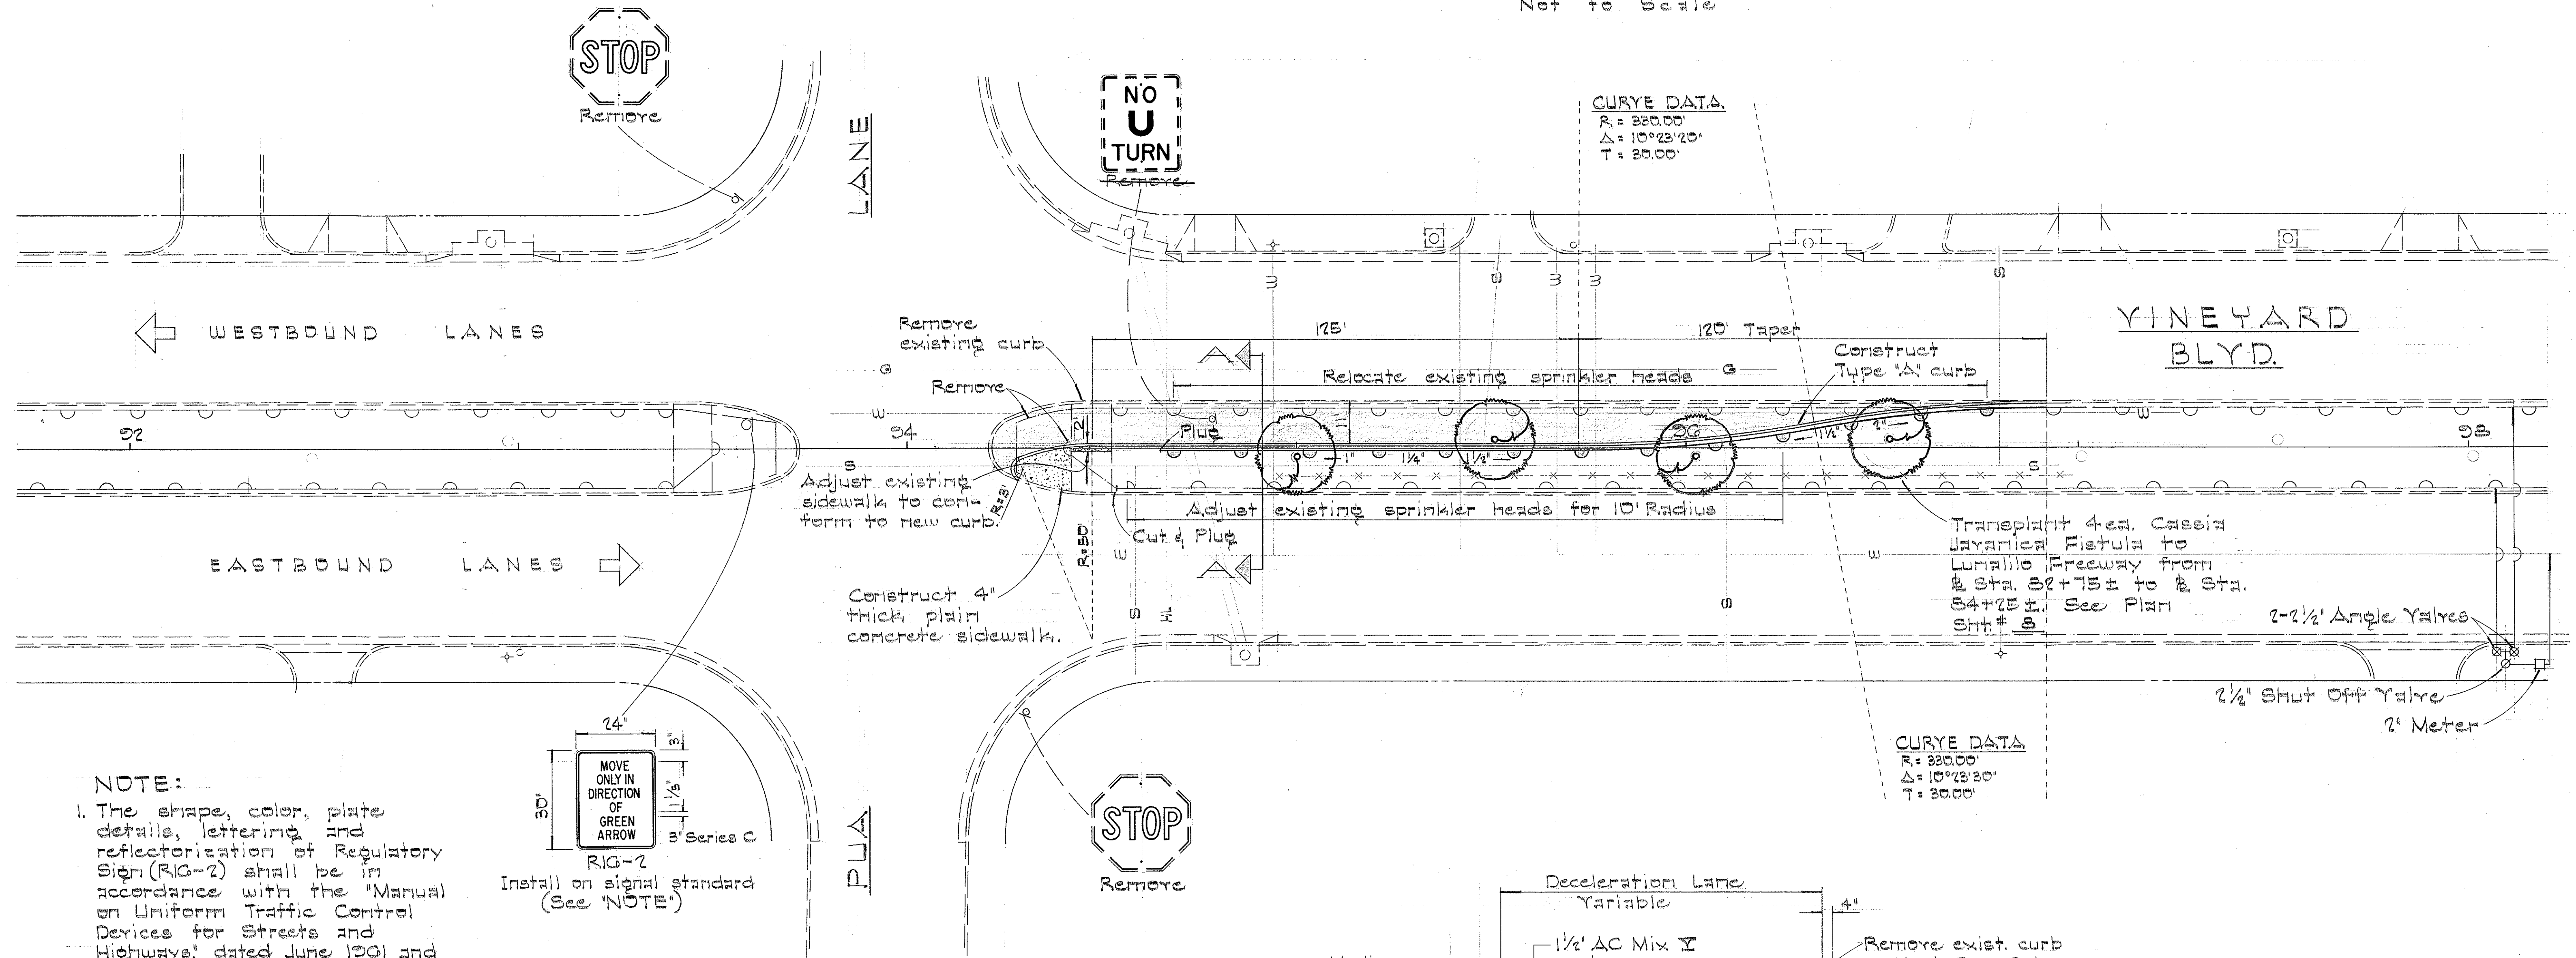

NOTE:

- The shape, color, plate details, lettering and reflectorization of Regulatory Sign (RIG-2) shall be in accordance with the "Manual on Uniform Traffic Control Devices for Streets and Highways," dated June 1961 and the BPR manual "Standard Highway Signs," dated Sept. 1961 unless otherwise specified.
- Regulatory Sign (RIG-2) shall be reflectorized and shall have 3/8" bolt holes drilled at appropriate locations unless otherwise specified.

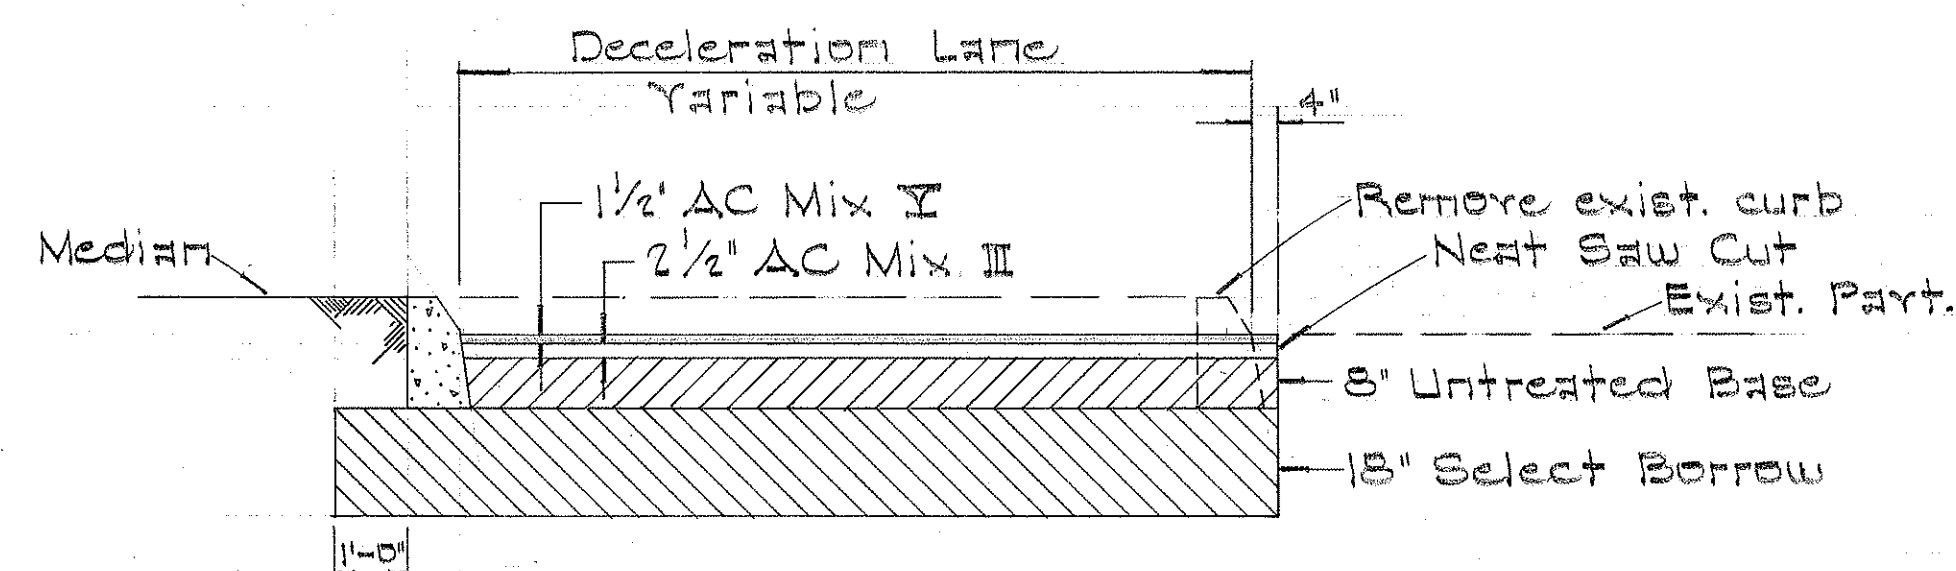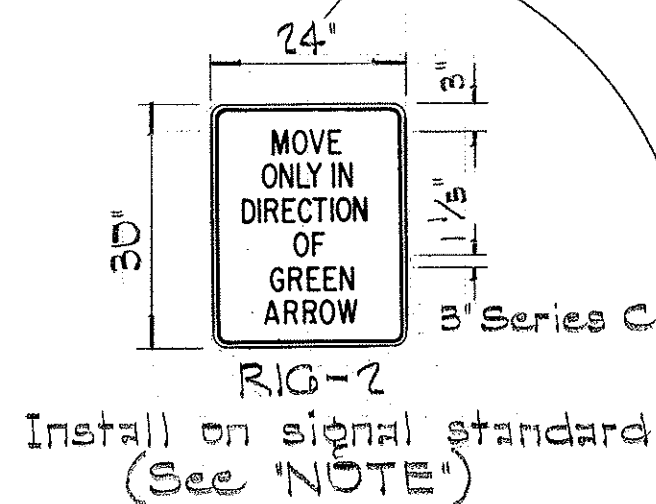

STATE OF HAWAII
DEPARTMENT OF TRANSPORTATION
HIGHWAYS DIVISION
DECELERATION LANE
VINEYARD BOULEVARD
AT
PUA LANE

Project No. F-098-1(7)
Scale: As Shown April 1967
SHEET No. 2 OF 8 SHEETS

DATE
DESIGNED BY
CHECKED BY
NOTED BY
ORIGINAL PLAN
NOTE BOOK
No.