


FED. ROAD DIST. NO.	STATE	FED. AID PROJ. NO.	FISCAL YEAR	SHEET NO.	TOTAL SHEETS
HAWAII	HAW.	F-098-1(7)	1967	8	8

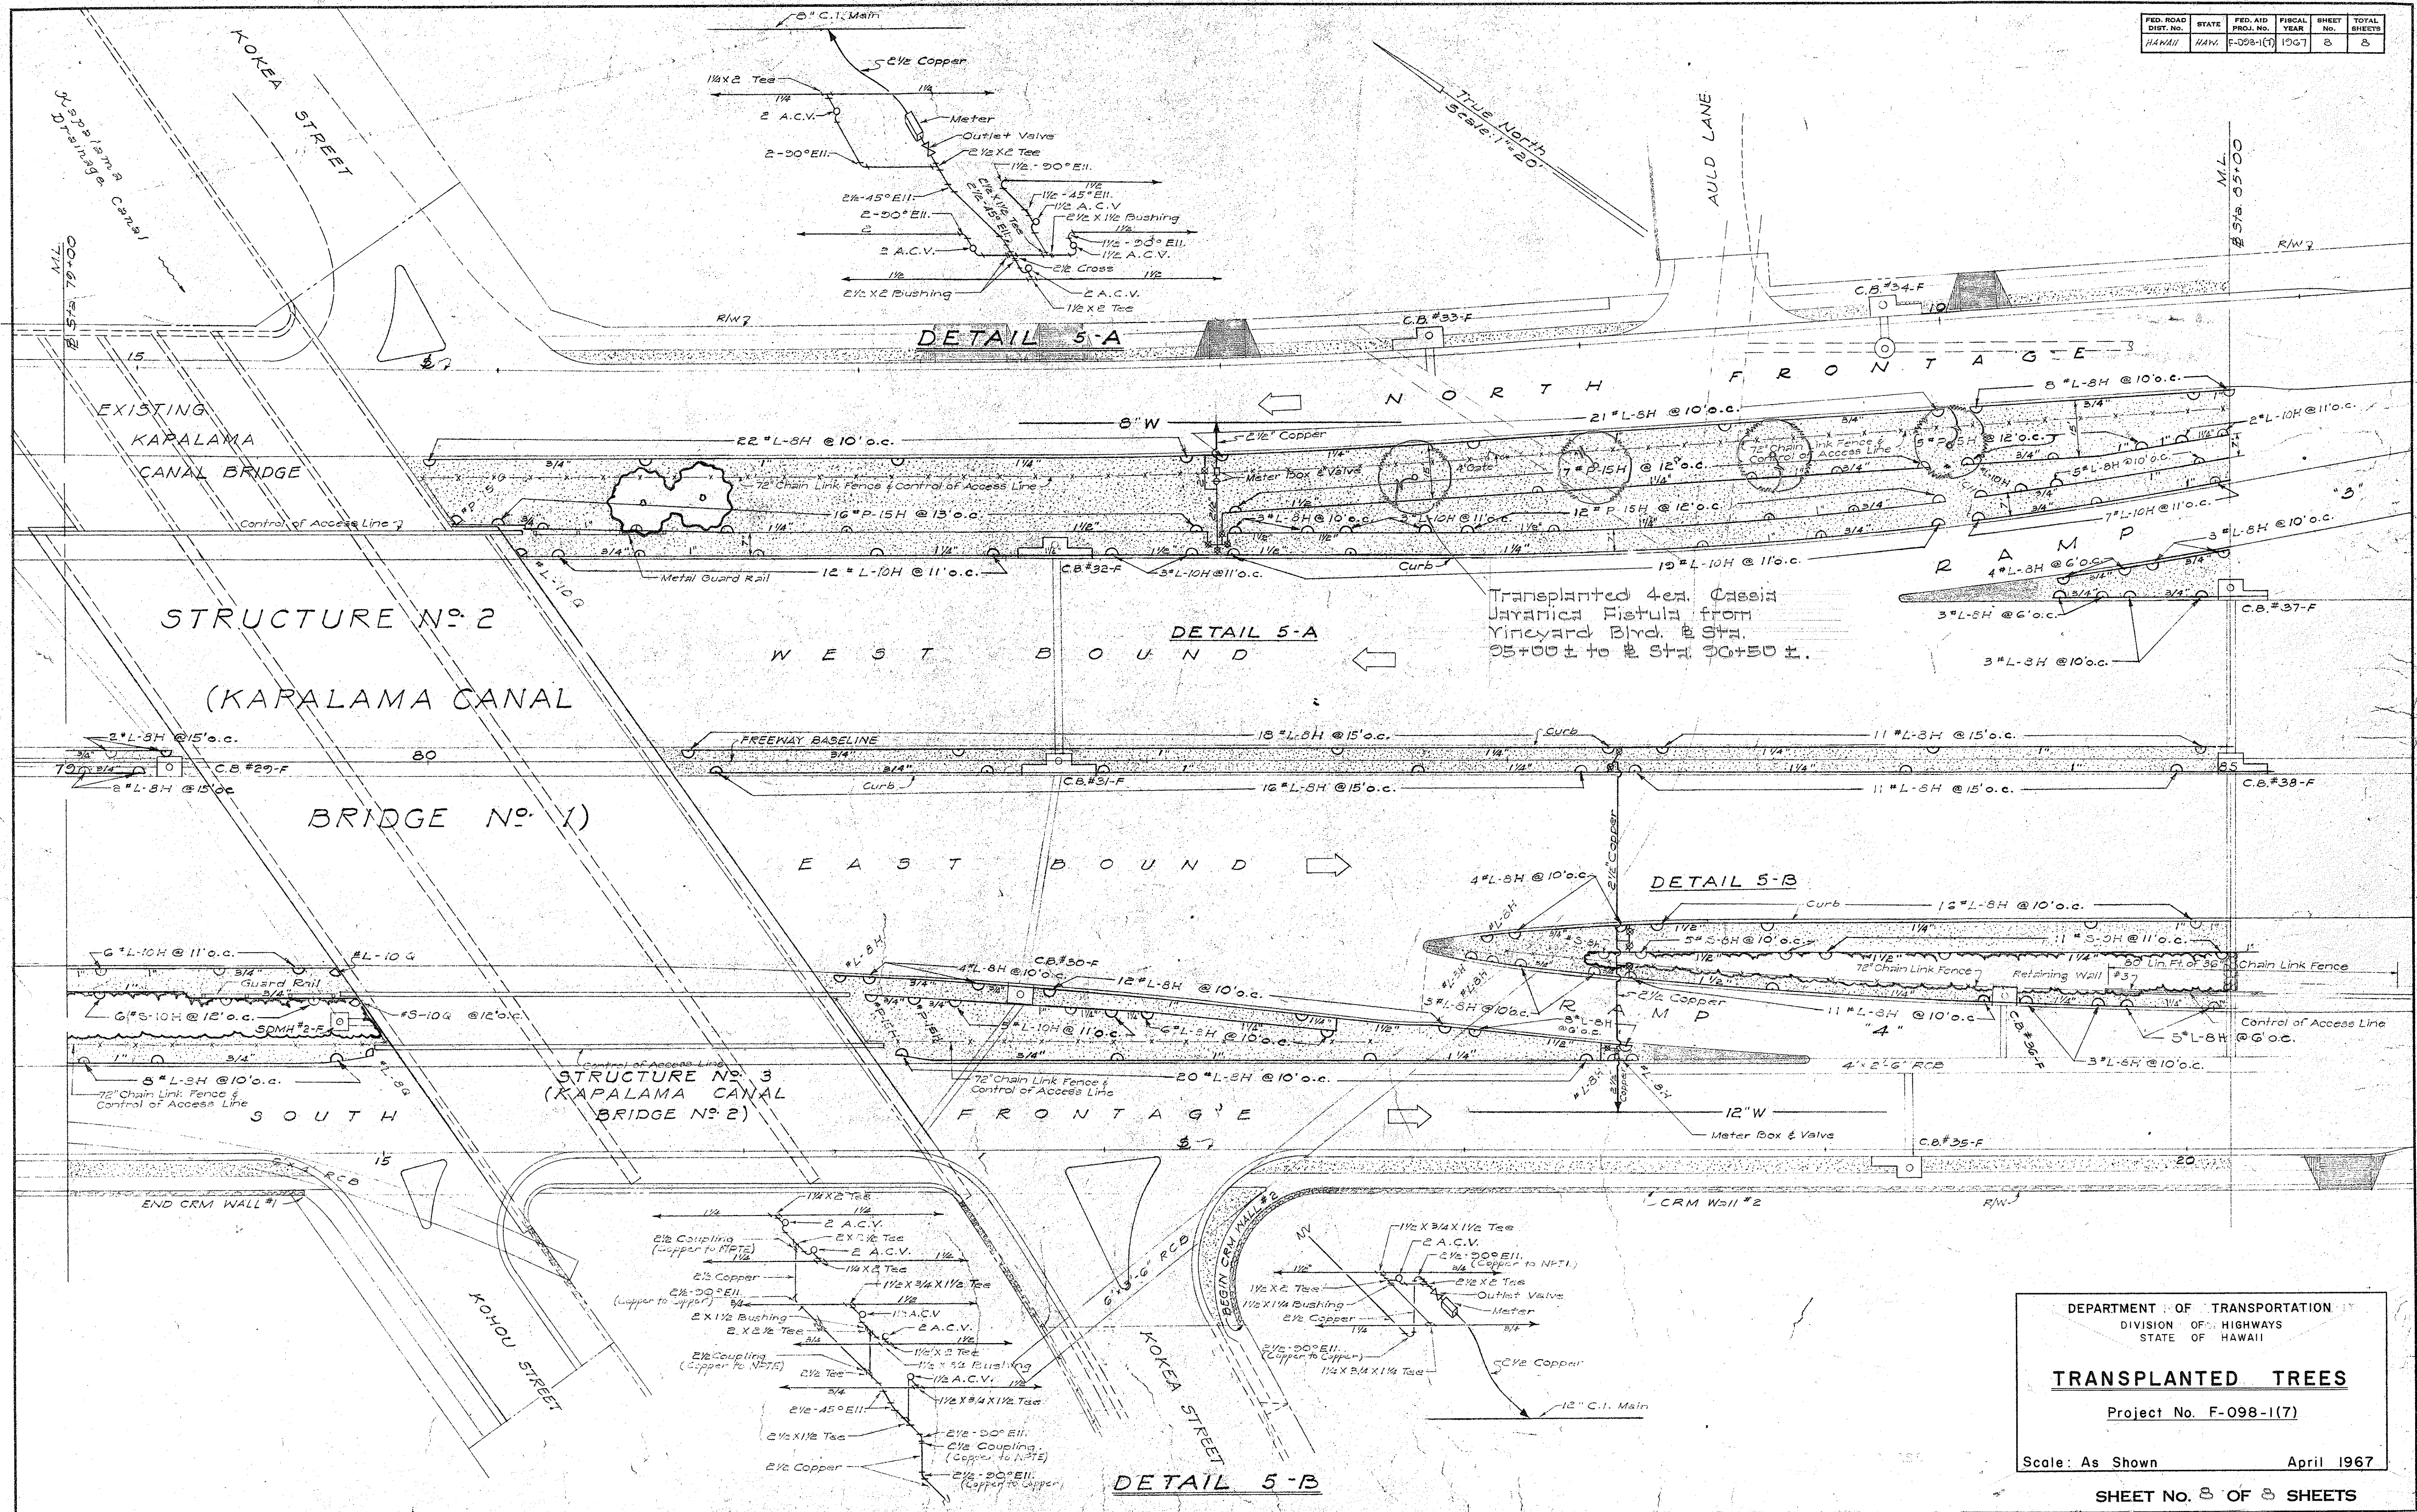

SURVEY PLOTTED BY:
 DESIGNED BY:
 DRAWN BY:
 CHECKED BY:
 ORIGINAL PLAN NO.
 NOTE BOOK NO.

DEPARTMENT OF TRANSPORTATION
 DIVISION OF HIGHWAYS
 STATE OF HAWAII

TRANSPLANTED TREES
 Project No. F-098-1(7)

Scale: As Shown April 1967

SHEET No. 8 OF 8 SHEETS