INDEX TO DRAWINGS	
SHEET NO.	DESCRIPTION
	TITLE SHEET AND LAYOUT PLAN
2	TYPICAL SECTION
3	PLAN
4-5	RAISED PAVEMENT MARKERS
	*

D-5-8

STATE OF HAWAII

DEPARTMENT OF TRANSPORTATION

HIGHWAYS DIVISION


HONOLULU, HAWAII

"AS BUILT" PLANS FOR

RESURFACING A PORTION OF VINEYARD BOULEVARD


PALAMA STREET TO MILLER STREET PROJECT NO. 98A-01-69

DISTRICT OF HONOLULU ISLAND OF OAHU

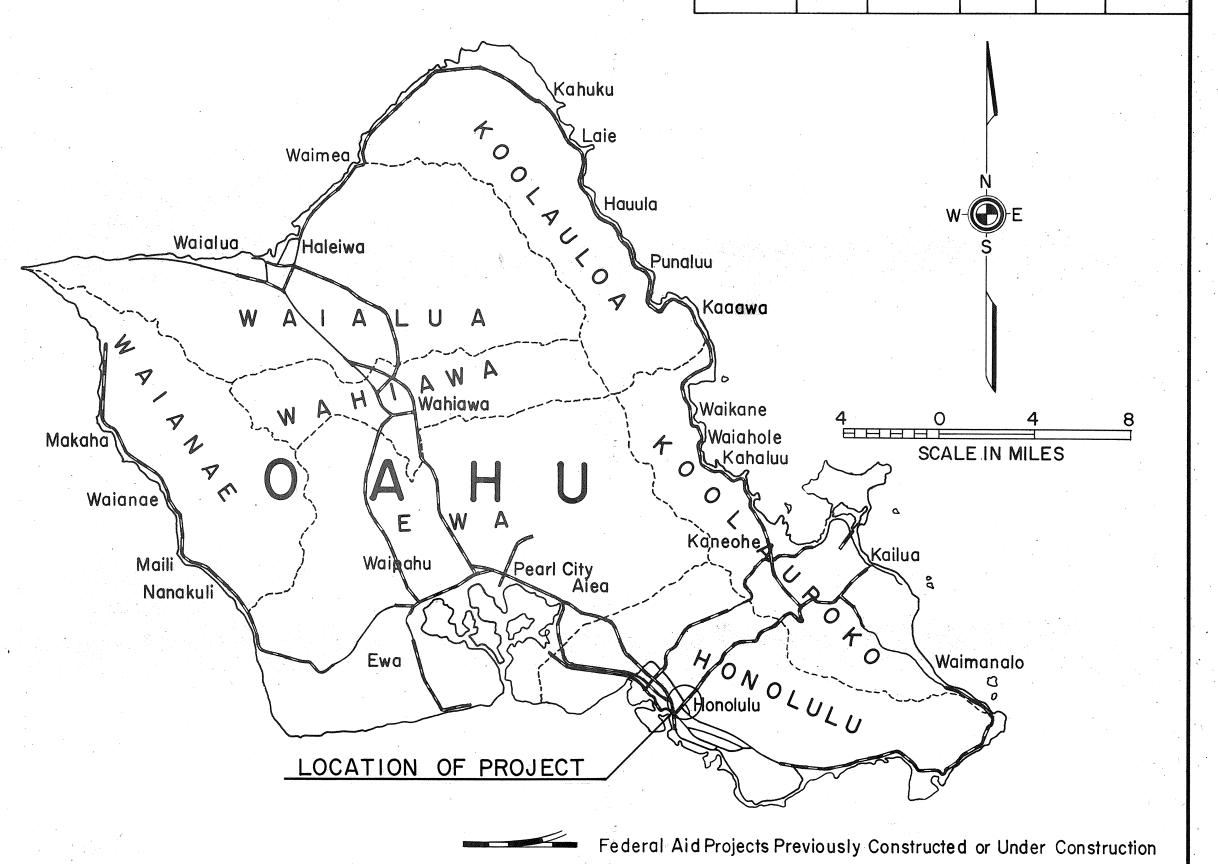

NOTE:

ALL CHANGES MADE DURING CONSTRUCTION HAVE BEEN NOTED IN RED ON THESE TRACINGS AND CHECKED BY:

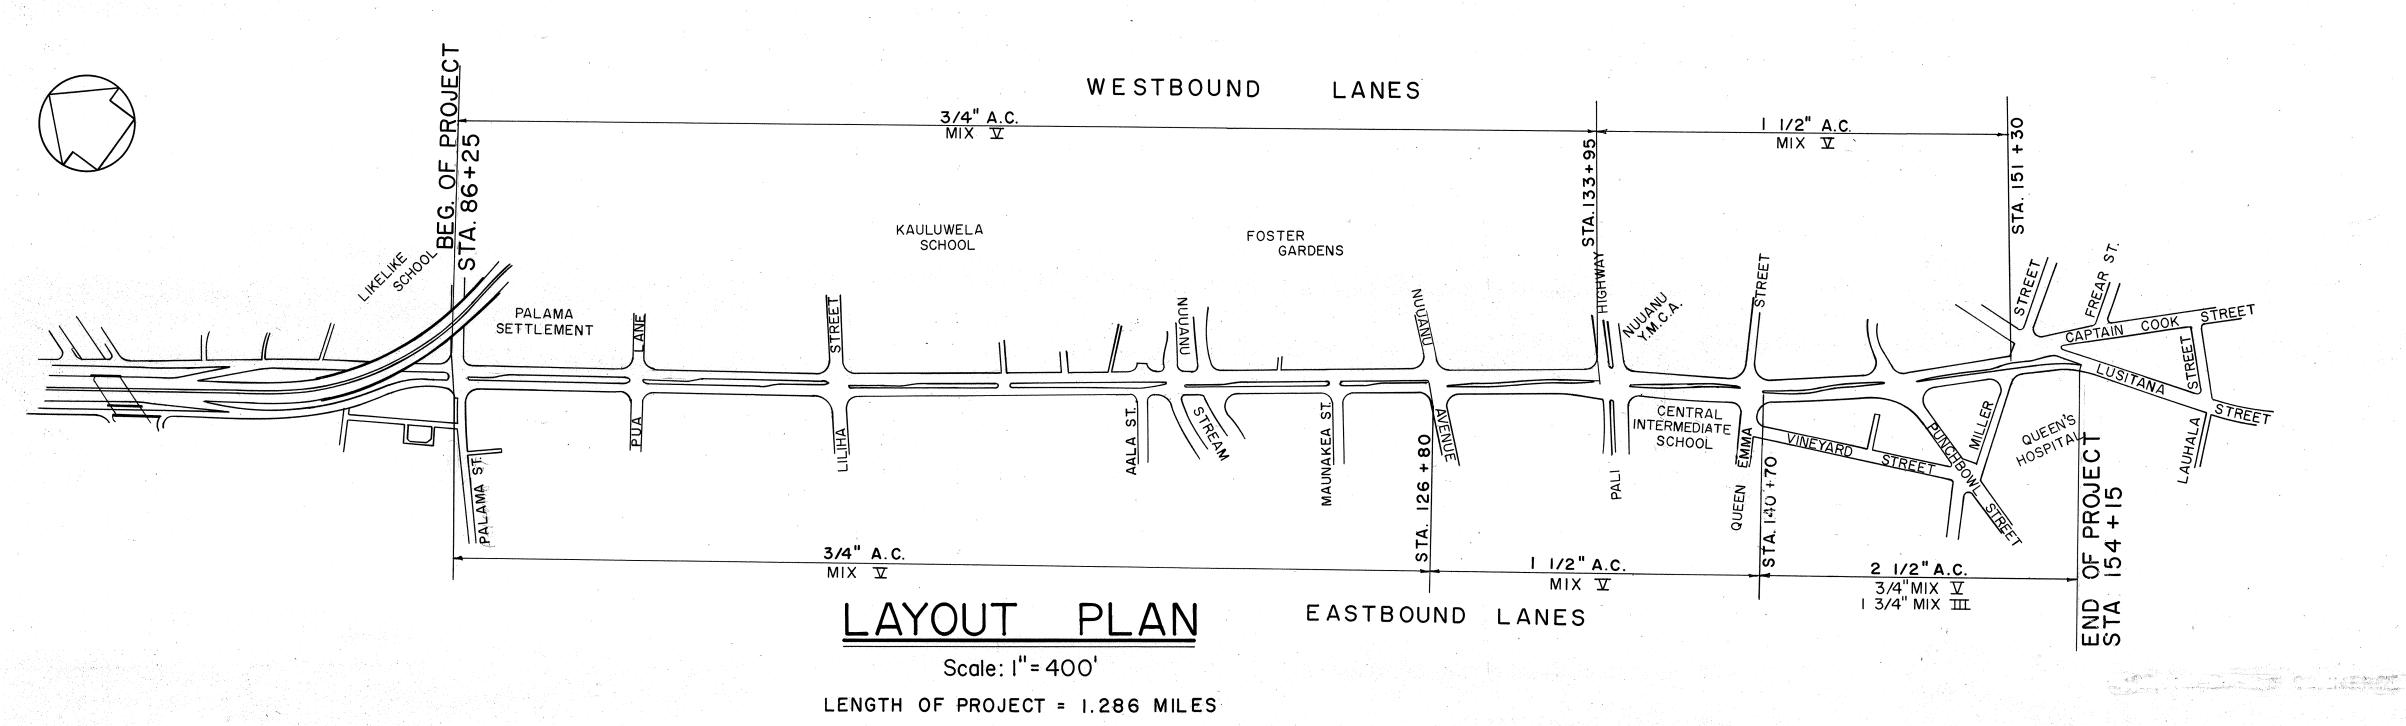

PROJECT ENGINEER

7/19/71

DATE

FED. ROAD STATE PROJ. NO. FISCAL SPROJ. NO. YEAR

HAW. 98A-01-69 1968

DEPARTMENT OF TRANSPORTATION STATE OF HAWAII

6. alvey Verighte for DIR. OF TRANSPORTATION

8/29/68 DATE

9