


FED. ROAD DIST. NO.	STATE	PROJ. NO.	FISCAL YEAR	SHEET NO.	TOTAL SHEETS
HAWAII	HAW.	98A-01-69	1968	2	5


GENERAL NOTES

1. Pot holes, cracks, and crevices, in the existing pavement, shall be cleaned, and paved with asphalt concrete pavement, Mix No. V, as ordered by the Project Engineer. No compensation will be made to the Contractor for this work, other than the actual quantity of the material incorporated into the work, and for which an item is listed in the Proposal.
2. Provide smooth transition between varying thickness of resurfaced pavement, and at connections, at the beginning, and end of project, and existing side streets (See Typical Section).
3. Medial openings shall be resurfaced to conform to new pavement thickness.
4. After paving, the Contractor shall locate all existing manholes, in the manner satisfactory to the Project Engineer. This work shall be considered as incidental to the item "Asphalt Concrete Pavement."

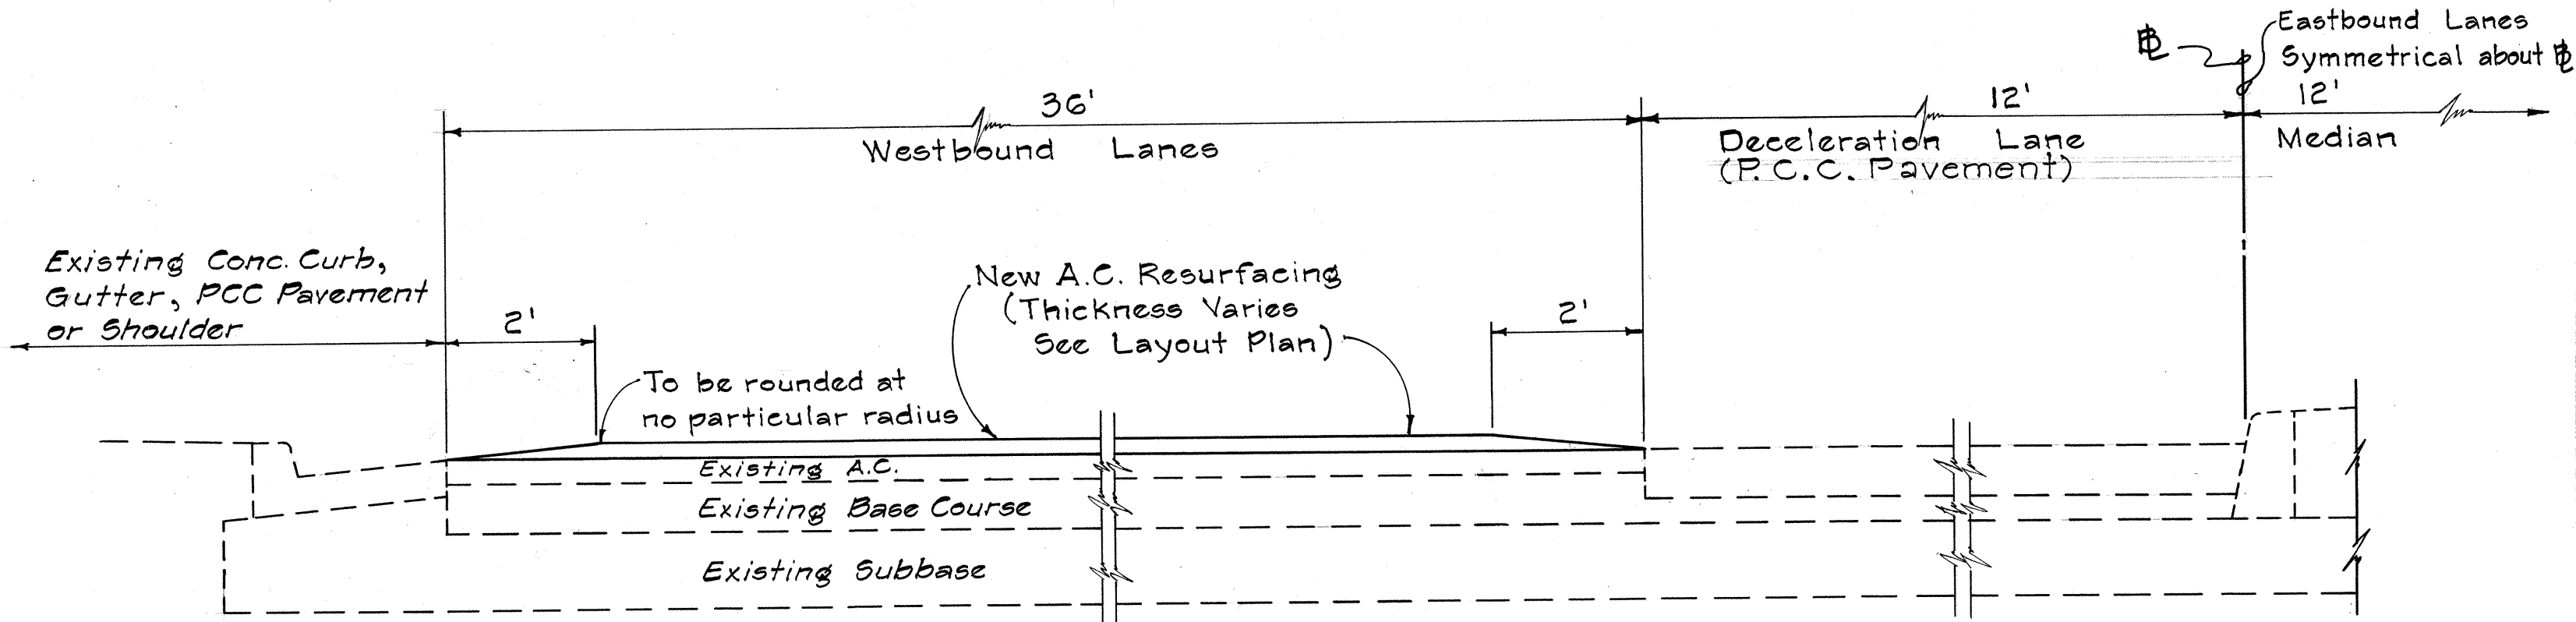


TYPICAL SECTION - RESURFACING

Scale: 1/2" = 1'-0"

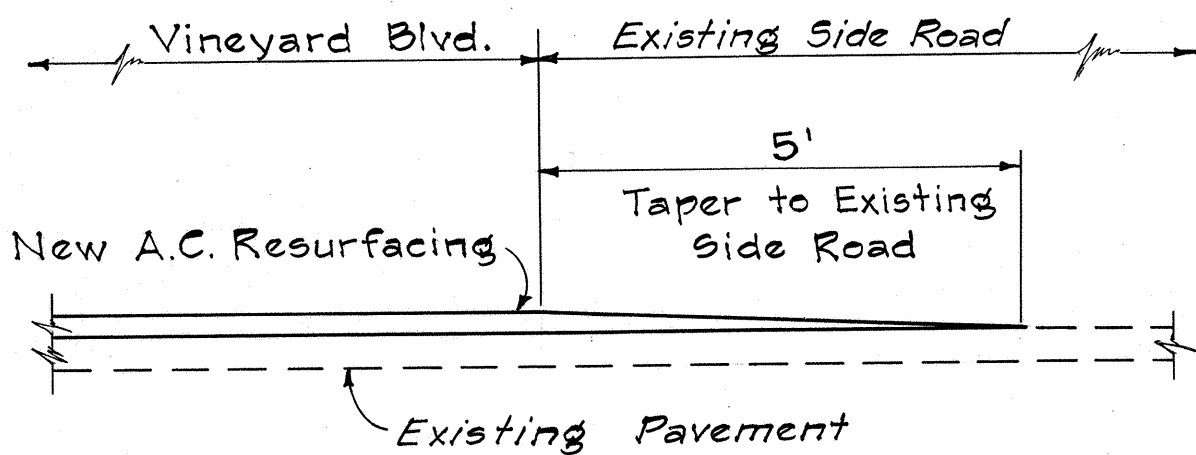

TYPICAL SECTION - SIDE ROAD CONNECTION

Scale: 1/2" = 1'-0"

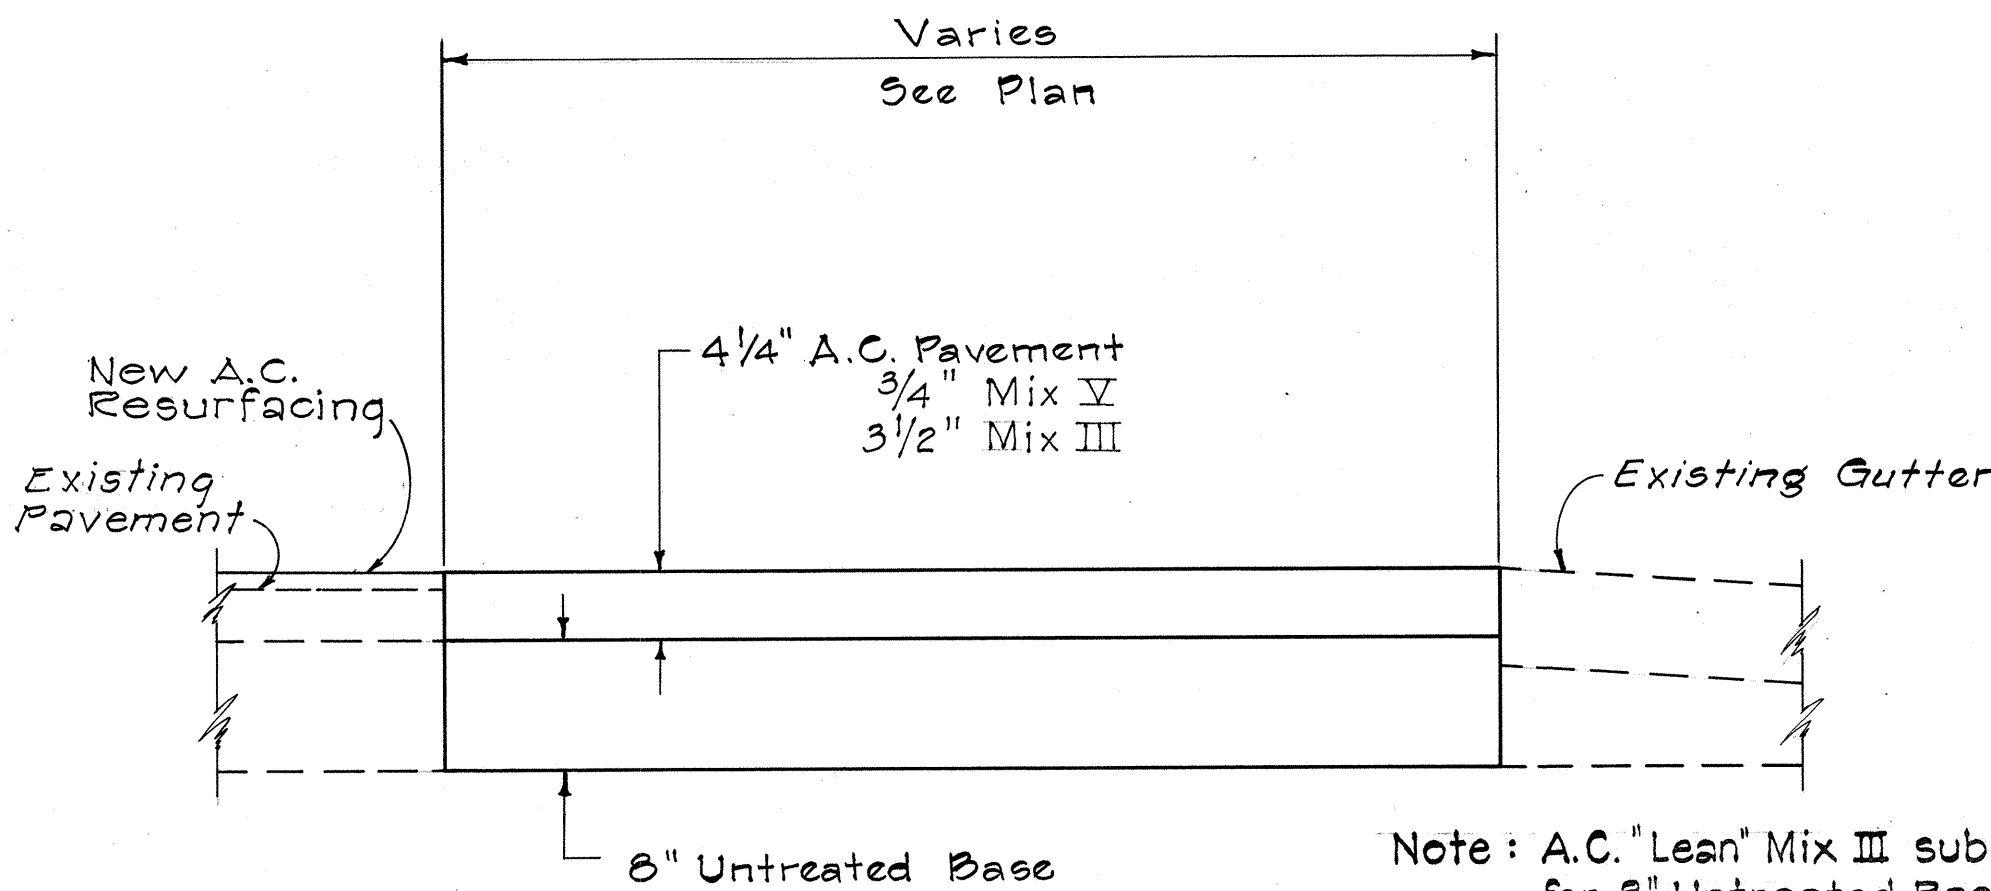

TYPICAL SECTION - RECONSTRUCTION

Scale: 1" = 1'-0"

STATE OF HAWAII
DEPARTMENT OF TRANSPORTATION
HIGHWAYS DIVISION

TYPICAL SECTION

PROJECT NO. 98A-01-69

Scale: As Shown Date: August 1968

SHEET No. 1 OF 1 SHEETS

ORIGINAL PLAN	DATE
DESIGNED BY	"
TRACED BY	"
NOTE BOOK	"
QUANTITIES BY	"
CHECKED BY	"
NO.	"