INDEX TO DRAWINGS	
SHEET NO.	DESCRIPTION
	TITLE SHEET
2	PLAN
3	MISCELLANEOUS DETAILS
4-6	STANDARD DETAILS
,	

LEGEND

----G2"- EXISTING GAS LINE (2")

EXISTING POWER POLE (# 23) WITH STREET

EXISTING UNDERGROUND TELEPHONE LINE

EXISTING DRAIN LINE (24") AND MANHOLE

EXISTING UNDERGROUND ELECTRIC LINE

-S8"---- EXISTING SEWER LINE (8") AND MANHOLE

NEW TRAFFIC MARKINGS

WITH NEW CONDUIT ( 1-2")

CONDUIT (2-2")

ARROW AS SHOWN.

EXISTING TRAFFIC SIGN AND POST

VEHICULAR SIGNAL HEADS R-Y-G.

CONTROLLER, TYPE "G" CABINET, ACCESSORIES



STATE OF HAWAII

## DEPARTMENT OF TRANSPORTATION HIGHWAYS DIVISION

HONOLULU, HAWAII


"AS BUILT"


PLANS FOR

## THE INSTALLATION OF TRAFFIC SIGNALS ON

## VINEYARD BOULEVARD AT AALA STREET

FEDERAL - AID TOPICS PROJECT NO. EHS -T- 9001(10) DISTRICT OF HONOLULU ISLAND OF OAHU

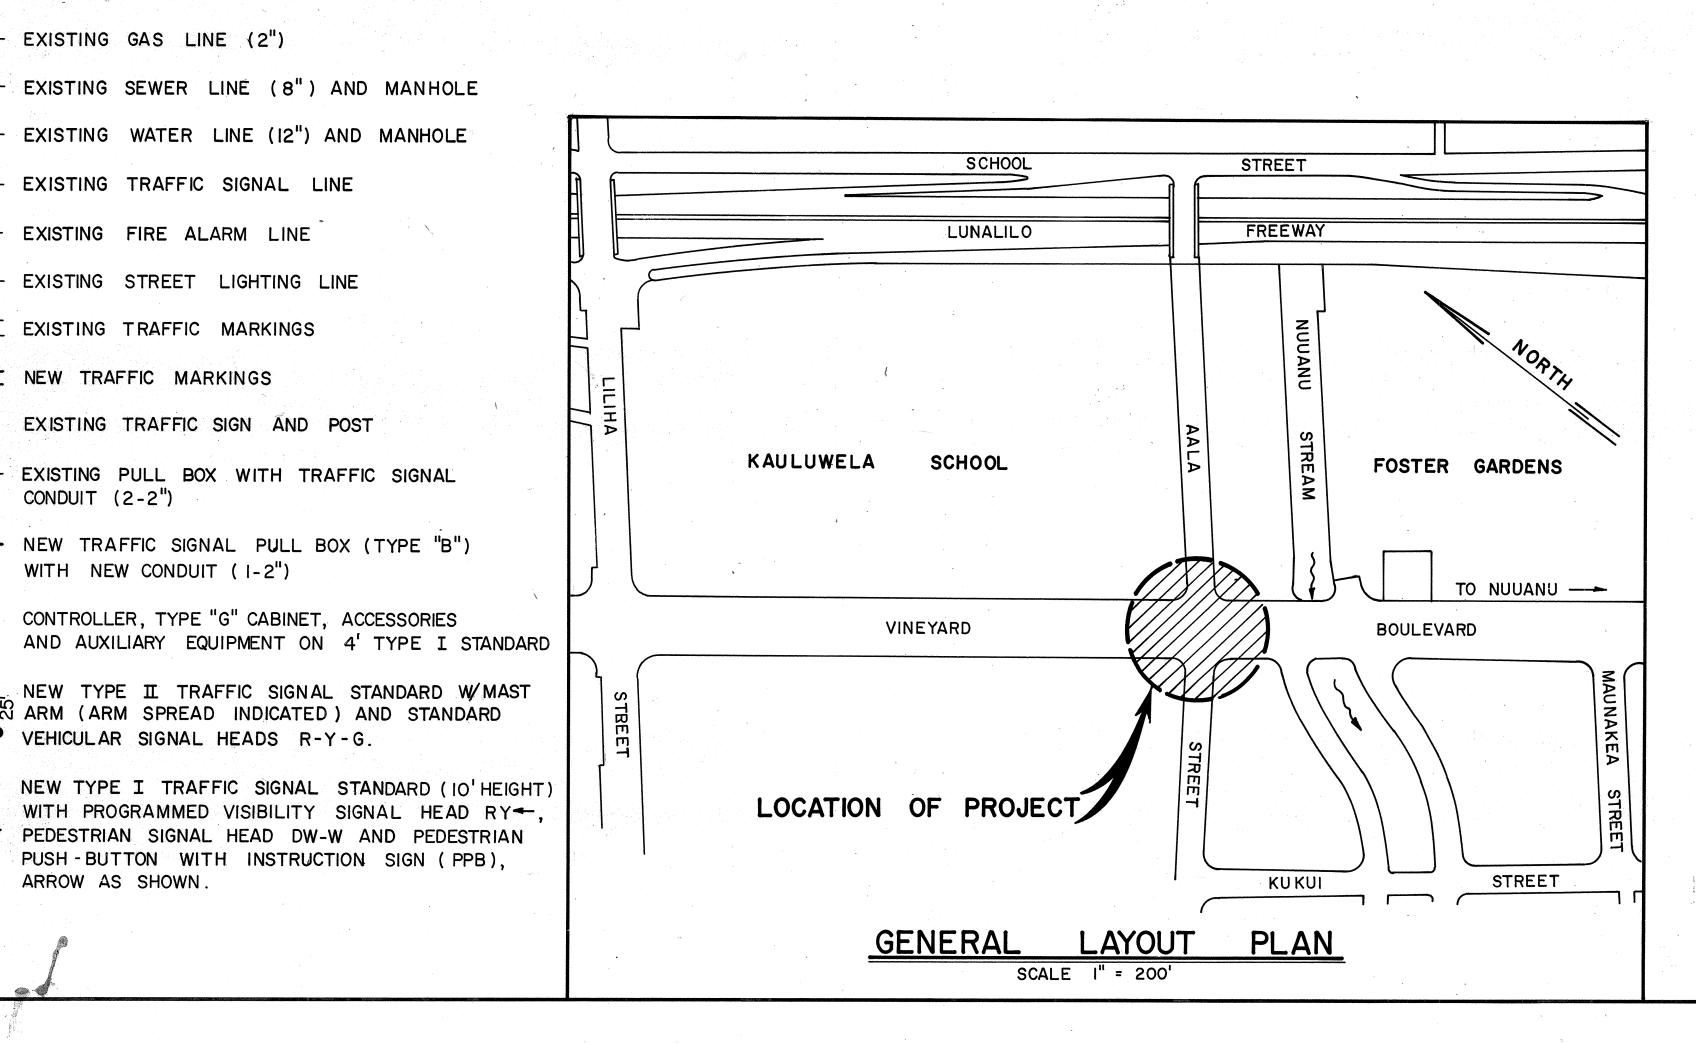

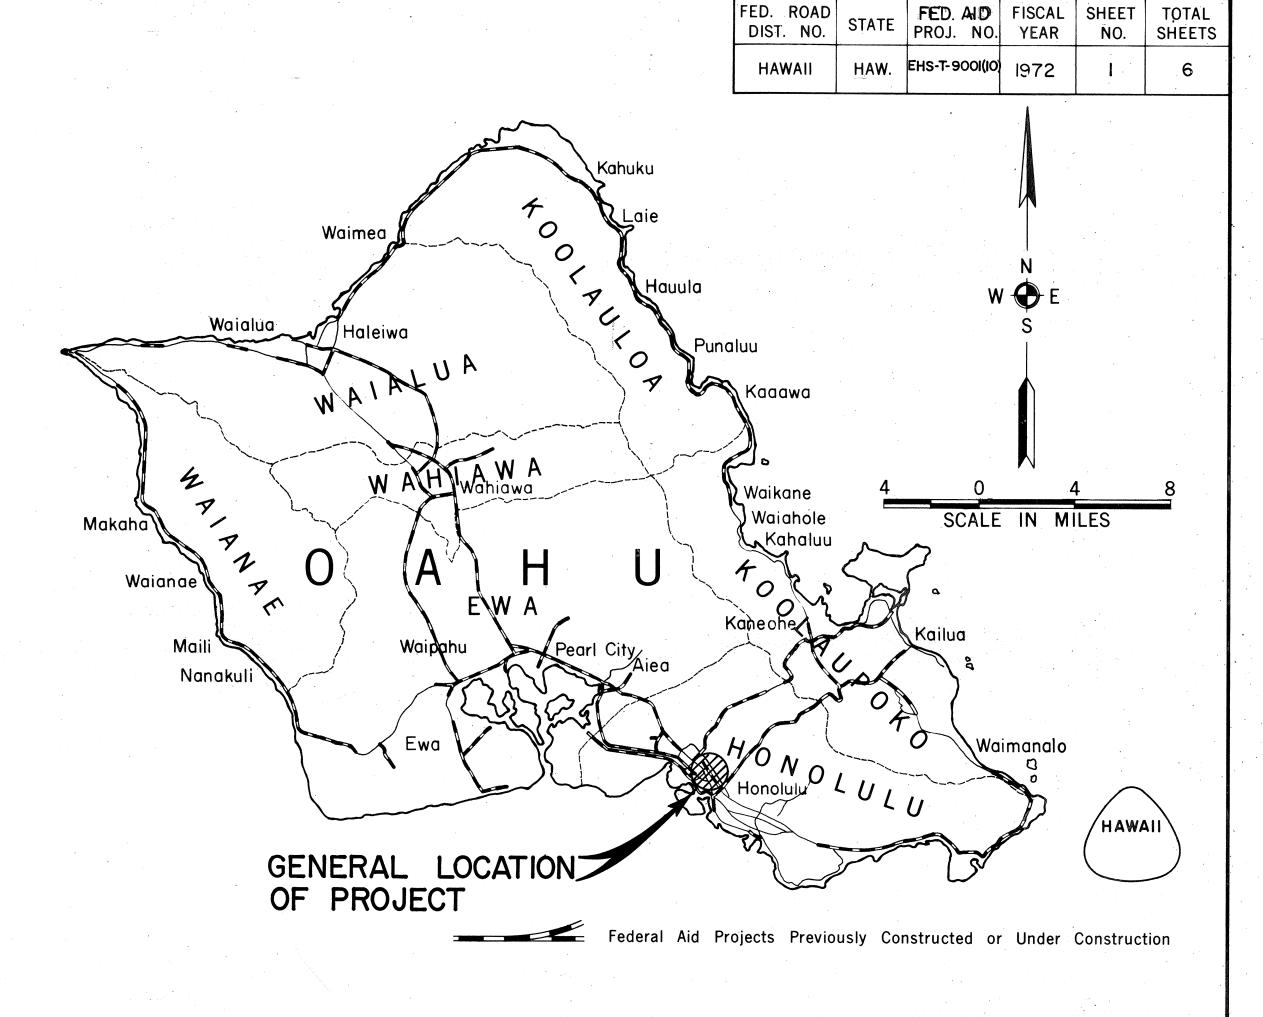

## NOTE:

ALL CHANGES MADE DURING CONSTRUCTION HAVE BEEN NOTED IN RED ON THESE TRACINGS AND CHECKED BY:

Rolph T. House PROJECT ENGINEER



THIS WORK WAS PREPARED BY

DEPARTMENT OF TRANSPORTATION FEDERAL HIGHWAXY ADMINISTRATION APPROVED: 6-29-72 DIVISION ENGINEER DATE

DEPARTMENT OF TRANSPORTATION STATE OF HAWAII APPROVED: FOR DIR. OF TRANSPORTATION

-WP"- EXISTING WATER LINE (12") AND MANHOLE ----I-2"--- EXISTING TRAFFIC SIGNAL LINE FA EXISTING FIRE ALARM LINE -SL- EXISTING STREET LIGHTING LINE ZZZZZ EXISTING TRAFFIC MARKINGS -B-I-2"- NEW TRAFFIC SIGNAL PULL BOX (TYPE "B")

 $\sqrt{S \times Z}$