HECO NOTES

- The Contractor shall exercise extreme caution when the excavation & construction crosses or is in close proximity of underground electrical facilities & maintain adequate clearance for his equipment while working close to and/or under the overhead facilities.
- 2. The Contractor shall obtain an excavation permit from HECO Mapping & Record Division, 4th floor, 820 Ward Ave. two weeks prior to start of construction.
- 3. Should it become necessary, any work required to relocate HECO facilities shall be done by HECo & cost shared by the State and HECo per Hawaii Revised Statutes 264-33. The State shall be responsible for all coordination
- 4. When trench excavation is adjacent to or under existing structures or facilities, the Contractor shall be responsible for properly sheeting & bracing the excavation & stabilizing the existing ground to render it safe & secure from possible slides. cave-ins & settlement and for properly supporting existing structures & facilities with beams, struts or underpinning to fully protect it from damage.
- 5. The existing HECo facilities shown on the plans are approximate only. For verifying the location of underground duct lines & for assistance in providing proper support & protection of the underground duct lines, the Contractor shall contact HECo Underground Division at 548-7395 a minimum of 72 hours in advance.
- 6. Any damage caused to HECo facilities shall be repaired by HECo with payment for this work to be borne by the Contractor.

BWS NOTES

- Unless otherwise specified, all materials & construction of water system facilities & appurtenances shall be in accordance with the "Standard Specifications For Road And Bridge Construction," dated 1976, as amended, of the Hawaii Highways Division, Department of Transportation.
- 2. Prior to excavating for new drain, sewer, and other utility lines, the Contractor shall verify in the field the location of existing water mains and appurtenances. Where the installation of new drain, sewer, or other utility lines are to cross over or under existing water mains, the Contractor shall expose the existing water mains prior to trenching. Excavation around water mains shall be done by hand
- 3. The minimum clearance between fire hydrants & utility poles or light standards shall be 3.0 ft. 4. The Contractor shall notify the Board of Water Supply in writing one week prior to commencing work on the water system.
- 5. The existence & location of underground utilities & structures as shown on the plans are from the latest available data but is not quaranteed as to the accuracy or the encountering of other obstacles during the course of the work. The Contractor shall be responsible and shall pay for all damages to existing utilities.
- 6. Any adjustments to the existing water system required during construction to meet requirements of BWS Standards, whether shown on the plans or not, shall be done by the Contractor at no cost to the Board.

LEGEND

M	New Traffic Signal Master Controller
C	New Traffic Signal Controller
\boxtimes	New Type "A" Pullbox
	New Type "B" Pullbox
\triangle	New Traffic Signal Conduits & Cables
$\longrightarrow \hspace{0.2in} \triangleright$	New I?" Traffic Signal Head
$\longrightarrow \downarrow$	New 12" Traffic Signal Head (Programmed Visibility)
	New Pedestrian Signal Head
4 = →	New Type II Traffic Signal Standard (Mast Arm Length & Signal Head spacing as specified). Signal Heads as specified.
	New Type I Traffic Signal Standard. Signal Heads as specified.
	New Loop Detector
þ .	New Regulatory, Warning or Guide Sign
þ	Existing Regulatory, Warning or Guide Sign
· • □	Existing Pavement Markers
~	New Pavement Line
	Existing Pavement Line
<i>W</i> 8	Existing Water Line & Size
5 ₈	Existing Sewer Line & Size

Existing Underground Electrical Conduit & Energized High Voltage Cables

Existing Drain Line & Size

Existing Underground Telephone Conduit

Existing Overhead Electrical Power Line

Existing Gas Line & Size

GENERAL NOTES

- All construction work shall be done in accordance with these plans, all applicable sections of the Standard Specifications for Road and Bridge Construction, dated 1985, as amended, of the State Highways Division, Dept. of Transportation & the project's Special Provisions, unless otherwise specified
- 2. All lanes shall be opened to traffic during the morning peak hours from 6:00 am. to 8:30 a.m. and during the afternoon peak hours from 3:00 p.m. to 5:30 p.m. and during off-work hours
- 3. The Contractor shall provide, install & maintain all necessary signs, lights, flares, barricades, markers, cones & other protective facilities and shall take all neces sary precautions for the protection & for the convenience & safety of public traffic. All such protective facilities & precautions to be taken shall conform with the "Rules and Regulations Governing the Use of Traffic Control Devices at Work Sites on or Adjacent to Public Streets and Highways" adopted by the Highway Safety Coordinator & the U.S. Federal Highway Administration's "Manual on Uniform Traffic Control Devices for Streets and Highways, Part W-Traffic Controls for Highway Construction and Maintenance Operations", dated 1978.
- 4. Full compensation for all additional materials & labor, not specifically shown or called for which are necessary to complete the construction of the project, shall be considered incidental to the various contract items in the proposal's no additional compensation will be allowed therefor
- 5. The Contractor shall remove all silt & debris resulting from his work and deposited in drainage facilities, roadways & other areas. The costs incurred for any neces sary remedial action by the Chief Engineer shall be payable by the Contractor.
- 6. The Contractor, at his own expense, shall keep the project area and surrounding area free from dust nuisance. The work shall be in conformance with the Air Pollution Control Standards & Regulations of the State Department of Health.
- 7. All exposed areas shall be sodded or planted immediately after the grading work has been completed

HTCO NOTES

Existing telephone facilities shown on these plans are approximate only. The Contractor shall verify their actual locations, dimensions & details and shall make adjustments as directed by HTCo.

GAS NOTES (GASCO, INC.)

- The Gasco, Inc. gas pipe lines in the project area are plastic coated & cathodically protected. The Contractor shall be extremely careful when working near these gas pipe lines.
- 2. Contractor to contact Gasco, Inc., five (5) working days prior to any excavation, for written clearance (Ph. 547-3575)
- 3. The Contractor shall verify the exact locations & depths of existing gas lines prior to start of construction operations. The Contractor shall call Gasco, Inc. a minimum of 48 hours before starting excavation to arrange for field location of all existing gas pipe lines. The telephone number is 547-3575 during business hours & 547-3555 after hours.
- 4. The Contractor shall excavate & backfill around gas pipe lines in the presence of a Gasco, Inc. representative. All backfill within six inches of gas line shall be select crusher screening cushion material approved by Gasco, Inc.
- 5. The Contractor shall notify Gasco, Inc. immediately after any damage has been caused to existing gas pipe lines, their coatings of their cathodic protection devices. Repair work on this damage will be done by Gasco, Inc. with payment for this work to be borne by the Contractor.
- 6. Minimum vertical or horizontal clearance between gas pipe lines & other pipe lines, conduits or duct lines shall be 12 inches. Adequate support & protection for gas pipe lines exposed in the trench shall be provided. Such support & protection will be approved by Gasco, Inc. If this clearance cannot be attained, the gas line shall be protected with a Gasco, Inc. approved insulation material fur-hished & installed by the Contractor and the work must be approved by Gasco, Inc.
- 7. The Contractor shall work in an expeditious manner in order to keep uncovered gas pipe lines exposed for as short a period of time as possible.

Muland John

FO-CHIEF, PLANNING & ENGINEERING, BWS

DIRECTOR & CHIEF ENGINEER, DPW (APPROVED FOR CONSTRUCTION WIN CITY R/W ONLY)

Hypung

CHIEF, DIVISION OF ENGINEERING, DPW (APPROVED FOR CONSTRUCTION WIN CITY R/W ONLY)

APPROVED:

CONSTRUCTION NOTES

FED. ROAD DIST. NO.	STATE	PROJ. NO.	FISCAL YEAR	SHEET NO.	TOTAL SHEETS
HAWAII	HAW.	HEG-098-1(8)	1985	ه	**************************************

- 1. Locations of existing underground structures & utilities, such as pipelines, conduits, cables, etc. shown on plans are approximate only. It is not the intent of these plans to show the exact location of all underground utilities & structures. It is the responsibility of the Contractor to verify the locations of all existing utilities with the respective owners. Existing utilities damaged by the Contractor shall be repaired by the Contractor at his own cost
- 2. The locations of the traffic signal standards, traffic signal standards with mast-arm, pedestrian push buttons, traffic controller, pullboxes, conduits, barriers & loop detectors shall be staked out in the field by Contractor & approval of the locations obtained from the Engineer prior to construction & installation.
- 3. Department of Transportation Services, City & County of Honolulu will assist the Engineer in construction inspection for the traffic signal system.
- 4. Work by the Dept. of Transportation Services, C & C of Honolulu:
- a. Test controller & auxiliary equipment in cabinet.

 b. Make all electrical equipment connections in the field for signal system after the system has been installed in place by the Contractor.
- c. Final adjustment of traffic signal control equipment. 5. Removal of existing signs shall also include the removal of posts & foundations unless otherwise noted. All such materials shall be the property of the Contractor. Cost shall be incidental to other items of work
- 6. Locations of traffic markings & markers (lane lines, stop lines, pavement arrows, etc.) shown on the plans shall be verified by the Contractor with the Engineer prior to installation of the traffic signal system.
- 7. Removal of pavement markings & stripings shall be done by the Contractor.
- 8. A solid #8 bare copper wire shall be pulled with the traffic signal control cable for equipment ground. Cost shall be incidental to the installation of the control cable.
- 9. Stop signs indicated to be removed shall be removed after the traffic signal system is operational.
- 10. Restoration of existing pavements & improvements unavoidably damaged shall be incidental to the various contract items. Restoration shall be to original or better condition.
- 11. All traffic signal work shall conform to the requirements of the "Manual on Uniform Traffic Control Devices for Streets and Highways", Federal Highway Administration (1978) and amendments
- 12. Maintenance of traffic through the construction area shall be in accordance with Part VI of the "Manual on Uniform Traffic Control Devices for Streets and Highways," Federal Highway Administration (1978) and as specified in the special provisions. The Contractor shall furnish and maintain adequate barricades, blinkers, construction signs, etc. for the safety of the motoring public.

TRAFFIC SIGNAL NOTES

HZ1182

DATE


DATE

3-11-82 DATE 47

- . All traffic signal controller equipment shall be completely wired in the cabinet and shall control the traffic signals as called for in the plans.
- 2. The Contractor shall install each meter socket & 50 Amp. breaker on power pole as shown on the plans in accordance with HECo requirements. Meter shall be mounted between 5 and 7 above ground. Meter socket shall be 4-prong, complete with a manual circuit closing device.

NOTES FOR CONSTRUCTION WITHIN CITY RIGHT-OF-WAY

All construction work within the City Right-of-Way shall be performed in accordance with the "Standard Details for Public Works Construction", dated August 1976 as revised & the "Standard Specifications for Public Works Construction", dated May 1975 of the Department of Public Works, City & County of Honolulu and the Revised Ordinances of Honolulu, 1978.

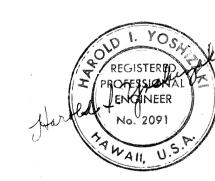

STATE OF HAWAII
DEPARTMENT OF TRANSPORTATION
HIGHWAYS DIVISION

TRAFFIC SIGNALS ON VINEYARD BOULEVARD AT MAUNAKEA STREET

NOTES & LEGEND

PROJECT NO. HEG-098-1(8) SCALE: AS SHOWN DATE: SEPT. 23, 1982

SHEET NO. / OF / SHEETS

