

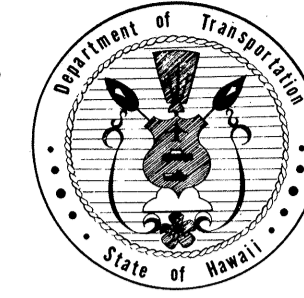


STANLEY S. SHIMABUKURO & ASSOC., INC. 1126 12TH AVENUE - HONOLULU, HI	FRED ABESHIWA	548 - 4042	FEB. 4, 1985
DESIGNED BY	P. S. & E. BY	PHONE	DATE

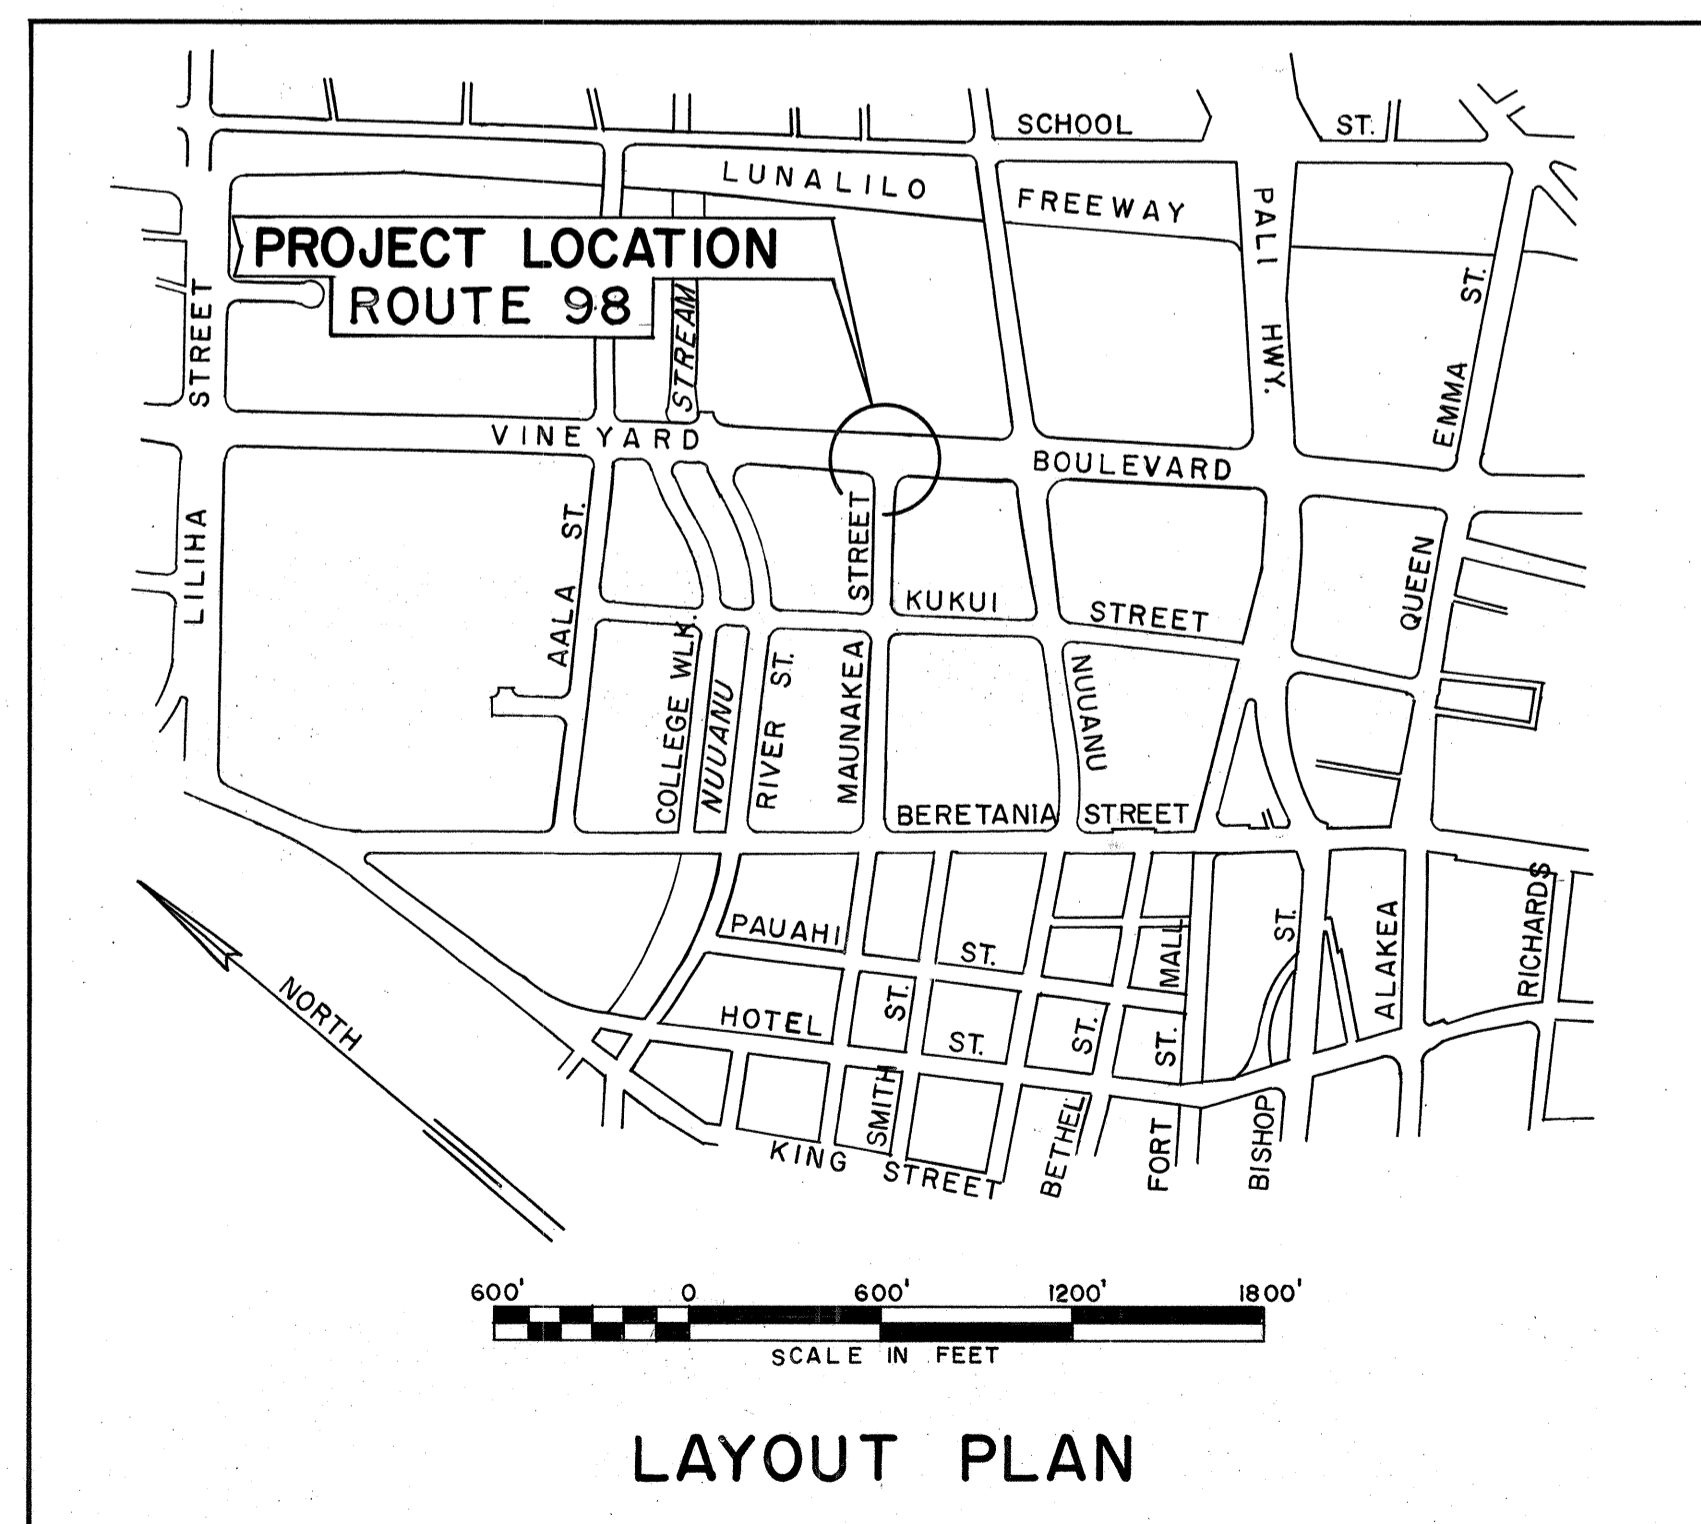

HONOLULU, HAWAII
"AS BUILT"
PLANS FOR


DISTRICT OF HONOLULU
ISLAND OF OAHU

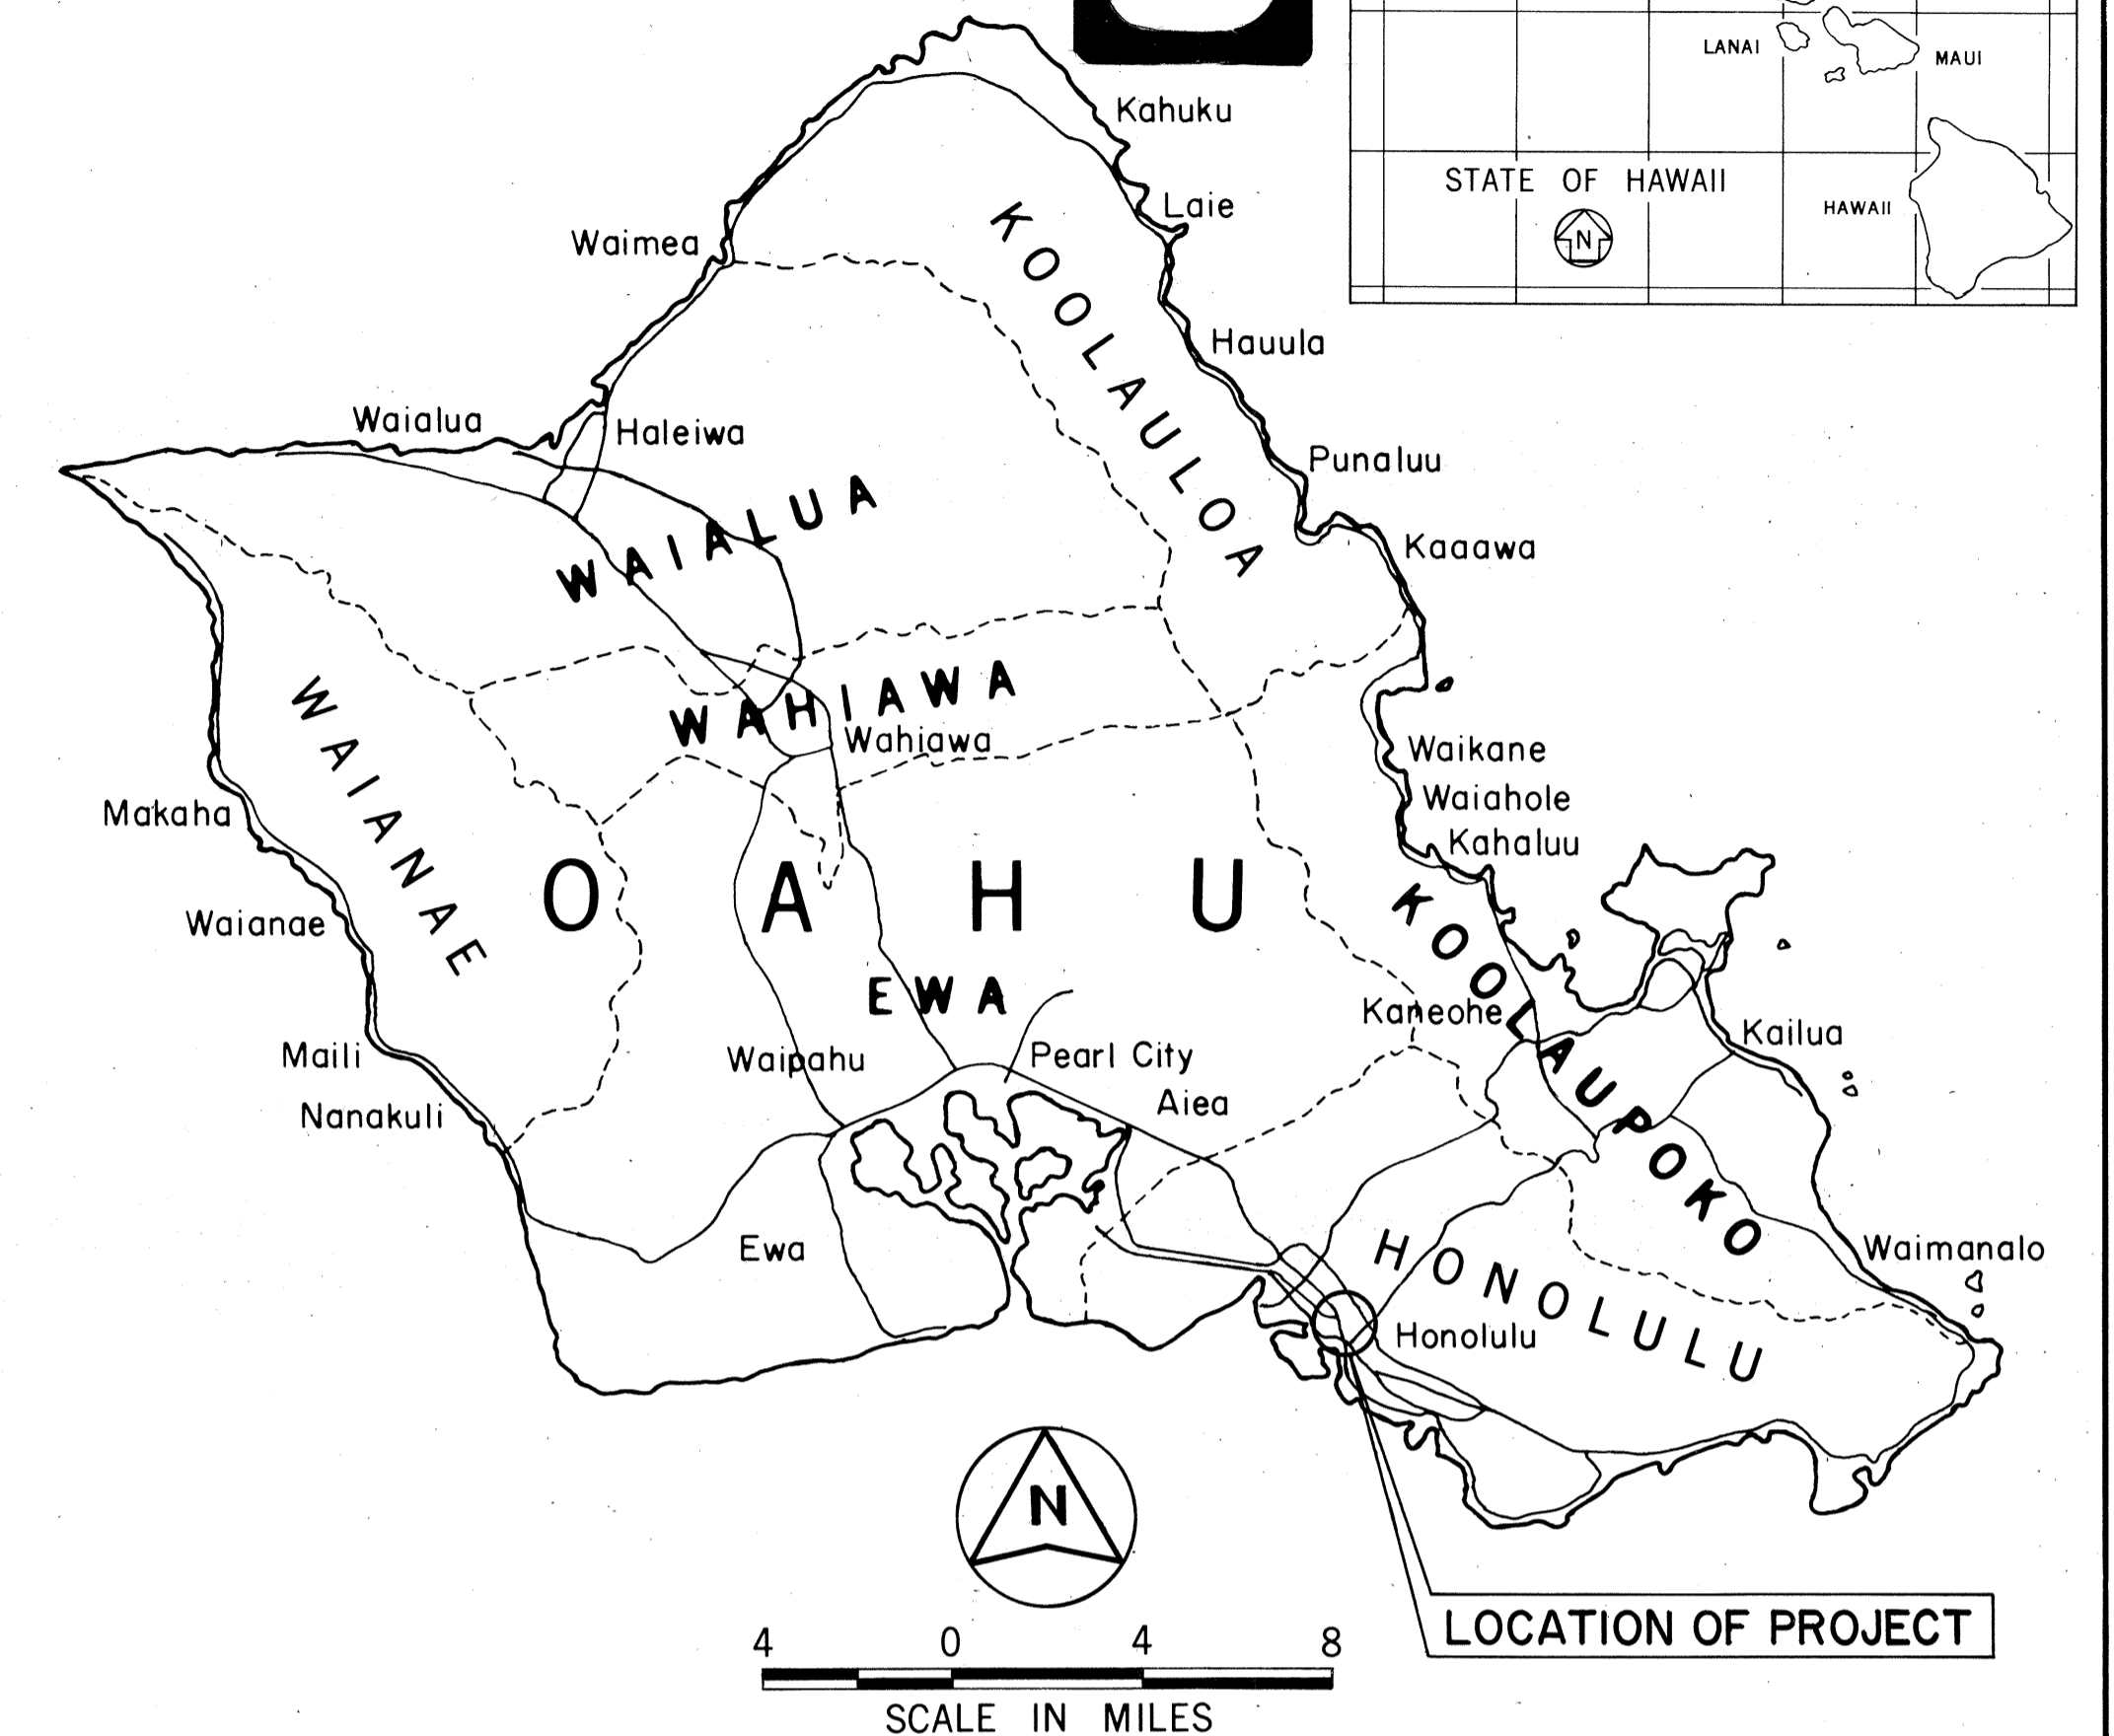

CHANGES MADE DURING CONSTRUCTION HAVE BEEN INCORPORATED ON THESE PLANS EXCEPT CHANGES IN THE ORIGINAL THEORETICAL QUANTITIES. FOR ACTUAL QUANTITIES, REFER TO PROJECT LEDGER AND/OR COMPUTATION BOOK.

Michael Duvigne
RESIDENT ENGINEER

11/24/86
DATE

DEPARTMENT OF TRANSPORTATION FEDERAL HIGHWAY ADMINISTRATION	
APPROVED:  <div style="display: flex; justify-content: space-between;"> <u>for</u> DIVISION ADMINISTRATOR 5/3/85 DATE </div>	

DEPARTMENT OF TRANSPORTATION STATE OF HAWAII	
APPROVED:	
<i>Charles D. Poore</i> DIR. OF TRANSPORTATION	3/25/85 DATE