

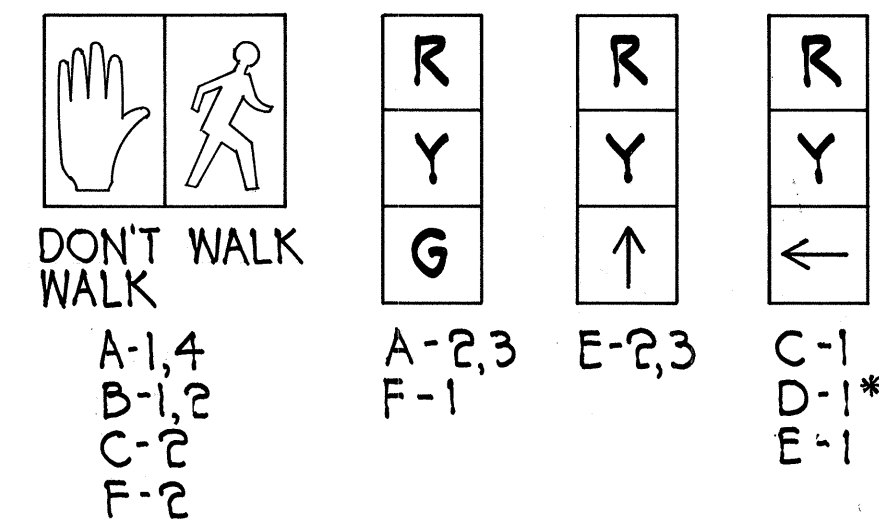


FED. ROAD DIST. NO.	STATE	PROJ. NO.	FISCAL YEAR	SHEET NO.	TOTAL SHEETS
HAWAII	HAW.	HES-098-1(8)	1985	3	17

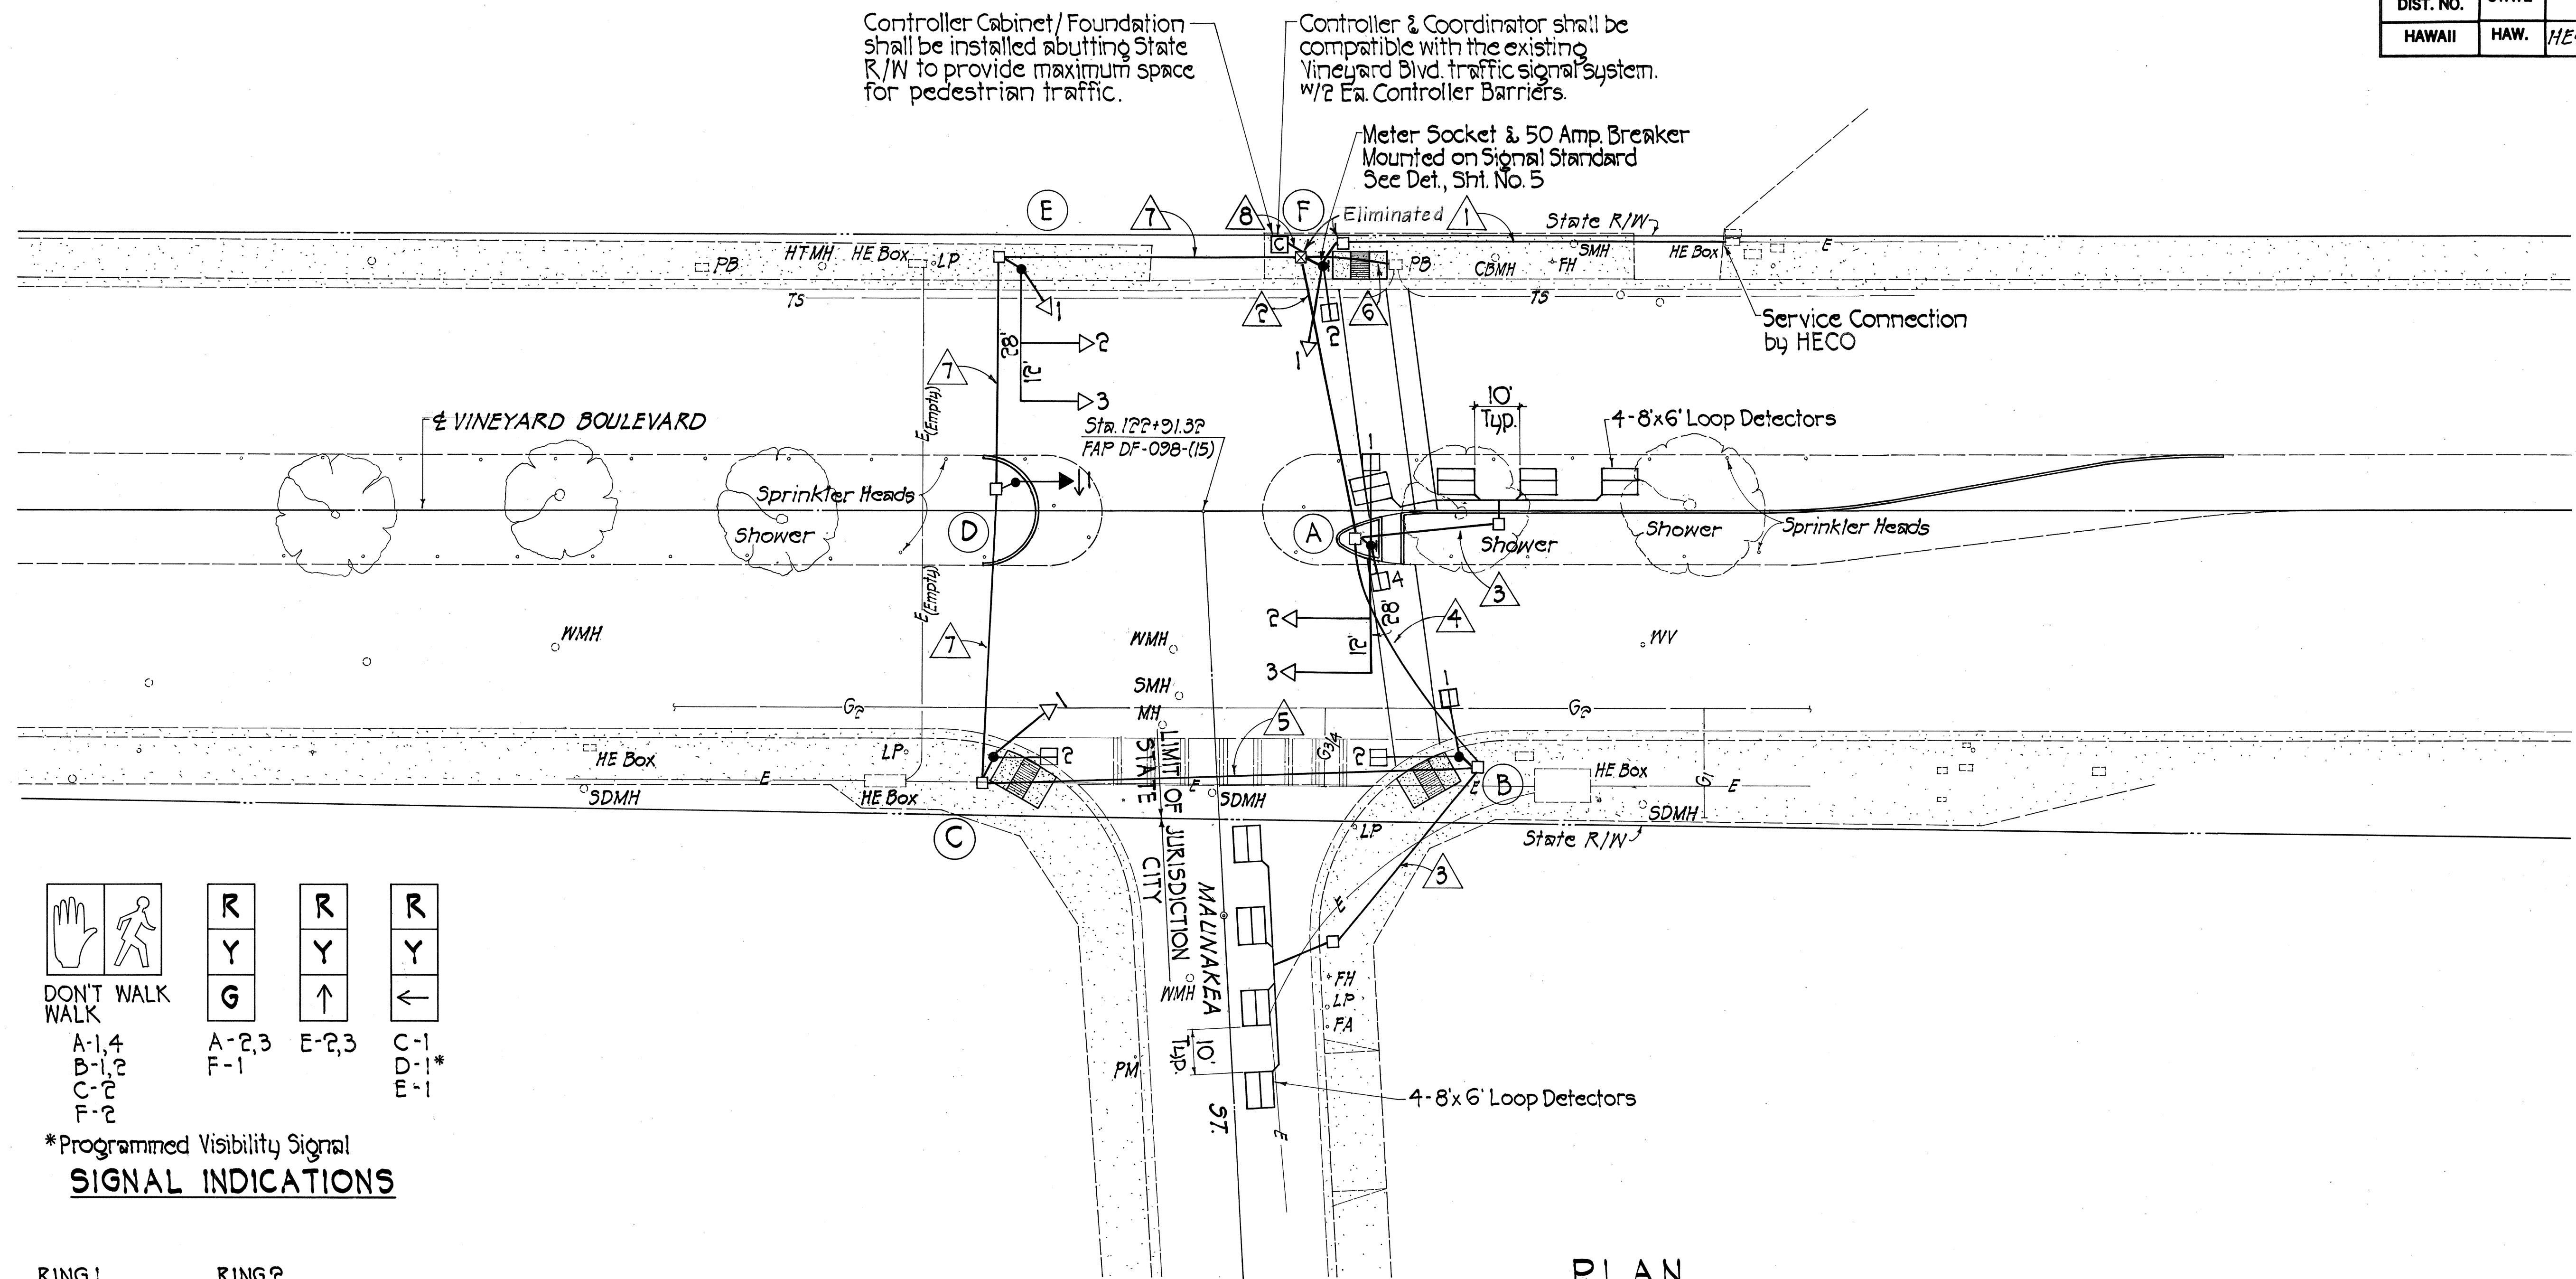

*Programmed Visibility Signal
SIGNAL INDICATIONS

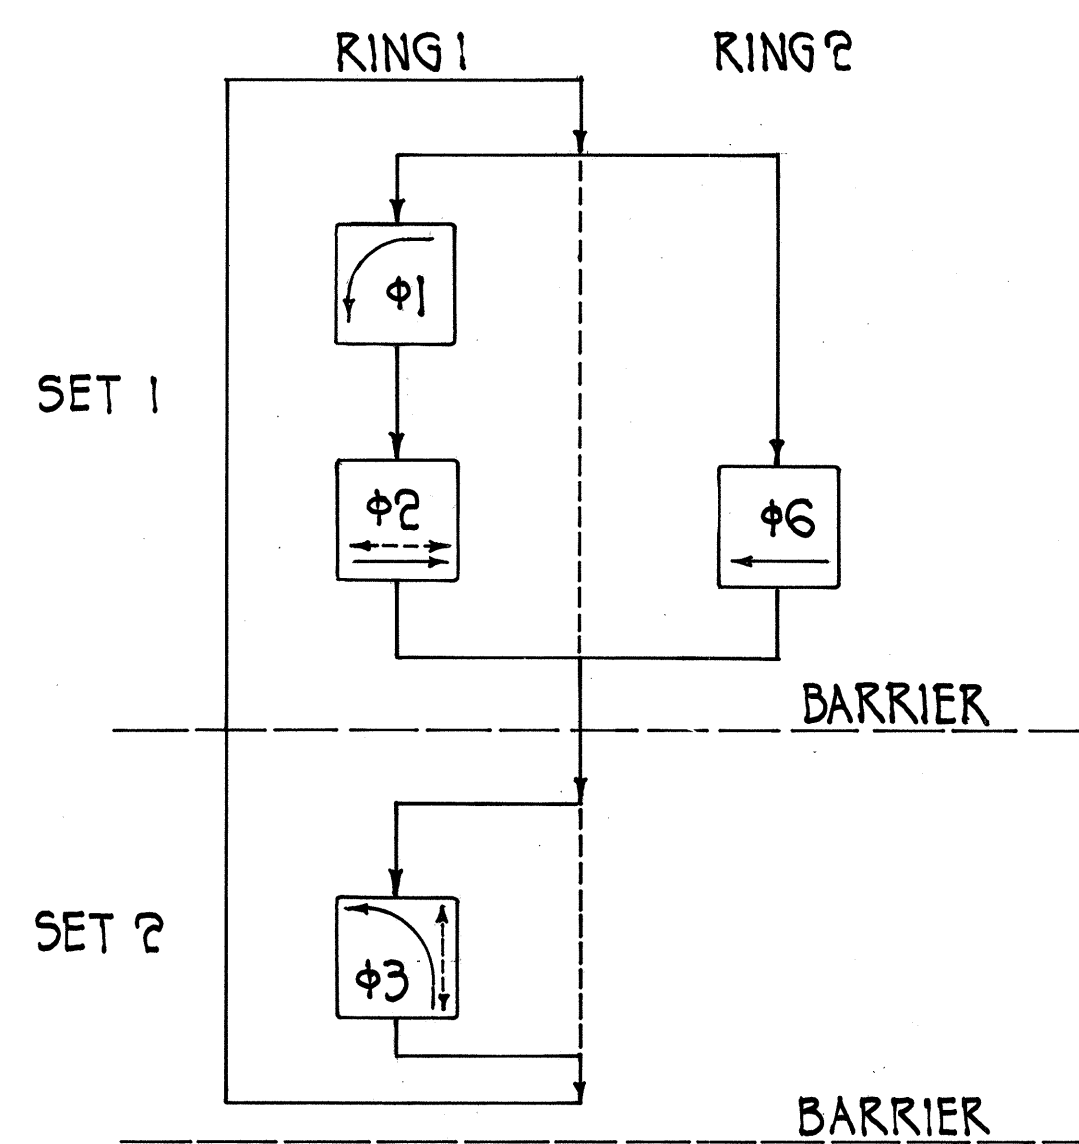

PHASE DIAGRAM


CONDUIT & CABLE SCHEDULE		
△	CONDUIT	CABLE
1	1-2" Sch. 80	1-3C #8
2	2-2" Sch. 80	1-26C #14, 3-2C #14
3	1-2" Sch. 80	1-2C #14
4	2-2" Sch. 80	1-26C #14, 2-2C #14
5	1-2" Sch. 80	1-26C #14
6	1-2" Sch. 80	1-24C #20
7	1-2" Sch. 80	1-26C #14
8	5-2" Sch. 80	2-26C #14, 3-2C #14, 1-24C #20, 1-3C #8

PLAN
Scale: 1"=20'
TMK: 1-7-06 & 07

APPROVED:

CHIEF, DIVISION OF ENGINEERING, DPW
(AUTHORIZED FOR CONSTRUCTION WITHIN CITY R/W ONLY)

CHIEF, PLANNING & ENGINEERING, BWS
DATE: 3-11-82

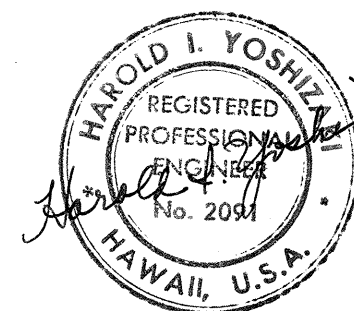

STATE OF HAWAII
DEPARTMENT OF TRANSPORTATION
HIGHWAYS DIVISION
TRAFFIC SIGNALS ON
VINEYARD BOULEVARD AT MAUNAKEA STREET
PLAN-TRAFFIC SIGNAL SYSTEM
PROJECT NO. HES-098-1(8)
SCALE: 1"=20' DATE: SEPT. 23, 1982
SHEET NO. 1 OF 3 SHEETS