


FED. ROAD DIST. NO.	STATE	PROJ. NO.	FISCAL YEAR	SHEET NO.	TOTAL SHEETS
HAWAII	HAW.	98A-02-86	1986	2	4

New Type "A" Wheelchair Ramp
Demolish Exist. Type "B" Pull Box,
Salvage frame and cover,
Construct New Type "B" Pull Box
flush with New Type "A" Wheel-
chair Ramp. No payment will
be paid and shall be considered
incidental to various contract
items.

Vineyard Blvd.-Nuuanu Ave. Intersection
Construct 6 Type "A" Wheelchair Ramps
and 2 Type "C" Wheelchair Ramps.

Vineyard Blvd. @ Sta. 131+72.50 - Driveway
Construct 2 Type "E" Wheelchair Ramps.

Vineyard Blvd-Pali Hwy. Intersection
Construct 2 Type "A" Wheelchair Ramps
and 4 Type "C" Wheelchair Ramps.

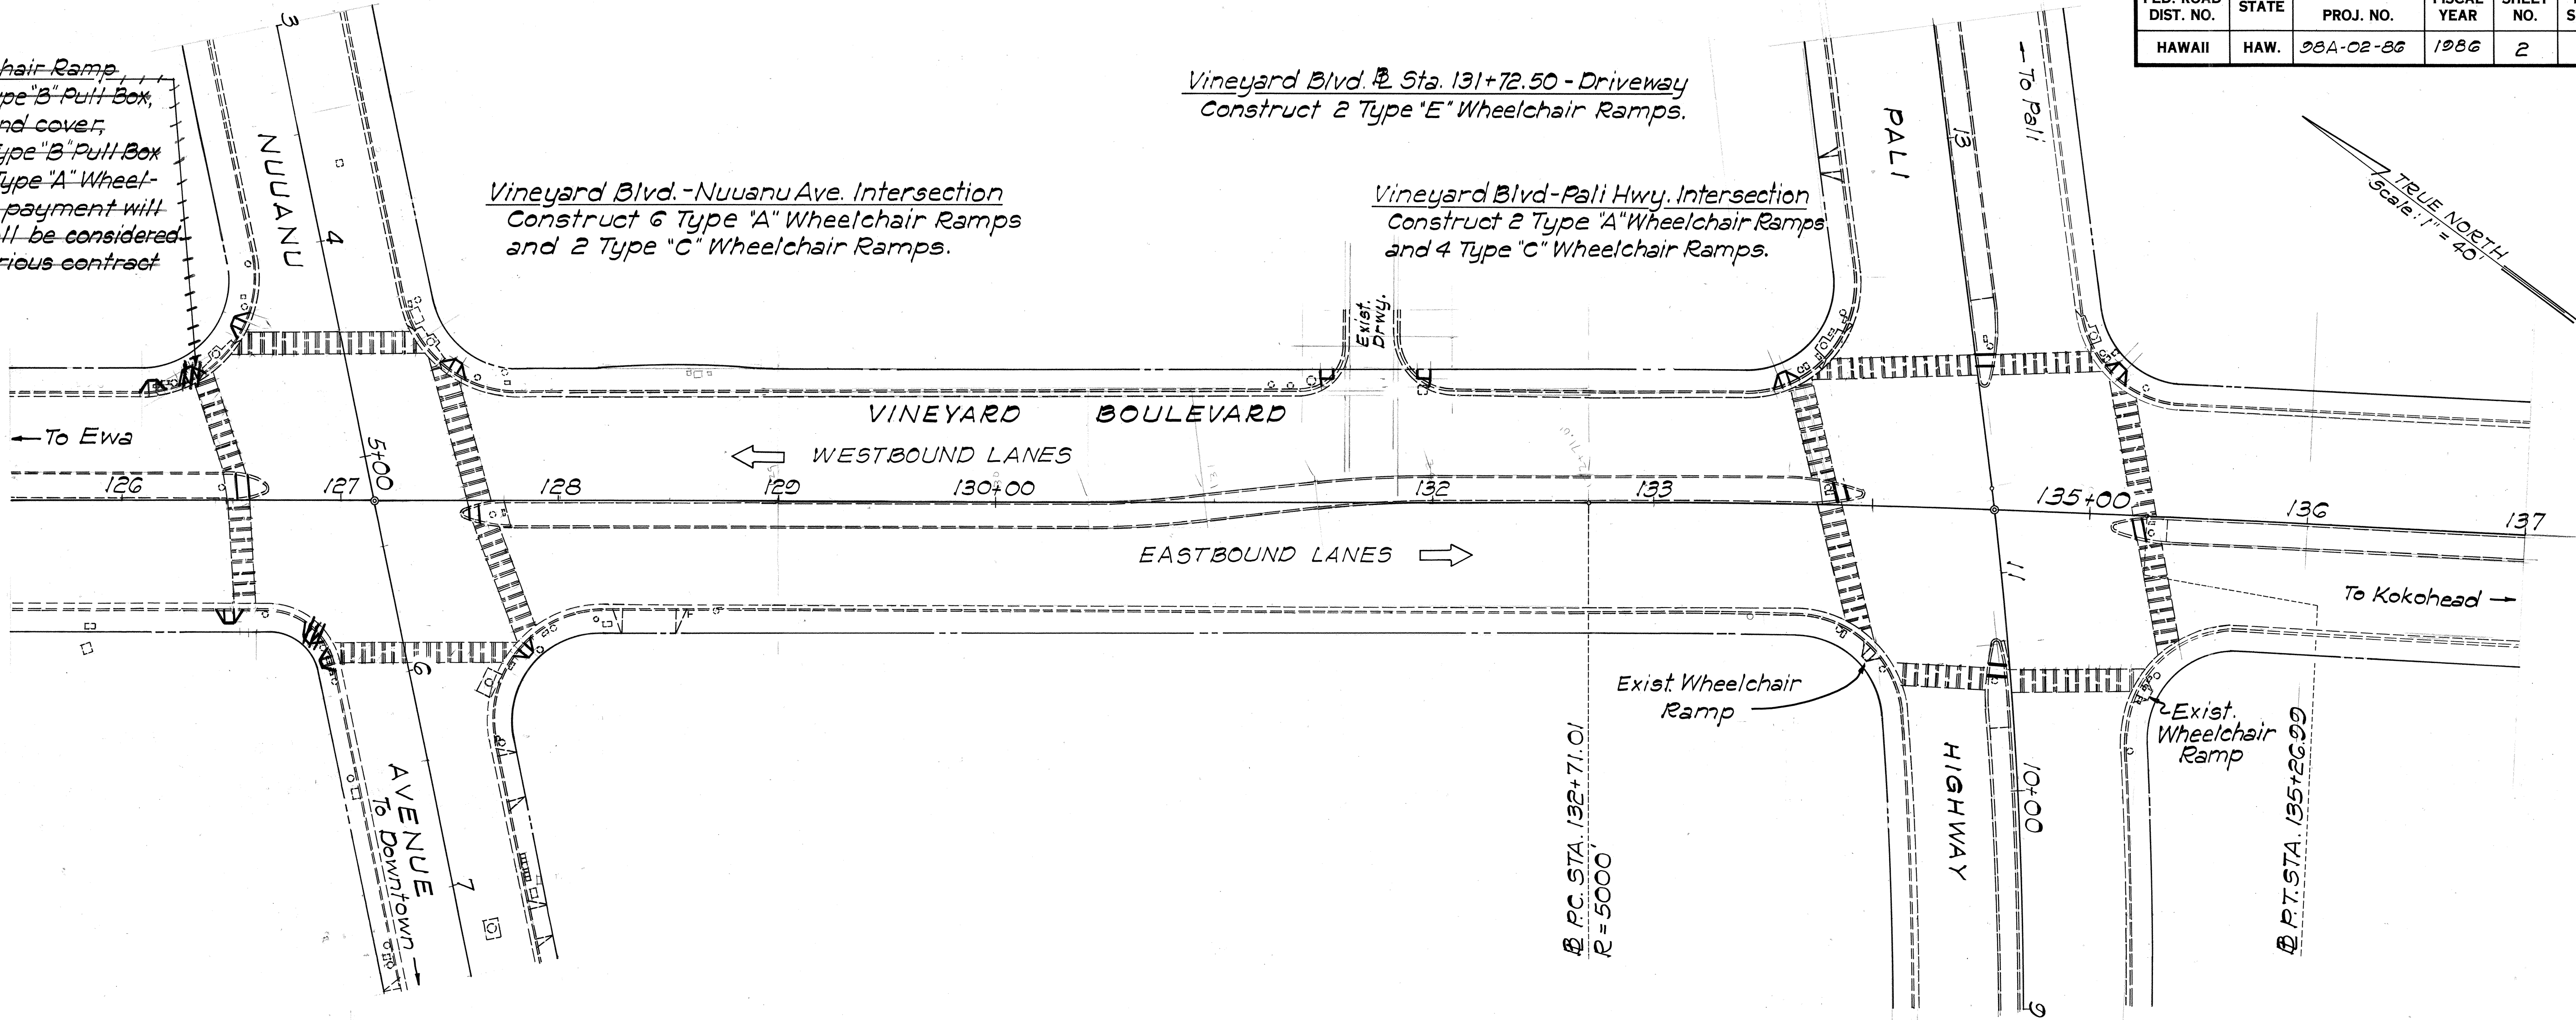

SCOPE OF WORK:
This project consists of constructing wheelchair
ramps along Vineyard Boulevard between
Nuuanu Avenue and Pali Highway.

LEGEND

- Type "A" Wheelchair Ramp
- Type "C" Wheelchair Ramp
- Type "E" Wheelchair Ramp

NOTES:

- All sidewalks shall be kept open to pedestrians
or alternate walk routes shall be clearly deline-
ated. Payment for delineation of walkways shall
be incidentals to the various contract items.
- Exact locations of wheelchair ramps to be deter-
mined by the Engineer, and shall be tied into
the existing crosswalk.
- Placement of all wheelchair ramps shall not inter-
fere with the existing utility lines and hardware.
Also no drainage facilities shall be affected by
the placement of all wheelchair ramps.
- If the Contractor elects to close one lane during
work hours, the Contractor shall submit a
traffic control plan in accordance with Section
645 Traffic Control.

STATE OF HAWAII
DEPARTMENT OF TRANSPORTATION
HIGHWAYS DIVISION

PLAN

WHEELCHAIR RAMPS ALONG VINEYARD BLVD.
Nuuanu Avenue to Pali Highway
Proj. No. 98A-02-86
Scale: 1"=40' Date: Aug. 1985

SHEET NO. 1 OF 1 SHEETS

9/30/85	Added demolishing and constructing Pull Box at Type "A" Wheelchair Ramp
DATE	REVISION