


STATE OF HAWAII


DEPARTMENT OF TRANSPORTATION
HIGHWAYS DIVISION
HONOLULU, HAWAII
"AS-BUILT"
PLANS FOR

WHEELCHAIR RAMPS ALONG
VINEYARD BOULEVARD
NUUANU AVENUE TO PALI HIGHWAY

PROJECT NO. 98A-02-86

DISTRICT OF HONOLULU ISLAND OF OAHU

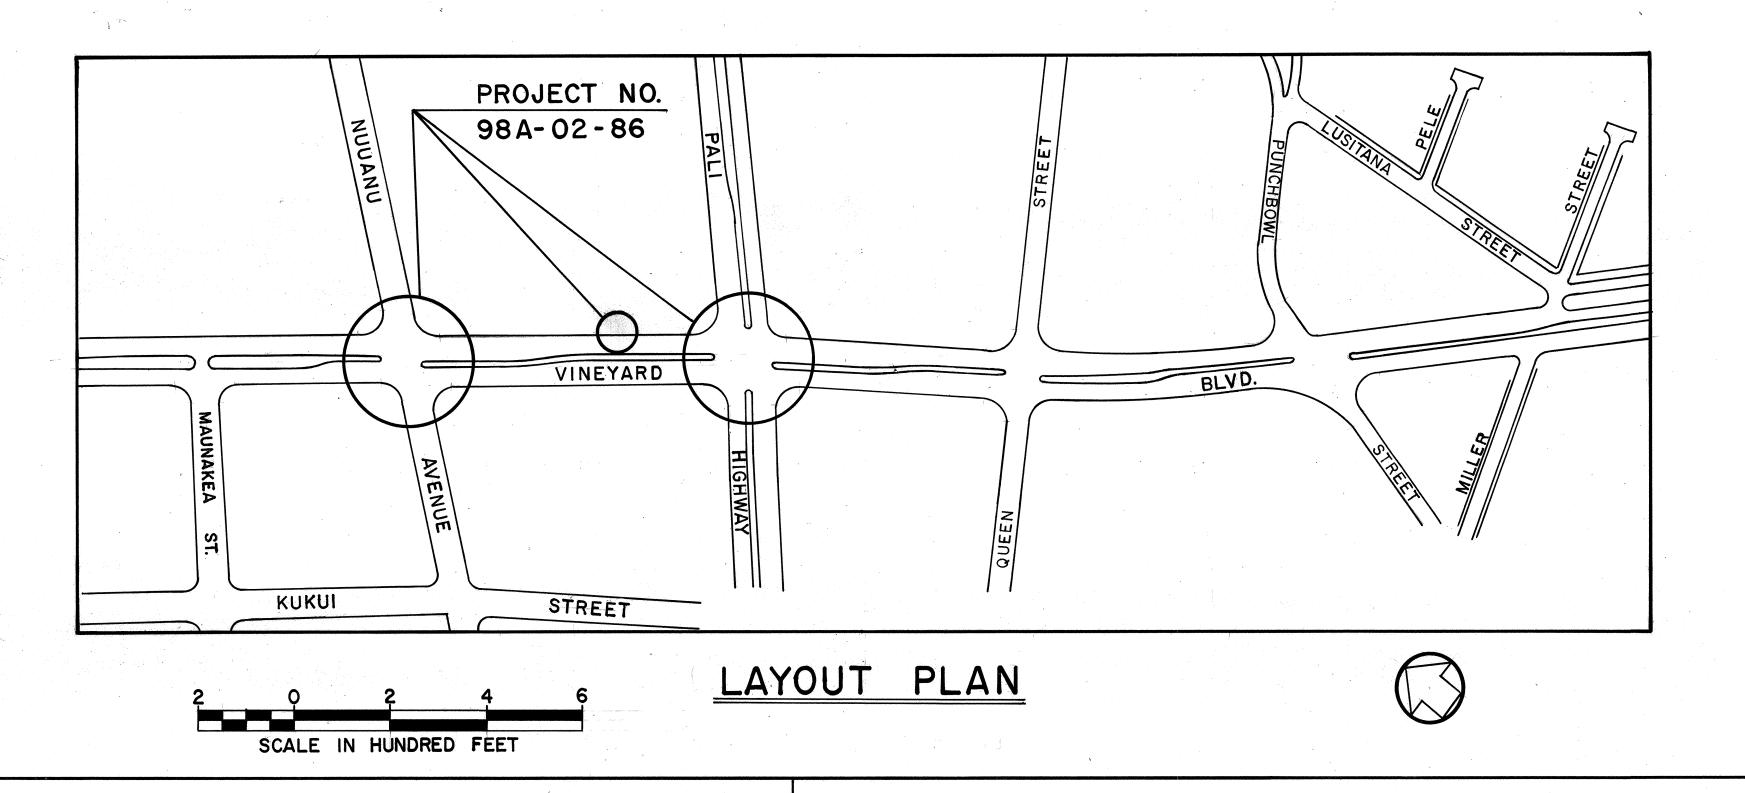

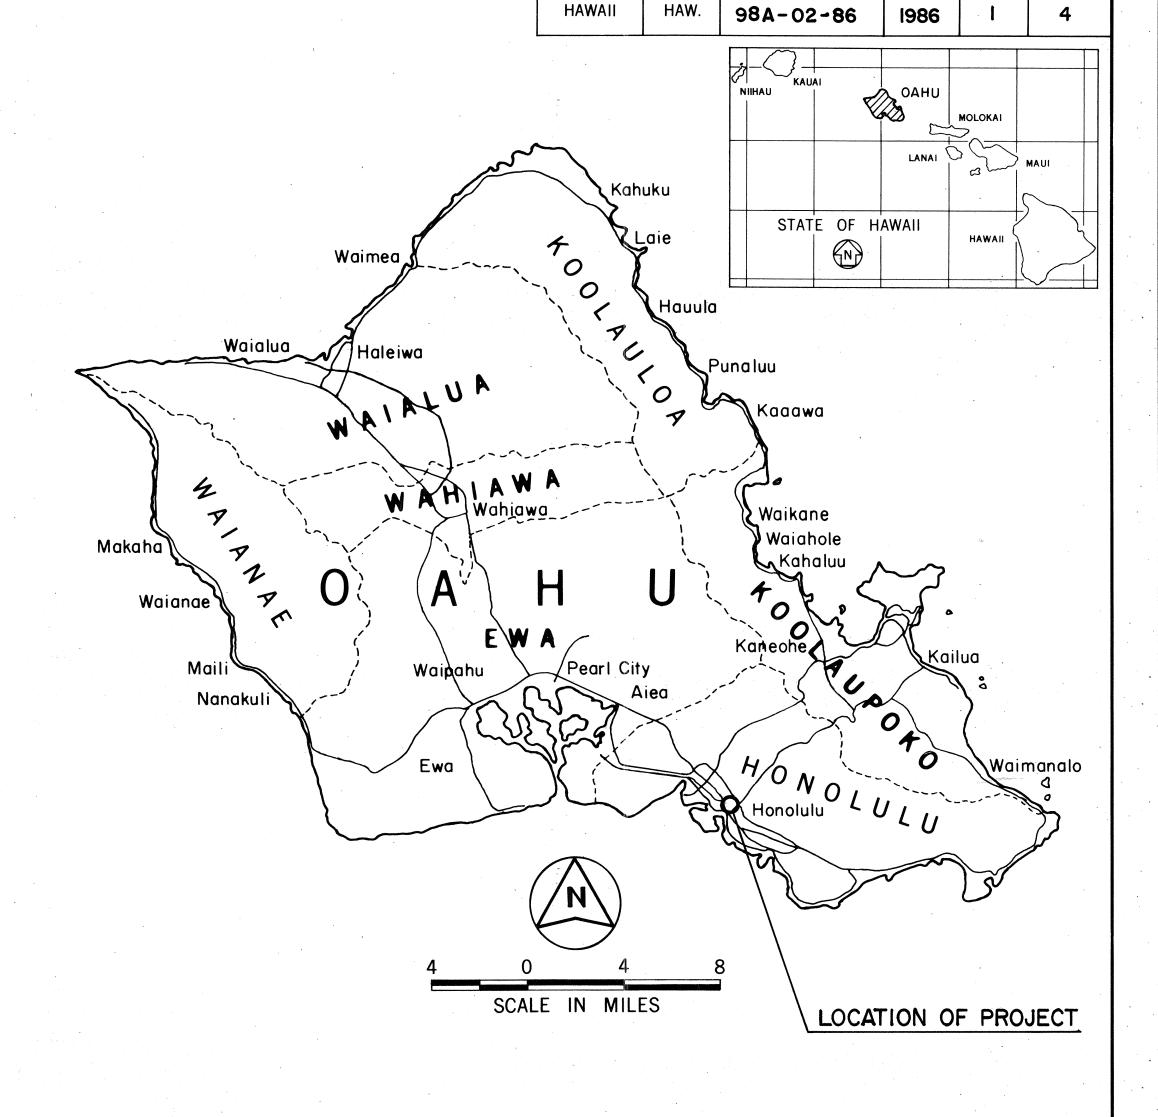

DIST. NO.

CHANGES MADE DURING CONSTRUCTION HAVE BEEN INCORPORATED ON THESE PLANS EXCEPT CHANGES IN THE ORIGINAL THEORETICAL QUANTITIES. FOR ACTUAL QUANTITIES, REFER TO PROJECT LEDGER AND/OR COMPUTATION BOOK.

RESIDENT ENGINEER

12/19/85 DATE

FISCAL SHEET YEAR NO.

PROJ. NO.

DEPARTMENT OF TRANSPORTATION
STATE OF HAWAII

APPROVED:

Check D. Boon 9/9/85

DIR. OF TRANSPORTATION DATE

Aug.1985 DATE

548-2456 PHONE

Roy T. Nagasako

Roy T. Nagasako DESIGNED BY