
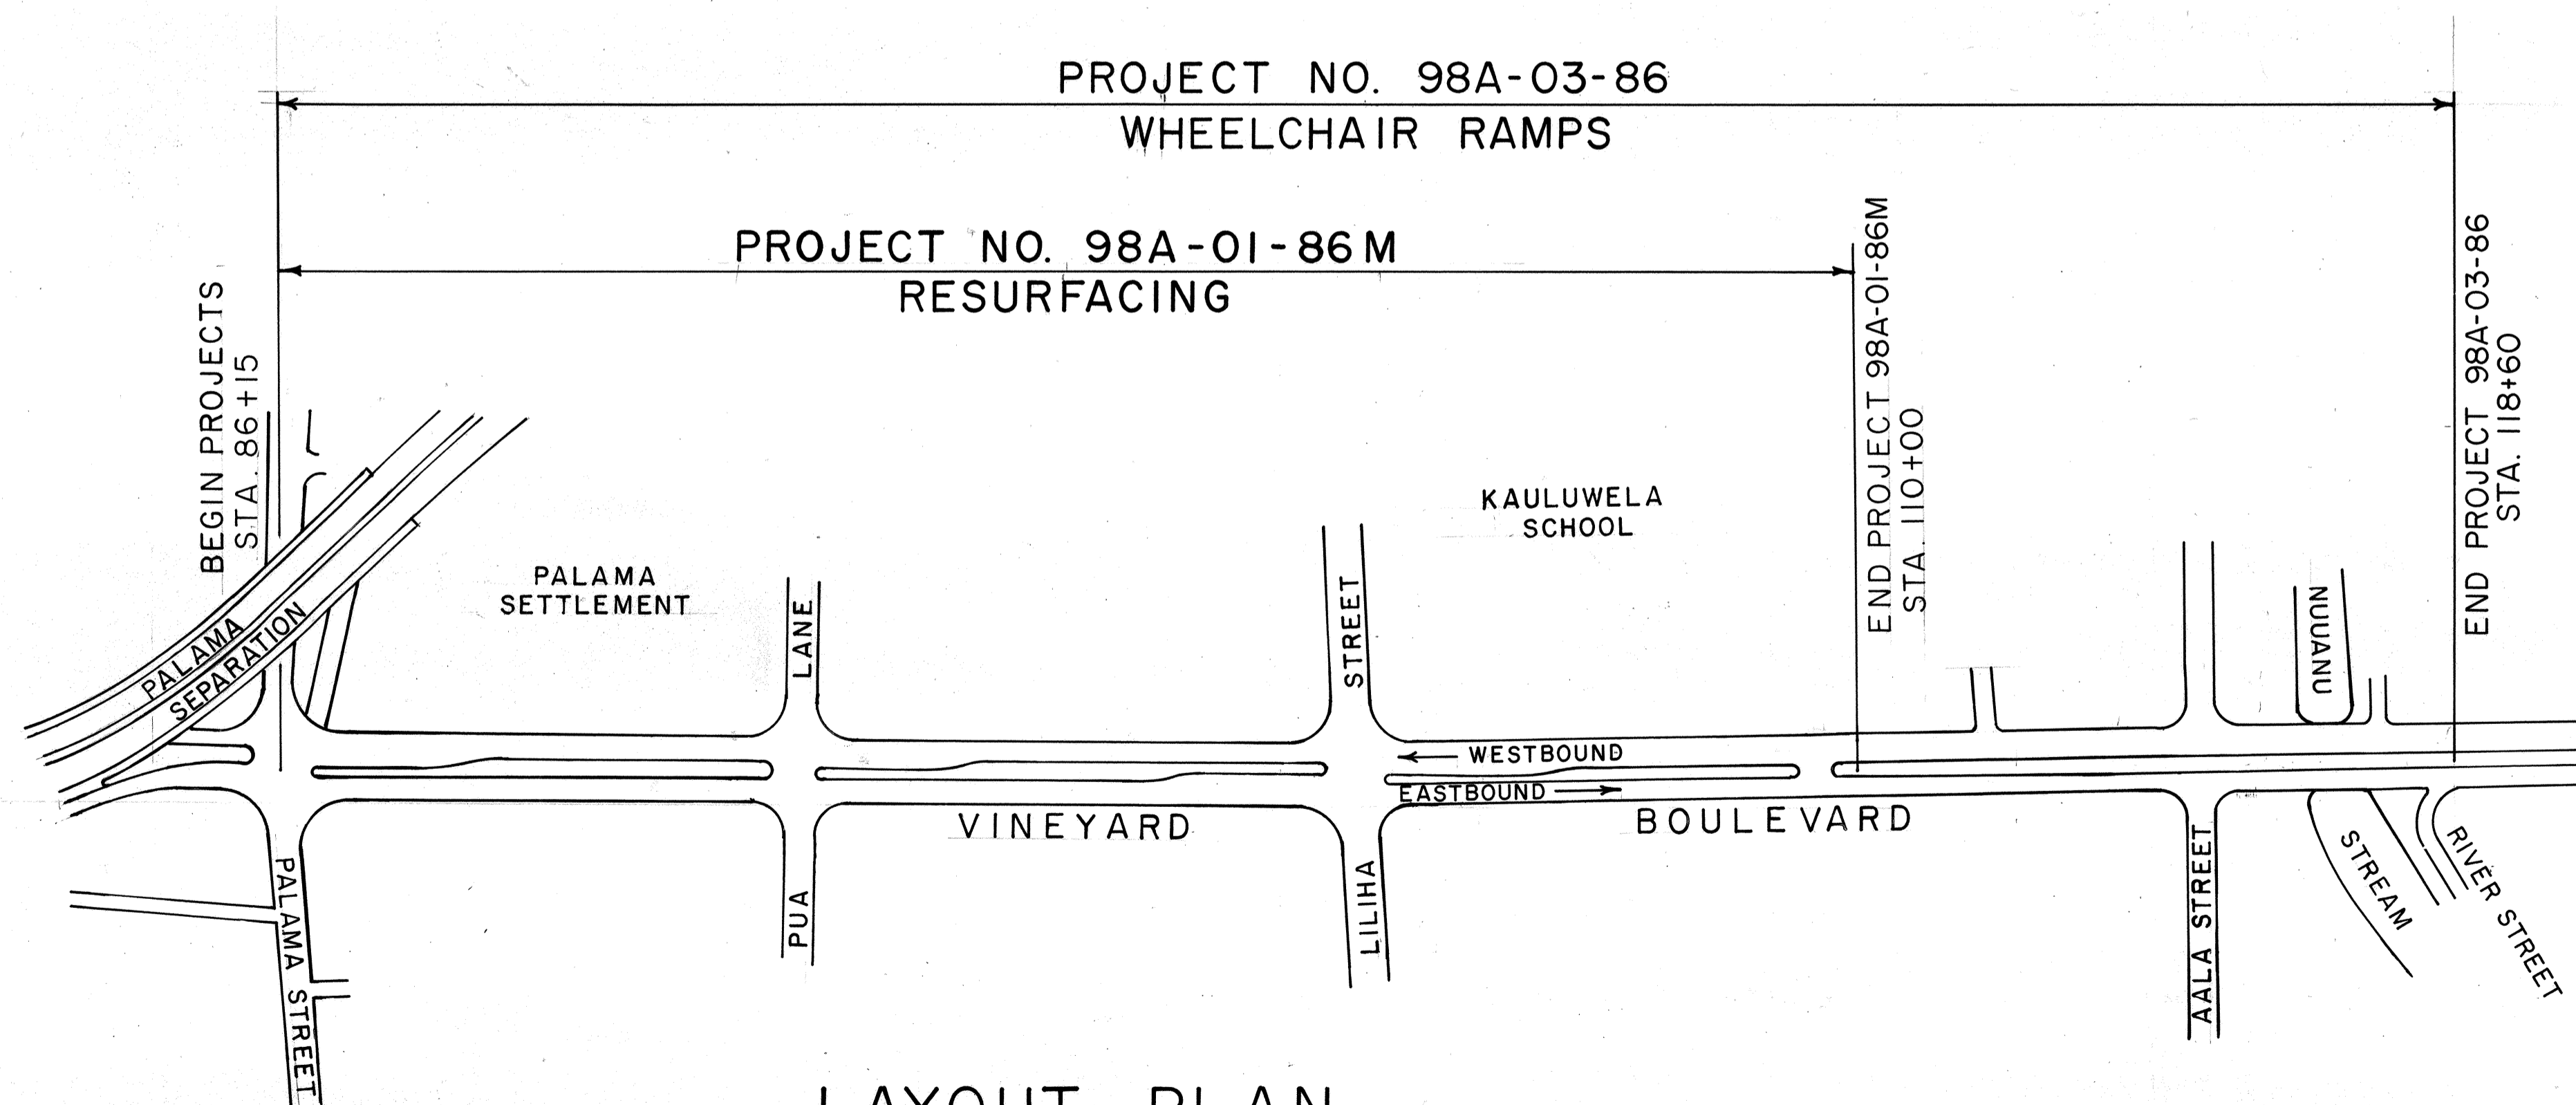


[illegible]

FED. ROAD DIST. NO.	STATE	PROJ. NO.	FISCAL YEAR	SHEET NO.	TOTAL SHEETS
HAWAII	HAW.	98A-01-86M 98A-03-86	1986	1	16

STATE OF HAWAII
DEPARTMENT OF TRANSPORTATION
HIGHWAYS DIVISION
HONOLULU, HAWAII
"AS-BUILT"
PLANS FOR
VINEYARD BOULEVARD RESURFACING
PALAMA STREET TOWARDS AALA STREET
PROJECT NO. 98A-01-86M
AND
WHEELCHAIR RAMPS ALONG VINEYARD BOULEVARD
PALAMA STREET TO RIVER STREET
PROJECT NO. 98A-03-86

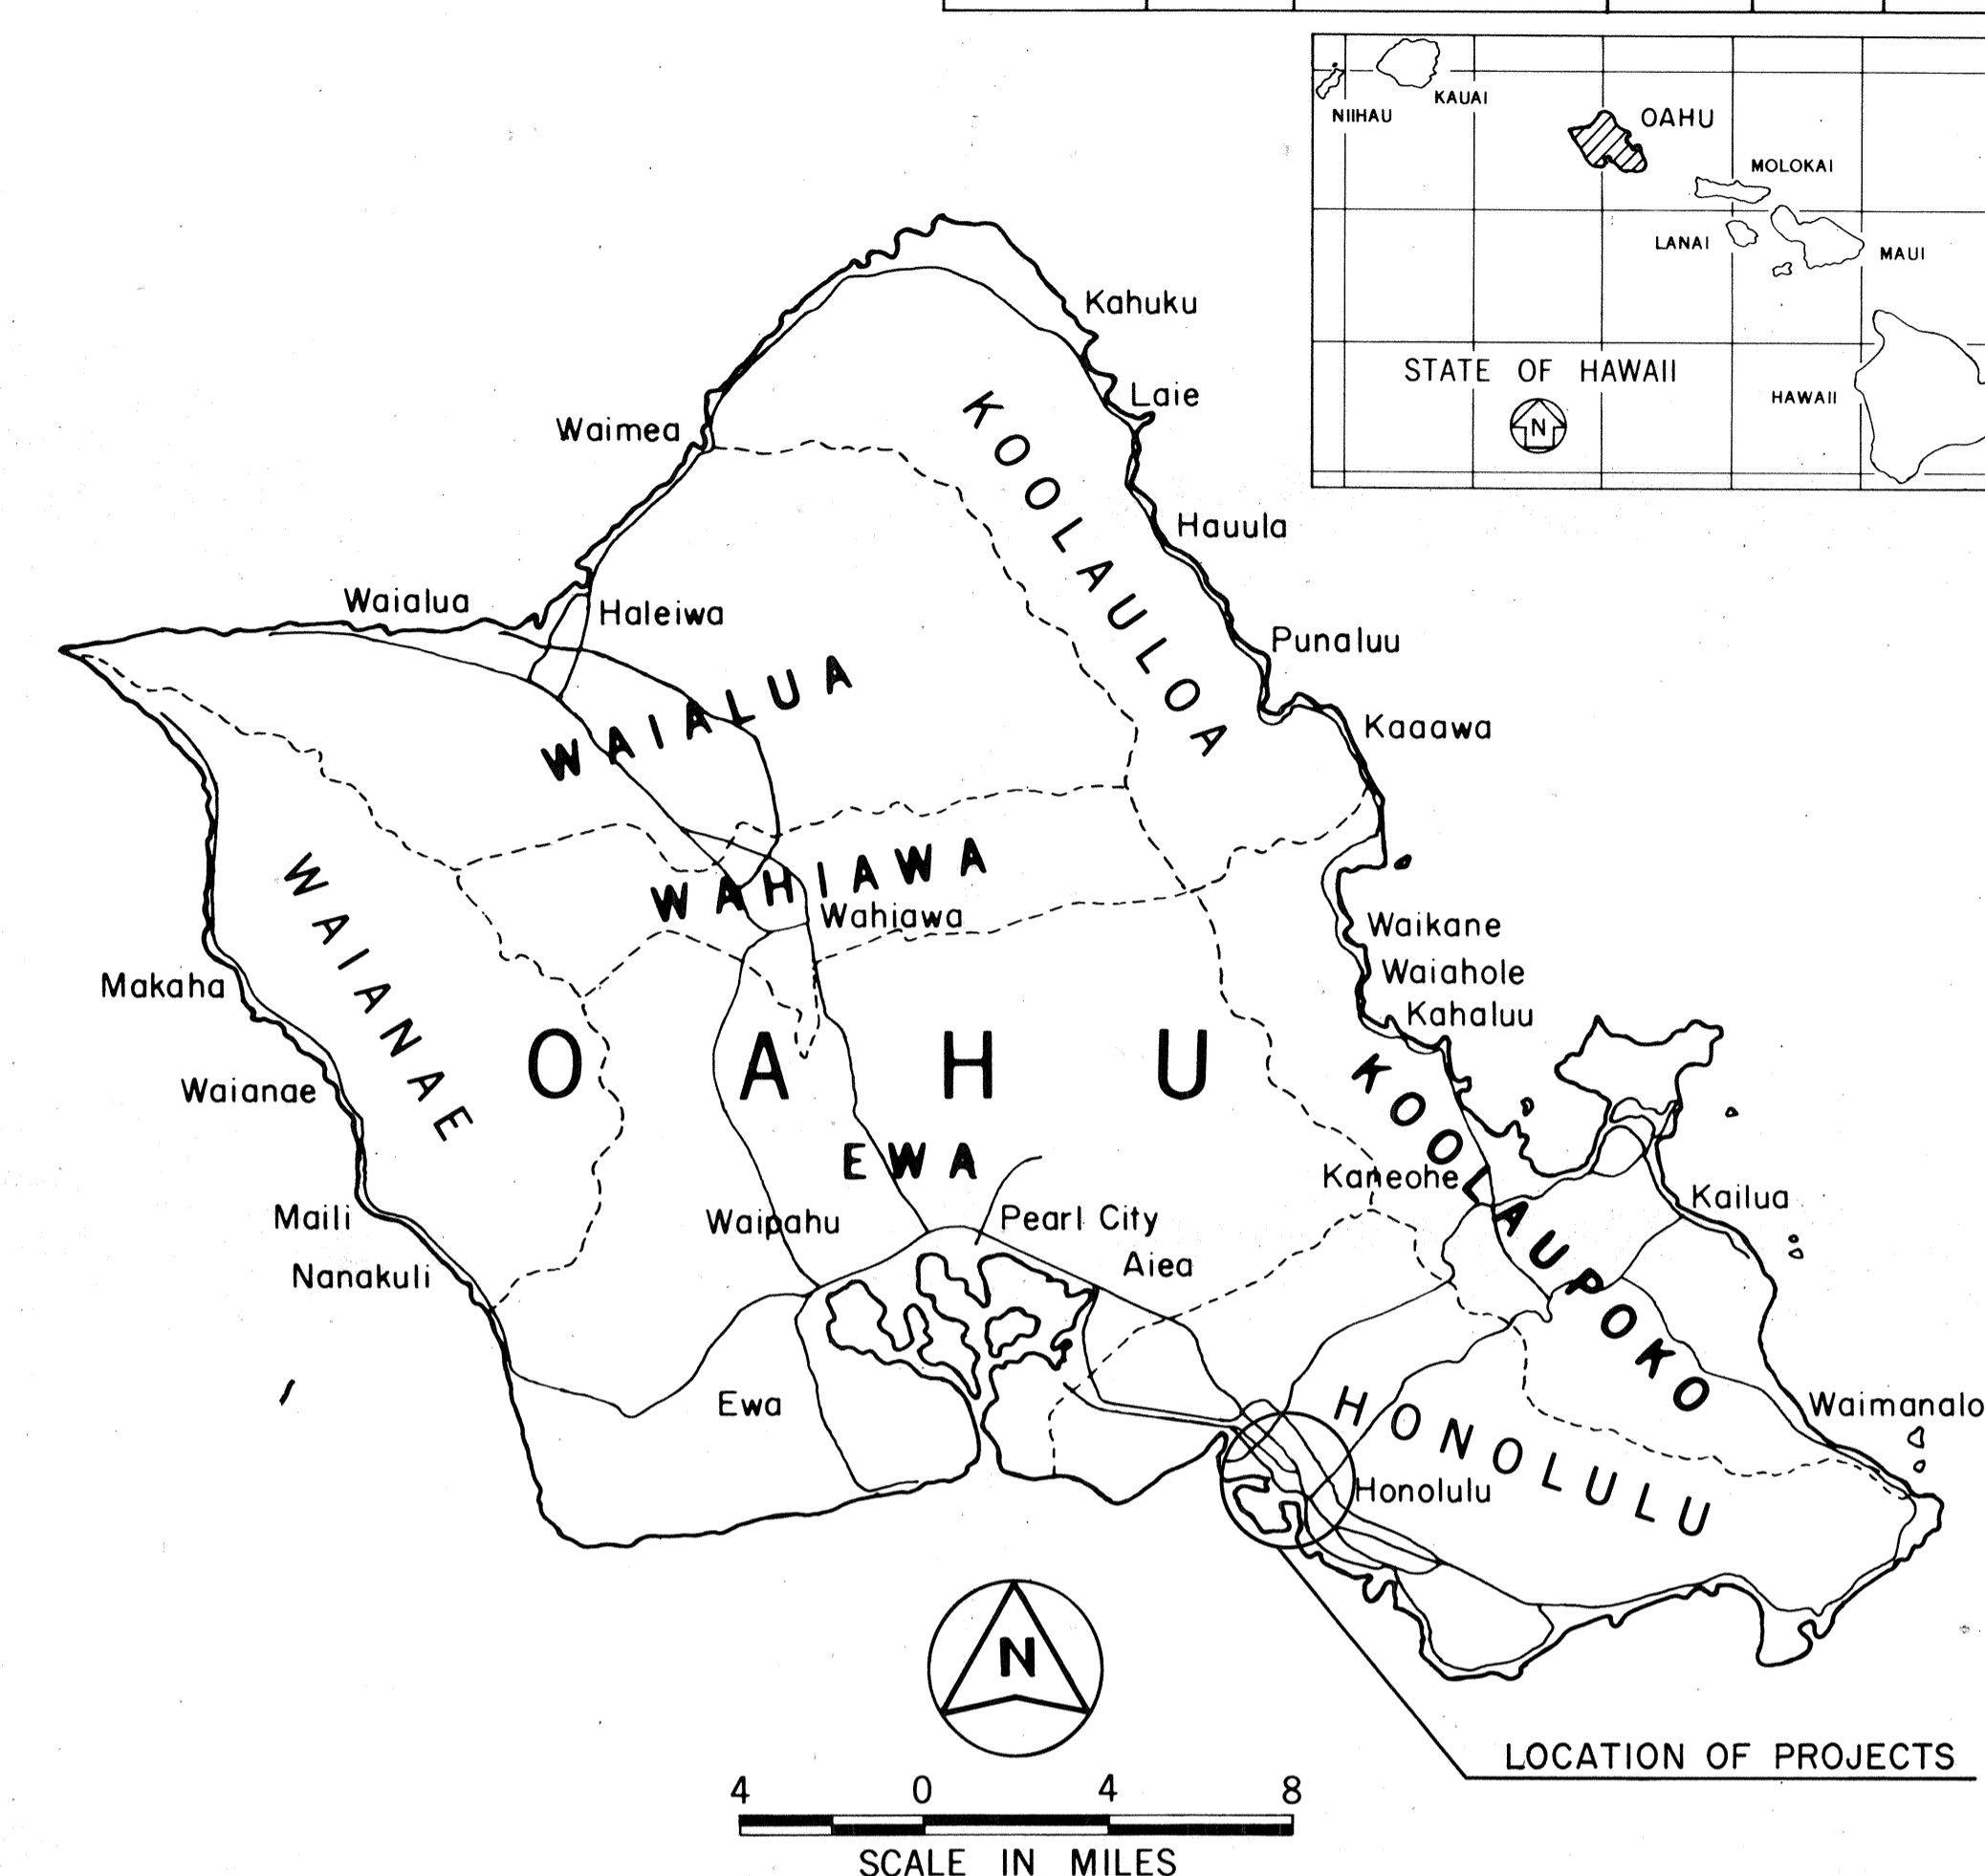


NO SIGNIFICANT CHANGES WERE MADE DURING CONSTRUCTION ON THESE PLANS EXCEPT CHANGES IN THE ORIGINAL THEORETICAL QUANTITIES. FOR ACTUAL QUANTITIES, REFER TO PROJECT LEDGER AND/OR COMPUTATION BOOK.

Virgilio P. Gonzalez
RESIDENT ENGINEER

9/6/88
DATE

LAYOUT PLAN

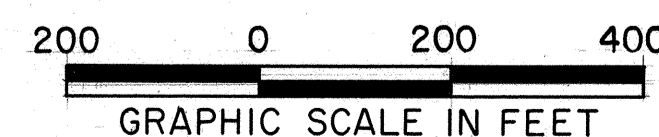

DESIGN UNIT "E"
DESIGNED BY
A. YAMAGUCHI
P. S. & E. BY
548-4125
PHONE
DATE

DEPARTMENT OF TRANSPORTATION
STATE OF HAWAII

APPROVED:

Shirley D. Aon 2/19/80
DIR. OF TRANSPORTATION DATE