



FED. ROAD DIST. NO.	STATE	FED. AID PROJ. NO.	FISCAL YEAR	SHEET NO.	TOTAL SHEETS
HAWAII	HAW.	NH-098-1(9)	1993	26	35

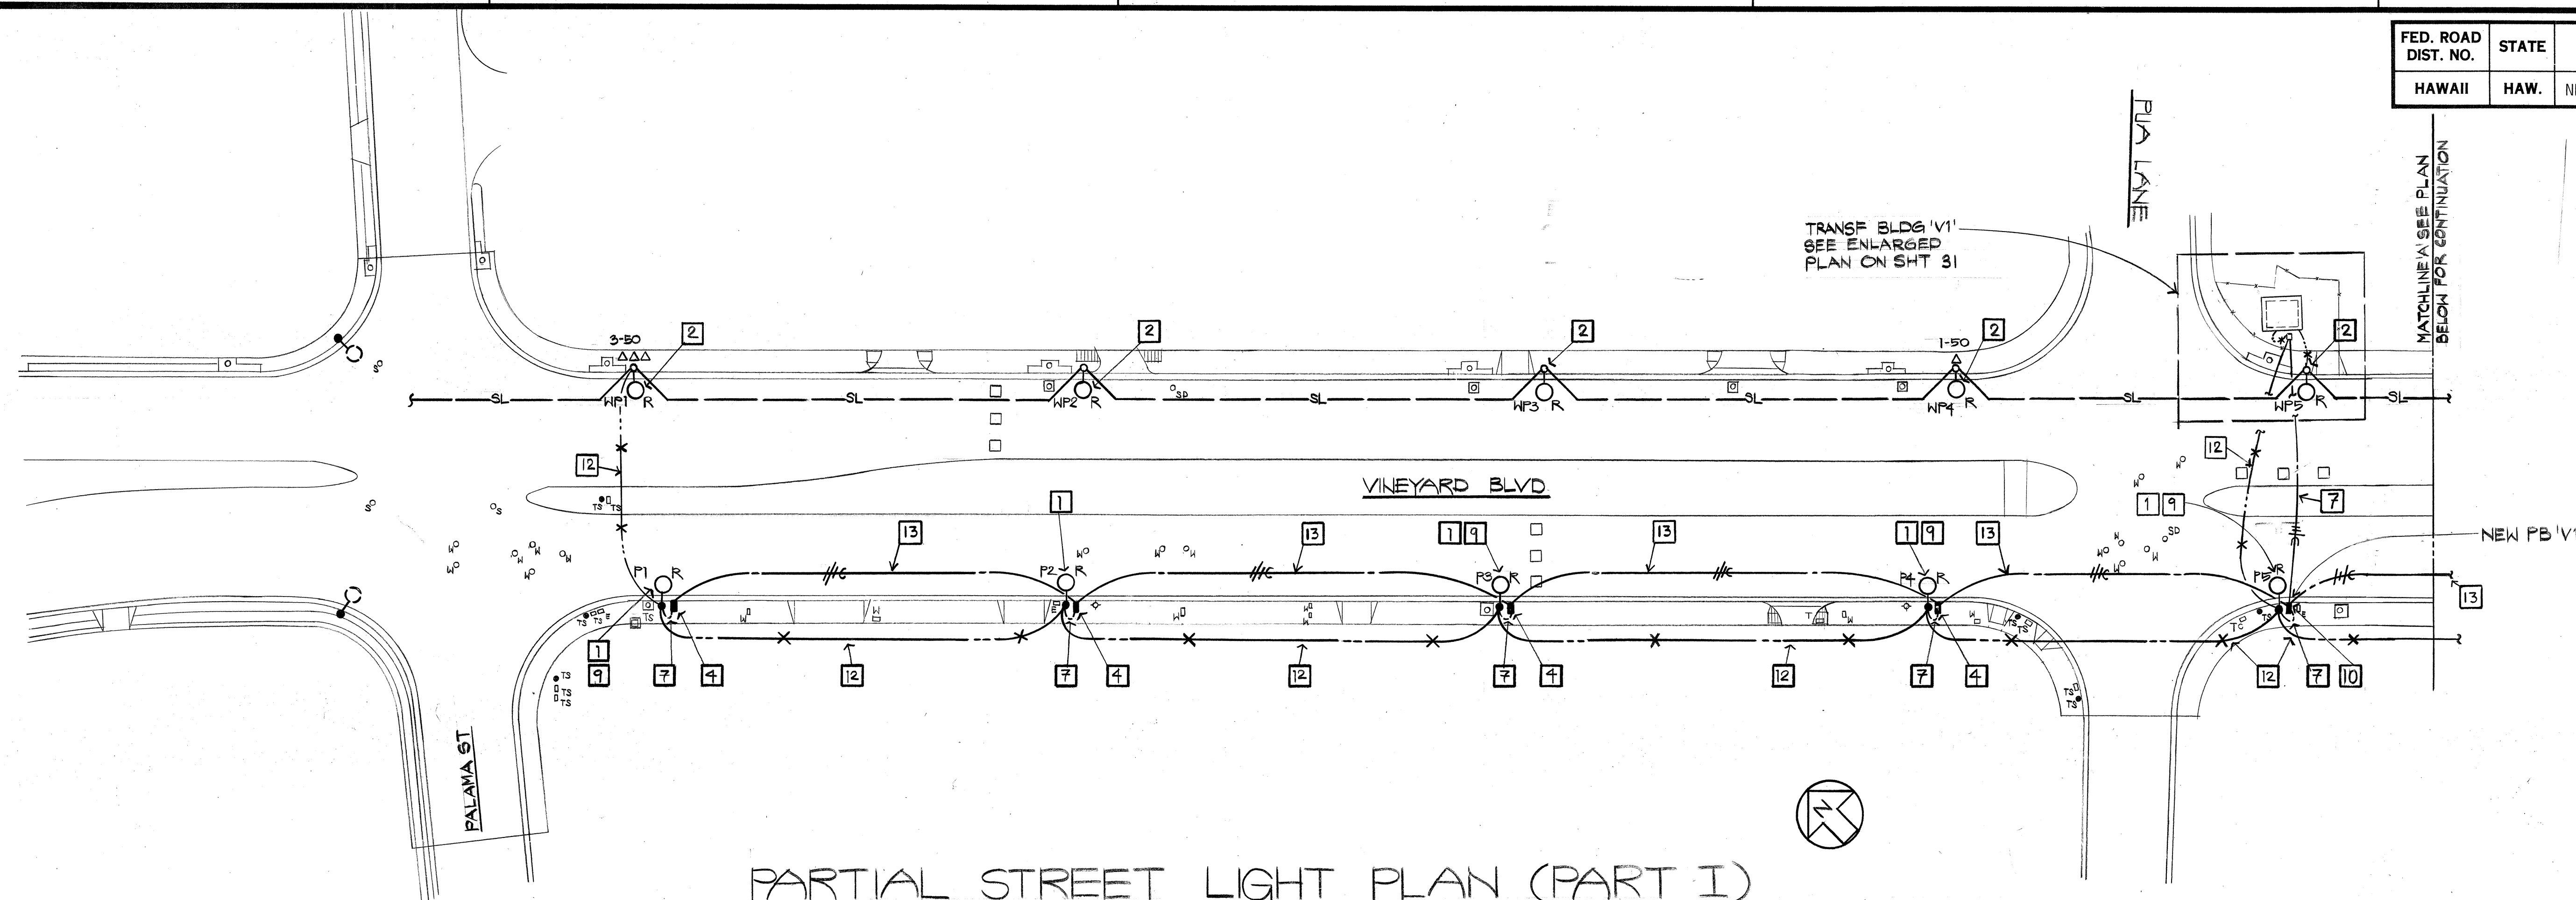

PARTIAL STREET LIGHT PLAN (PART I)


SCALE: 1"=40'

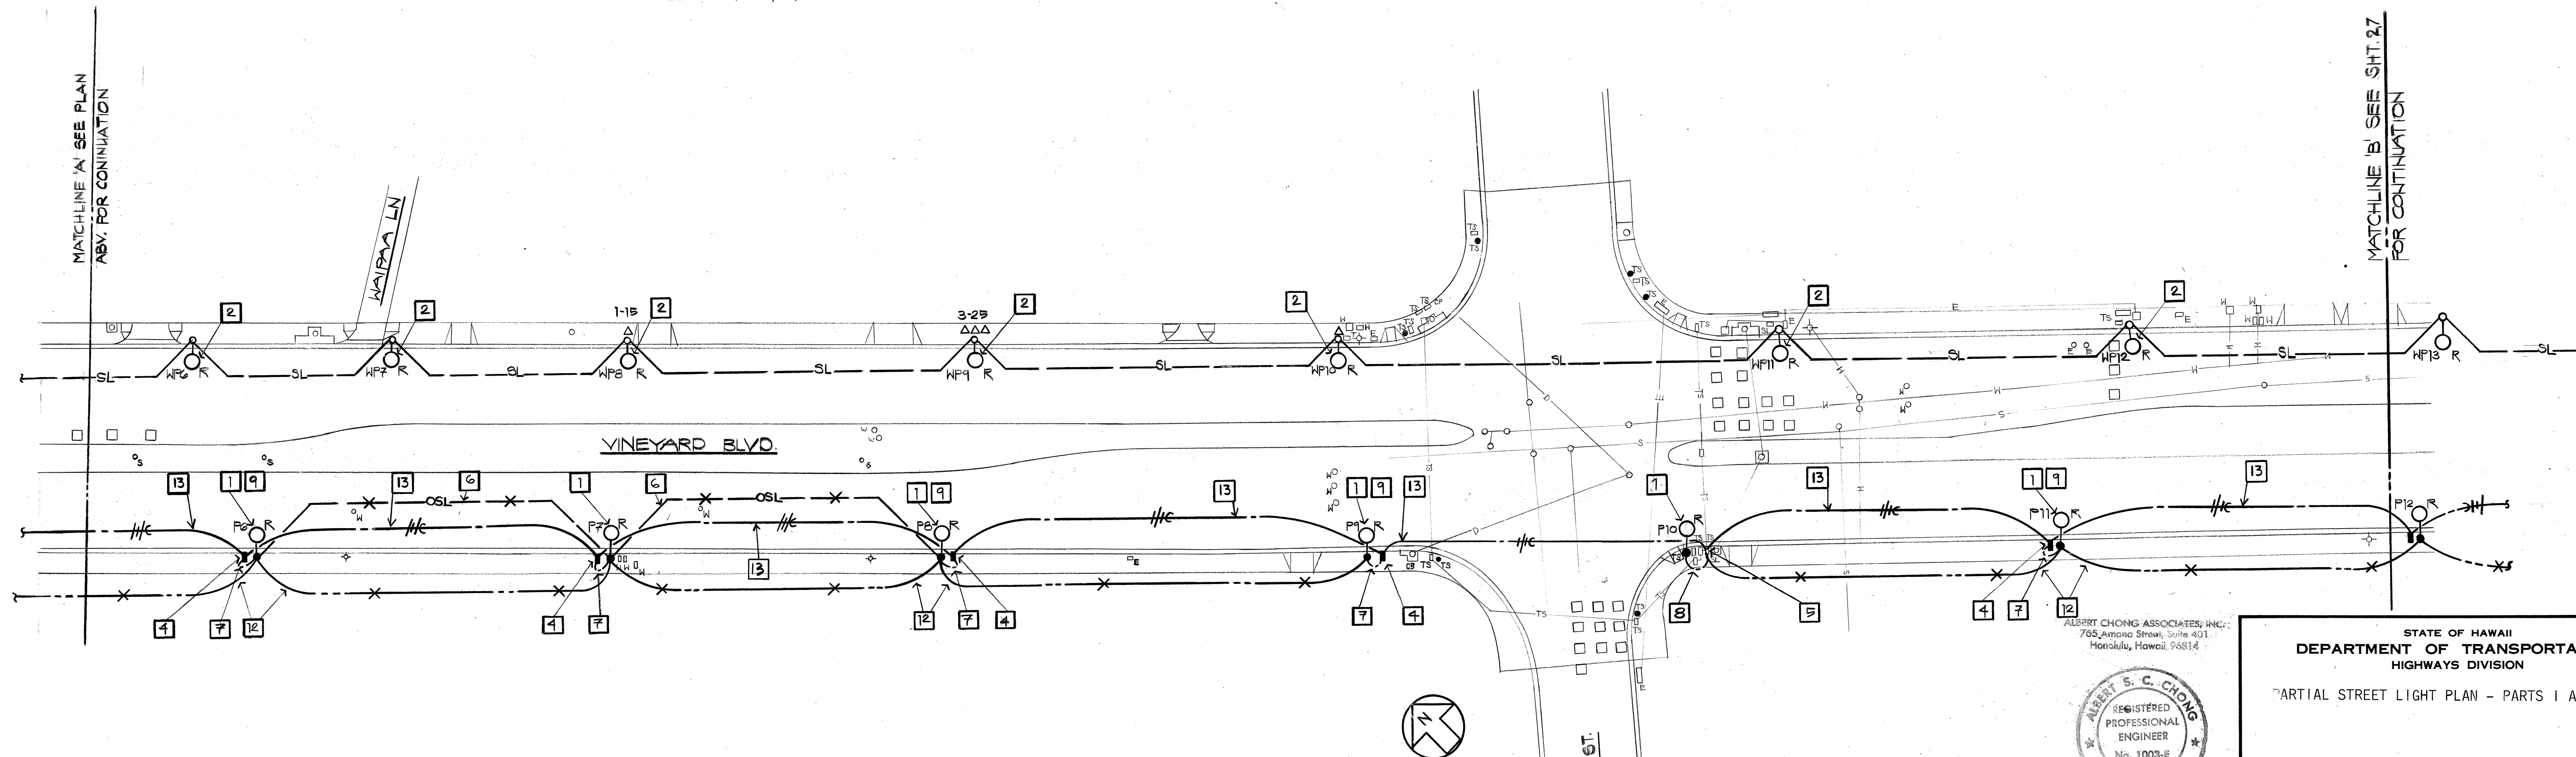

PARTIAL STREET LIGHT PLAN (PART II)

SCALE: 1"=40'

DATE	_____
SURVEY PLOTTED BY	_____
DRAWN BY	_____
DESIGNED BY	_____
QUANTITIES BY	_____
CHECKED BY	_____
ORIGINAL PLAN	_____
NOTE BOOK	_____
No.	_____

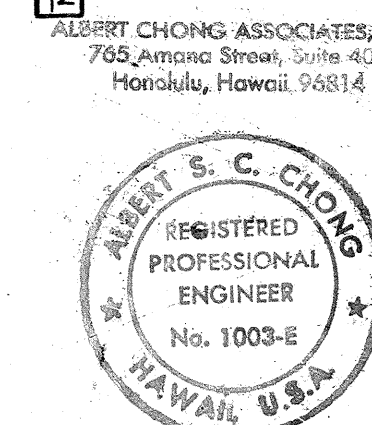

THIS WORK WAS PREPARED BY ME
OR UNDER MY SUPERVISION
Albert S. C. Chong


STATE OF HAWAII
DEPARTMENT OF TRANSPORTATION
HIGHWAYS DIVISION

PARTIAL STREET LIGHT PLAN - PARTS I AND II


HIGHWAY LIGHTING IMPROVEMENTS AND REHABILITATION
VINEYARD BOULEVARD
PALAMA STREET TO PUNCHBOWL STREET

SHEET No. 26 OF 35 SHEETS

FED. ROAD DIST. NO.	STATE	FED. AID PROJ. NO.	FISCAL YEAR	SHEET NO.	TOTAL SHEETS
HAWAII	HAW.	NH-098-1(9)	1993	27	35

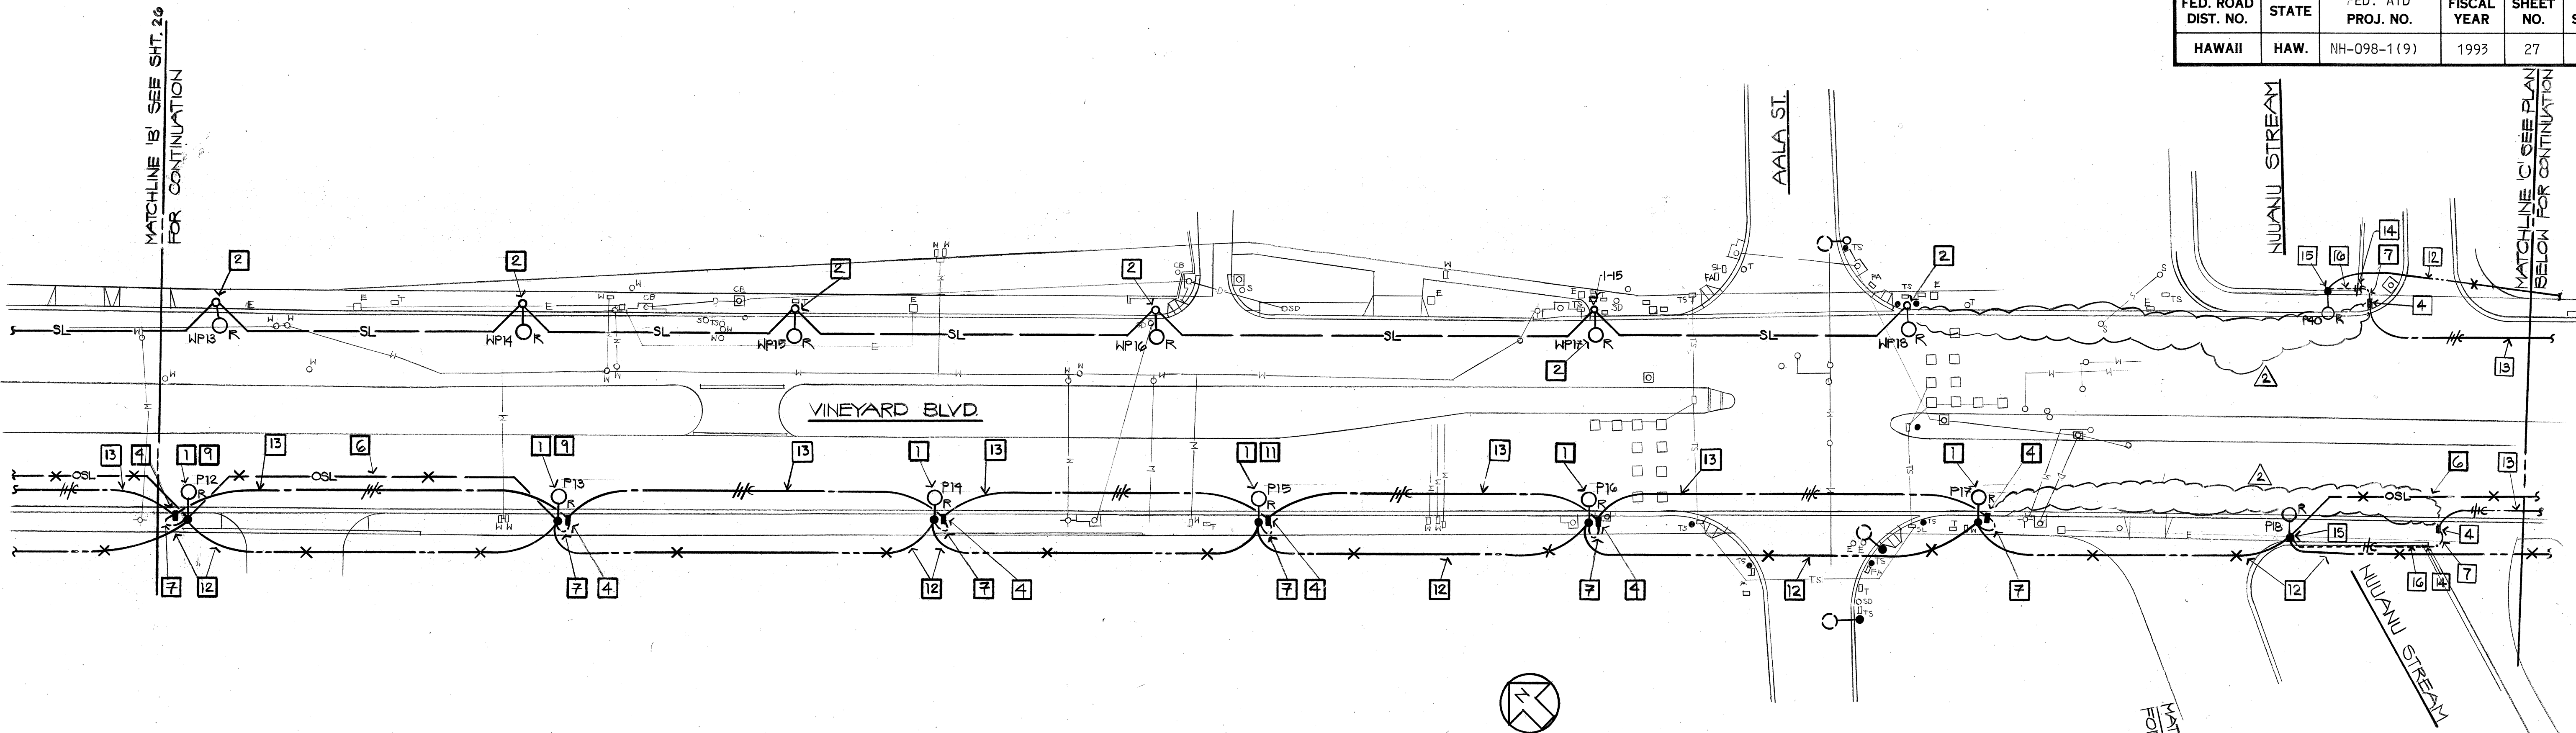


PARTIAL STREET LIGHT PLAN (PART III)
SCALE: 1"=40'

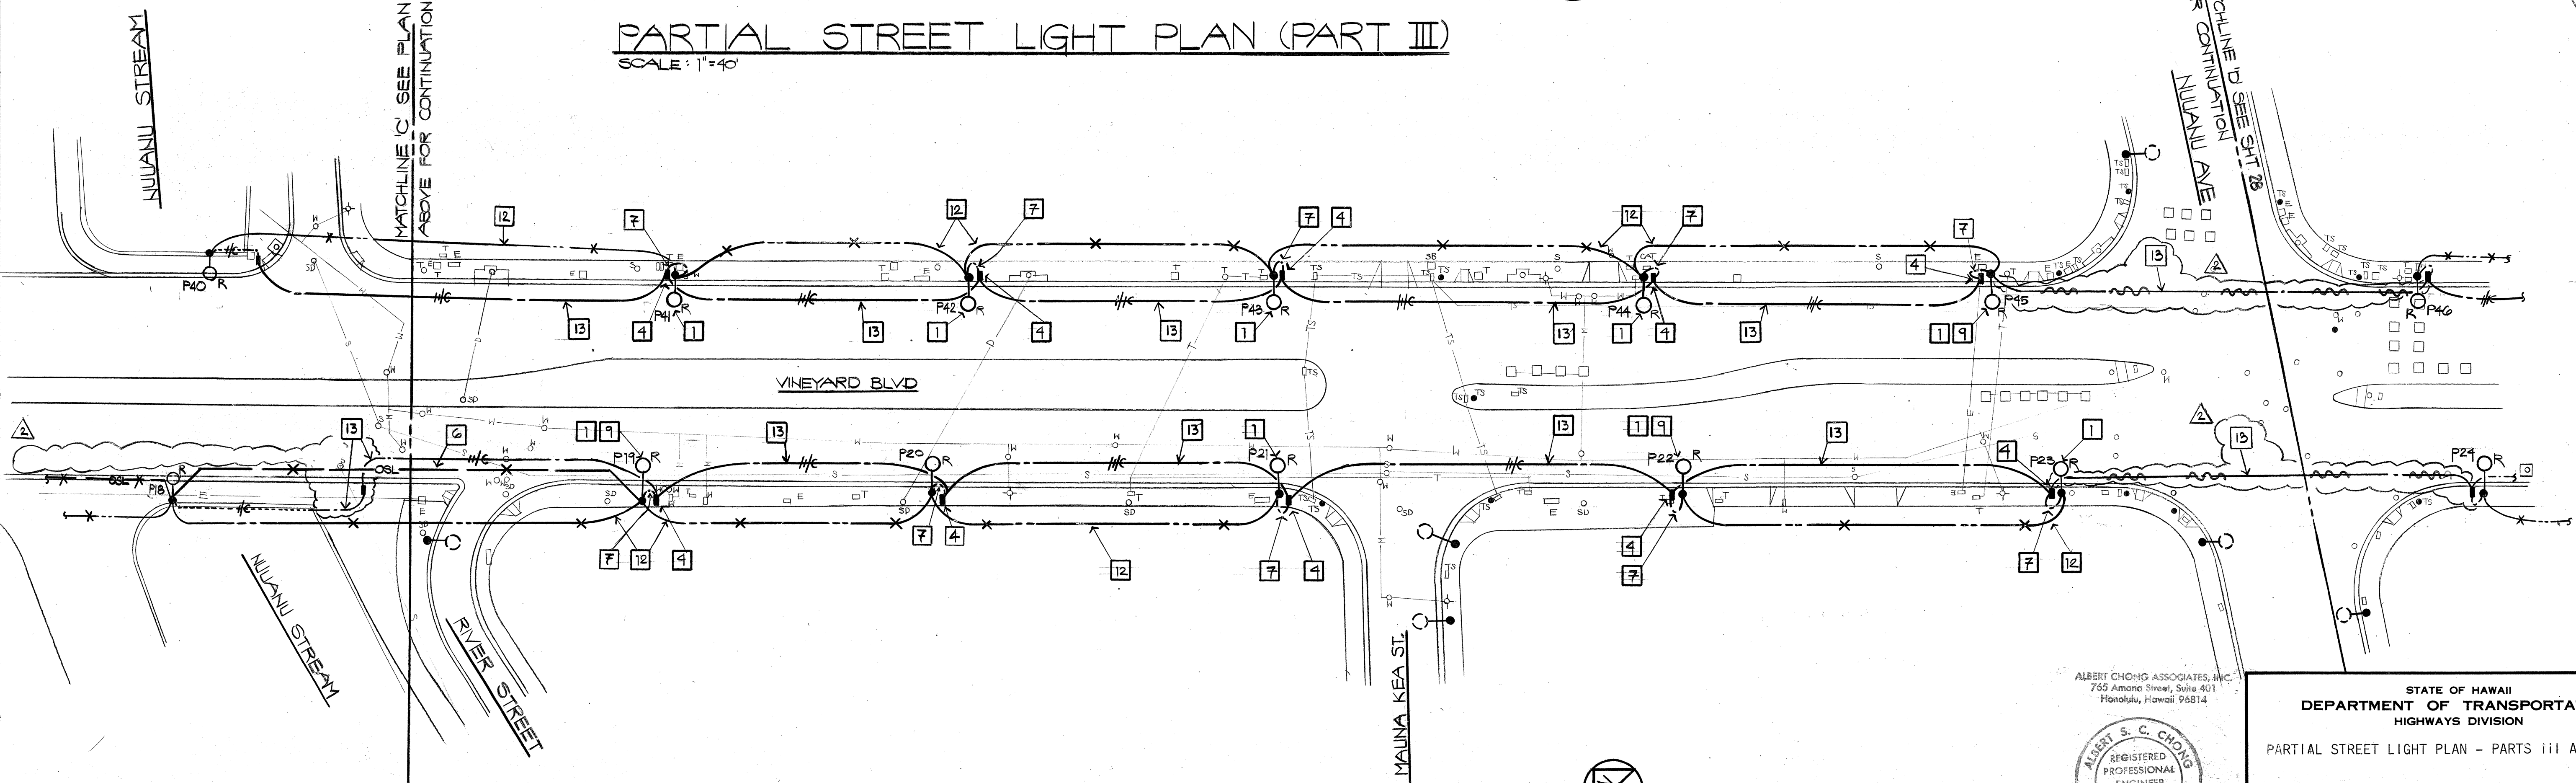

PARTIAL STREET LIGHT PLAN (PART IV)
SCALE: 1"=40'

DATE	DATE
SURVEY PLOTTED BY	SURVEY PLOTTED BY
DRAWN BY	DRAWN BY
TRACED BY	TRACED BY
DESIGNED BY	DESIGNED BY
CHECKED BY	CHECKED BY
ORIGINAL PLAN	ORIGINAL PLAN
NOTE BOOK	NOTE BOOK
No.	No.

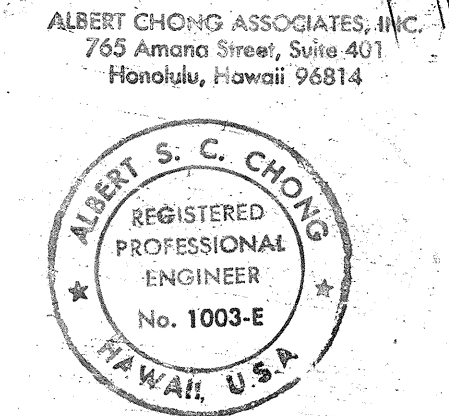

THIS WORK WAS PREPARED BY ME OR UNDER MY SUPERVISION

5-27-94	REVISED ST LT PLAN	
DATE	NO.	REVISION
		ENG

STATE OF HAWAII
DEPARTMENT OF TRANSPORTATION
HIGHWAYS DIVISION


PARTIAL STREET LIGHT PLAN - PARTS III AND IV

HIGHWAY LIGHTING IMPROVEMENTS AND REHABILITATION
VINEYARD BOULEVARD
PALAMA STREET TO PUNCHBOWL STREET


SHEET No. 27 OF 35 SHEETS

C.O. 27

FED. ROAD DIST. NO.	STATE	FED. AID PROJ. NO.	FISCAL YEAR	SHEET NO.	TOTAL SHEETS
HAWAII	HAW.	NH-098-1(9)	1993	28	35

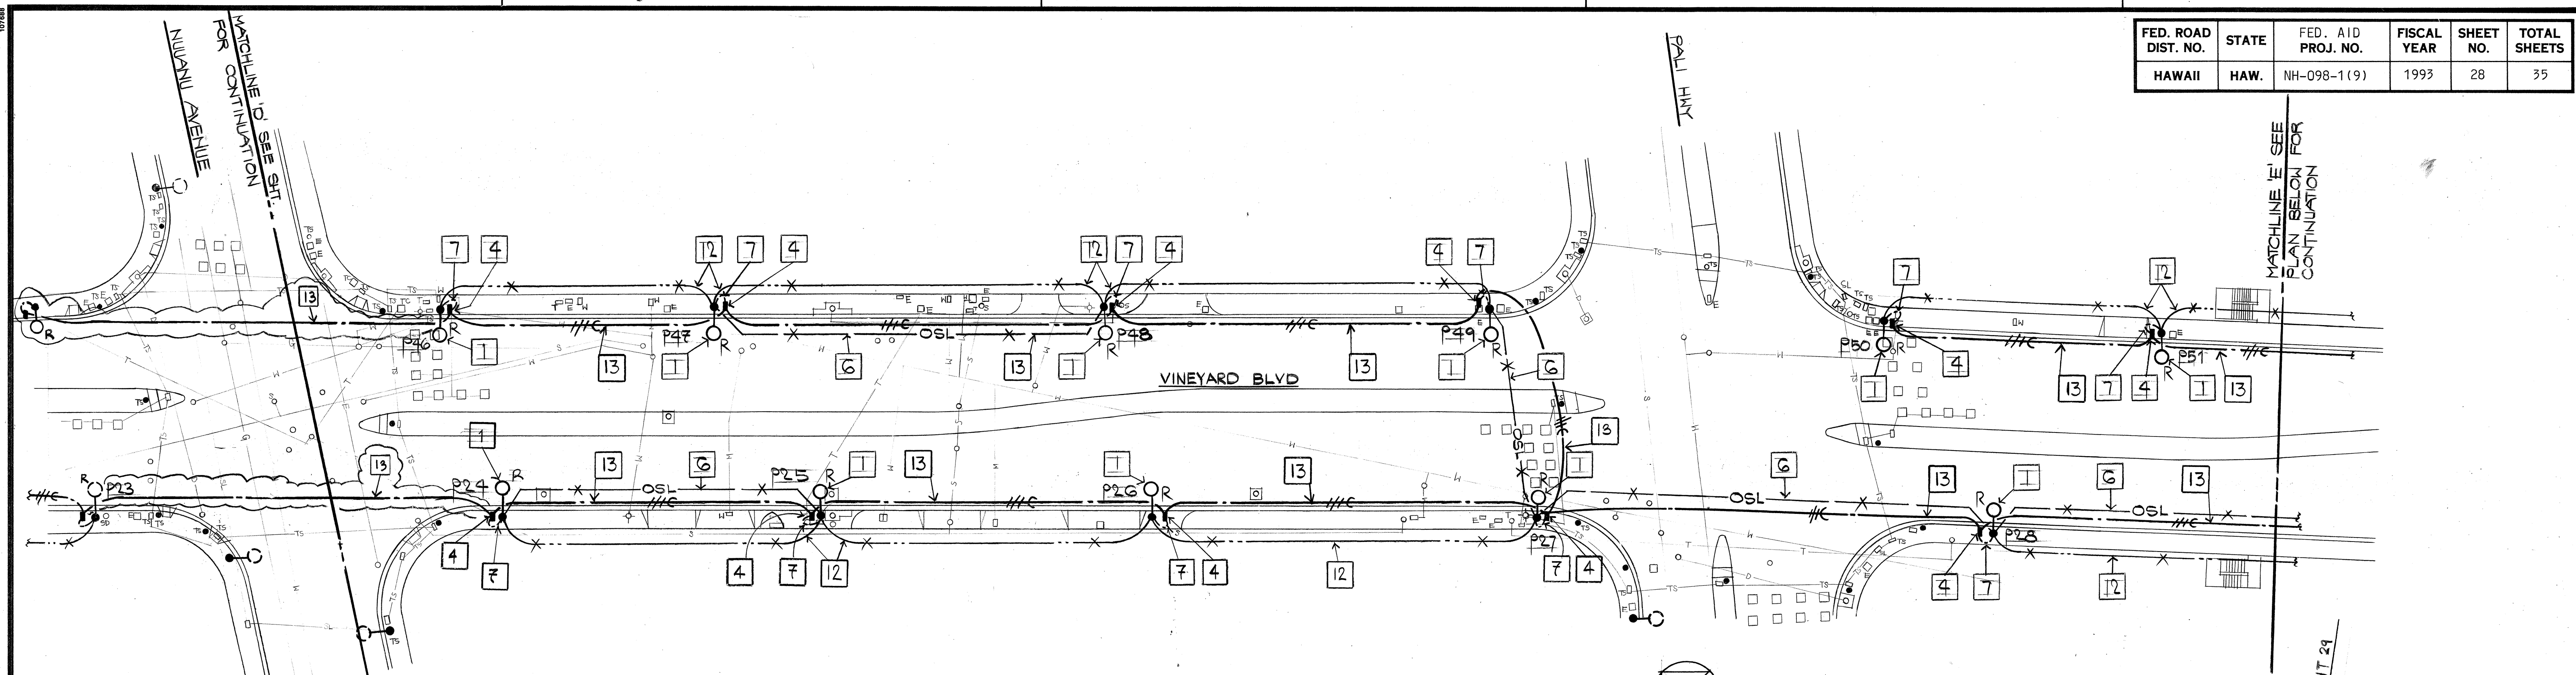


PARTIAL STREET LIGHT PLAN (PART V)
 SCALE: 1"=40'

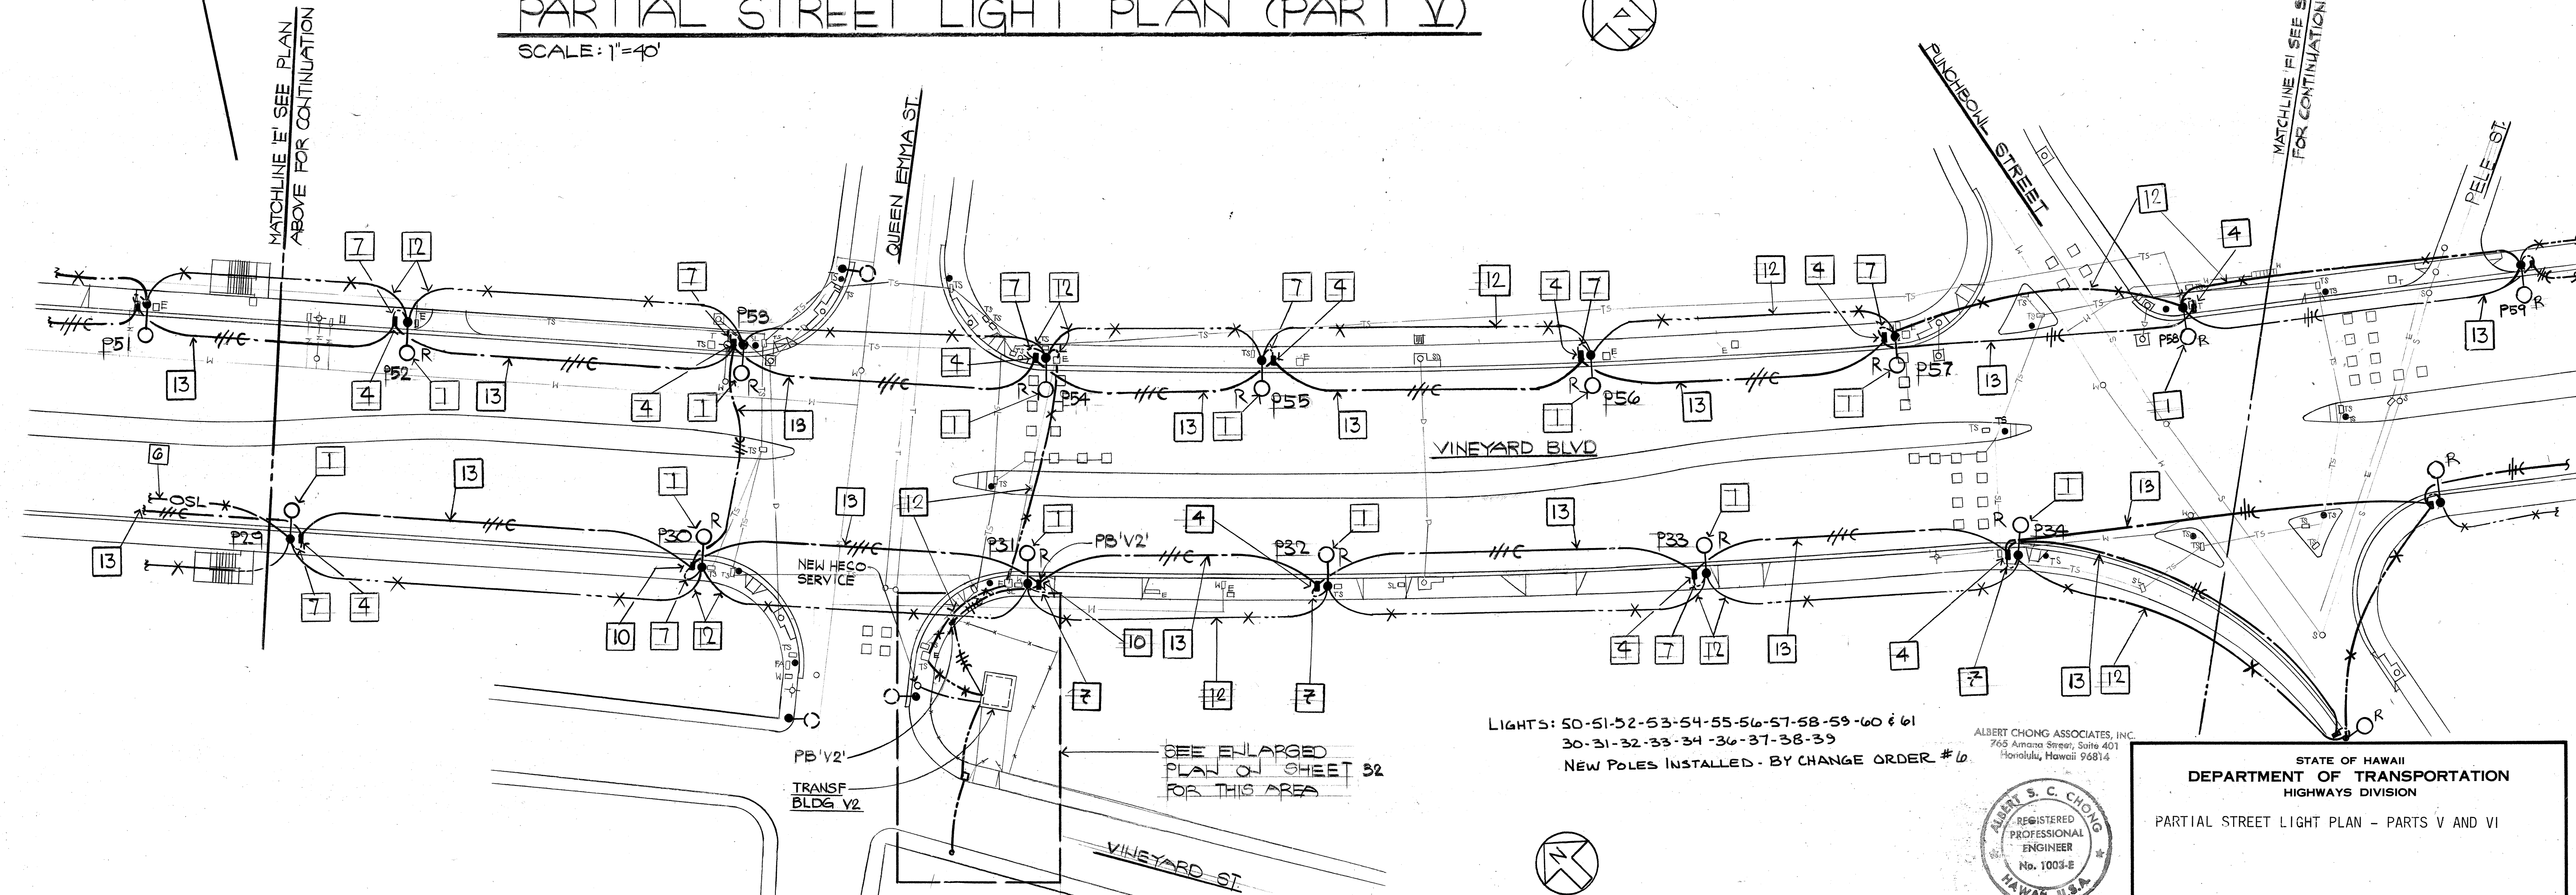

PARTIAL STREET LIGHT PLAN (PART VI)
 SCALE: 1"=40'

LIGHTS: 50-51-52-53-54-55-56-57-58-59-60 & 61
 30-31-32-33-34-36-37-38-39
 NEW POLES INSTALLED - BY CHANGE ORDER # 10

ALBERT CHONG ASSOCIATES, INC.
 765 Armand Street, Suite 401
 Honolulu, Hawaii 96814

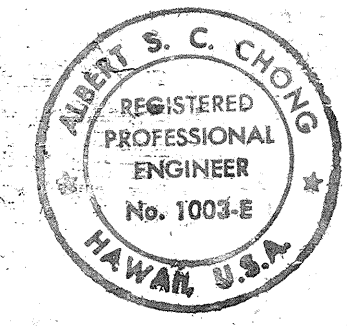

THIS WORK WAS PREPARED BY ME OR UNDER MY SUPERVISION
Albert S. C. Chong

STATE OF HAWAII
DEPARTMENT OF TRANSPORTATION
HIGHWAYS DIVISION


PARTIAL STREET LIGHT PLAN - PARTS V AND VI

HIGHWAY LIGHTING IMPROVEMENTS AND REHABILITATION
VINEYARD BOULEVARD
PALAMA STREET TO PUNCHBOWL STREET

5-27-94	2	REVISED ST LT PLAN	
DATE	NO.	REVISION	ENG


ORIGINAL PLAN	DATE
DRAWN BY	
DESIGNED BY	
CHECKED BY	
NO.	

FED. ROAD DIST. NO.	STATE	FED. AID PROJ. NO.	FISCAL YEAR	SHEET NO.	TOTAL SHEETS
HAWAII	HAW.	NH-098-1(9)	1993	29	35

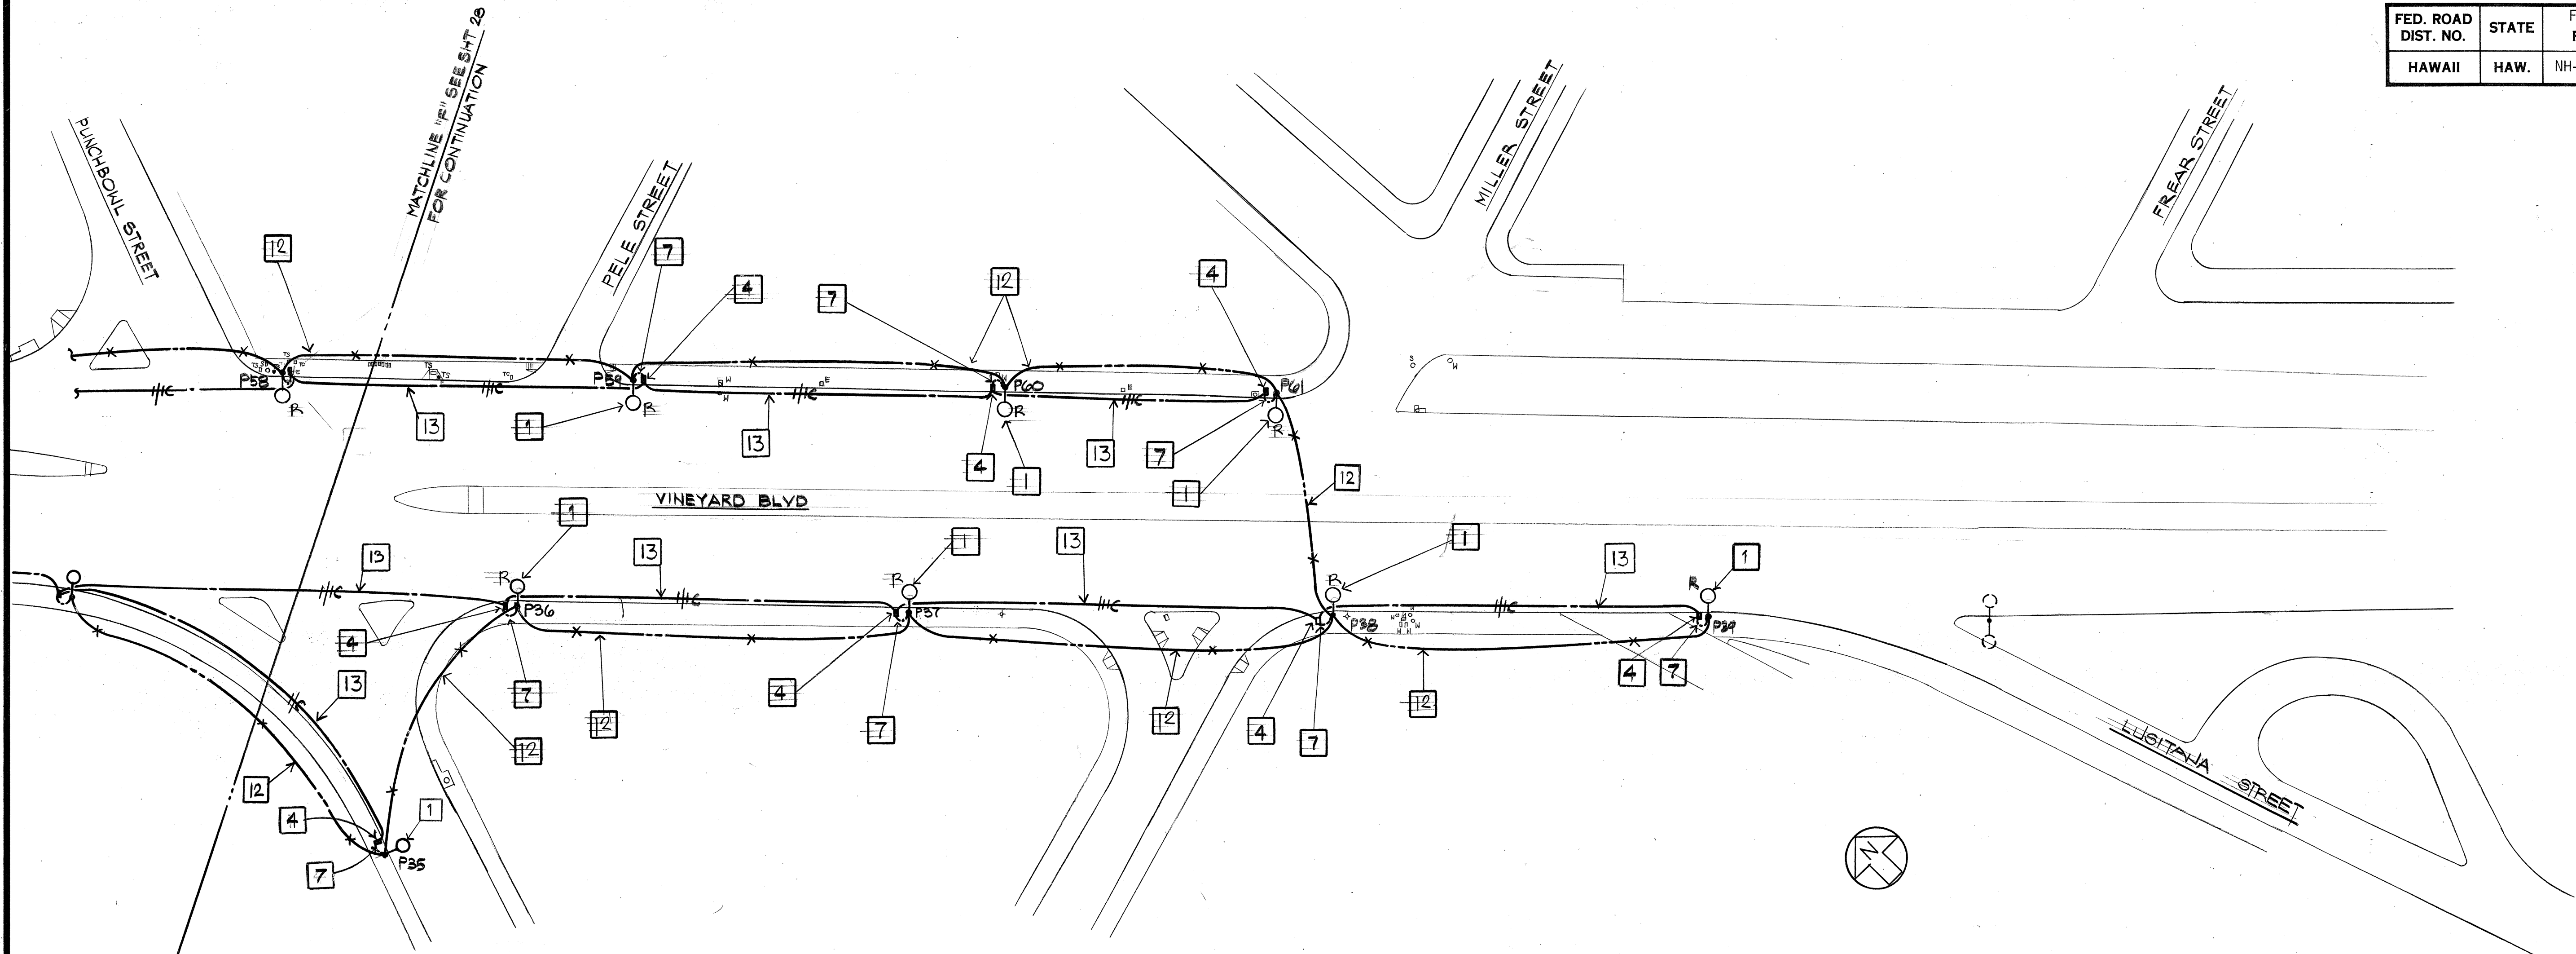

PARTIAL STREET LIGHT PLAN (PART VII)
 SCALE: 1" = 40'-0"

ORIGINAL PLAN	DATE
DESIGNED BY	
TRACED BY	
NOTED BY	
CHECKED BY	
NO.	

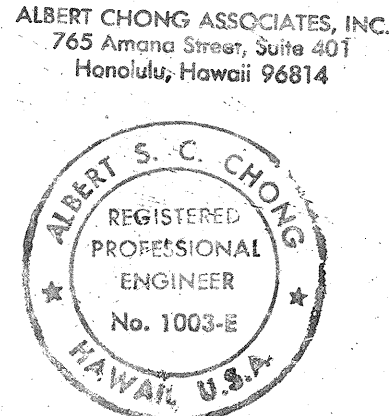

THIS WORK WAS PREPARED BY ME
 OR UNDER MY SUPERVISION
Albert S. C. Chong

STATE OF HAWAII
 DEPARTMENT OF TRANSPORTATION
 HIGHWAYS DIVISION
 PARTIAL STREET LIGHT PLAN - PART VII
 HIGHWAY LIGHTING IMPROVEMENTS AND REHABILITATION
 VINEYARD BOULEVARD
 PALAMA STREET TO PUNCHBOWL STREET