	INDEX TO DRAWINGS
	INDEX TO DRAWINGS
SHEET NO.	DESCRIPTION
24	TITLE SHEET
25	LOCATION PLAN AND ELECTRICAL SYMBOLS
26	PARTIAL STREET LIGHT PLAN-PARTS I AND II
27 ,	PARTIAL STREET LIGHT PLAN-PARTS III AND IV
28	PARTIAL STREET LIGHT PLAN-PARTS V AND VI
29	PARTIAL STREET LIGHT PLAN-PART VII
3.0	STREET LIGHT DIAGRAM
31	TRANSF BLDG V1-ELECTRICAL PLANS & ELEVATIONS
32	TRANSF BLDG V2-ELECTRICAL PLANS & ELEVATIONS
33	MISCELLANEOUS DETAILS
34	MISCELLANEOUS DETAILS
35	TRANSF BLDG V1 & V2:SINGLE LINE DIAGRAMS
	AND GENERAL NOTES

STATE OF HAWAII

DEPARTMENT OF TRANSPORTATION

HIGHWAYS DIVISION HONOLULU, HAWAII

"AS-BUILT"


Plans For

HIGHWAY LIGHTING IMPROVEMENTS & REHABILITATION

VINEYARD BOULEVARD: PALAMA STREET TO PUNCHBOWL STREET

Project No.: NH - 098 - 1 (9)


DISTRICT of HONOLULU, ISLAND of OAHU

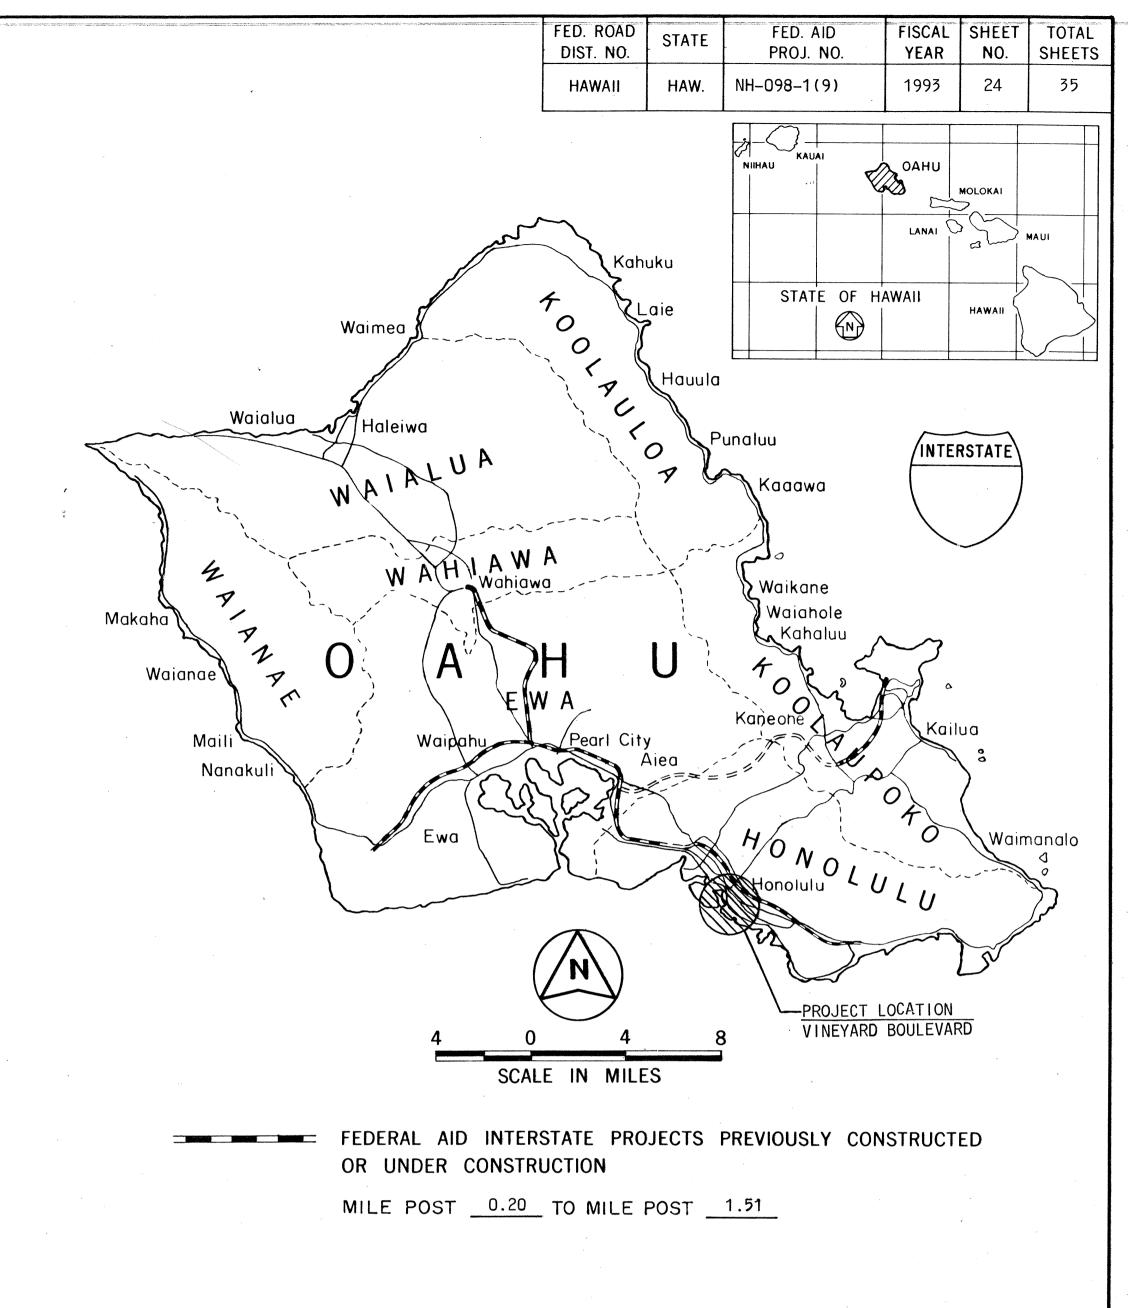

CHANGES MADE DURING CONSTRUCTION HAVE BEEN INCORPORATED ON THESE PLANS EXCEPT CHANGES IN THE ORIGINAL THEORETICAL QUANTITIES. FOR ACTUAL QUANTITIES, REFER TO PROJECT LEDGER AND/OR COMPUTATION BOOK.

RESIDENT ENGINEER

DATE

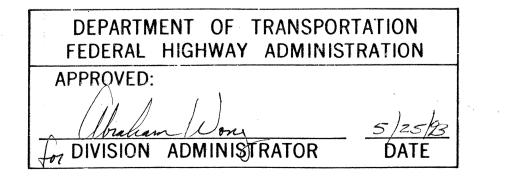

DEPARTMENT OF TRANSPORTATION
STATE OF HAWAII

APPROVED:

5/18/93

FIR DIR. OF TRANSPORTATION

DATE