

Begin Resurfacing
Ramp "R-3" Sta. 4+19.5

Halona St.
Cold Plane 1"
Reconstruct 4"

"R-3" P.C. Sta. 3+29.05

"R-3" P.T. Sta. 1+81.51

HALONA ST. Sta. 5+96.34
Begin Ramp "R-3"
P.C. Sta. 0+00 =

TRUE NORTH
SCALE: 1" = 40'

Limits of Resurfacing

610'x12'

141'00"00"

314'28"00"

324'52"00"

Westbound

Limits of Resurfacing

Ramp "R-3"
Cold Plane 1/2"

INTERSTATE ROUTE H-1

OLOMEA STREET

Limits of Resurfacing

Limits of Resurfacing

BEGIN PROJECT
M.P. 0.00

Begin Resurfacing
Olomea Street Sta. 19+00

Olomea Street
Cold Plane 1/2"
Reconstruct 6"

LEGEND

- Cold Plane Area over existing P.C.C.
- Reconstruction Area
- New Paved Area over existing P.C.C.

Begin Resurfacing
Ramp "R-3" Sta. 4+19.5

Halona St.
Cold Plane 1"
Reconstruct 4"

"R-3" P.C. Sta. 3+29.05

"R-3" P.T. Sta. 1+81.51

HALONA ST. Sta. 5+96.34
Begin Ramp "R-3"
P.C. Sta. 0+00 =

TRUE NORTH
SCALE: 1" = 40'

Limits of Resurfacing

Auto Lane

"R-3" P.T. Sta. 4+77.98

Limits of Resurfacing

610'x12'

141'00'00"

314'28'00"

Ramp "R-3"

INTERSTATE ROUTE H-1

Limits of Resurfacing

Westbound

20'x12'

St. Mon.

20+00

"0" Sta. 20+38.60

"0" P.C. Sta. 21+11.63

OLOMEA STREET

Ico Lane

Limits of Resurfacing

Limits of Resurfacing

BEGIN PROJECT
M.P. 0.00


Begin Resurfacing
Olomea Street Sta. 19+00

Olomea Street
Cold Plane 1/2"
Reconstruct 6"

LEGEND

- Cold Plane Area over existing P.C.C.
- Reconstruction Area
- New Paved Area over existing P.C.C.



FED. ROAD DIST. NO.	STATE	FED. AID PROJ. NO.	FISCAL YEAR	SHEET NO.	TOTAL SHEETS
HAWAII	HAW.	STP-098-1(10)	1993	ADD. 9	35

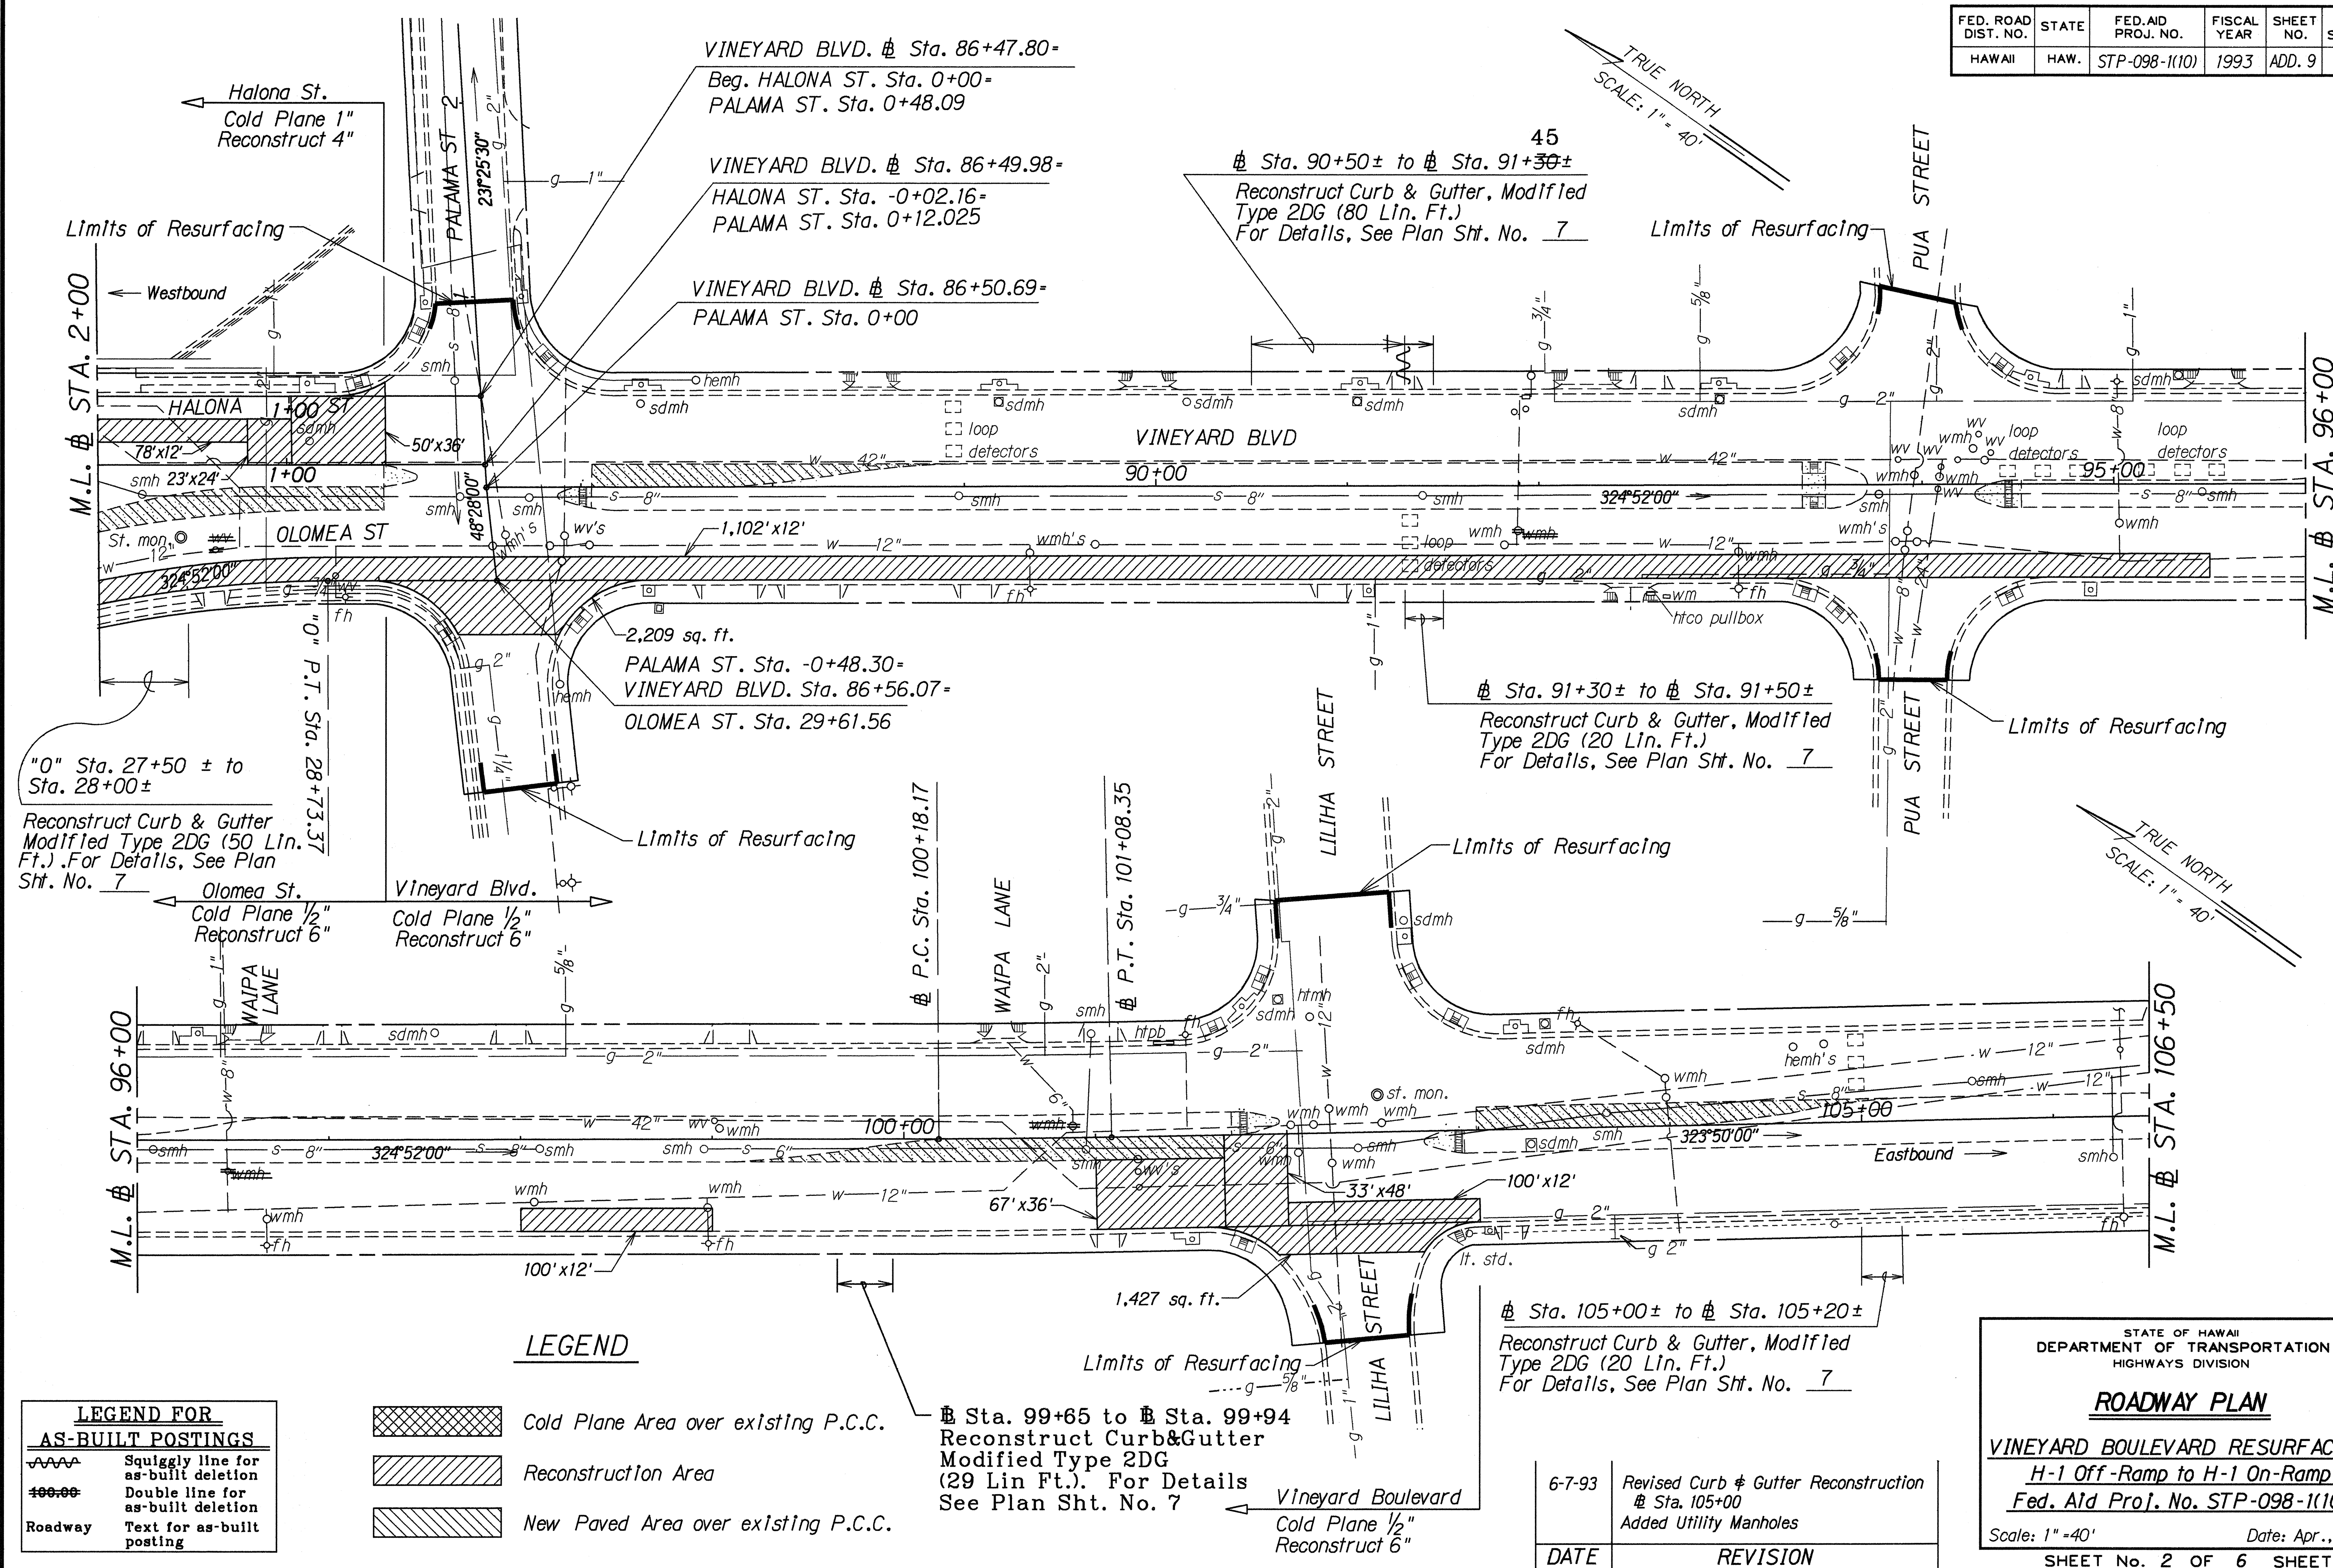

"AS-BUILT"

ADD. 9

FED. ROAD DIST. NO.	STATE	FED. AID PROJ. NO.	FISCAL YEAR	SHEET NO.	TOTAL SHEETS
HAWAII	HAW.	STP-098-1(10)	1993	C.O. 10	35

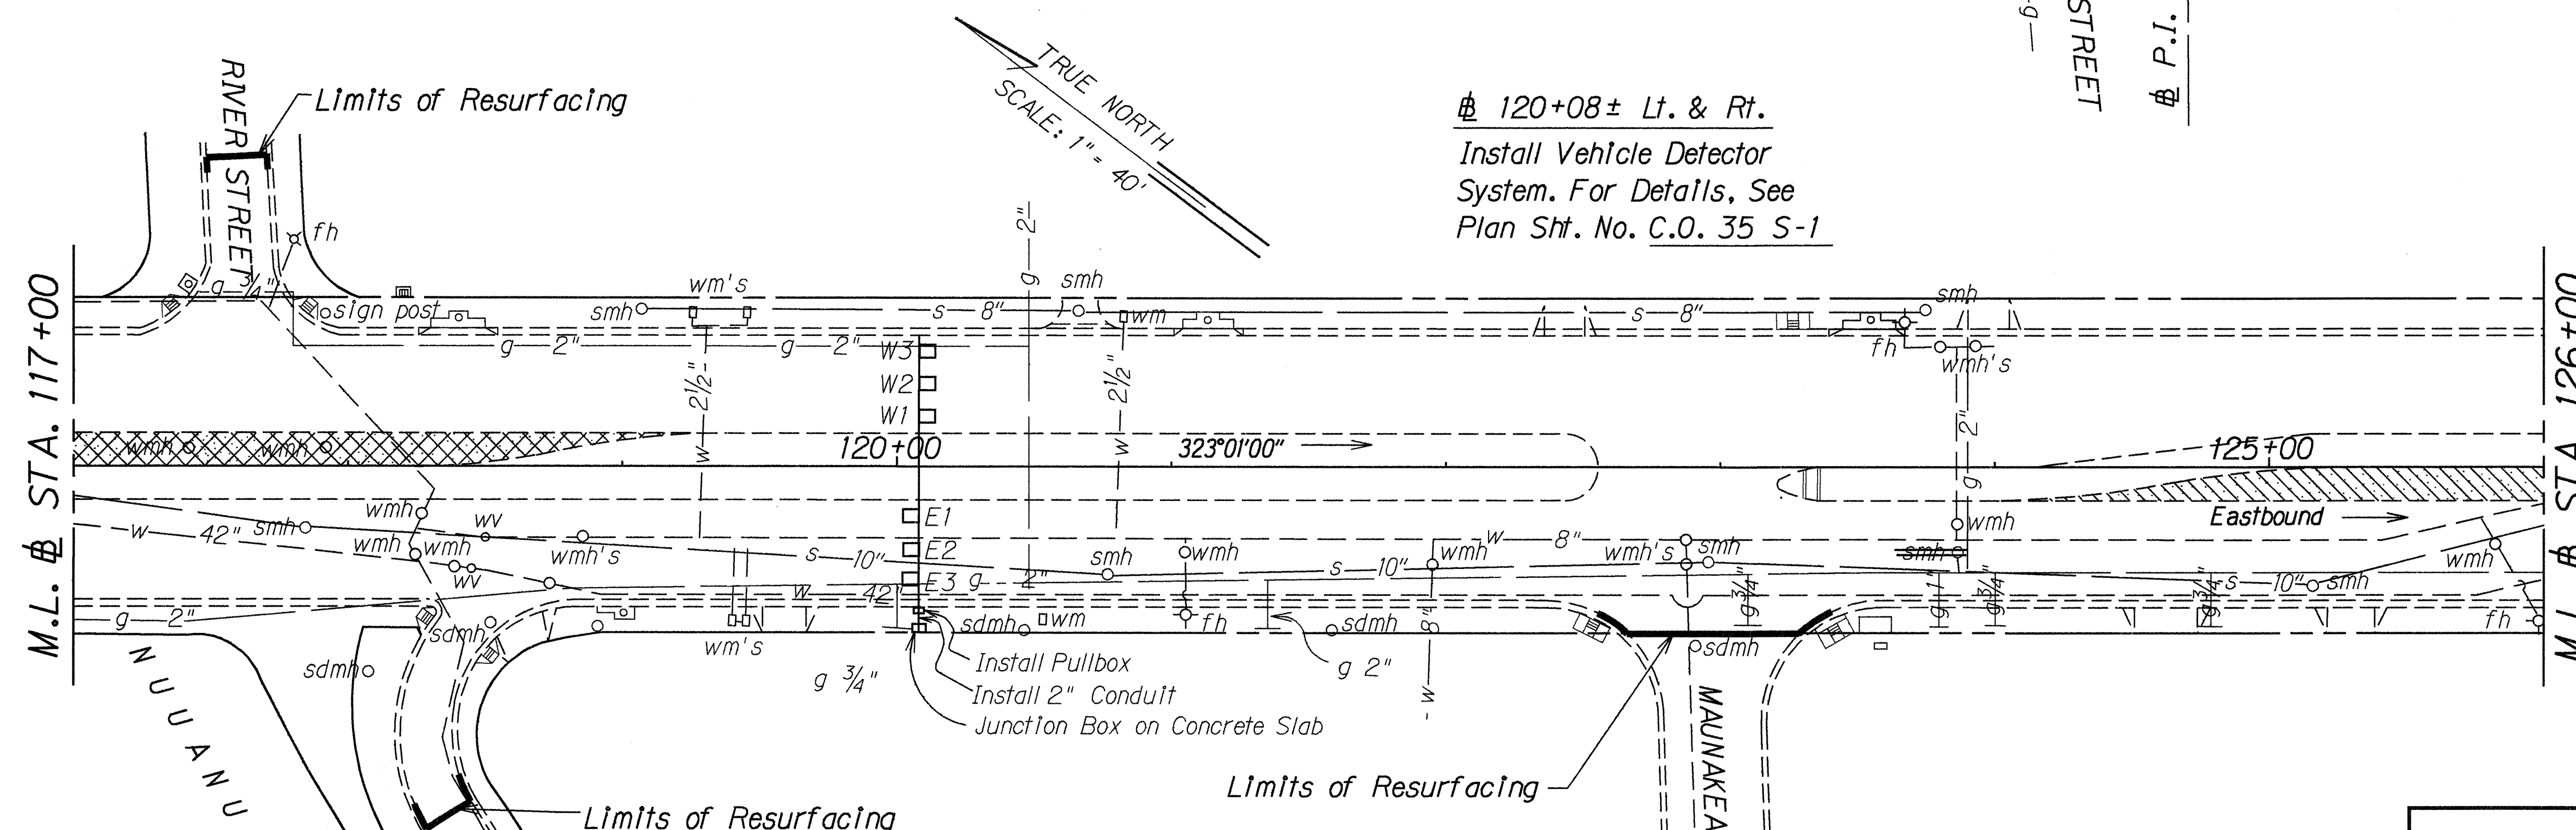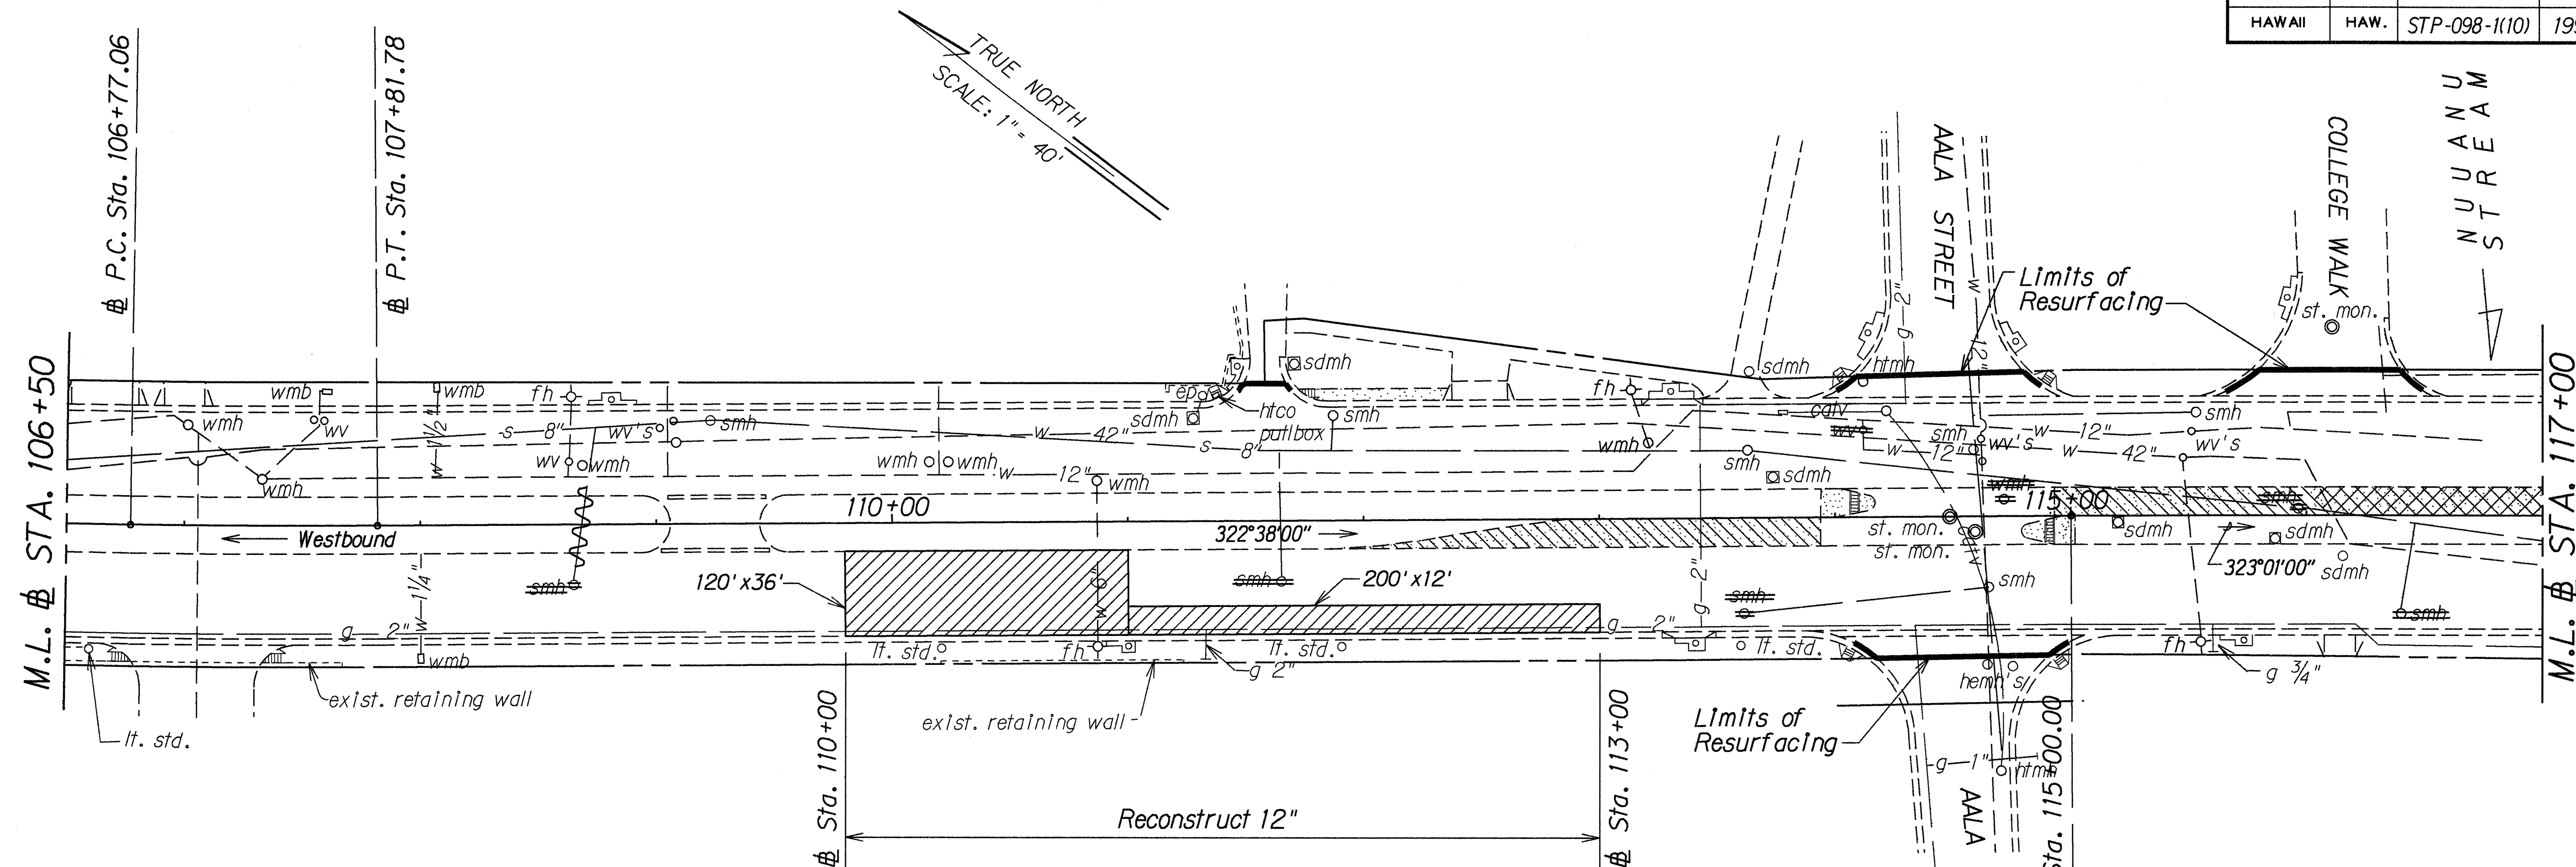

120+08± Lt. & Rt.
 Install Vehicle Detector
 System. For Details, See
 Plan Sht. No. C.O. 35 S-1

LEGEND FOR AS-BUILT POSTINGS	
	Squiggly line for as-built deletion
	Double line for as-built deletion
Roadway	Text for as-built posting

LEGEND	
	Cold Plane Area over existing P.C.C.
	Reconstruction Area
	New Paved Area over existing P.C.C.


DATE	REVISION
11/23/93	Added Installation of Vehicle Detector System

STATE OF HAWAII DEPARTMENT OF TRANSPORTATION HIGHWAYS DIVISION	
ROADWAY PLAN	
VINEYARD BOULEVARD RESURFACING	
H-1 Off-Ramp to H-1 On-Ramp	
Fed. Aid Proj. No. STP-098-1(10)	
Scale: 1" = 40'	Date: Apr., 1993
SHEET No. 3 OF 6 SHEETS	

"AS-BUILT"

C.O. 10

FED. ROAD DIST. NO.	STATE	FED. AID PROJ. NO.	FISCAL YEAR	SHEET NO.	TOTAL SHEETS
HAWAII	HAW.	STP-098-1(10)	1993	11	35

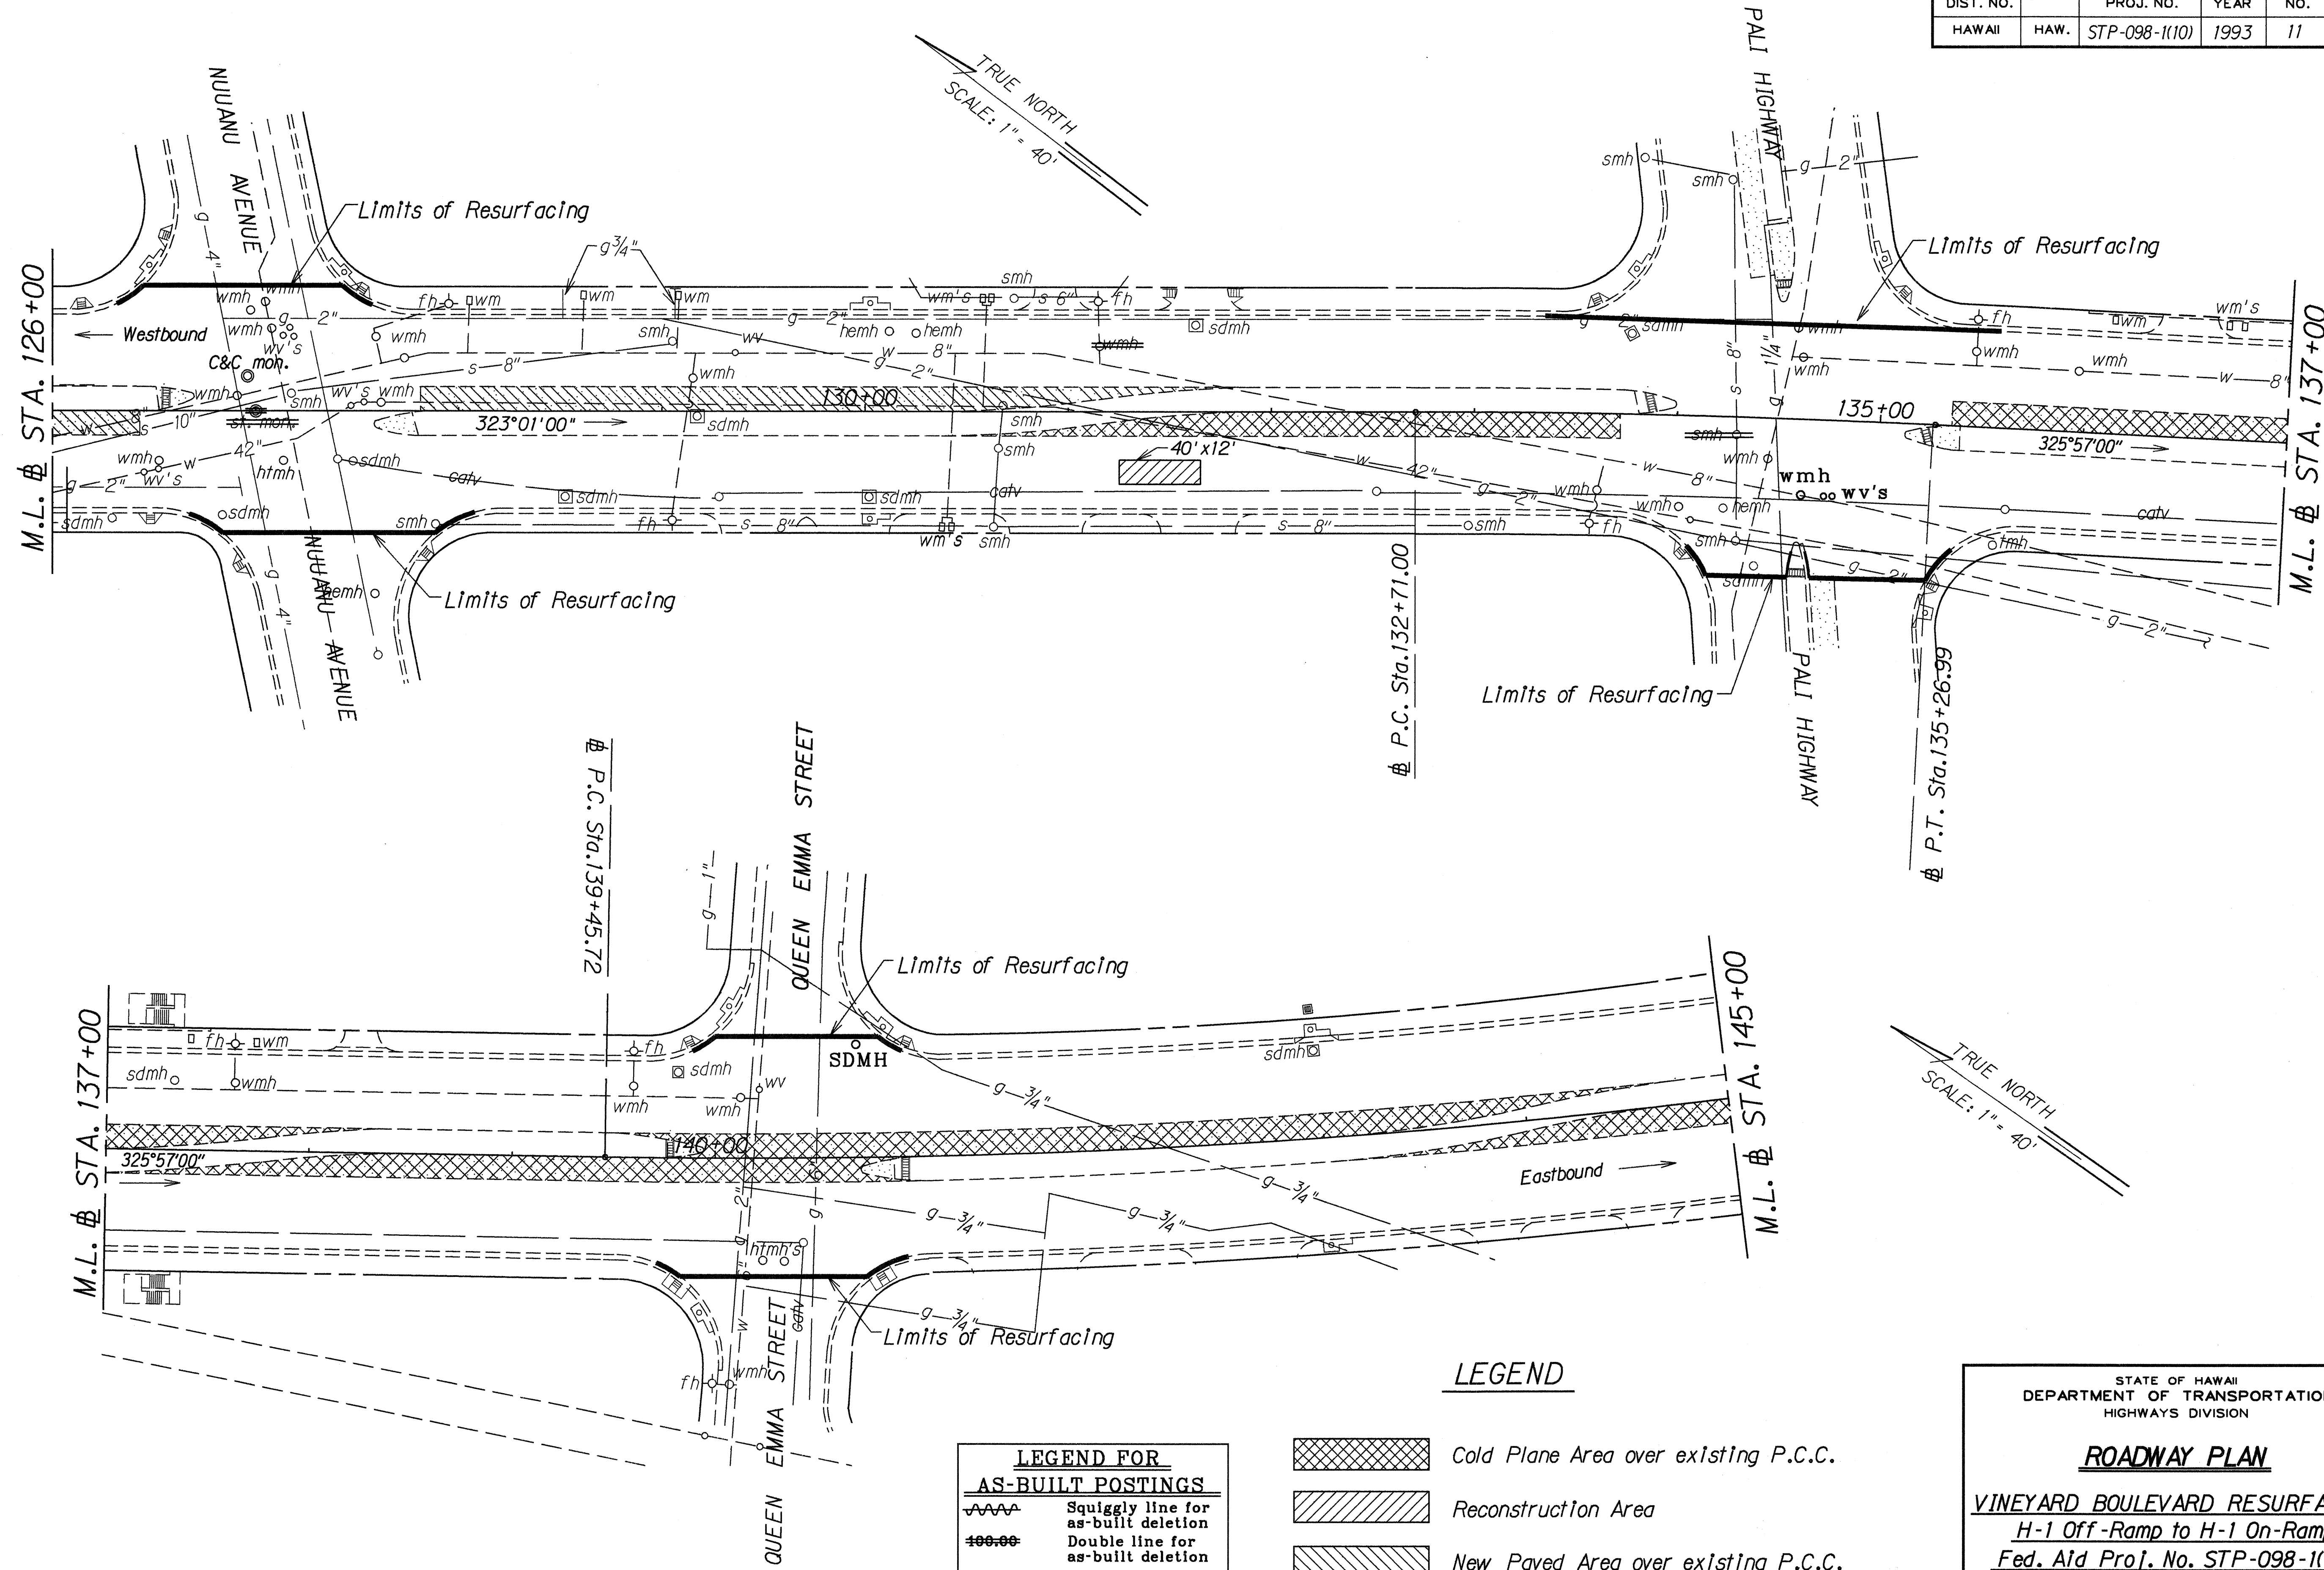

ORIGINAL PLAN	DATE
NOTED BY	4/2/93
DESIGNED BY	
CHECKED BY	

LEGEND FOR AS-BUILT POSTINGS	
	Squiggly line for as-built deletion
	Double line for as-built deletion
Roadway	Text for as-built posting

	Cold Plane Area over existing P.C.C.
	Reconstruction Area
	New Paved Area over existing P.C.C.


LEGEND

STATE OF HAWAII
DEPARTMENT OF TRANSPORTATION
HIGHWAYS DIVISION

ROADWAY PLAN
VINEYARD BOULEVARD RESURFACING
H-1 Off-Ramp to H-1 On-Ramp
Fed. Aid Proj. No. STP-098-1(10)
Scale: 1"=40' Date: Apr., 1993
SHEET No. 4 OF 6 SHEETS

"AS-BUILT"

FED. ROAD DIST. NO.	STATE	FED. AID PROJ. NO.	FISCAL YEAR	SHEET NO.	TOTAL SHEETS
HAWAII	HAW.	STP-098-1(10)	1993	12	35

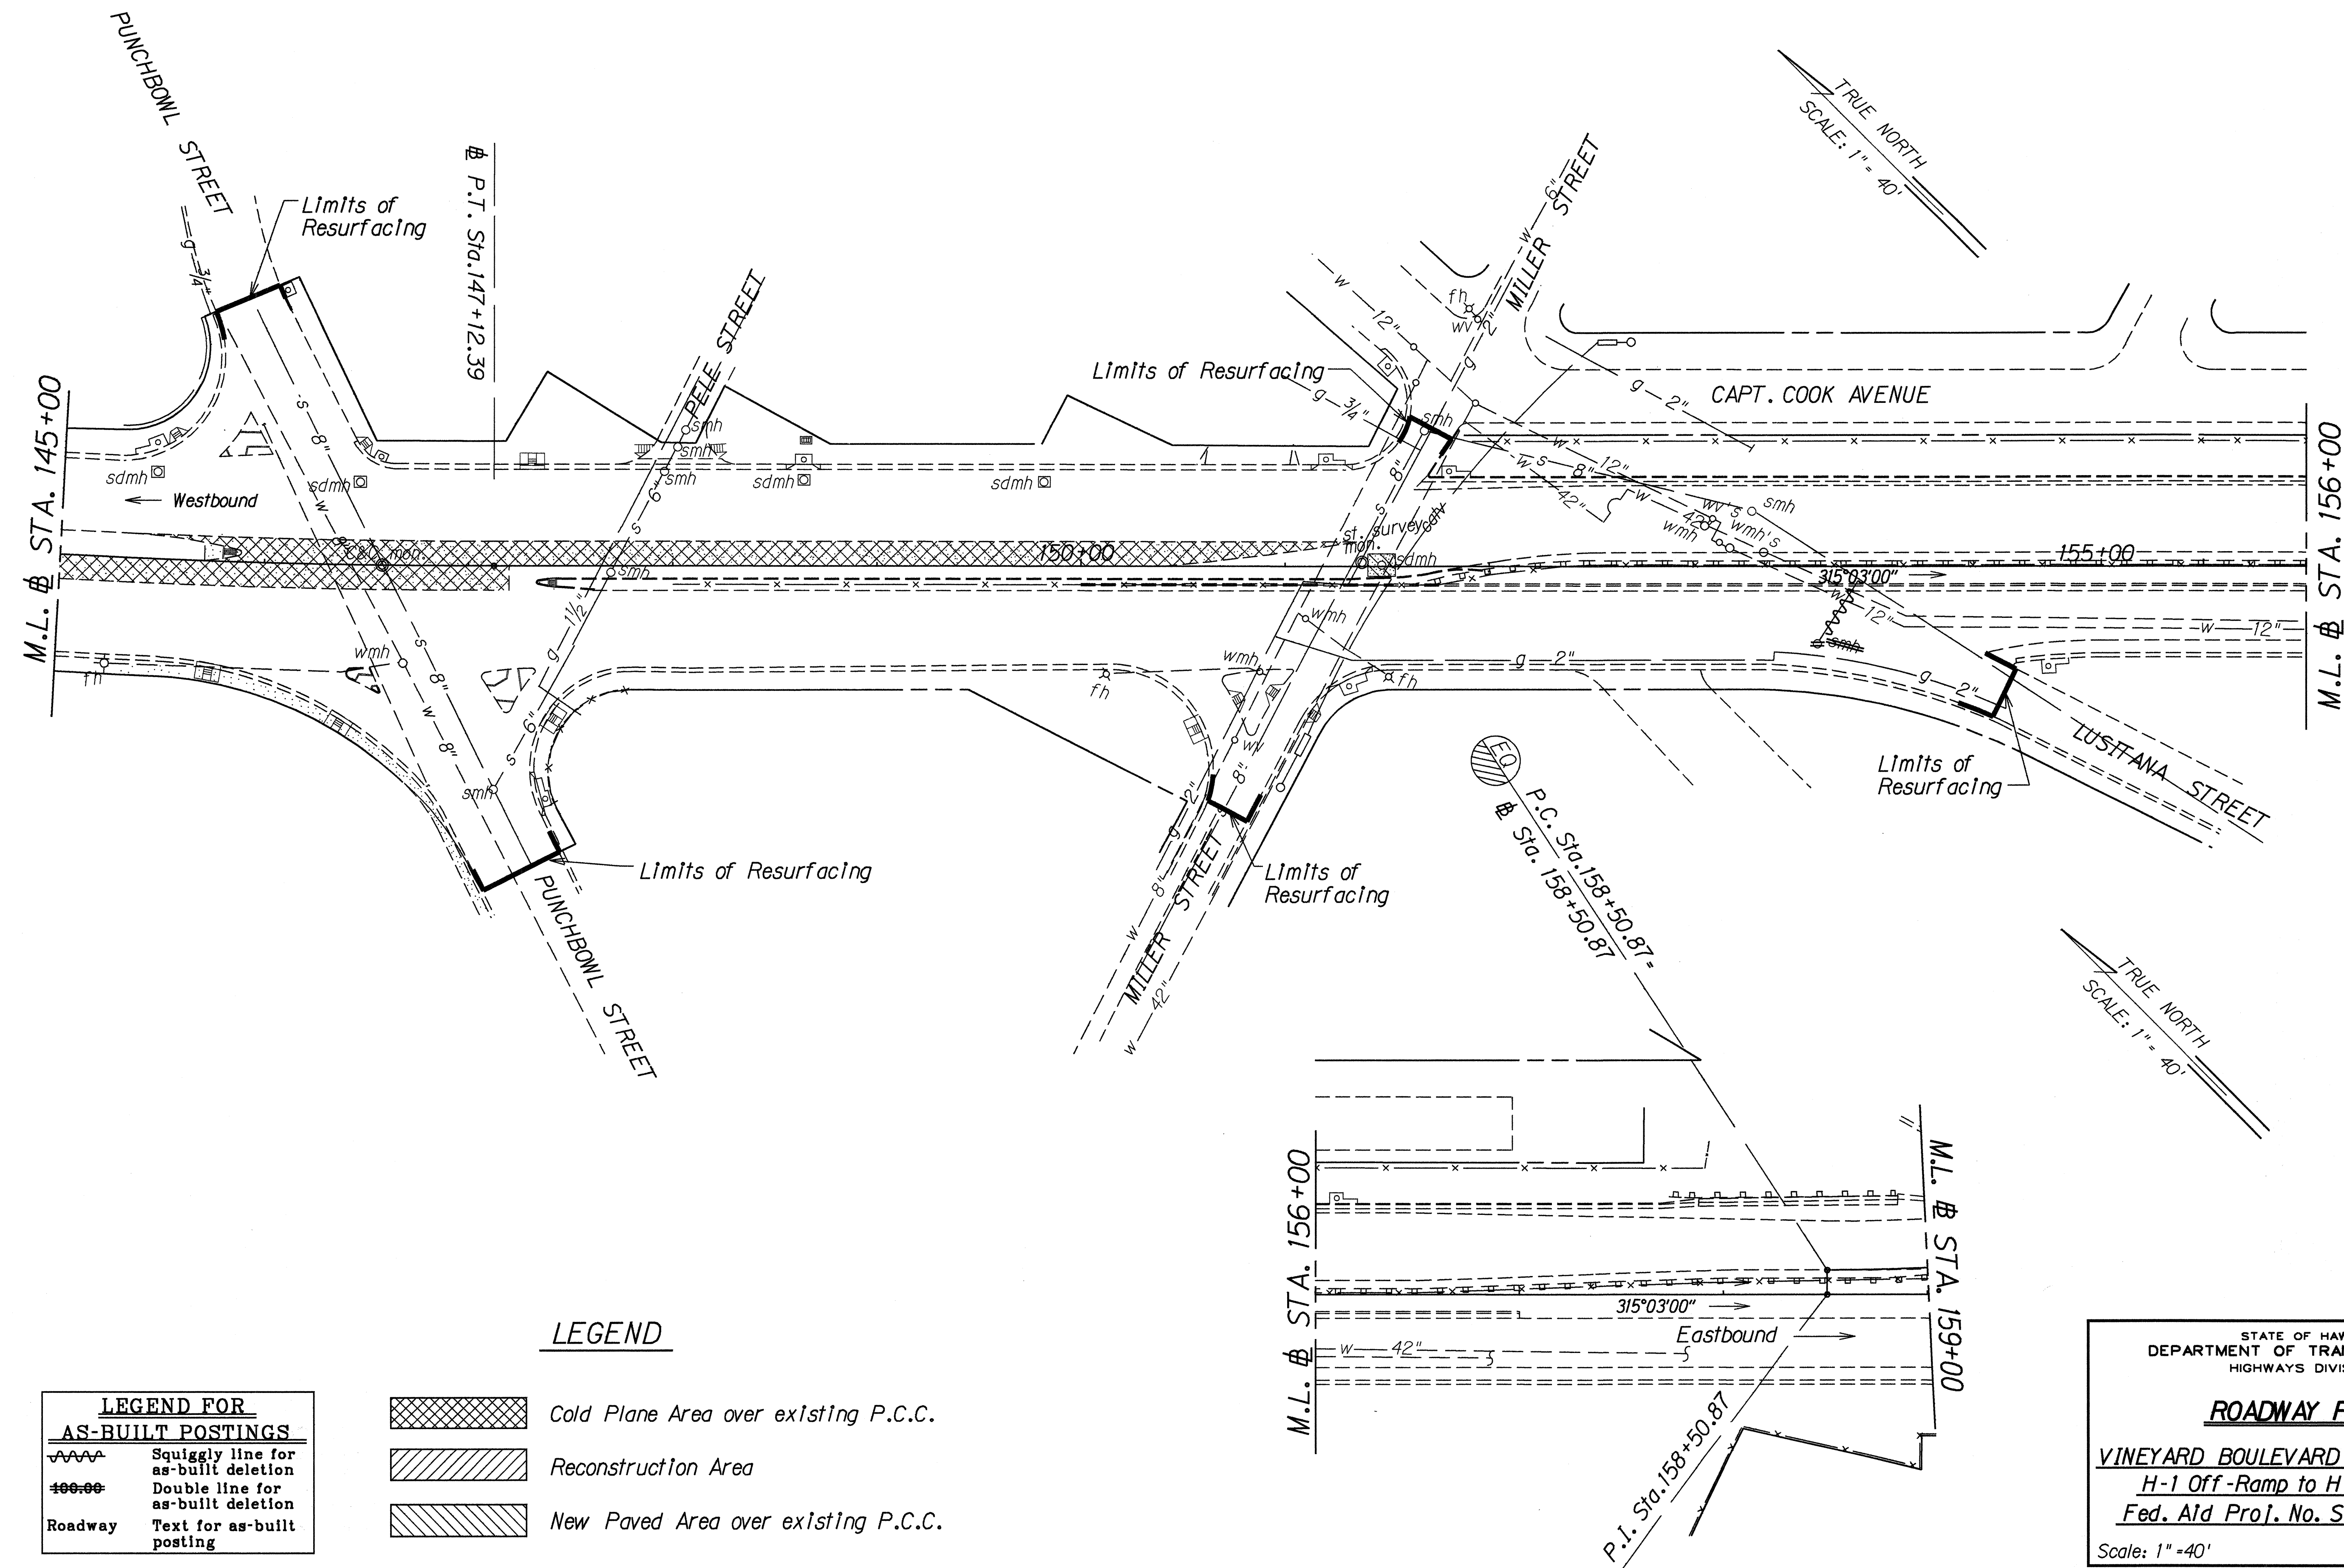

ORIGINAL PLAN	SURVEY PLOTTED BY	DATE
NOTE BOOK	DRAWN BY	4/22/93
DESIGNED BY	DESIGNED BY	
CHECKED BY	CHECKED BY	

LEGEND

LEGEND FOR AS-BUILT POSTINGS	
	Squiggly line for as-built deletion
	Double line for as-built deletion
	Roadway Text for as-built posting


	Cold Plane Area over existing P.C.C.
	Reconstruction Area
	New Paved Area over existing P.C.C.

STATE OF HAWAII DEPARTMENT OF TRANSPORTATION HIGHWAYS DIVISION	
ROADWAY PLAN	
VINEYARD BOULEVARD RESURFACING	
H-1 Off-Ramp to H-1 On-Ramp	
Fed. Aid Proj. No. STP-098-1(10)	
Scale: 1" = 40'	Date: Apr., 1993
SHEET No. 5 OF 6 SHEETS	

"AS-BUILT"

12

FED. ROAD DIST. NO.	STATE	FED. AID PROJ. NO.	FISCAL YEAR	SHEET NO.	TOTAL SHEETS
HAWAII	HAW.	STP-098-1(10)	1993	13	35

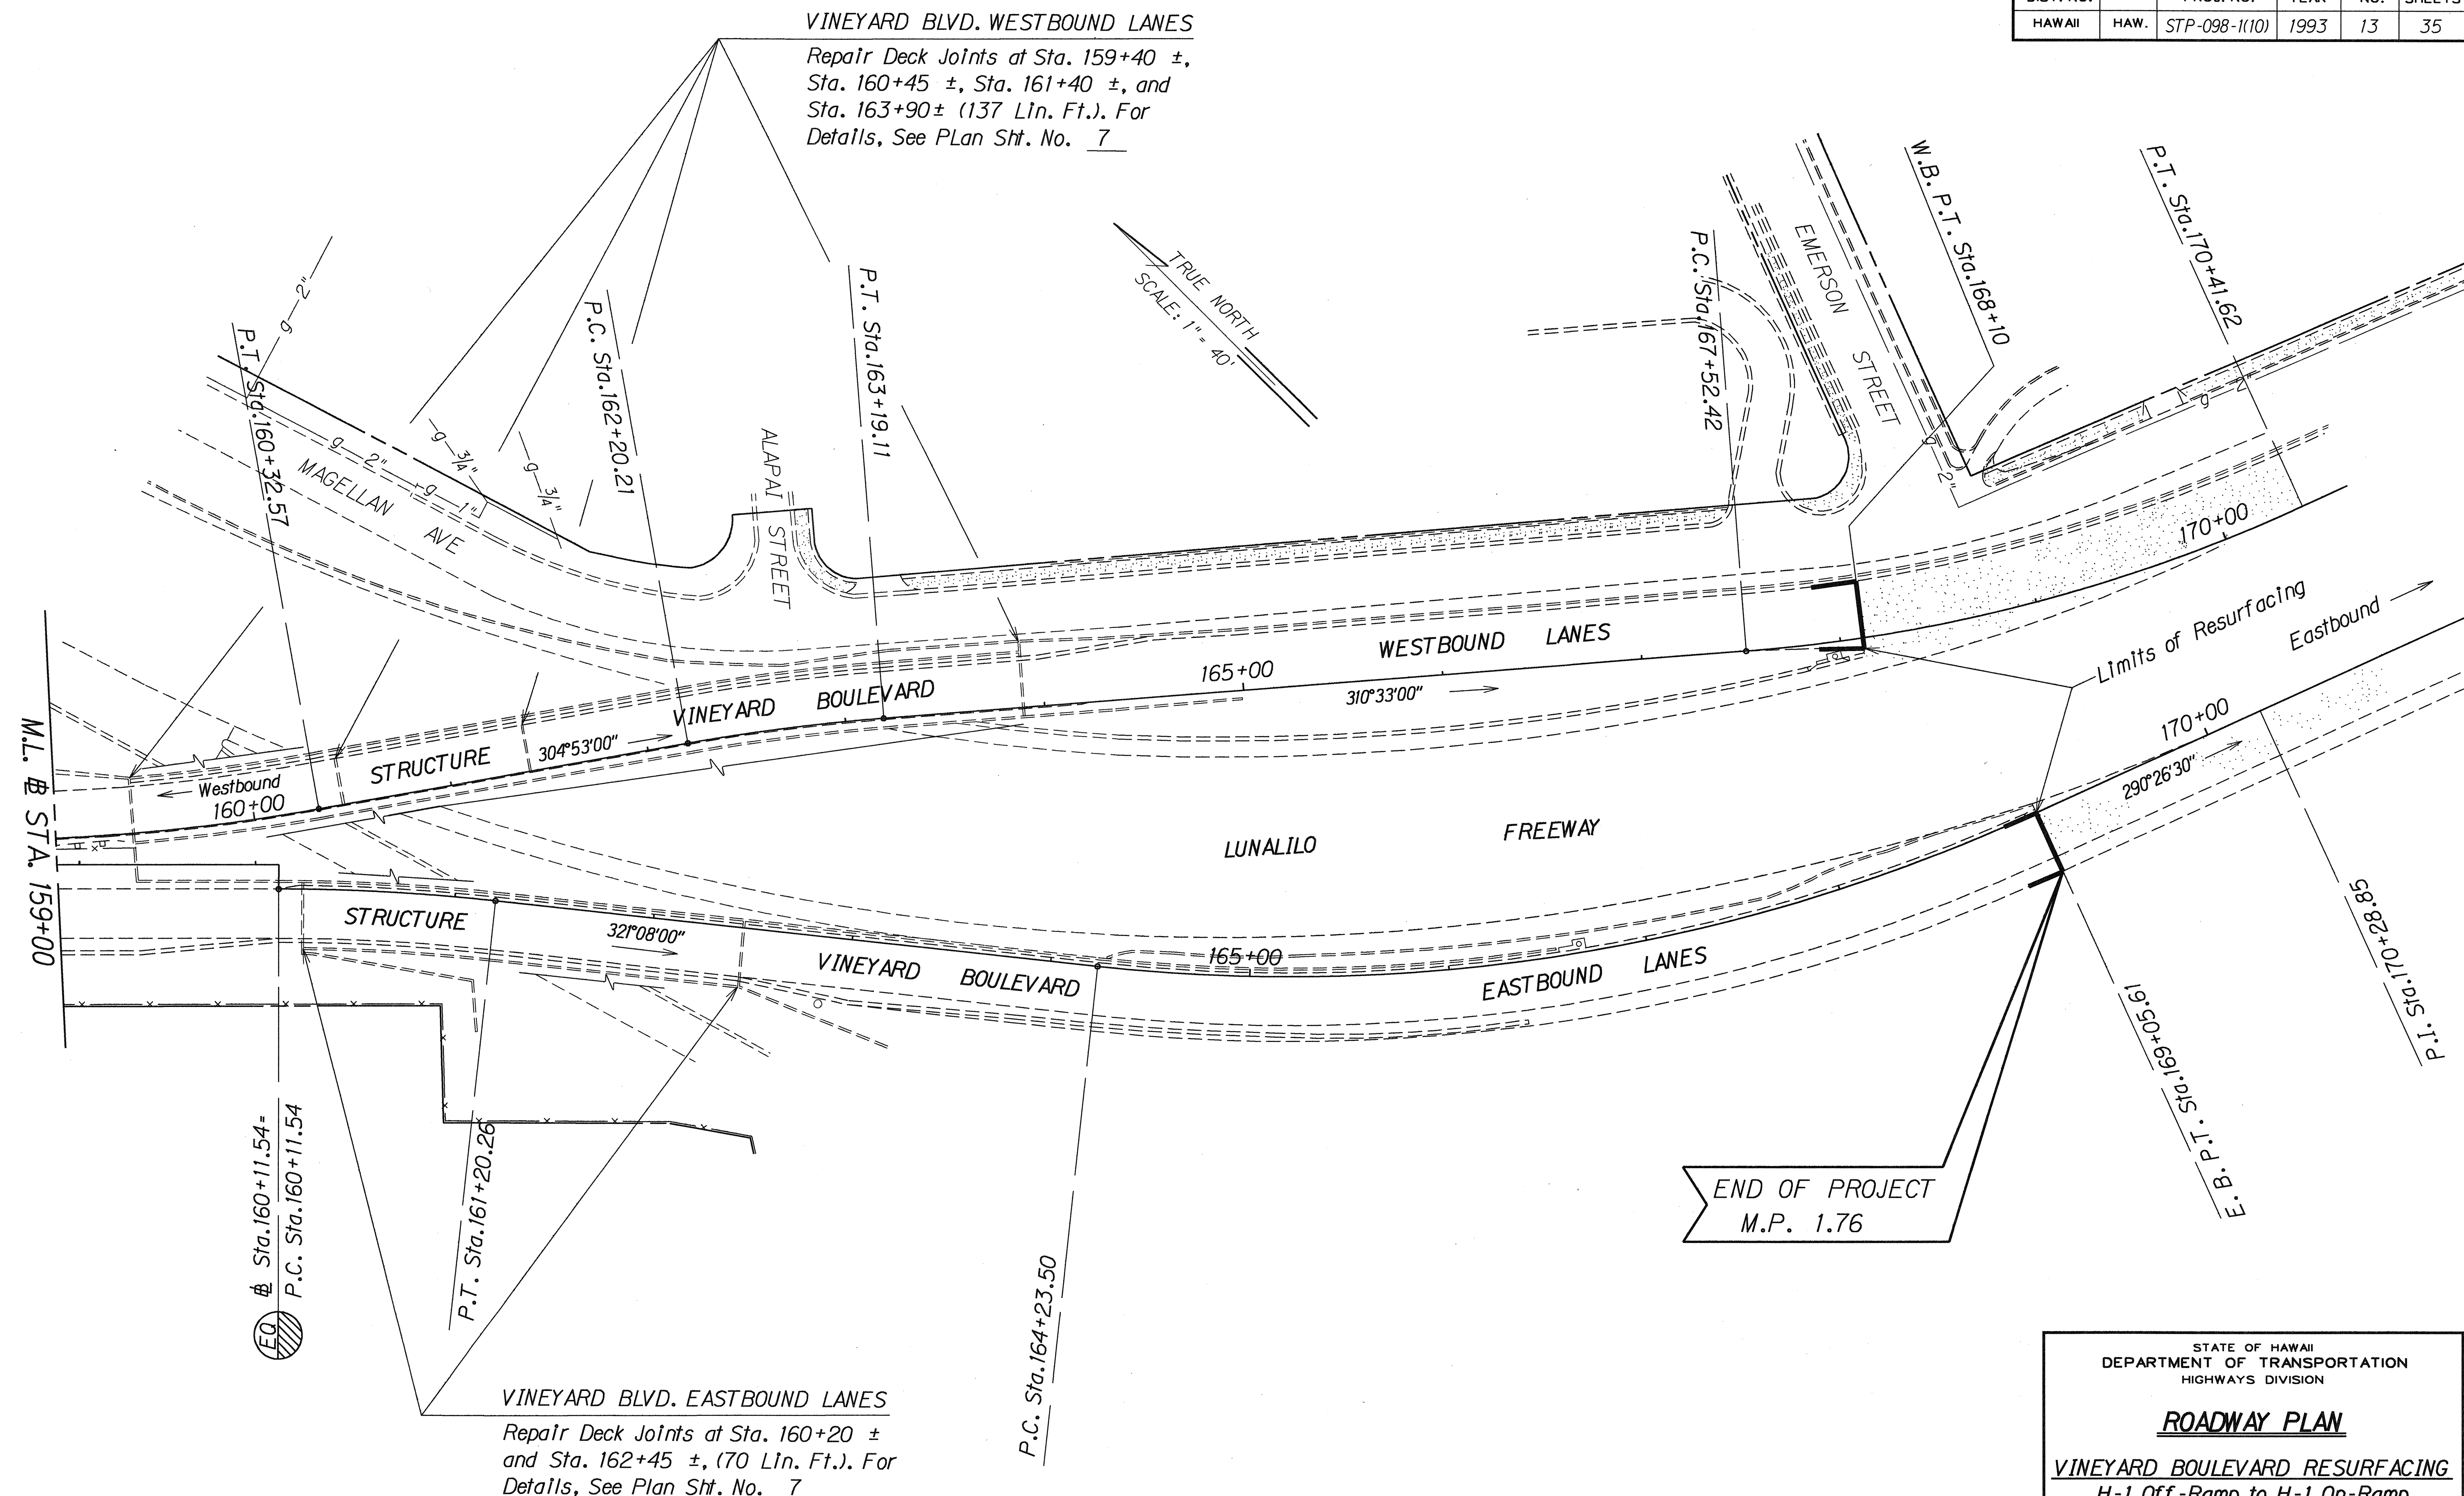

ORIGINAL PLAN	DATE
NOTED BY	4/2/93
DESIGNED BY	
CHECKED BY	
QUANTITIES BY	
NOTED BY	

STATE OF HAWAII
 DEPARTMENT OF TRANSPORTATION
 HIGHWAYS DIVISION

ROADWAY PLAN

VINEYARD BOULEVARD RESURFACING
 H-1 Off-Ramp to H-1 On-Ramp
 Fed. Aid Proj. No. STP-098-1(10)

Scale: 1" = 40' Date: Apr., 1993

SHEET NO. 6 OF 6 SHEETS