

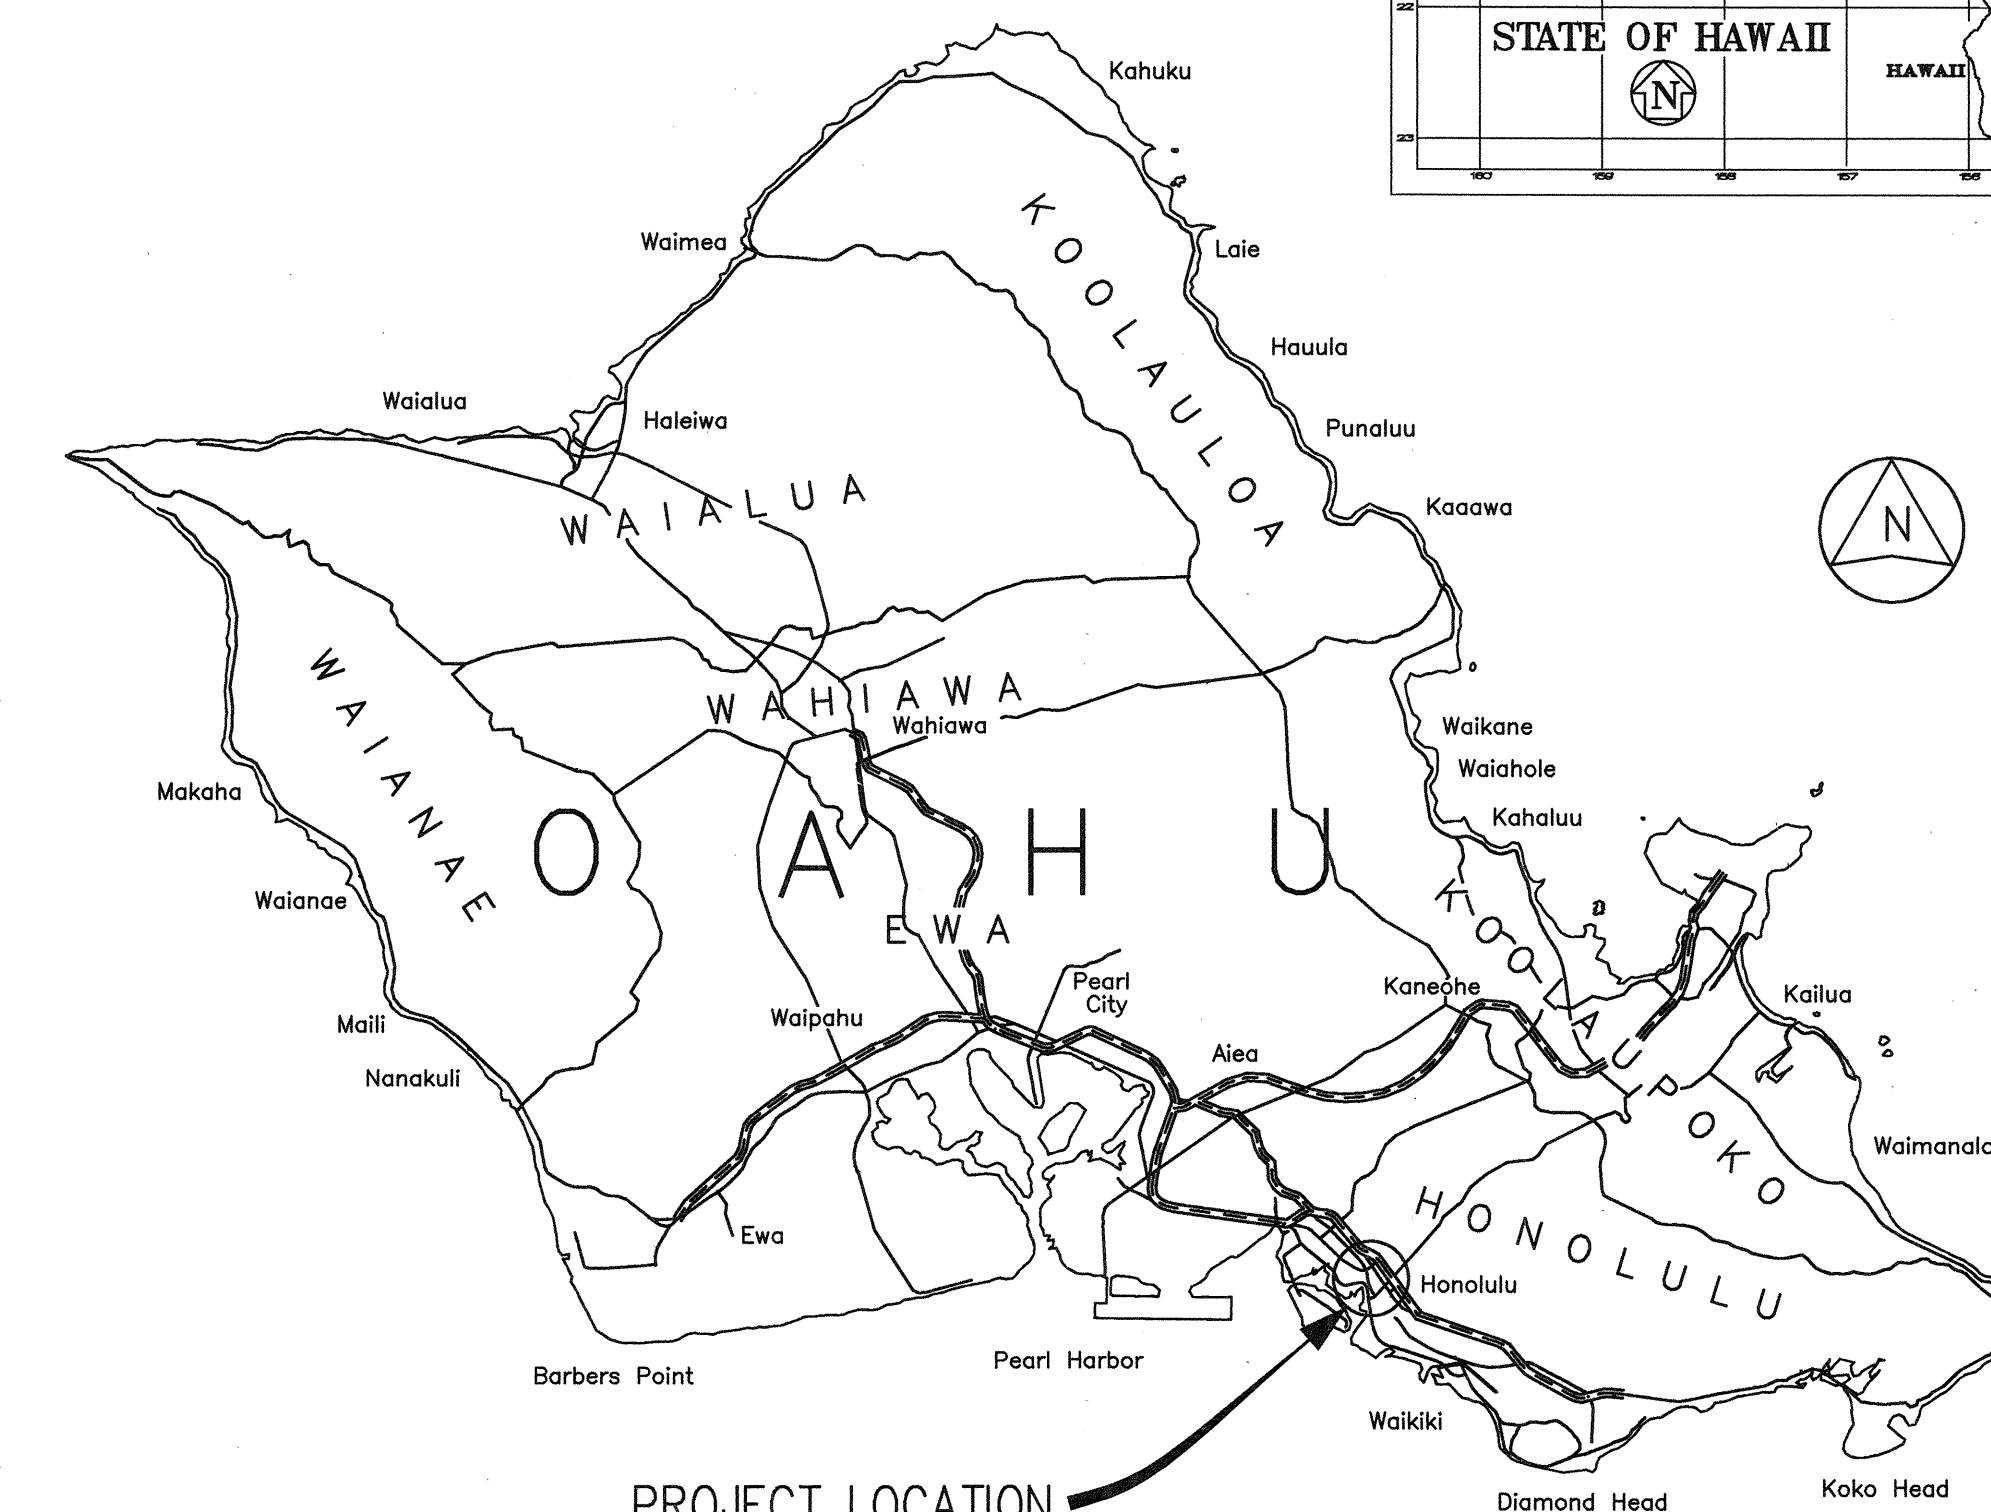


FED. ROAD DIST. NO.	STATE	PROJ. NO.	FISCAL YEAR	SHEET NO.	TOTAL SHEETS
HAWAII	HAW.	98A-01-98	1999	1	23

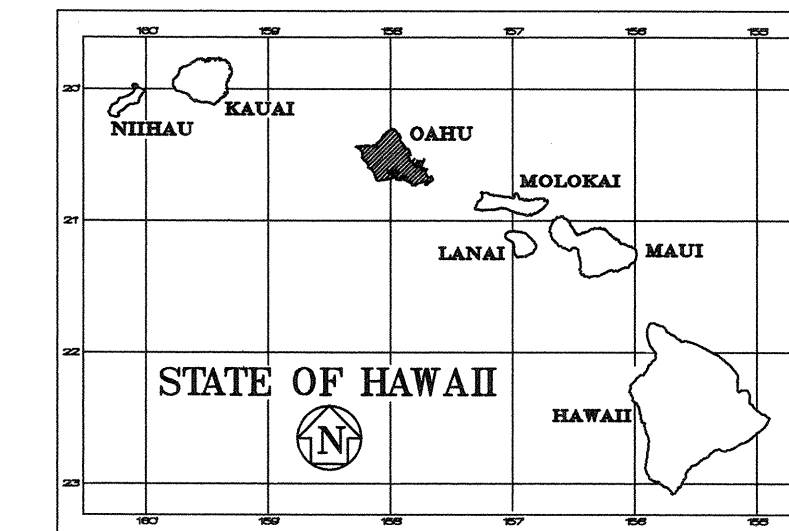

PROJECT LOCATION

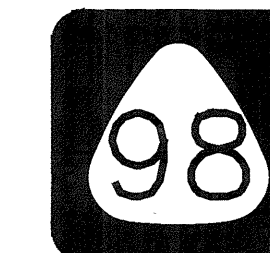


MILEPOST 0.94 TO MILEPOST 1.00

CHANGES MADE DURING CONSTRUCTION HAVE BEEN  
INCORPORATED ON THESE PLANS EXCEPT CHANGES  
IN THE ORIGINAL THEORETICAL QUANTITIES. FOR  
ACTUAL QUANTITIES, REFER TO PROJECT LEDGER  
AND/OR COMPUTATION BOOK.

*Giana Lee*  
RESIDENT ENGINEER


4/4/01  
DATE

DEPARTMENT OF TRANSPORTATION STATE OF HAWAII	
APPROVED: 	4/5/19
<u>DIR. OF TRANSPORTATION</u>	<u>DATE</u>


[illegible]

STATE OF HAWAII  
DEPARTMENT OF TRANSPORTATION  
HIGHWAYS DIVISION  
HONOLULU, HAWAII  
"AS-BUILT"  
PLANS FOR  
VINEYARD BOULEVARD  
TRAFFIC SIGNAL UPGRADE  
AT NUUANU AVENUE  
PROJECT NO. 98A-01-98

DISTRICT OF HONOLULU  
ISLAND OF OAHU

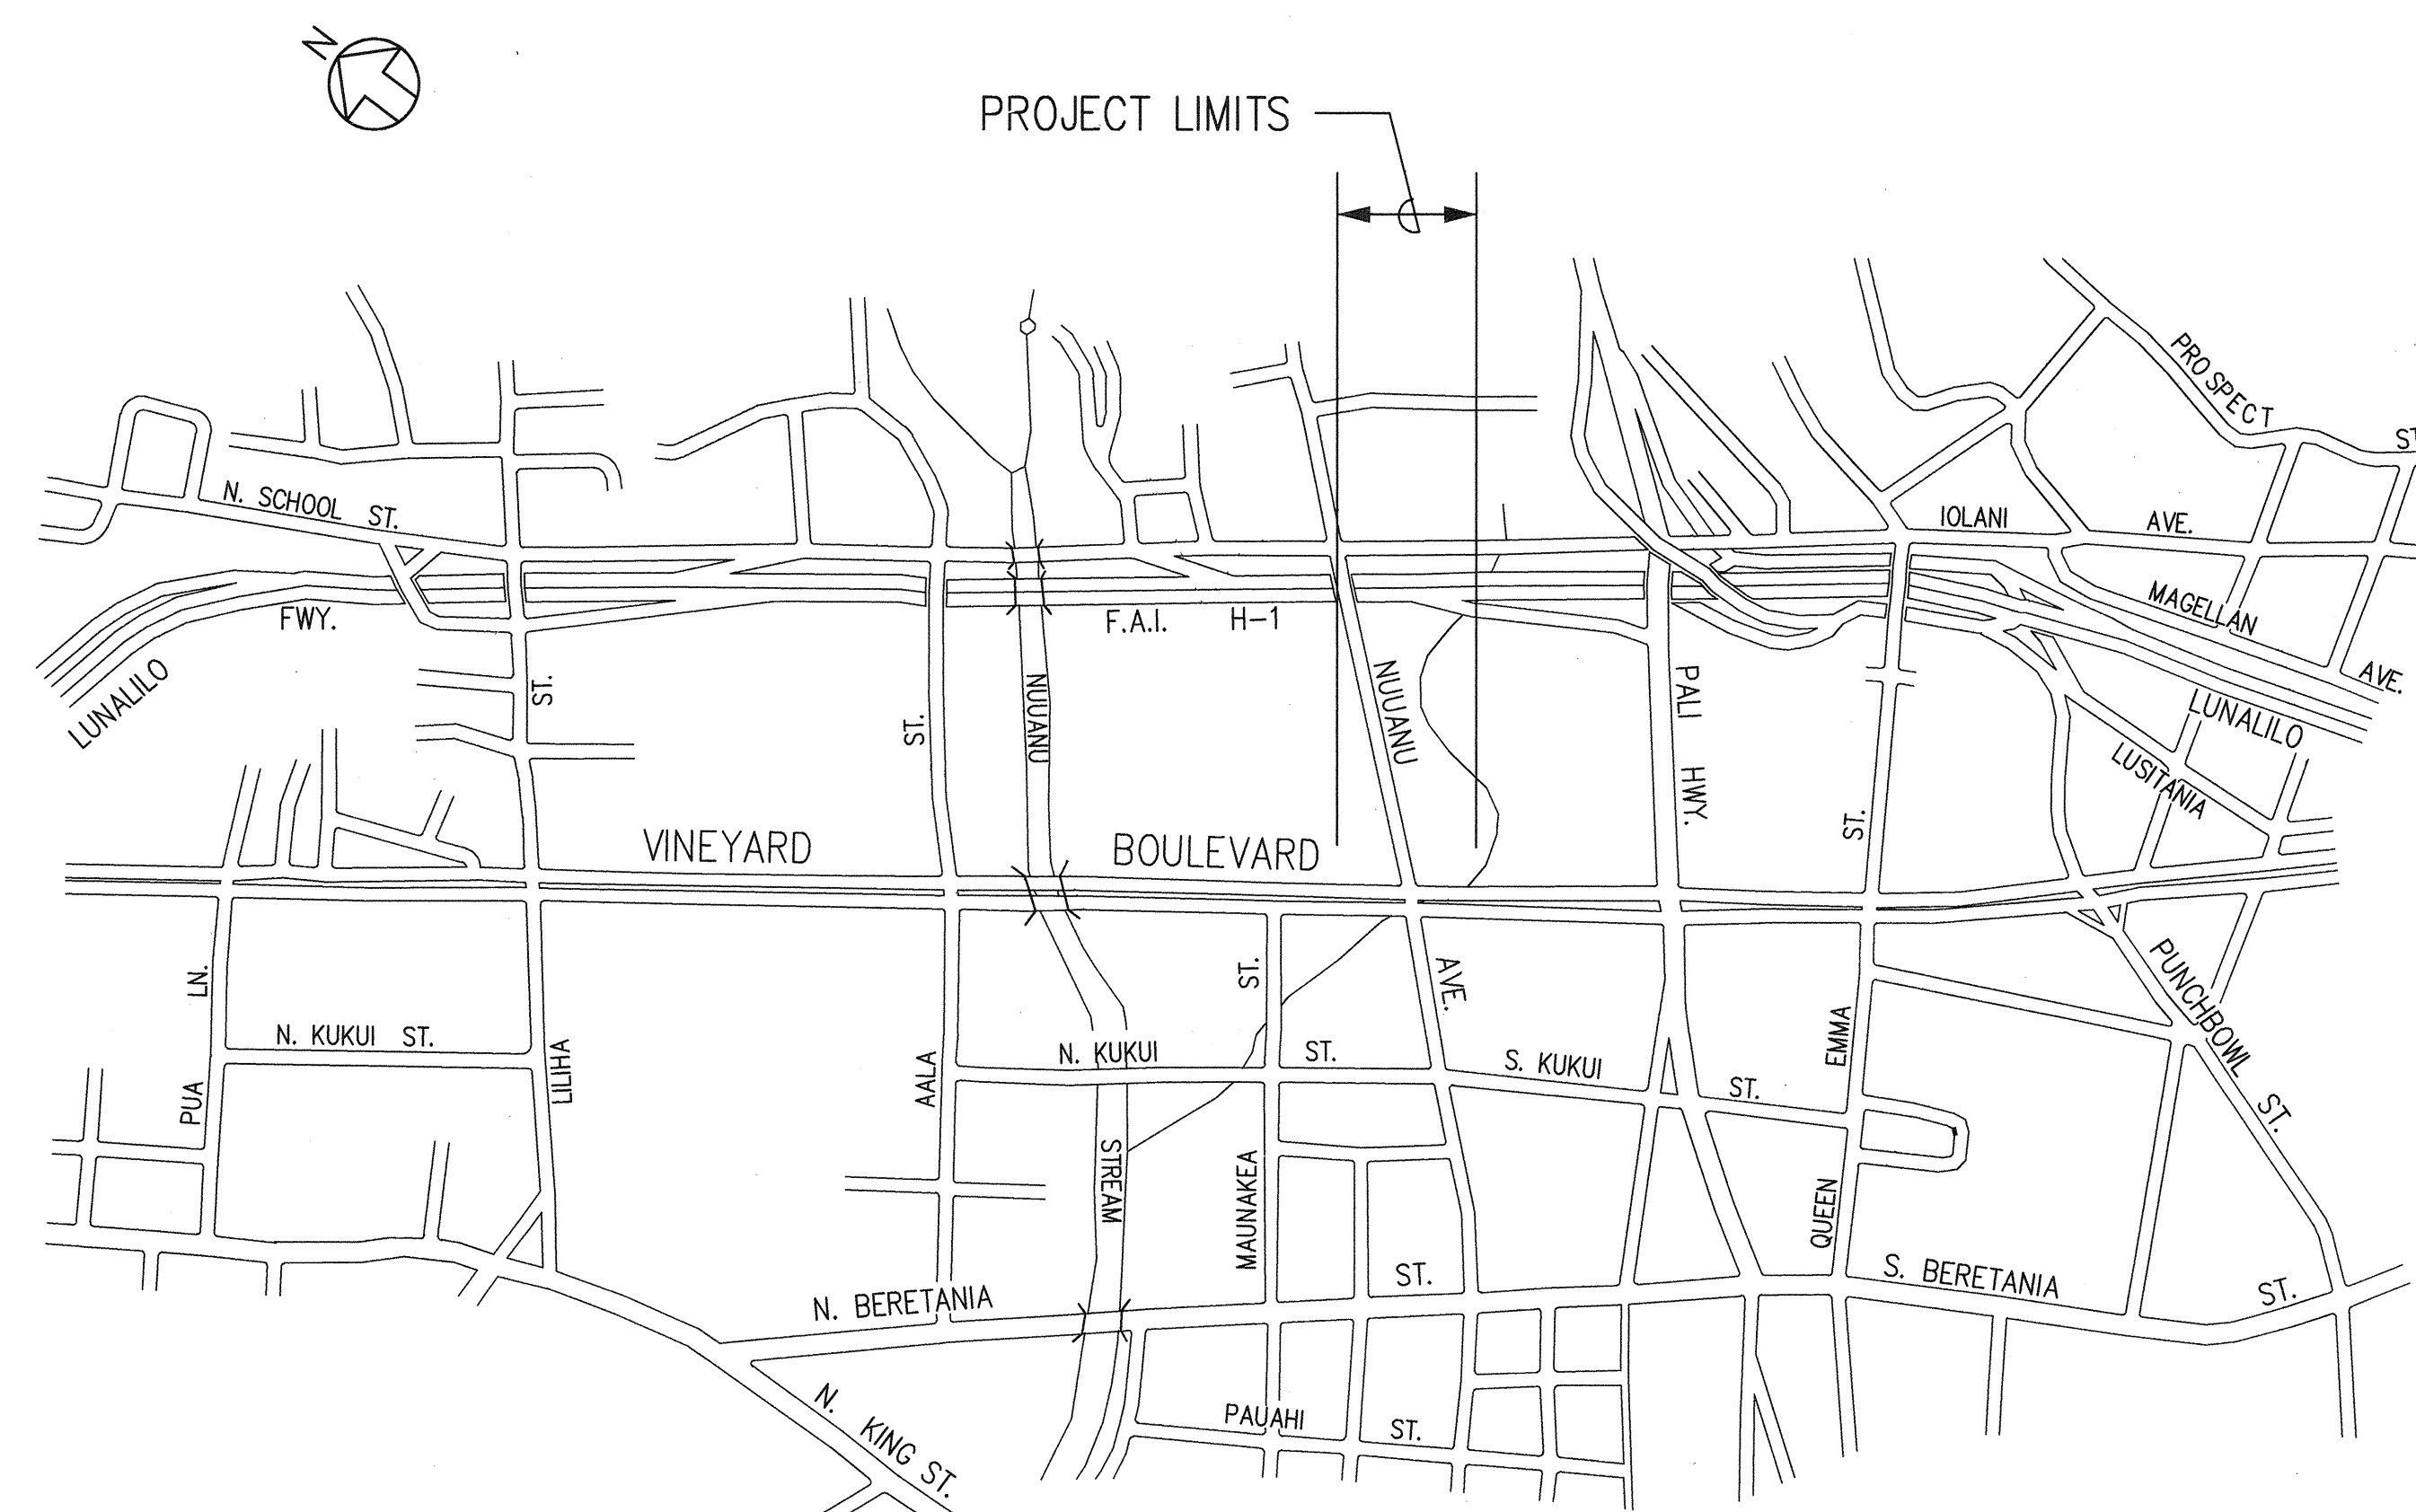

## LOCATION PLAN

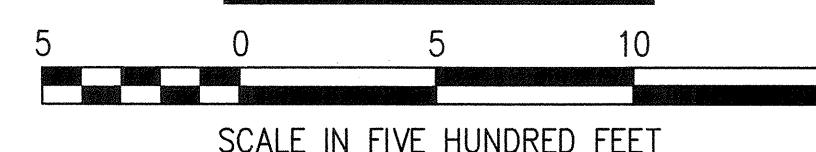

SCALE IN FIVE HUNDRED FEET

ORIGINAL PLAN	SURVEY PLOTTED BY _____ DATE _____
NOTE BOOK	DRAWN BY _____
	TRACED BY _____
	DESIGNED BY _____
	QUANTITIES BY _____
No. _____	CHECKED BY _____

PARSONS BRINCKERHOFF	KARL KUNISHIGE	692-7679	JANUARY 1999
DESIGNED BY	P. S. & F. BY	PHONE	DATE