




FED. ROAD DIST. NO.	STATE	FED. AID PROJ. NO.	FISCAL YEAR	SHEET NO.	TOTAL SHEETS
HAWAII	HAW.	STP-098-1(011)	2012	13	64

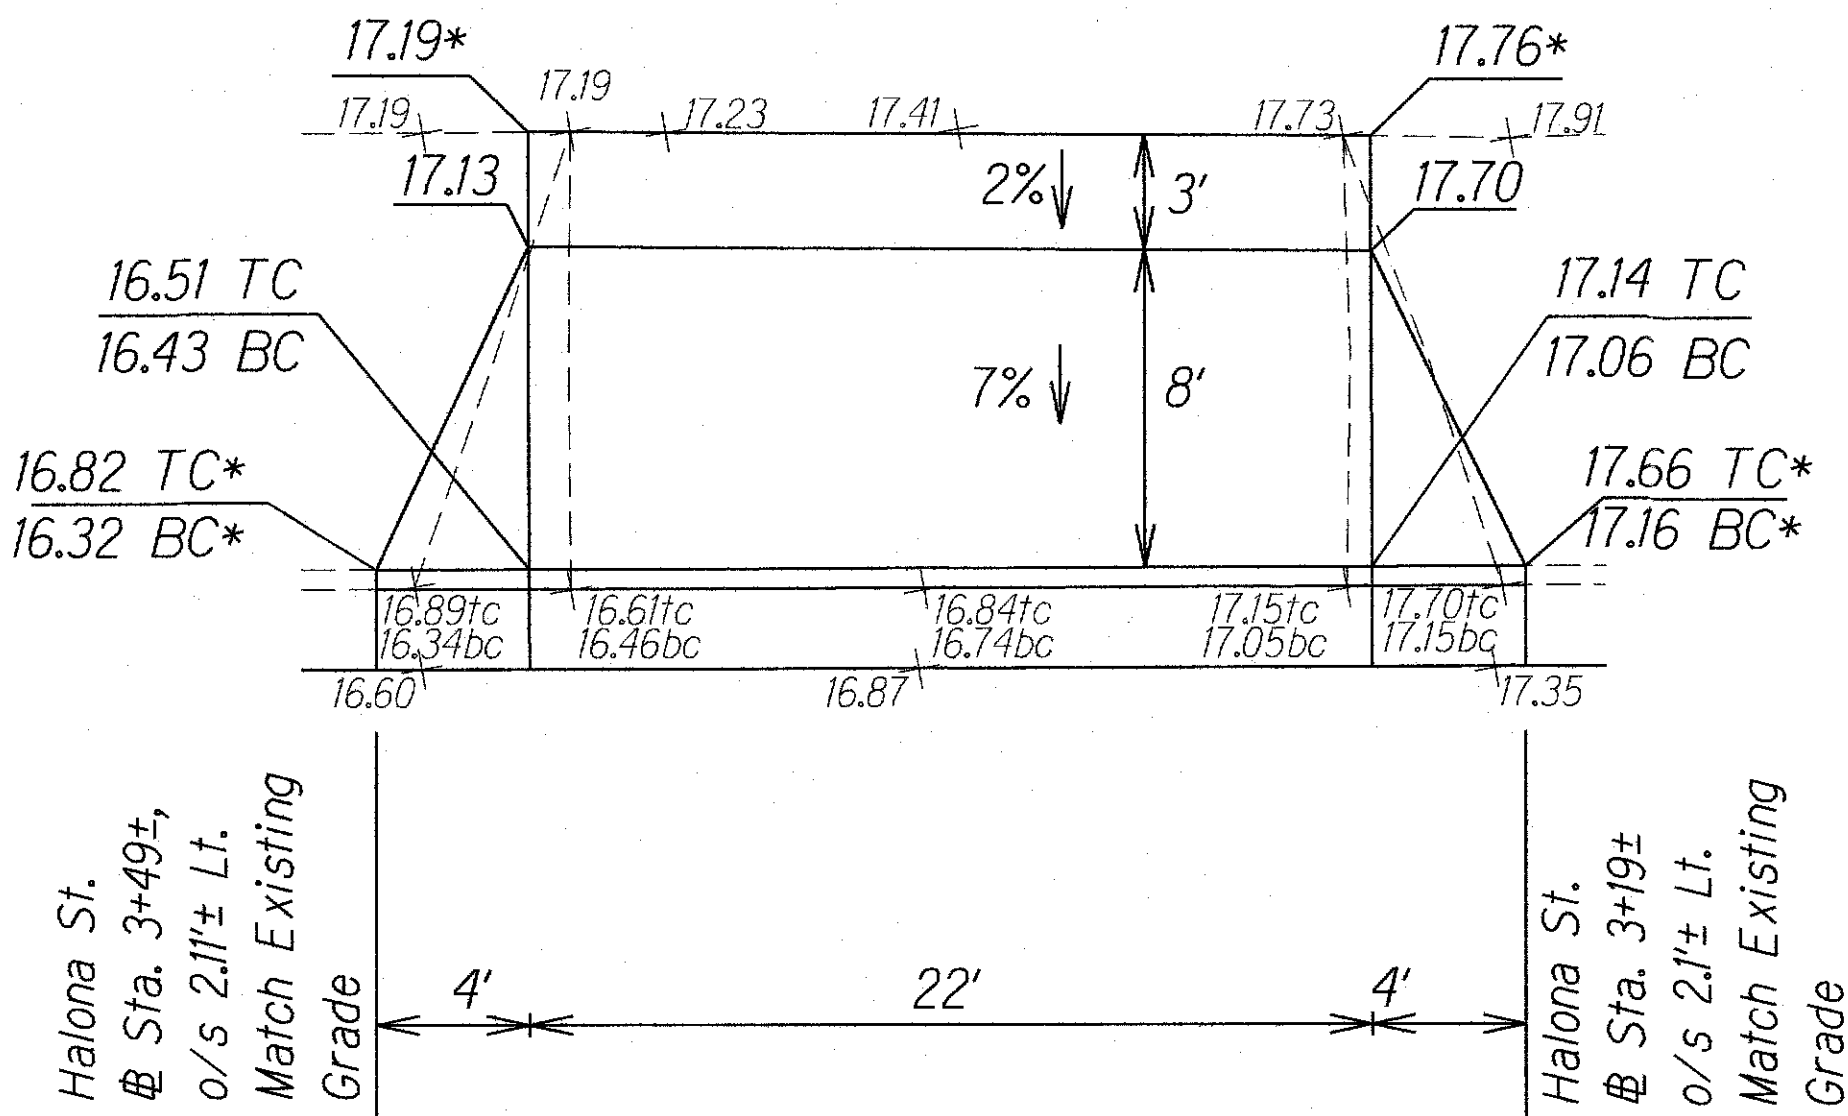


HALONA ST. @ STA. 3+49± LT. to HALONA ST. @ STA. 3+19± LT.

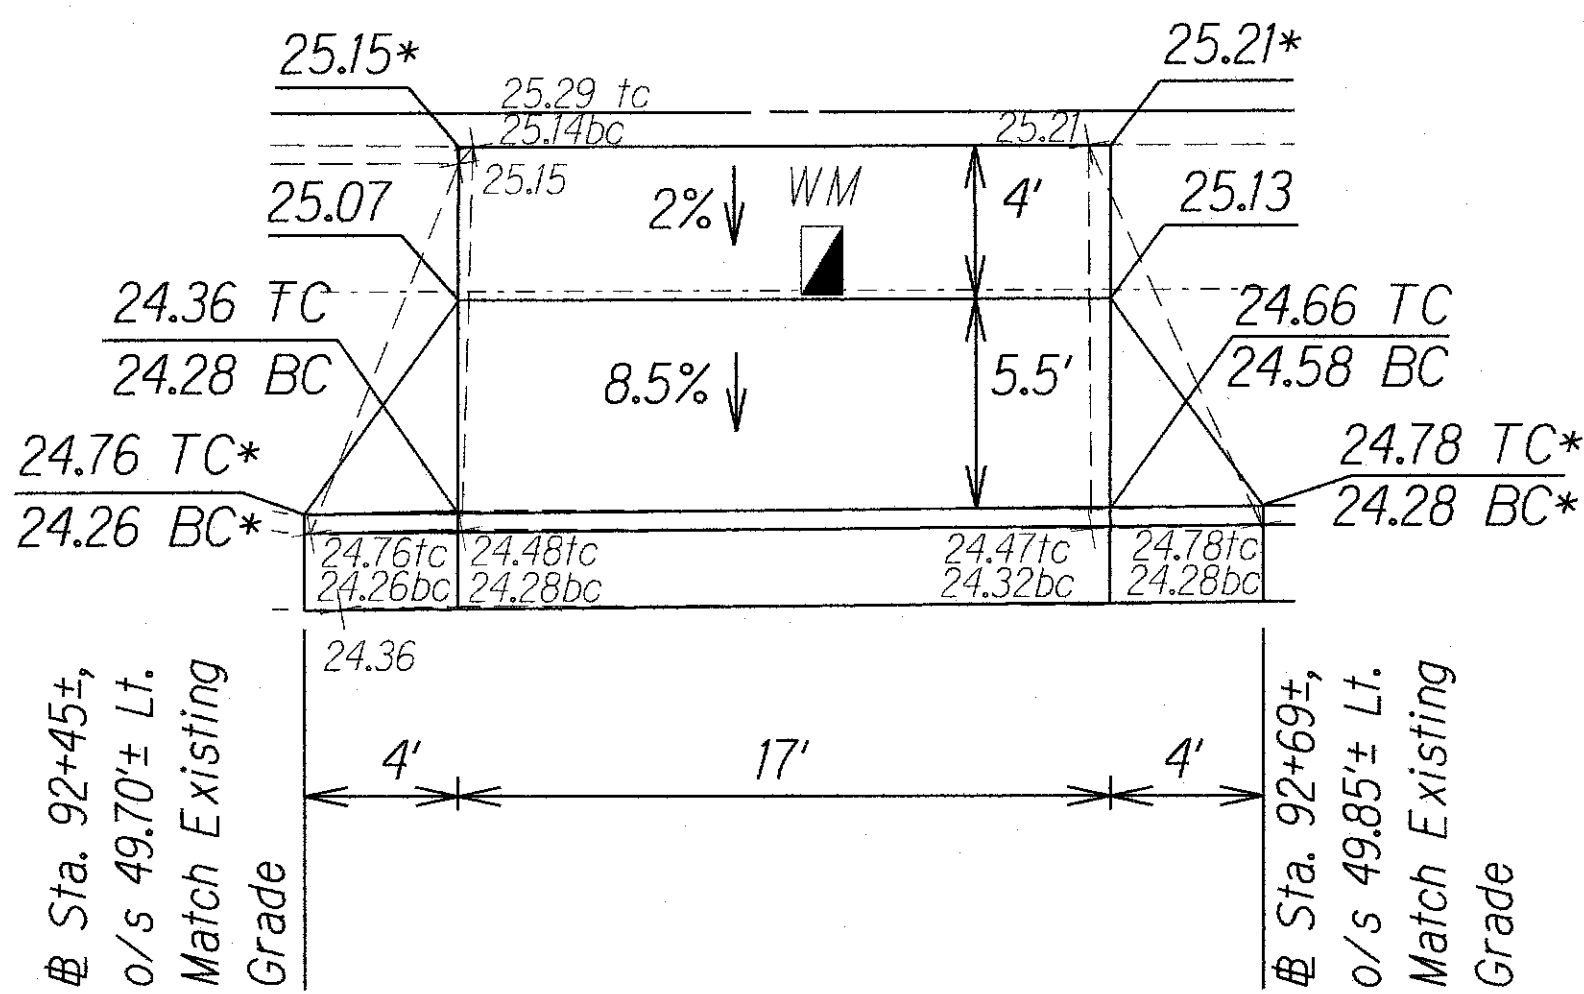

@ STA. 92+45± LT. TO @ STA. 92+69± LT.

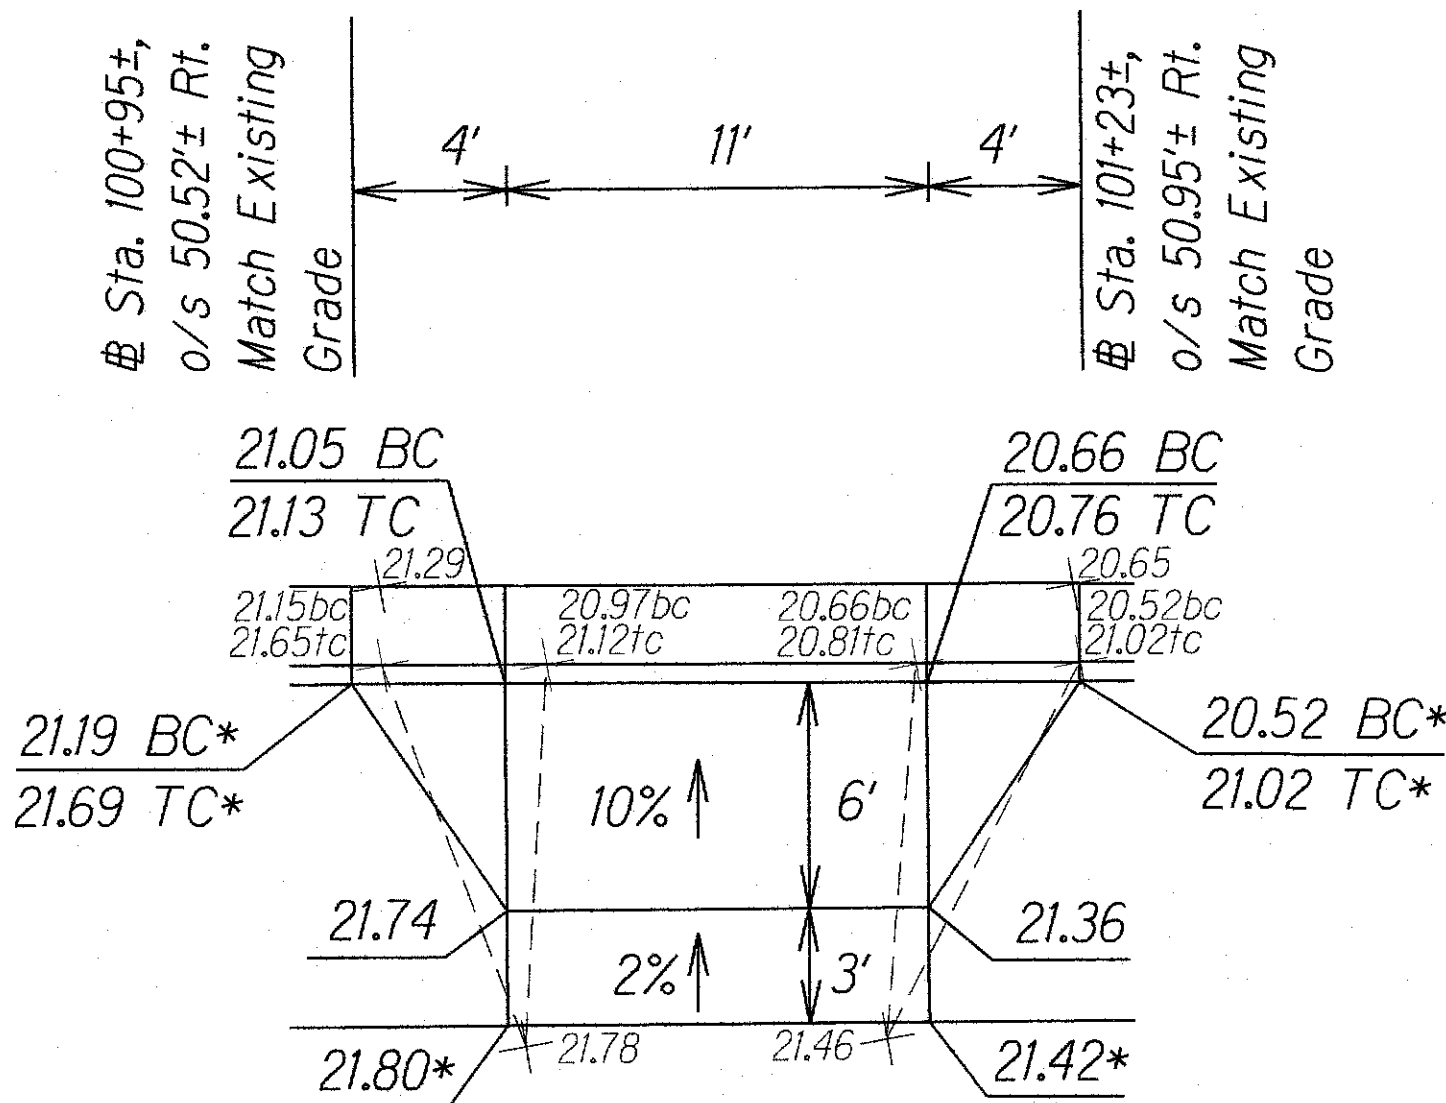

@ STA. 100+95± RT. TO @ STA. 101+23± RT.

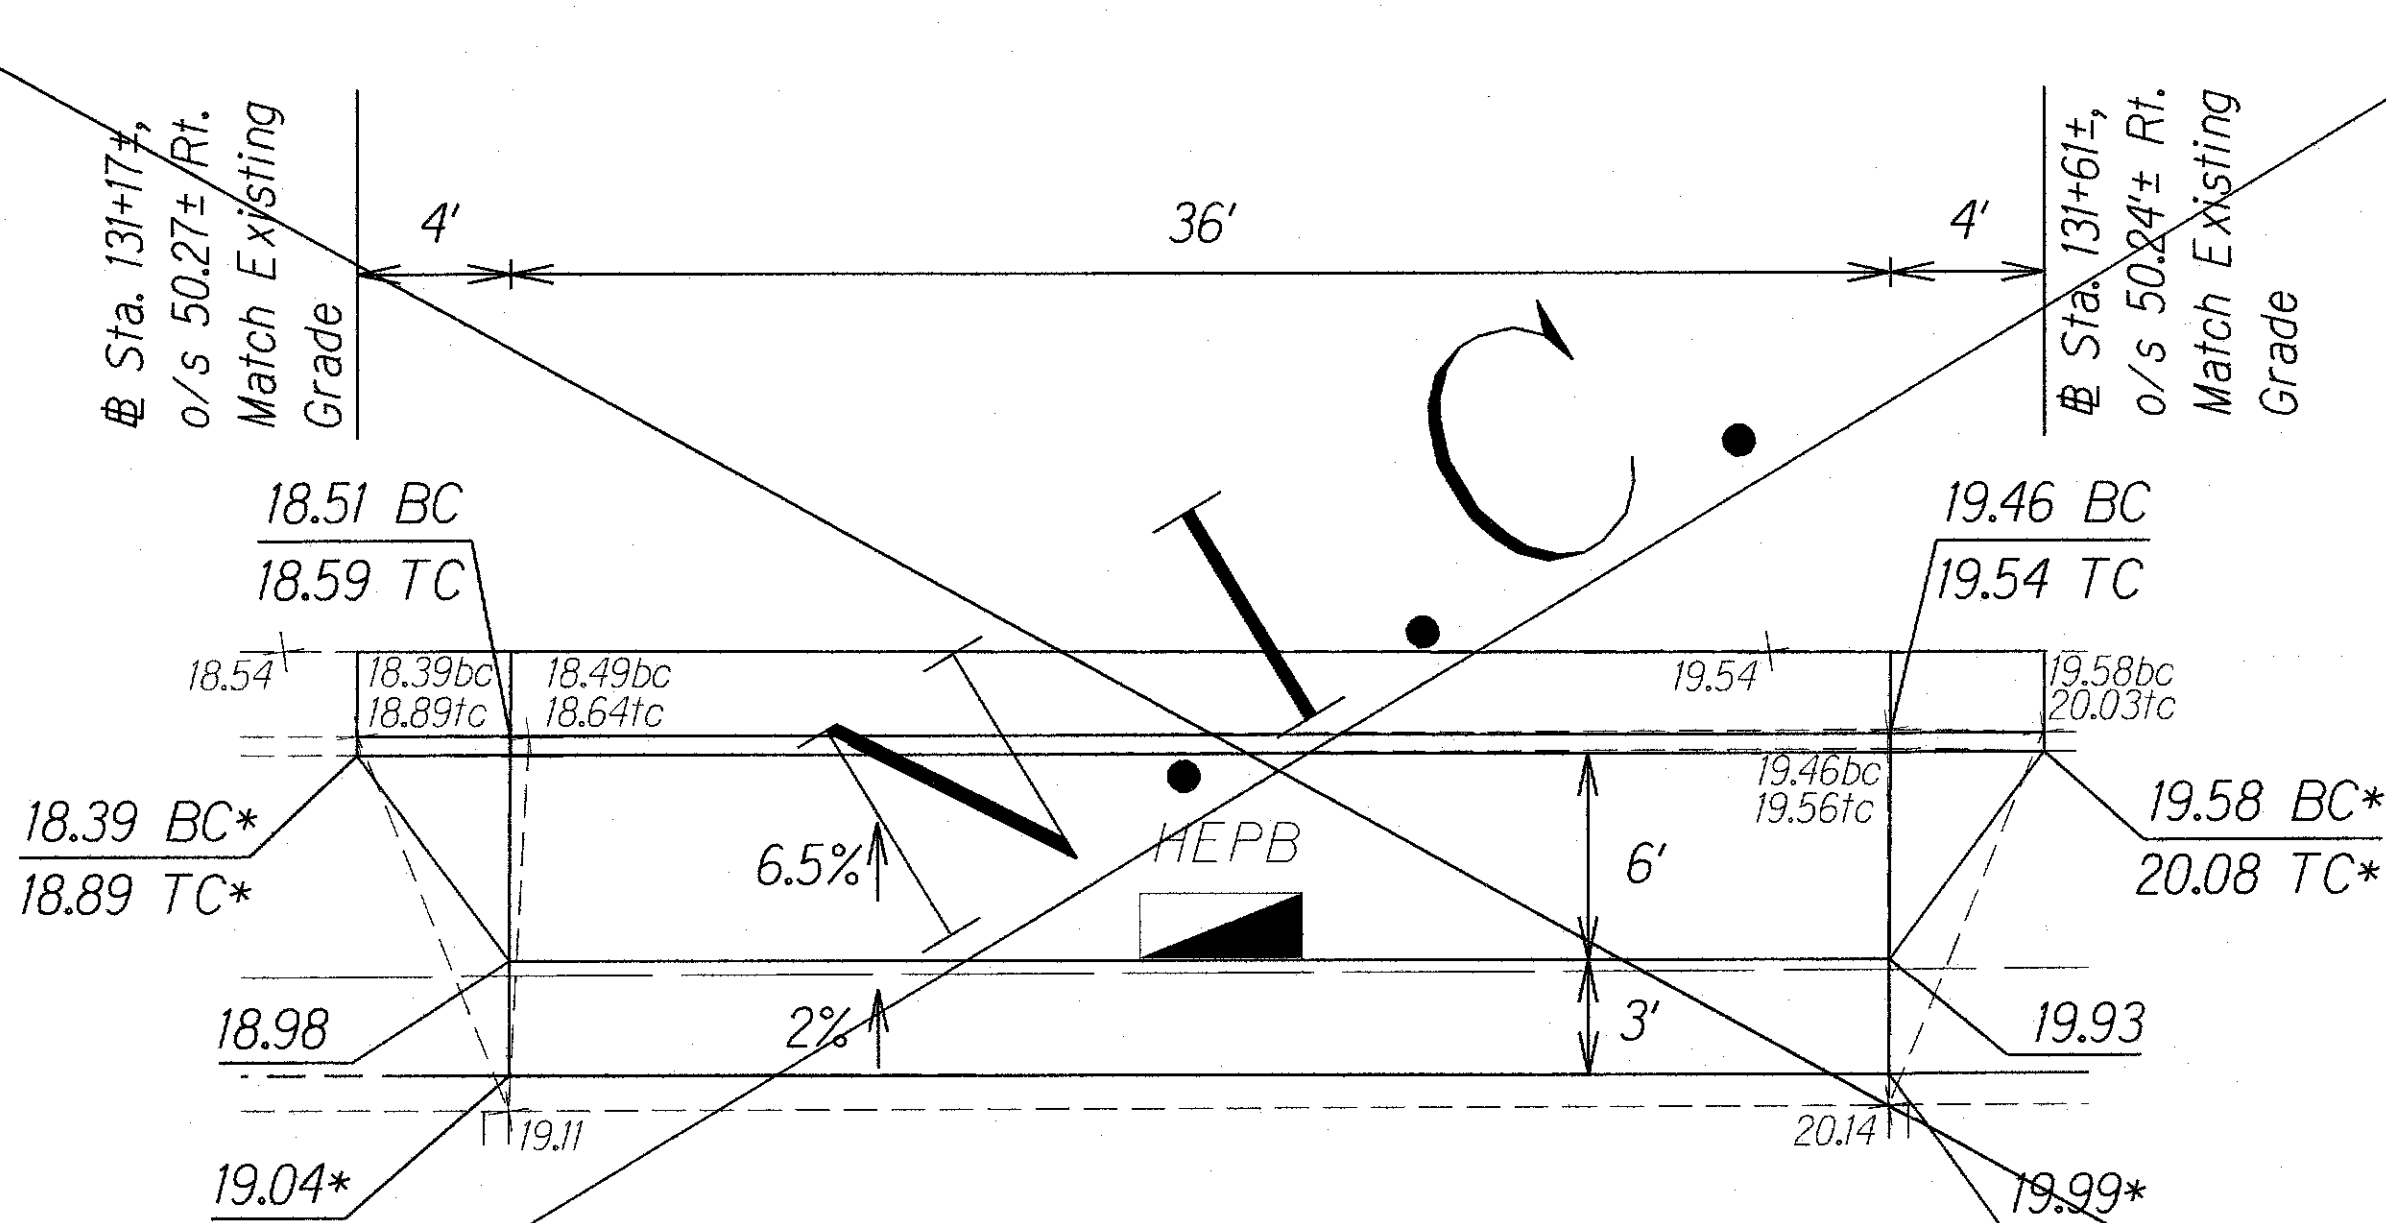

@ STA. 131+17± RT. TO @ STA. 131+61± RT.

Note: All grades shown are finished grades. The Contractor shall verify in the field that the grades shown with an asterisk (*) are consistent with the existing grade at the indicated location and make necessary adjustments to make a smooth connection between new and existing surfaces. All adjusted surfaces shall be in full compliance with the accessibility requirements.

LEGEND FOR AS-BUILT POSTINGS	
	Squiggly line for as-built deletion
	Double line for as-built deletion
Roadway	Text for as-built posting

STATE OF HAWAII
DEPARTMENT OF TRANSPORTATION
HIGHWAYS DIVISION

CONCRETE DRIVEWAY PLANS & DETAILS

VINEYARD BOULEVARD RESURFACING
Vicinity of Palama St. to End of H-1 On-and-off Ramp
Federal-Aid Project No. STP-098-1(011)

Scale: 1" = 5'
Date: November, 2012

SHEET No. 1 OF 1 SHEETS

SURVEY PLOTTED BY	DATE
DRAWN BY	
DESIGNED BY	
NOTED BY	
CHECKED BY	

"AS-BUILT"