


| FED. ROAD DIST. NO. | STATE | FED. AID PROJ. NO. | FISCAL YEAR | SHEET NO. | TOTAL SHEETS |
|---------------------|-------|--------------------|-------------|-----------|--------------|
| HAWAII              | HAW.  | STP-098-1(011)     | 2012        | 47        | 64           |

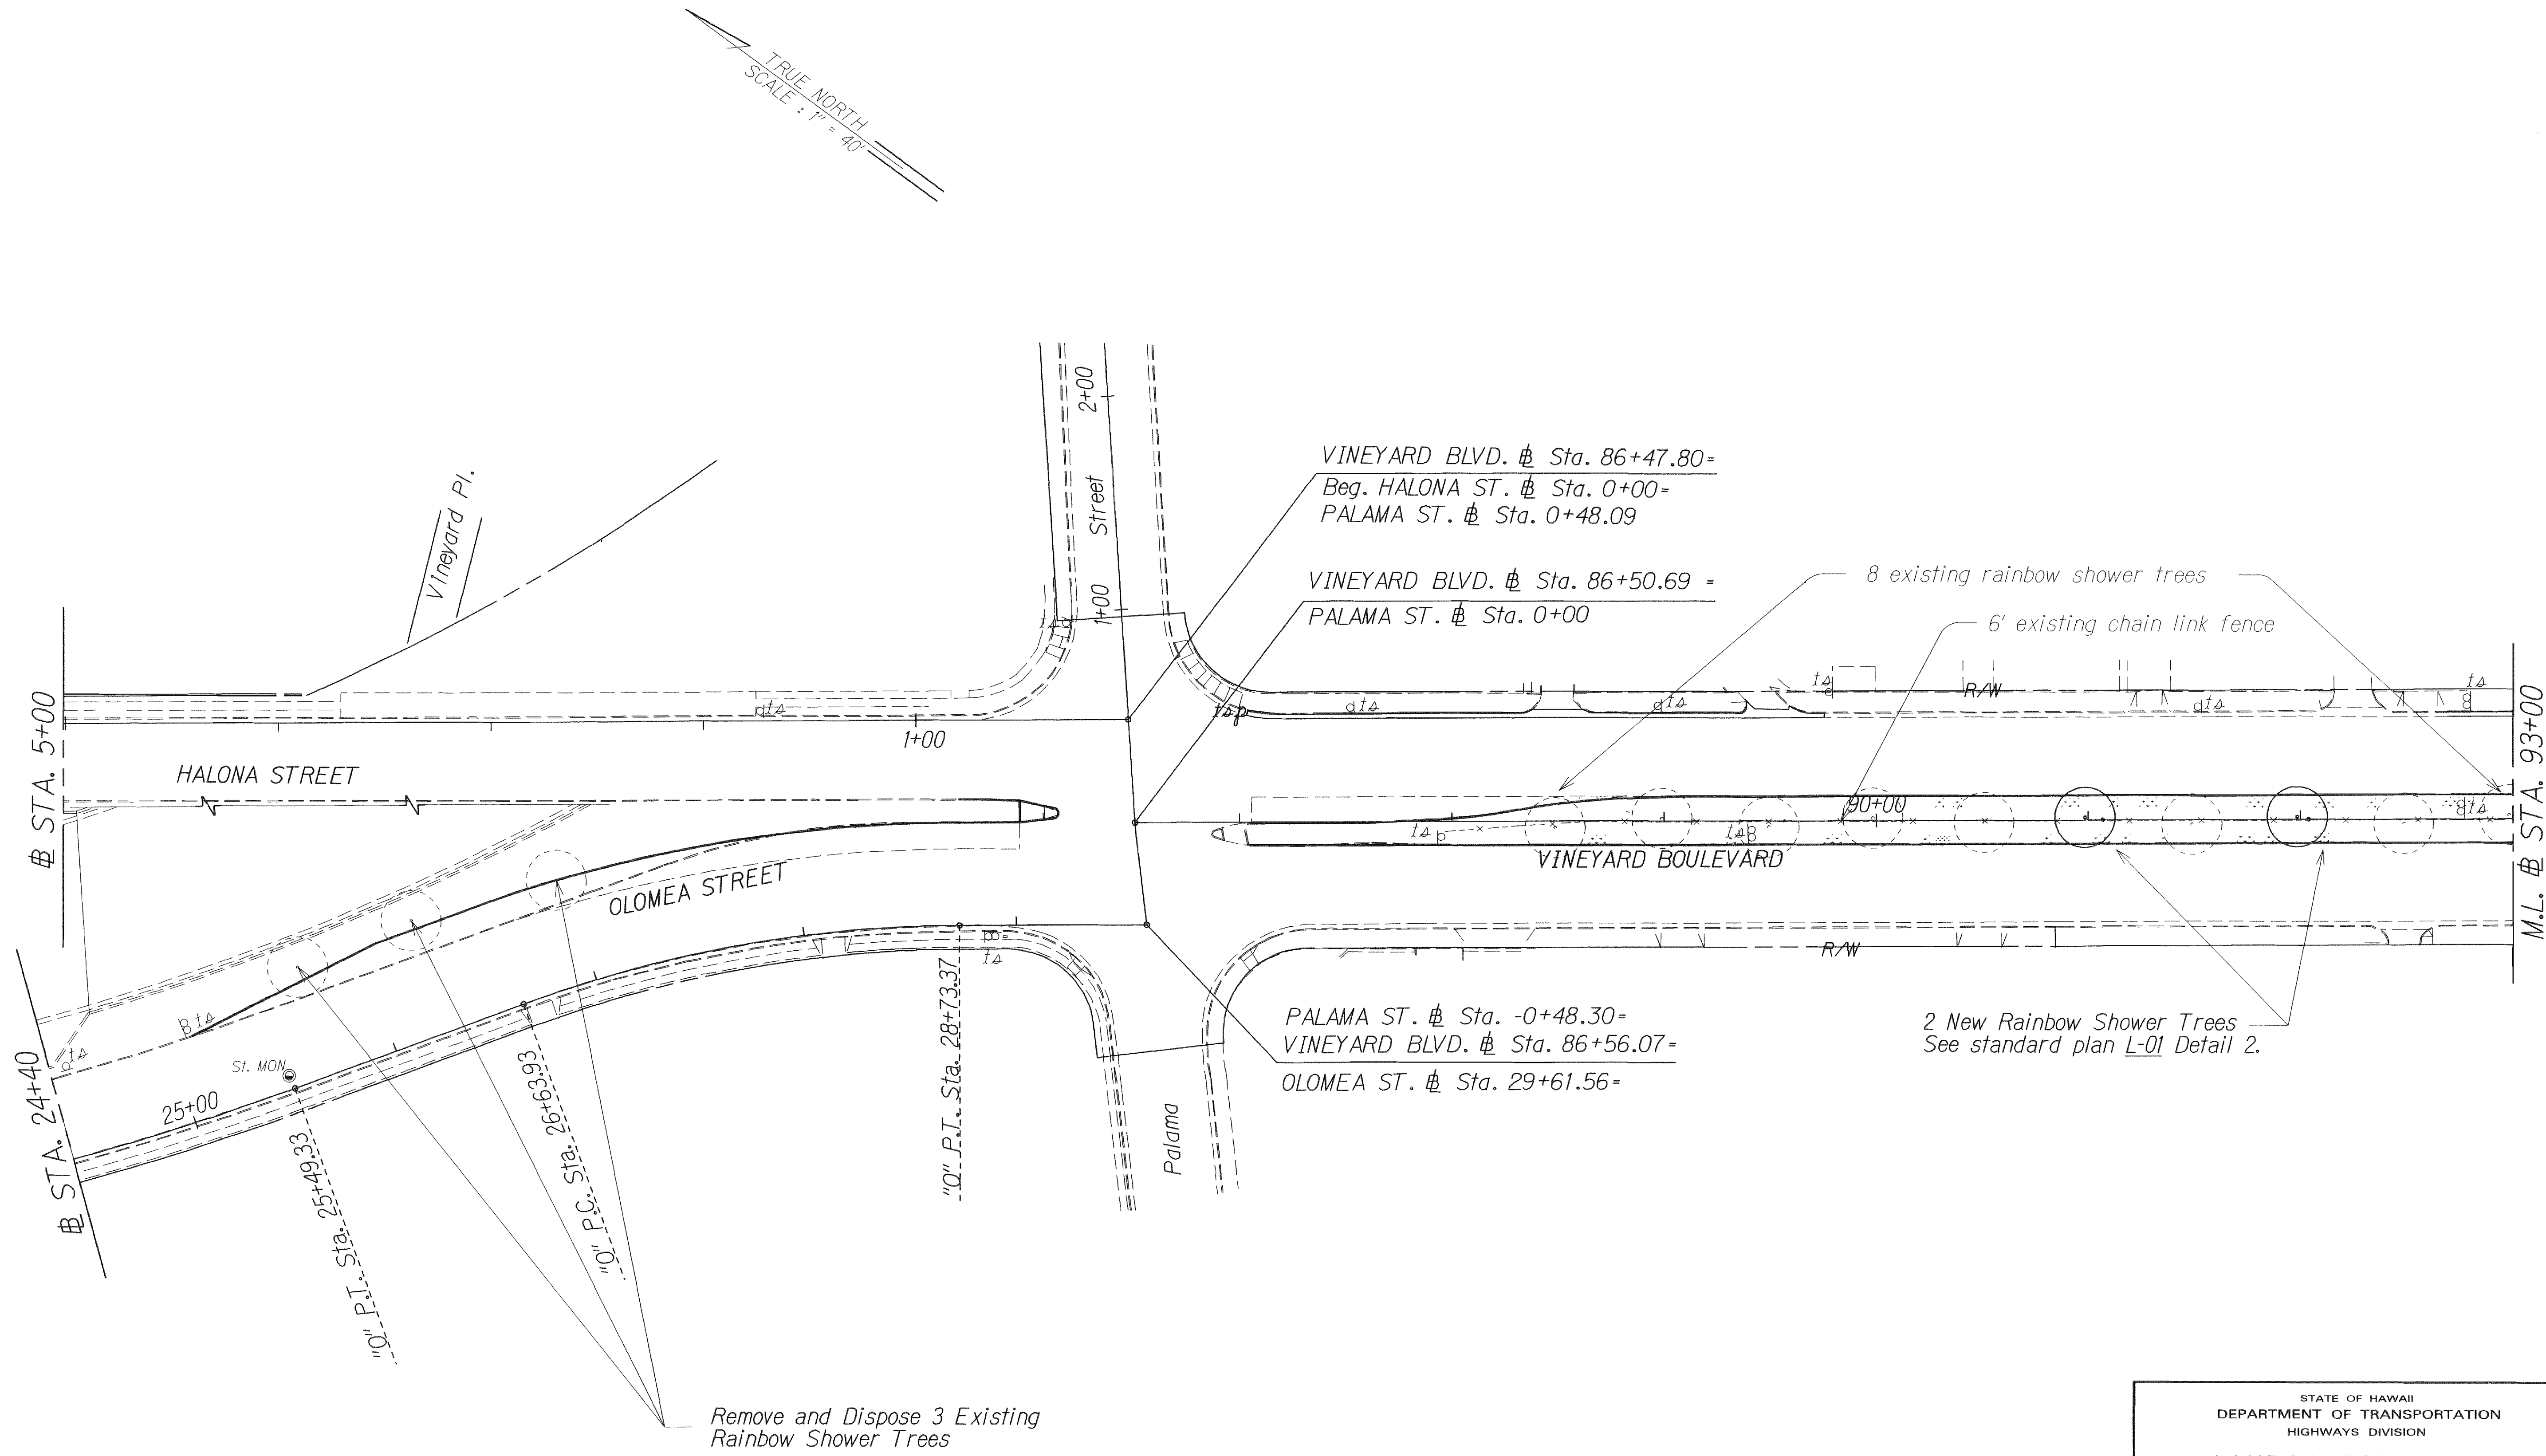

\* Note: For details regarding watering New Rainbow Shower Trees, see Plan Sheet No. 46.

STATE OF HAWAII  
DEPARTMENT OF TRANSPORTATION  
HIGHWAYS DIVISION

LANDSCAPING PLANS


VINEYARD BOULEVARD RESURFACING  
Vicinity of Palama St. to End of H-1 On- and Off Ramp  
Federal-Aid Project No. STP-098-1(011)

Scale: 1"=40'      Date: November, 2012

SHEET No. 1 OF 5 SHEETS



| FED. ROAD DIST. NO. | STATE | FED. AID PROJ. NO. | FISCAL YEAR | SHEET NO. | TOTAL SHEETS |
|---------------------|-------|--------------------|-------------|-----------|--------------|
| HAWAII              | HAW.  | STP-098-1(011)     | 2012        | 49        | 64           |

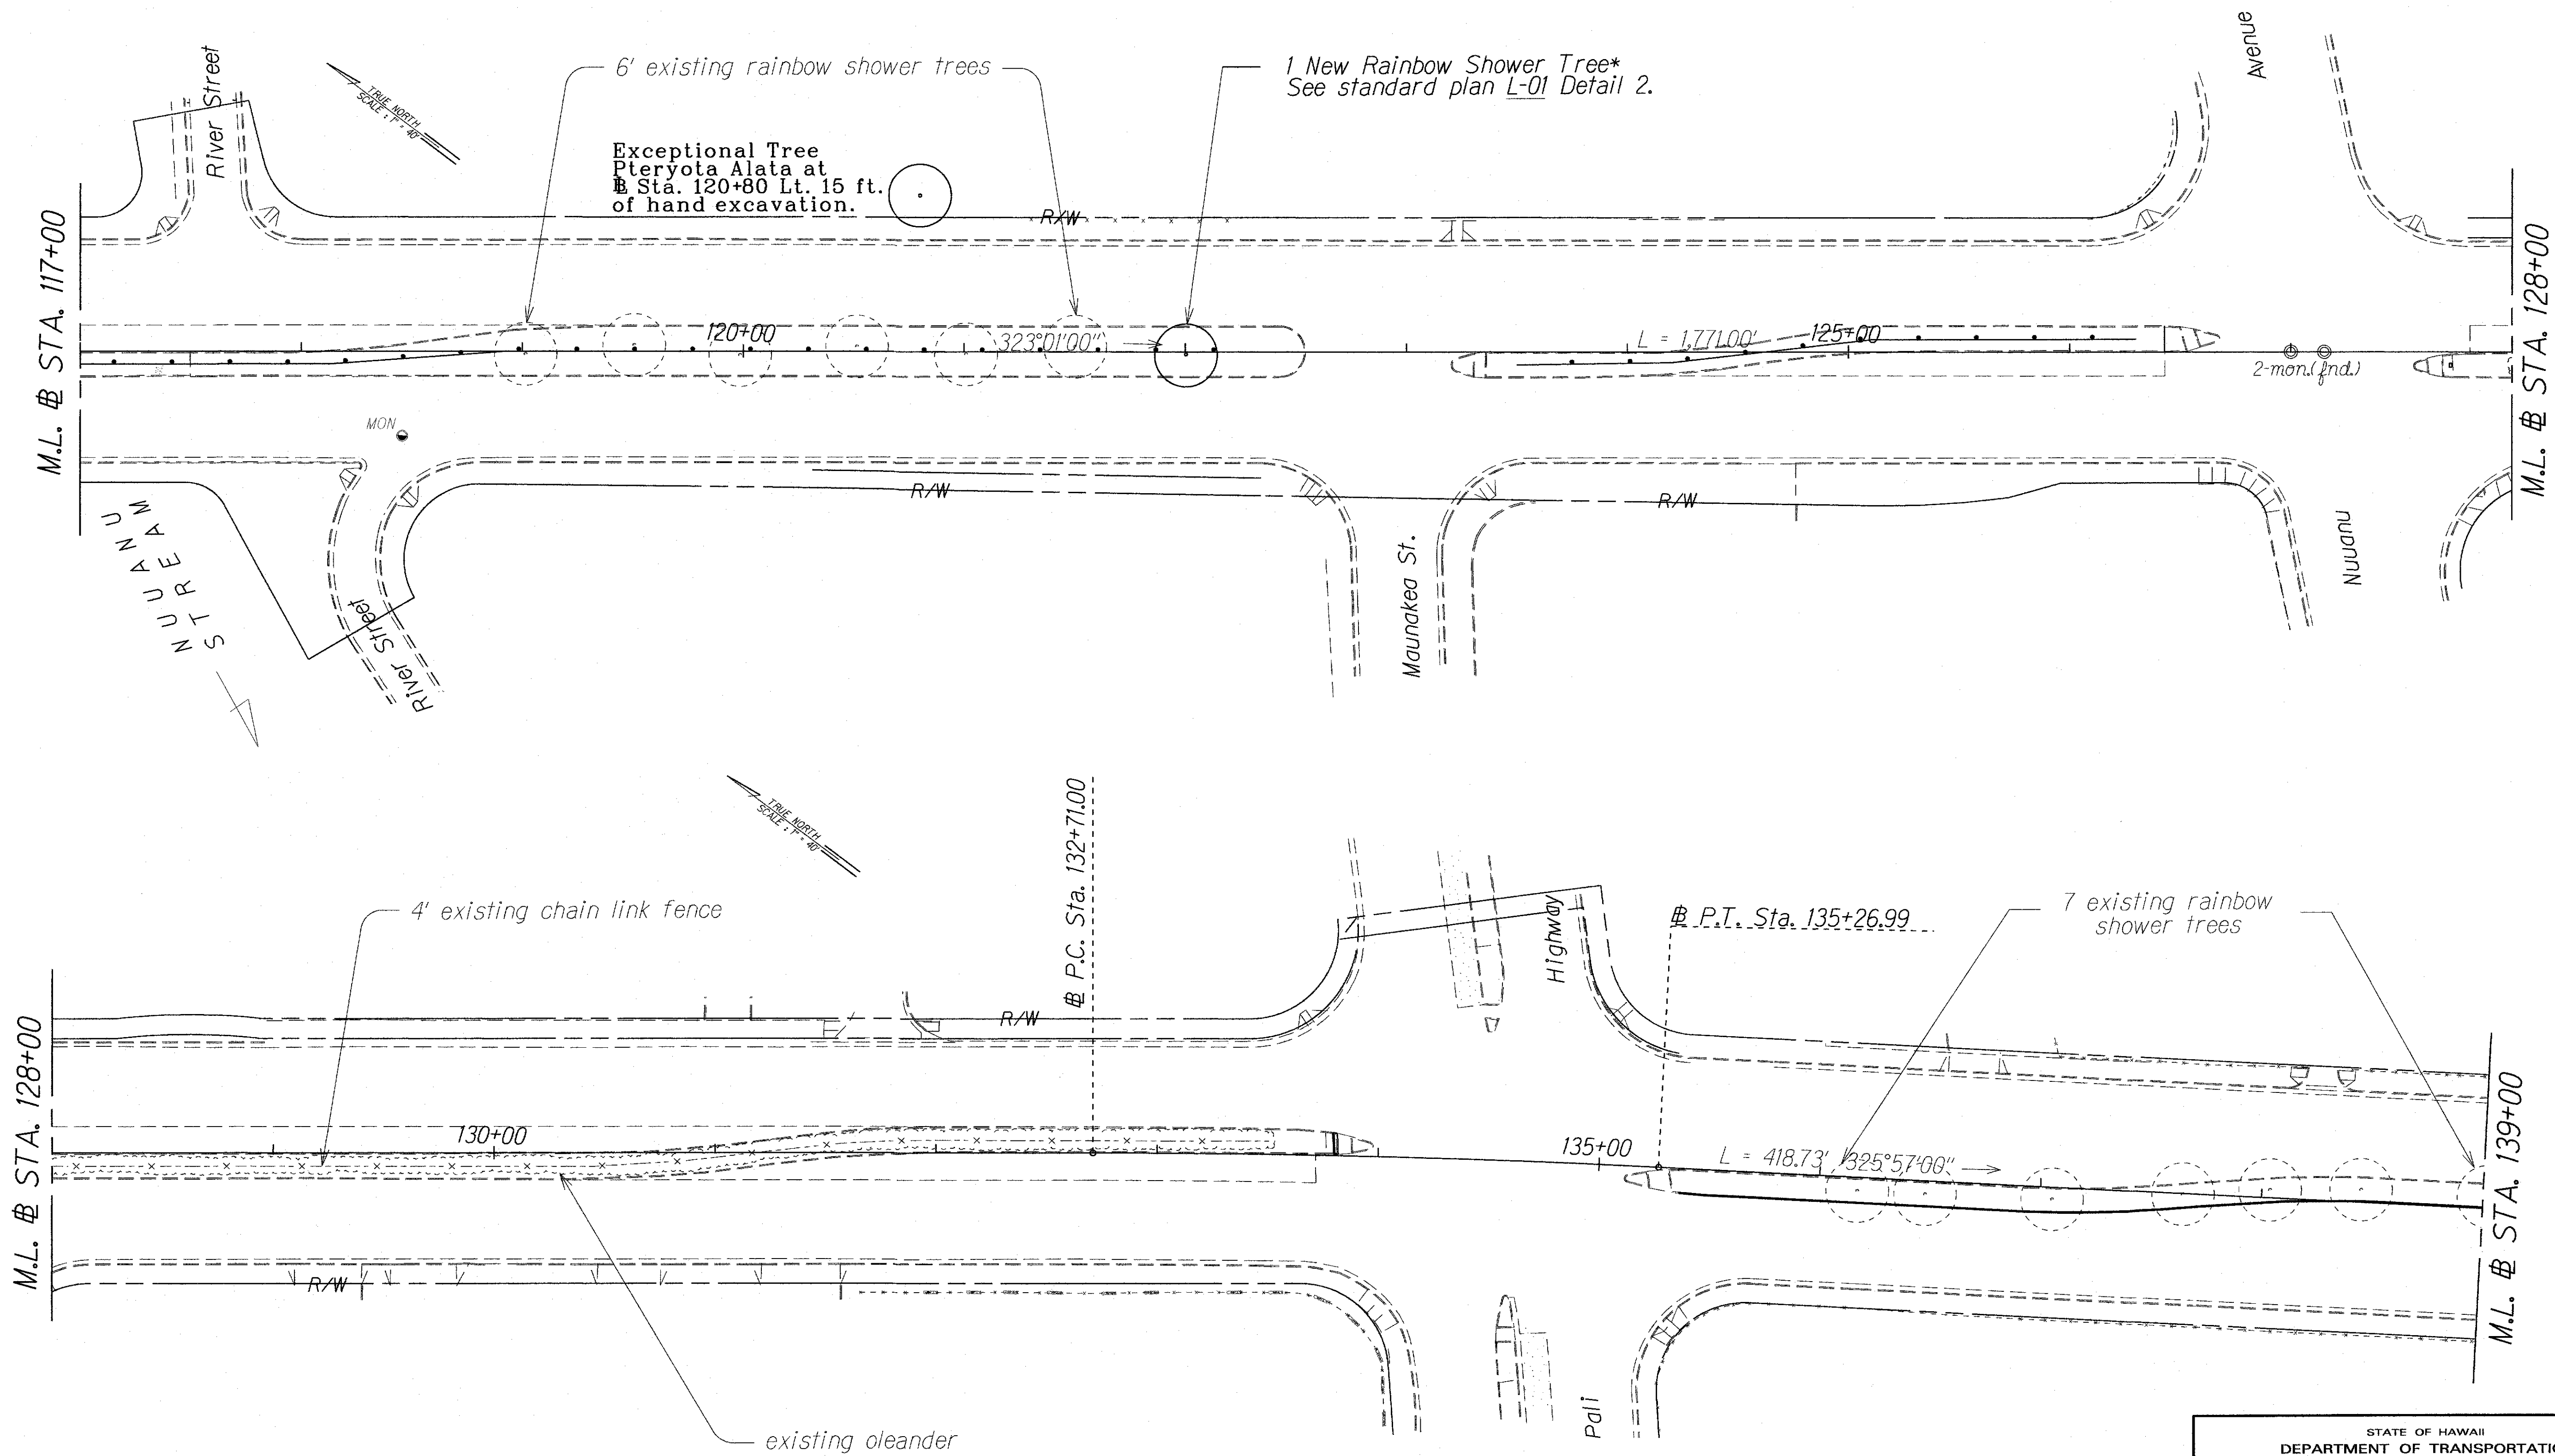

| LEGEND FOR AS-BUILT POSTINGS |                                     |
|------------------------------|-------------------------------------|
|                              | Squiggly line for as-built deletion |
|                              | Double line for as-built deletion   |
| Roadway                      | Text for as-built posting           |

\* Note: For details regarding watering New Rainbow Shower Trees, see Plan Sheet No. 46.

STATE OF HAWAII  
DEPARTMENT OF TRANSPORTATION  
HIGHWAYS DIVISION


**LANDSCAPING PLANS**  
VINEYARD BOULEVARD RESURFACING  
Vicinity of Palama St. to End of H-1 On-and-Off Ramp  
Federal-Aid Project No. STP-098-1(011)  
Scale: 1"=40'      Date: November, 2012  
SHEET No. 3 OF 5 SHEETS

|               |                   |      |
|---------------|-------------------|------|
| ORIGINAL PLAN | SURVEY PLOTTED BY | DATE |
| NOTE BOOK     | DESIGNED BY       |      |
| QUANTITIES BY | CHECKED BY        |      |
| No. 200000000 |                   |      |

"AS-BUILT"



| FED. ROAD DIST. NO. | STATE | FED. AID PROJ. NO. | FISCAL YEAR | SHEET NO. | TOTAL SHEETS |
|---------------------|-------|--------------------|-------------|-----------|--------------|
| HAWAII              | HAW.  | STP-098-1(011)     | 2012        | 51        | 64           |

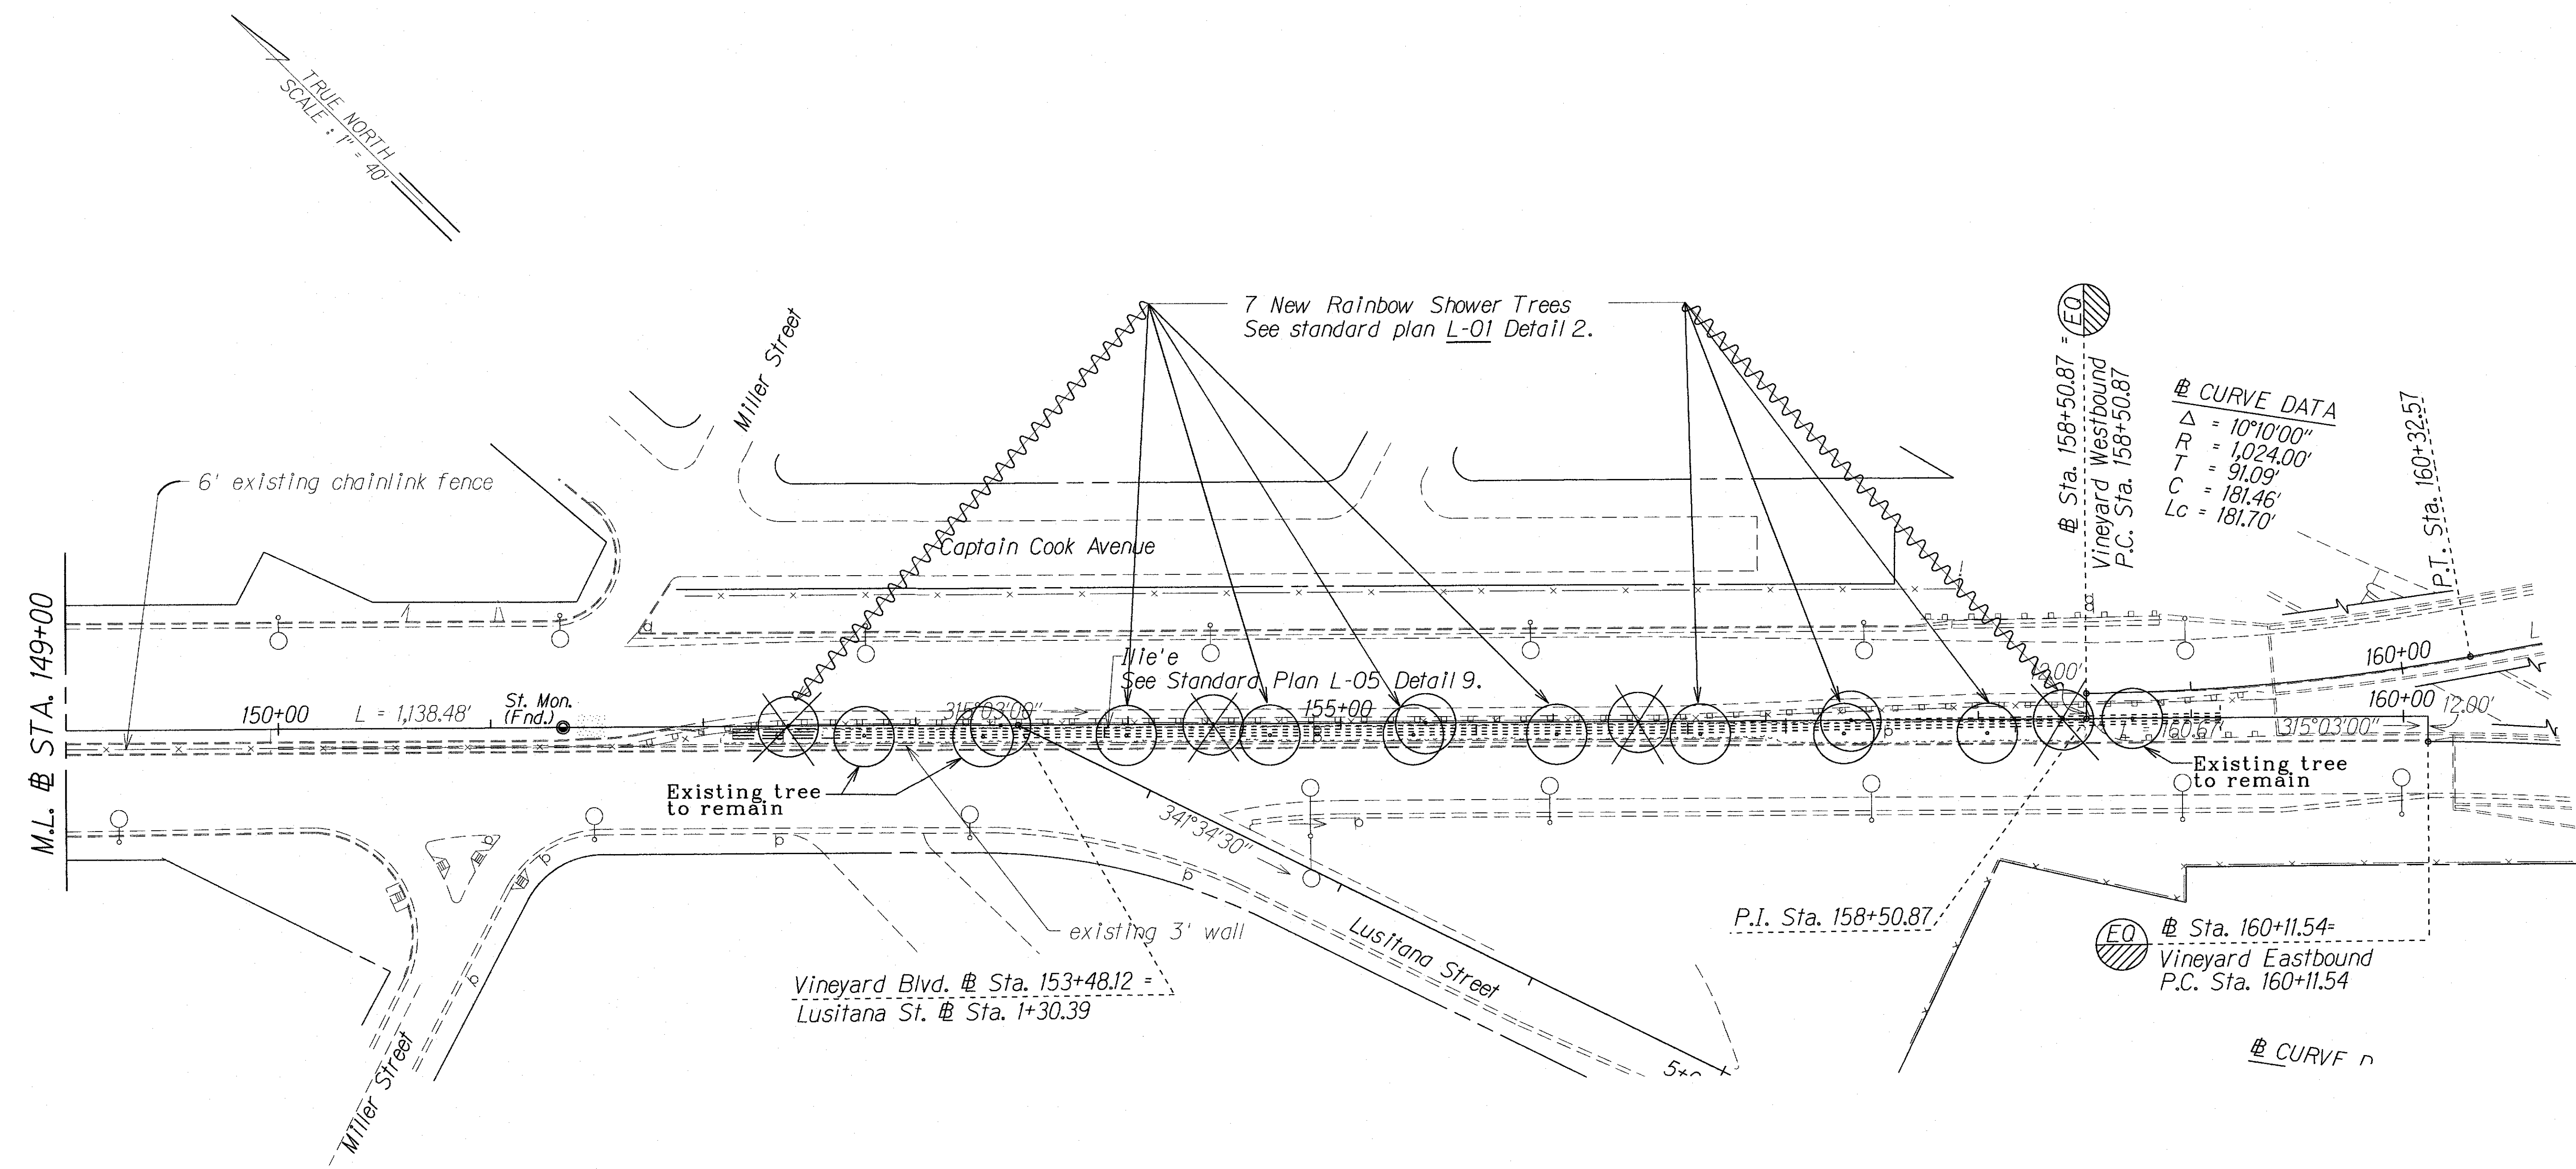

**CURVE DATA**

|          |             |
|----------|-------------|
| $\Delta$ | = 10°10'00" |
| R        | = 1,024.00' |
| T        | = 91.09'    |
| C        | = 181.46'   |
| Lc       | = 181.70'   |

**LEGEND FOR AS-BUILT POSTINGS**

|         |                                     |
|---------|-------------------------------------|
|         | Squiggly line for as-built deletion |
|         | Double line for as-built deletion   |
| Roadway | Text for as-built posting           |

STATE OF HAWAII  
DEPARTMENT OF TRANSPORTATION  
HIGHWAYS DIVISION

**LANDSCAPING PLANS**

VINEYARD BOULEVARD RESURFACING  
Vicinity of Palama St. to End of H-1 On-and-off Ramp  
Federal Aid Project No. STP-098-1(011)

Scale: 1"=40'      Date: November, 2012

SHEET No. 5 OF 5 SHEETS

\* Note: For details regarding watering New Rainbow Shower Trees, see Plan Sheet No. 46.

"AS-BUILT"