

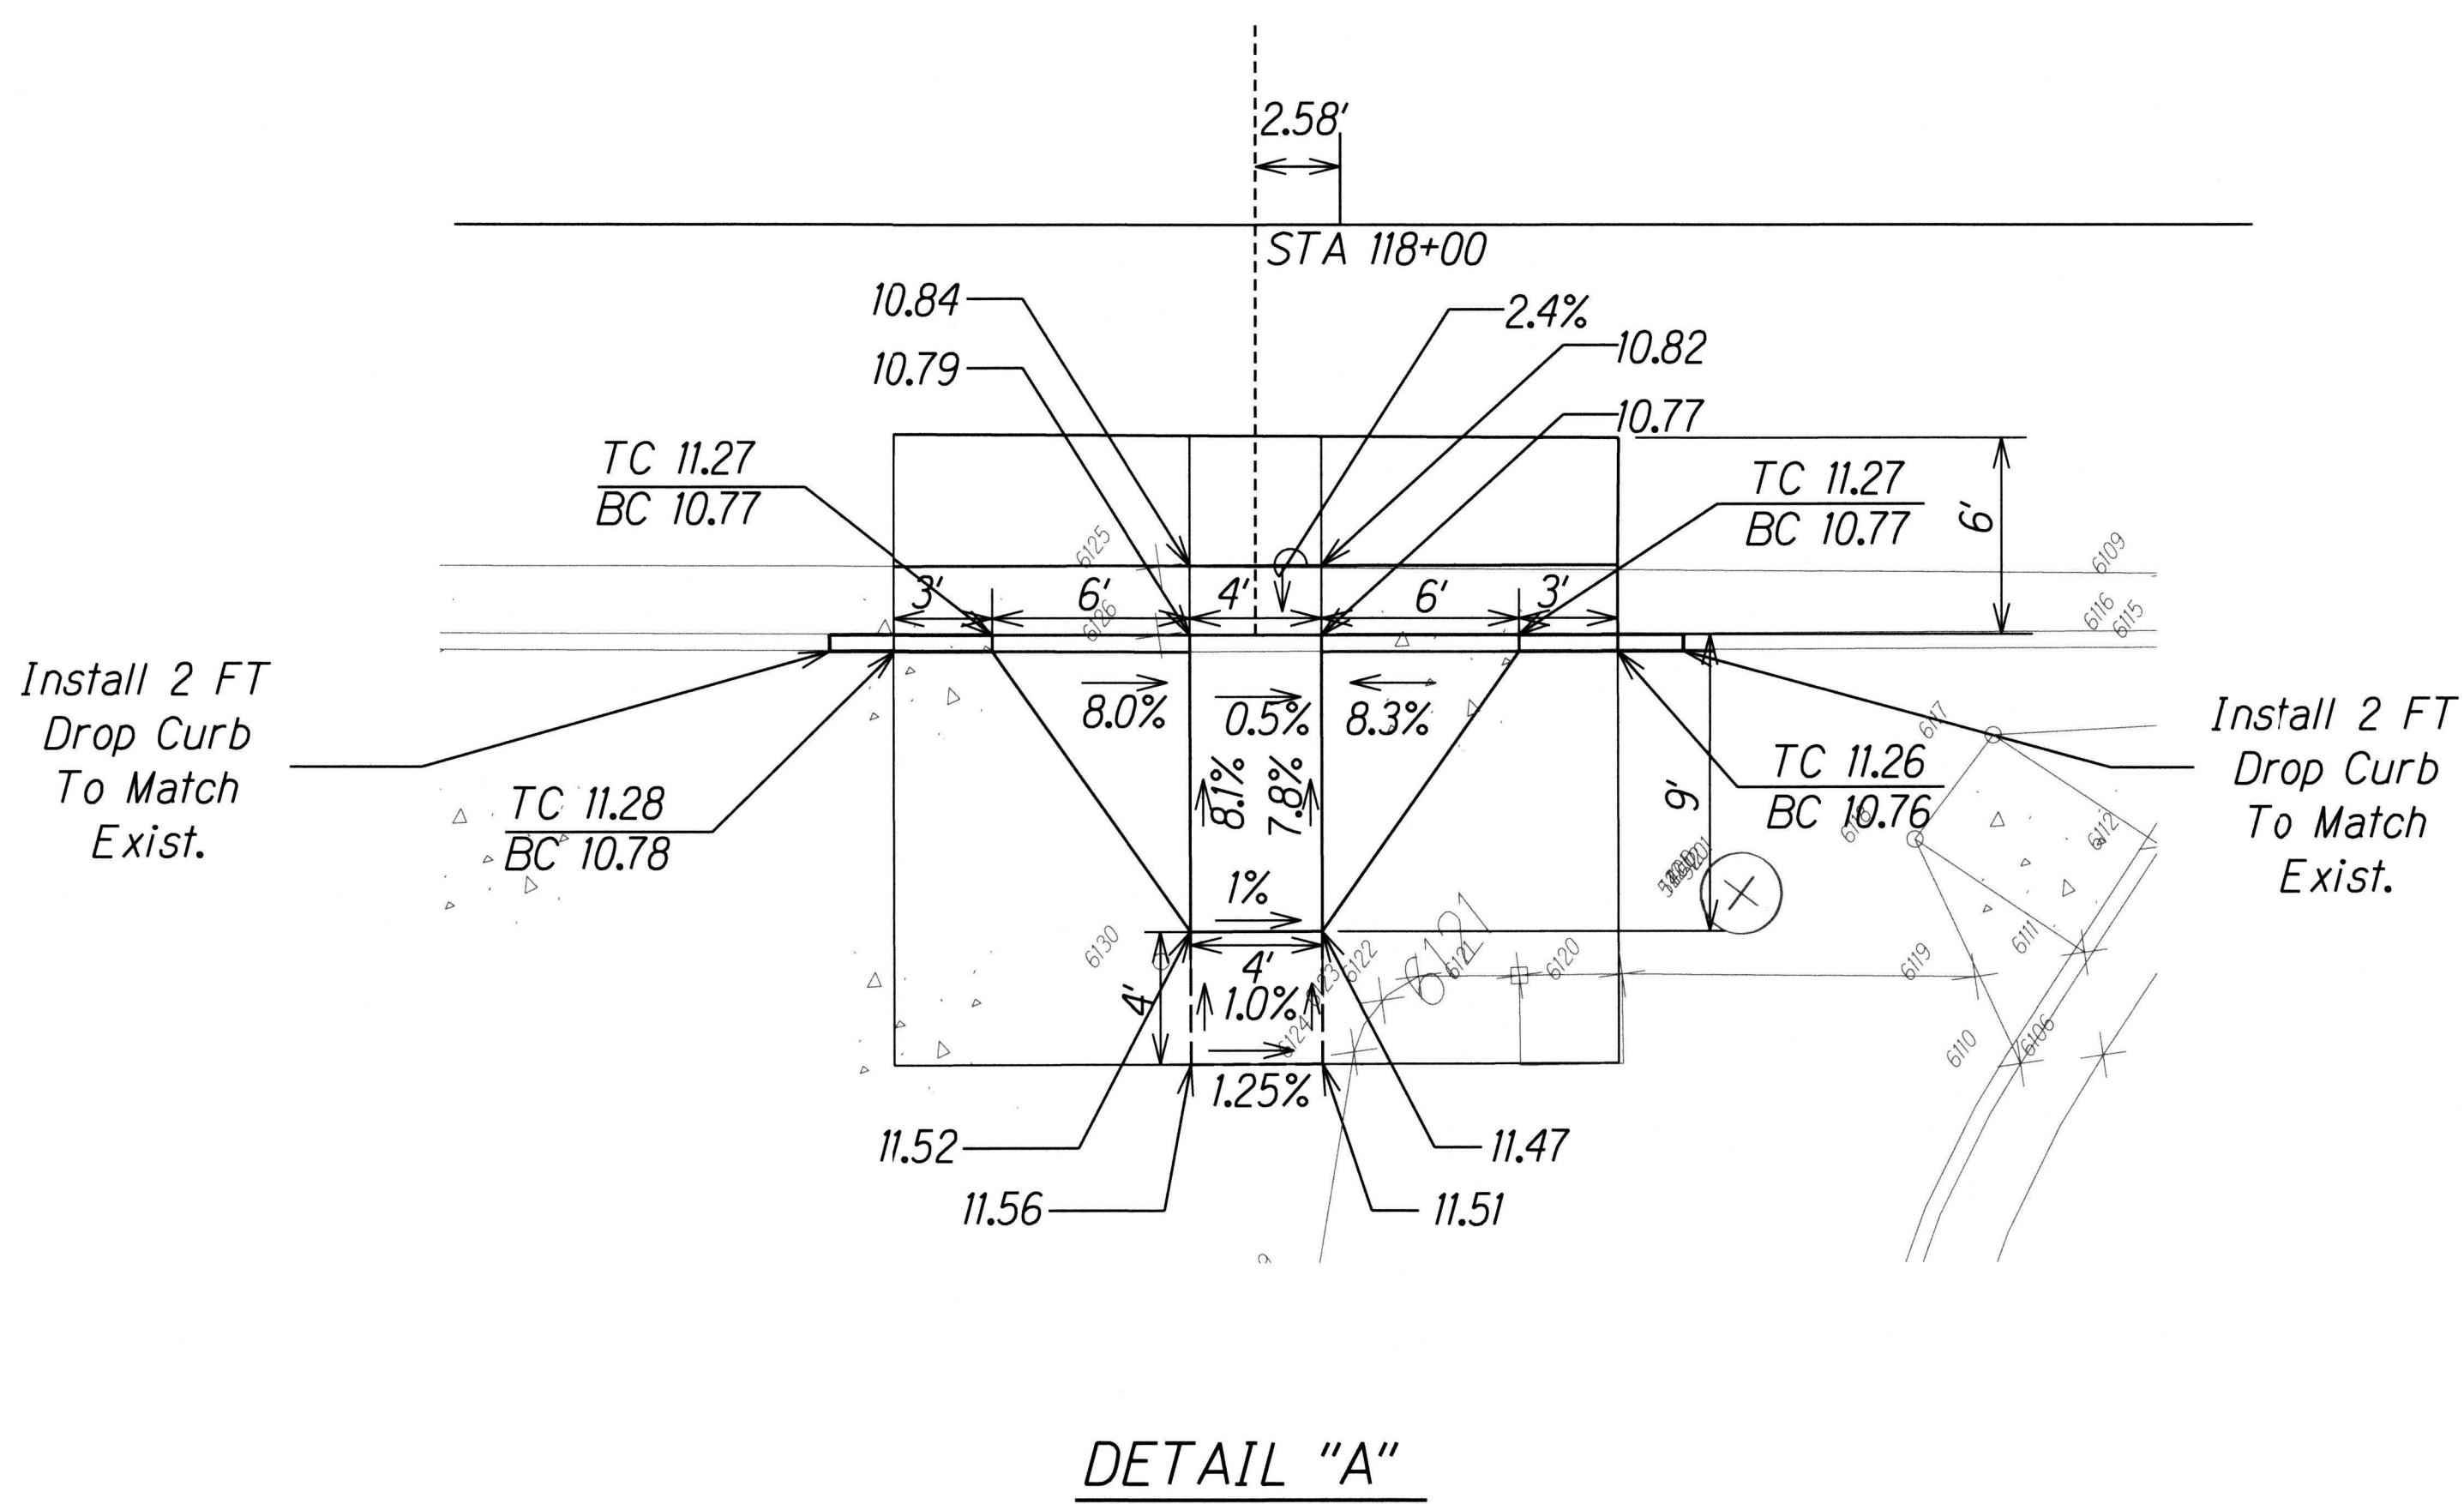
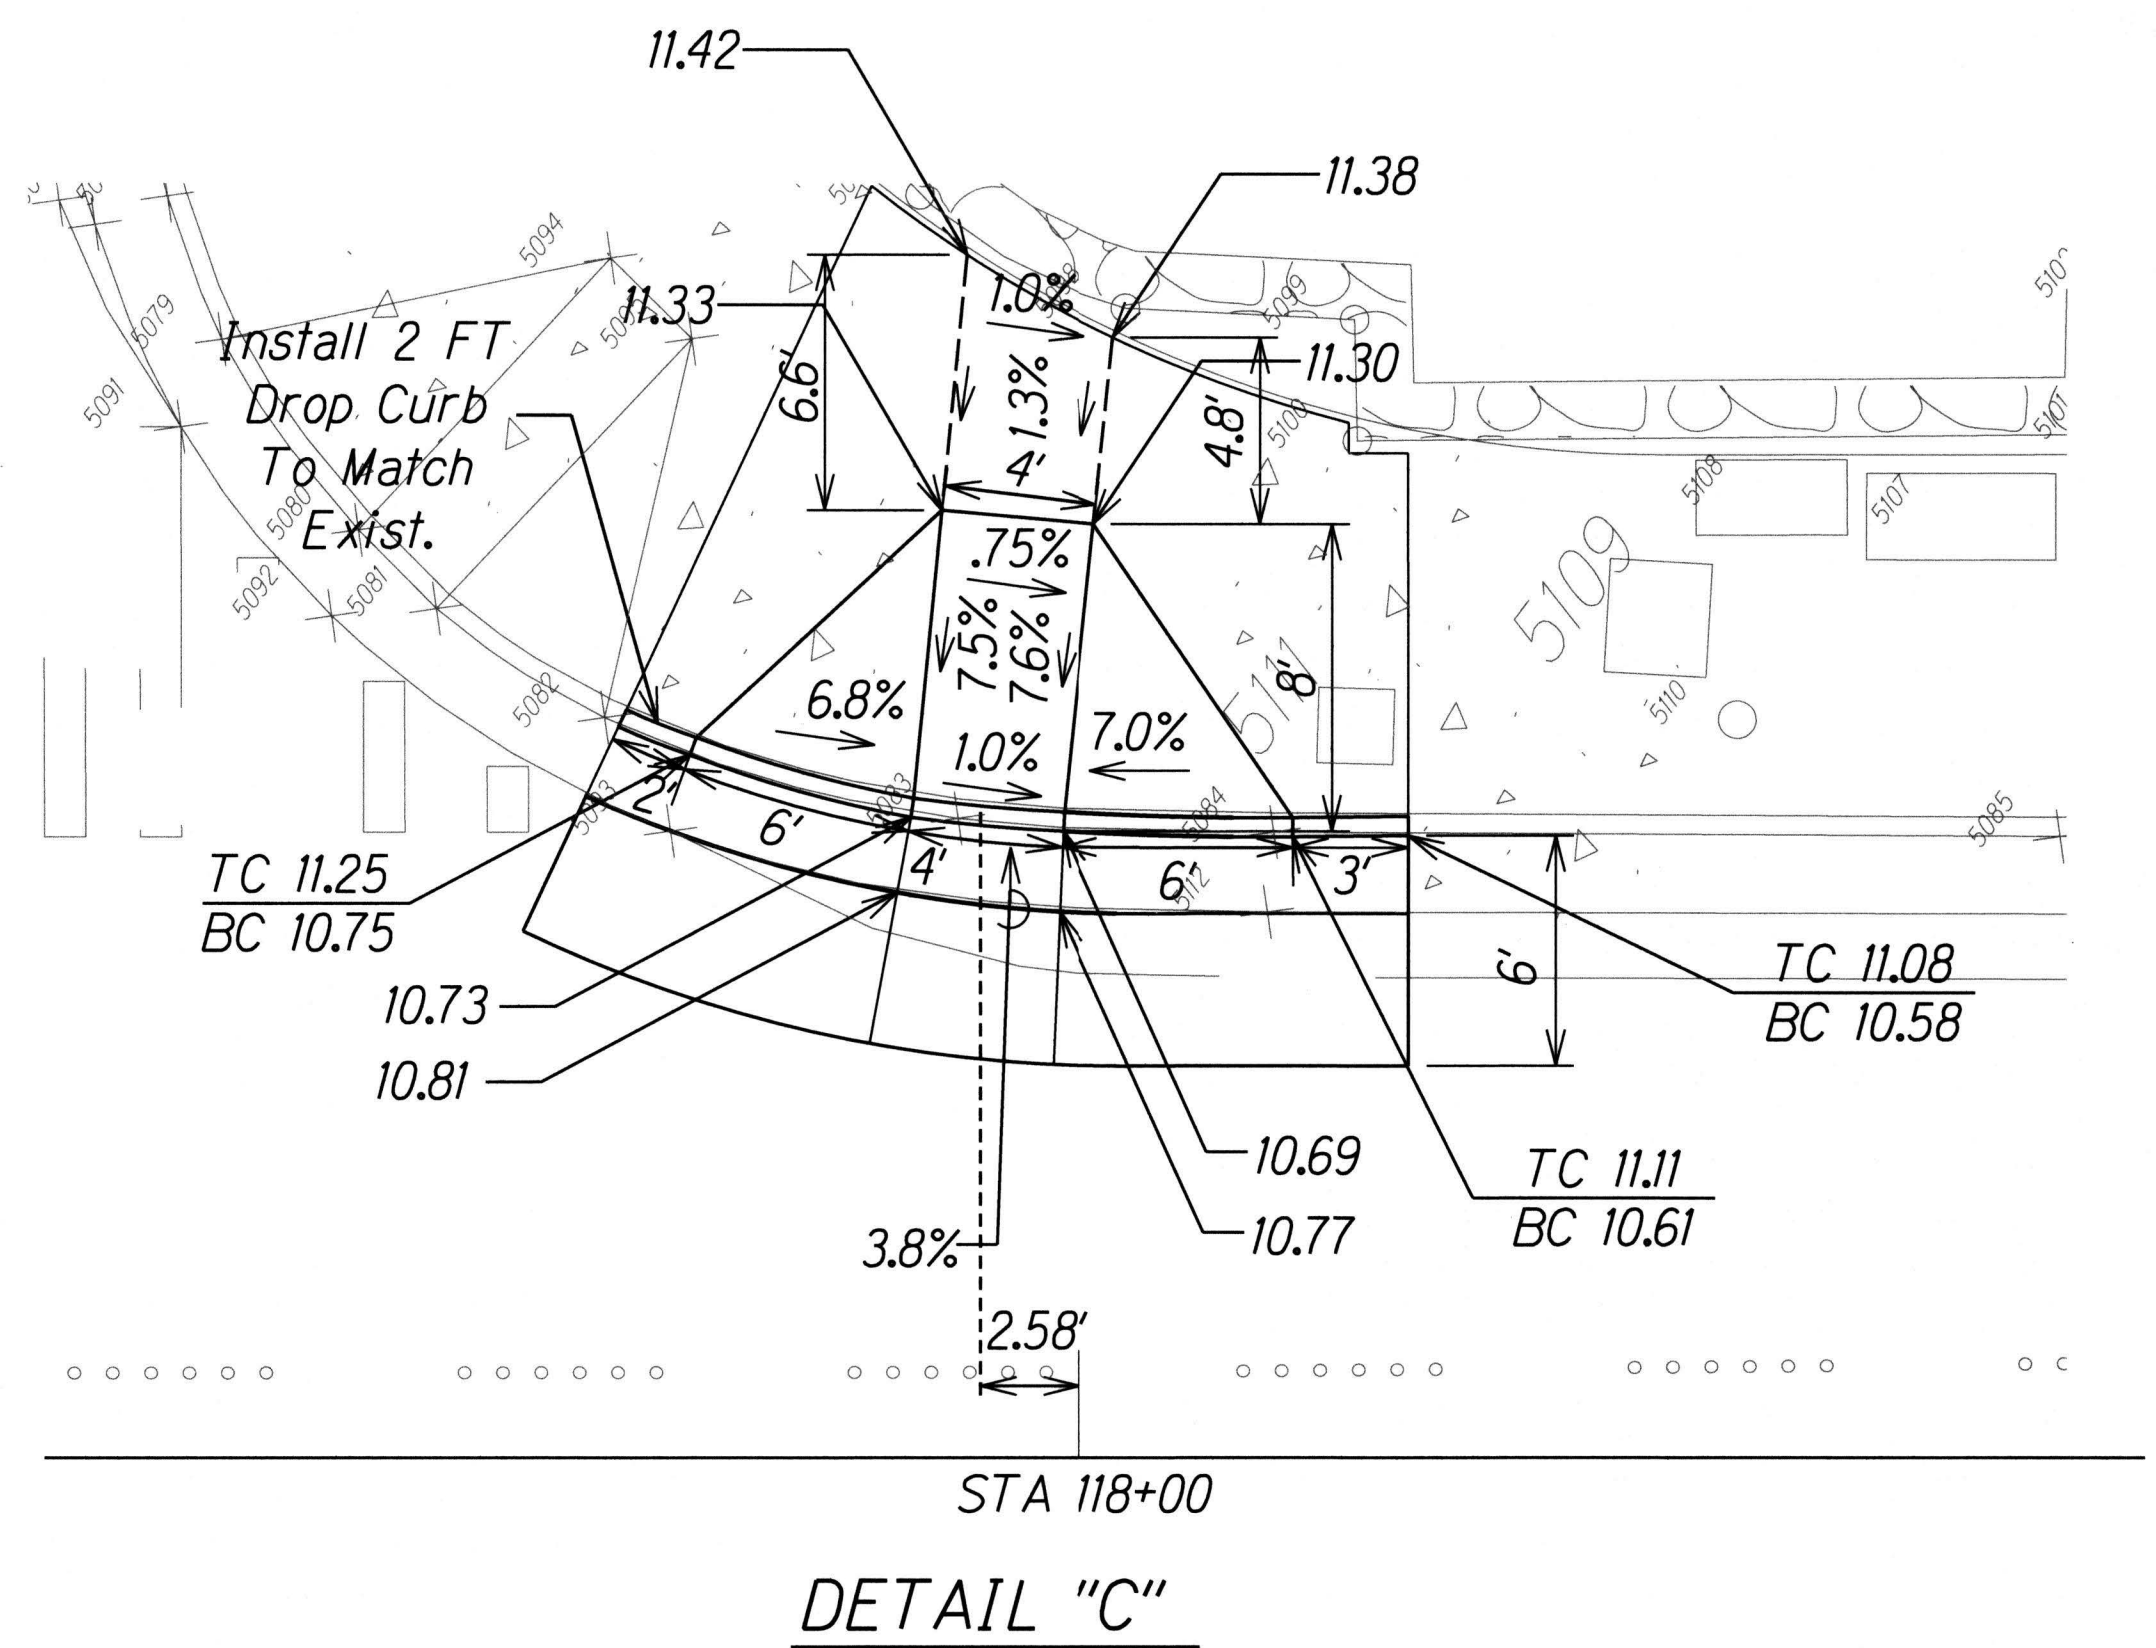
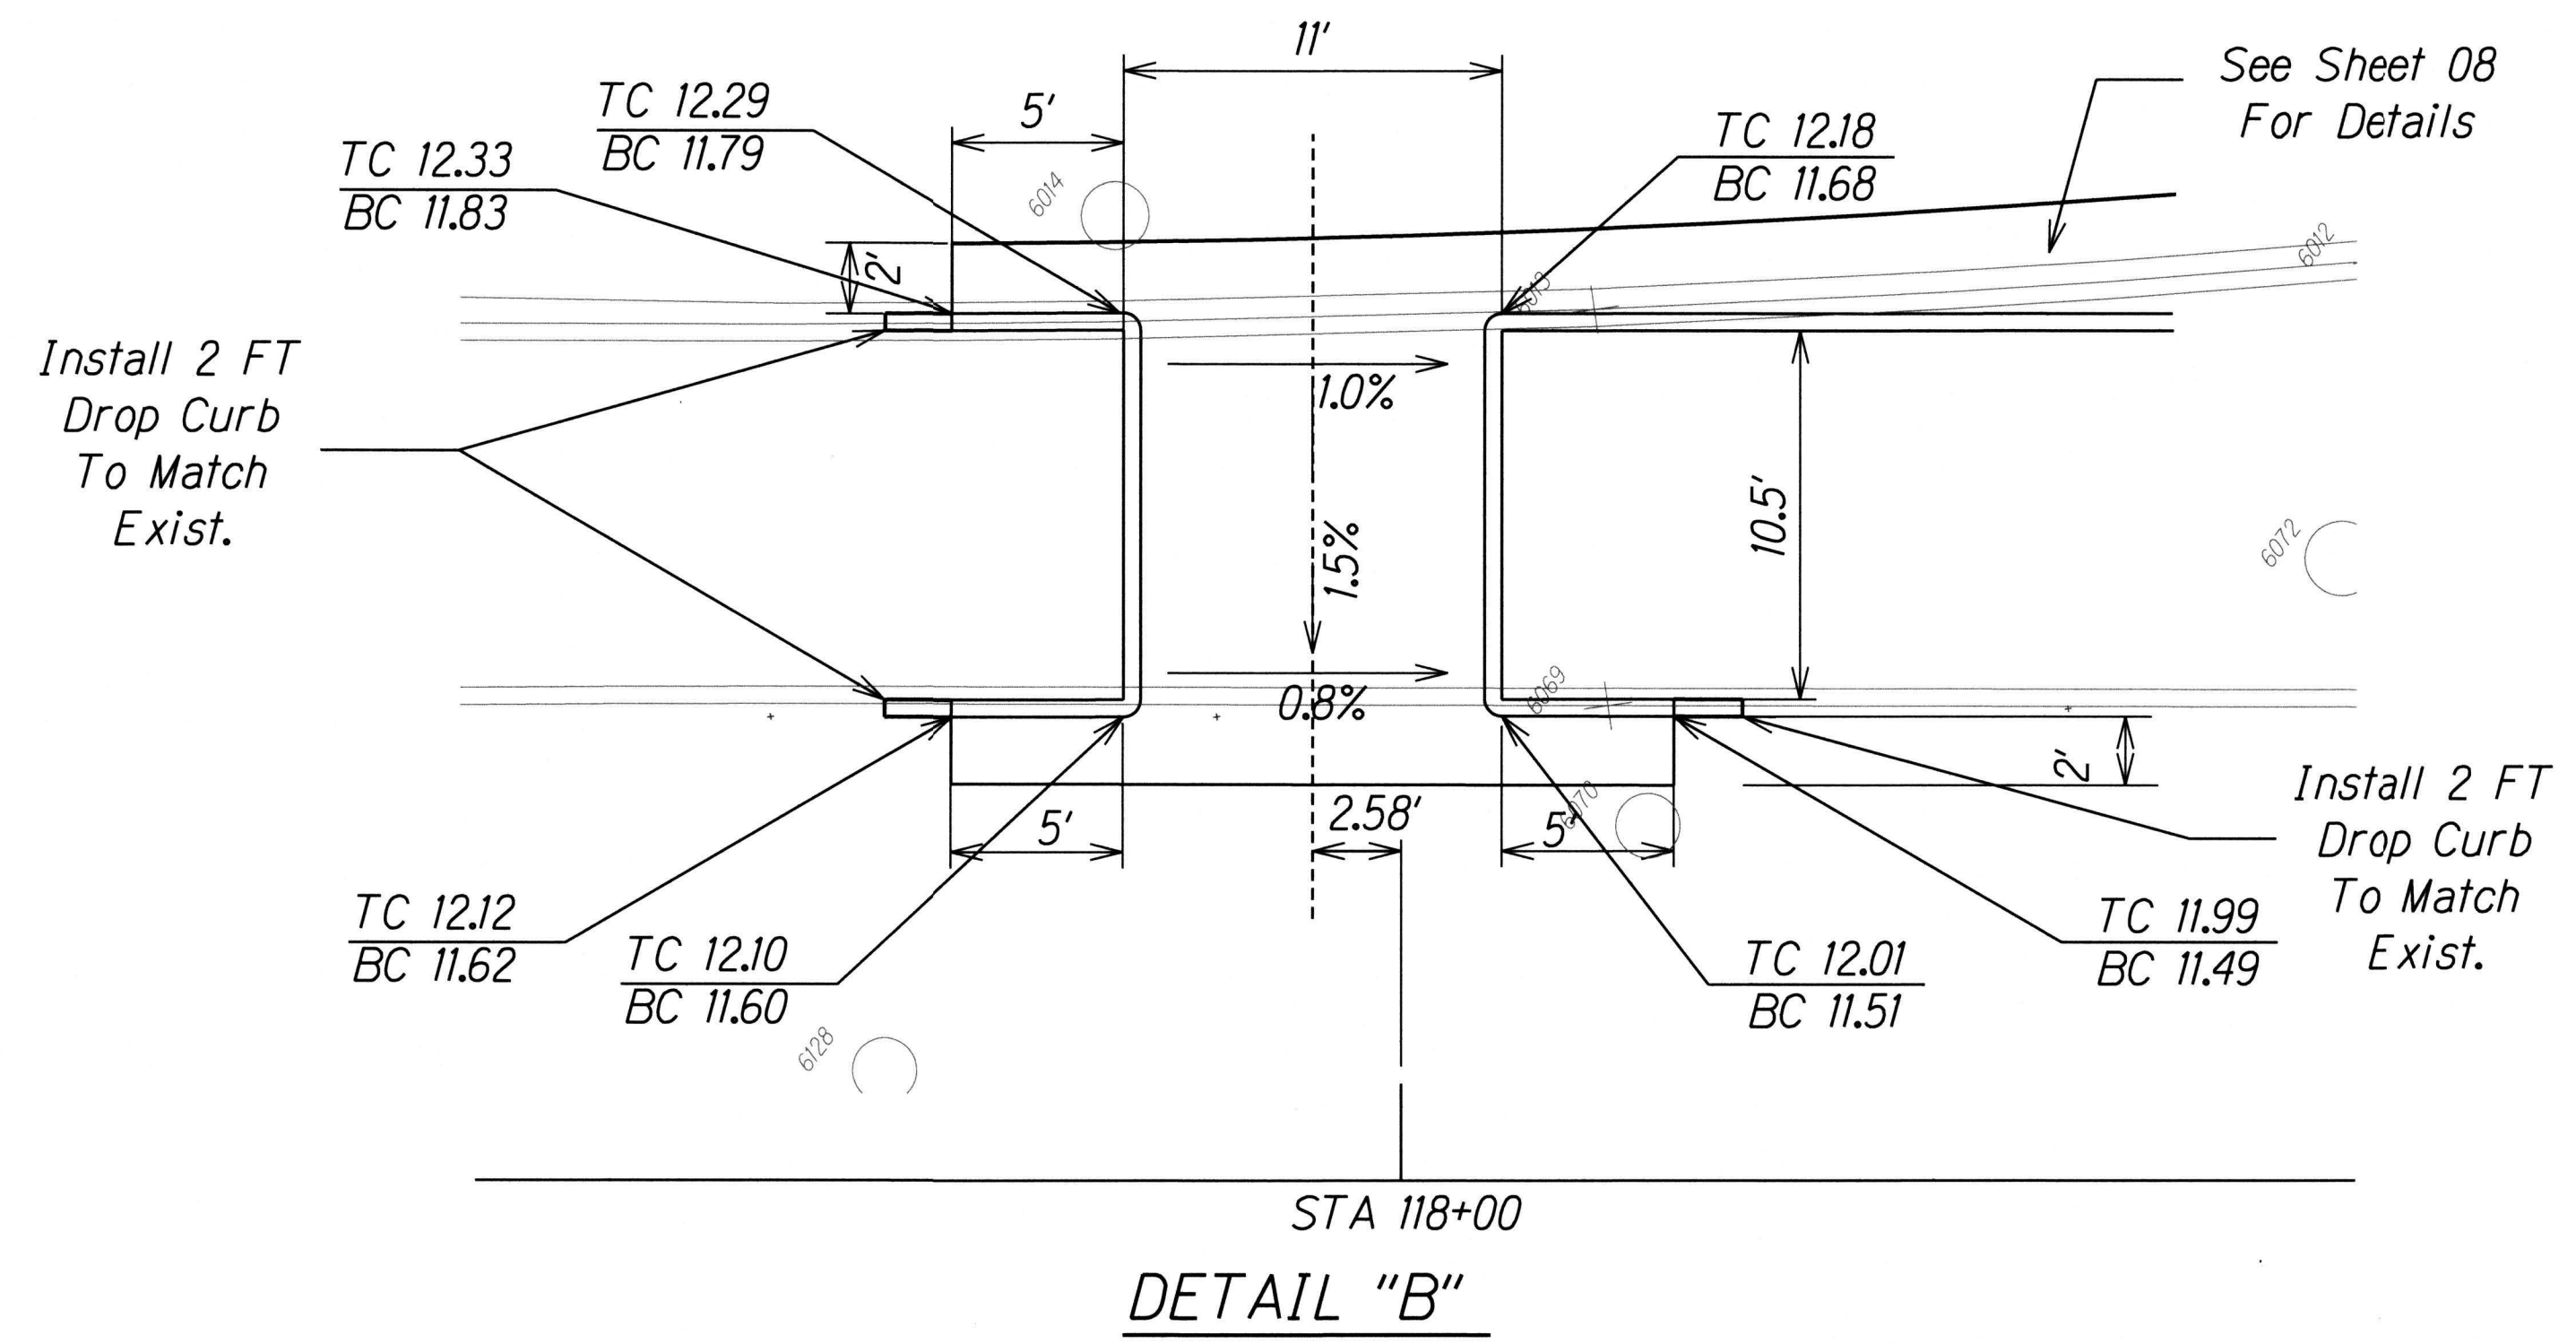


FED. ROAD DIST. NO.	STATE	PROJ. NO.	FISCAL YEAR	SHEET NO.	TOTAL SHEETS
HAWAII	HAW.	98A-01-15	2017	10	40

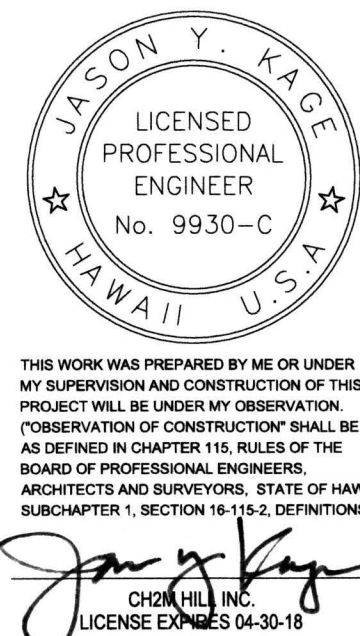

- Notes:**
- Contractor shall field verify all dimensions and connections
 - Contractor shall provide smooth riding connections

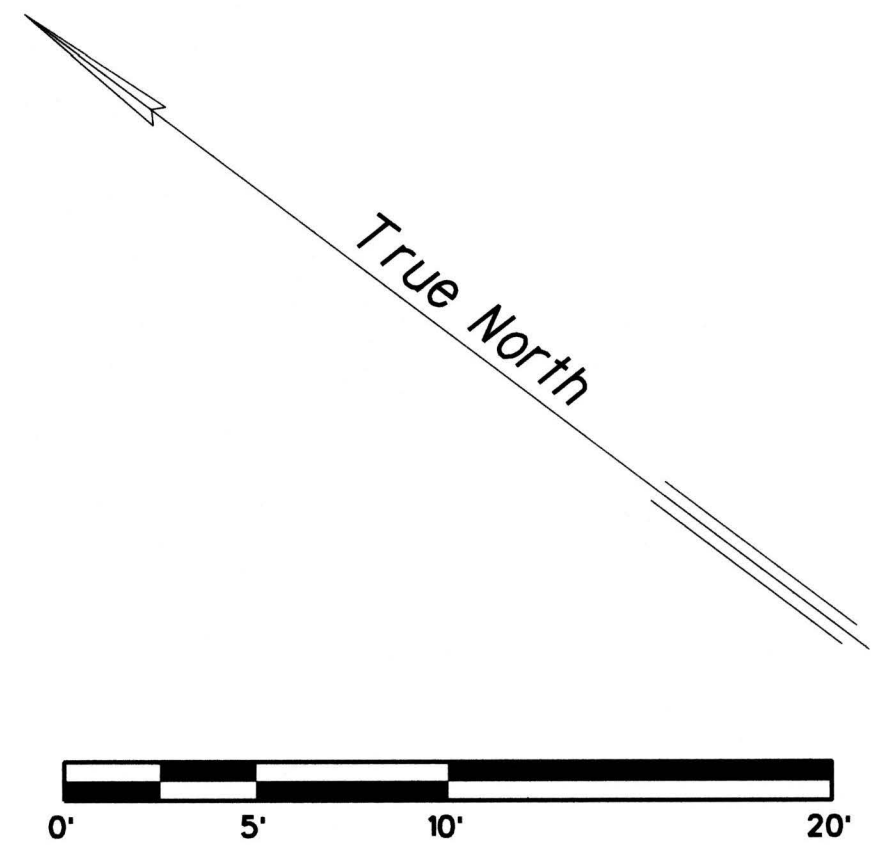

STATE OF HAWAII
DEPARTMENT OF TRANSPORTATION
HIGHWAYS DIVISION

CURB RAMP DETAILS

VINEYARD BOULEVARD
TRAFFIC SIGNALS AT RIVER STREET
PROJECT NO. 98A-01-15

Scale: 1"=5'
Date: June, 2017

SHEET No. 10 OF 34 SHEETS

ORIGINAL PLAN	SURVEY PLOTTED BY	DATE
NOTE BOOK	DRAWN BY	
	DESIGNED BY	
	QUANTITIES BY	
	CHECKED BY	