

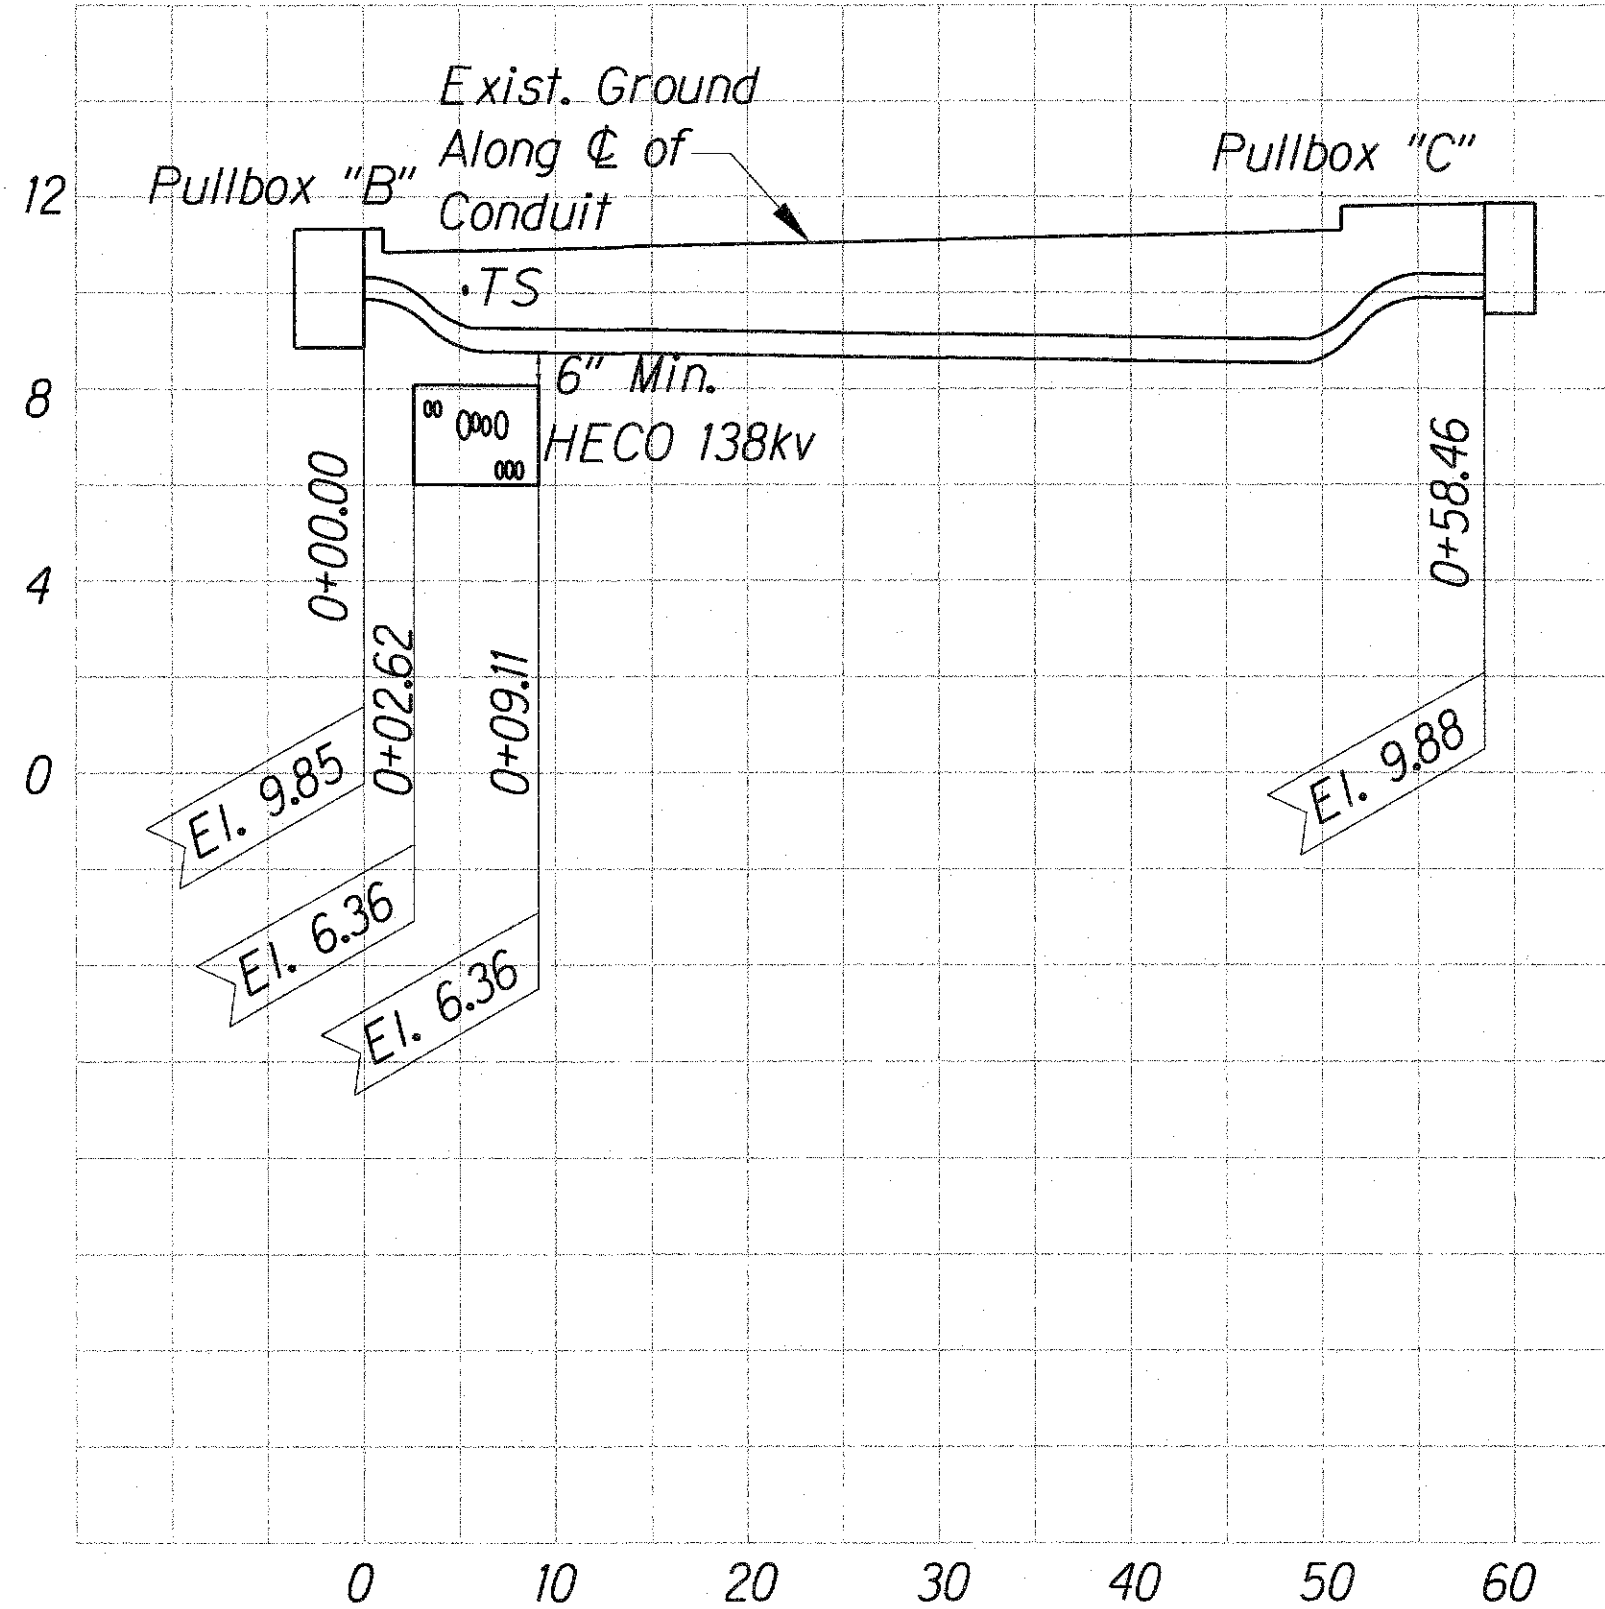
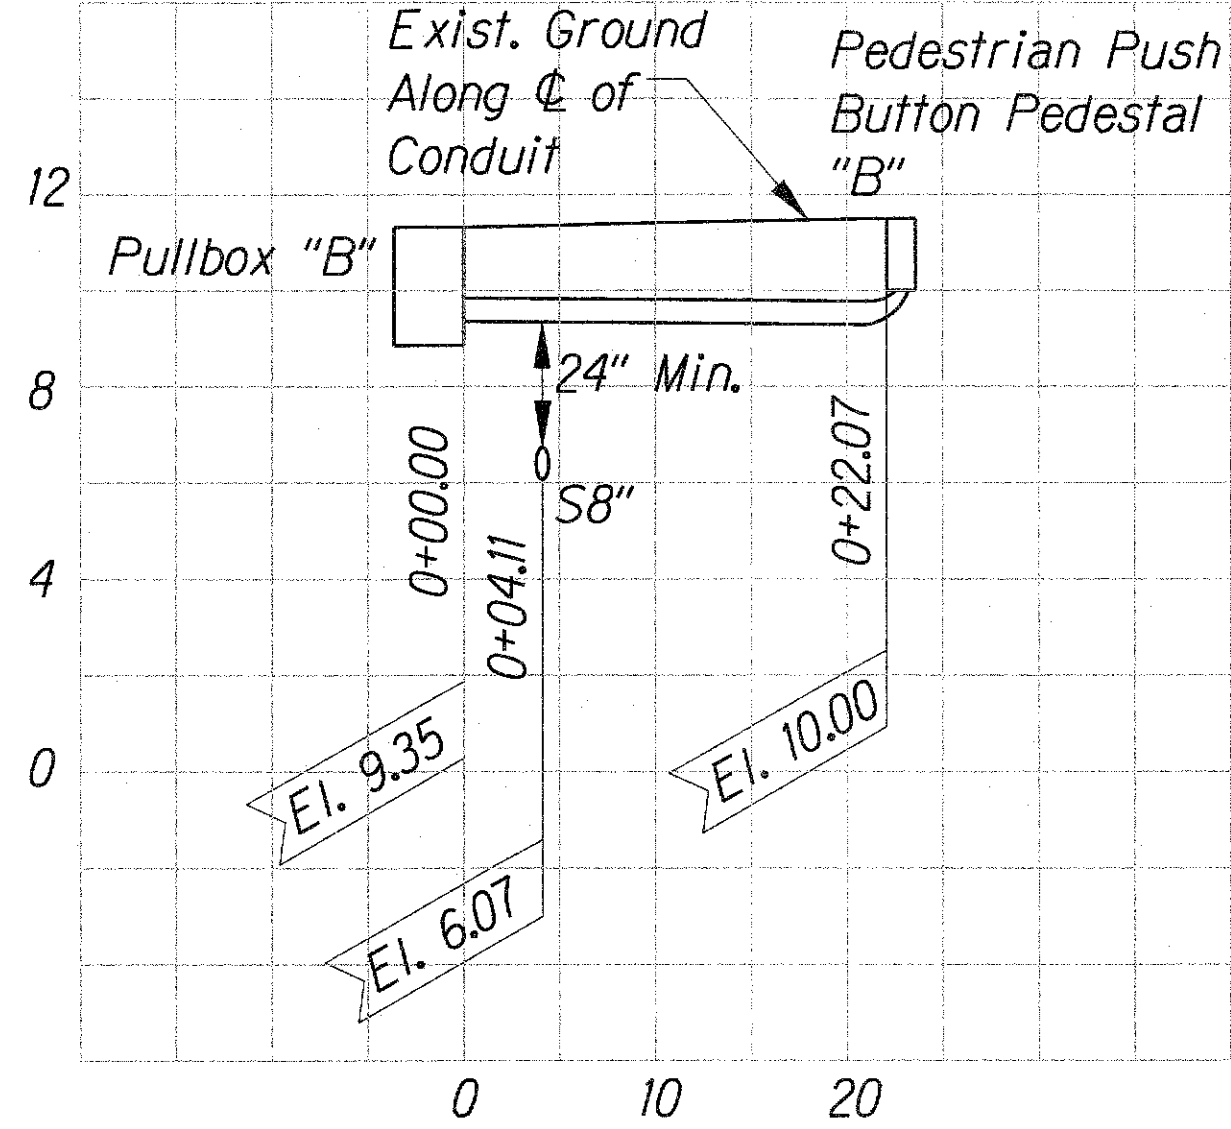
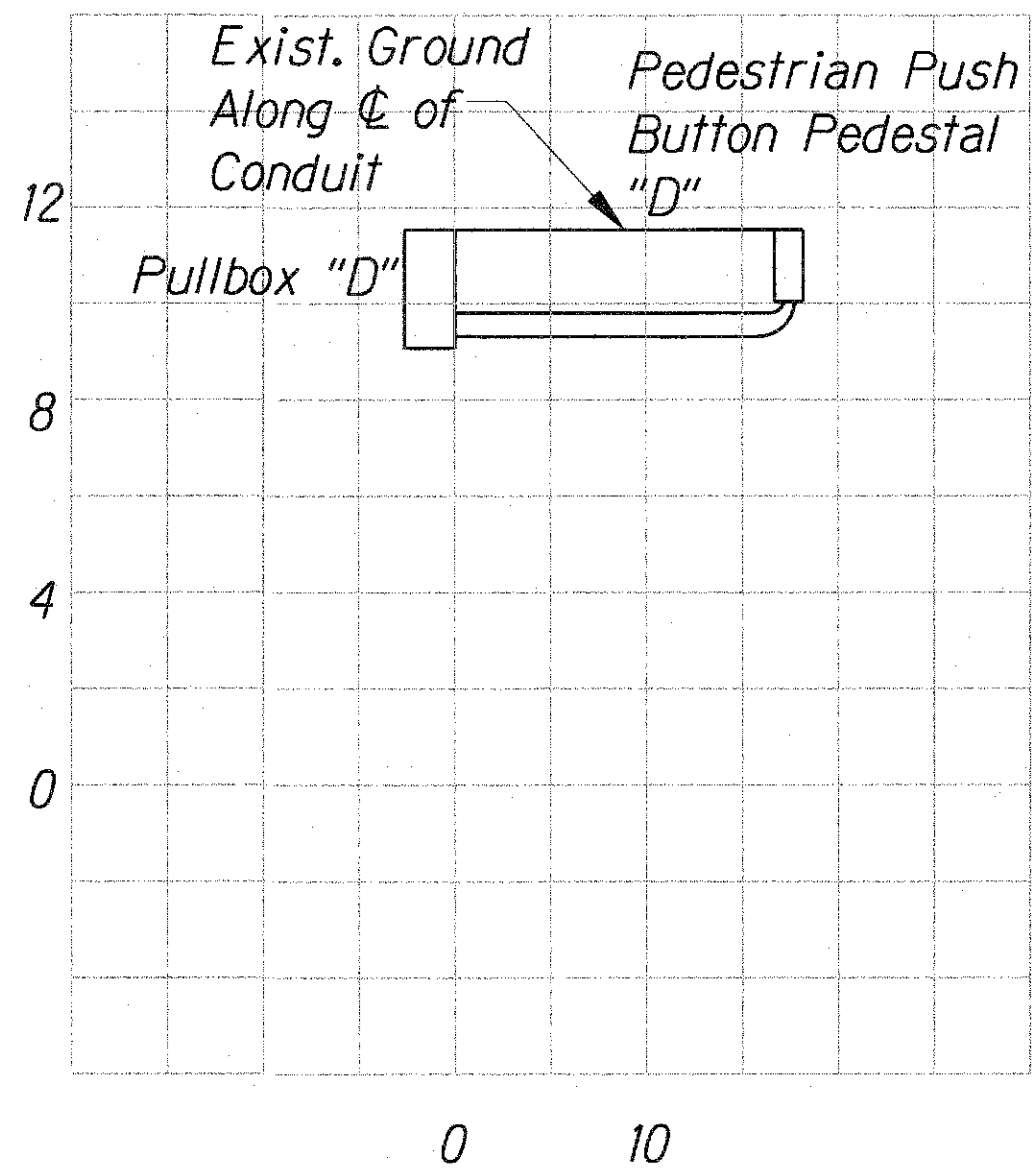
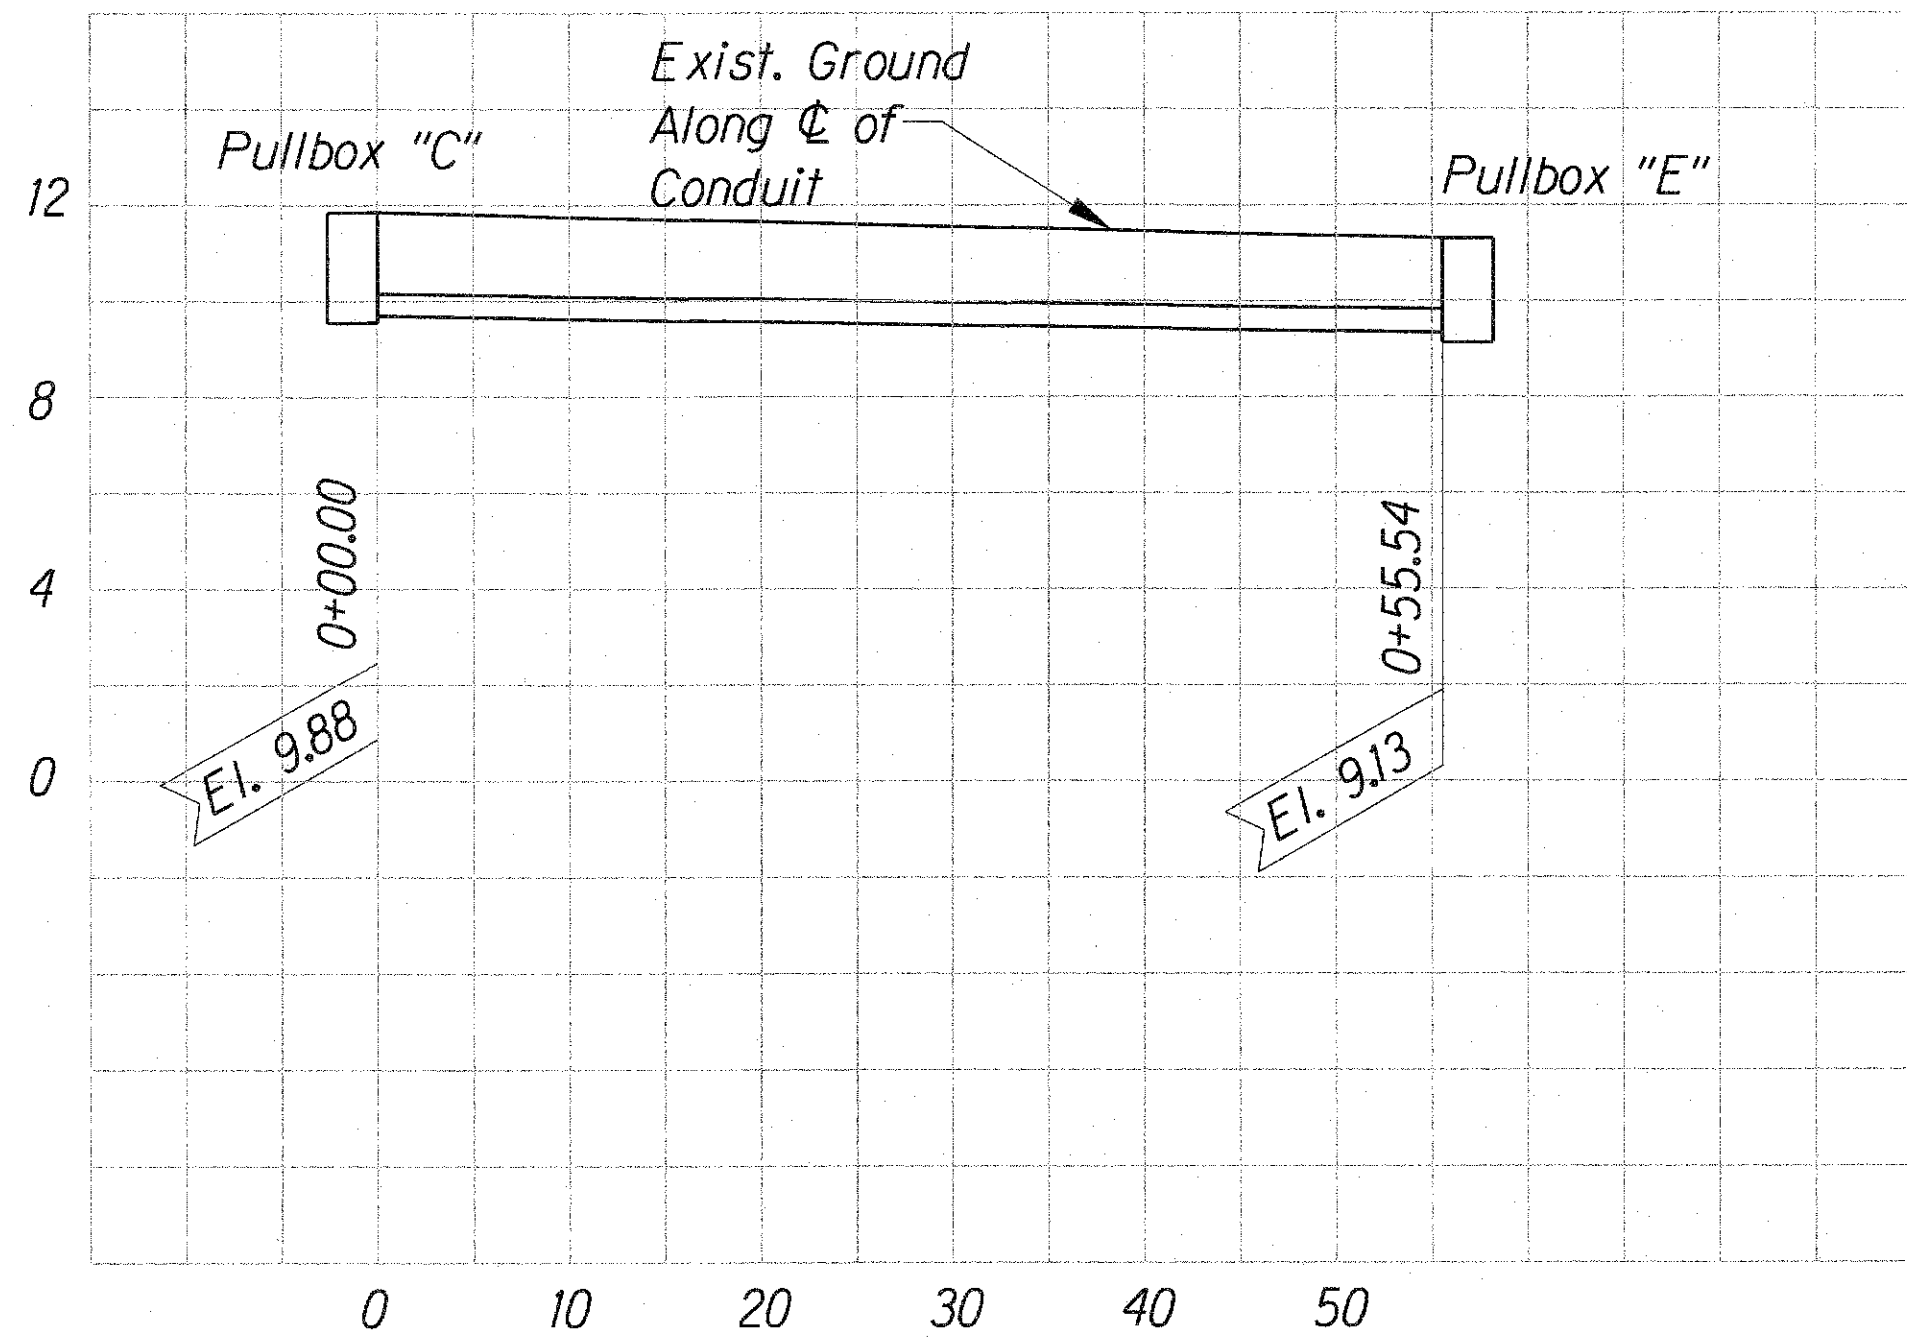
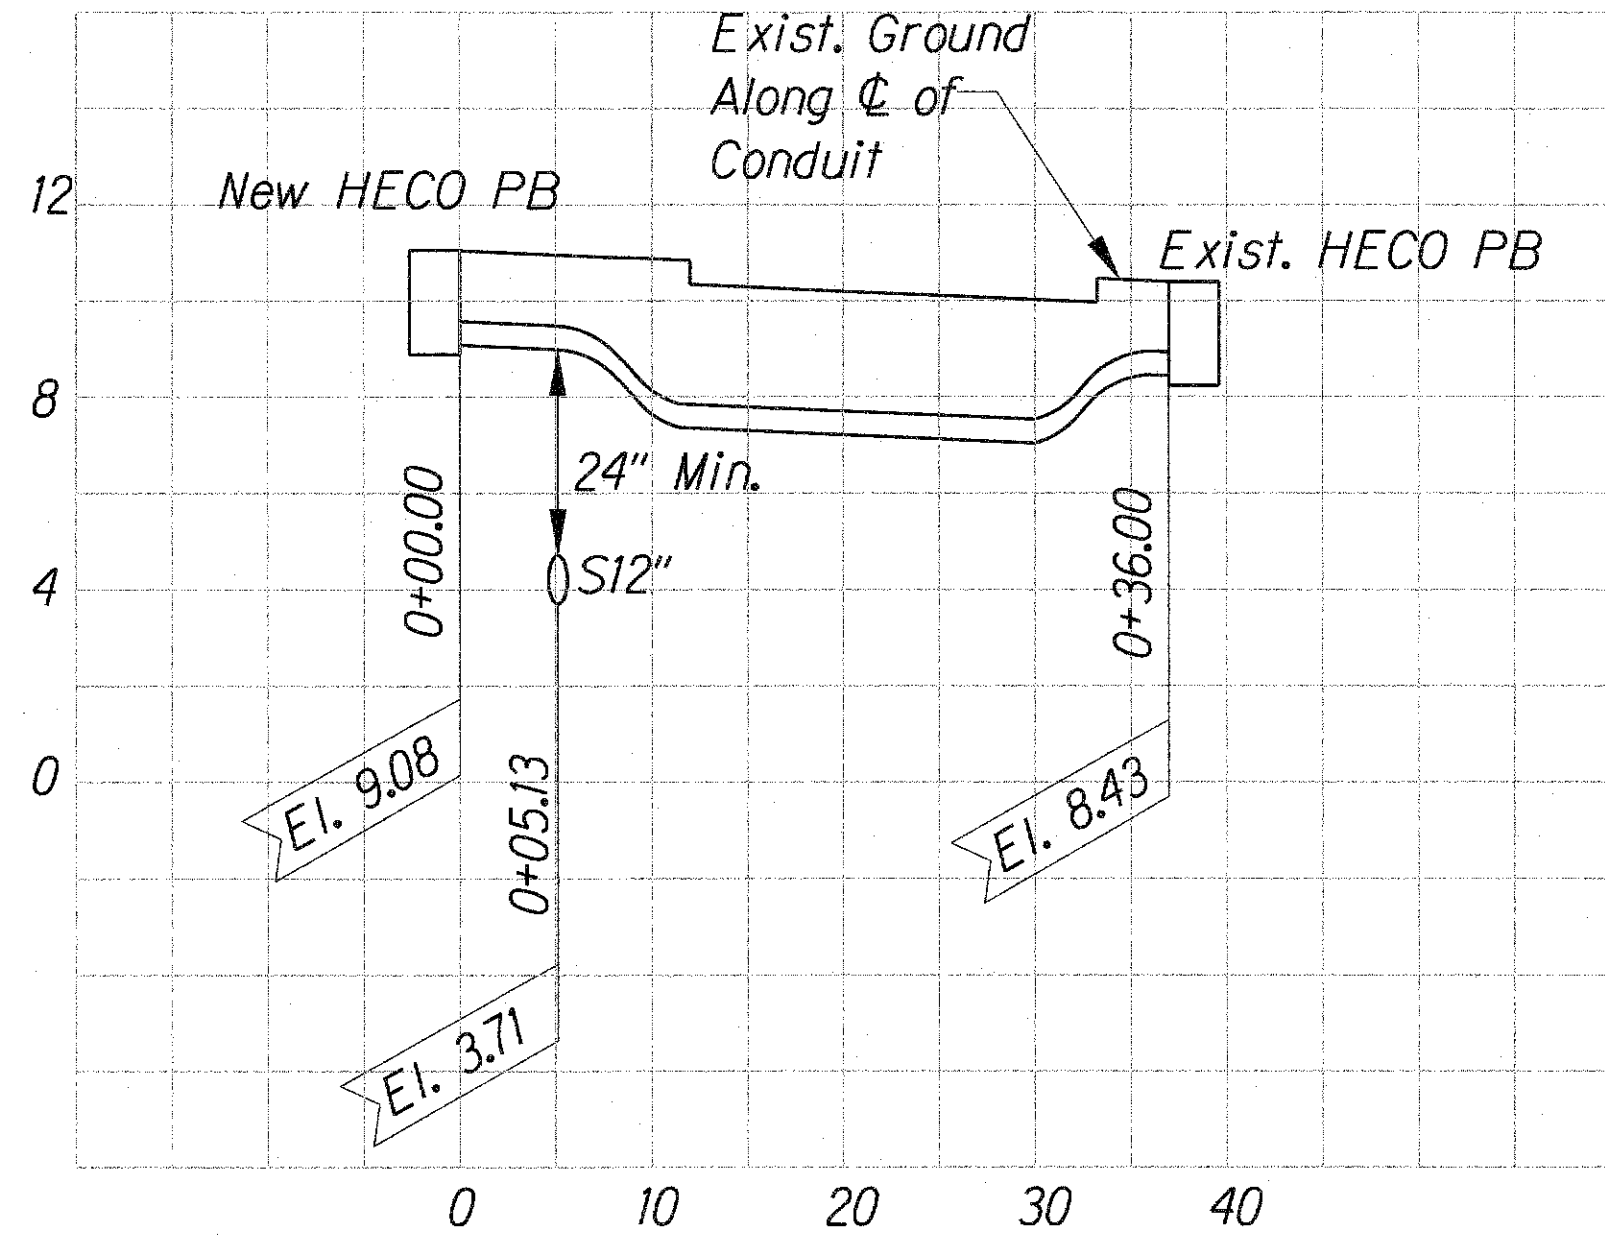
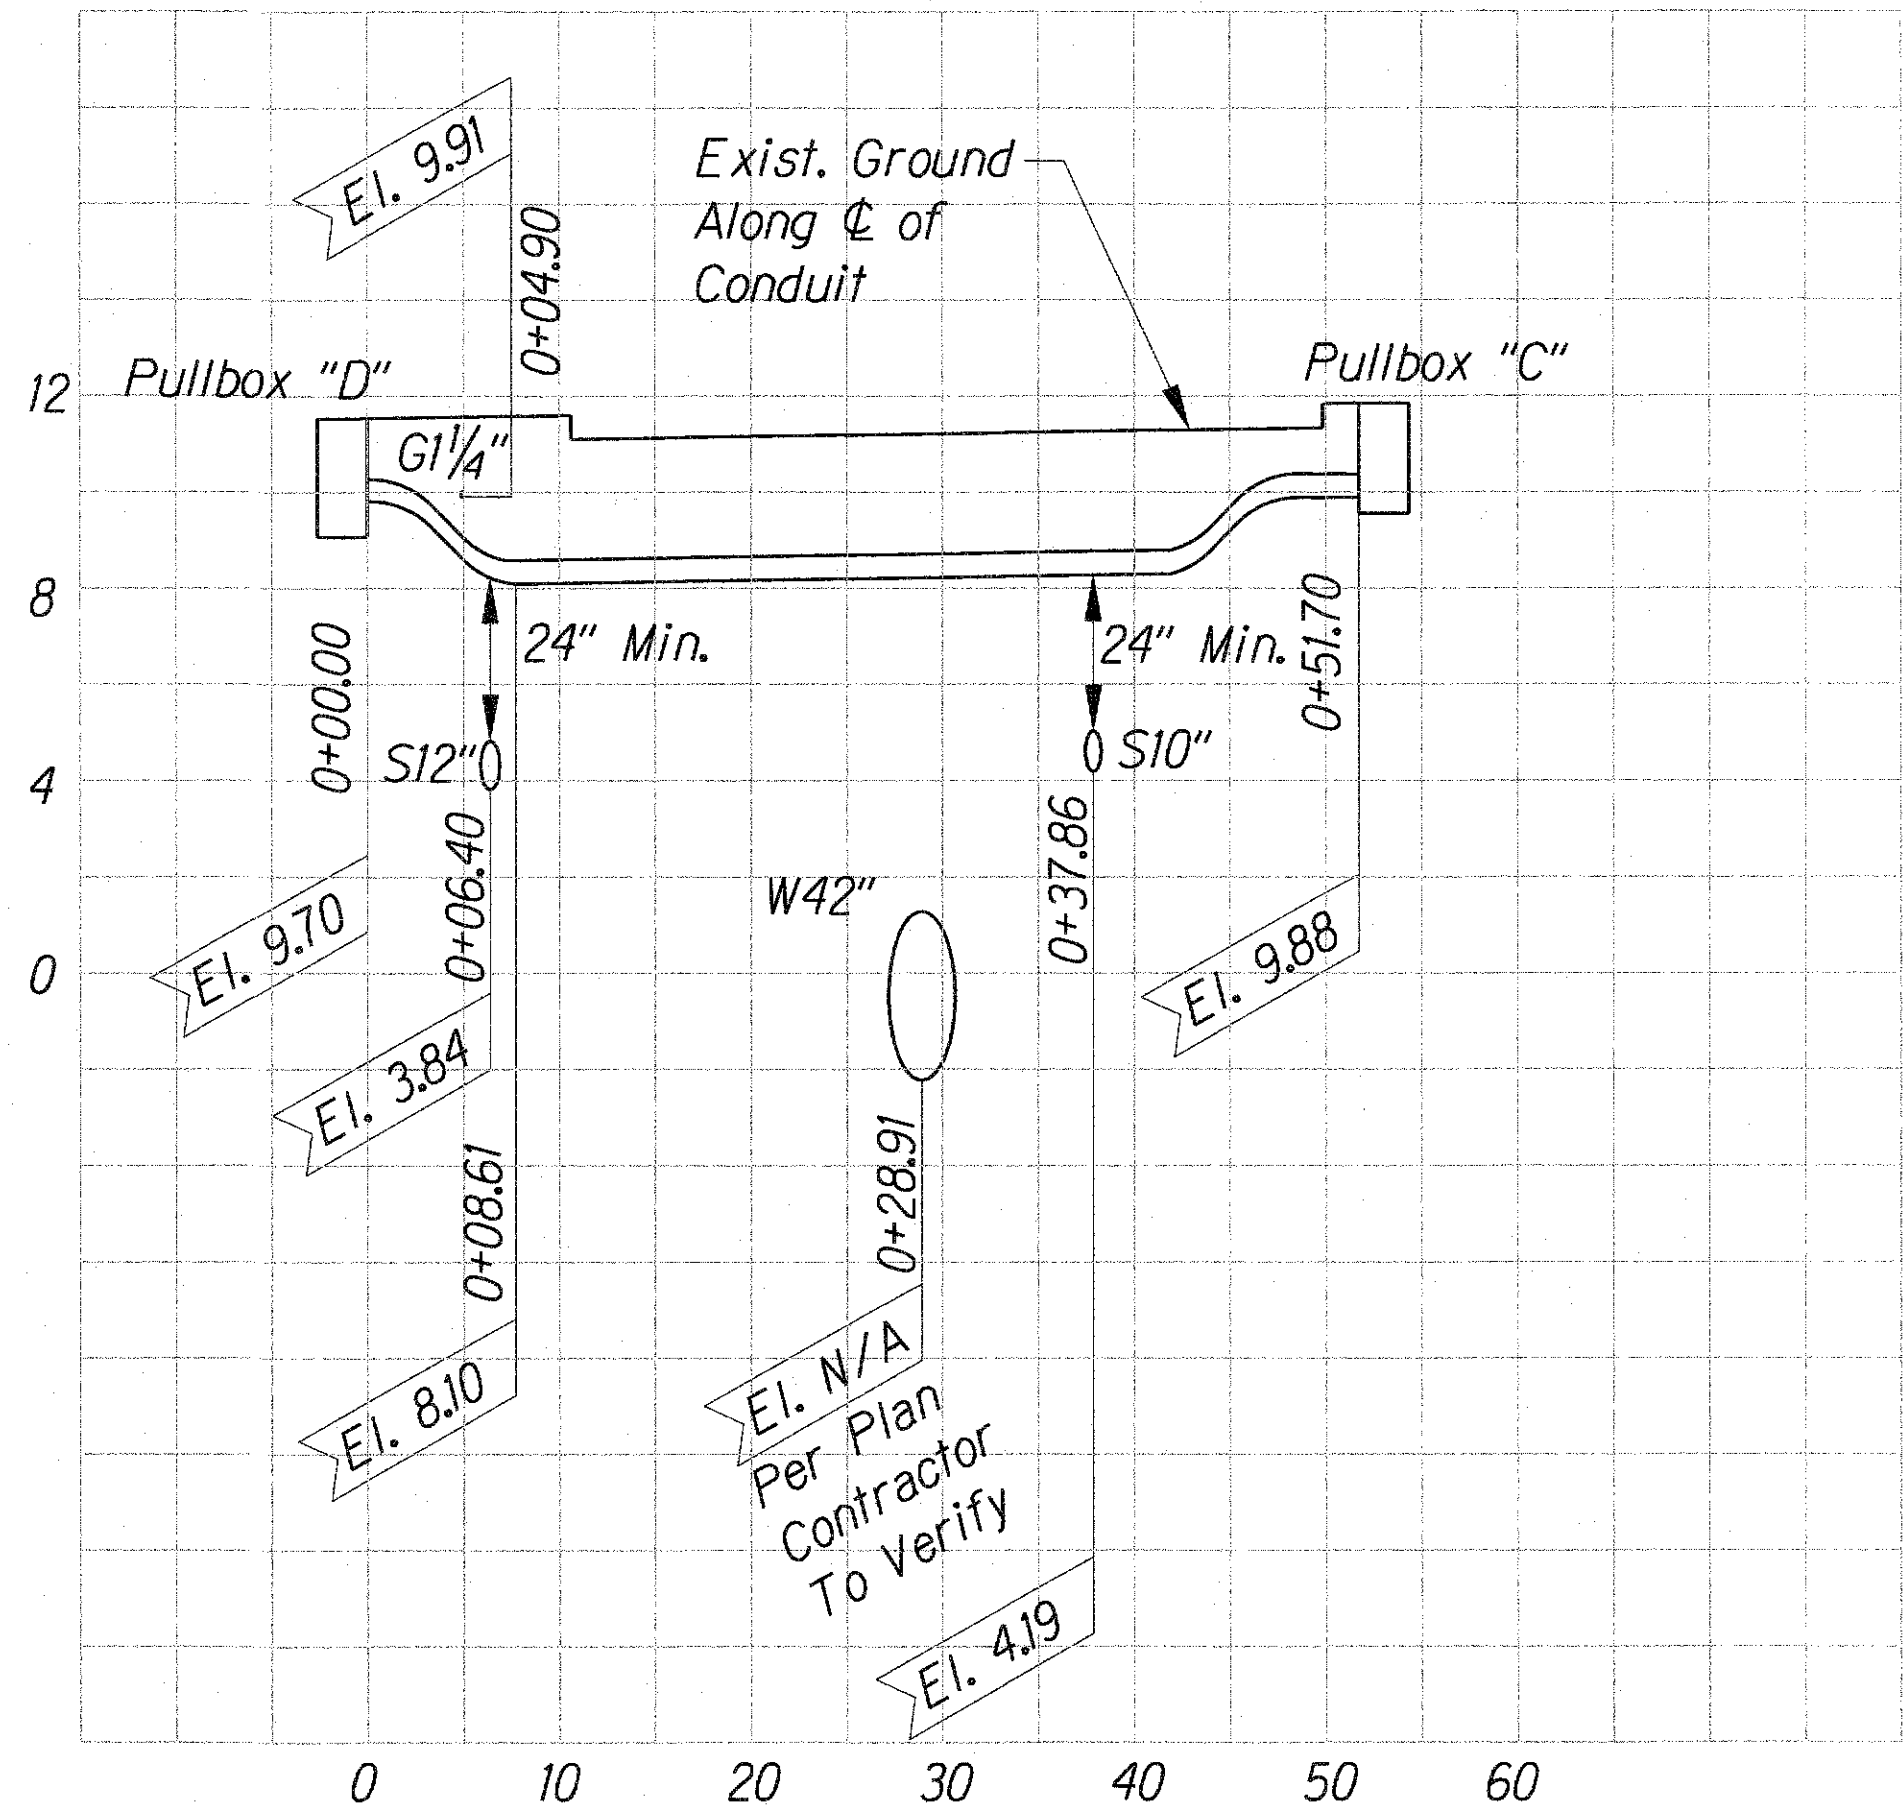


FED. ROAD DIST. NO.	STATE	PROJ. NO.	FISCAL YEAR	SHEET NO.	TOTAL SHEETS
HAWAII	HAW.	98A-01-15	2017	25	40

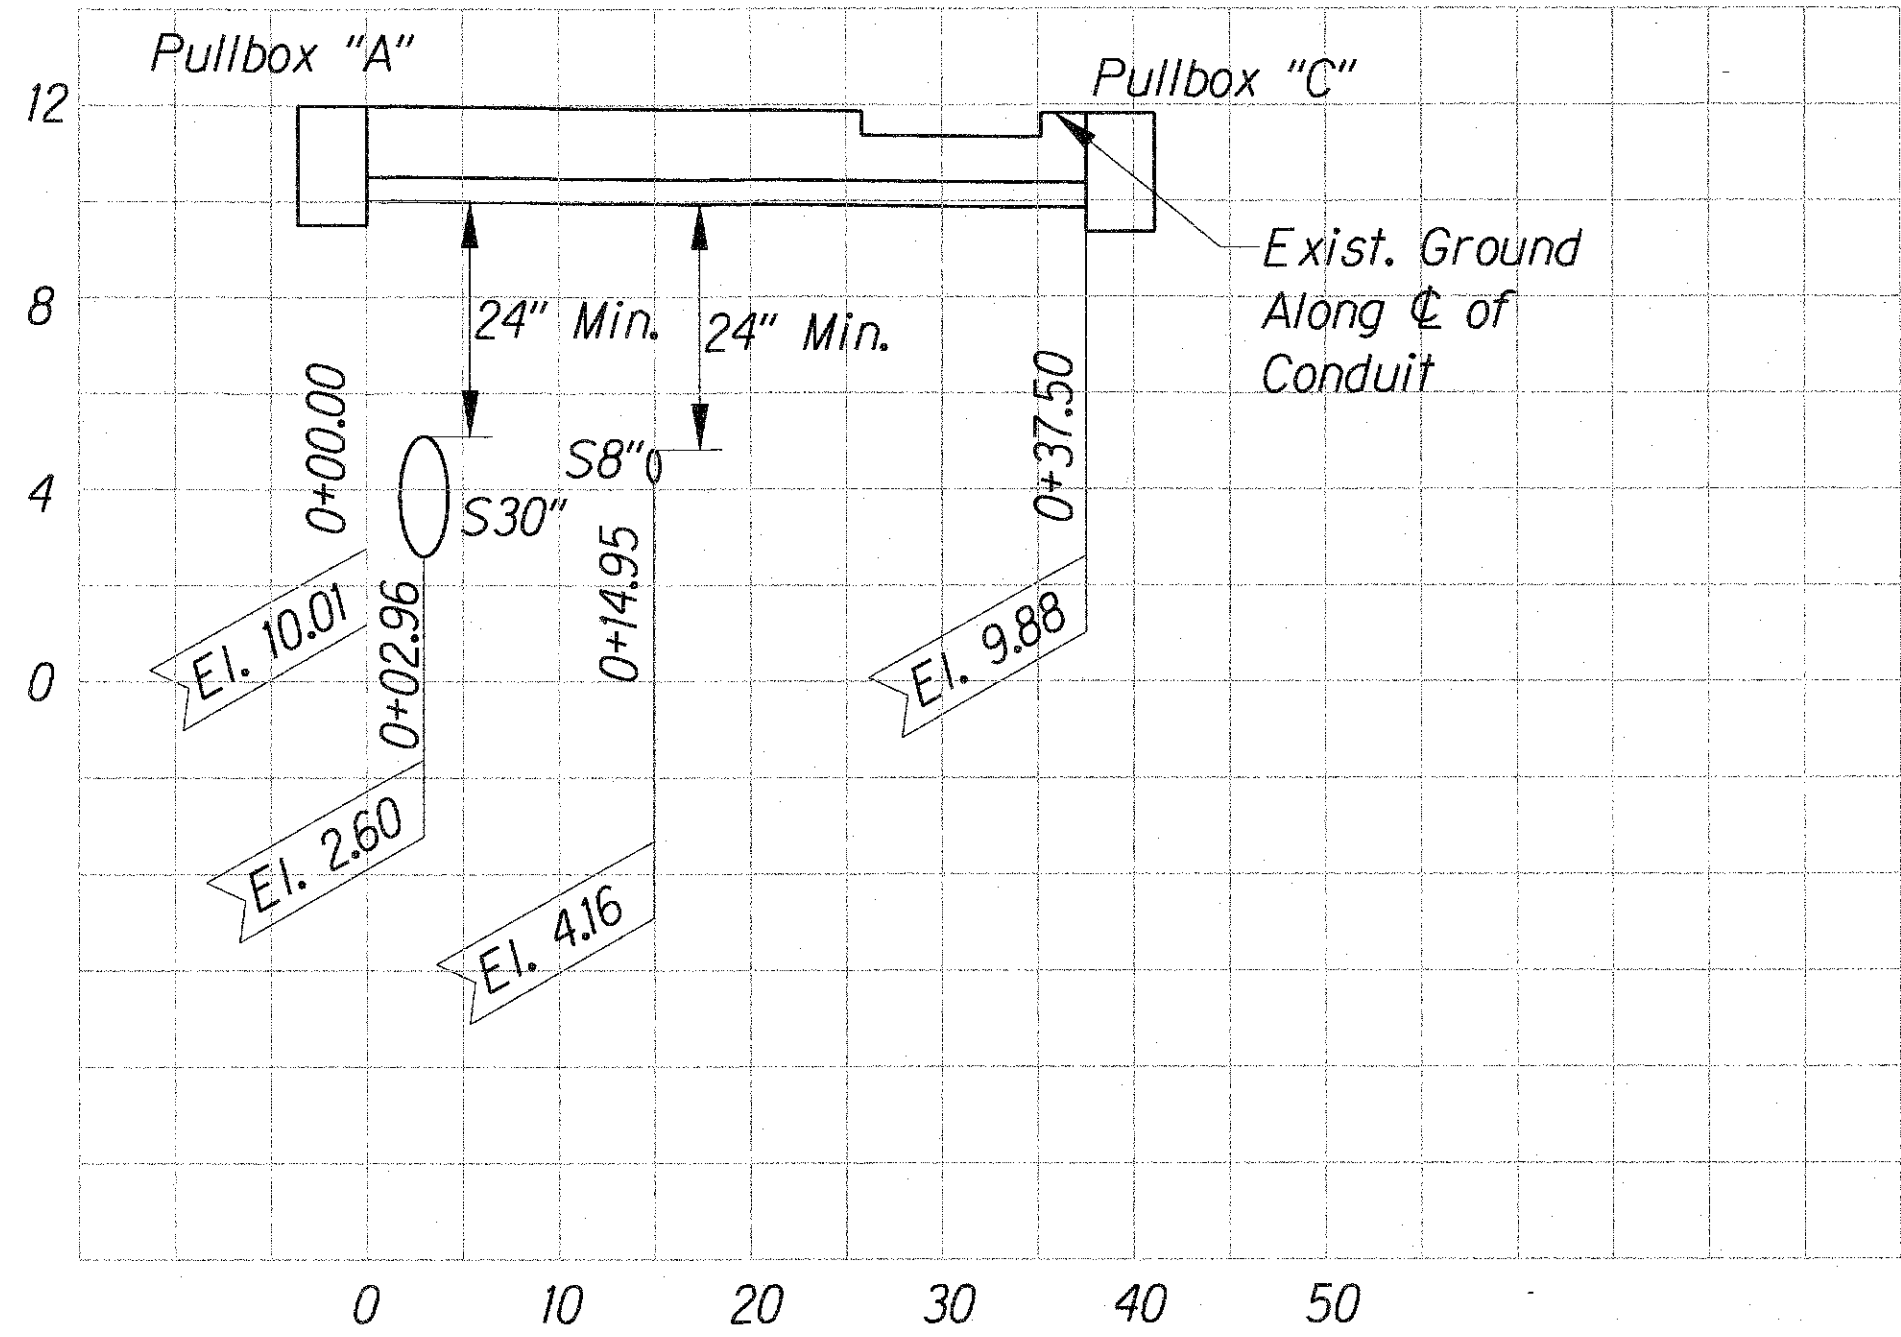


**Notes:**

1. Contractor to verify invert and locations.
2. Ductlines shall have a minimum of 2' clearance from Sewer, 3' clearance from Water mains and a minimum clearance of 12" from Gas lines.
3. There may be insufficient clearance at some utility crossing. Refer to TE-36 Conduit By-Pass Detail.

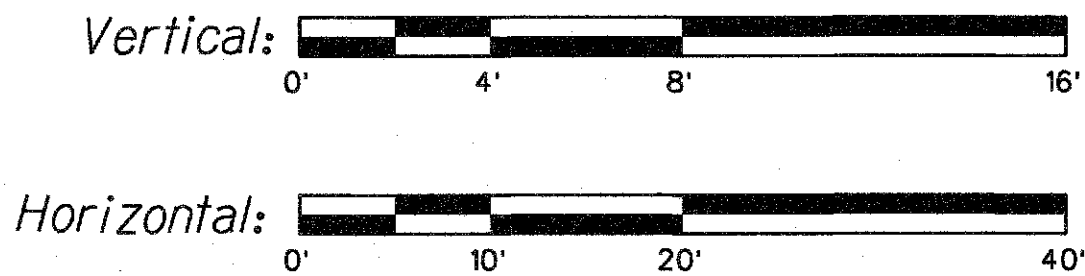

DATE	REVISION
1/14/19	REVISED PROFILE FROM PULLBOX A TO PULLBOX C
12/7/18	REVISED OLD PROFILE FROM PULLBOX D TO PULLBOX E TO NEW PULLBOX C TO PULLBOX E
10/24/18	REVISED SHEET TO SHOW EXIST. GROUND AND 30\"/>

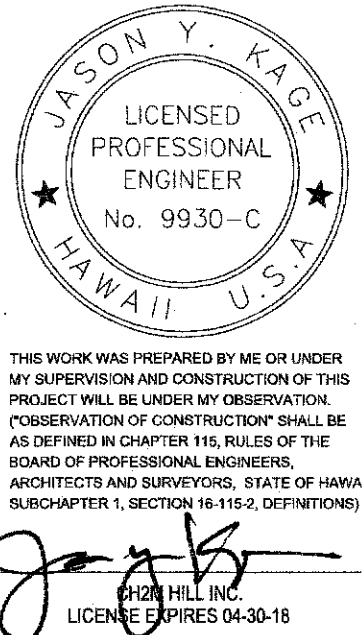

STATE OF HAWAII  
DEPARTMENT OF TRANSPORTATION  
HIGHWAYS DIVISION

**PROFILE DETAIL**  
**VINEYARD BOULEVARD**  
**TRAFFIC SIGNALS AT RIVER STREET**  
**PROJECT NO. 98A-01-15**

Scale: AS NOTED      Date: June, 2017

SHEET No. 25 OF 34 SHEETS