



FED. ROAD DIST. NO.	STATE	PROJ. NO.	FISCAL YEAR	SHEET NO.	TOTAL SHEETS
HAWAII	HAW.	98A-01-15	2017	17	40

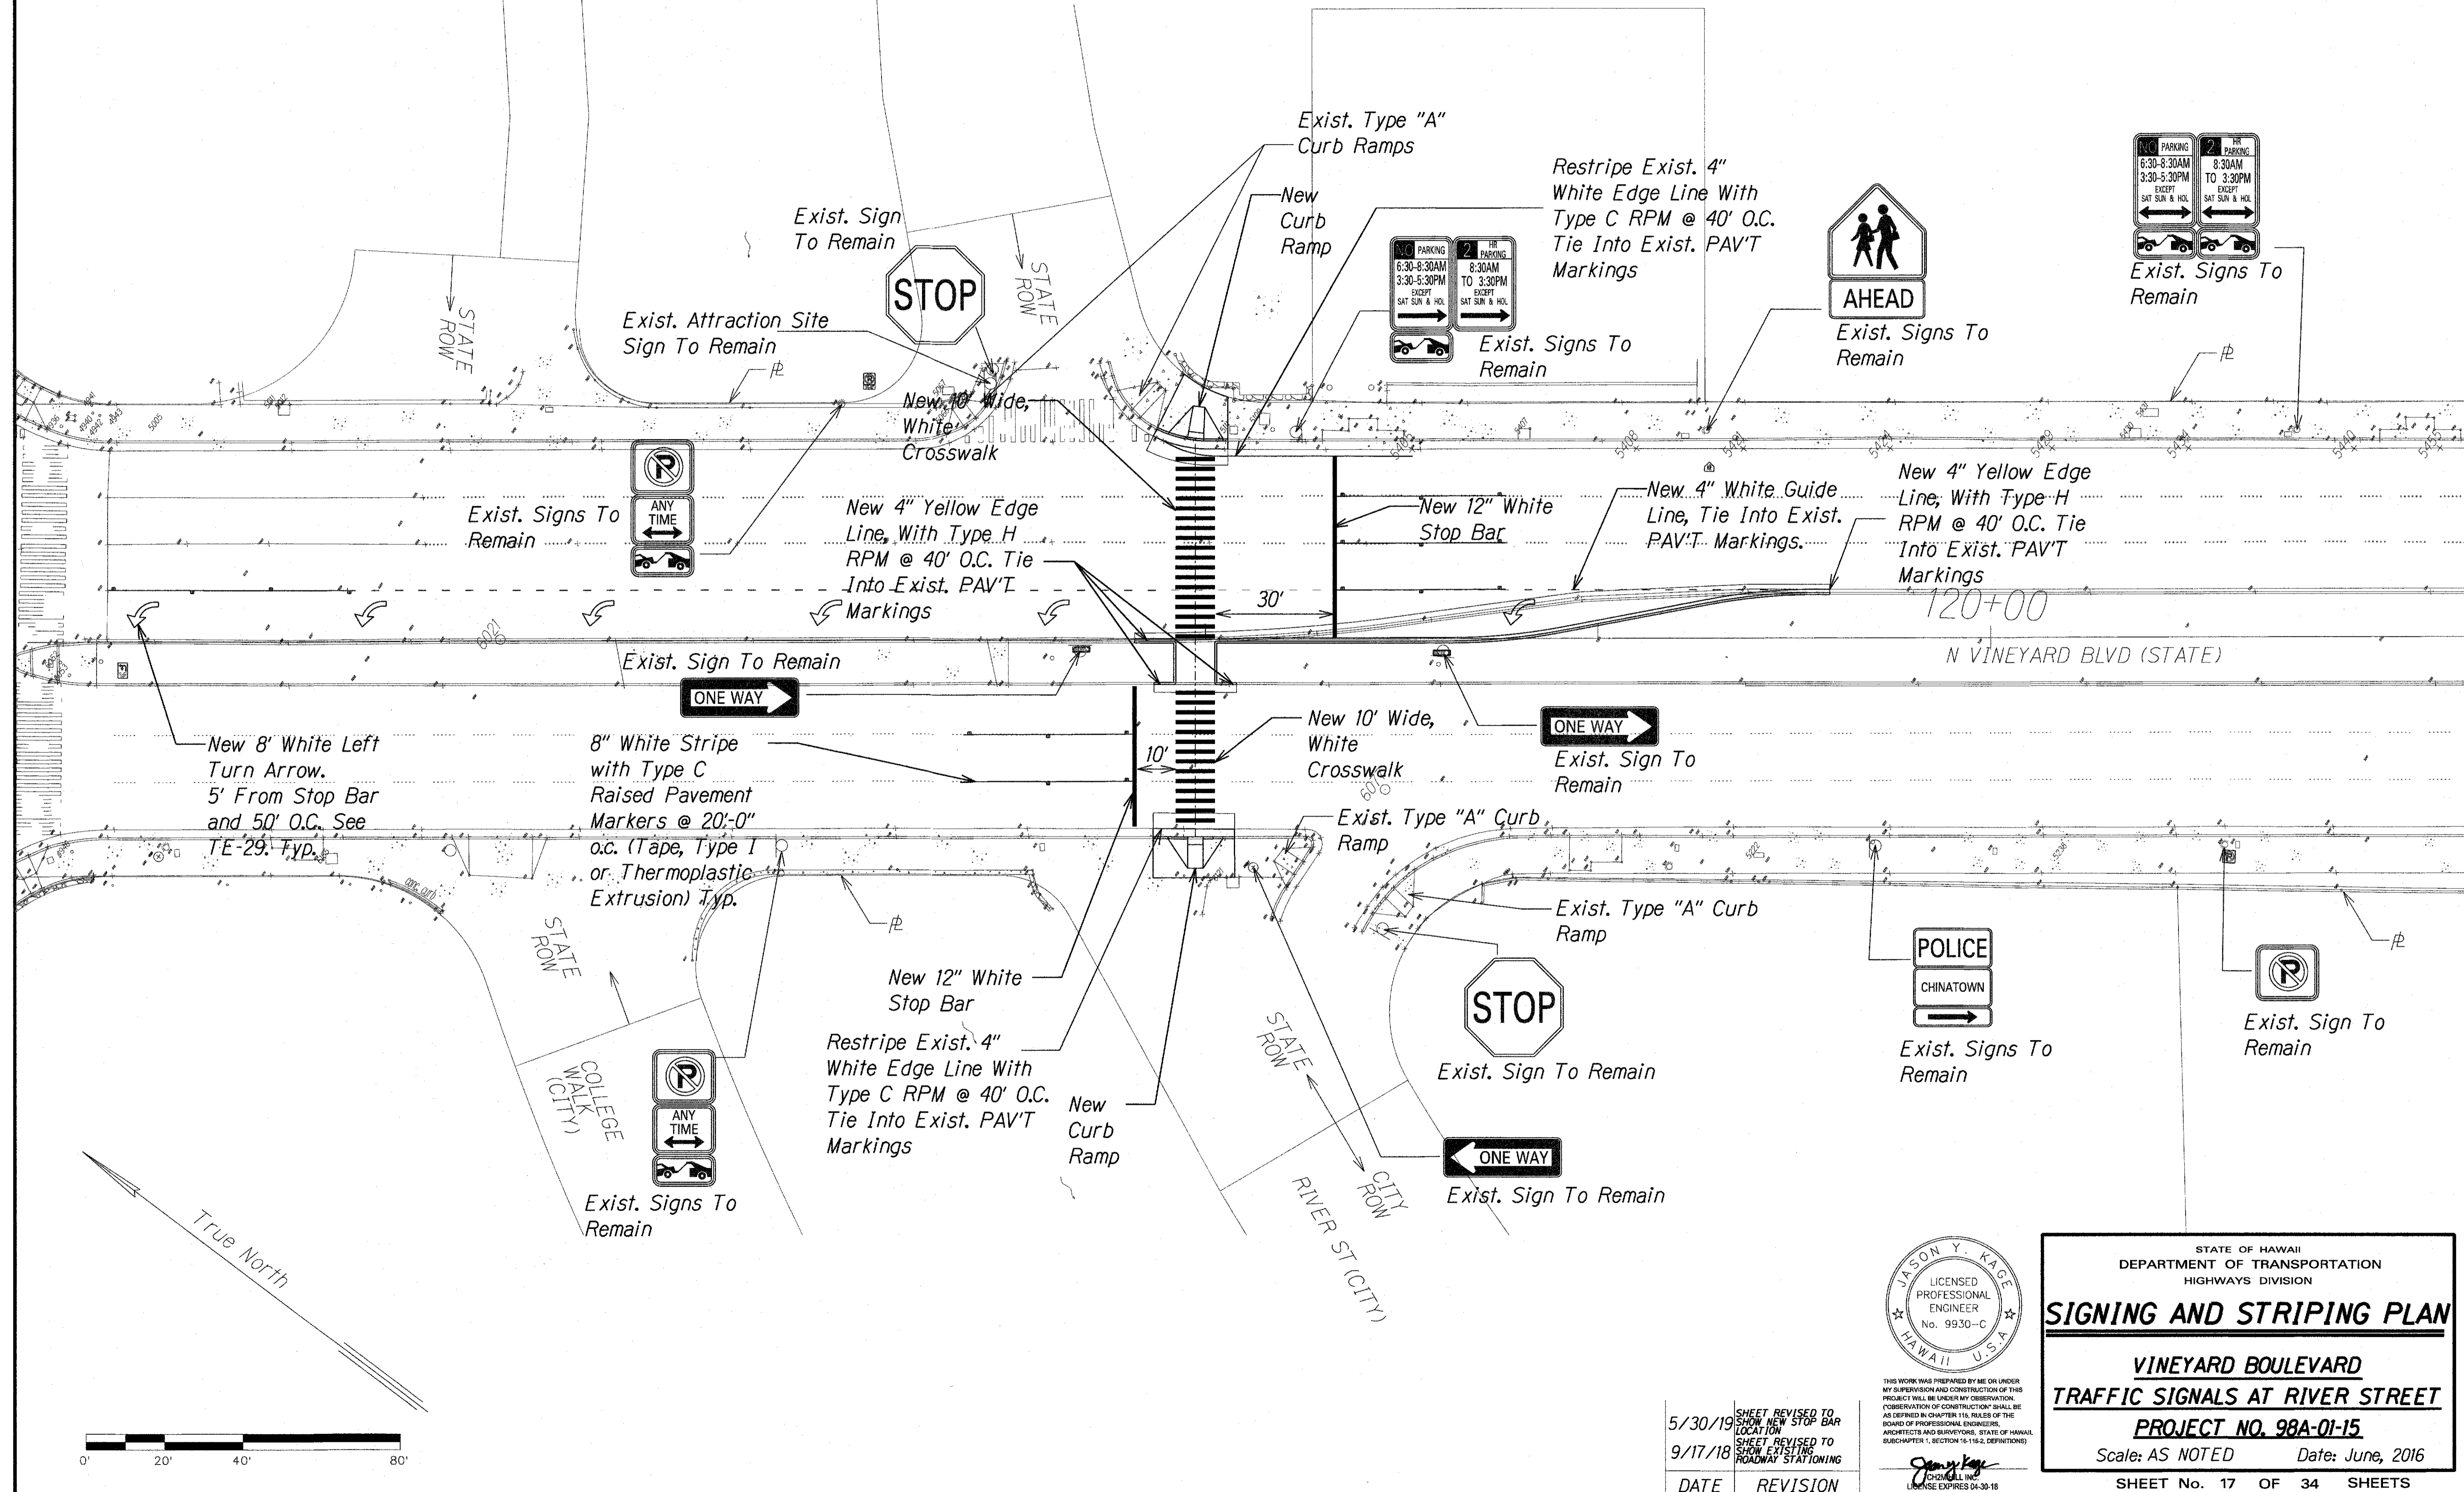

SURVEY PLOTTED BY	DATE
DRAWN BY	
TRACED BY	
NOTED BY	
CHECKED BY	

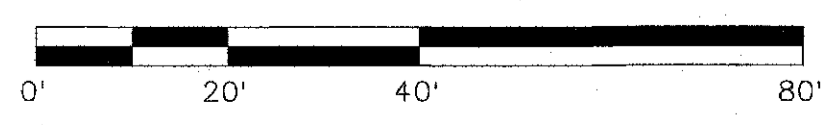

True North

JASON Y. KAGE
 LICENSED PROFESSIONAL ENGINEER
 No. 9930-C
 HAWAII U.S.A.

DATE	REVISION
5/30/19	SHEET REVISED TO SHOW NEW STOP BAR LOCATION
9/17/18	SHEET REVISED TO SHOW EXISTING ROADWAY STATIONING

STATE OF HAWAII
 DEPARTMENT OF TRANSPORTATION
 HIGHWAYS DIVISION
SIGNING AND STRIPING PLAN
VINEYARD BOULEVARD
TRAFFIC SIGNALS AT RIVER STREET
PROJECT NO. 98A-01-15
 Scale: AS NOTED Date: June, 2016
 SHEET No. 17 OF 34 SHEETS