




FED. ROAD DIST. NO.	STATE	PROJ. NO.	FISCAL YEAR	SHEET NO.	TOTAL SHEETS
HAWAII	HAW.	98A-01-15	2017	26	40

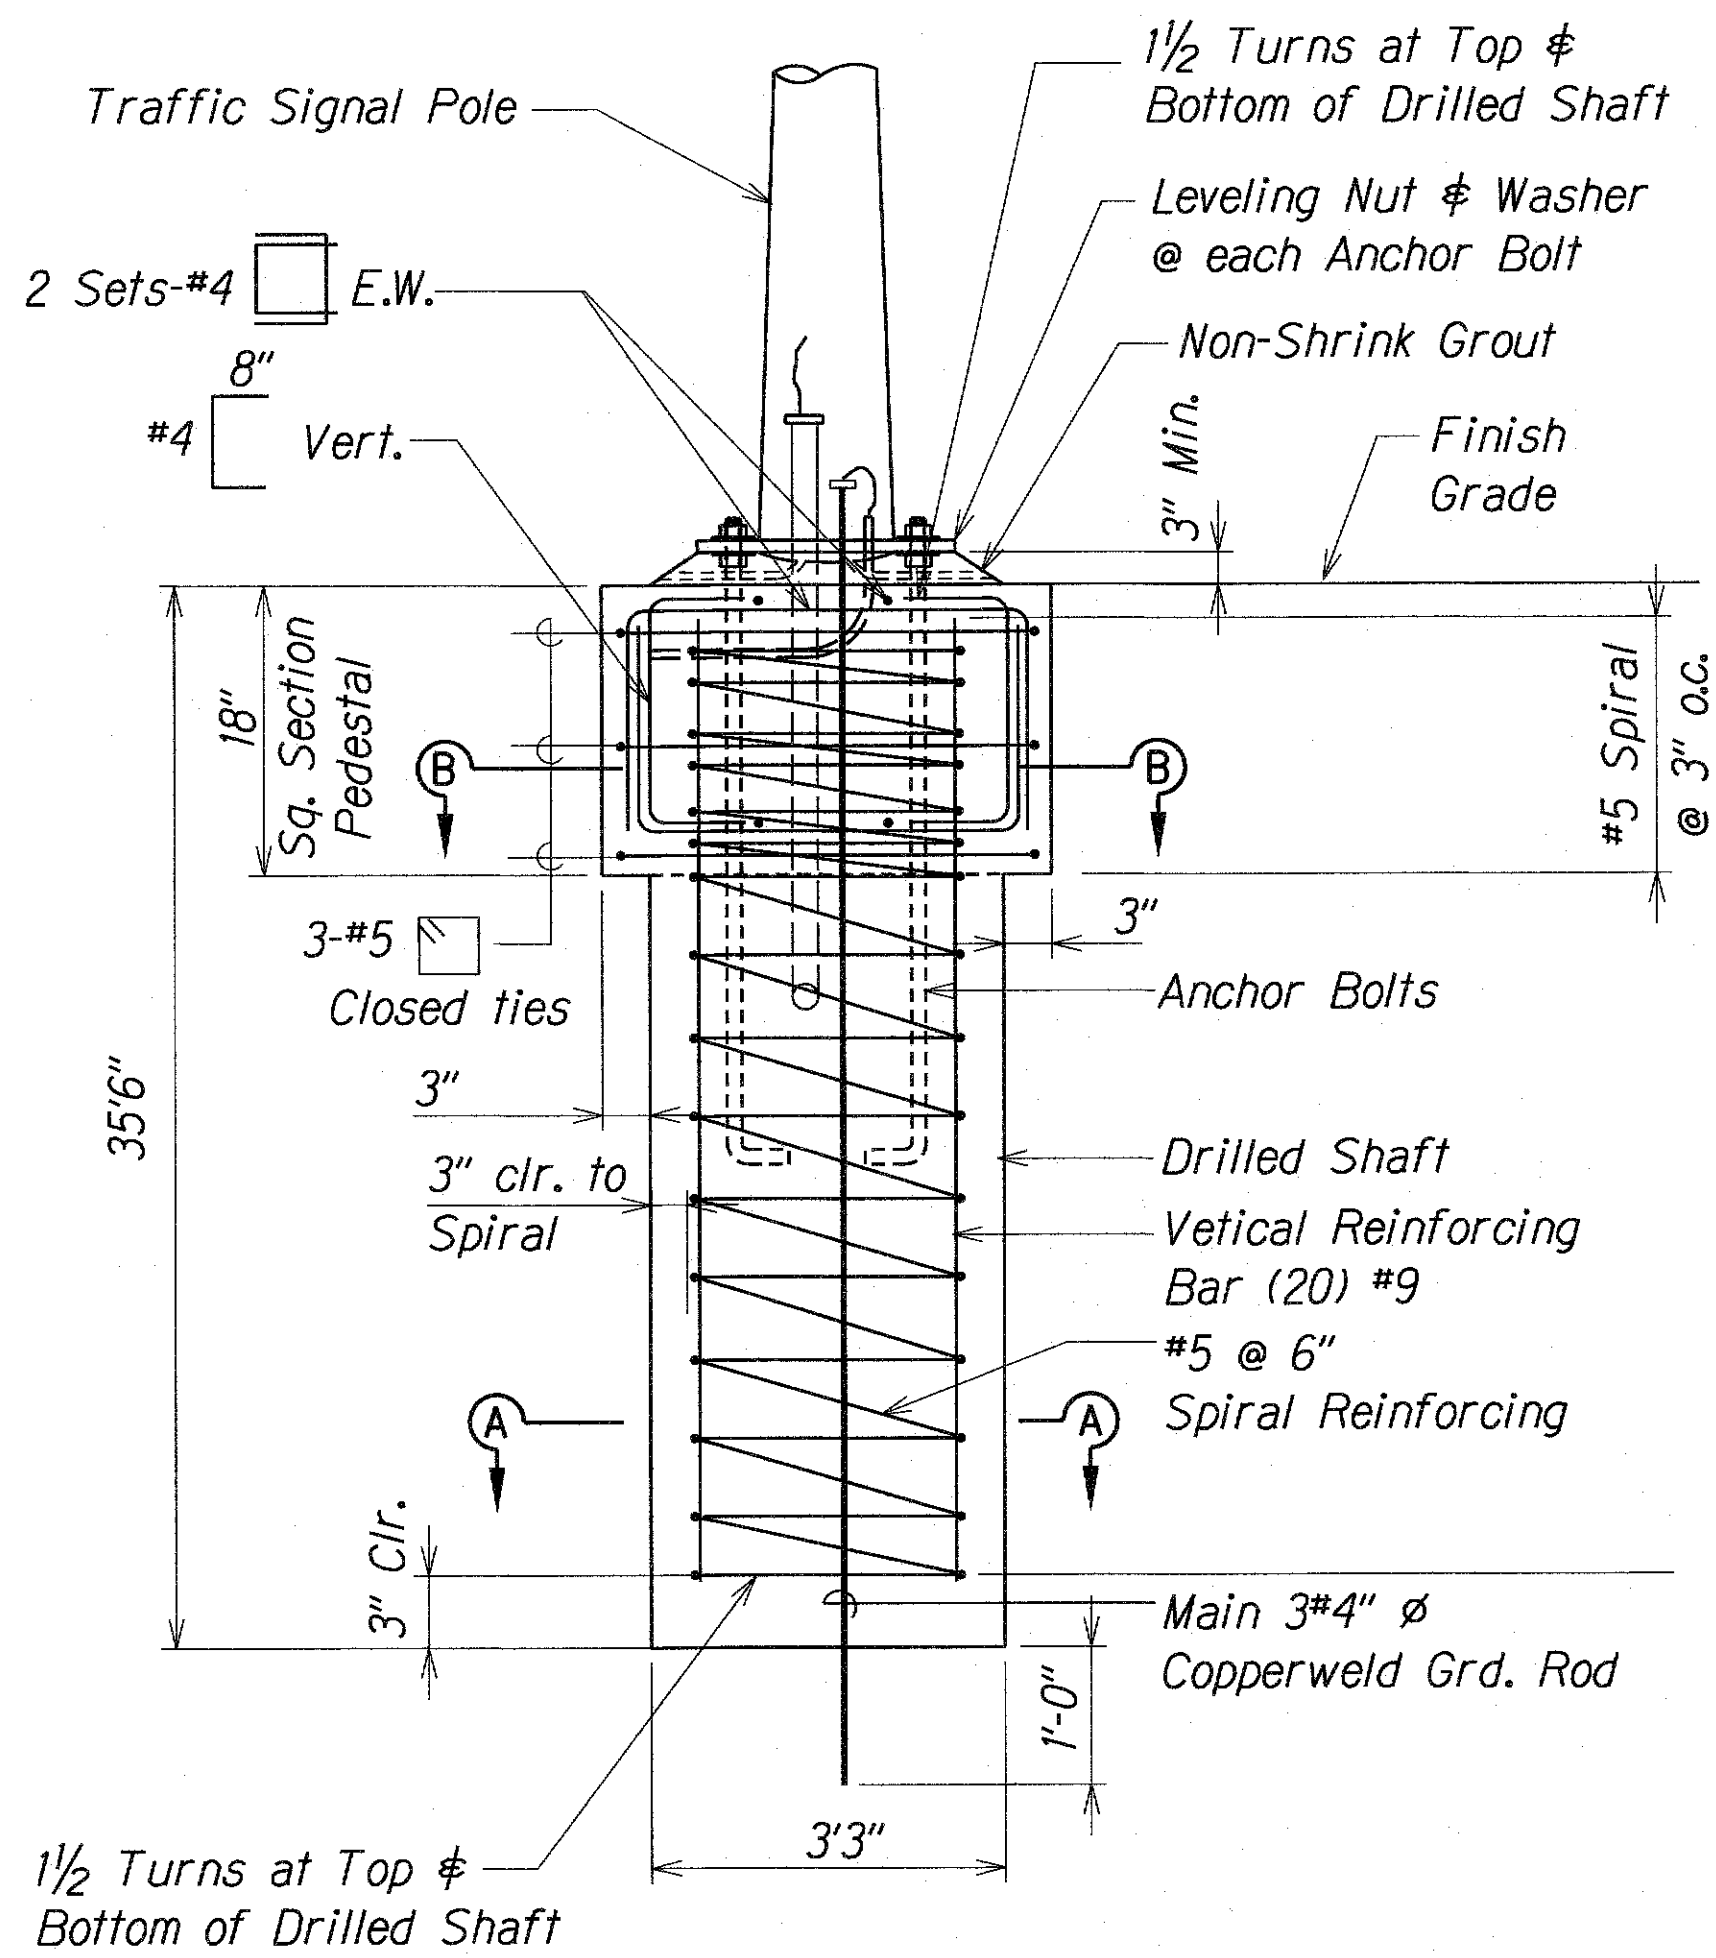

Note:
1. Traffic signal poles manufacturer's recommendations shall be followed.

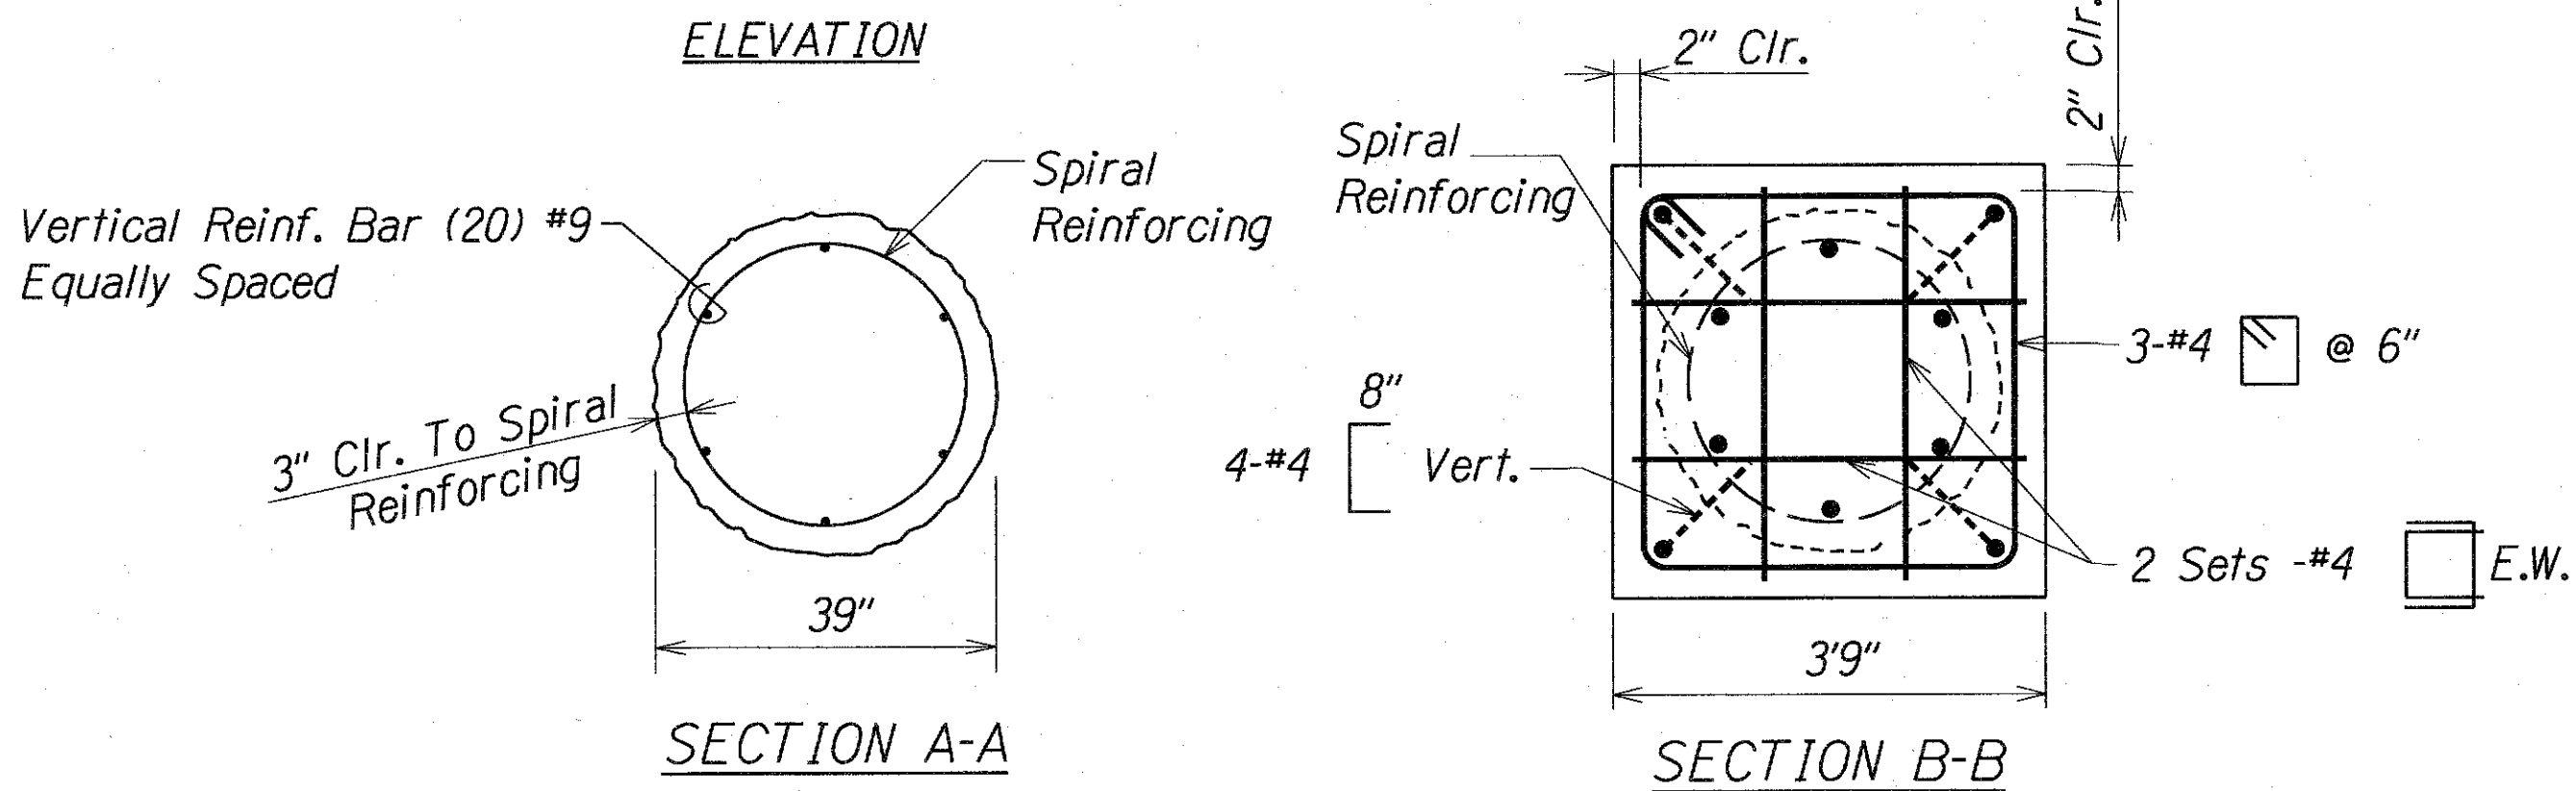


DRILLED SHAFT FOUNDATION FOR TYPE II MAST ARM
Not to Scale

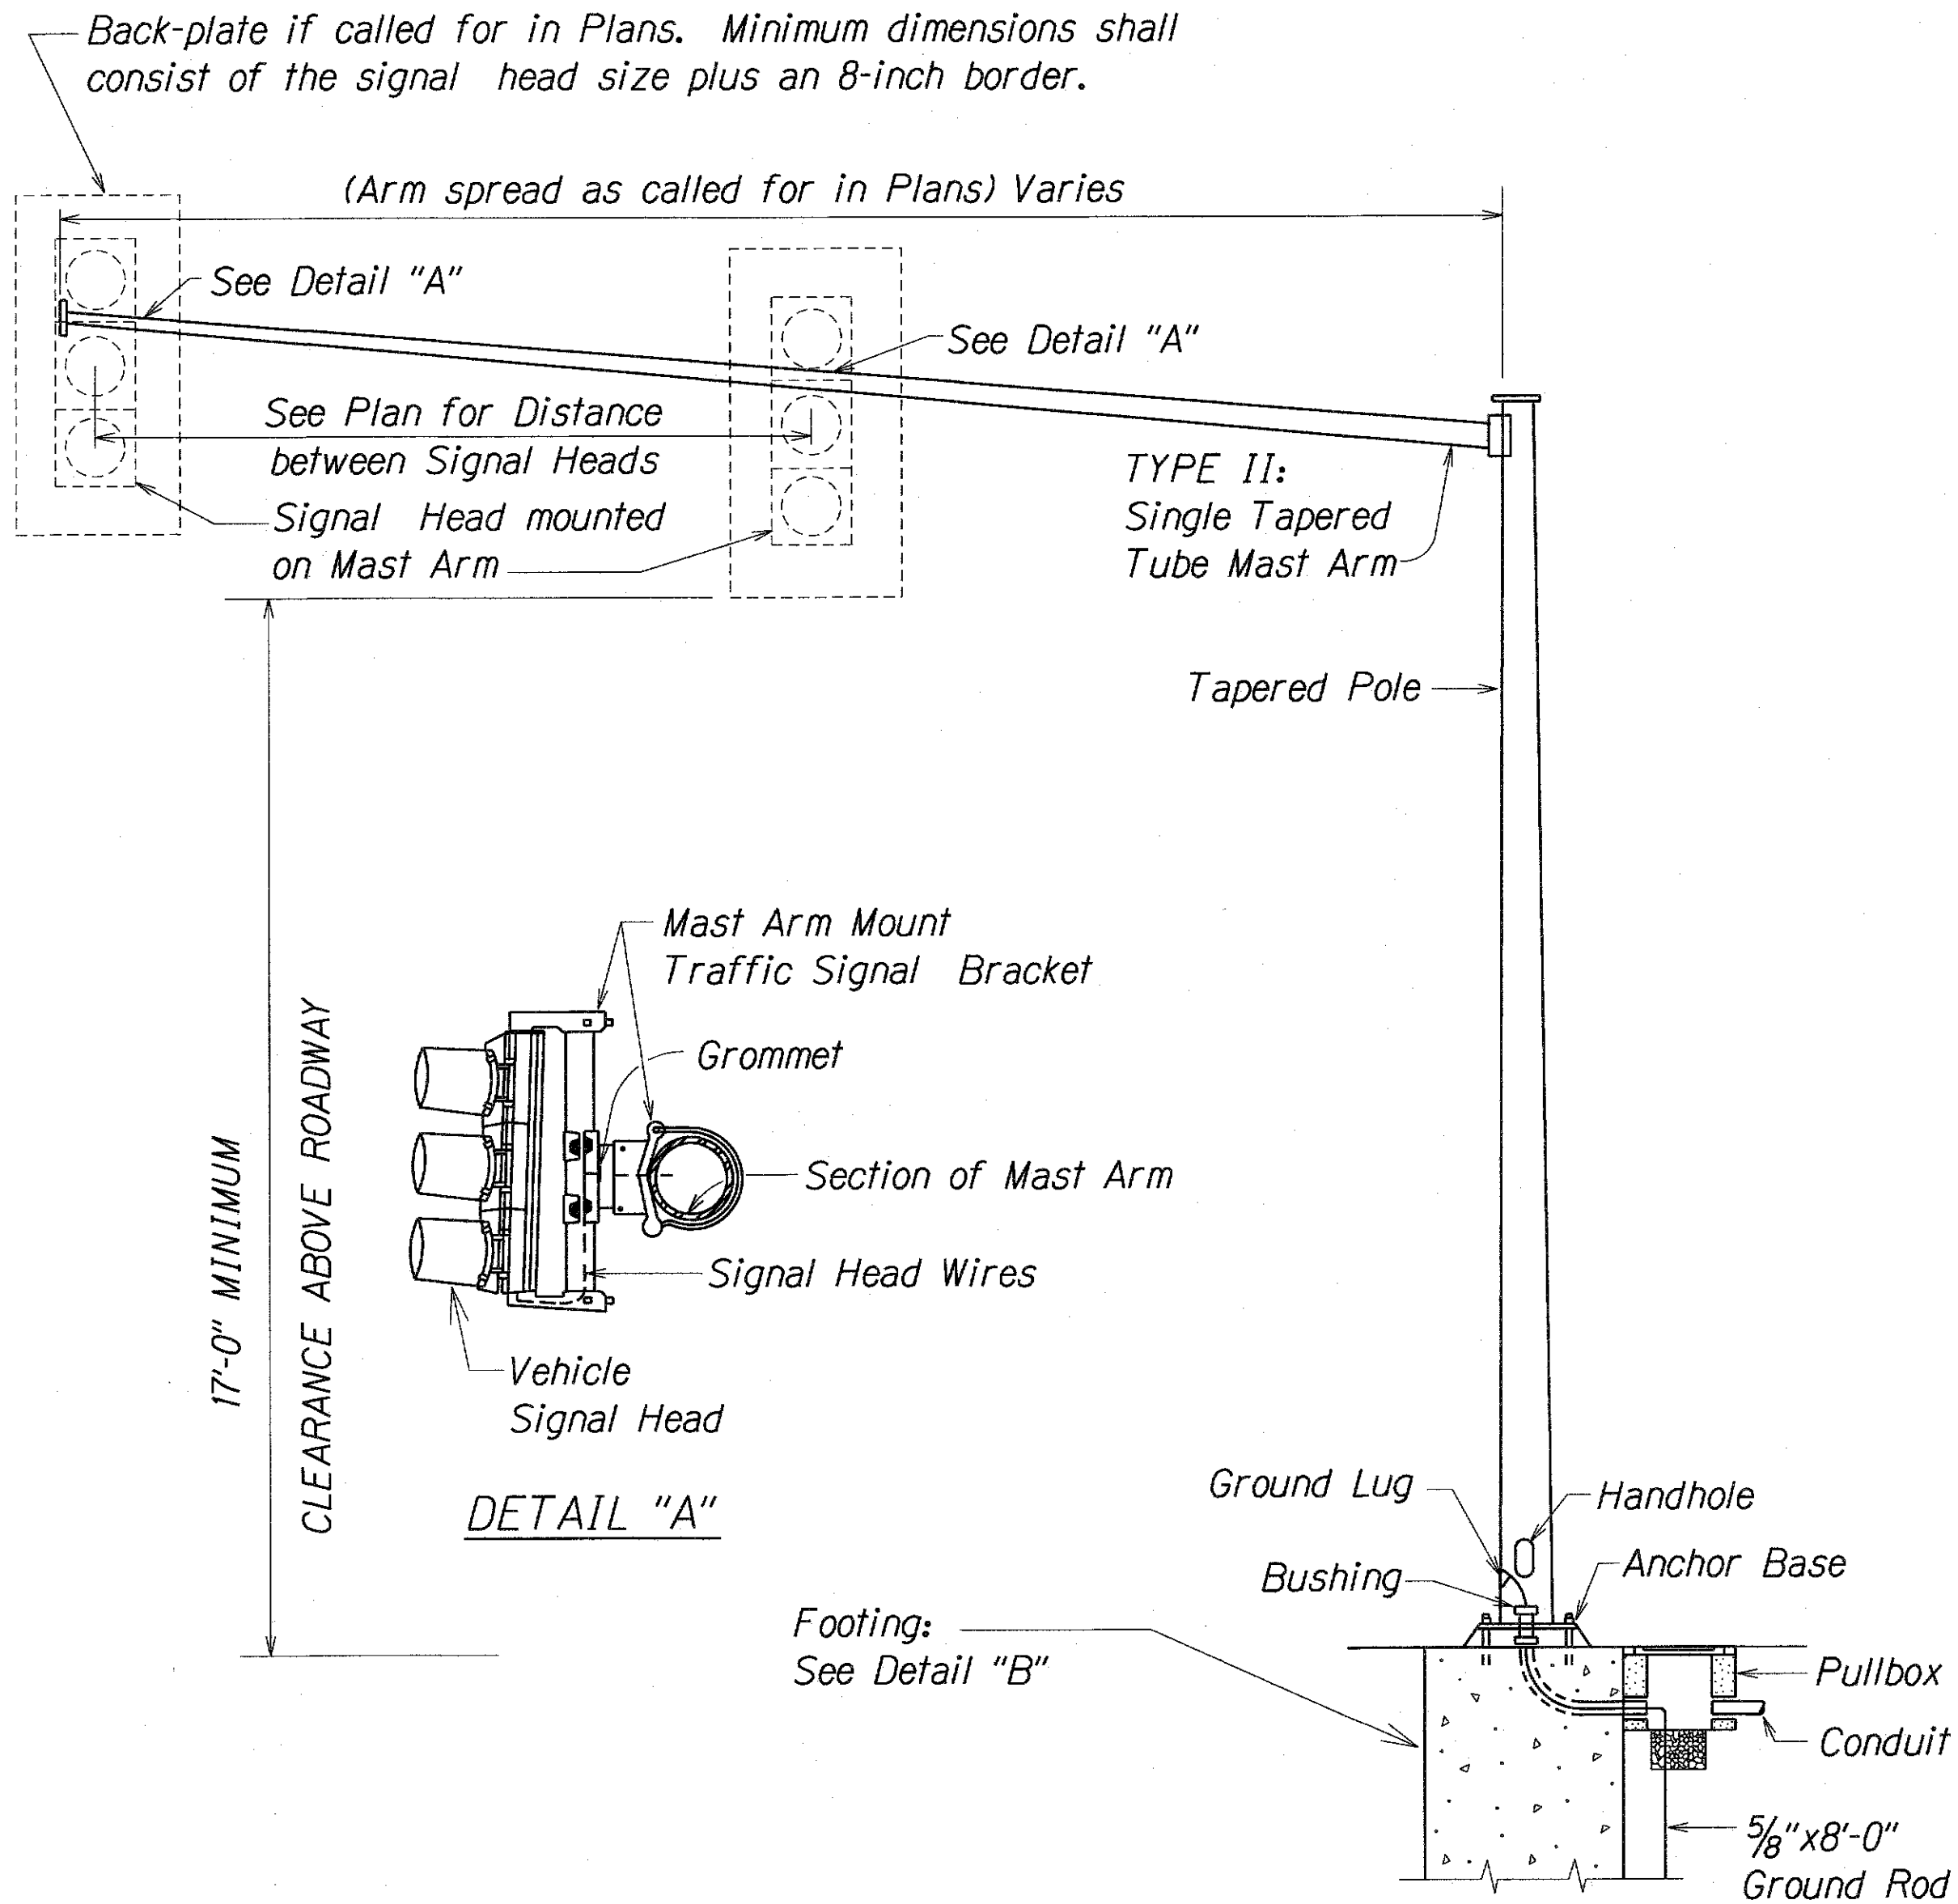

TYPE II MAST ARM ELEVATION
Not to Scale

SURVEY PLOTTED BY	DATE
DRAWN BY	
DESIGNED BY	
CHECKED BY	
IN CHARGE	
DATE	

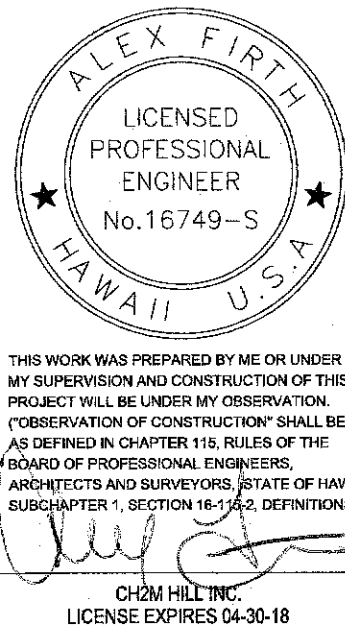

STATE OF HAWAII
DEPARTMENT OF TRANSPORTATION
HIGHWAYS DIVISION

TYPE II AND FOOTING DETAIL

VINEYARD BOULEVARD
TRAFFIC SIGNALS AT RIVER STREET
PROJECT NO. 98A-01-15
Scale: NTS Date: June, 2017
SHEET No. 26 OF 34 SHEETS

DATE	REVISION
1/11/19	SHEET REVISED TO SHOW NEW DRILLED SHAFT DIAMETER