
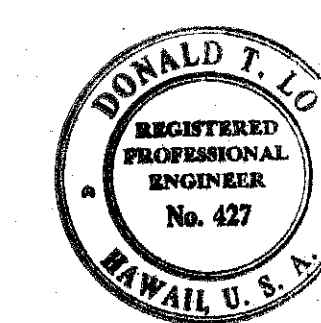
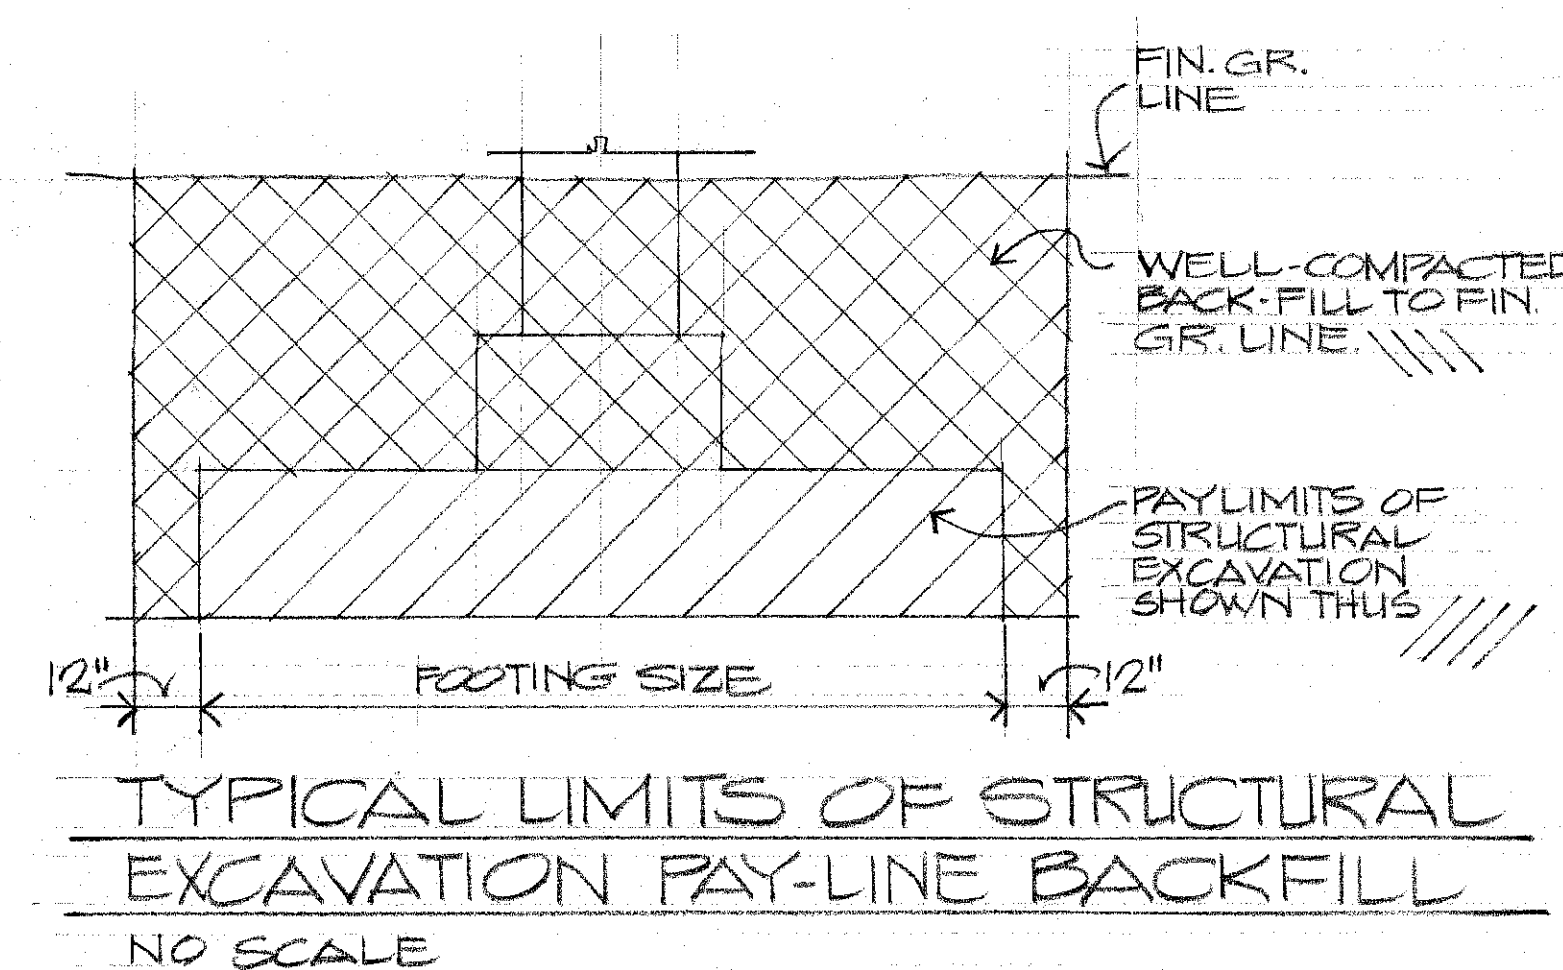


FED. ROAD DIST. NO.	STATE	PROJ. NO.	FISCAL YEAR	SHEET NO.	TOTAL SHEETS
HAWAII	HAW.	98A-01-70	1970	4	19

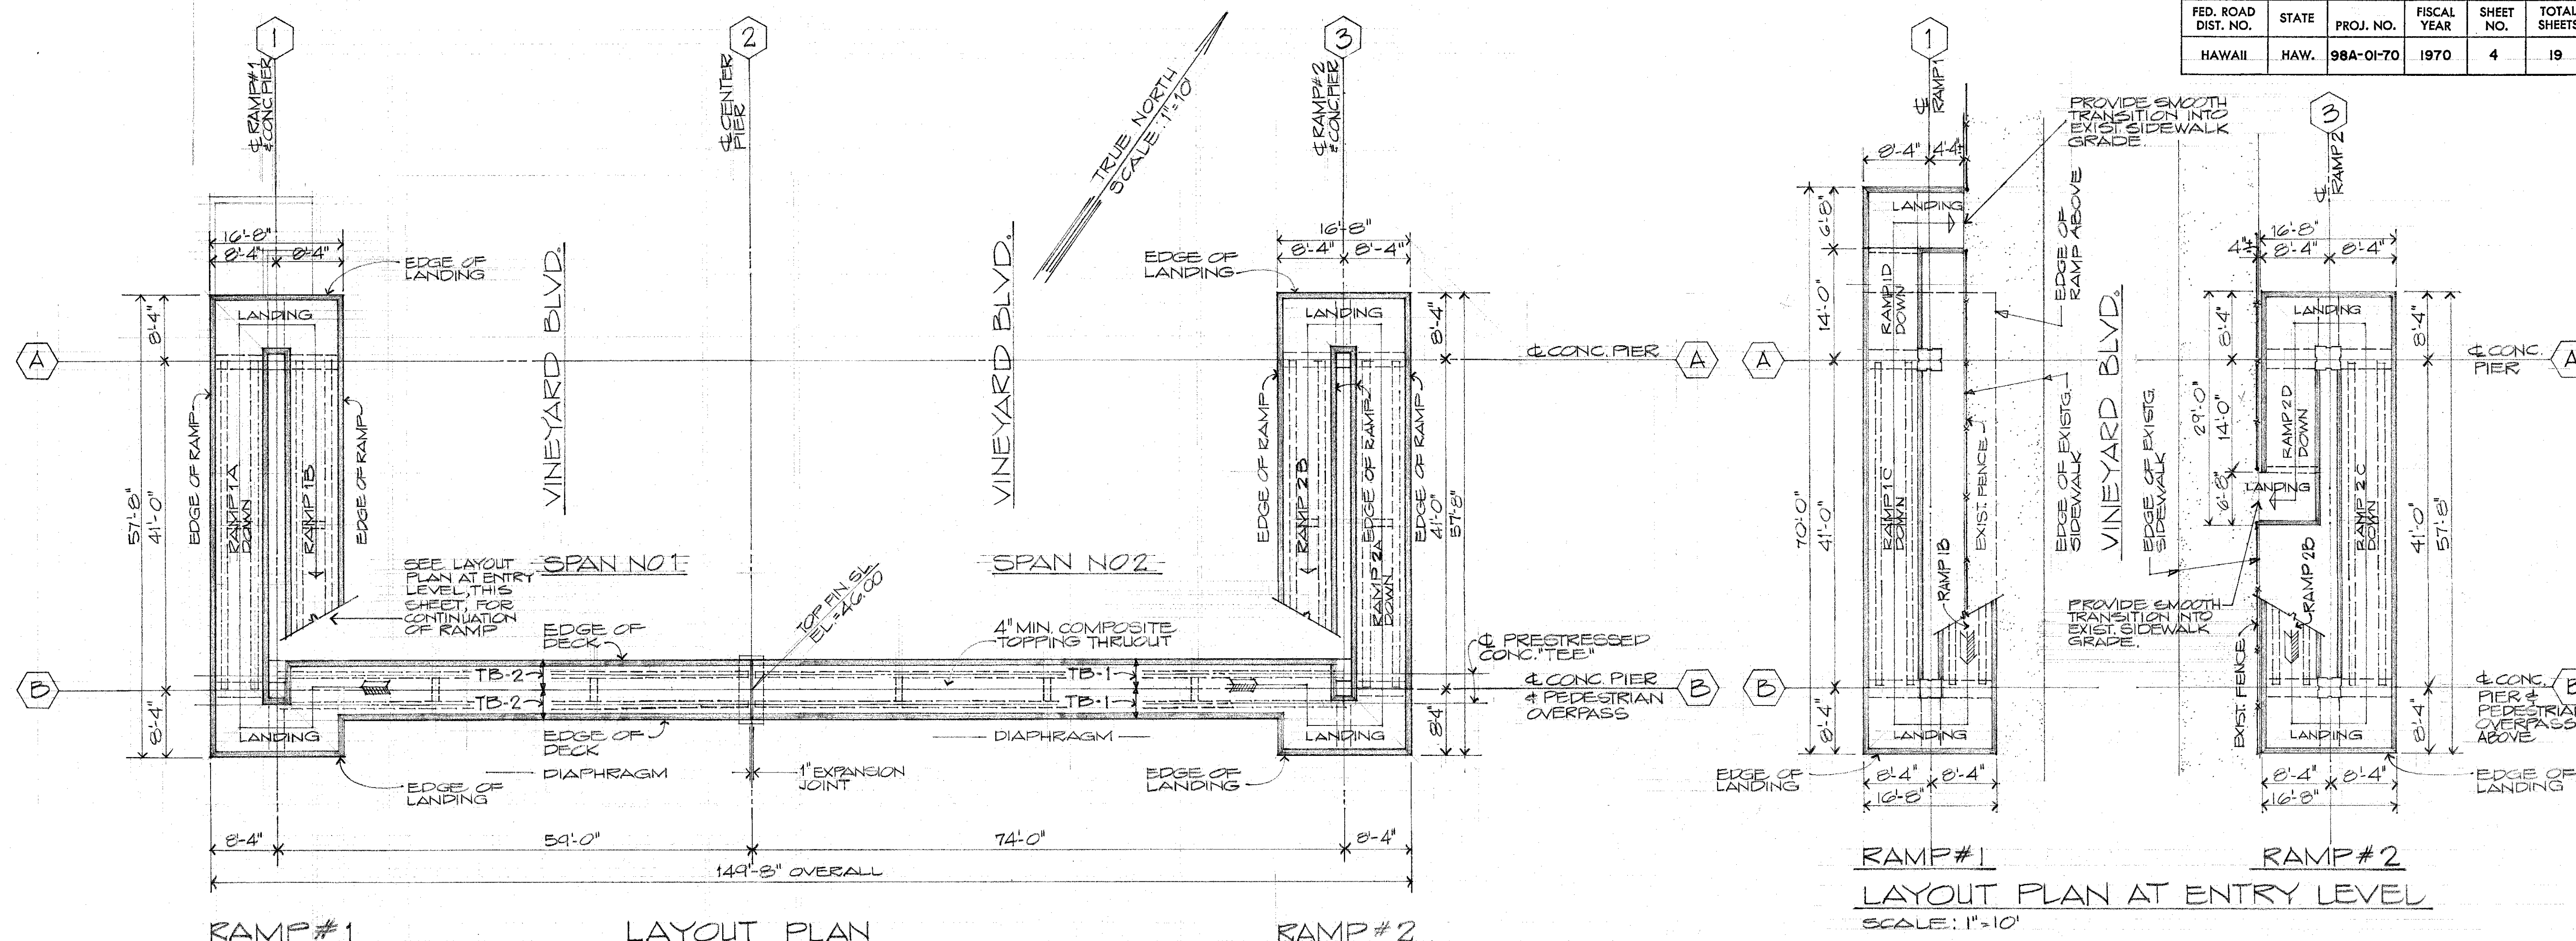

STATE OF HAWAII
DEPARTMENT OF TRANSPORTATION
HIGHWAYS DIVISION

LAYOUT PLAN
VINEYARD BOULEVARD
PEDESTRIAN OVERPASS
VICINITY OF PUA LANE, OAHU
PROJECT NO. 98A-01-70

THIS WORK WAS PREPARED
BY ME OR UNDER MY
SUPERVISION.

Signature: Donald T. Lo

SHEET No. 1 OF 4 SHEETS

DATE	
SURVEY PLOTTED BY	
ORIGINAL PLAN	
DRAWN BY	
TRACED BY	
NOTE BOOK	
QUANTITIES BY	
CHECKED BY	
No.	

