
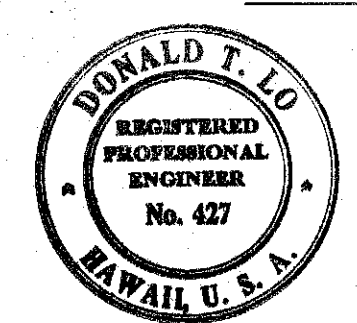
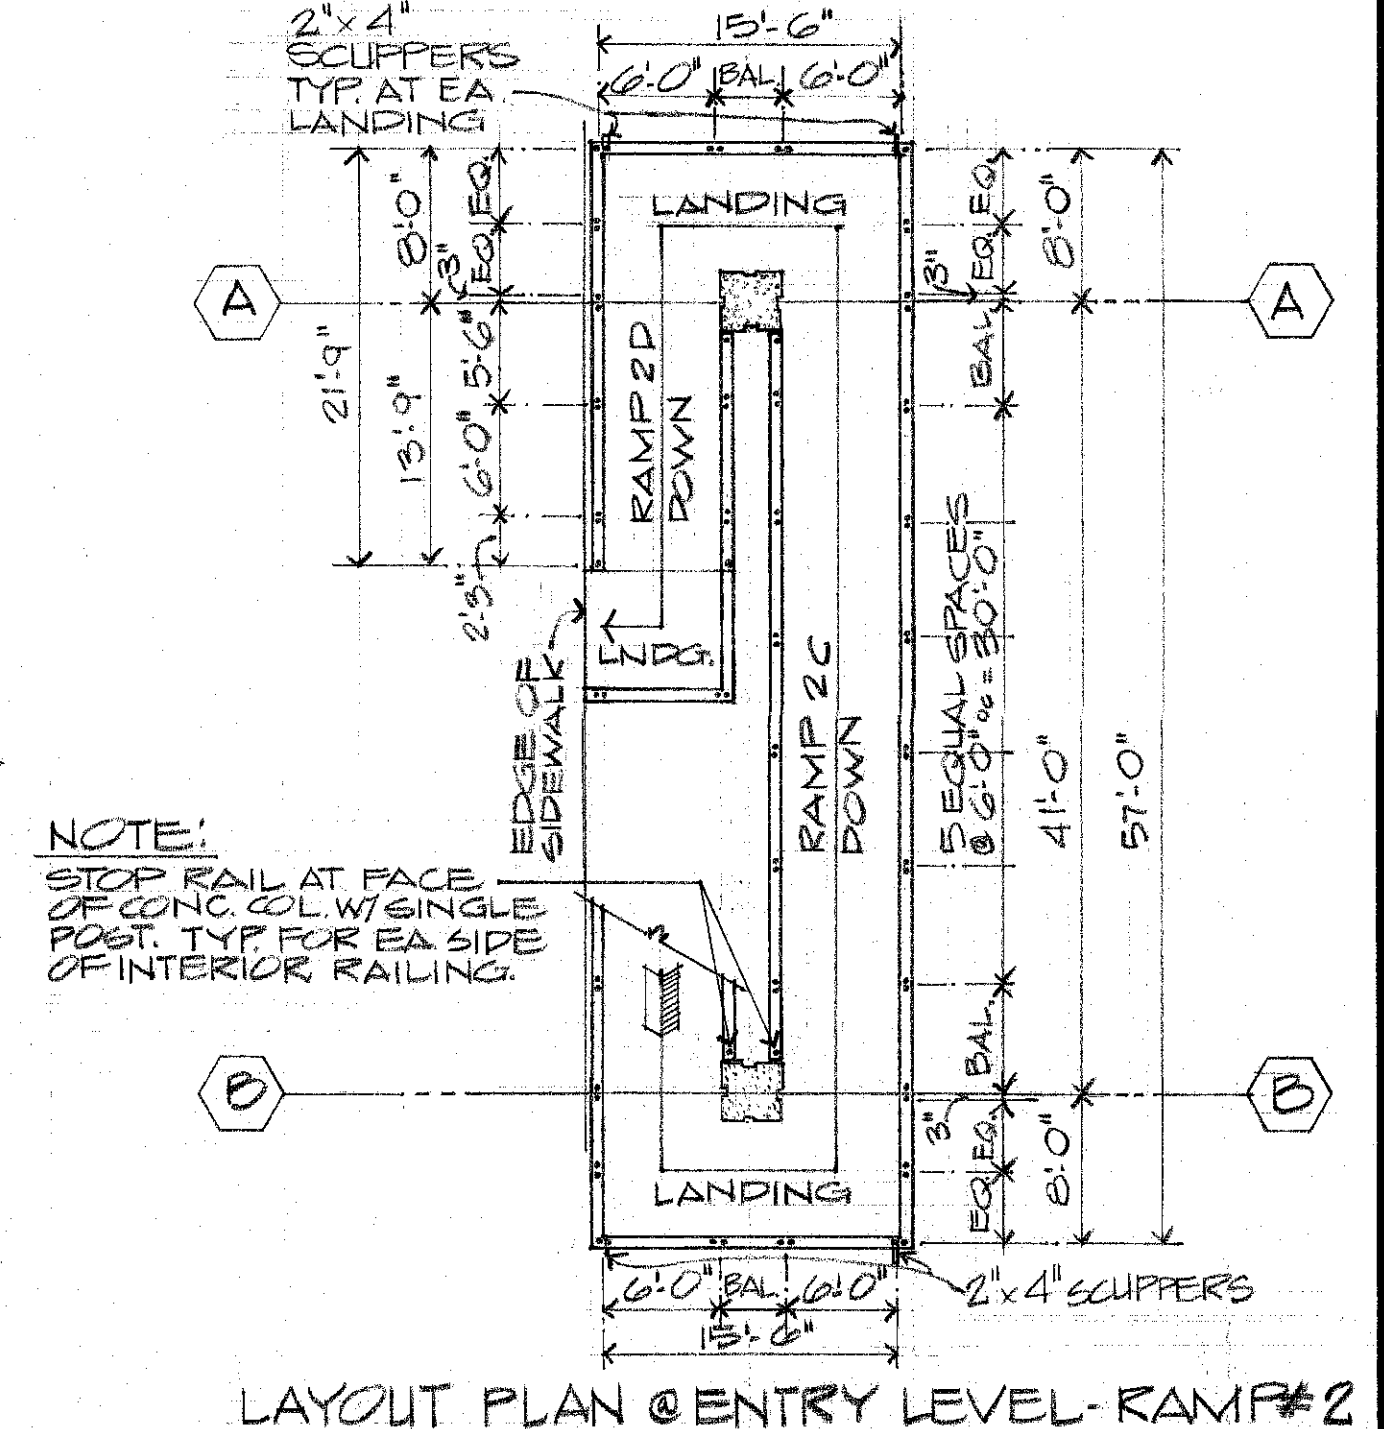
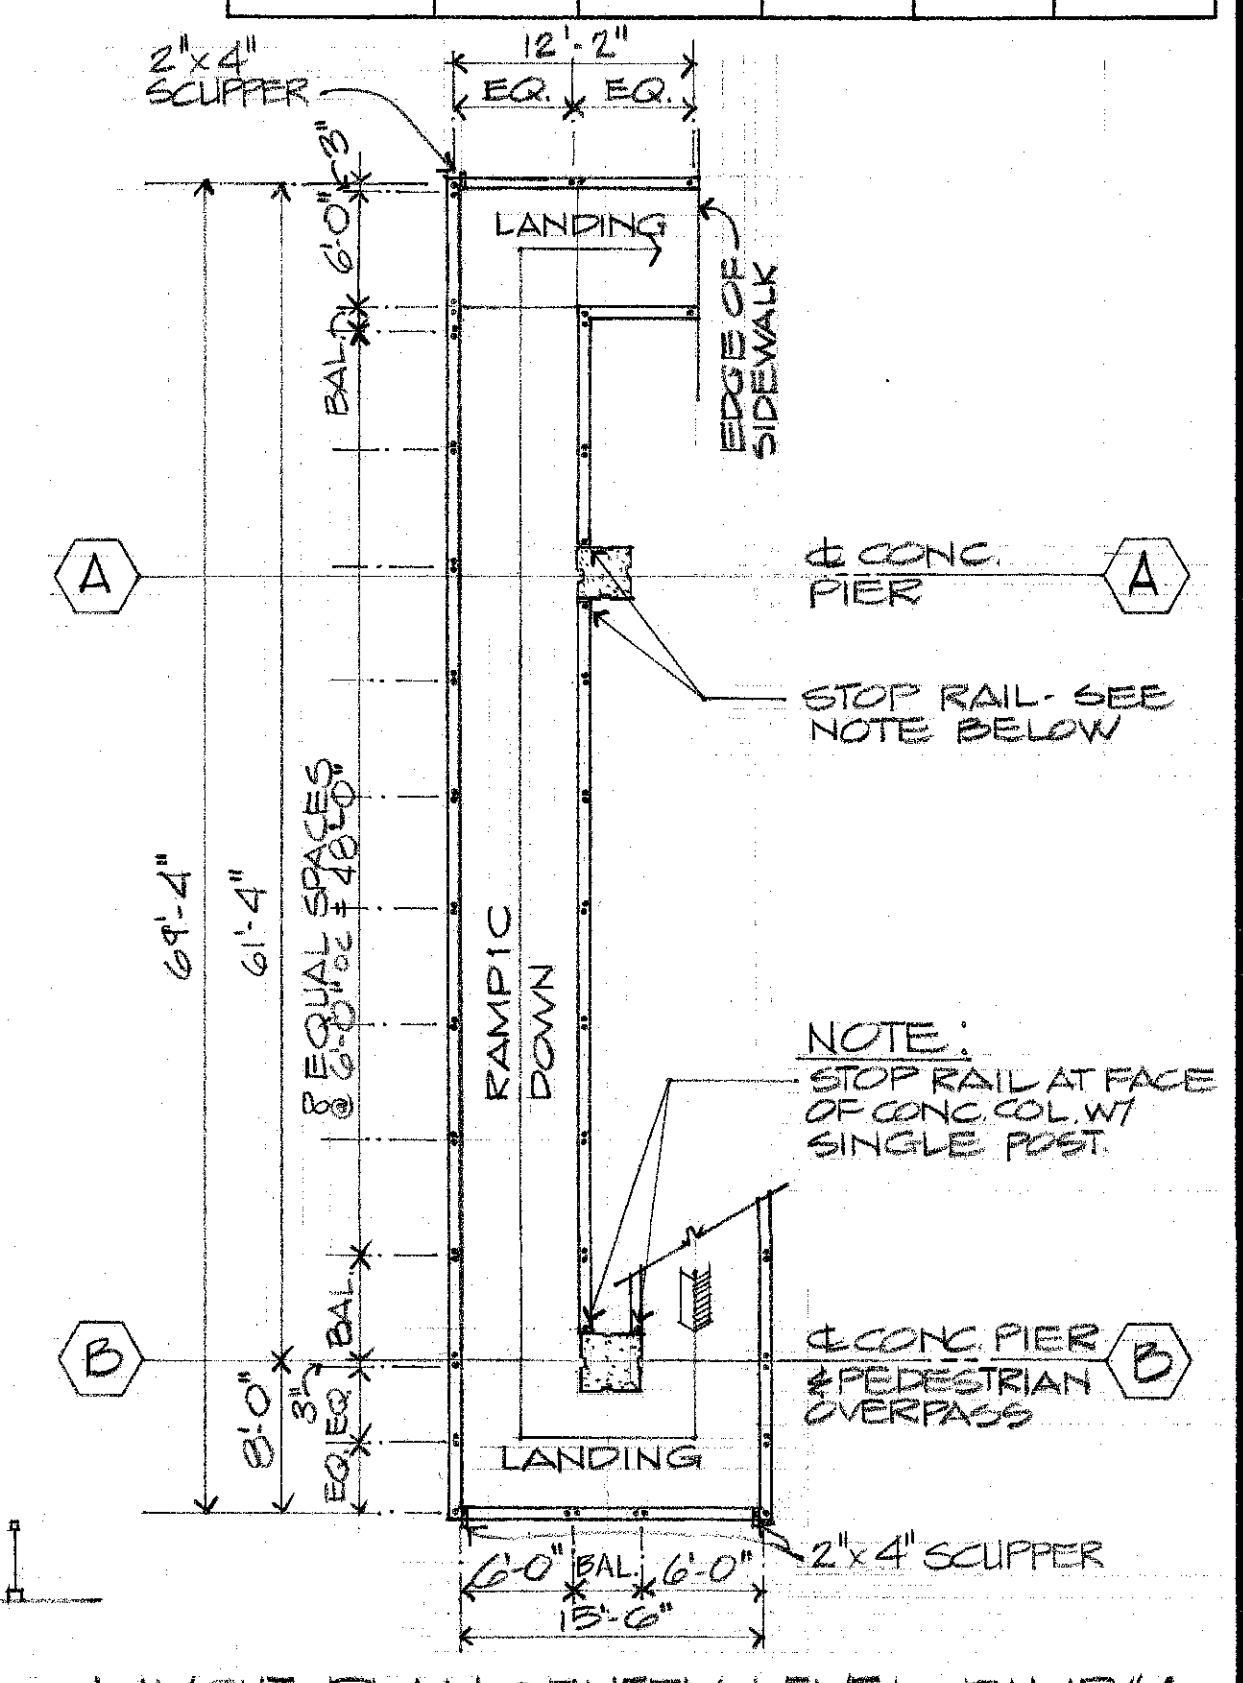
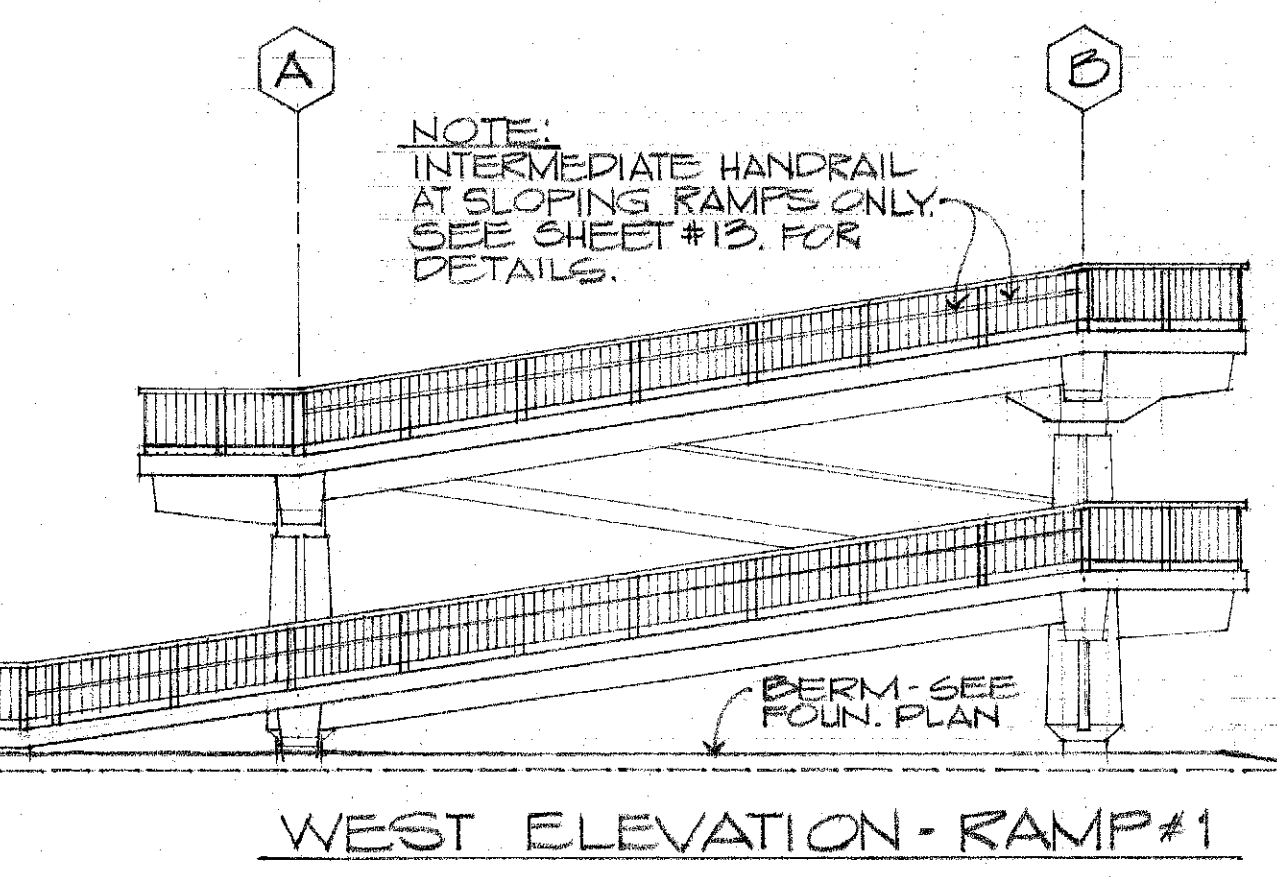
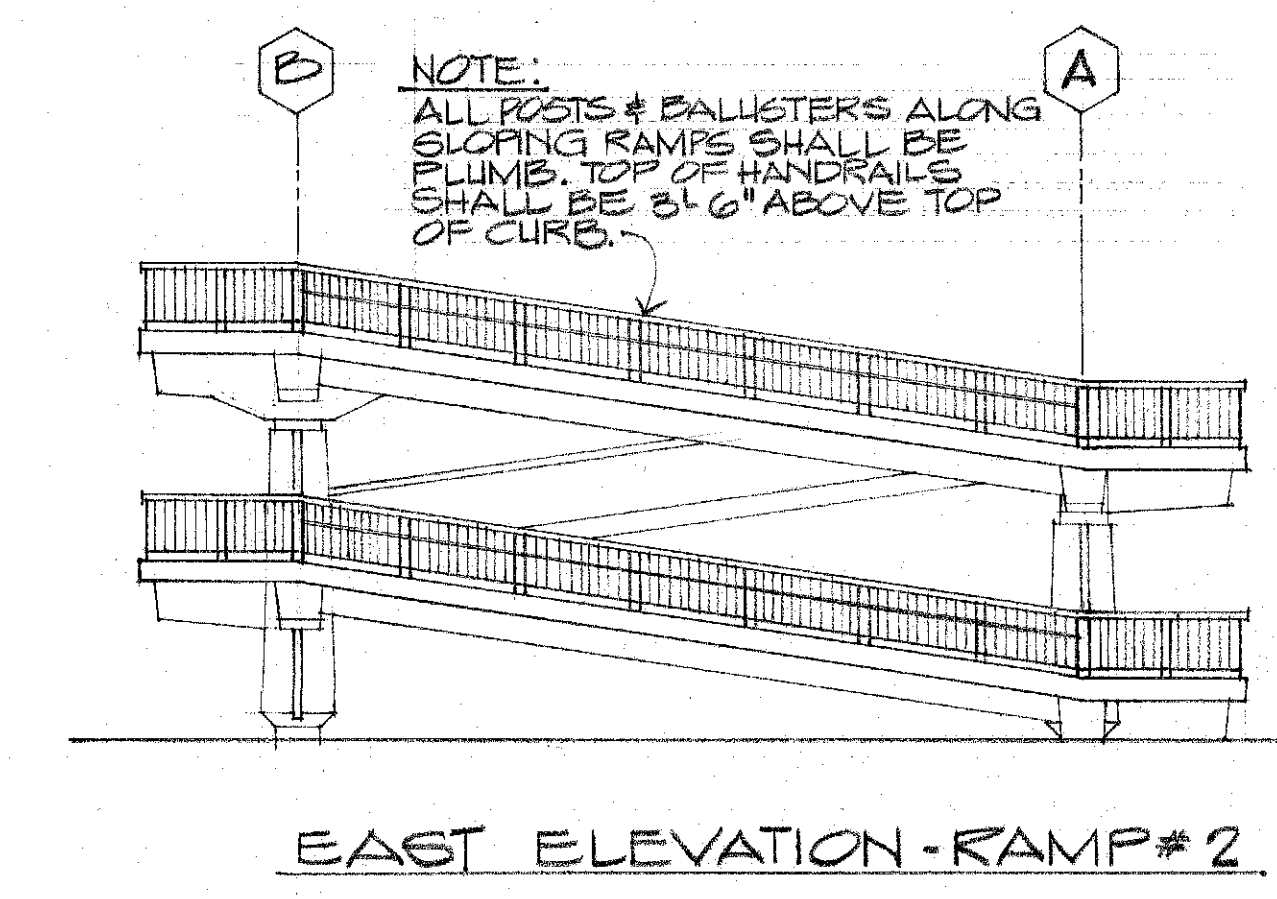
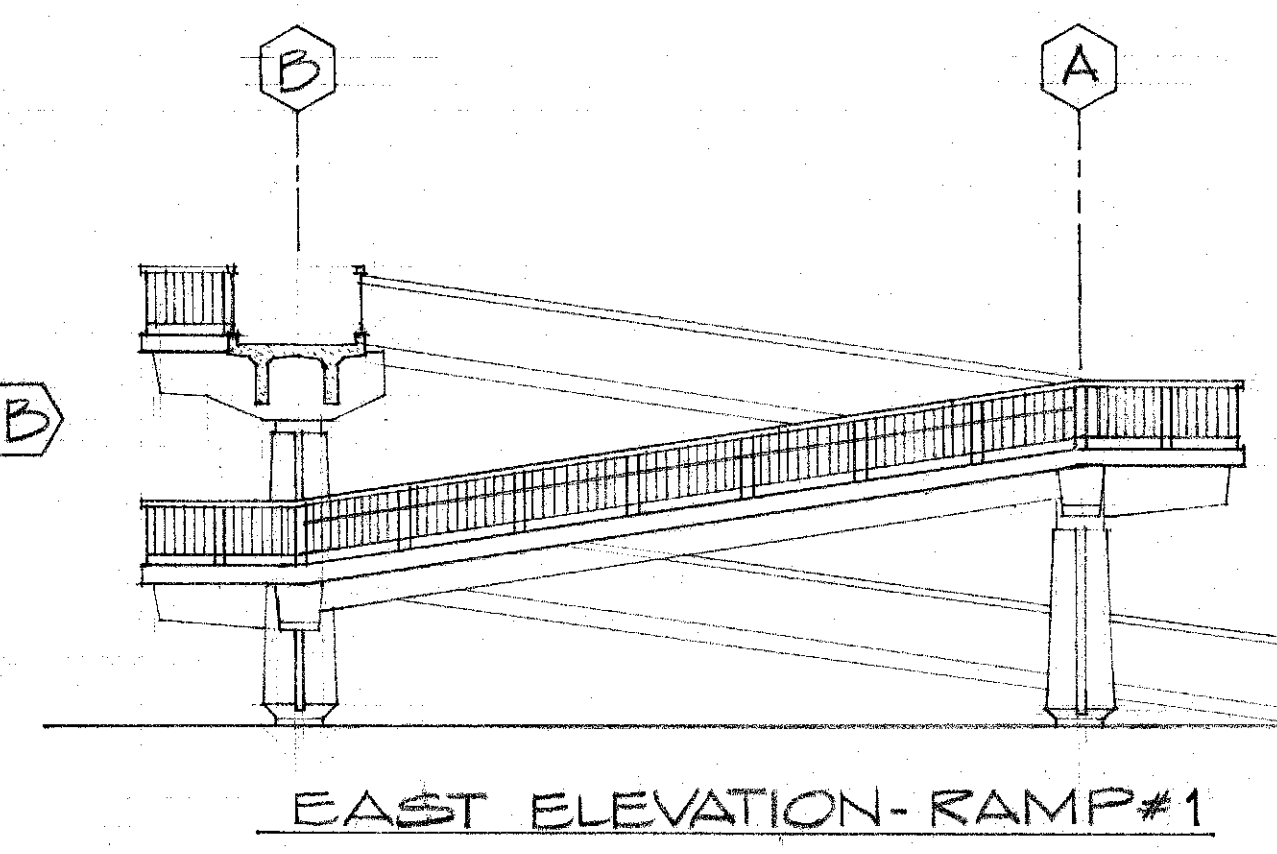
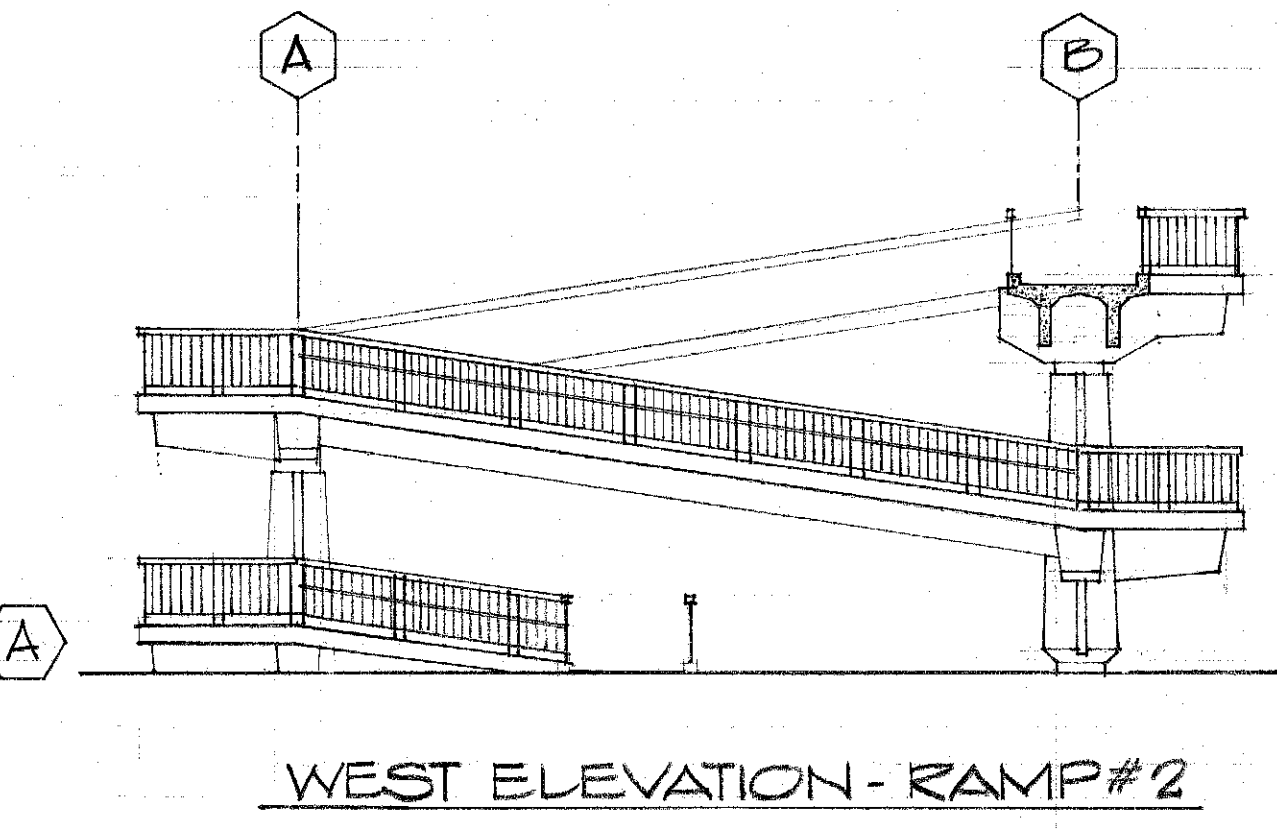
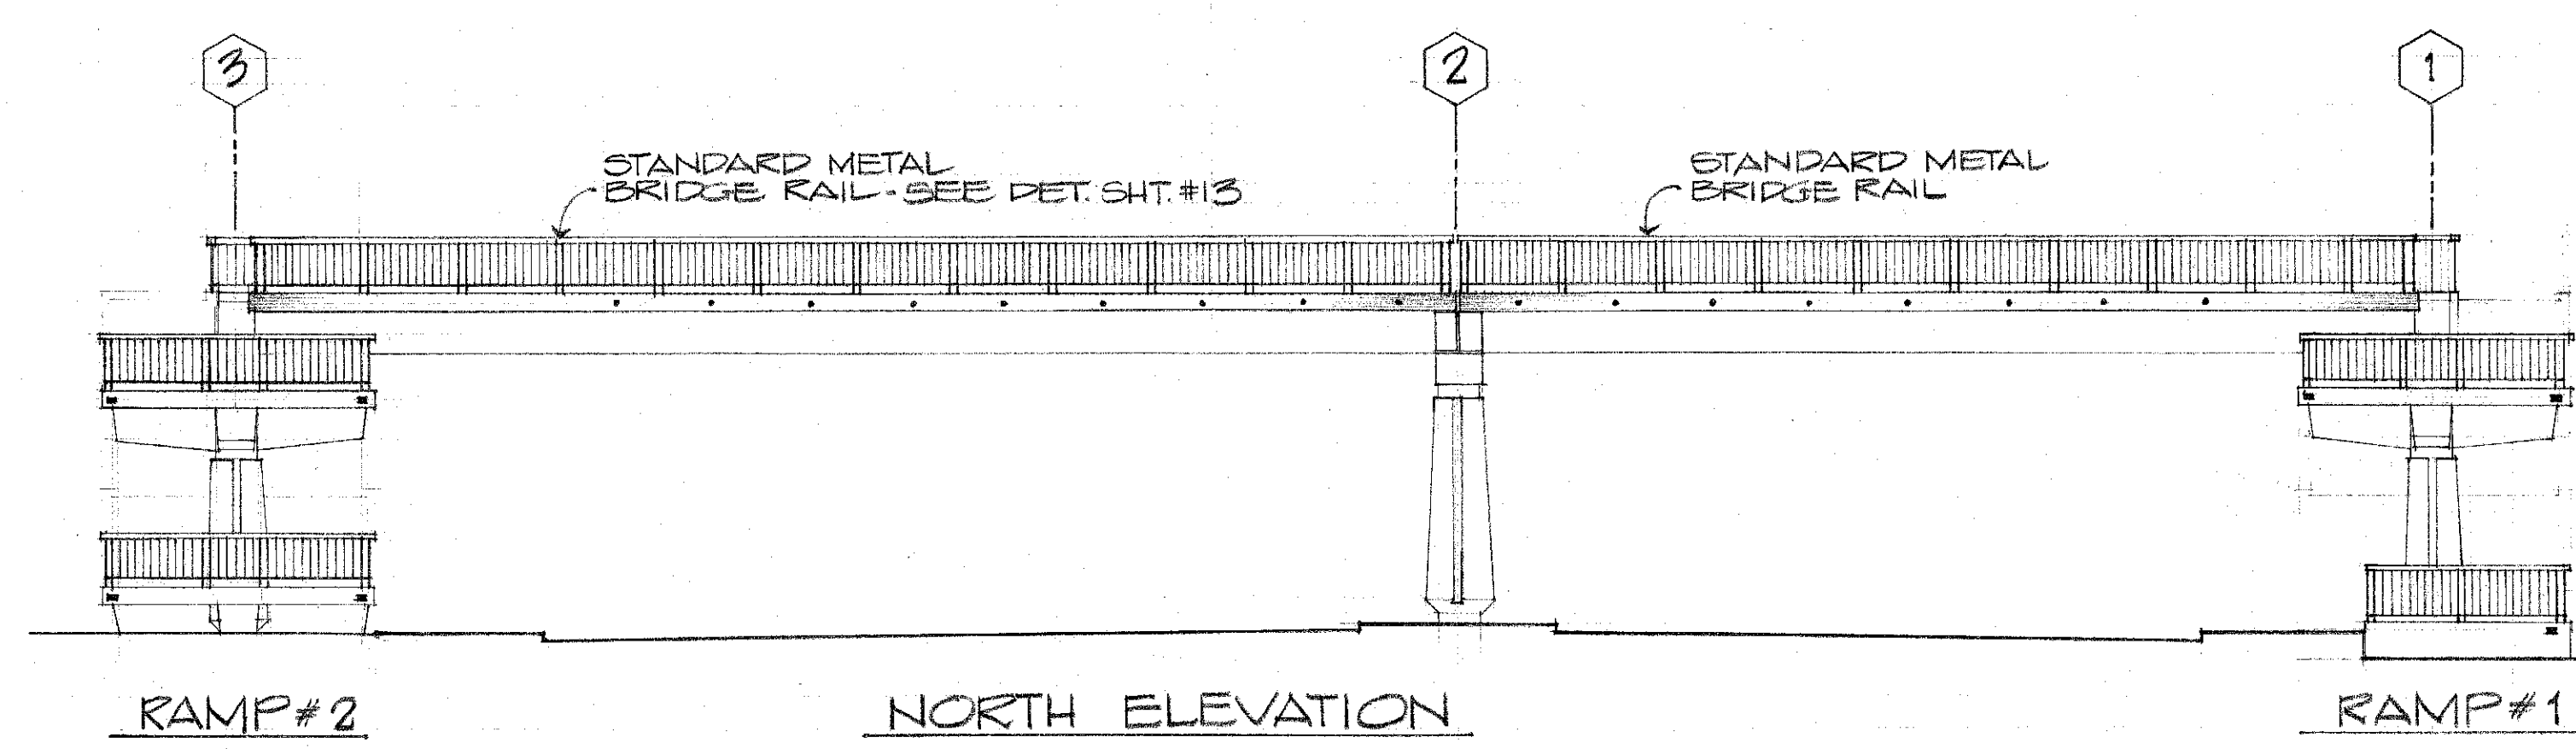
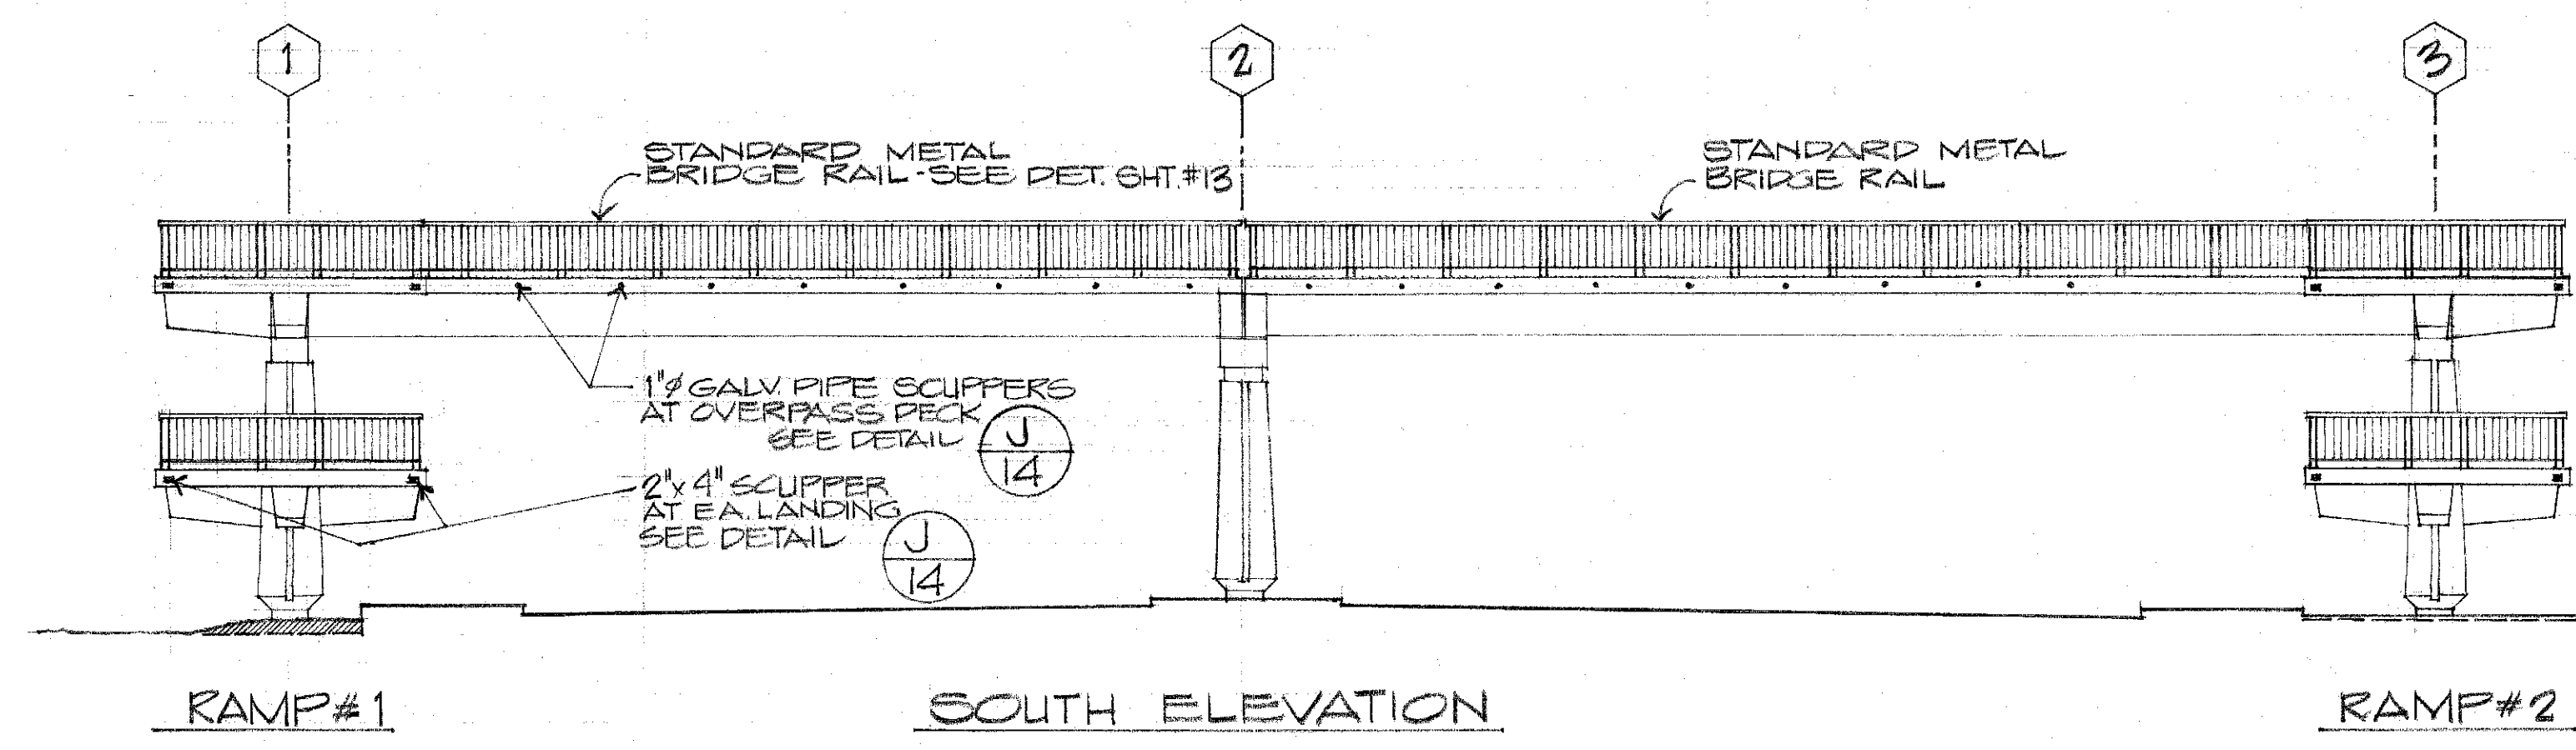


FED. ROAD DIST. NO.	STATE	PROJ. NO.	FISCAL YEAR	SHEET NO.	TOTAL SHEETS
HAWAII	HAW.	98A-01-70	1970	5	19

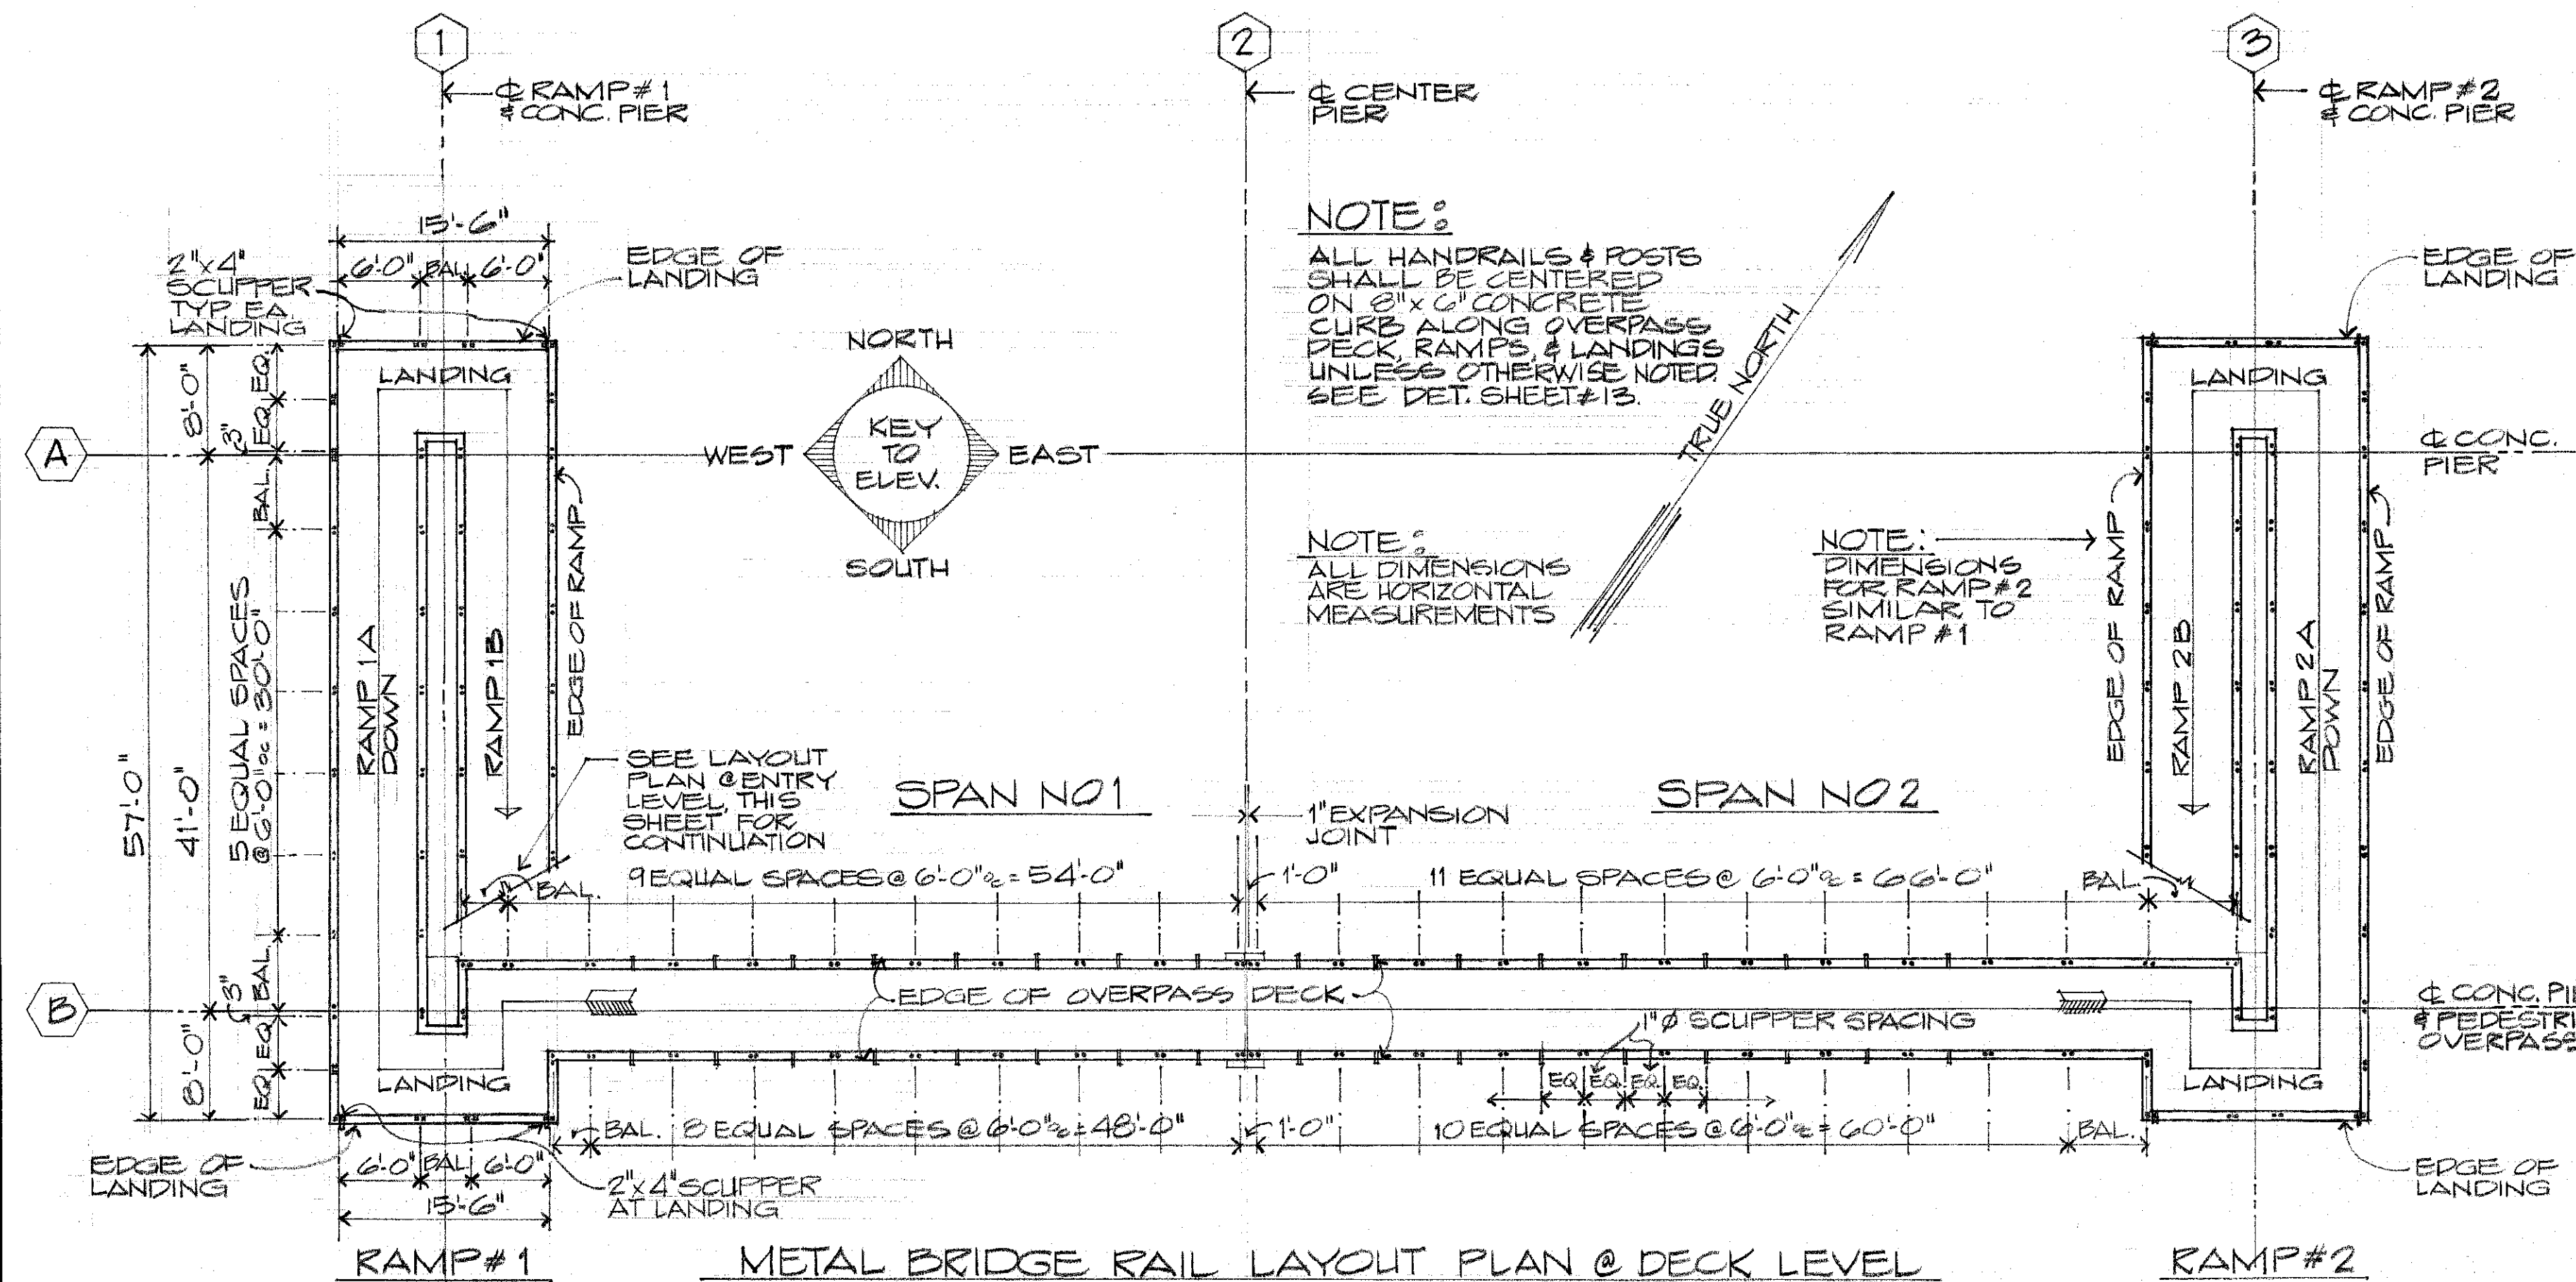

STATE OF HAWAII
DEPARTMENT OF TRANSPORTATION
HIGHWAYS DIVISION

RAILING LAYOUT PLAN
VINEYARD BOULEVARD
PEDESTRIAN OVERPASS
VICINITY OF PUA LANE, OAHU
PROJECT NO. 98A-01-70

DATE	_____
SURVEY PLOTTED BY	_____
DRAWN BY	_____
TRACES BY	_____
NOTE BOOK	_____
CHECKED BY	_____
NO.	_____