


FED. ROAD DIST. NO.	STATE	PROJ. NO.	FISCAL YEAR	SHEET NO.	TOTAL SHEETS
HAWAII	HAW.	98A-01-70	1970	2	19

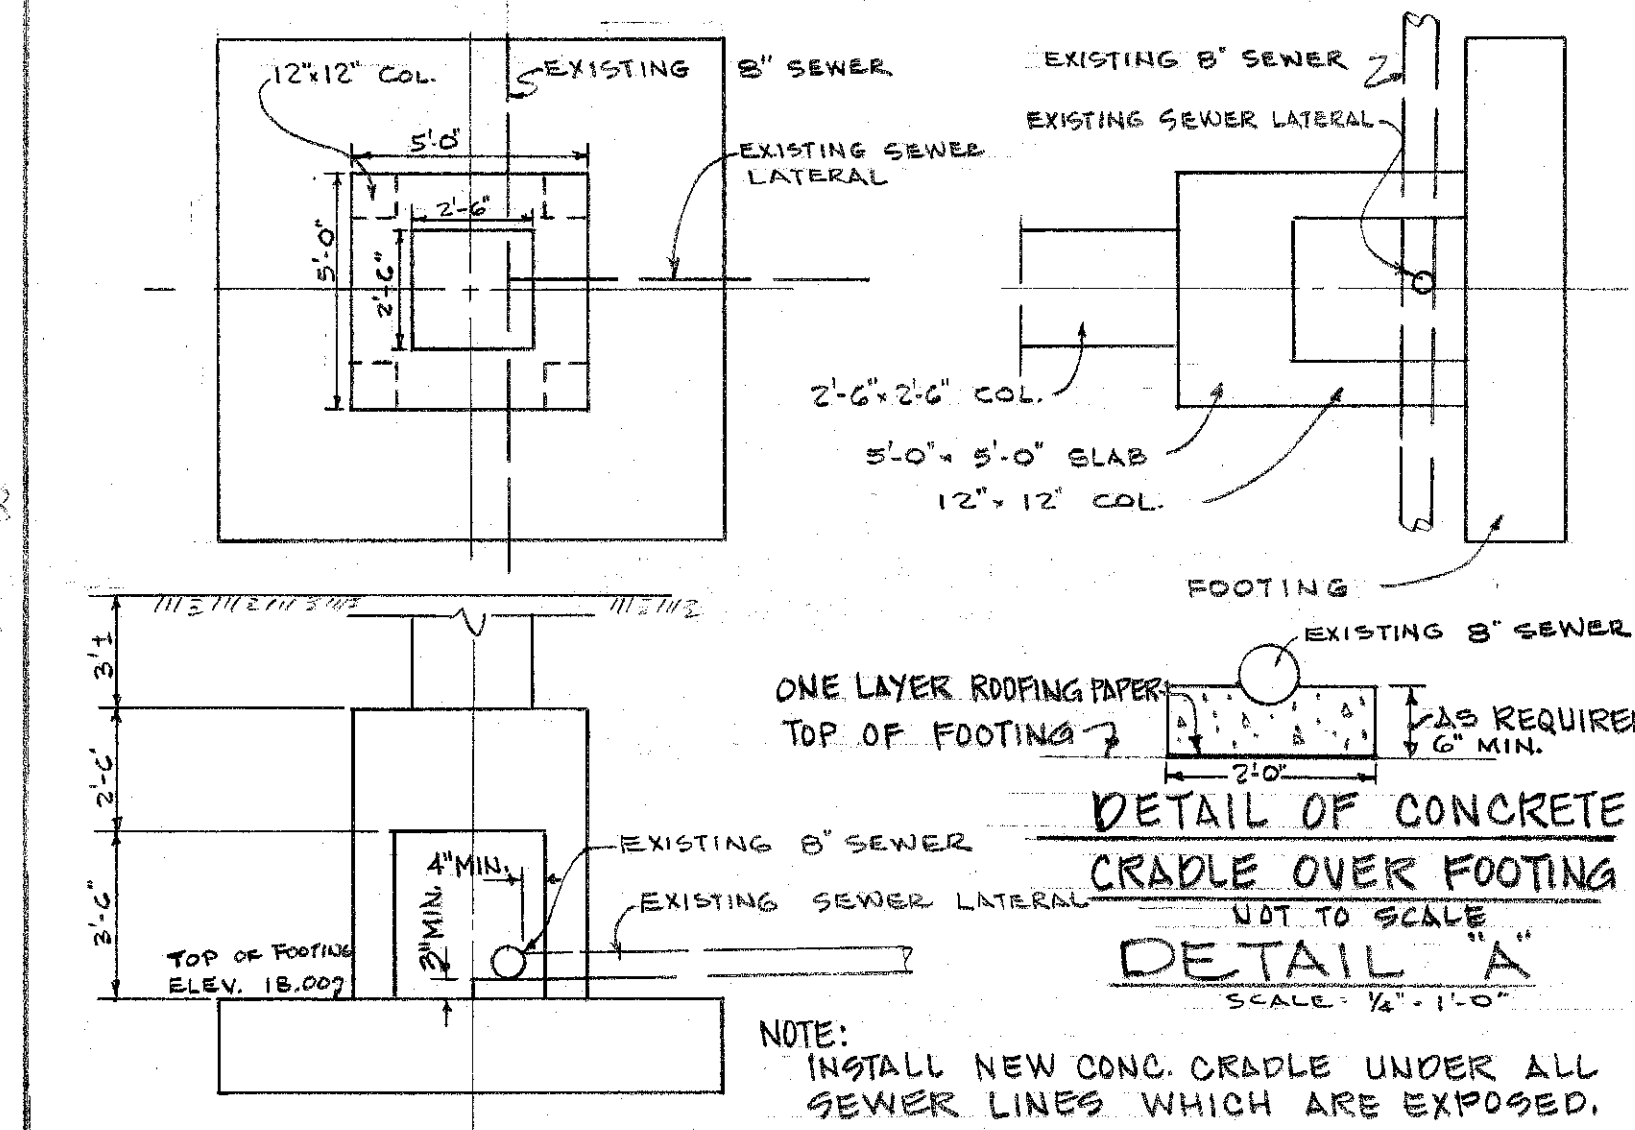


SEWER NOTES

1. ALL CONSTRUCTION WORK AND MATERIAL SHALL CONFORM TO THE STANDARD DETAIL AND SPECIFICATIONS OF THE CITY & COUNTY OF HONOLULU AS AMENDED.
2. IN THE EVENT THAT ANY CHANGES IN ALIGNMENT OR GRADE FOR THE PROPOSED SEWER IS REQUIRED DUE TO UNFORSEEN CONFLICT WITH OTHER UNDERGROUND UTILITIES, THE ENGINEER OR MAKER OF PLANS SHALL BE RESPONSIBLE FOR THE REQUIRED CHANGES WHICH ARE TO BE PRESENTED TO THE DIVISION OF SEWER FOR APPROVAL.
3. THE CONTRACTOR SHALL VERIFY THE LOCATION AND INVERT OF ALL EXISTING UTILITIES WHETHER SHOWN OR NOT SHOWN.
4. THE CONTRACTOR SHALL NOTIFY THE DIVISION OF SEWERS TWO (2) DAYS PRIOR TO COMMENCEMENT OF WORK.
5. ALL PAVEMENTS, CURB, GUTTERS, SIDEWALKS, UTILITIES AND OTHER IMPROVEMENTS DESTROYED OR DISTURBED, UNDERMINED OR REMOVED BY THE CONTRACTOR SHALL BE SATISFACTORY RECONSTRUCTED OR REPLACED AT THE CONTRACTORS EXPENSE.
6. THE CONTRACTOR SHALL OBTAIN AND PAY FOR ALL NECESSARY PERMITS.
7. DURING CONSTRUCTION THE CONTRACTOR SHALL SUPPORT EXISTING 8" SEWER AND SEWER LATERAL IN A MANNER SATISFACTORY TO THE DIV. OF SEWER.

LEGEND

- 25.35 EXIST. SPOT ELEVATION
- W12 EXIST. WATER LINE
- SD24 EXIST. STORM DRAIN LINE
- 8" EXIST. SEWER LINE W/EXIST. SMH
- 8" NEW 8" SEWER LINE
- 24" NEW 24" RCP (CL III) STORM DRAIN LINE
- NEW DRAIN INTAKE
- OH WIRE EXIST. OVERHEAD ELECTRICAL WIRES

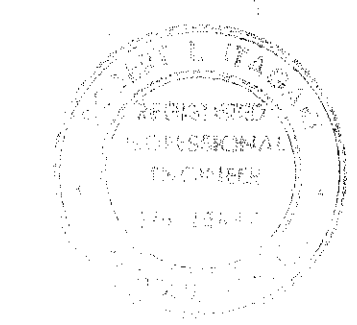

STATE OF HAWAII
DEPARTMENT OF TRANSPORTATION
HIGHWAYS DIVISION

SITE AND UTILITY PLAN


VINEYARD BOULEVARD

PEDESTRIAN OVERPASS

VICINITY OF PUA LANE, OAHU

PROJECT NO. 98A-01-70

SHEET No. 1 OF 1 SHEETS

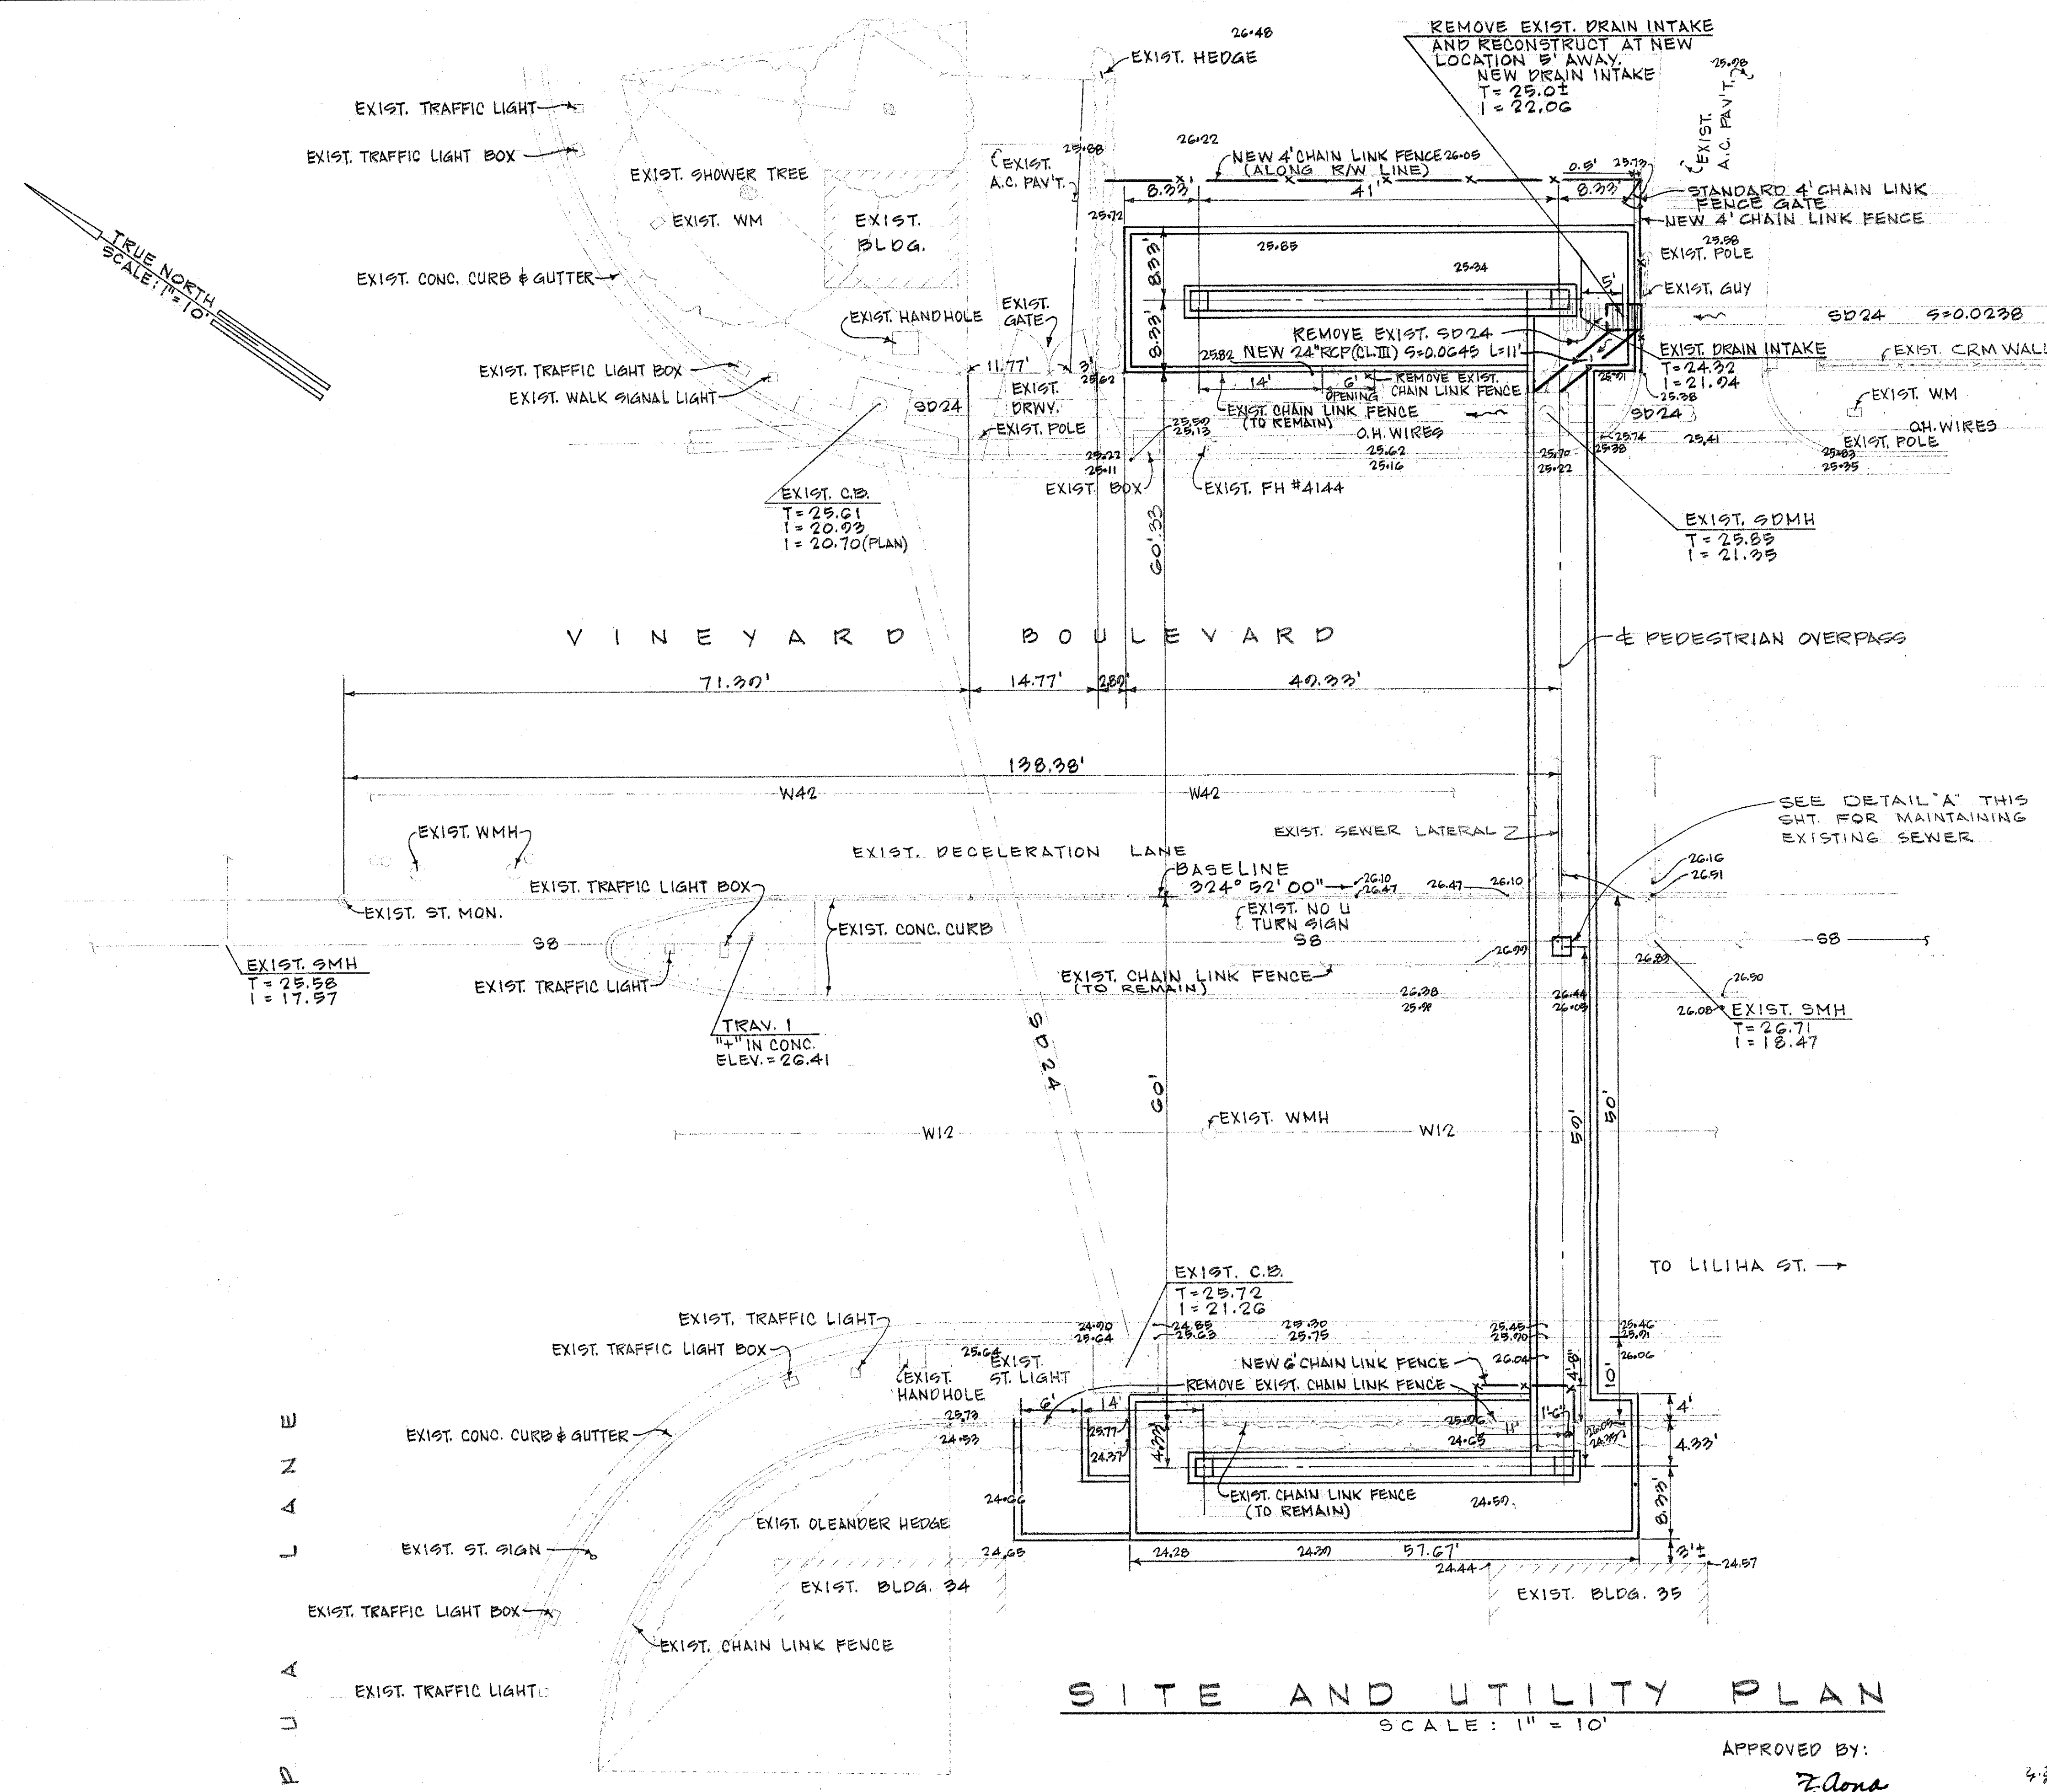

SITE AND UTILITY PLAN
SCALE: 1" = 10'

APPROVED BY:
F. Aona
CHIEF, DIVISION OF SEWERS
DATE: 9/3/70

DATE	
SURVEY PLOTTED BY	
DRAWN BY	
CHECKED BY	
NOTED BY	
NO.	