


DATE	BY	REVIEWED	DATE
		PLANNED	
		DESIGNED	
		NOTED	
		APPROVED	
		NO.	

DATE	BY	REVIEWED	DATE
		PLANNED	
		DESIGNED	
		NOTED	
		APPROVED	
		NO.	

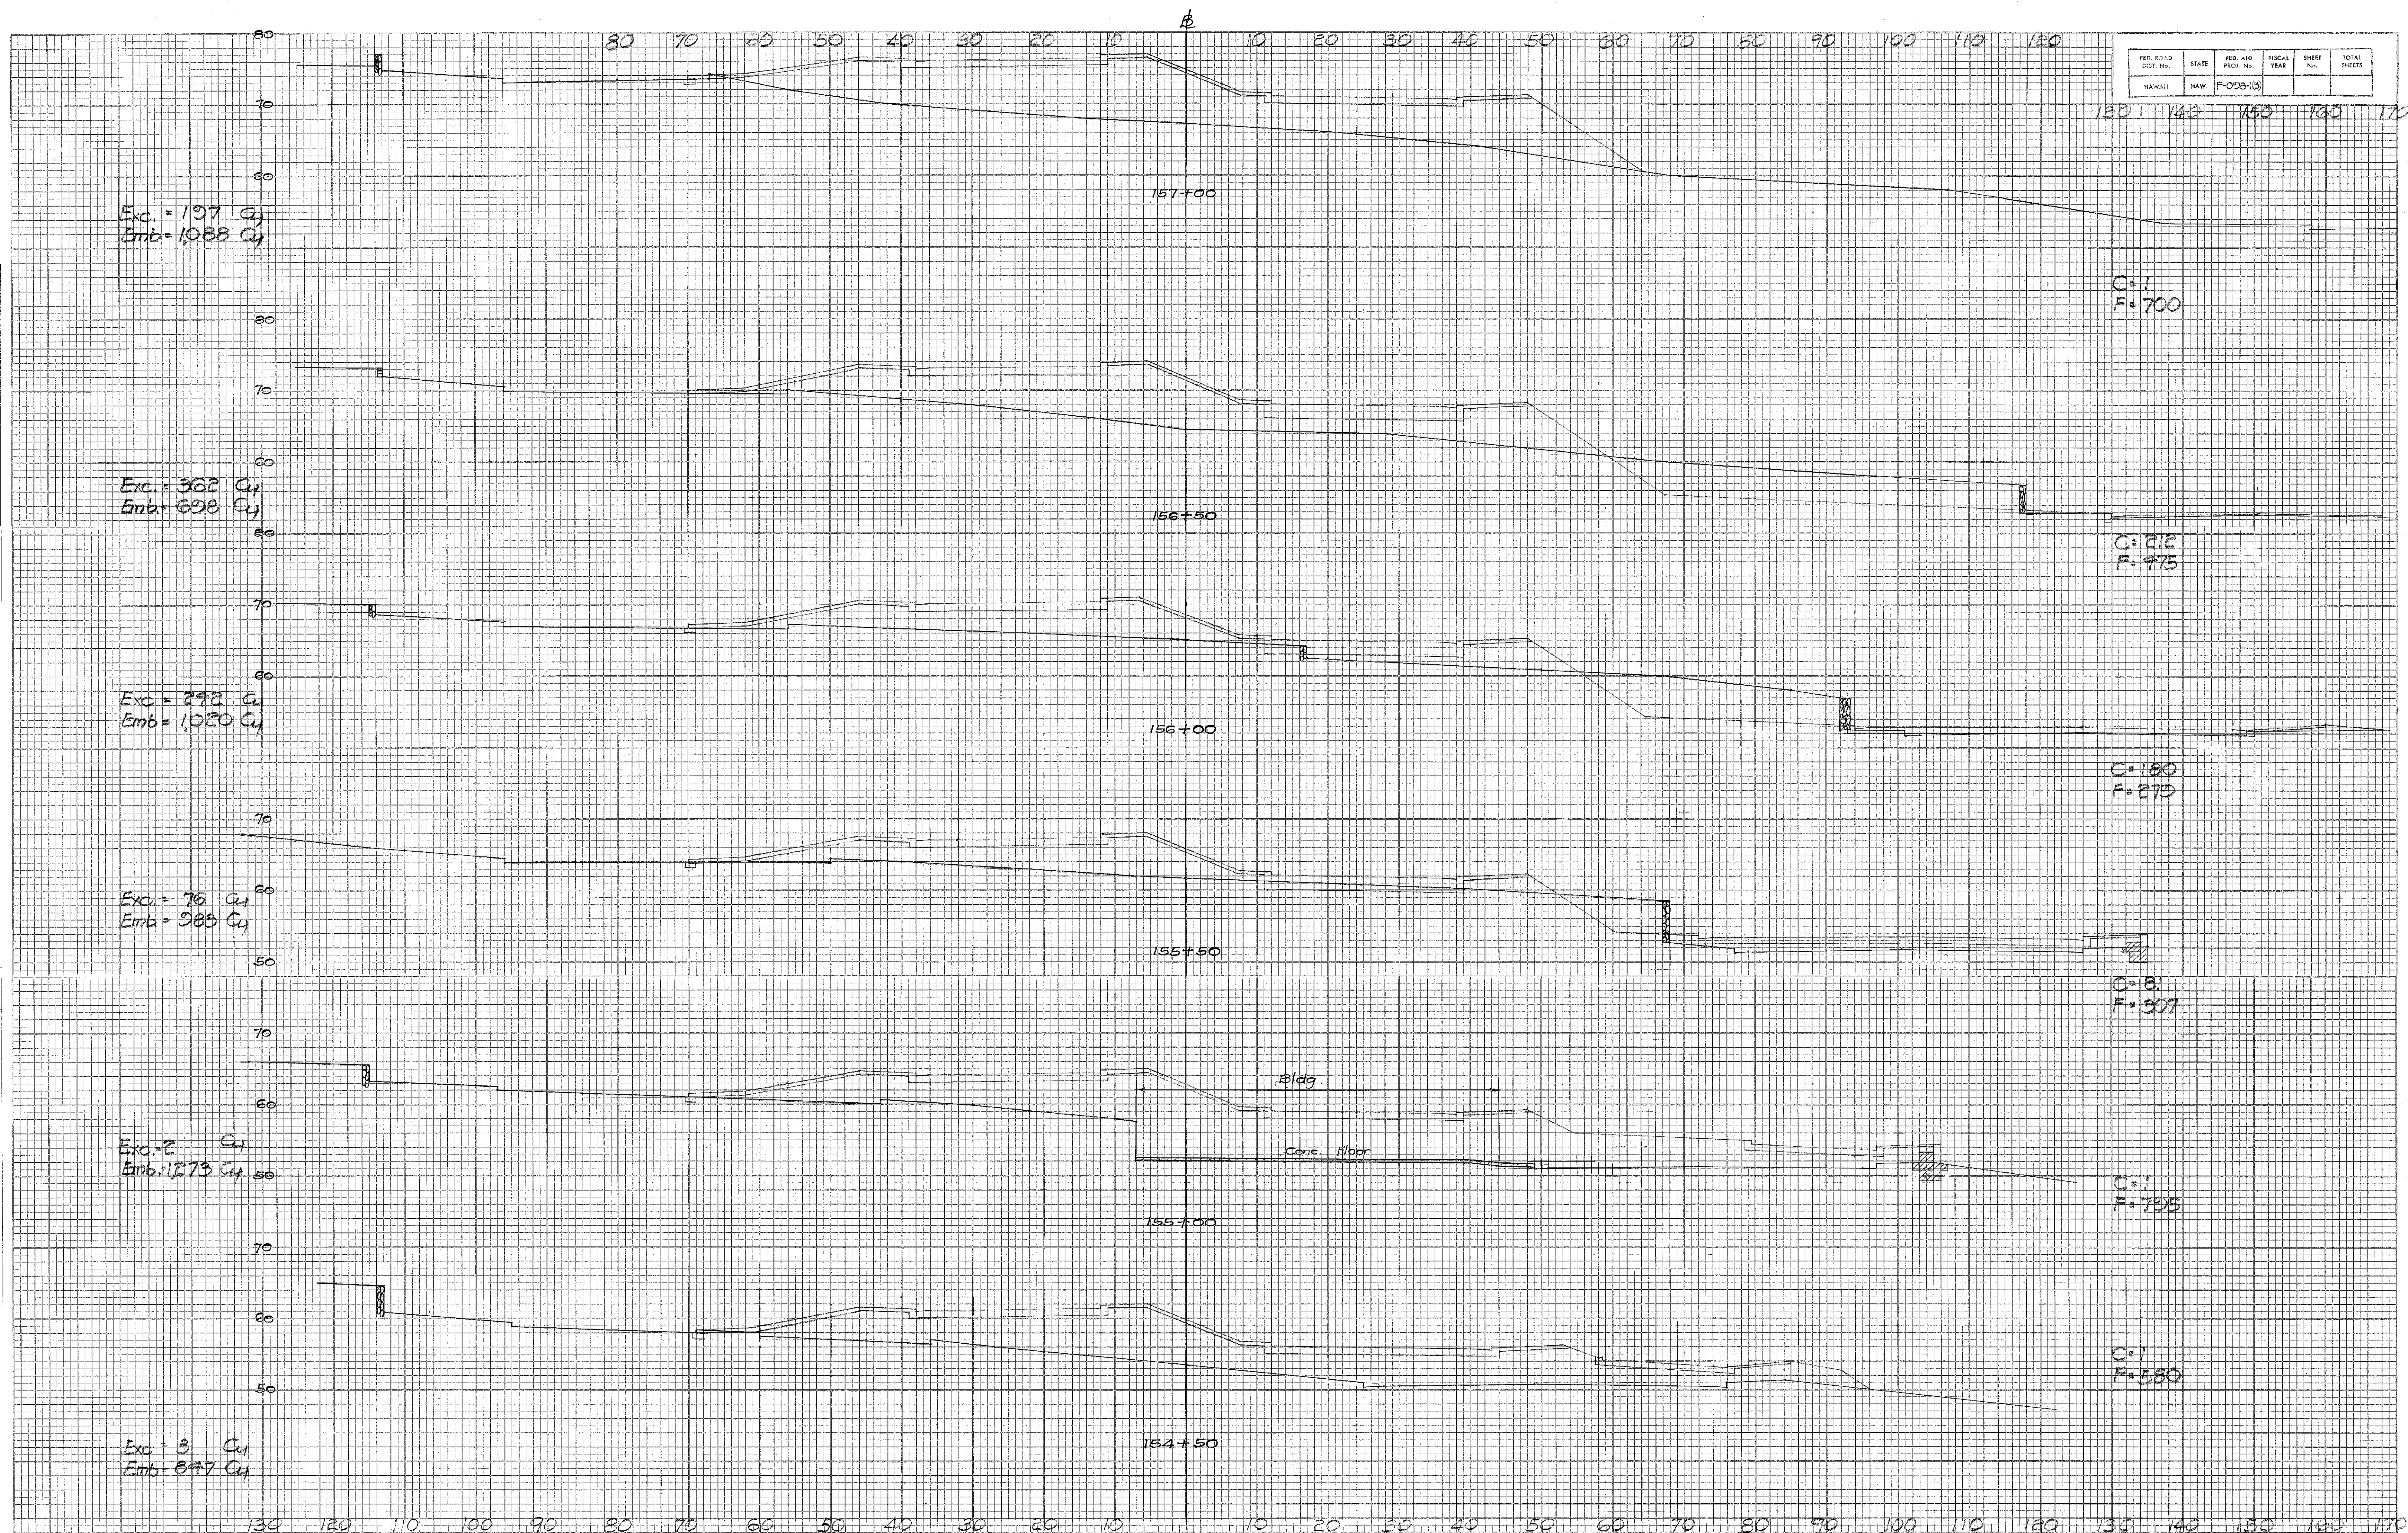

5928. (100)

FED. ROAD DIST. NO.	STATE	FED. AID PROJ. NO.	FISCAL YEAR	SHEET NO.	TOTAL SHEETS

DATE	BY	REVIEWED	PLANNED	NO. OF AREAS CHECKED

DATE	BY	REVIEWED	PLANNED	NO. OF AREAS CHECKED

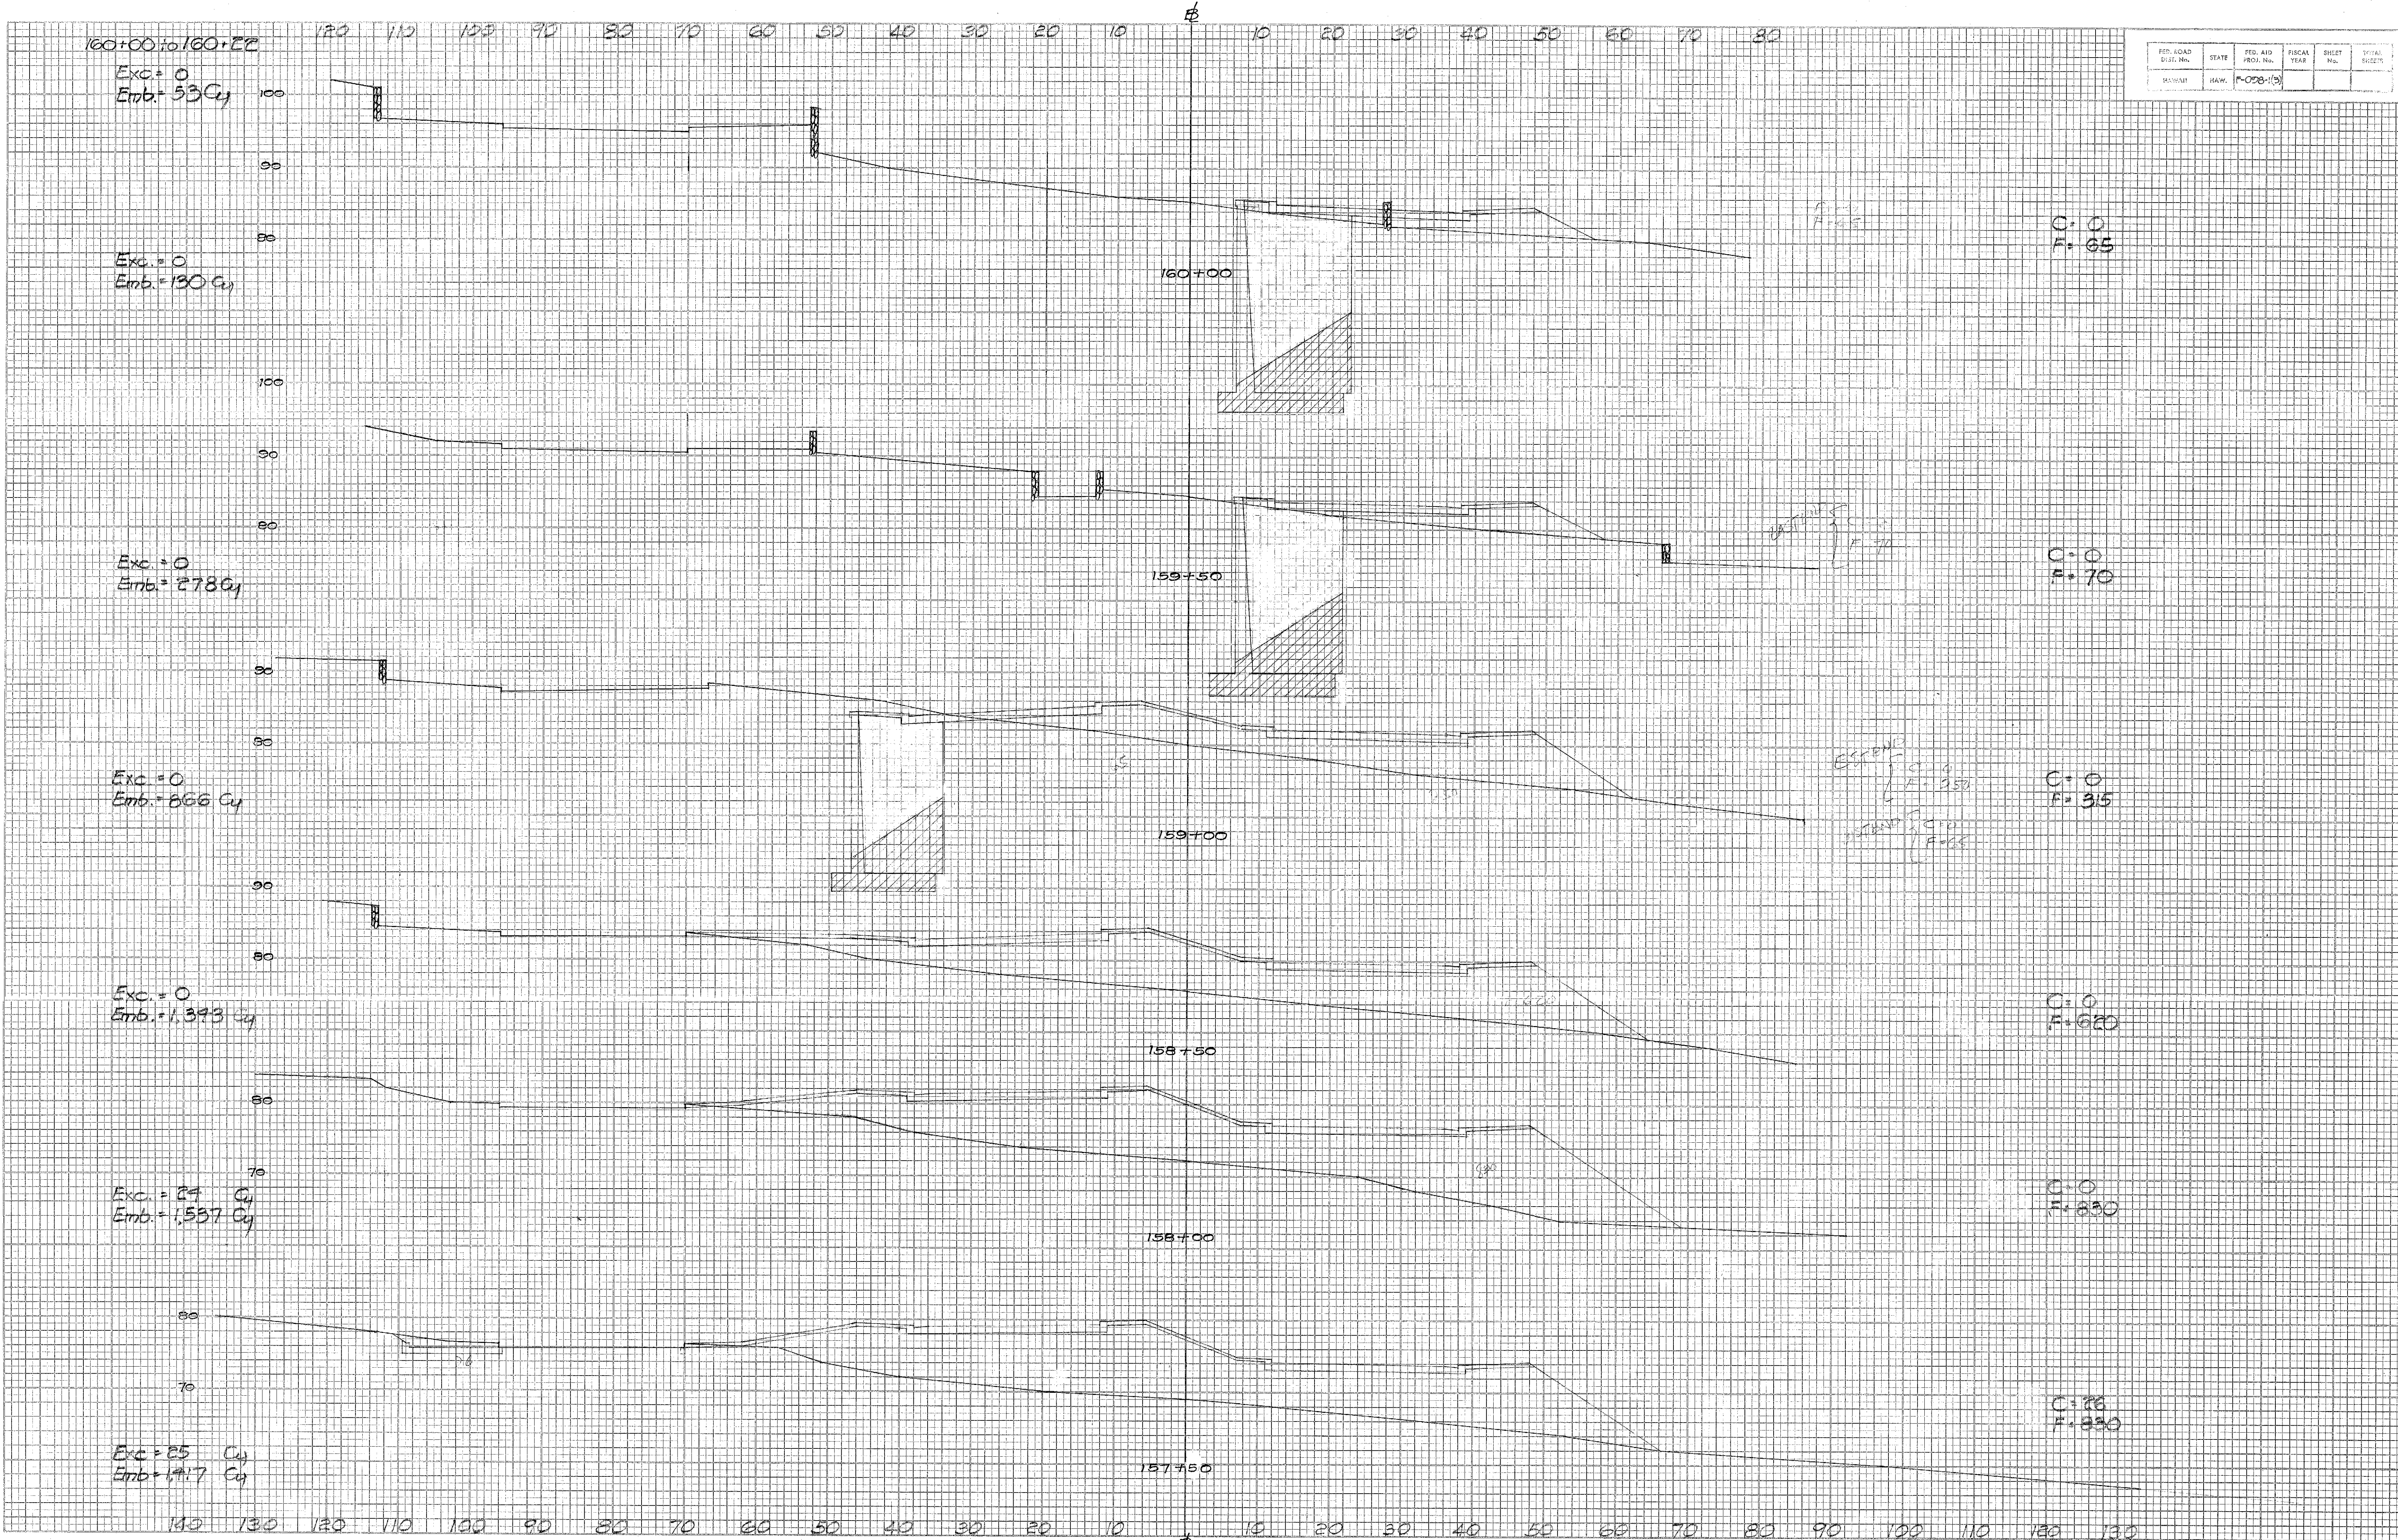


PLATE 3 CROSS SECTION O.P.R.S.E.
VINEYARD THOROUGHFARE

5928. (101)

DATE	BY	NO.
FINAL SURVEY	SURVEY	NO.
PLOTTED	PLOTTED	
NOTED	NOTED	
AREAS	AREAS	
CHECKED	CHECKED	

DATE	BY	NO.
ORIGINAL SURVEY	SURVEY	NO.
PLOTTED	PLOTTED	
NOTED	NOTED	
AREAS	AREAS	
CHECKED	CHECKED	

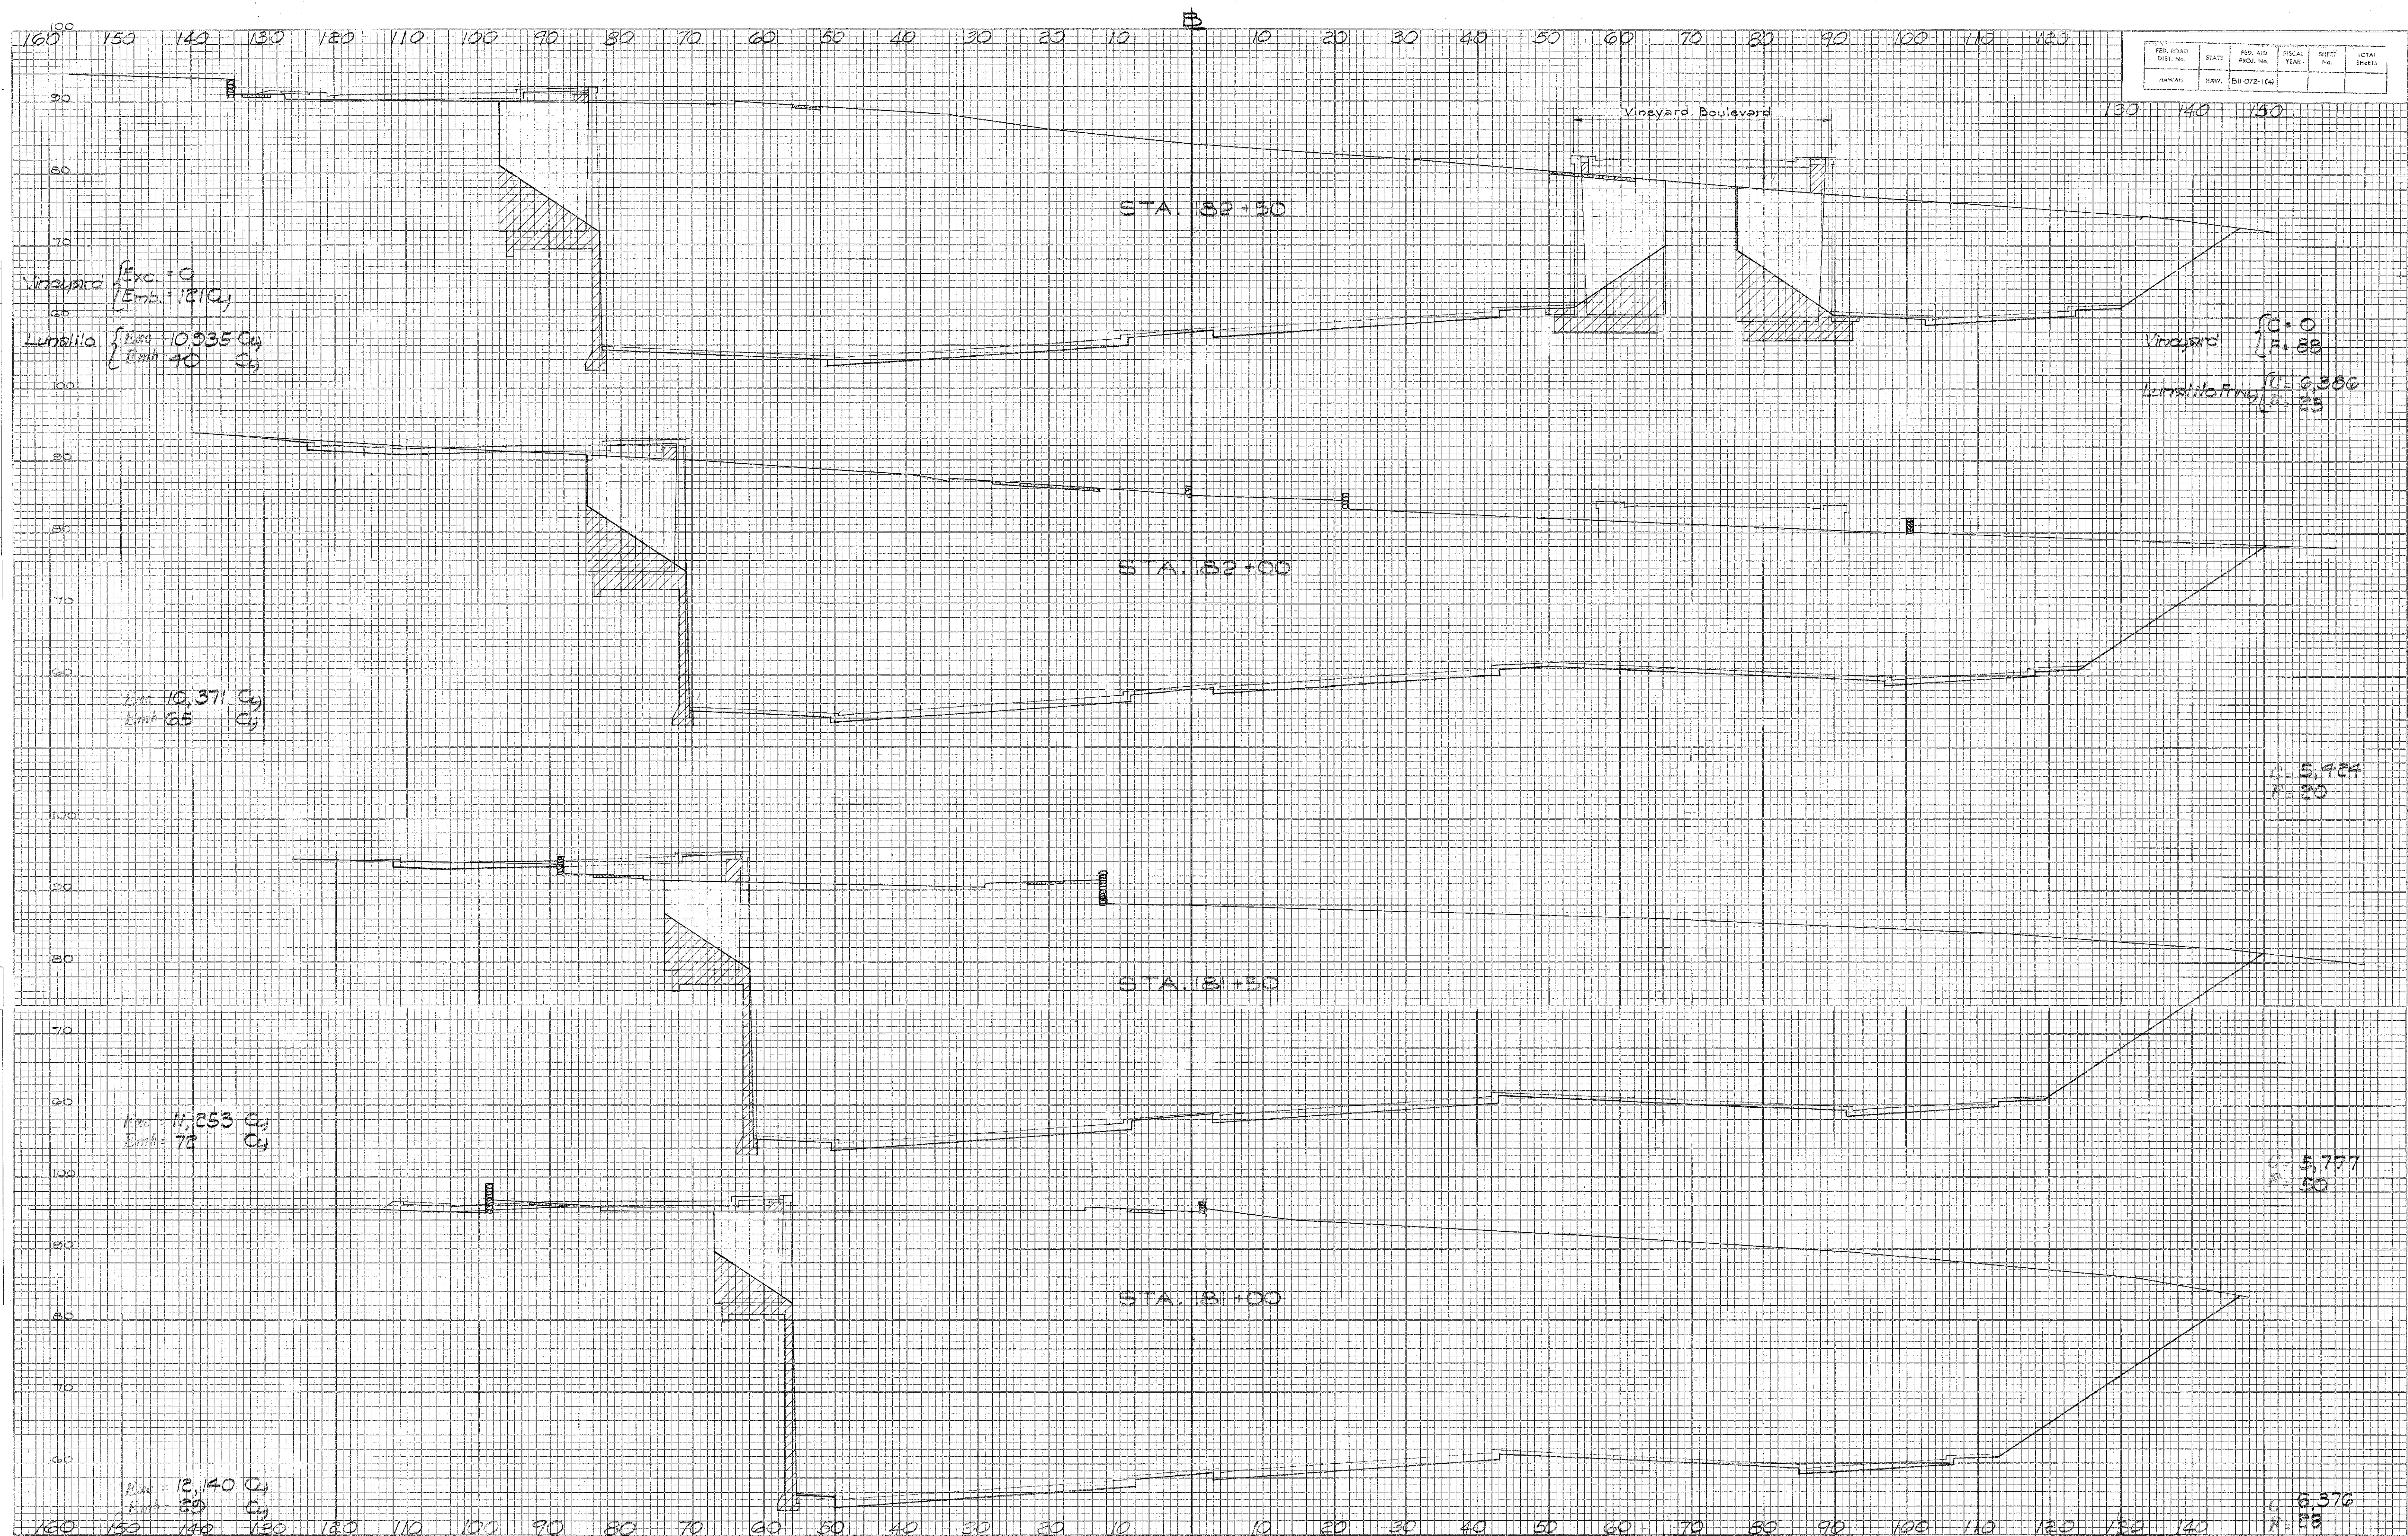


PLATE 3 CROSS SECTION O.P.R.D.S.
100% RAS PAPER-MADE AND PRINTED IN U.S.A.
CHARLES BRIDGES COMPANY

5927.

5928.

18125 to 18250

DATE _____
BY _____
FINAL SURVEY PLOTTED _____
NOTE BOOK _____
NO. _____

DATE _____
BY _____
ORIGINAL SURVEY PLOTTED _____
NOTE BOOK _____
NO. _____

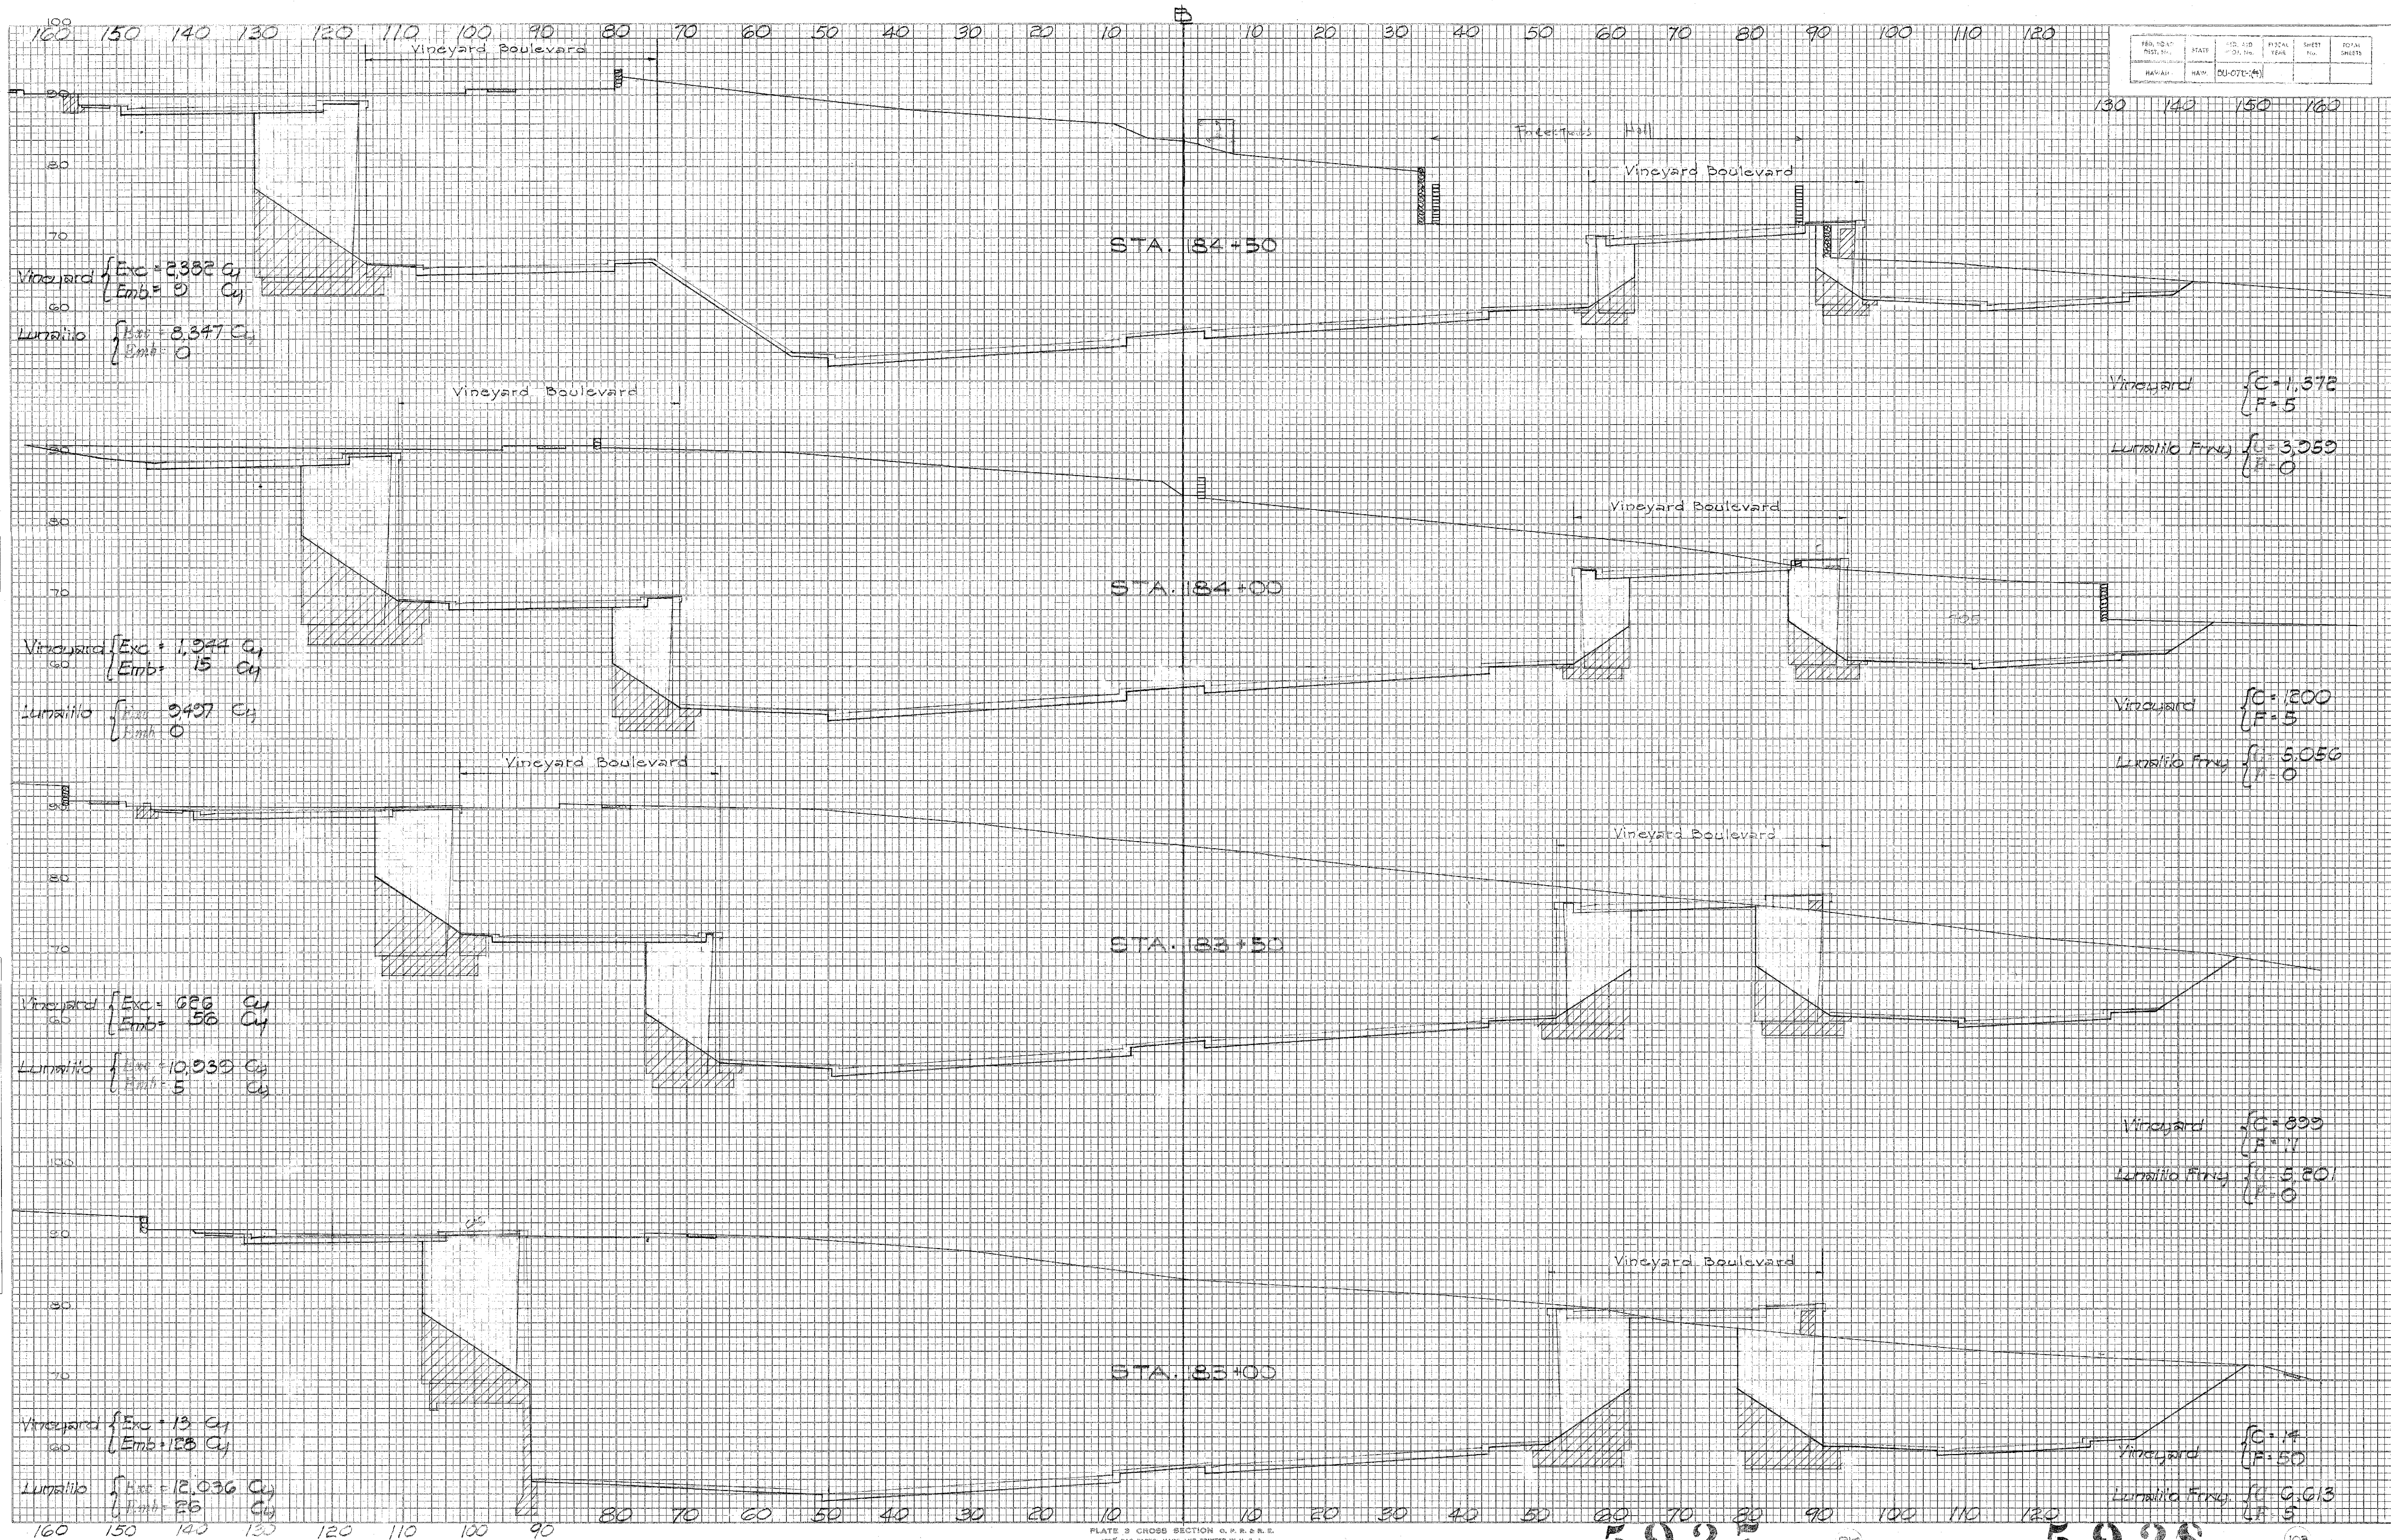


PLATE 3 CROSS SECTION C. P. R. & R. R.
100% 250 PAPER-MADE AND PRINTED IN U. S. A.
CHARLES BRUNING COMPANY

5927.

5928.

1/3 00 10 184 50

DATE	BY	SURVEYED	PLOTTED	NOTED	AREAS CHECKED
FINAL					
SURVEY					
NO.					

DATE	BY	SURVEYED	PLOTTED	NOTED	AREAS CHECKED
ORIGINAL					
SURVEY					
NO.					

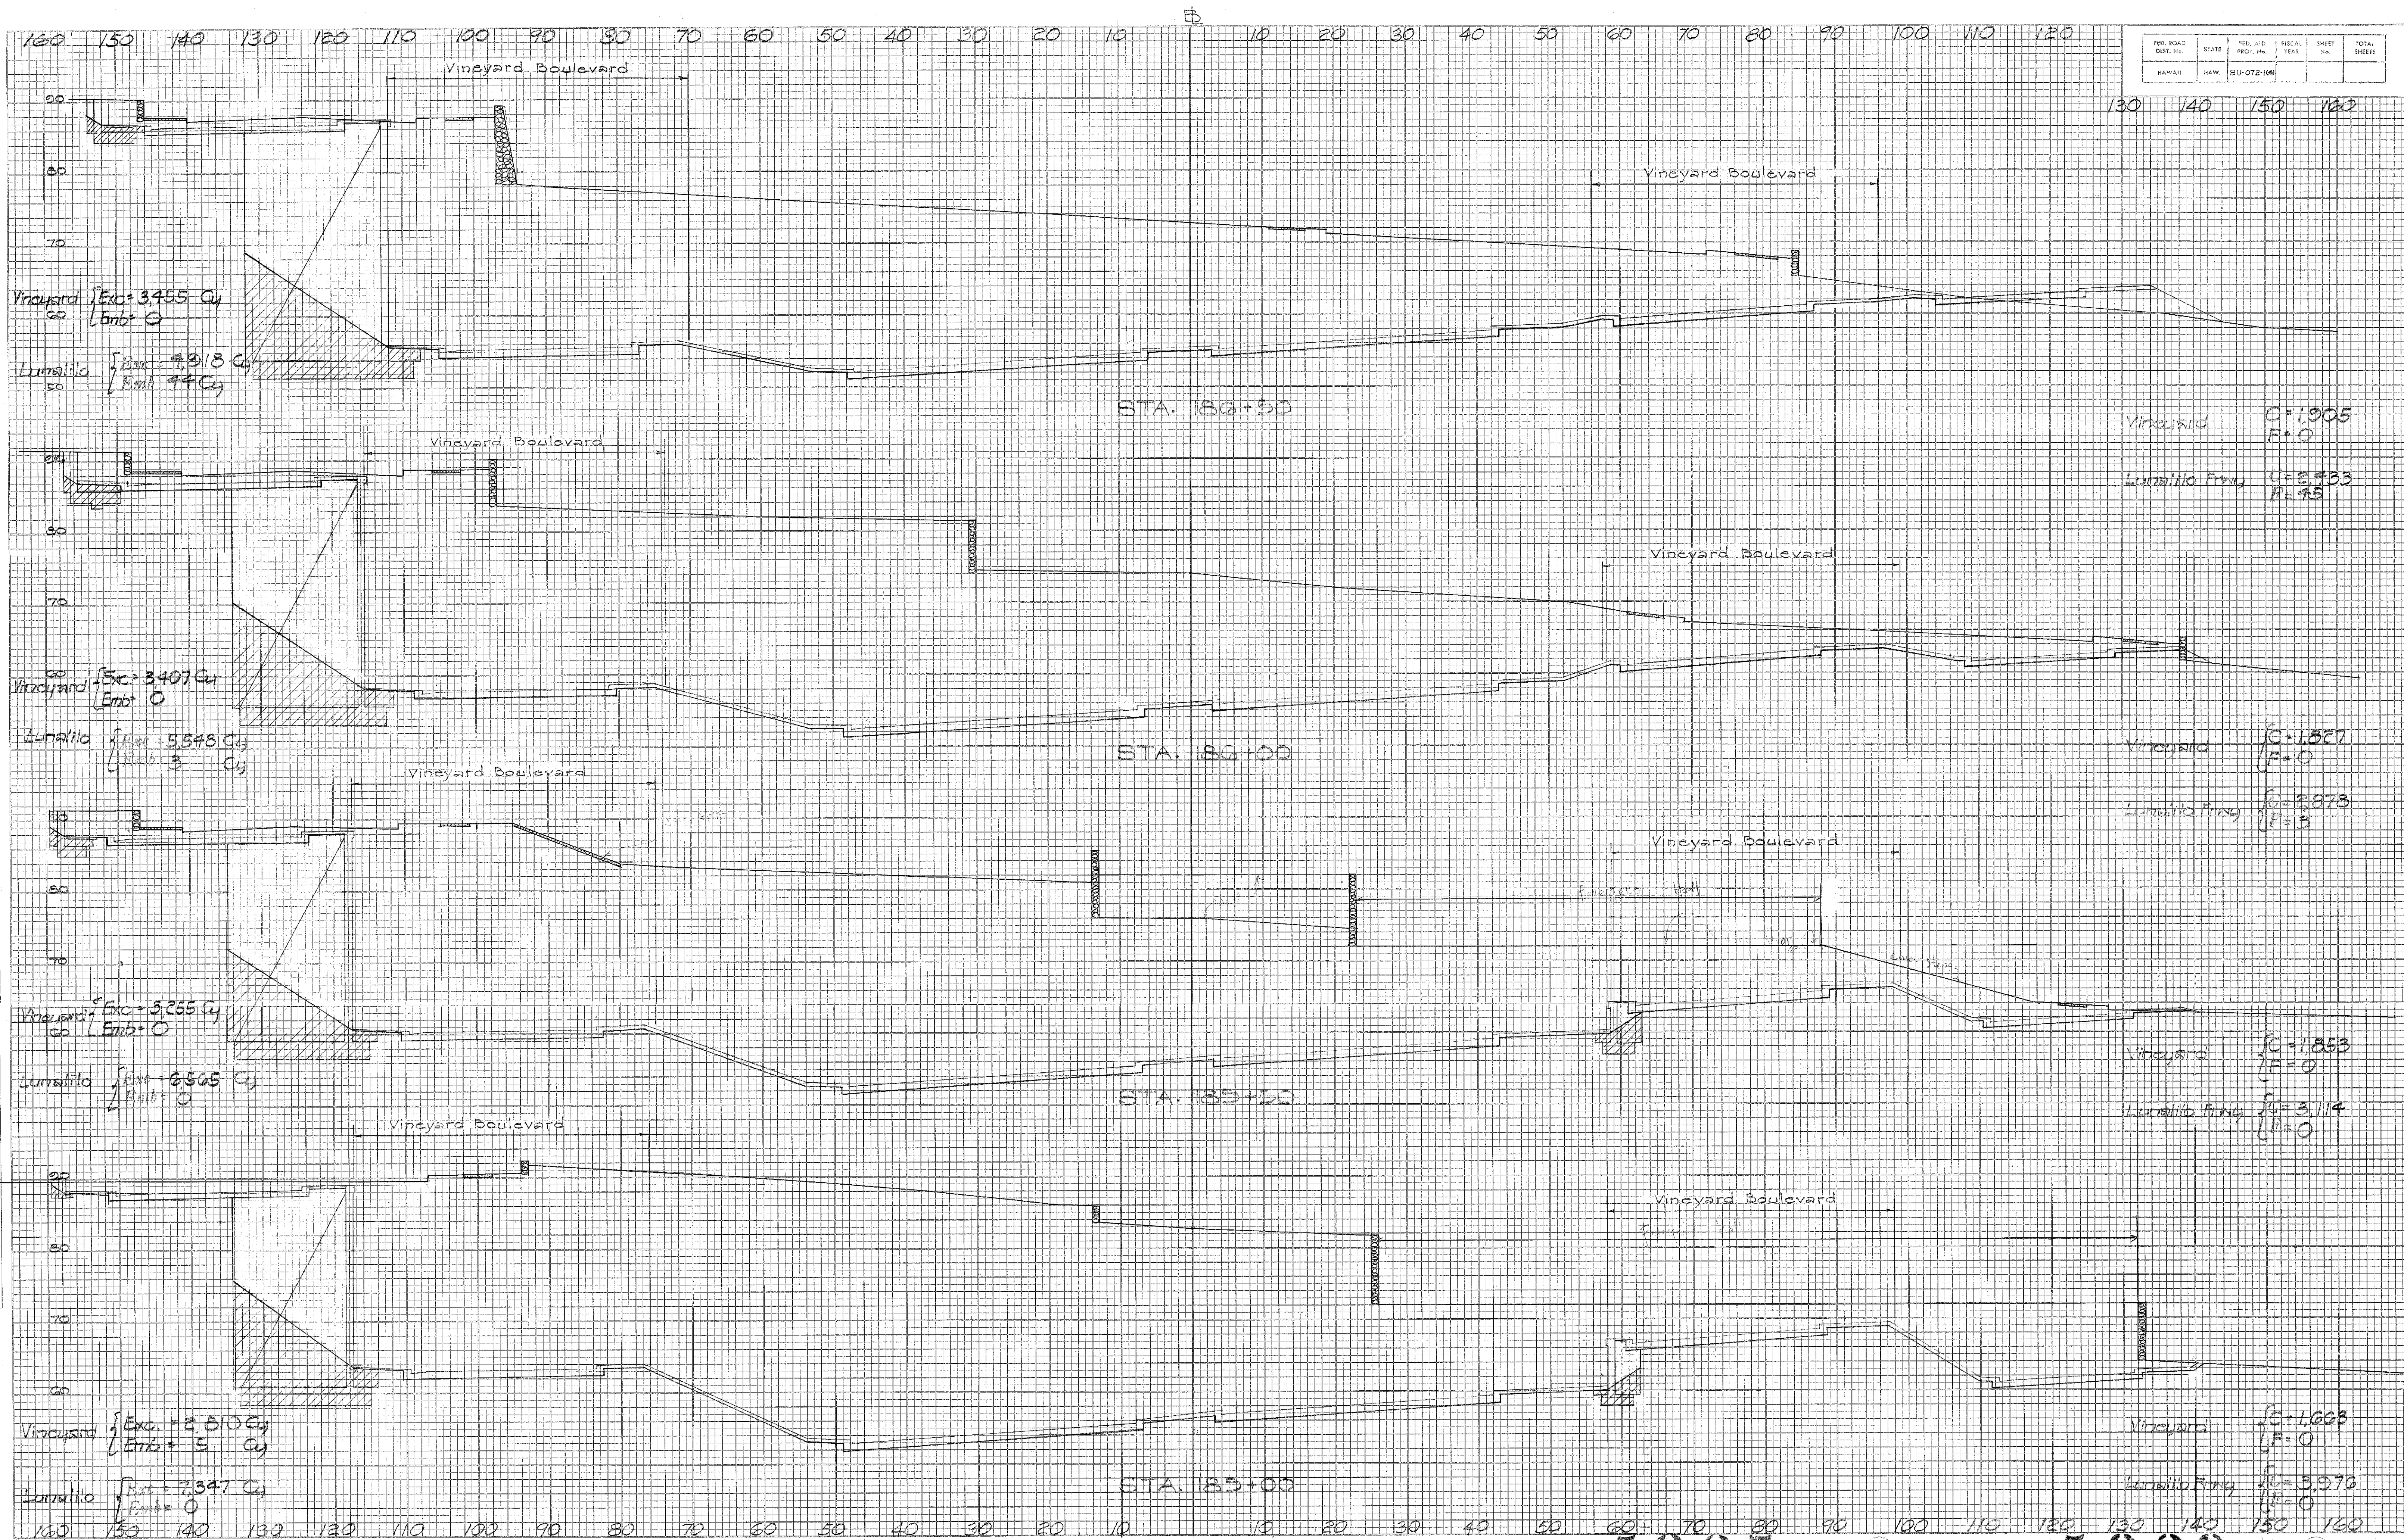


PLATE 3 CROSS SECTION O. P. R. & E.
 100% MAG PAPER—MADE AND PRINTED IN U. S. A.
 CHARLES BRUNING COMPANY

5927.

5928.

100% MAG PAPER

DATE	BY	REVIEWED	PLANNED	NOTED	AREAS CHECKED
NO.					

DATE	BY	REVIEWED	PLANNED	NOTED	AREAS CHECKED
NO.					

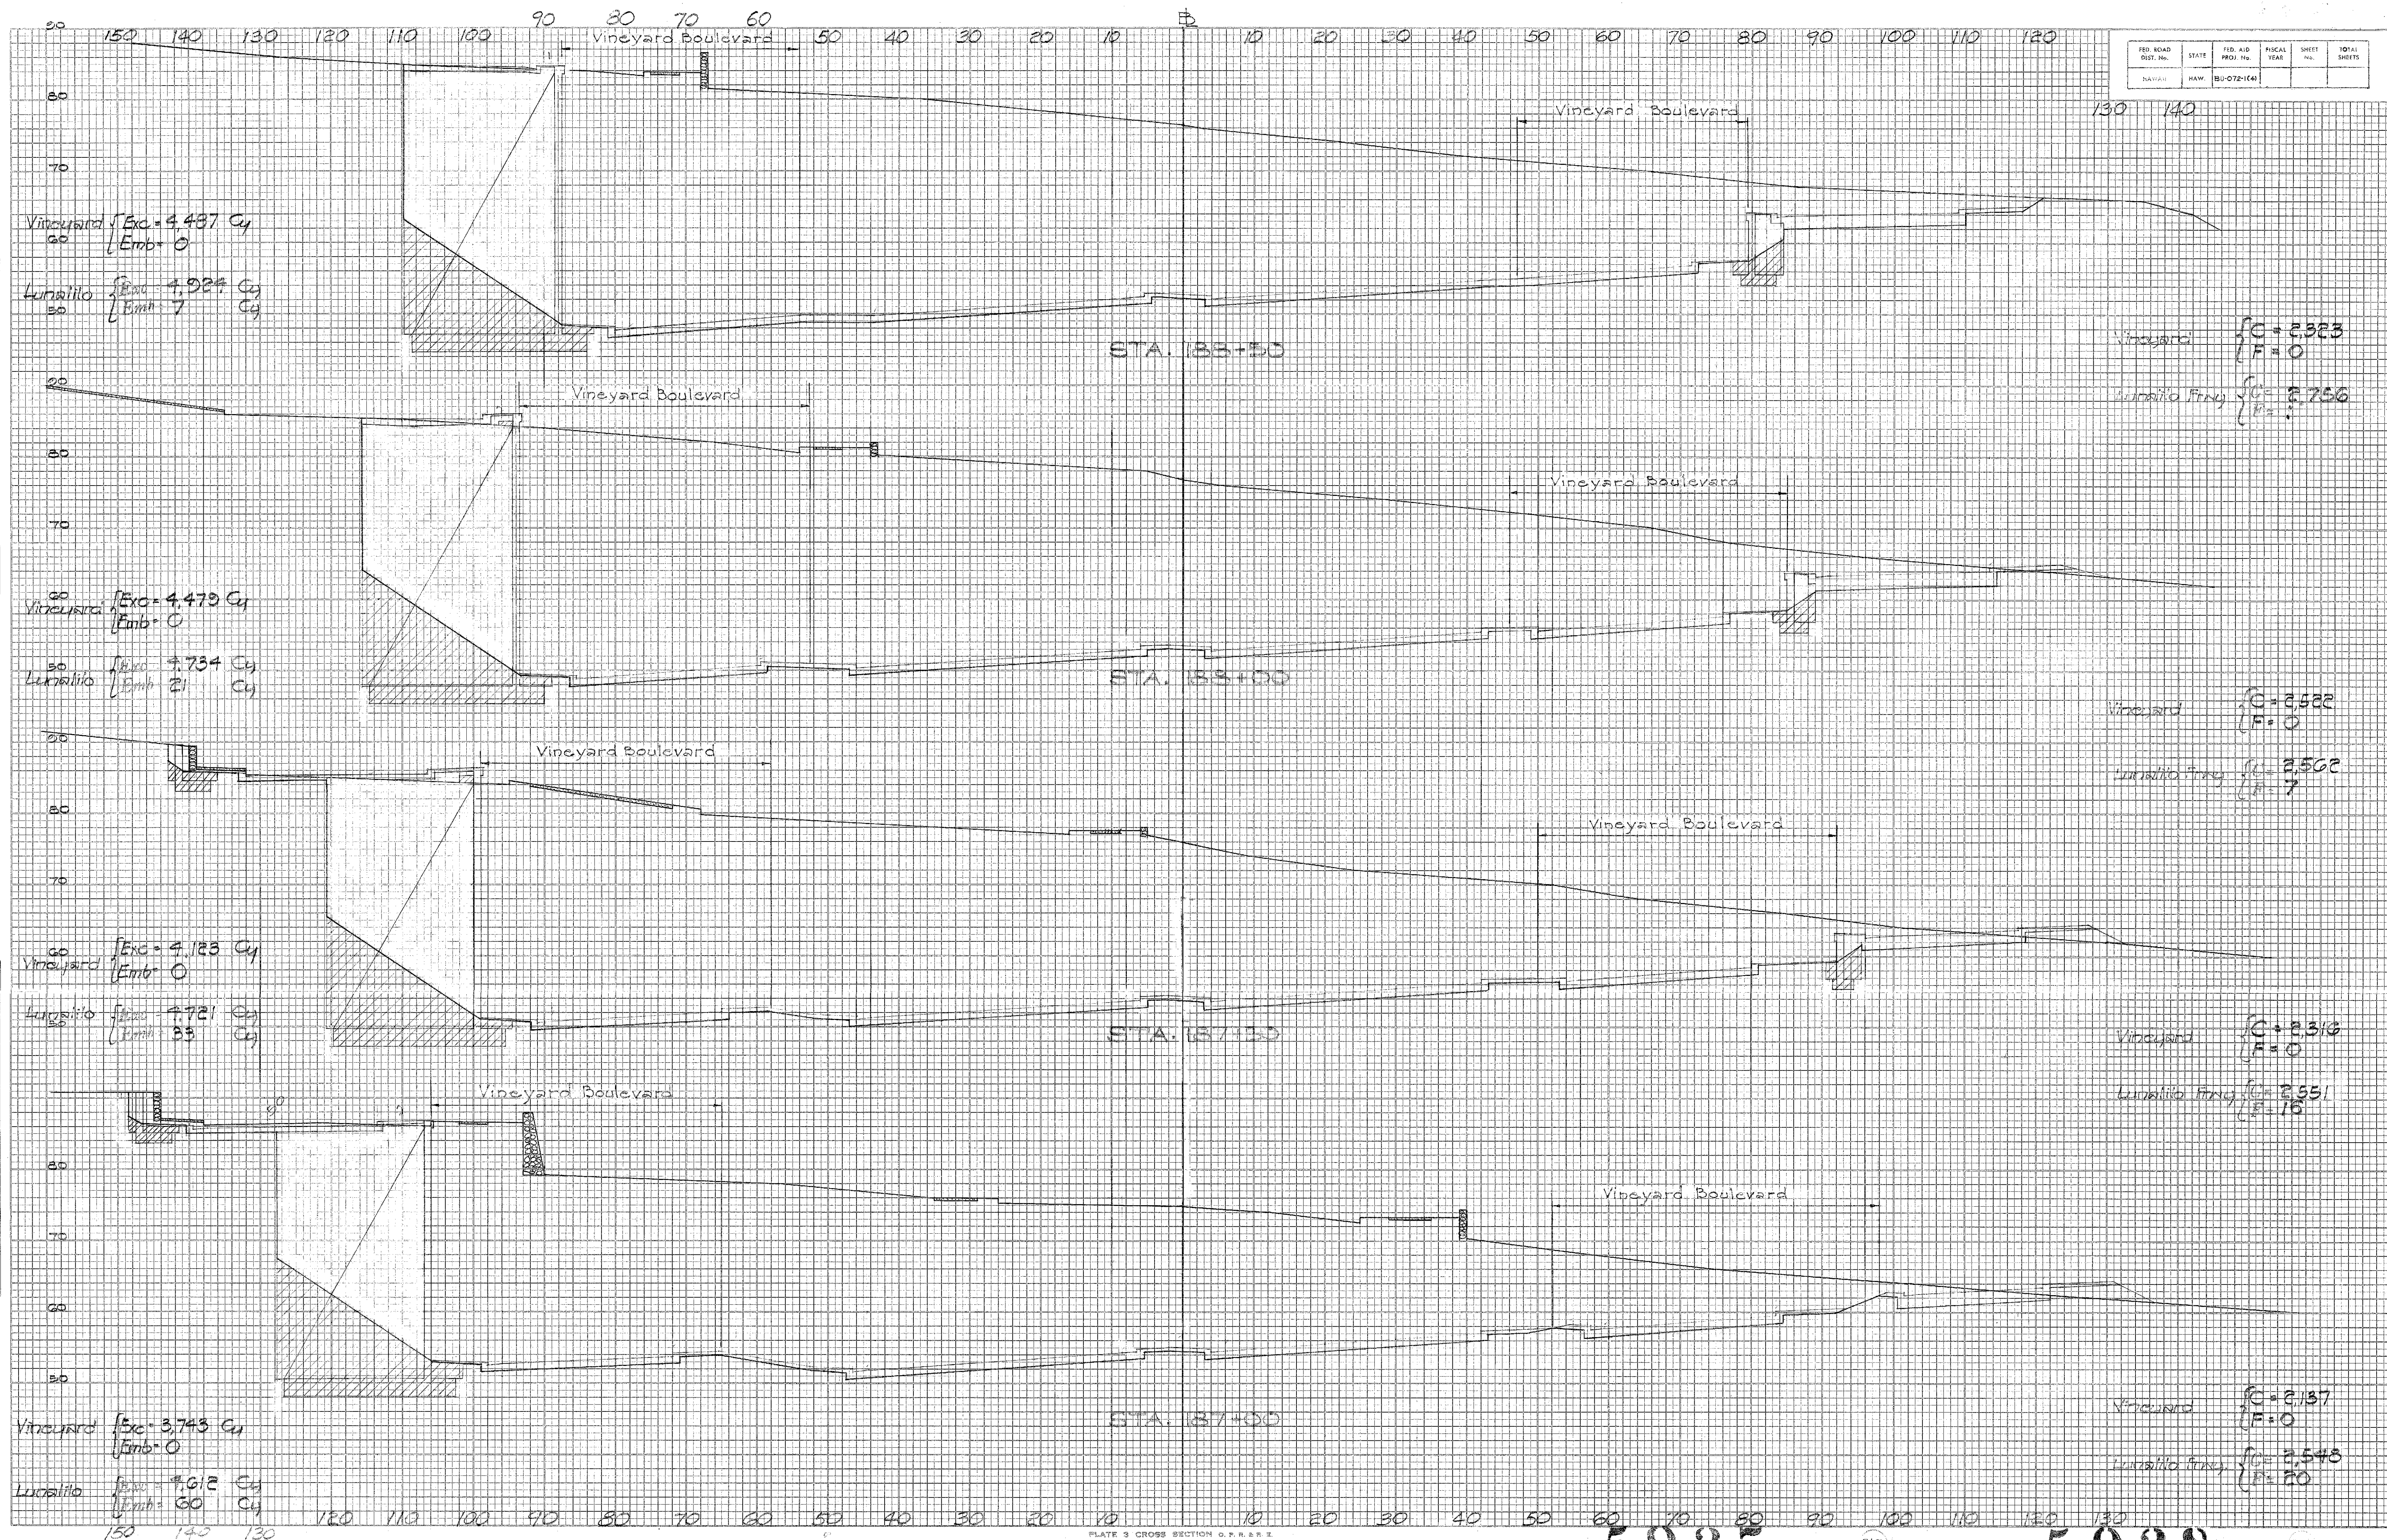


PLATE 3 CROSS SECTION O.P.R.R. E.
 100' R.A. PAPER—MADE AND PRINTED IN U.S.A.
 CHARLES BRUNING COMPANY

5927.

5928.

ORIGINAL SURVEY	SURVEYED	BY	DATE
NOTE BOOK	PLOTTED		
	TEMPLATE		
	AREAS		
	AREAS CHECKED		
NO. _____			

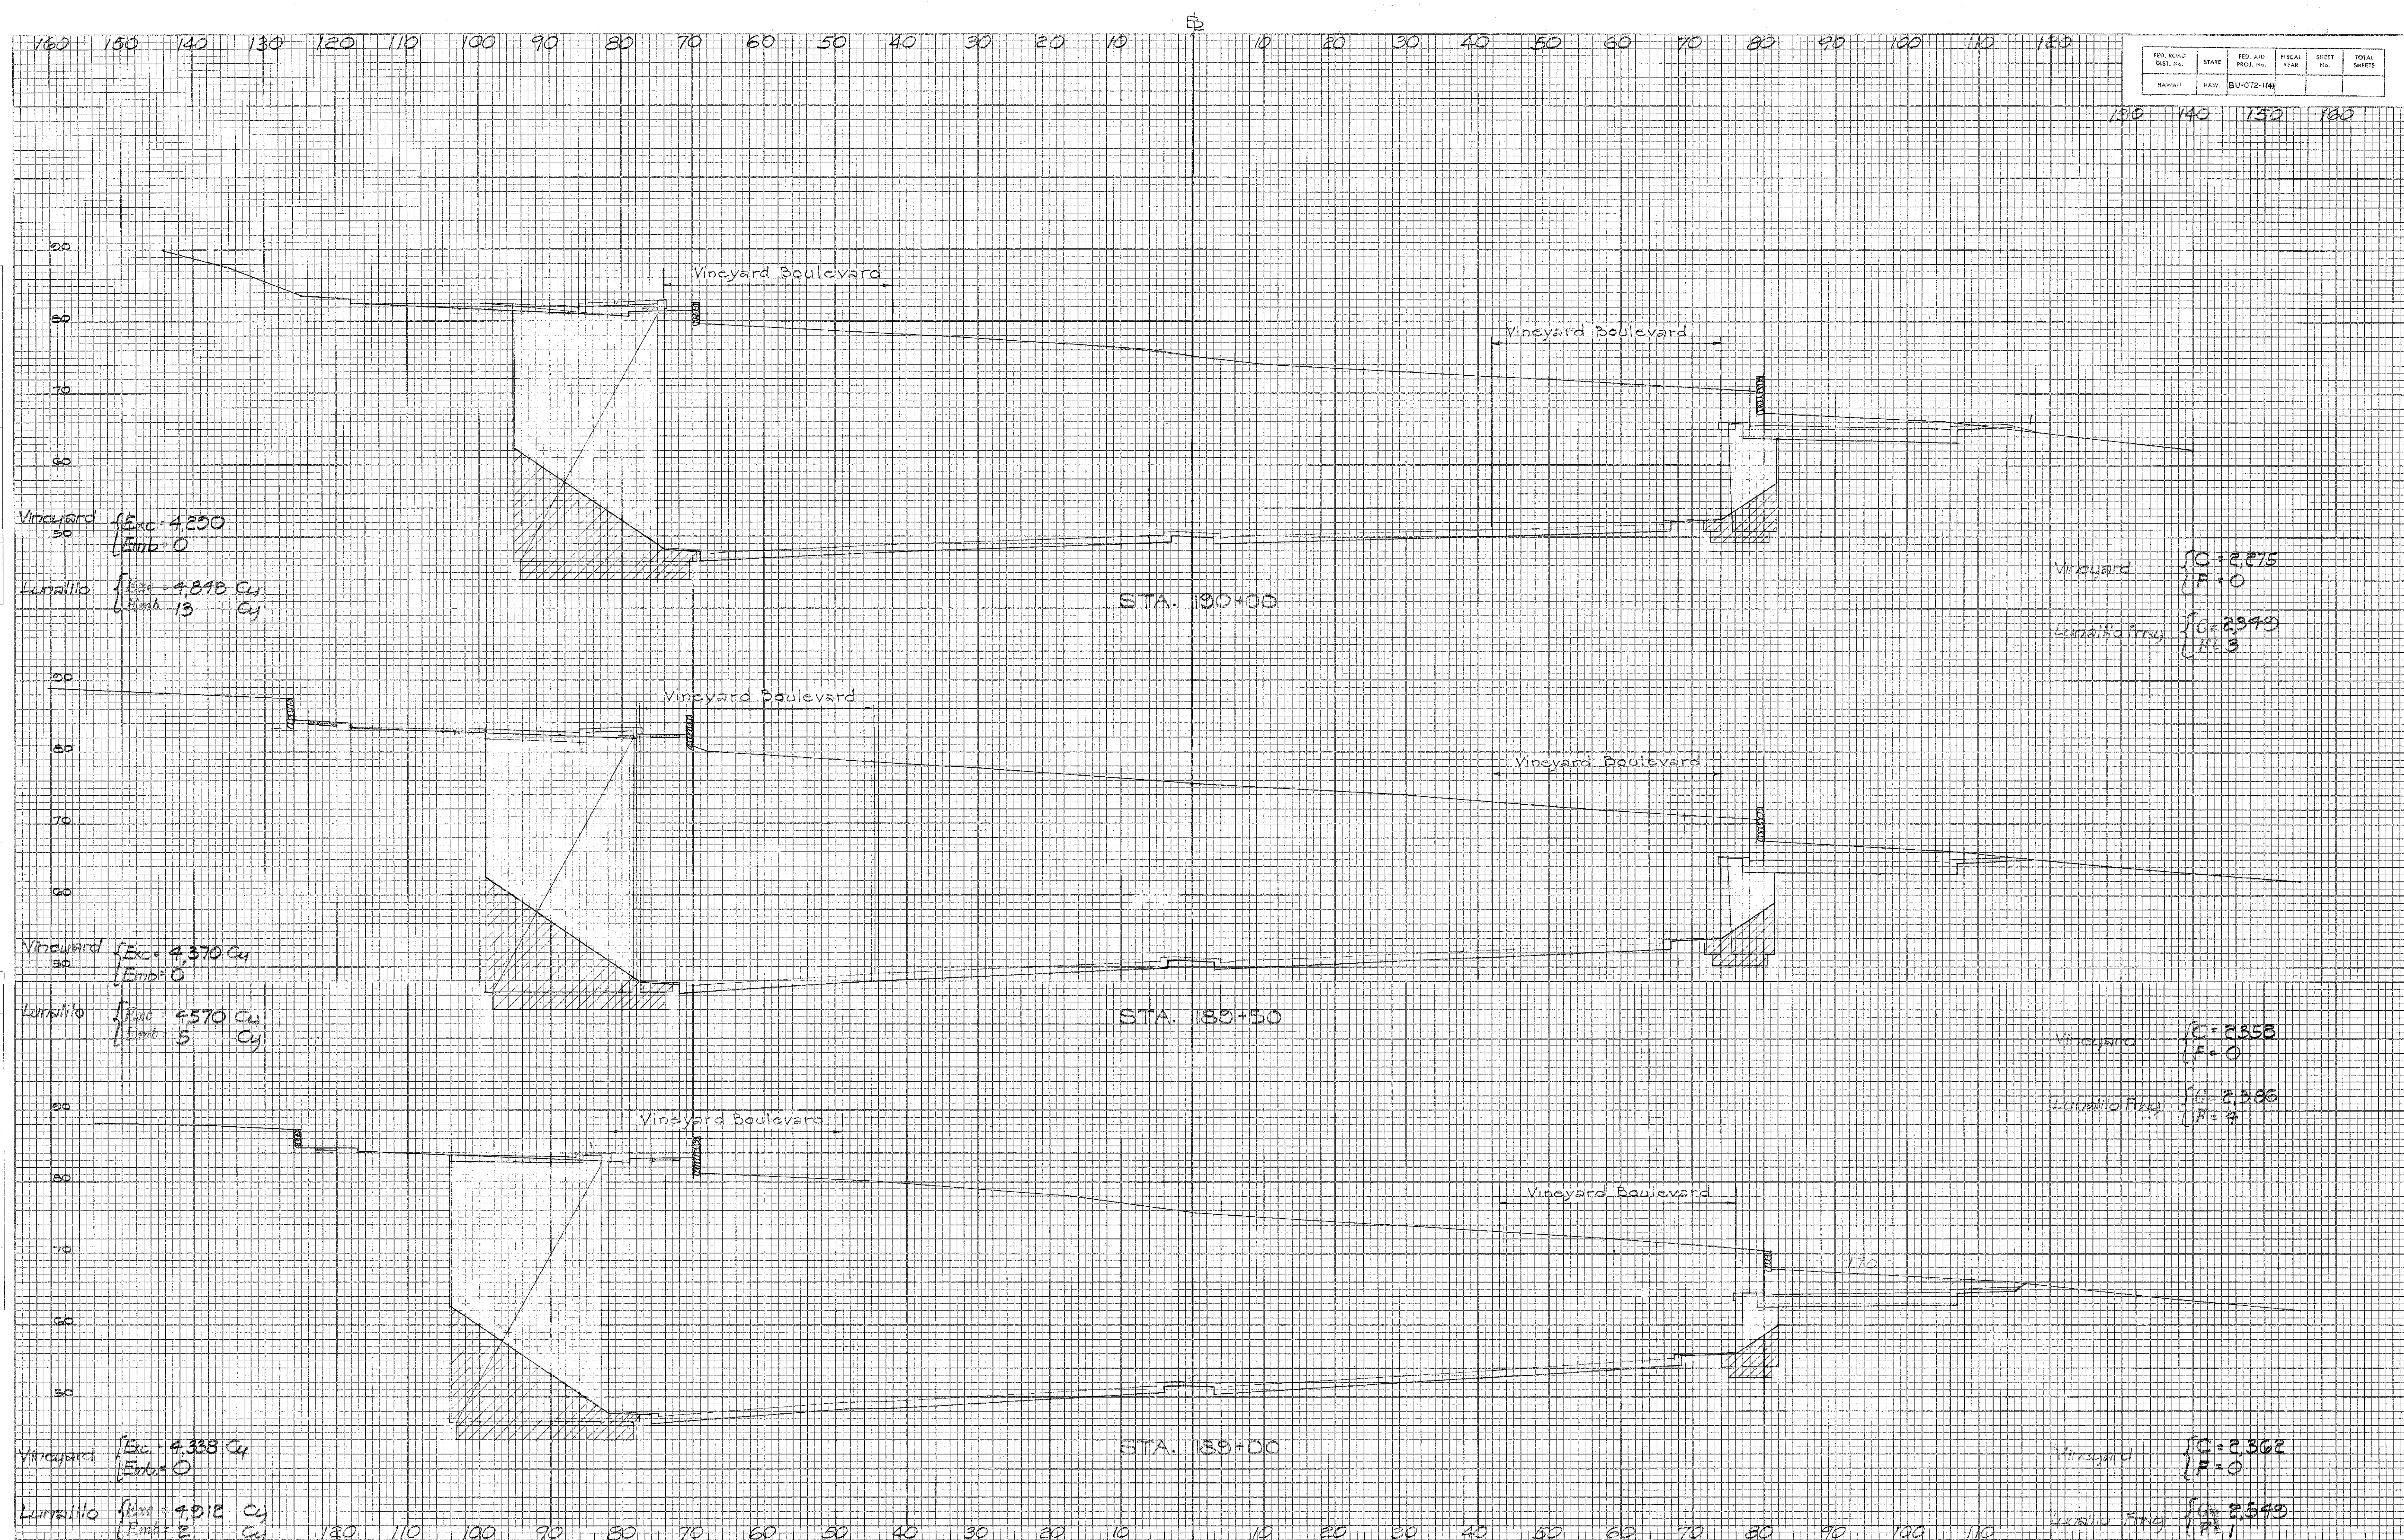


PLATE 3 CROSS SECTION O. P. R. & R. R.
100% RAG PAPER—MADE AND PRINTED IN U. S. A.
CHARLES BRUNING COMPANY

5927

(17)

5928.

(10)

18902 To 190 25

①

DATE	BY	DATE	BY
FINAL SURVEY	SURVEYED	POSTED	DATE
NOTE BOOK	TEMPLATE	AREA	BY
NO.		AREA	CHECKED

DATE	BY	DATE	BY
ORIGINAL SURVEY	SURVEYED	POSTED	DATE
NOTE BOOK	TEMPLATE	AREA	BY
NO.		AREA	CHECKED

FED. ROAD DIST. NO.	STATE	FED. AID PROJ. NO.	FISCAL YEAR	SHEET NO.	TOTAL SHEETS
HAWAII	HAW.	BU-072-16			

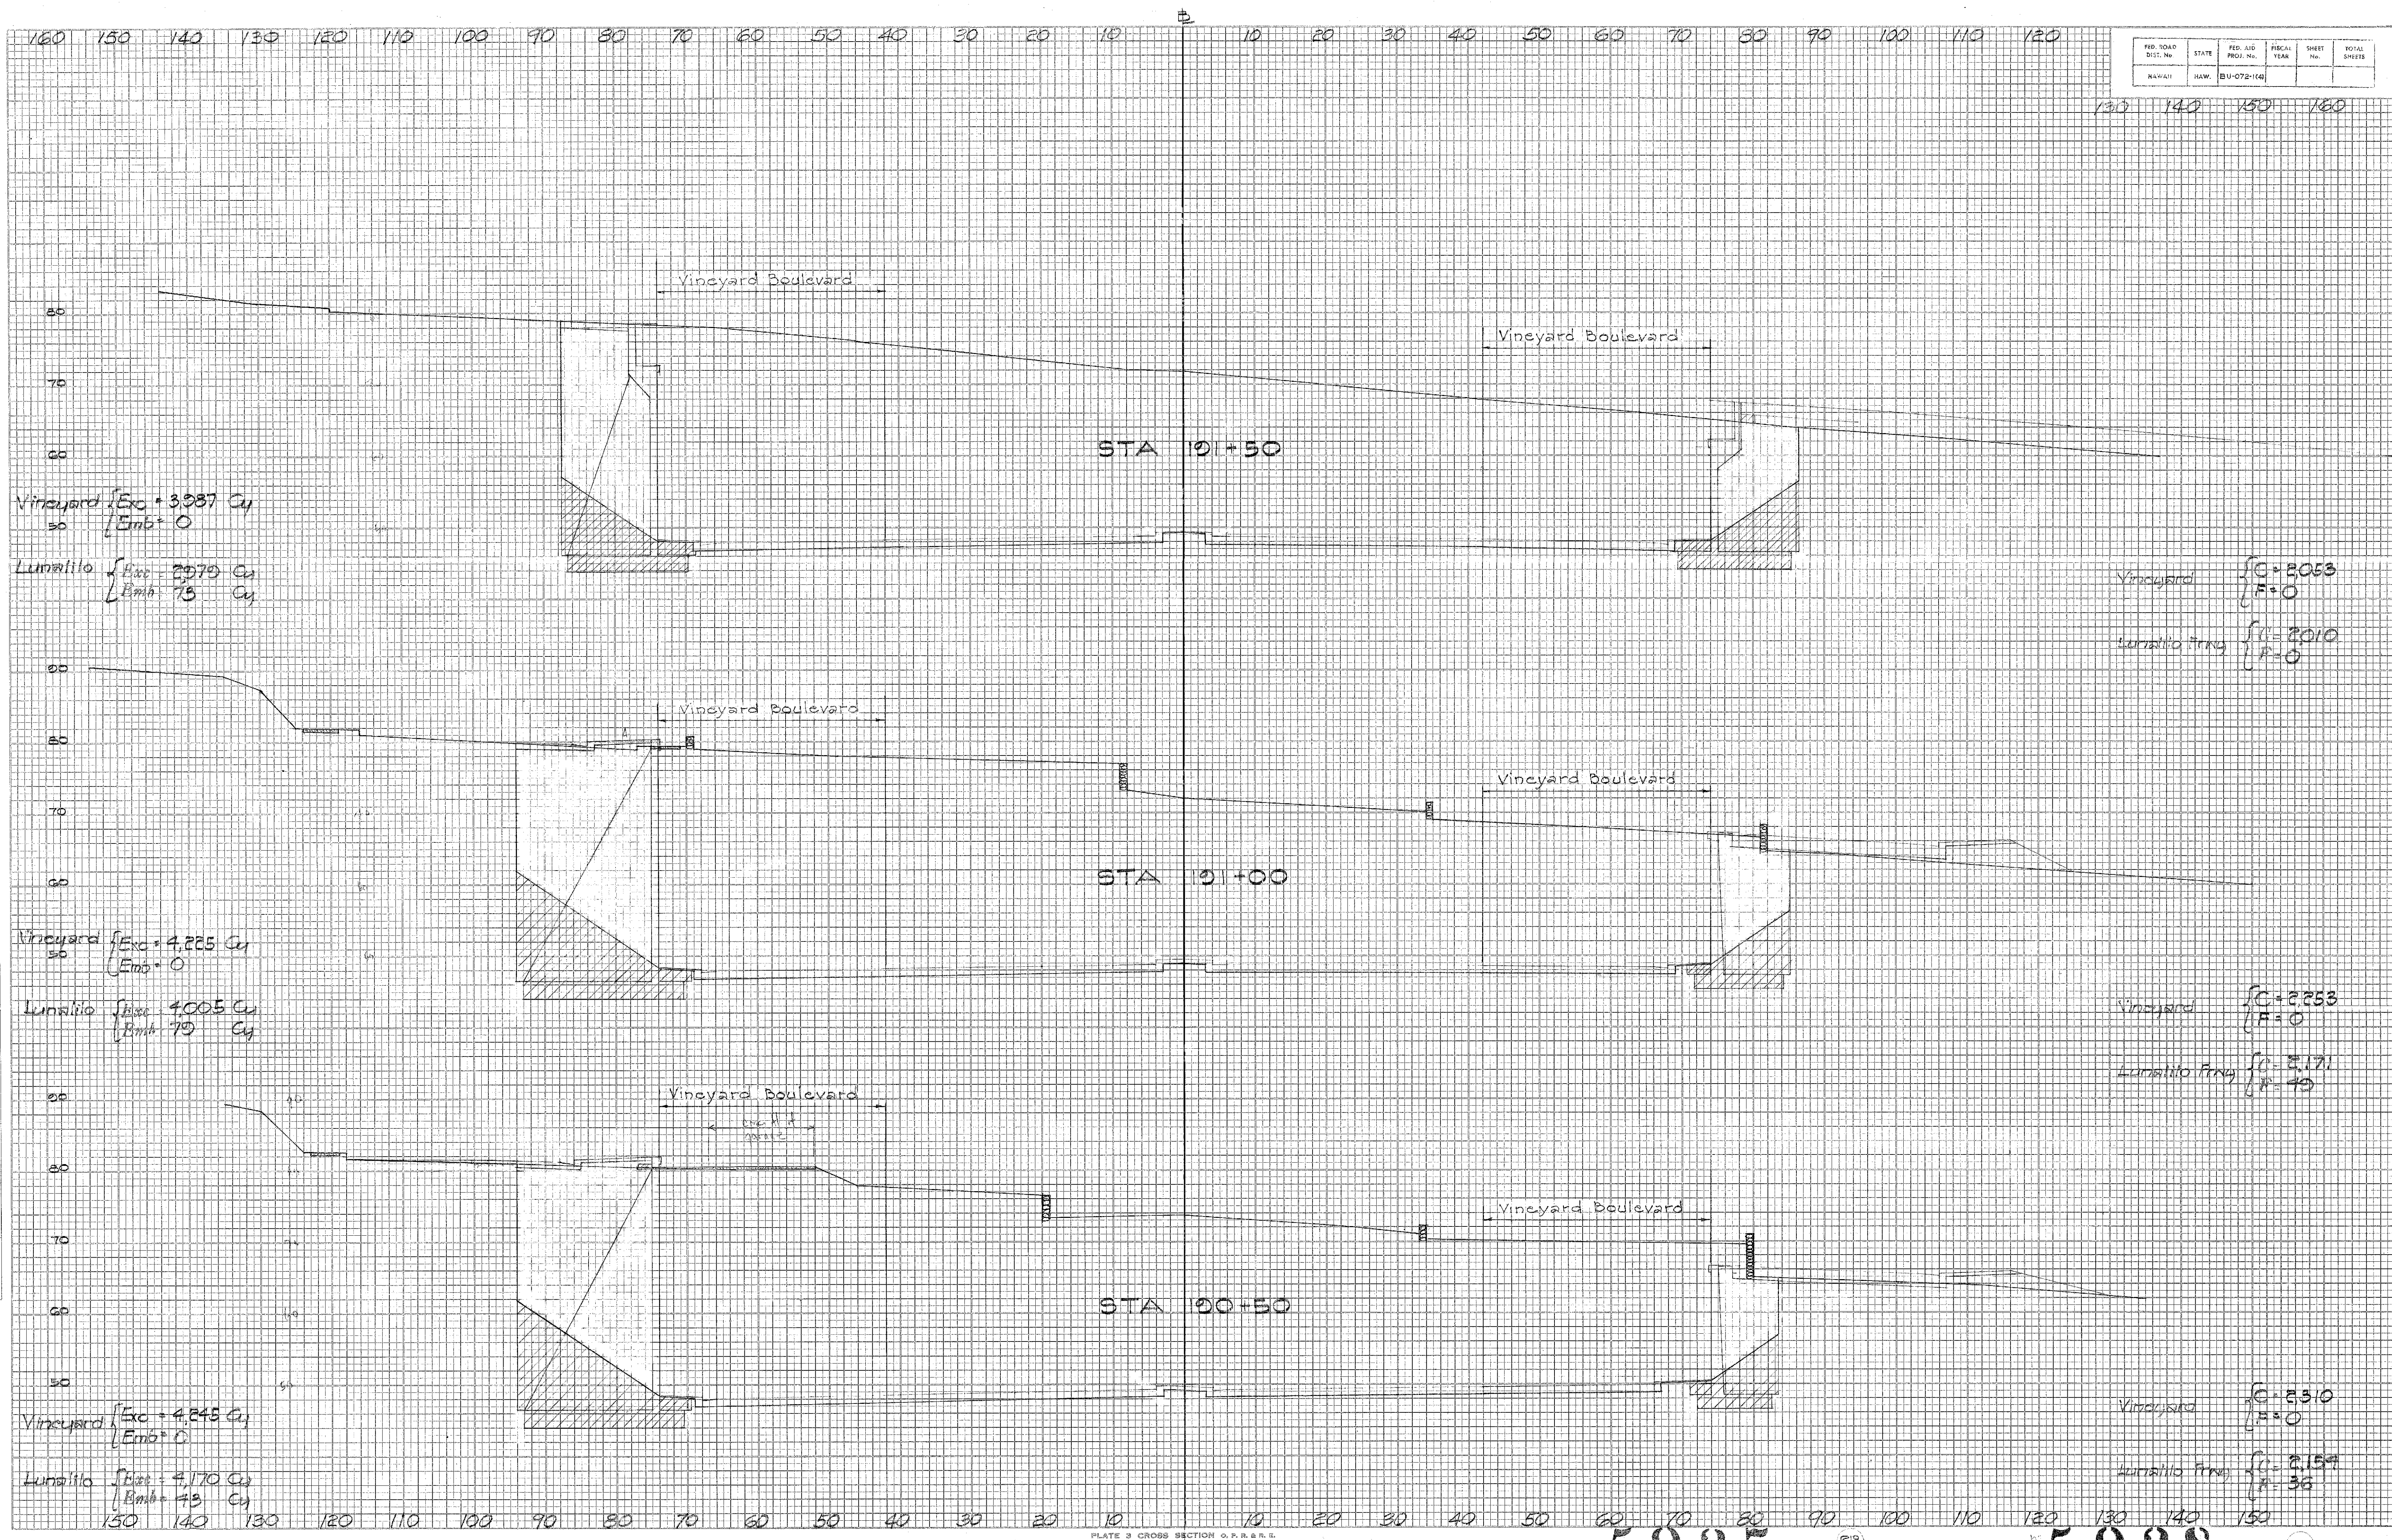


PLATE 3 CROSS SECTION C.D. R.R. & L.
100% RIG. PAPER-MADE AND PRINTED IN U. S. A.
CHARLES BRUNING COMPANY

5927.

5928.

107

108

DATE	BY	NO.
FINAL SURVEY	SURVEYED	PLOTTED
	NOTE BOOK	AREA CHECKED

DATE	BY	NO.
ORIGINAL SURVEY	SURVEYED	PLOTTED
	NOTE BOOK	AREA CHECKED

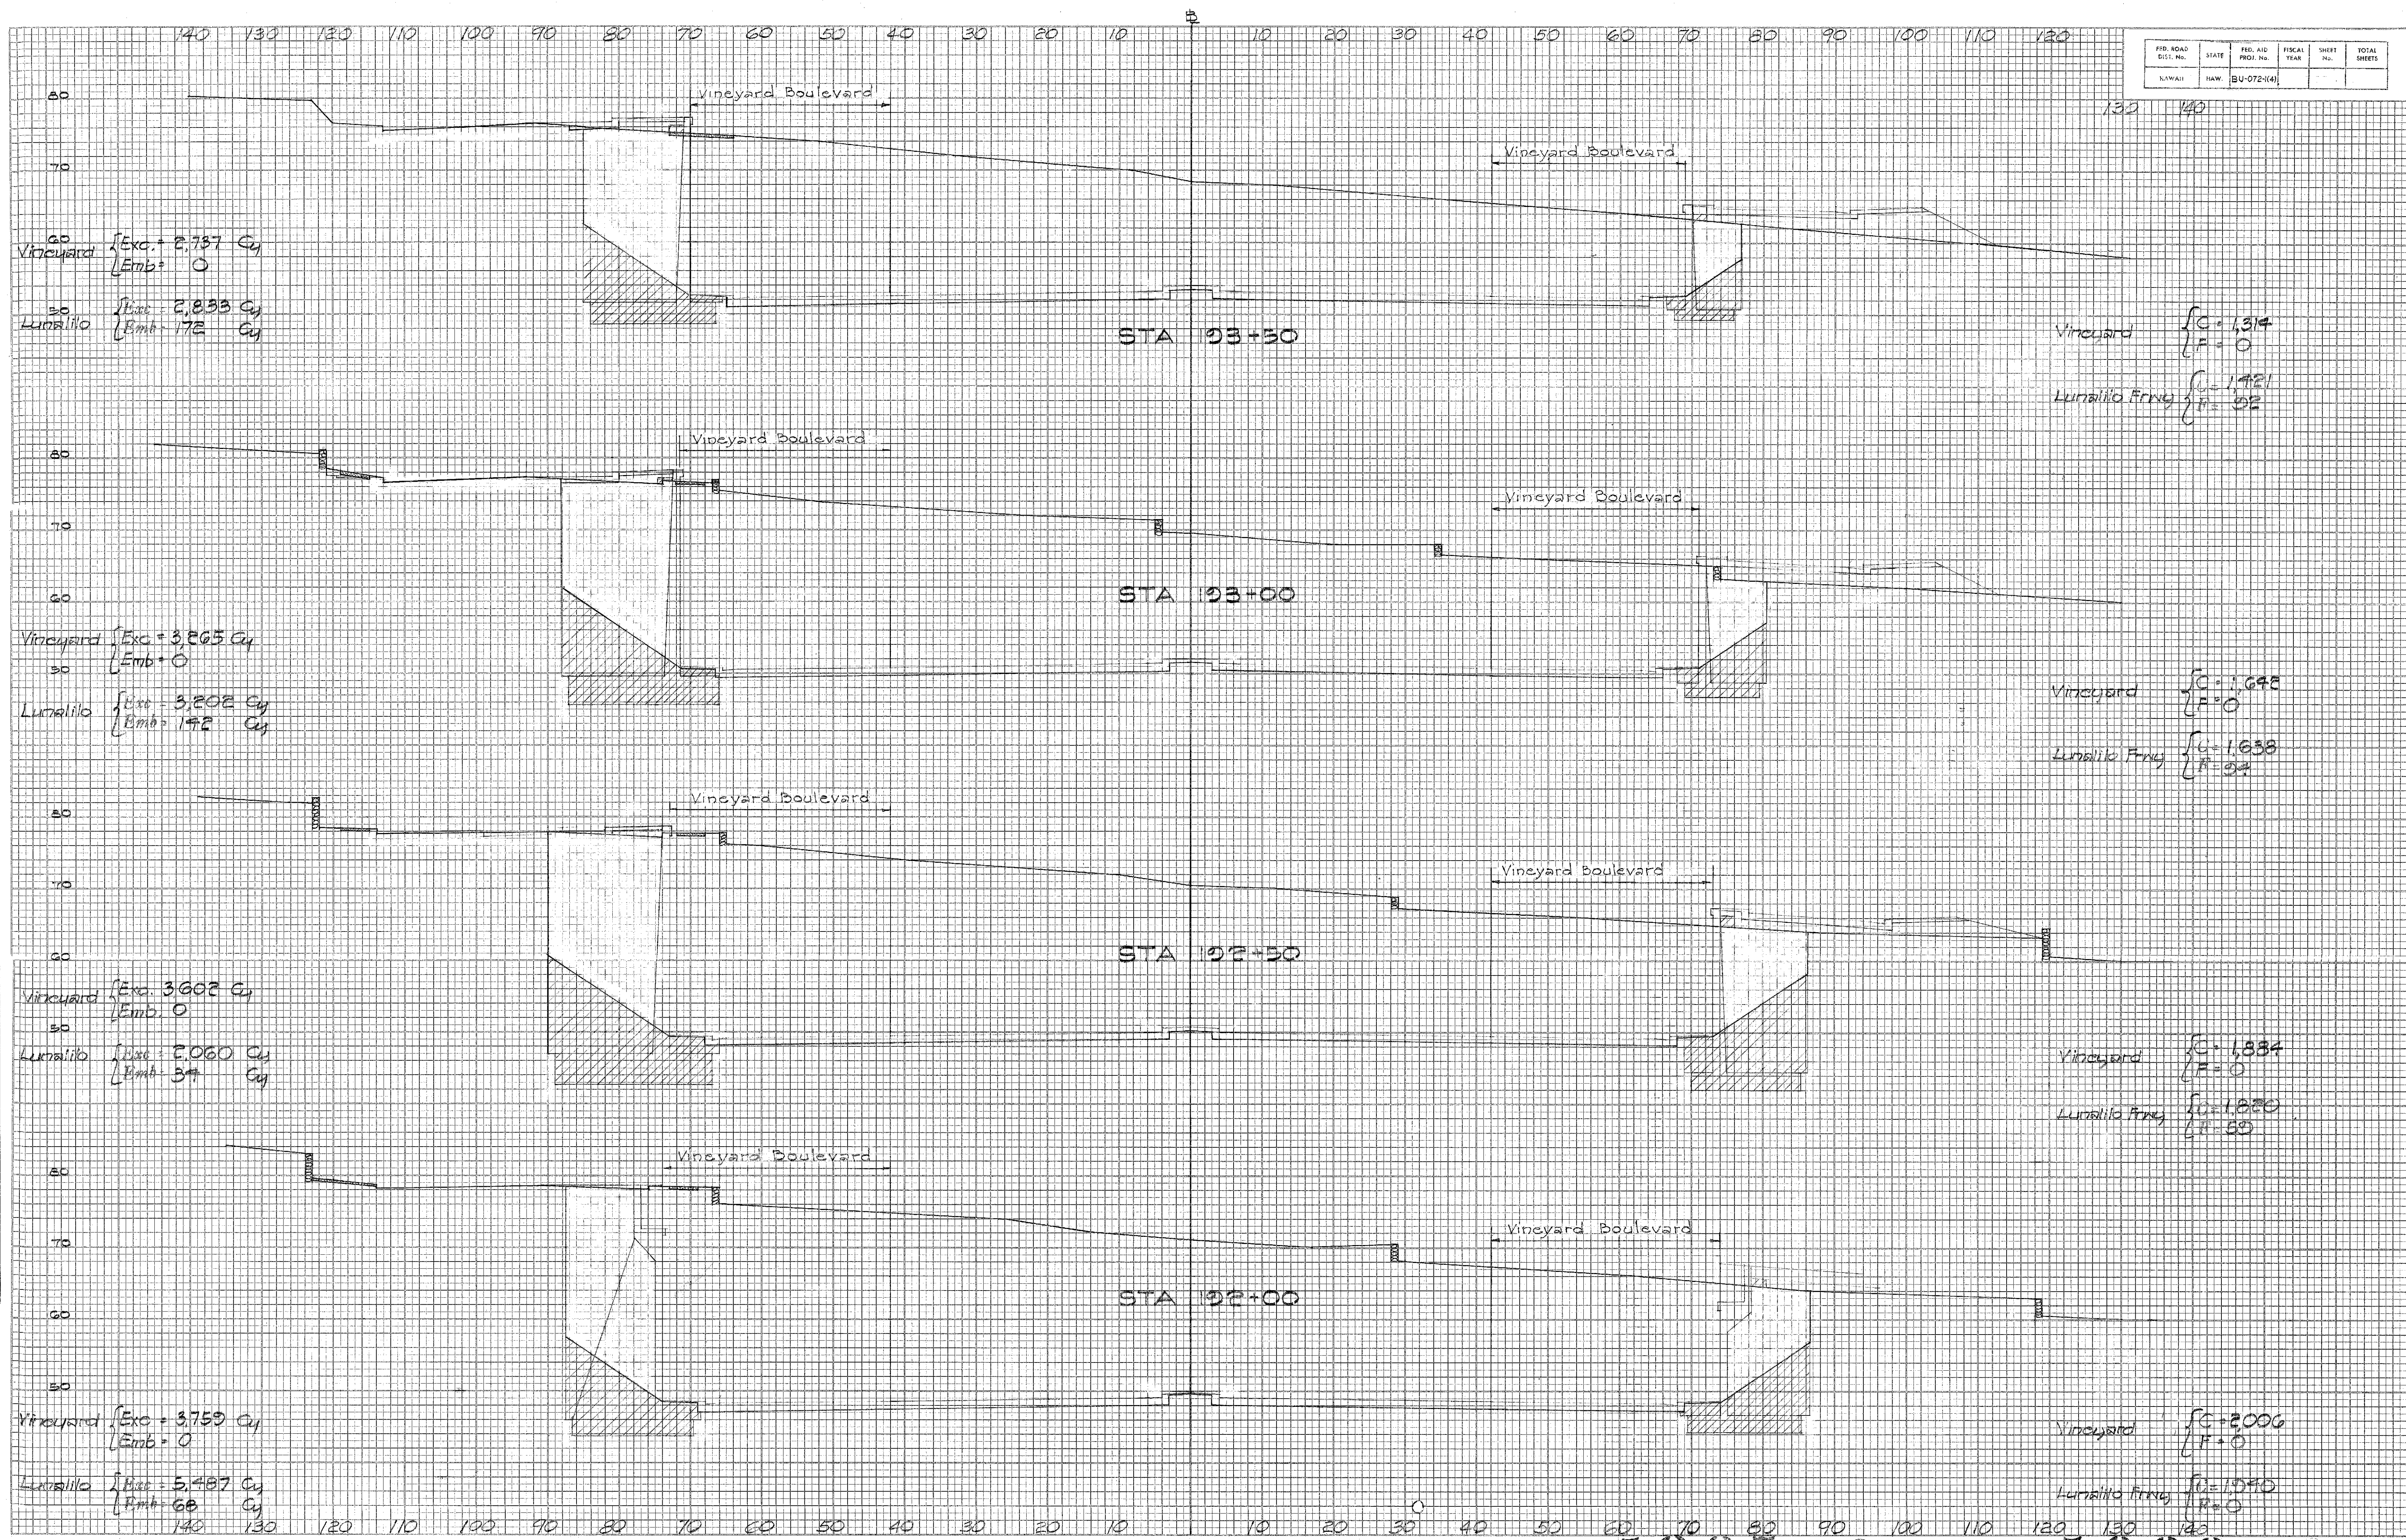


PLATE 3 CROSS SECTION G.P.R.R.E.
 1967 MAP PART-1000 AND PART-1001
 CHARLES BRUNING COMPANY

5927.

5928.

192.22 to 193.22

DATE _____ BY _____
 SURVEYED _____
 TSP/PLATE _____
 NO. _____
 AREA CHECKED _____

DATE _____ BY _____
 SURVEYED _____
 TSP/PLATE _____
 NO. _____
 AREA CHECKED _____

FED. ROAD DIST. NO.	STATE	FED. AID PROJ. NO.	FISCAL YEAR	SHEET NO.	TOTAL SHEETS
	HAWAII	KAN	BU-072-1(4)		

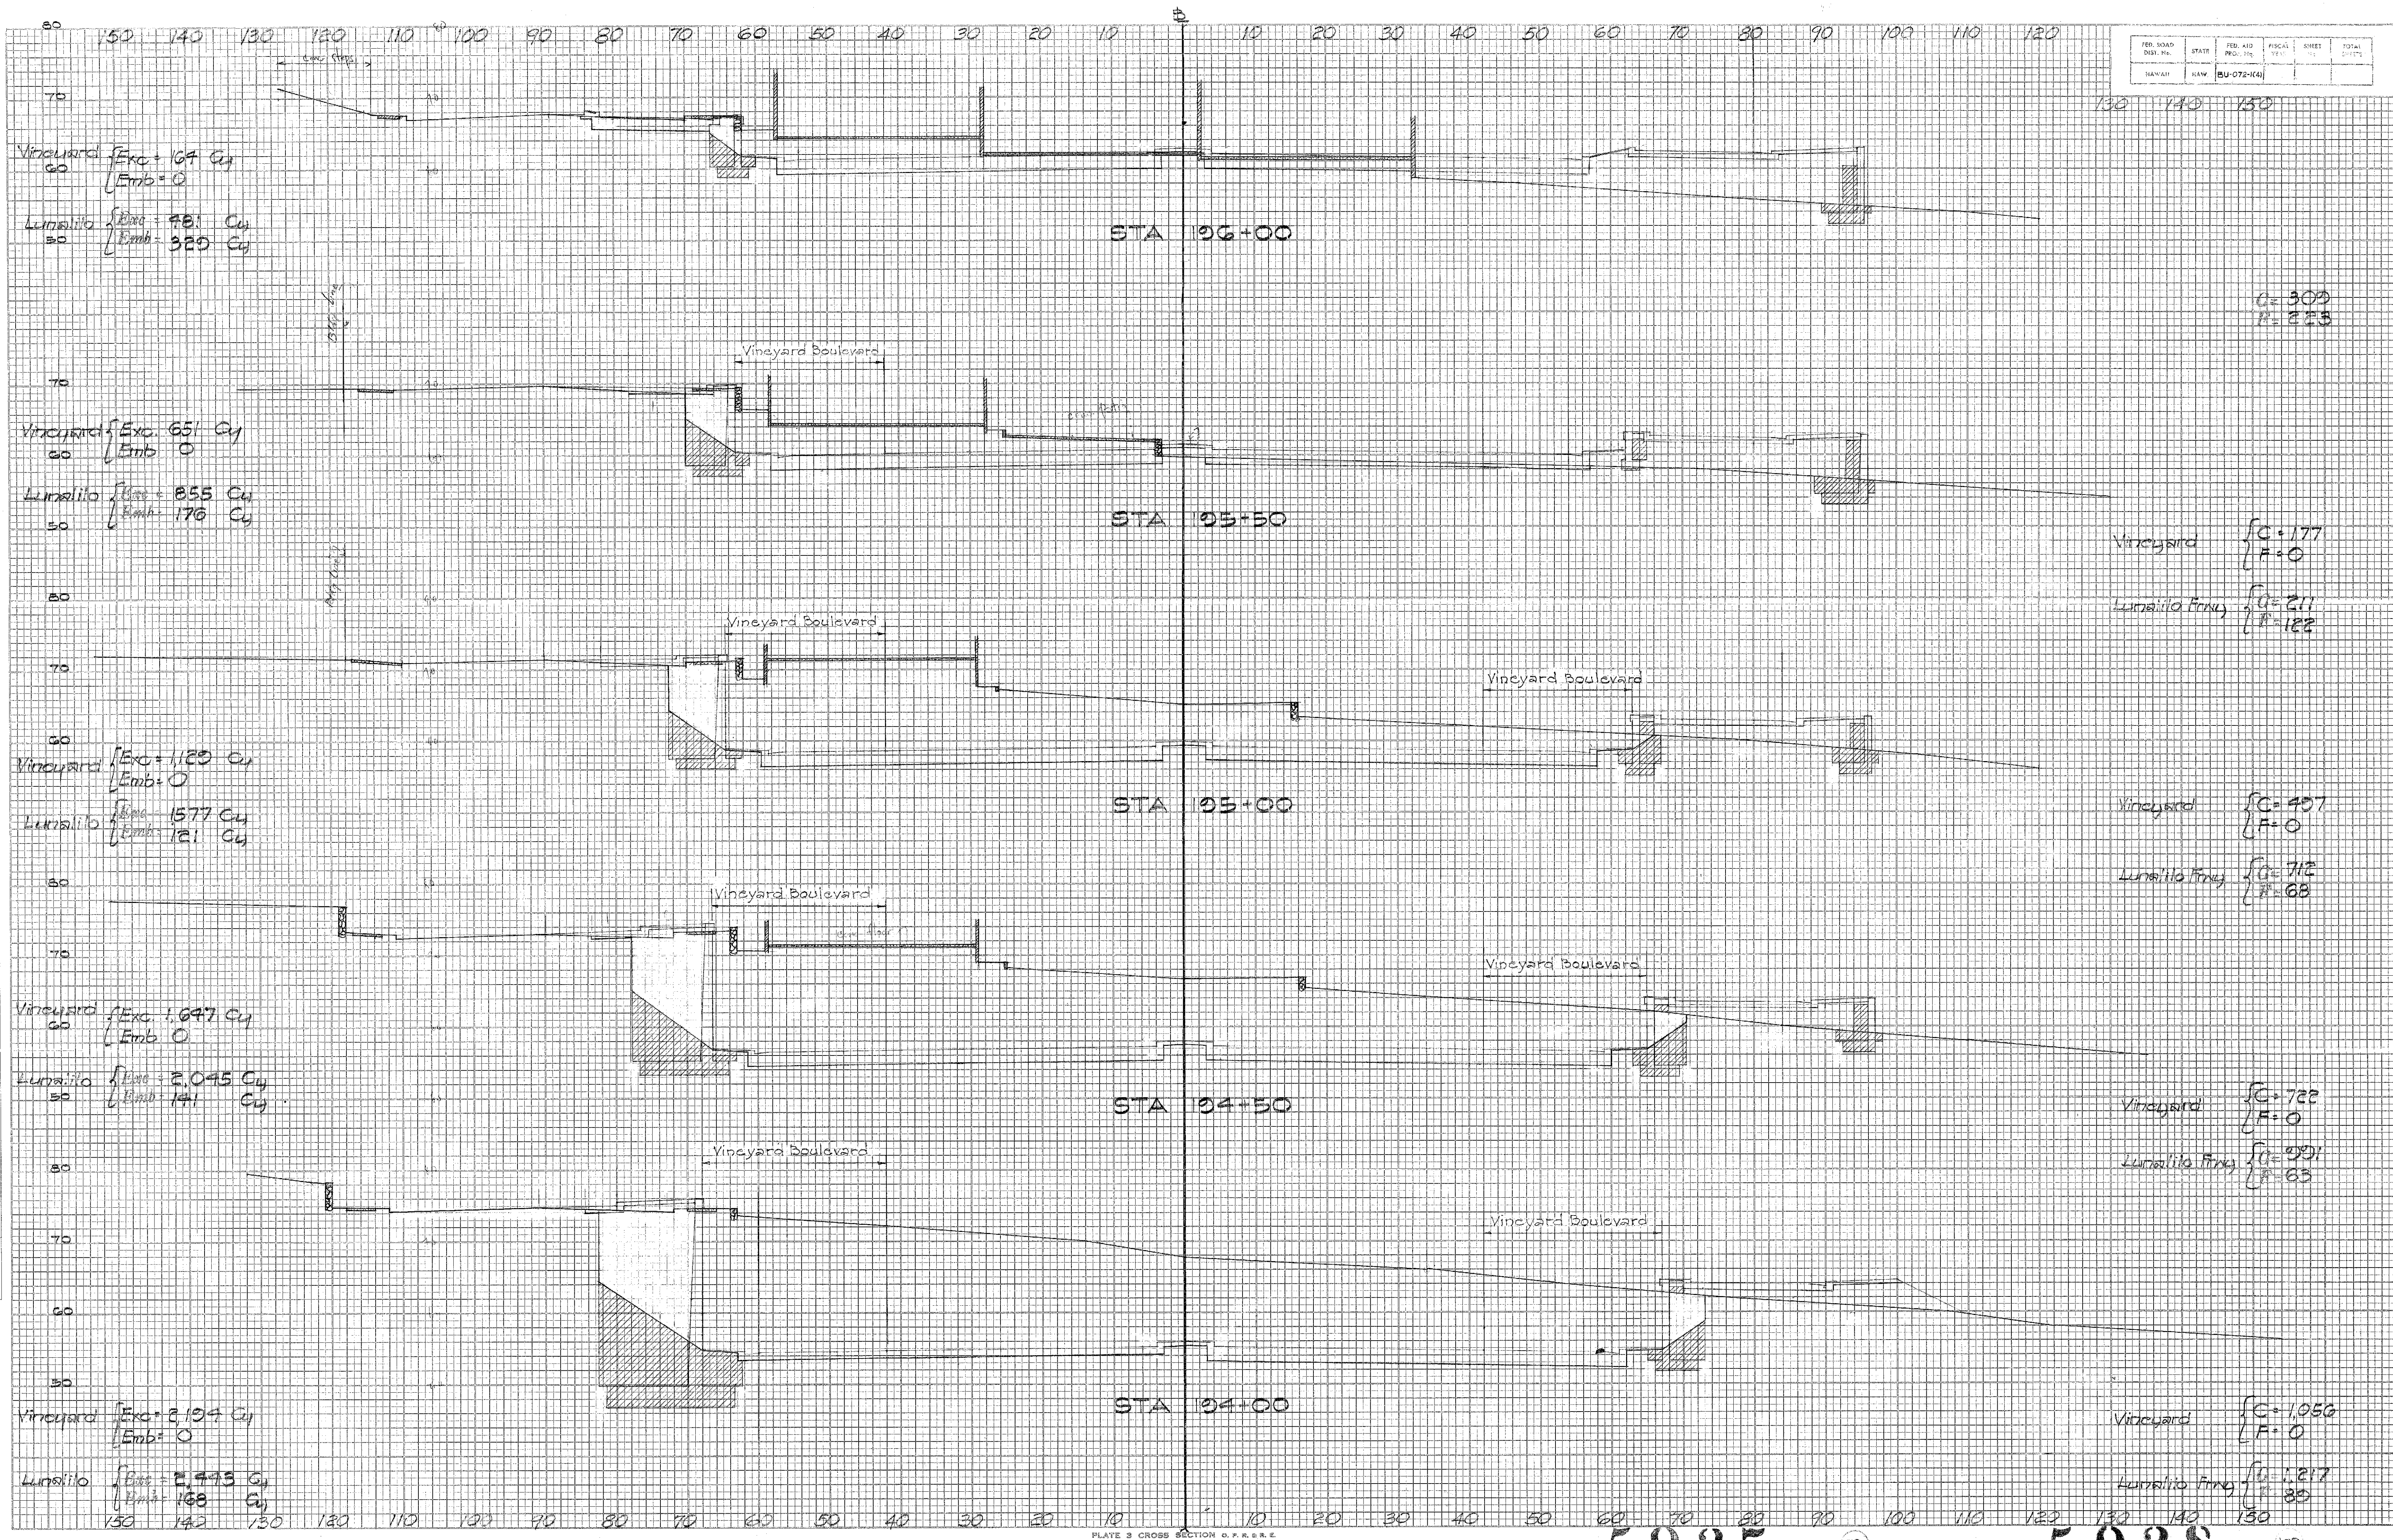


PLATE 3 CROSS SECTION C.P.R.R.E.
 100% RAS PAPER-MADE AND PRINTED IN U.S.A.
 CHARLES GRUNING COMPANY

5927.

5928.

11+28 TO 11+60