

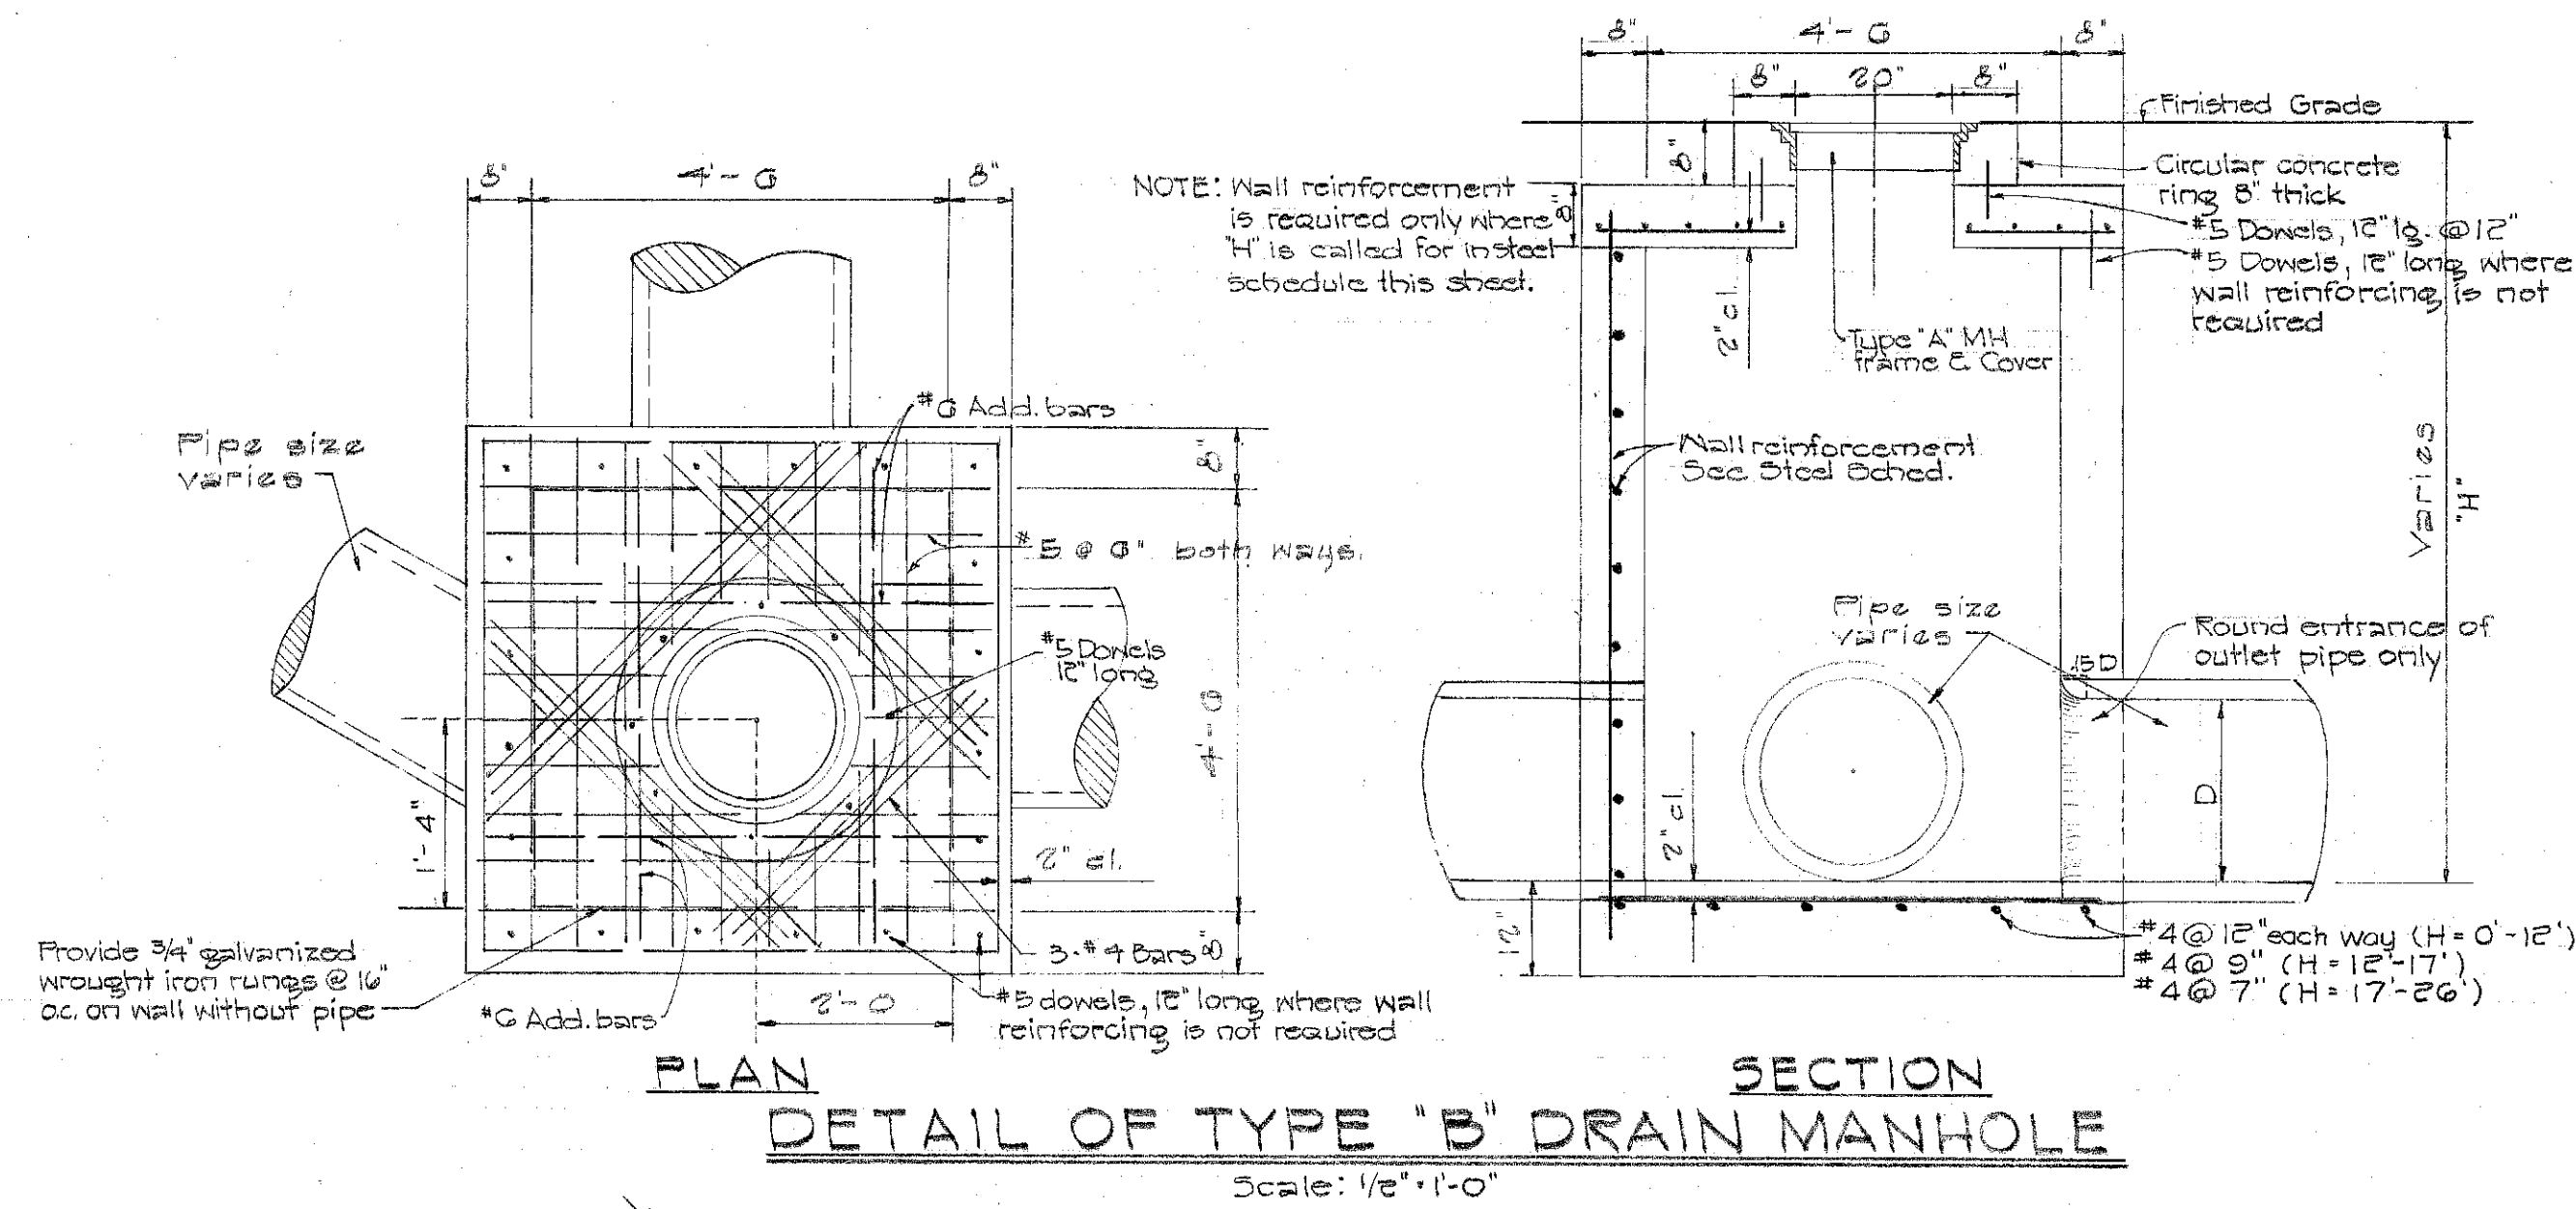
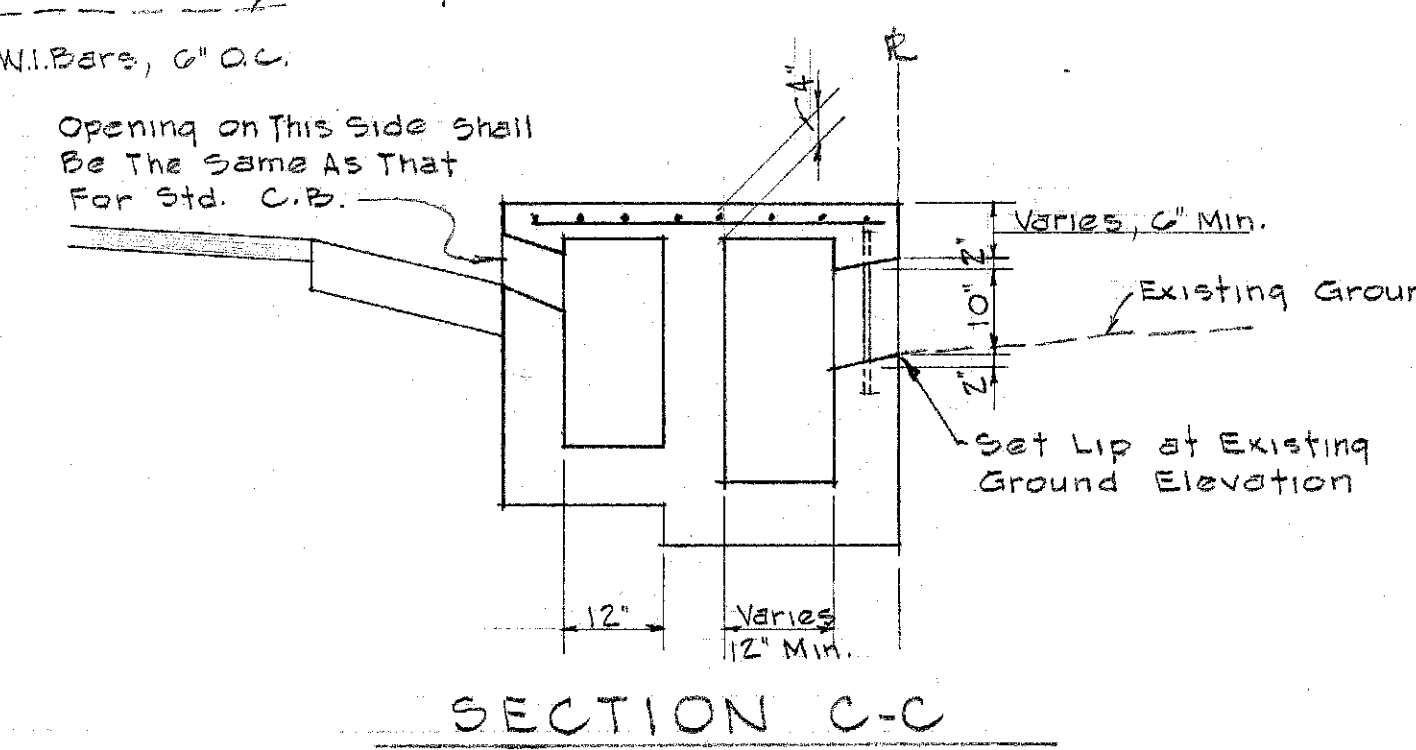
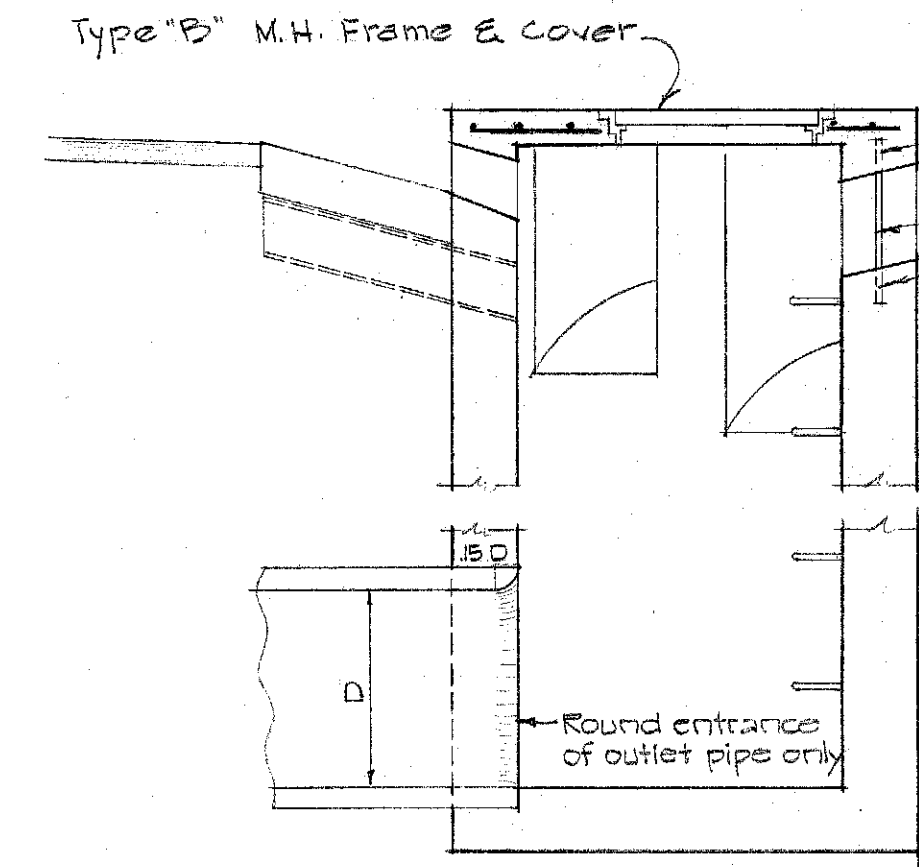
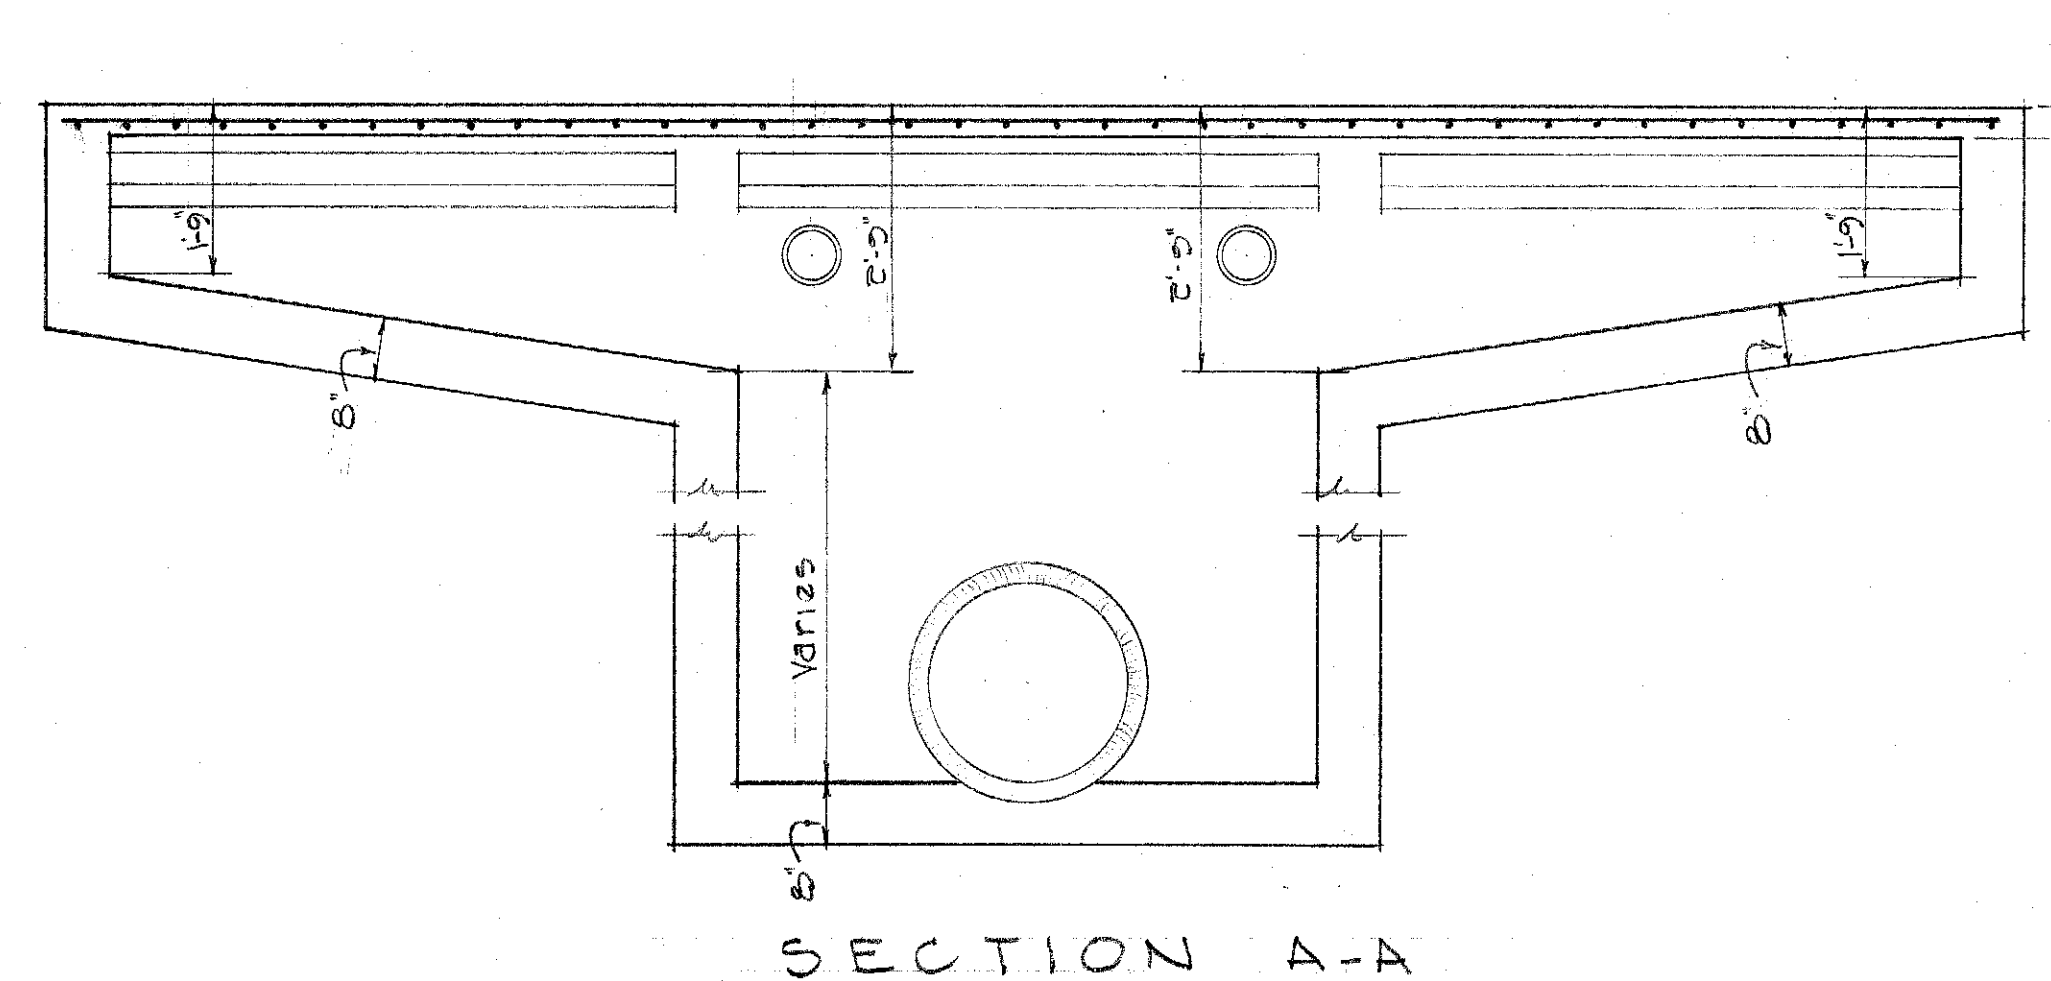
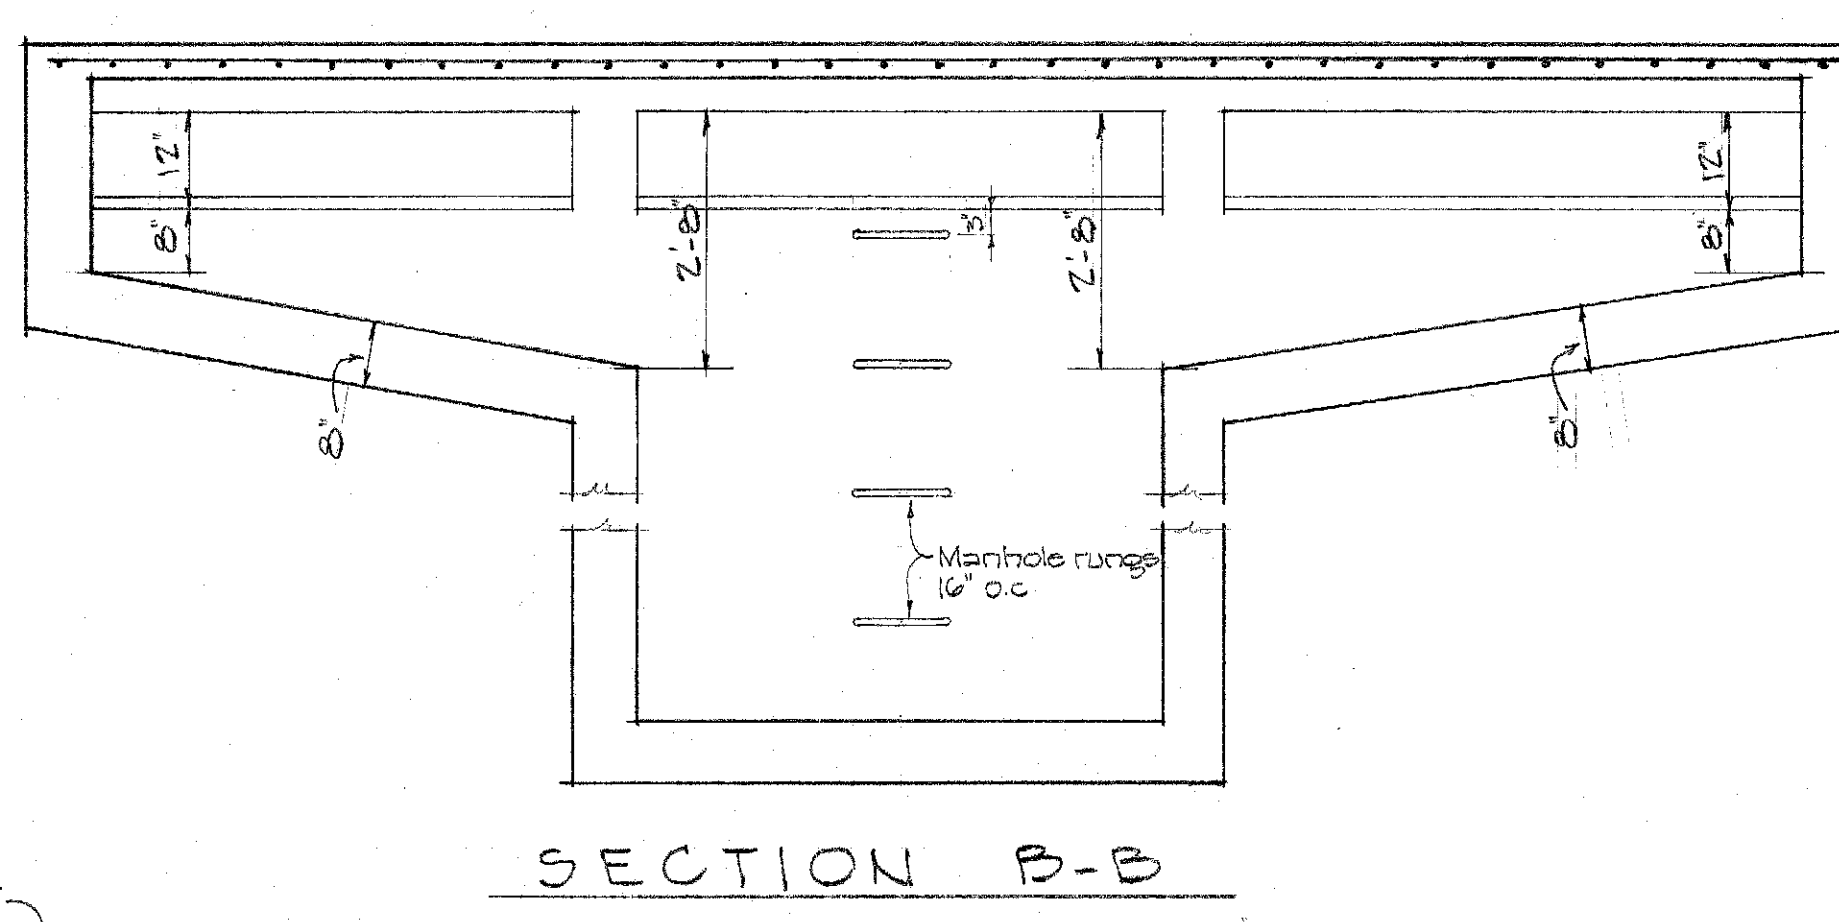


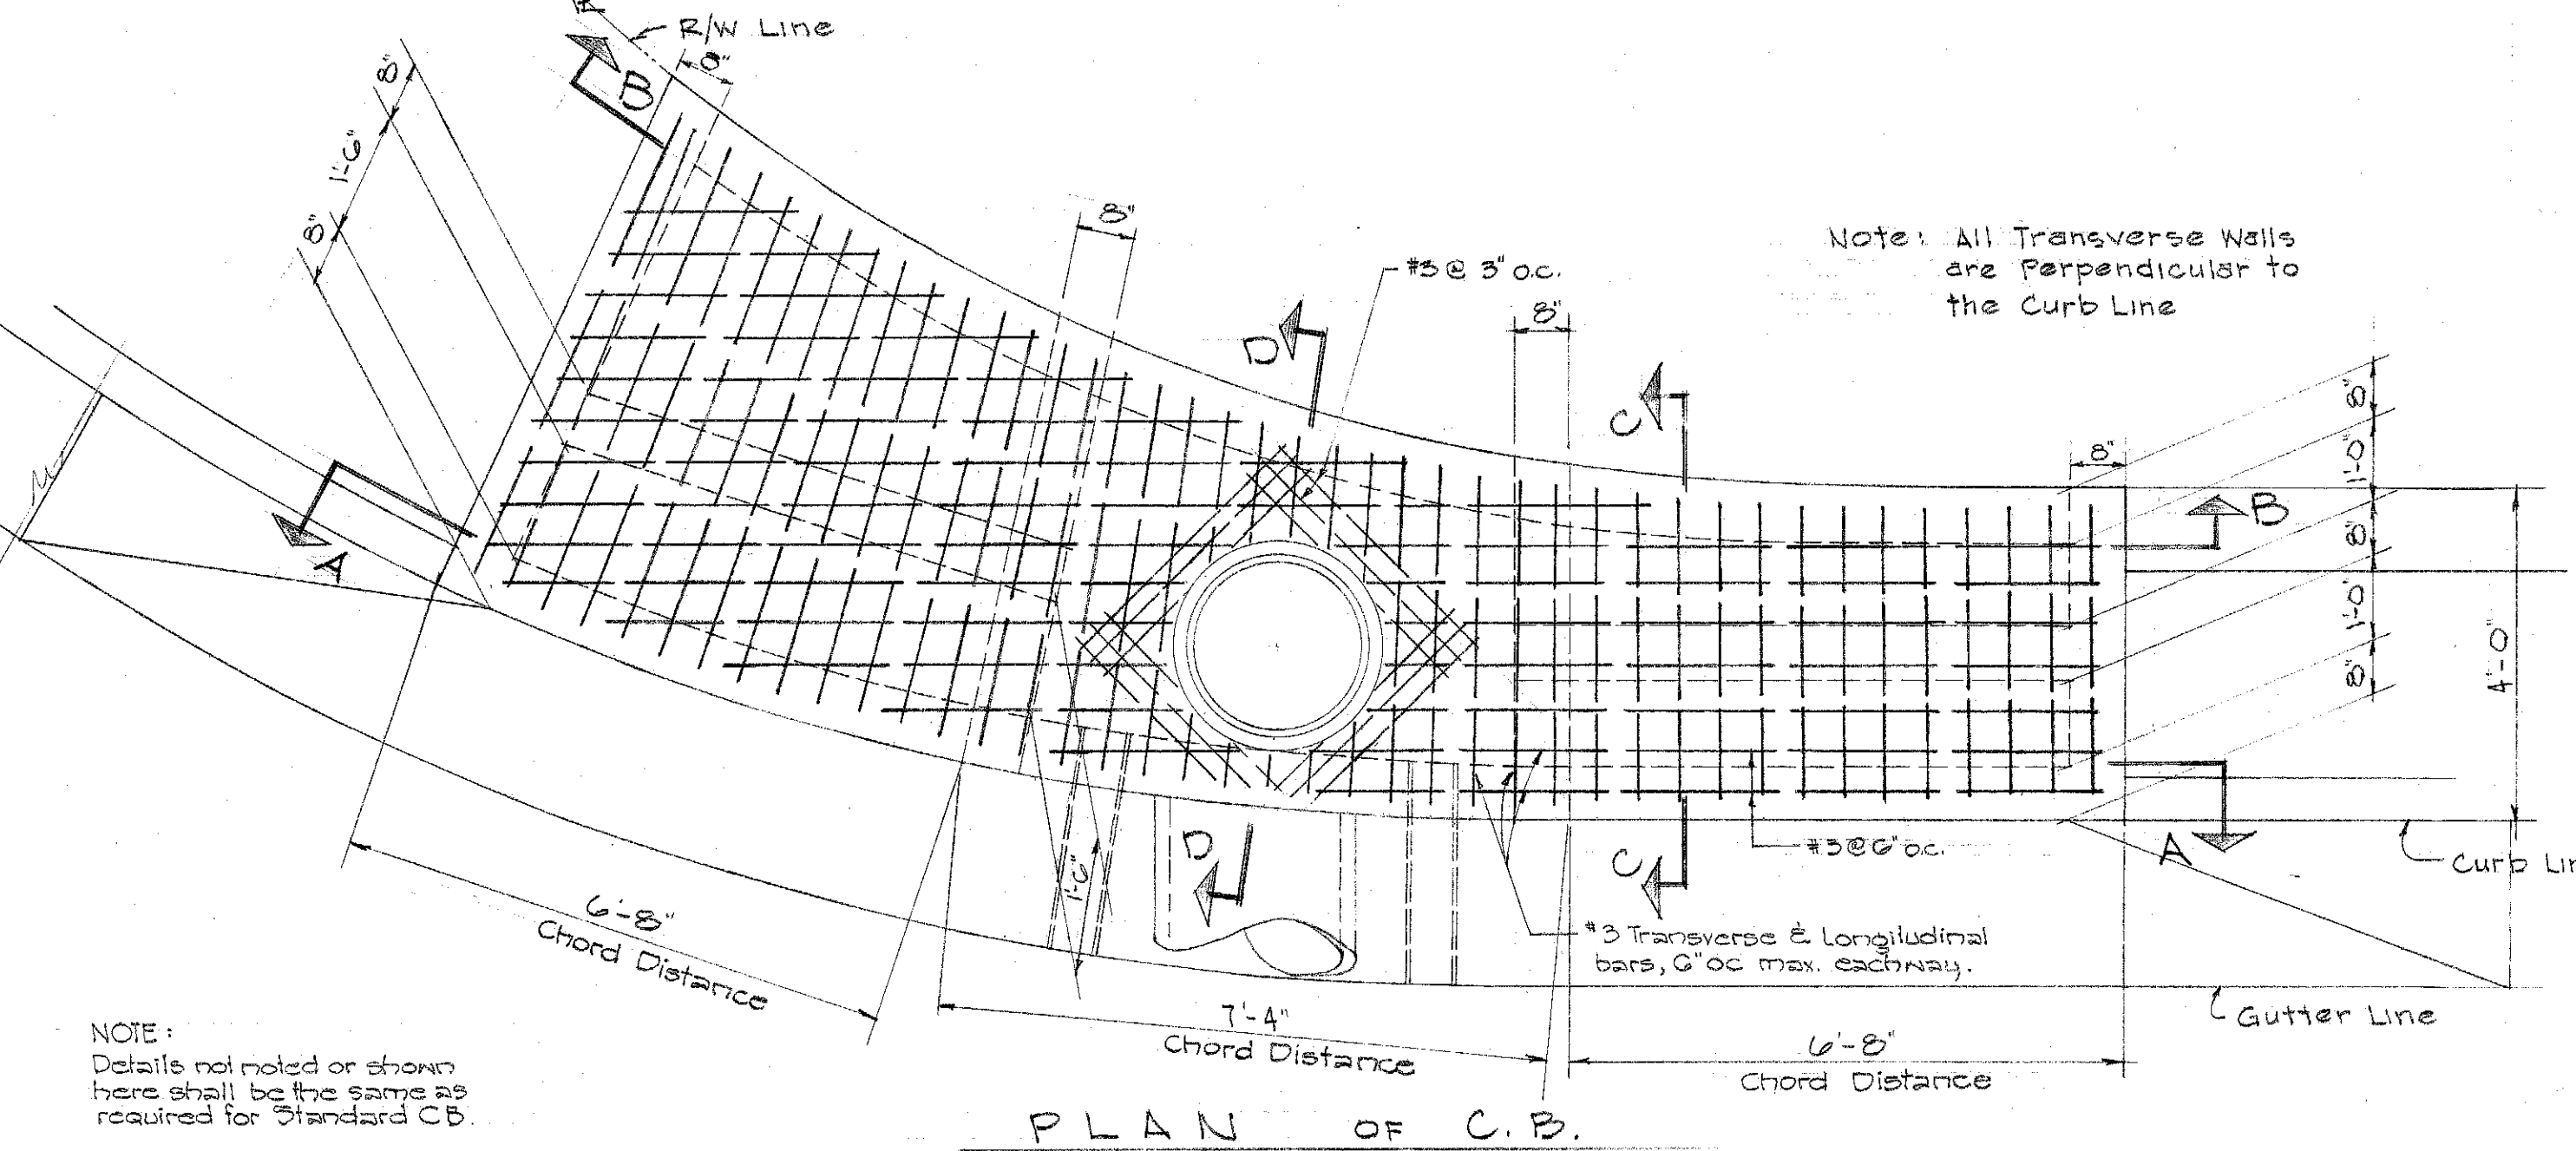

STEEL SCHEDULE			
"H"	Horiz. Steel	Vert. Steel	Notes
0'-0"	None	None	
0'-12"	#4 @ 12"	#4 @ 12"	
12'-17"	#4 @ 12"	#4 @ 12"	
17'-22"	#4 @ 12"	#4 @ 12"	
22'-26"	#4 @ 12"	#4 @ 12"	

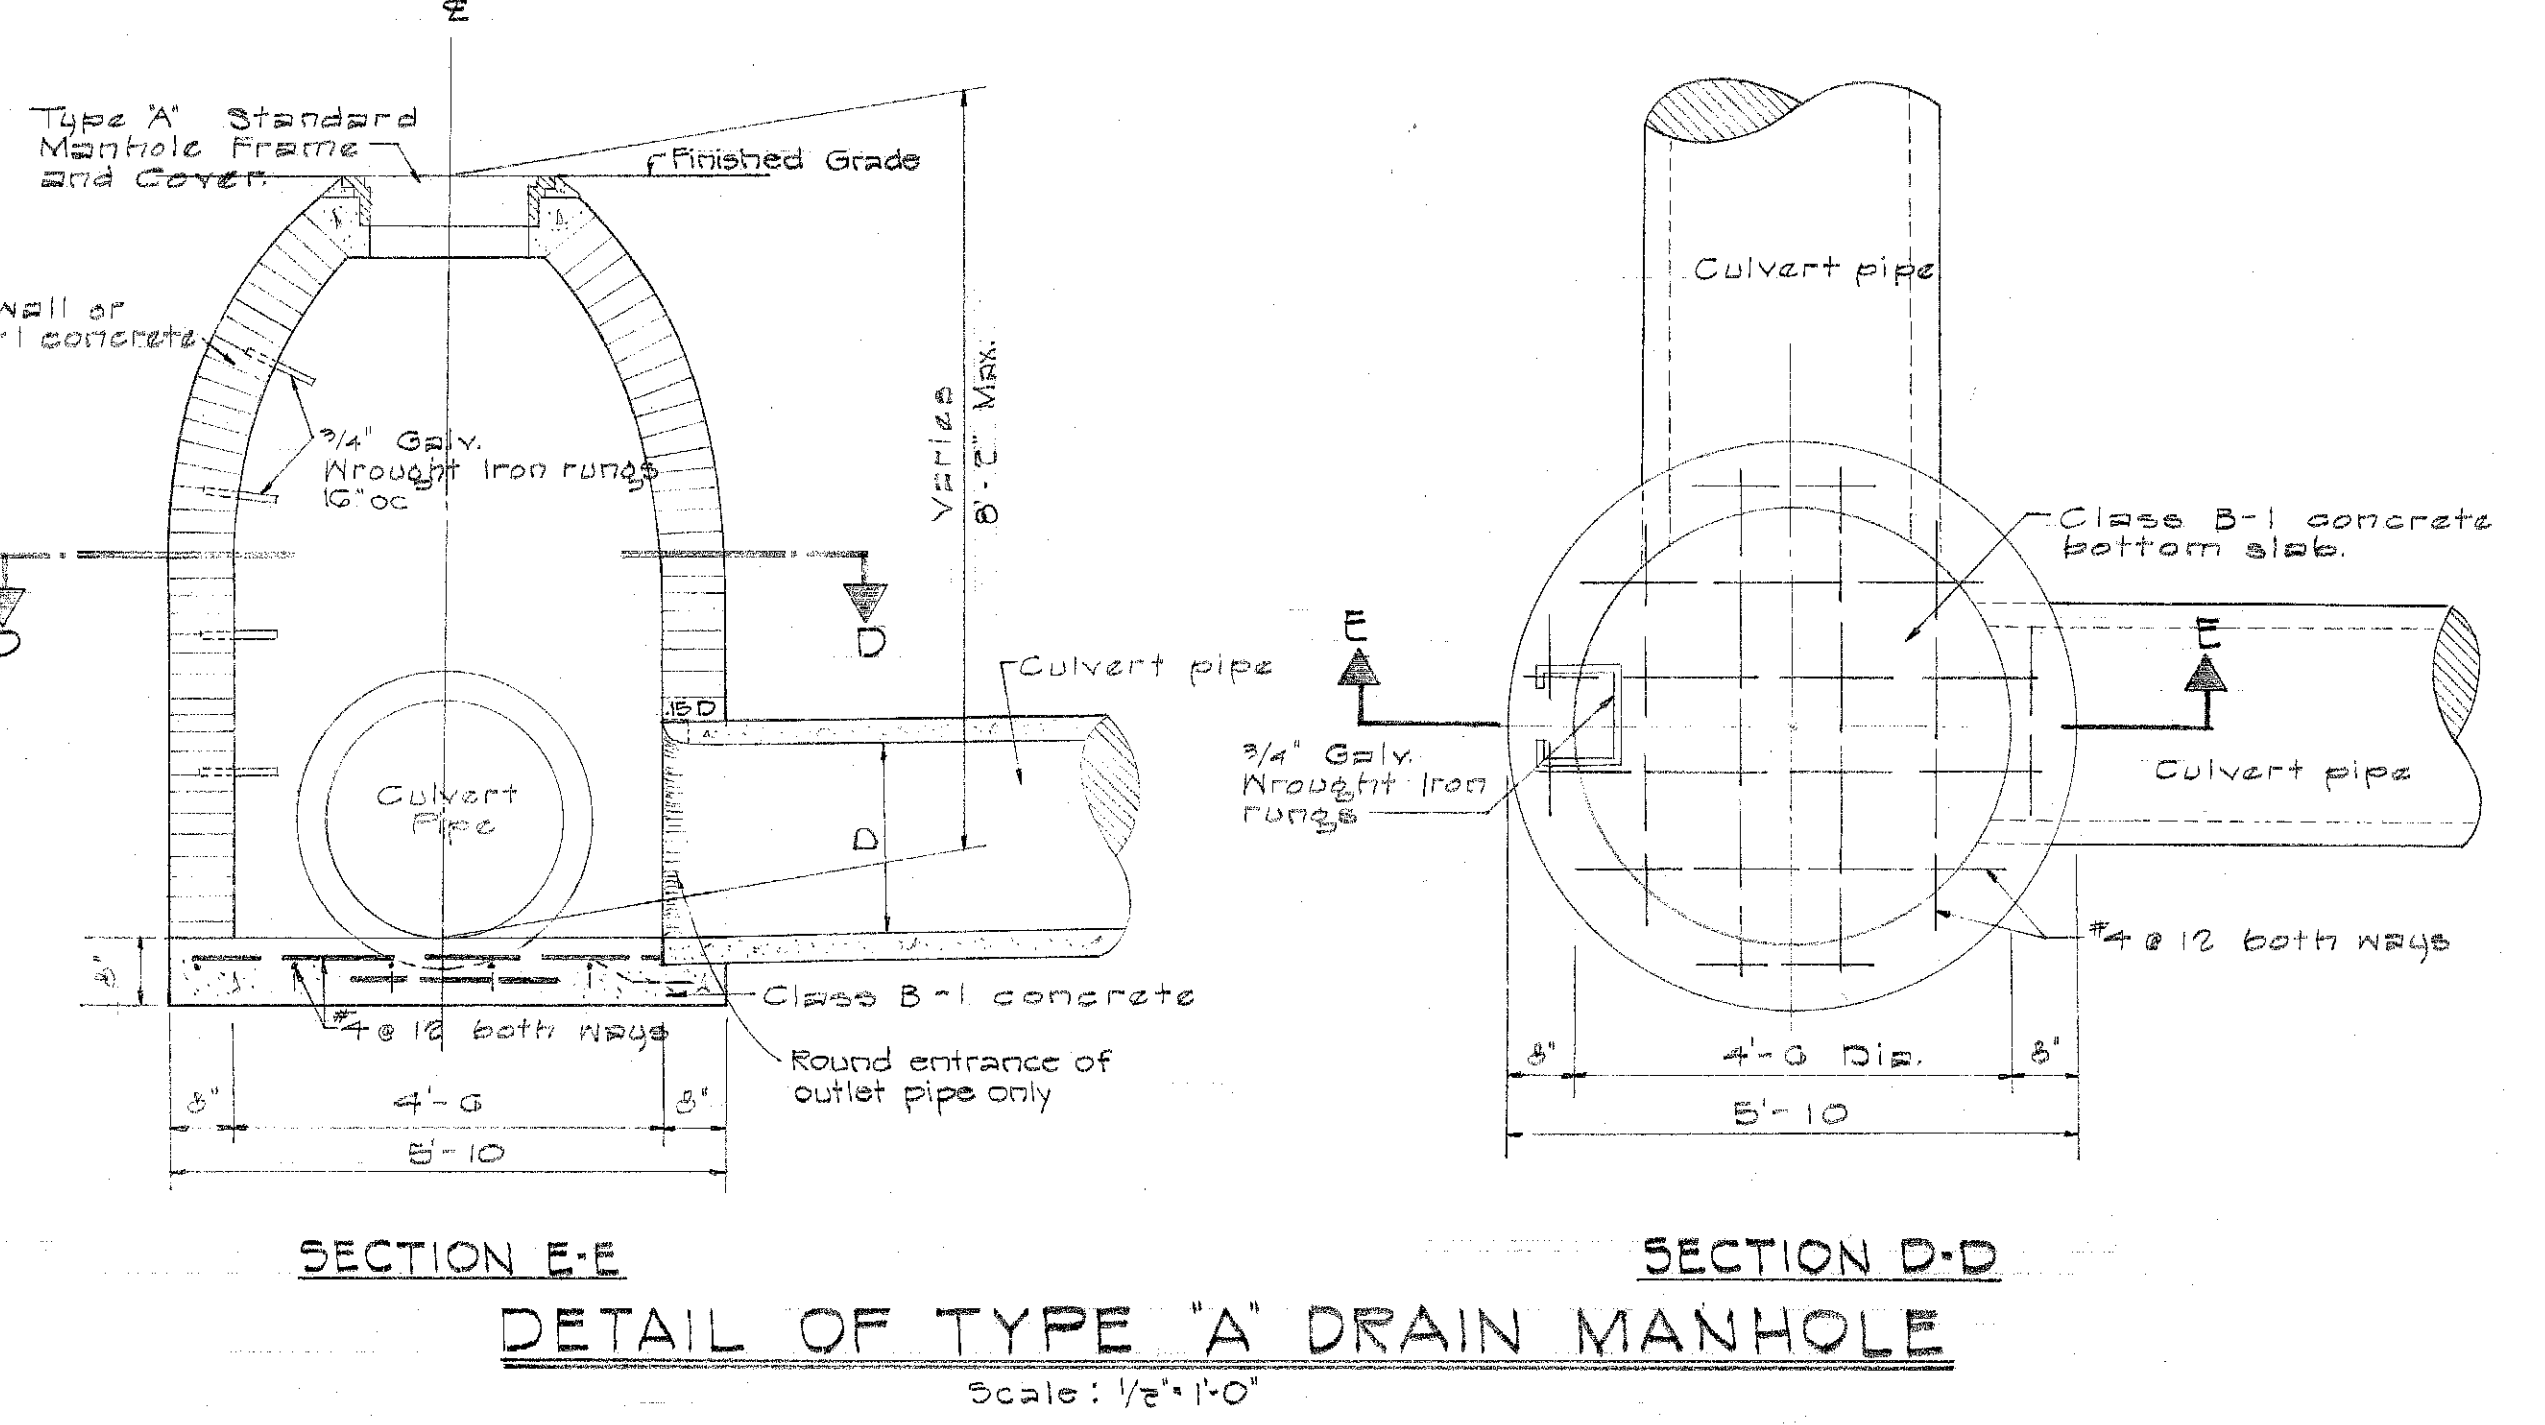

DETAIL OF C.B. No's 71-D & 66-D
SCALE: 1/2" = 1'-0"

APPROVED: *S. Kashiwagi* 12/24/58
STRUCTURAL ENGINEER
Reg. Eng. Cert. No. 568
DATE

TERRITORIAL HIGHWAY DEPARTMENT
TERRITORY OF HAWAII
DRAINAGE DETAILS
LUNALILO FREEWAY
PELE ST. TO KEEAUMOKU ST.
PROJECT NO. 100-000000-1(4)
VINEYARD THOROUGHFARE
MILLER ST. TO LUNALILO FREEWAY
PROJECT NO. 100-000000-1(3)
Scale: As Noted.

SHEET NO. 1 OF 10 SHEETS

5927. (57)

5928. (57)