


FED. ROAD DIST. NO.	STATE	FED. AID PROJ. NO.	FISCAL YEAR	SHEET NO.	TOTAL SHEETS
HAWAII	HAW.	BU-072-1(4)		3	6

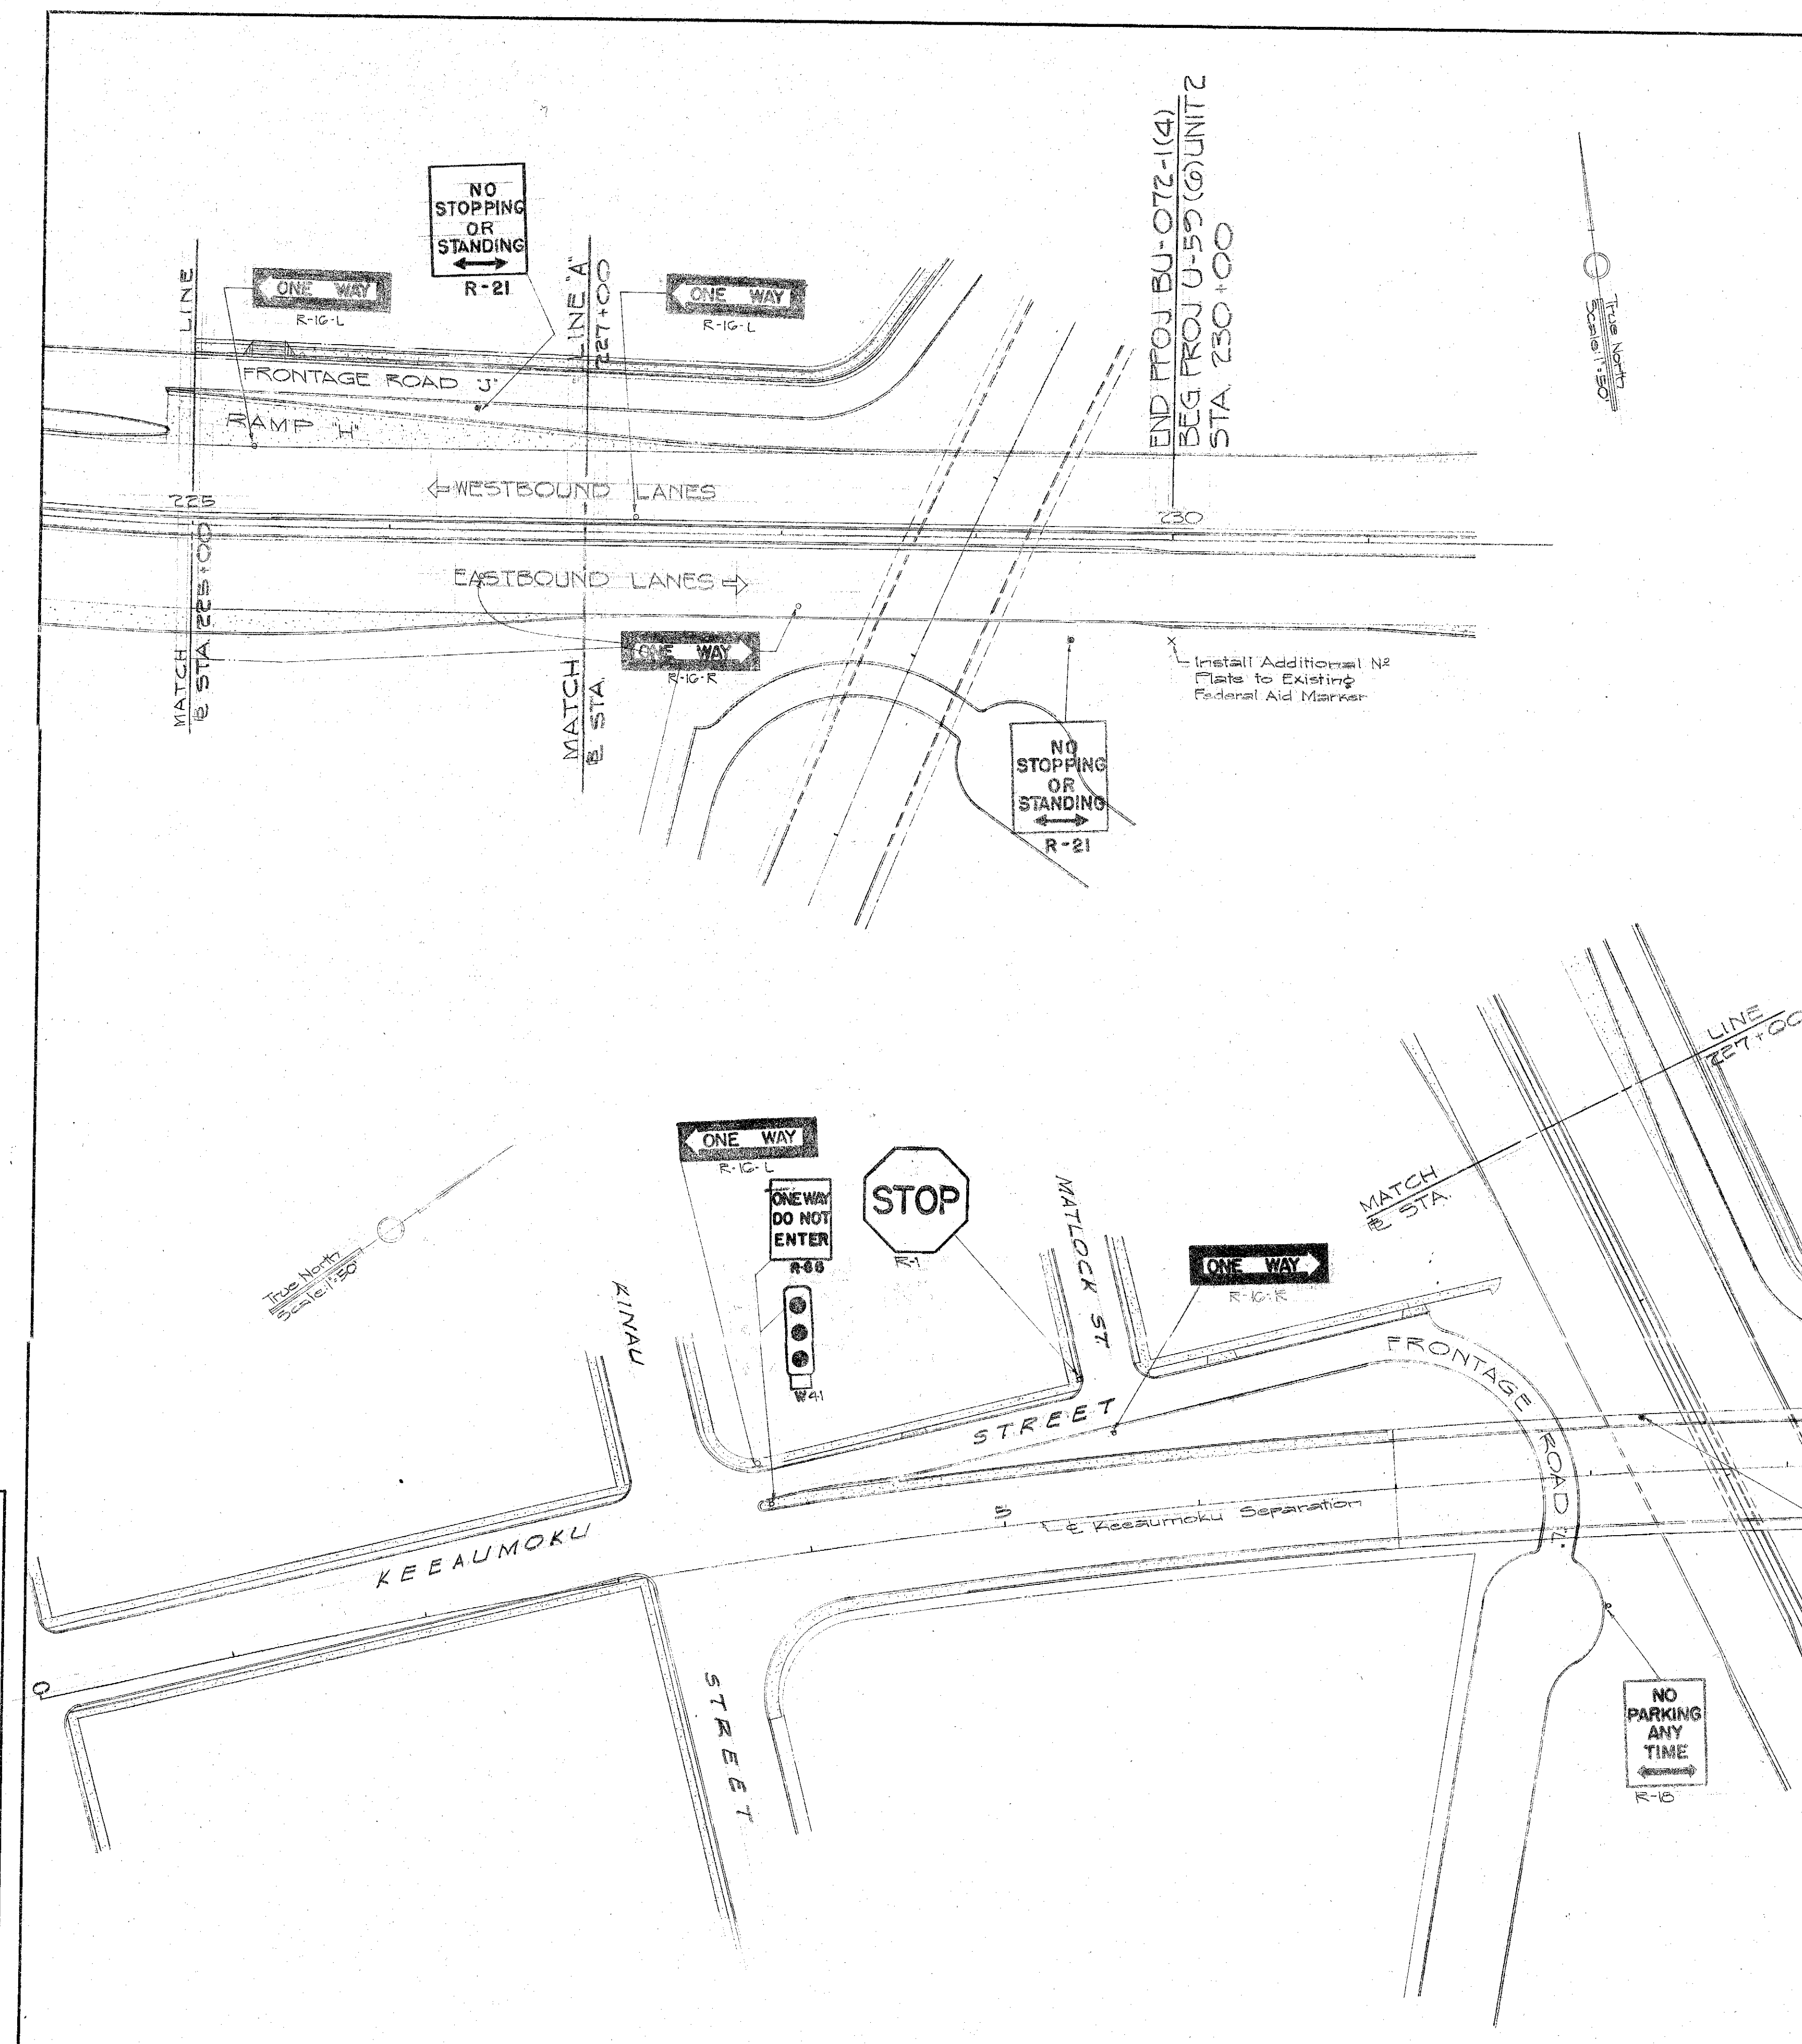

SUMMARY OF REGULATORY AND WARNING SIGNS

TYPE	MESSAGE	MOUNTED ON			TOTAL REQUIRED	EXIST. SIGNS TO BE RESET OR SALVAGED	NEW SIGNS REQUIRED
		Walls	GI Pipe Post	Other Standards			
R-1	Stop		11	5	11	6	5
R-6	No Right Turn			2	2		2
R-14	Keep Right		5	2	7		7
R-10-R	One Way		11	5	14	13	1
R-10-L	One Way		1	2	3	16	0
R-15	No Parking Any Time		2	1	3		3
R-21	No Stopping or Standing	1	0	5	12		12
R-30	Yield Right of Way		1		1		1
R-50	One Way Do Not Enter		1		1		1
R-102-A	* Speed Limit 25		7		7		
R-102-C	* Speed Limit 45		1	7	8		
R-104-A	Reduced Speed of 25 Ahead		1		1		1
R-105-A	Begin 25 Mile Speed			1	1		1
R-105-C	Begin 45 Mile Speed			1	1		1
W-10	Pavement Narrows			1	1		1
W-20	Merging Traffic		5		5		5
W-41	(Reflectors)		17		17		17
W-44	(Reflectors)		3		3		3

* Not in this contract

NOTE:
1. Pavement markings are not part of this contract. Work to be done by others.

ORIGINAL PLAN	DESIGNED BY	DATE
NOTE BOOK	DESIGNED BY	
	QUANTITIES CHECKED BY	
	CHECKED BY	

TERRITORIAL HIGHWAY DEPARTMENT
TERRITORY OF HAWAII
TRAFFIC SIGNS
LUNALILO FREEWAY
PELE ST. TO KEEAUMOKU ST.
PROJECT NO. BU-072-1(4)

SHEET No. 3 OF 6 SHEETS

5927